

O.D.O.T. DISTRICT 2 SURVEY OFFICE (USE ONLY)

PERSONNEL

REFERENCE NO. N

SHEET 14 OF 17

NOTES BURNSIDE

DATE 6/22/70

ROUTE OLD US 6

H.C. BURNSIDE

WEATHER

COUNTY WOOD

R.C. HOFFMAN

TEMP.

TOWNSHIP BOWLING GREEN

DWG BY RHOADES PID

SECTION 24

T 5 N R 10 E

TYPE MONUMENT P.K.NAIL


ON SURFACE - ~~BELOW~~ ON

OFFSET Q PAVEMENT ON LT : RT  
- TO - EDGE PAVEMENT


STATION: 605+06.70

HORIZ.DATUM:  GEOID:

GRID: NORTHING:  EASTING:

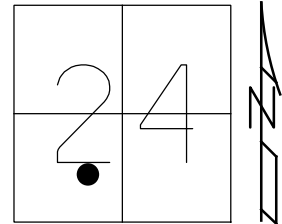

RECORD:  
 $\Delta = 5^{\circ} 46'$  LT  
STA. 605+06.70  
FD P.K.NAIL  
6/22/70, SH

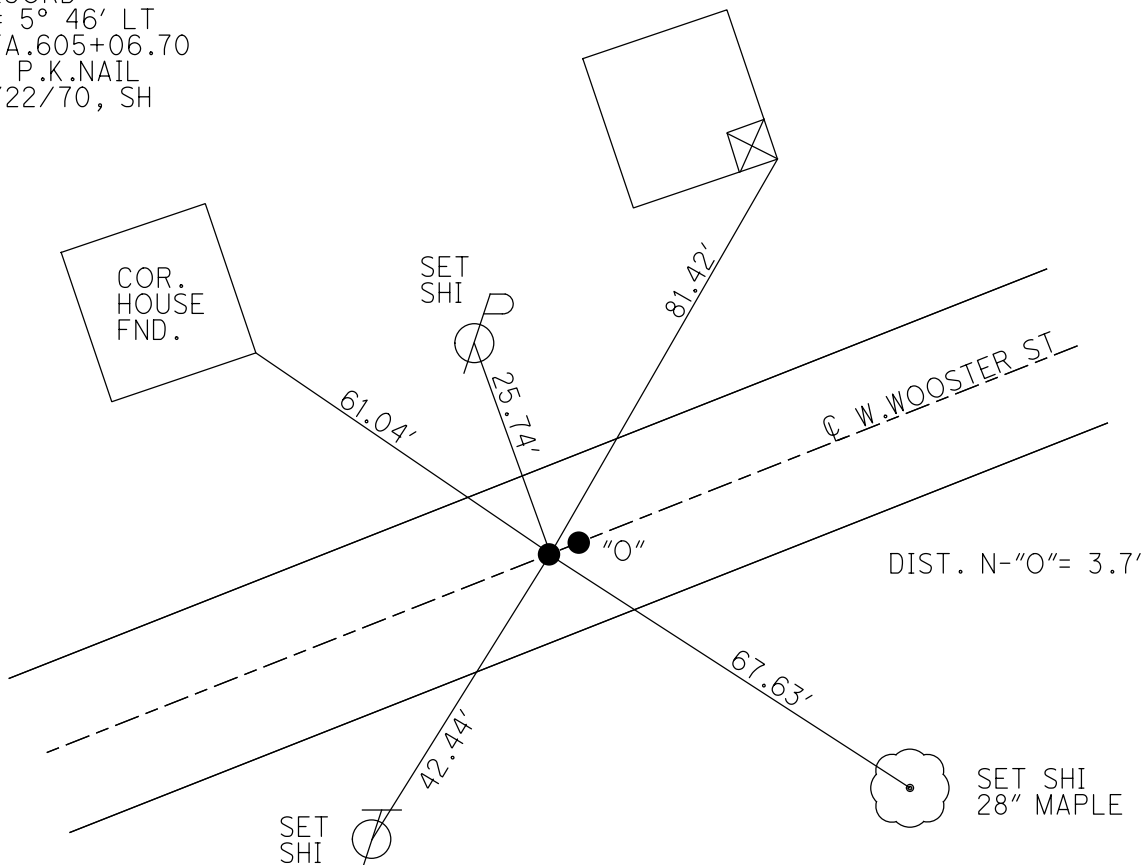

PERSONNEL TITLE PERSONNEL TITLE

BURNSIDE  
HOFFMANCOUNTY WOODDATE OK 6-22-70S. R. OLD U.S. #6WEATHER ClearSEC. BOWLING GREENTEMP. +73°

DESCRIPTION

CONTROL POINTS

LEFT


CENTER LINE

RIGHT


JOB NO.

STA. 605+10.4  
Mort. SET. - FD. P.K.

#792

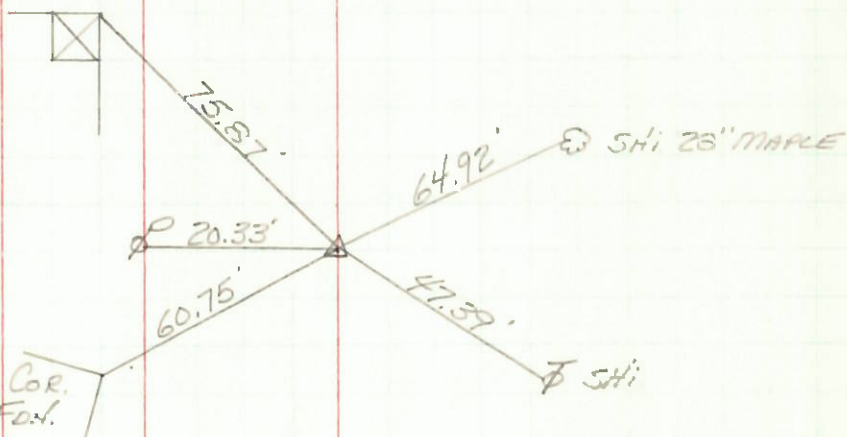S.E. COR.  
Ho. FDN.STA. 605+06.70  
P.I.  $\Delta = 5^\circ 46' LT.$   
FD. P.K.

#791

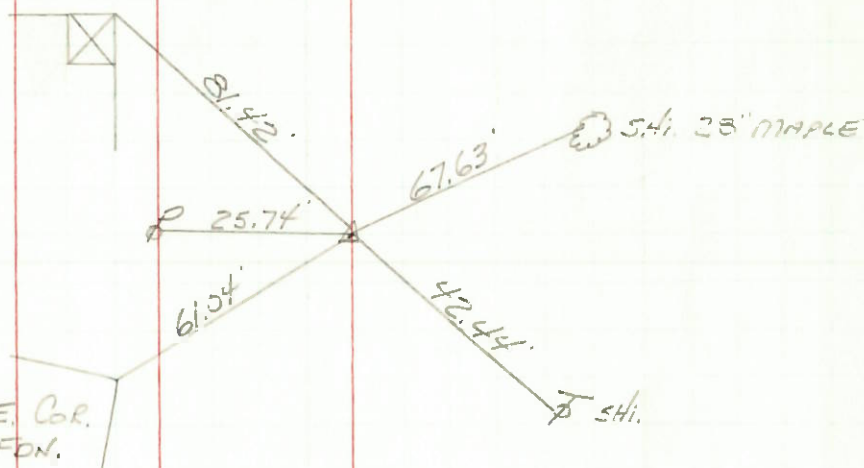S.E. COR.  
Ho. FDN.STA. 601+58.25  
COR. STONE MON. SET.  
FD. P.K.

#790

BASE HYD.

IRON POST  
NORTH