

O.D.O.T. DISTRICT 2 SURVEY OFFICE (USE ONLY)

PERSONNEL

REFERENCE NO. A

SHEET 1 OF 26

NOTES LEU

DATE 8/8/17

ROUTE SR 295

H.C.

WEATHER

COUNTY LUCAS

R.C.

TEMP.

TOWNSHIP PROVIDENCE

SECTION 5

DWG BY MILLER

PID 83894

T 5 N R 9 E

TYPE MONUMENT MONBOX W/ 3/4" IPIN

ON SURFACE - ~~BELOW~~ ON

OFFSET CL PAVEMENT 2.1' ~~LT~~ : RT

- TO - EDGE PAVEMENT


STATION: 5+84.5

HORZ.DATUM: NAD83(2011)

GEOID: 2012A

GRID: NORTHING: 640178.338

EASTING: 1595420.313

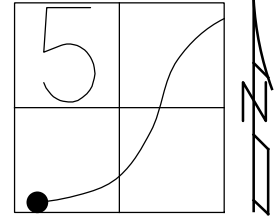

RECORD:
PRIOR REF6-US24
FD MONBOX
5-20-97, BVD

NOTE:

REF: LUC-24-0.00

PID: 25490, 83984

NEW MON BOX SET PER PID

#83894 WITH STRADDLERS, NO


IRON PIN WAS FOUND INSIDE.

ODOT STAFF SET 3/4" IRON PIN

FROM STRADDERS. SHOT W/GPS,

BUT DID NOT REFERENCE

YEAR 2017

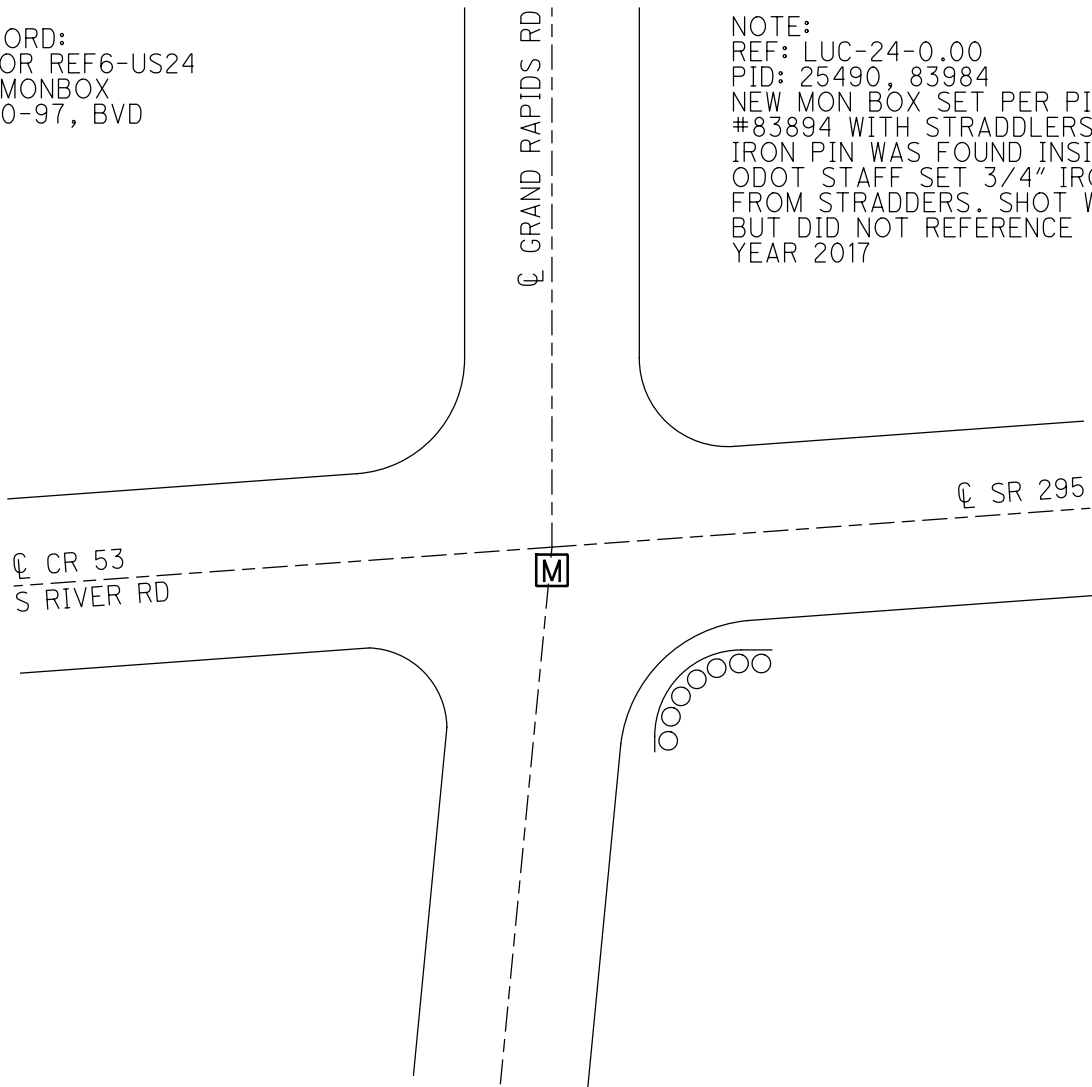

O.D.O.T. DISTRICT 2 SURVEY OFFICE (USE ONLY)

PERSONNEL

REFERENCE NO. B

SHEET 2 OF 26

NOTES LEU

DATE 8/8/17

ROUTE SR 295

H.C.

WEATHER

COUNTY LUCAS

R.C.

TEMP.

TOWNSHIP PROVIDENCE

SECTION 5

DWG BY MILLER

PID 83894

T 5 N R 9 E

TYPE MONUMENT MONBOX W/ 3/4" IPIN

ON SURFACE - ~~BELOW~~ ON

OFFSET CL PAVEMENT 1.4' ~~LT~~ : RT

10.5' TO RT EDGE PAVEMENT


STATION: 19+54.3

HORIZ.DATUM: NAD83(2011)

GEOID: 2012A


GRID: NORTHING: 641026.536

EASTING: 1596429.344

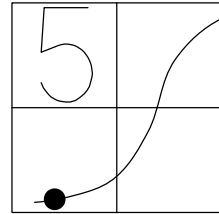

RECORD:
PRIOR REF7-US24
SET PK/WASHER
10-21-97, SAH

NOTE: PT
REF: LUC-24-0.00
PID: 25490, 83984
NEW MON BOX SET PER PID
#83894 WITH STRADDLERS, NO
IRON PIN WAS FOUND INSIDE.
ODOT STAFF SET 3/4" IRON PIN
FROM STRADDERS. SHOT W/GPS,
BUT DID NOT REFERENCE
YEAR 2017

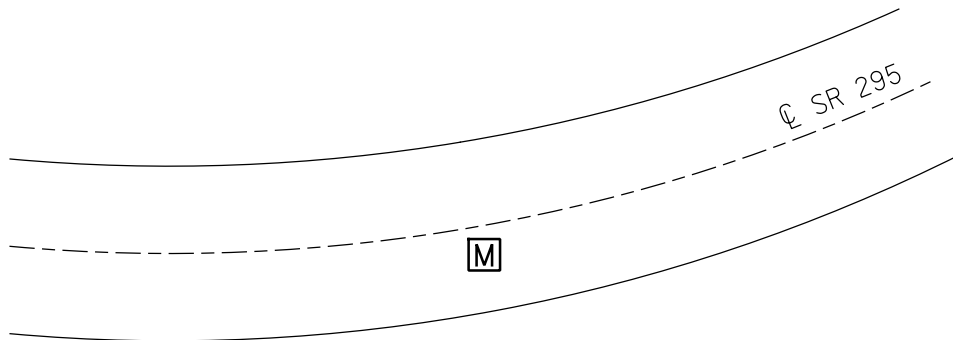

O.D.O.T. DISTRICT 2 SURVEY OFFICE (USE ONLY)

PERSONNEL

REFERENCE NO. C

SHEET 3 OF 26

NOTES LEU

DATE 8/8/17

ROUTE SR 295

H.C.

WEATHER

COUNTY LUCAS

R.C.

TEMP.

TOWNSHIP PROVIDENCE

SECTION 5

DWG BY MILLER

PID 83894

T 5 N R 9 E

TYPE MONUMENT MONBOX W/ 3/4" IPIN

ON SURFACE - ~~BELOW~~ ON

OFFSET Q PAVEMENT 1.2' LT : ~~RT~~

10.4' TO LT EDGE PAVEMENT


STATION: 37+11.2

HORIZ.DATUM: NAD83(2011)

GEOID: 2012A

GRID: NORTHING: 642649.393

EASTING: 1597102.639

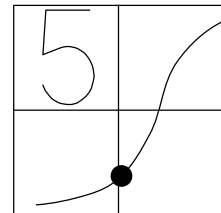

NOTE:

REF: LUC-24-0.00

PID: 25490, 83984

NEW MON BOX SET PER PID

#83894 WITH STRADDLERS, NO

IRON PIN WAS FOUND INSIDE.

ODOT STAFF SET 3/4" IRON PIN

FROM STRADDERS. SHOT W/GPS,

BUT DID NOT REFERENCE

YEAR 2017

RECORD: P.C.

STA.96+96.55

PRIOR REF 8B-US24

SET R.R.SPIKE

1958

FD R.R.SPIKE

5" DOWN



1994

FD P.K./WASHER

5/20/97, BVD

SET PK/WASHER

10-21-97, SAH

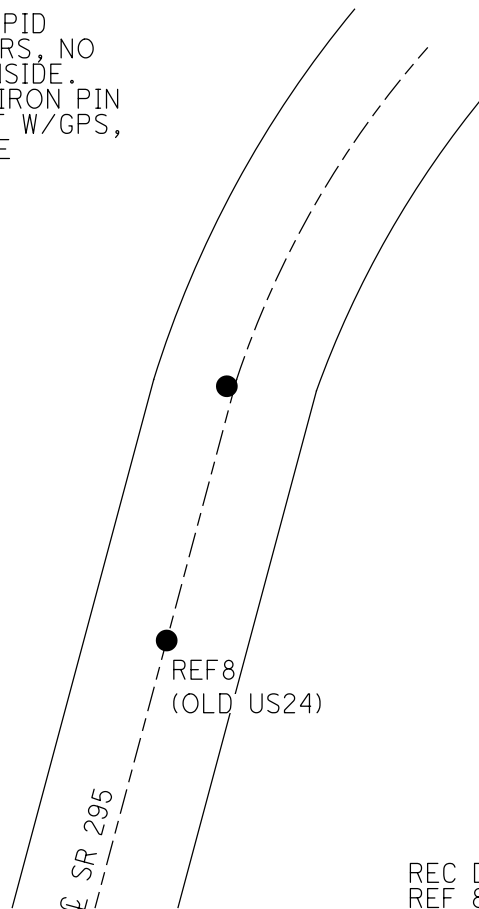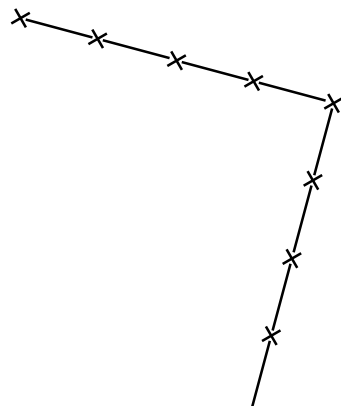

REC DIST. REFC-REF8= 123.80'
REF 8 ORIGIN UNK. POSSIBLY
MISTAKEN AS PC FROM 1964 TILL
1994. POINT NOT RESET.

O.D.O.T. DISTRICT 2 SURVEY OFFICE (USE ONLY)

PERSONNEL

REFERENCE NO. D

SHEET 4 OF 26

NOTES AUBLE

DATE 11/6/20

ROUTE SR 295

H.C. AUBLE

WEATHER SUNNY

COUNTY LUCAS

R.C. O'DONNELL

TEMP. 54°

TOWNSHIP PROVIDENCE

SECTION 5

DWG BY NIESE

PID NO PID

T 5 N R 9 E

TYPE MONUMENT MONBOX W/ 3/4" IPIN

ON SURFACE - ~~BELOW~~ ON

OFFSET 6.0' LT : ~~RT~~

6.0' TO LT EDGE PAVEMENT


STATION: 39+11.2±

HORIZ.DATUM: NAD83(2011)


GEOID: NAVD88 2012A

GRID: NORTHING: 642649.400

EASTING: 1597102.630

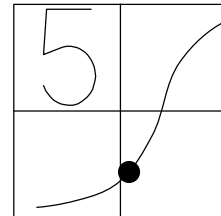

RECORD:
PRIOR REF 8A-US24
FD P.K./WASHER
5/28/97, SAH
SET P.K./WASHER
10/21/97, SAH
D.N.F.
8/8/17, JLL
FD MONBOX
W/ 3/4" IPIN
11/6/20, DSA

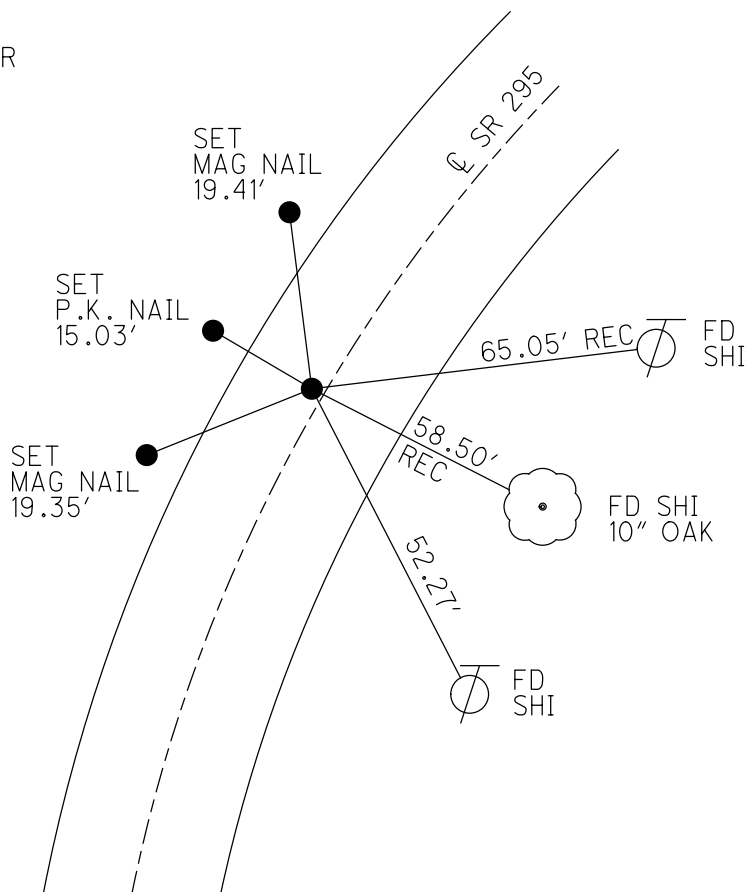

O.D.O.T. DISTRICT 2 SURVEY OFFICE (USE ONLY)

PERSONNEL

REFERENCE NO. E

SHEET 5 OF 26

NOTES HUSS
H.C. VAN DUSEN
R.C. MOSER

DATE 5/28/97
WEATHER CLOUDY/WINDY
TEMP. 61°

ROUTE SR 295
COUNTY LUCAS
TOWNSHIP PROVIDENCE
SECTION 5
T 5 N R 9 E

DWG BY MILLER PID 83894

TYPE MONUMENT BOLT W/ CHISELED "+"

ON SURFACE - ~~BELOW~~ ON

OFFSET Q PAVEMENT 42' LT : ~~RT~~

29' TO LT EDGE PAVEMENT


STATION: 40+31.2

HORZ.DATUM: NAD83(2011)

GEOID: 2012A


GRID: NORTHING: 642944.925

EASTING: 1597225.259

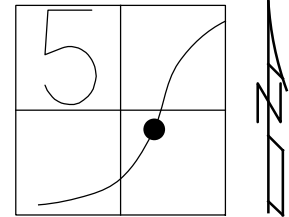

RECORD:
PRIOR REF9-US24
NOT DISTURBED
FD BOLT W/ "+"
5/28/97
10-21-97, SAH
FD MONBOX
W/ 1/2" IPIN
REF6
8-8-17, JLL

NOTE:
REF: LUC-24-0.00
PID: 25490, 83984

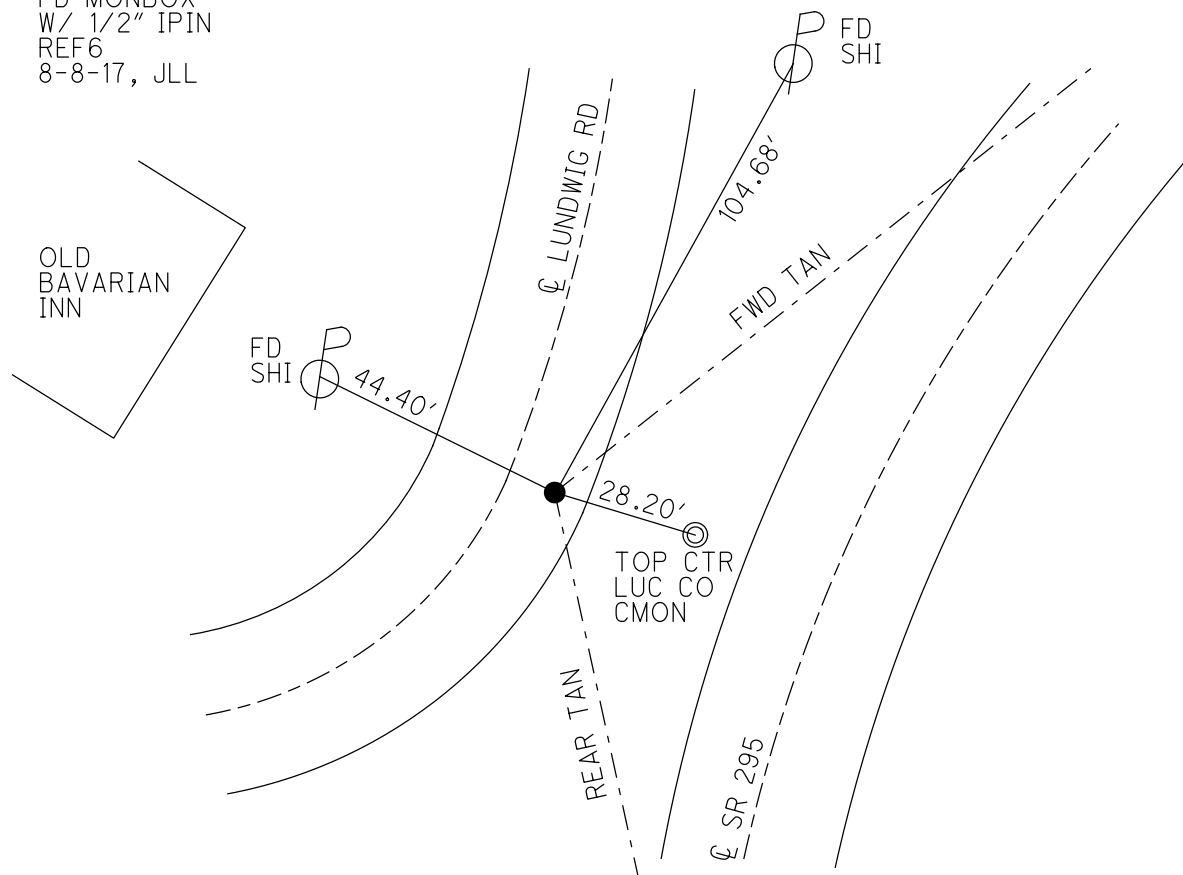

O.D.O.T. DISTRICT 2 SURVEY OFFICE (USE ONLY)

PERSONNEL

REFERENCE NO. F

SHEET 6 OF 26

NOTES AUBLE

DATE 11/6/20

ROUTE SR 295

H.C. AUBLE

WEATHER SUNNY

COUNTY LUCAS

R.C. O'DONNELL

TEMP. 54°

TOWNSHIP PROVIDENCE

DWG BY NIESE

PID NO PID

SECTION 5

T 5 N R 9 E

TYPE MONUMENT MONBOX W/ 3/4" IPIN

ON SURFACE - ~~BELOW~~ ON

OFFSET Q PAVEMENT 2.3' LT : ~~RT~~

9.6' TO LT EDGE PAVEMENT


STATION: 43+40.9

HORZ.DATUM: NAD83(2011)


GEOID: NAVD88 2012A

GRID: NORTHING: 643160.151

EASTING: 1597461.960

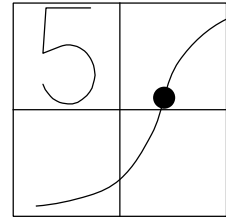

RECORD:
PRIOR REFA9-US24
FD P.K./WASHER
5/28/97, BVD
SET P.K./WASHER
10/21/97, SAH
FD MONBOX
SET 3/4" IPIN
8/8/17, JLL

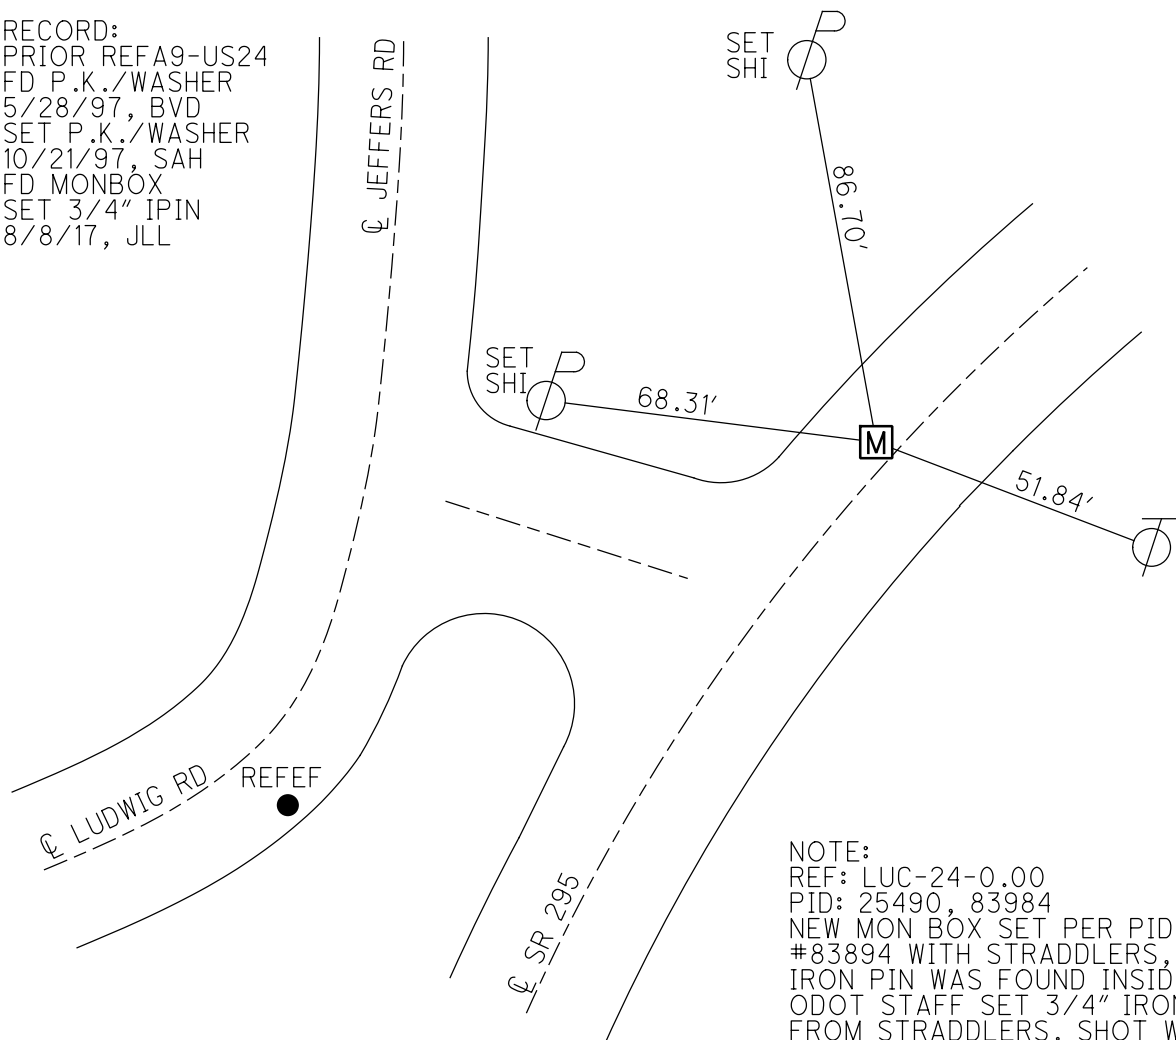

NOTE:
REF: LUC-24-0.00
PID: 25490, 83984
NEW MON BOX SET PER PID
#83894 WITH STRADDLERS, NO
IRON PIN WAS FOUND INSIDE.
ODOT STAFF SET 3/4" IRON PIN
FROM STRADDLERS. SHOT W/GPS,
BUT DID NOT REFERENCE
YEAR 2017

O.D.O.T. DISTRICT 2 SURVEY OFFICE (USE ONLY)

PERSONNEL

REFERENCE NO. G

SHEET 7 OF 26

NOTES LEU

DATE 8/8/17

ROUTE SR 295

H.C.

WEATHER

COUNTY LUCAS

R.C.

TEMP.

TOWNSHIP PROVIDENCE

DWG BY MILLER

PID 83894

SECTION 5

T 5 N R 9 E

TYPE MONUMENT MONBOX W/ 3/4" IPIN

ON SURFACE - ~~BELOW~~ ON

OFFSET CL PAVEMENT 2.0' LT : ~~RT~~
10.0' TO LT EDGE PAVEMENT


STATION: 53+96.2

HORZ.DATUM: NAD83(2011)

GEOID: 2012A


GRID: NORTHING: 643869.834

EASTING: 1598242.451

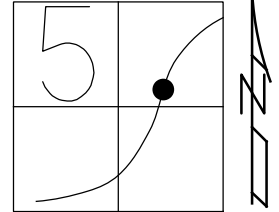

RECORD: P.C.
PRIOR REF10-US24
FD P.K./WASHER
5/28/97, BVD
SET P.K./WASHER
10-21-97, SAH

NOTE:
REF: LUC-24-0.00
PID: 25490, 83984
NEW MON BOX SET PER PID
#83894 WITH STRADDLERS, NO
IRON PIN WAS FOUND INSIDE.
ODOT STAFF SET 3/4" IRON PIN
FROM STRADDLERS. SHOT W/GPS,
BUT DID NOT REFERENCE
YEAR 2017

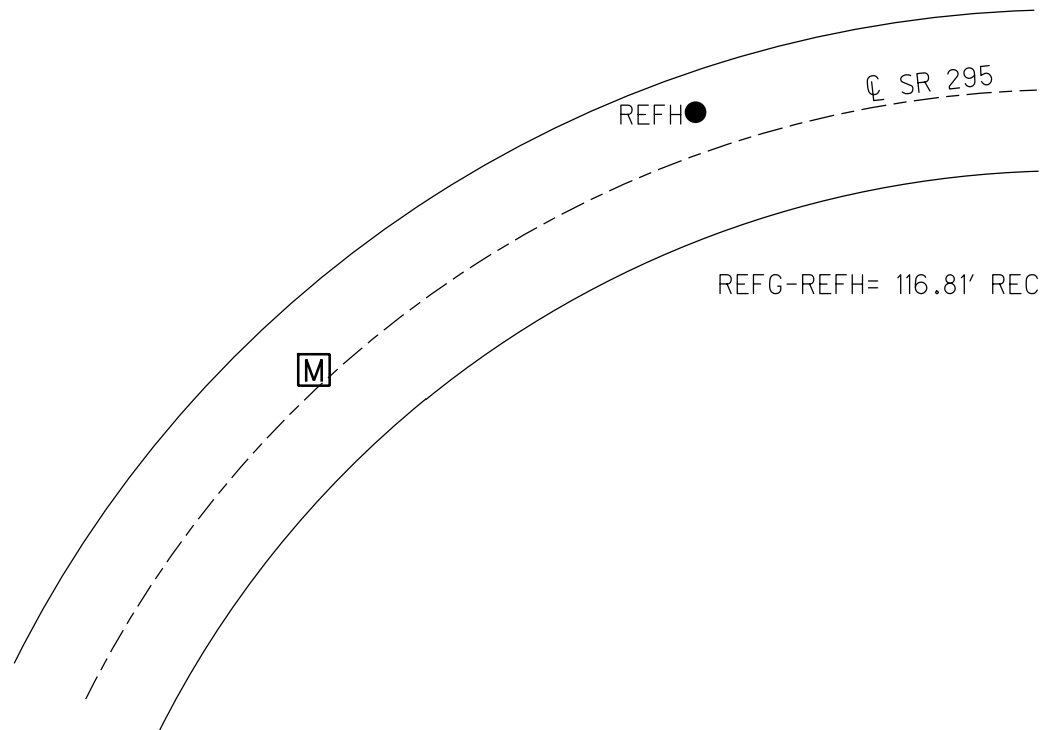

O.D.O.T. DISTRICT 2 SURVEY OFFICE (USE ONLY)

PERSONNEL

REFERENCE NO. H

SHEET 8 OF 26

NOTES HUSS

DATE 5/28/97

ROUTE SR 295

H.C. VAN DUSEN

WEATHER CLOUDY/WINDY

COUNTY LUCAS

R.C. MOSER

TEMP. 61°

TOWNSHIP PROVIDENCE

SECTION 5

DWG BY MILLER PID

T 5 N R 9 E

TYPE MONUMENT PK/WASHER

ON SURFACE - ~~BELOW~~ ON

OFFSET CL PAVEMENT 8.0' LT : ~~RT~~

4.0' TO LT EDGE PAVEMENT


STATION: 55+13

HORIZ.DATUM: NAD83(2011)


GEOID: 2012A

GRID: NORTHING:

EASTING:

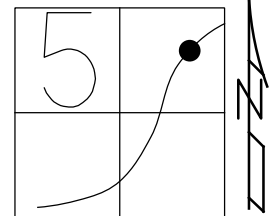

RECORD: P.I.
PRIOR REF11-US24
FD P.K./WASHER
5/28/97, BVD
SET P.K./WASHER
10-21-97, SAH

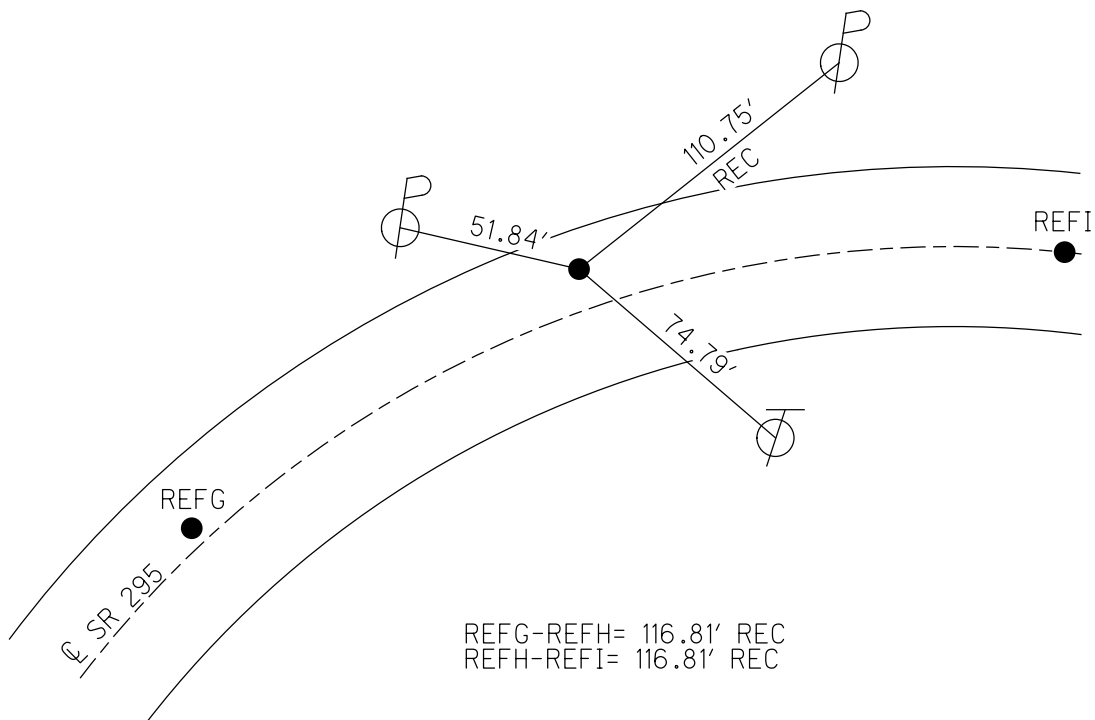

O.D.O.T. DISTRICT 2 SURVEY OFFICE (USE ONLY)

PERSONNEL

REFERENCE NO. 1

SHEET 9 OF 26

NOTES LEU

DATE 8/8/17

ROUTE SR 295

H.C. HOMAN

WEATHER

COUNTY LUCAS

R.C. LEU

TEMP.

TOWNSHIP PROVIDENCE

SECTION 5

DWG BY MILLER

PID 83894

T 5 N R 9 E

TYPE MONUMENT MON BOX W/ 3/4" IPIN

ON SURFACE - ~~BELOW~~ ON

OFFSET Q PAVEMENT ~~LT:RT~~

TO EDGE PAVEMENT


STATION: 56+29.5

HORIZ.DATUM: NAD83(2011)

GEOID: 2012A


GRID: NORTHING: 644015.987

EASTING: 1598424.279

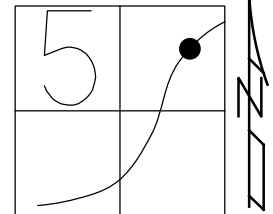

RECORD:

NOTE: P.T.
REF: LUC-24-0.00
PID: 25490, 83984
NEW MON BOX SET PER PID
#83894 WITH STRADDLERS, NO
IRON PIN WAS FOUND INSIDE.
ODOT STAFF SET 3/4" IRON PIN
FROM STRADDERS. SHOT W/GPS,
BUT DID NOT REFERENCE
YEAR 2017

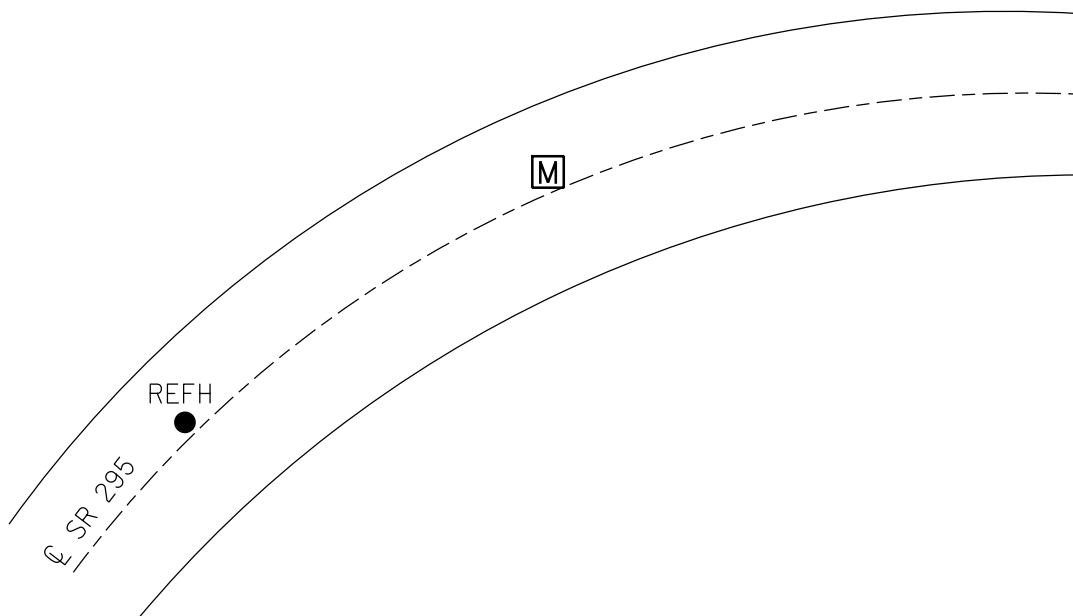

REFI-REFIJ= 116.81' REC

O.D.O.T. DISTRICT 2 SURVEY OFFICE (USE ONLY)

PERSONNEL

REFERENCE NO. J

SHEET 10 OF 26

NOTES LEU

DATE 8/8/17

ROUTE SR 295

H.C. HOMAN

WEATHER

COUNTY LUCAS

R.C. LEU

TEMP.

TOWNSHIP PROVIDENCE

SECTION 5

DWG BY MILLER PID 83894

T 5 N R 9 E

TYPE MONUMENT MON BOX W/ 3/4" IPIN

ON SURFACE - ~~BELOW~~ ON

OFFSET CL PAVEMENT LT:RT

TO EDGE PAVEMENT


STATION: 66+55

HORZ.DATUM: NAD83(2011)

GEOID: 2012A


GRID: NORTHING: 644608.390

EASTING: 1599261.606

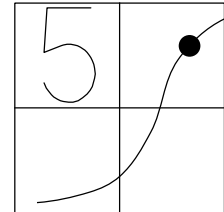

RECORD:

NOTE: P.C.
REF: LUC-24-0.00
PID: 25490, 83984
NEW MON BOX SET PER PID
#83894 WITH STRADDLERS, NO
IRON PIN WAS FOUND INSIDE.
ODOT STAFF SET 3/4" IRON PIN
FROM STRADDERS. SHOT W/GPS,
BUT DID NOT REFERENCE
YEAR 2017

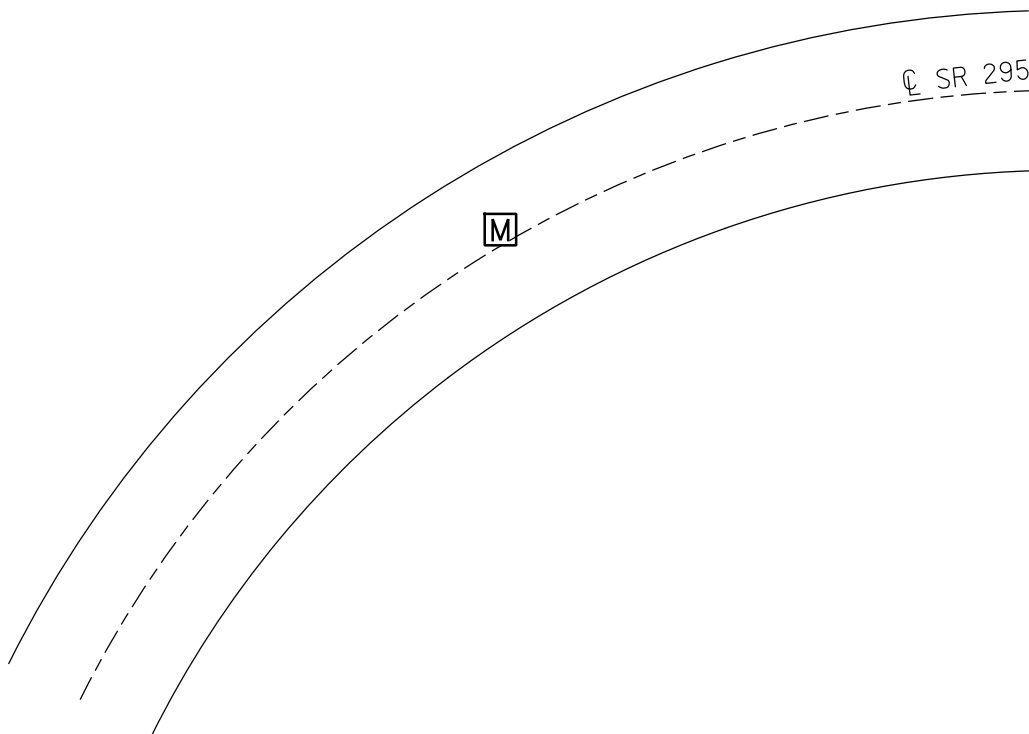

O.D.O.T. DISTRICT 2 SURVEY OFFICE (USE ONLY)

PERSONNEL

REFERENCE NO. K

SHEET 11 OF 26

NOTES

HUSS

DATE

5/28/97

ROUTE SR 295

H.C.

VAN DUSEN

WEATHER

CLOUDY/WINDY

COUNTY LUCAS

R.C.

MOSER

TEMP.

61°

TOWNSHIP PROVIDENCE

SECTION 5

DWG BY MILLER

PID

T 5 N R 9 E

TYPE MONUMENT

P.K./WASHER

ON SURFACE - ~~BELOW~~ ON

OFFSET 2.3' TO LT PAVEMENT 14.2' LT : ~~RT~~

2.3' TO LT EDGE PAVEMENT


STATION: ±67+58

HORZ.DATUM: NAD83(2011)


GEOID: 2012A

GRID: NORTHING:

EASTING:

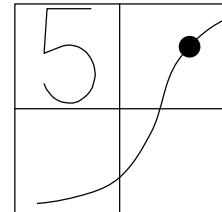

RECORD:
PRIOR REF13-US24
FD P.K./WASHER
5/28/97, BVD
SET P.K./WASHER
10-21-97, SAH

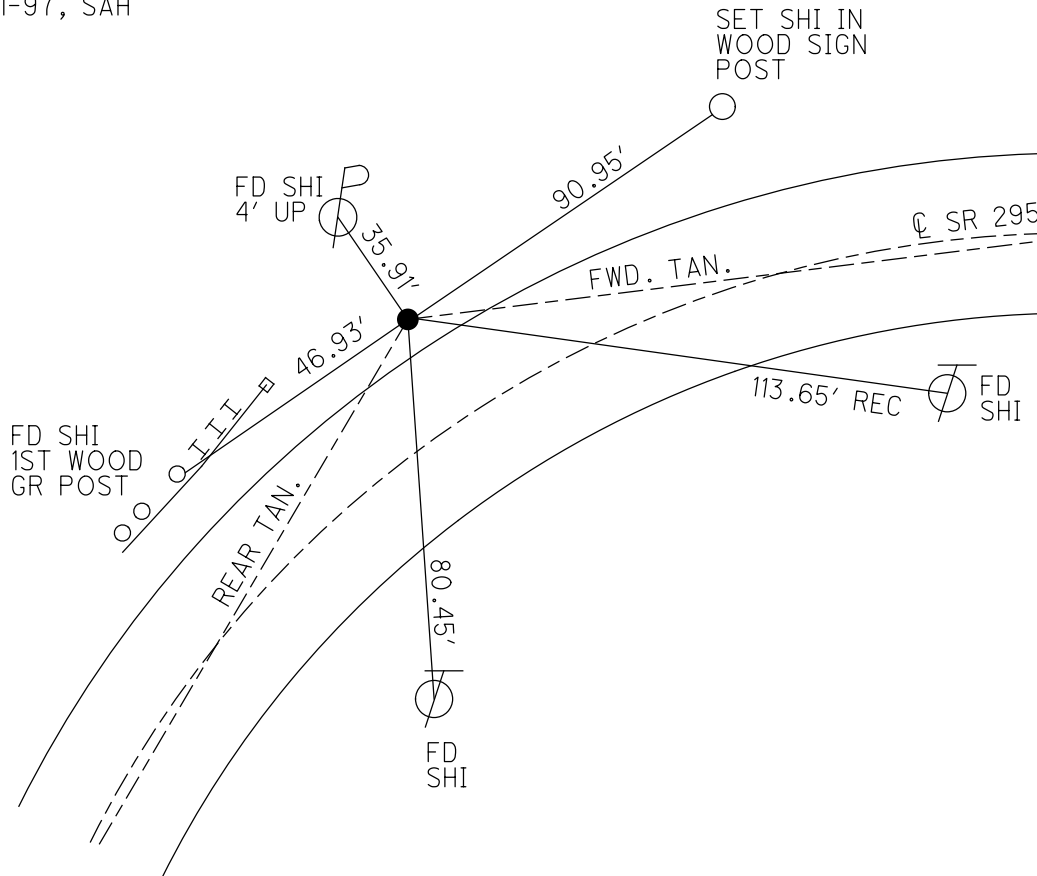

O.D.O.T. DISTRICT 2 SURVEY OFFICE (USE ONLY)

PERSONNEL

REFERENCE NO. L

SHEET 12 OF 26

NOTES LEU

DATE 8/8/17

ROUTE SR 295

H.C.

WEATHER

COUNTY LUCAS

R.C.

TEMP.

TOWNSHIP PROVIDENCE

DWG BY MILLER

PID 83894

SECTION 5

T 5 N R 9 E

TYPE MONUMENT MON BOX W/ 3/4" IPIN

ON SURFACE - ~~BELOW~~

OFFSET $\varnothing$ PAVEMENT ~~LT~~ : ~~RT~~

TO EDGE PAVEMENT


STATION: 68+60.6

HORZ.DATUM: NAD83(2011)

GEOID: 2012A


GRID: NORTHING: 644708.287

EASTING: 1599440.964

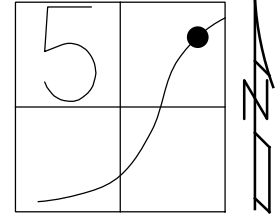

RECORD:

NOTE: P.T.
REF: LUC-24-0.00
PID: 25490, 83984
NEW MON BOX SET PER PID
#83894 WITH STRADDLERS, NO
IRON PIN WAS FOUND INSIDE.
ODOT STAFF SET 3/4" IRON PIN
FROM STRADDERS. SHOT W/GPS,
BUT DID NOT REFERENCE
YEAR 2017

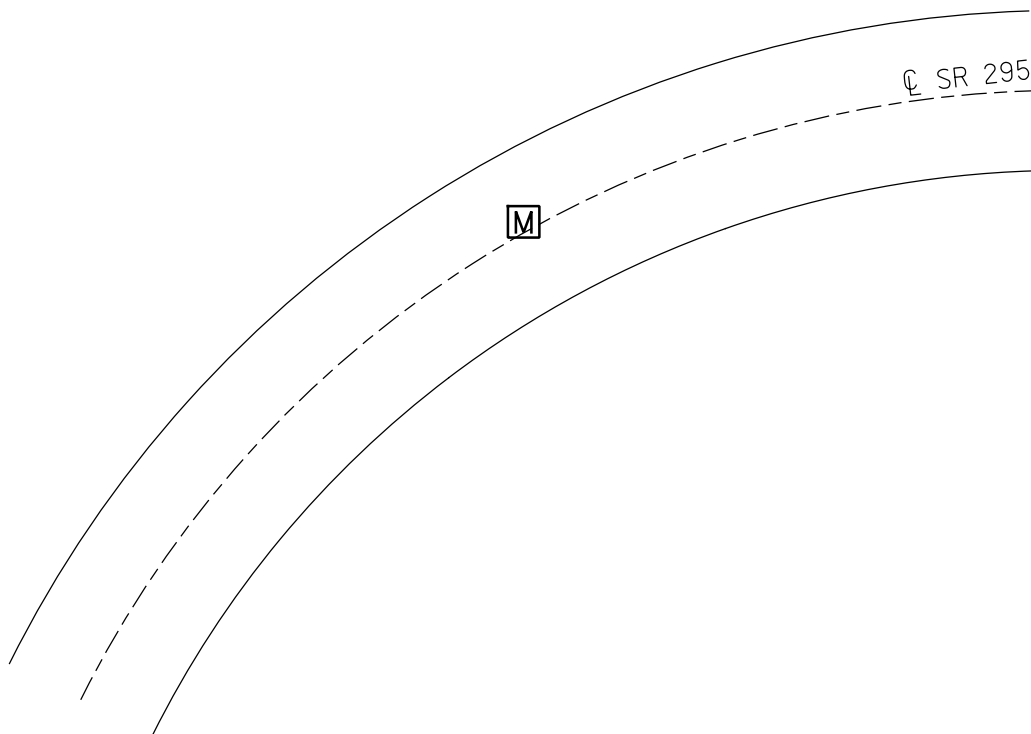

O.D.O.T. DISTRICT 2 SURVEY OFFICE (USE ONLY)

PERSONNEL

REFERENCE NO. M

SHEET 13 OF 26

NOTES LUE

DATE 8/8/17

ROUTE SR 295

H.C.

WEATHER

COUNTY LUCAS

R.C.

TEMP.

TOWNSHIP PROVIDENCE

SECTION 5

DWG BY MILLER

PID 83894

T 5 N R 9 E

TYPE MONUMENT MONBOX W/ 3/4' IPIN

ON SURFACE - ~~BELOW~~ ON

OFFSET Q PAVEMENT 1.0' LT : ~~RT~~

11.0' TO LT EDGE PAVEMENT


STATION: 80+41.7

HORIZ.DATUM: NAD83(2011)


GEOID: 2012A

GRID: NORTHING: 645168.762

EASTING: 1600528.892

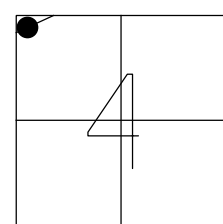


RECORD:
PRIOR REF14-US24
FD P.K./WASHER
5/28/97, BVD
SET P.K./WASHER
10-21-97, SAH

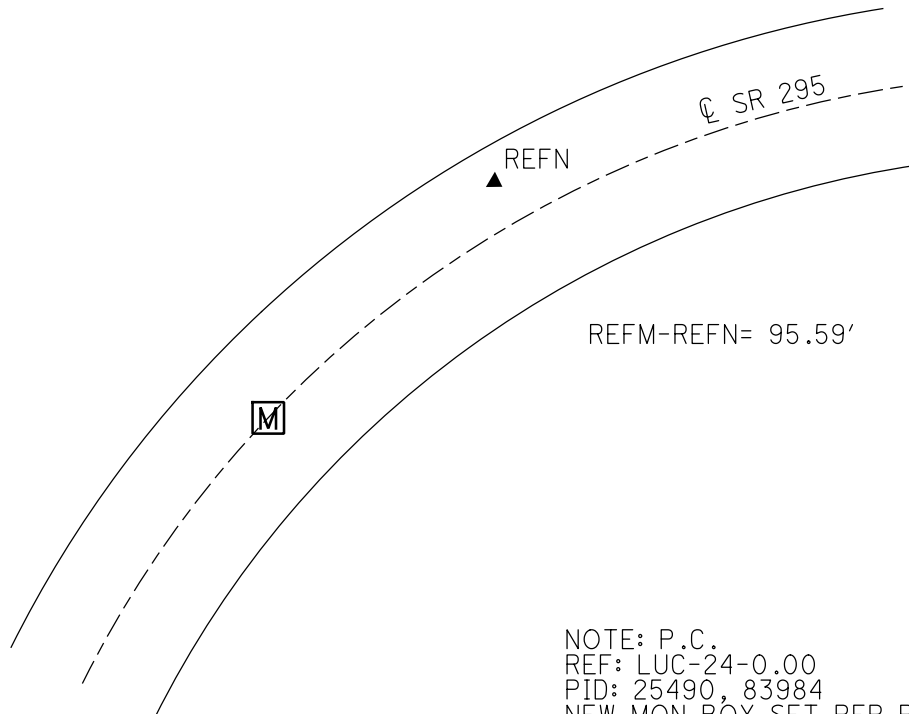


NOTE: P.C.
REF: LUC-24-0.00
PID: 25490, 83984
NEW MON BOX SET PER PID
#83894 WITH STRADDLERS, NO
IRON PIN WAS FOUND INSIDE.
ODOT STAFF SET 3/4" IRON PIN
FROM STRADDLERS. SHOT W/GPS,
BUT DID NOT REFERENCE
YEAR 2017

O.D.O.T. DISTRICT 2 SURVEY OFFICE (USE ONLY)

PERSONNEL	REFERENCE NO. <u>N</u>	SHEET <u>14</u> OF <u>26</u>
NOTES <u>HUSS</u>	DATE <u>5/28/97</u>	ROUTE <u>SR 295</u>
H.C. <u>VAN DUSEN</u>	WEATHER <u>CLOUDY/WINDY</u>	COUNTY <u>LUCAS</u>
R.C. <u>MOSER</u>	TEMP. <u>61°</u>	TOWNSHIP <u>PROVIDENCE</u>
		SECTION <u>33</u>
DWG BY <u>MILLER</u>	PID <u>83894</u>	T <u>6</u> N R <u>9</u> E
TYPE MONUMENT <u>P.K./WASHER</u>		
ON SURFACE - BELOW <u>ON</u>		
OFFSET <u>Q</u> PAVEMENT <u>3.9'</u> LT : RT		
<u>8.0'</u> TO LT EDGE PAVEMENT		
STATION: <u>±81+36</u>		
HORIZ.DATUM: <u>NAD83(2011)</u>		GEOID: <u>2012A</u>
GRID: NORTHING: _____		EASTING: _____

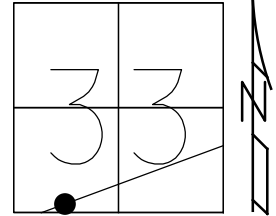

RECORD:
PRIOR REF15-US24
SET PK/WASHER
10-21-97, SAH

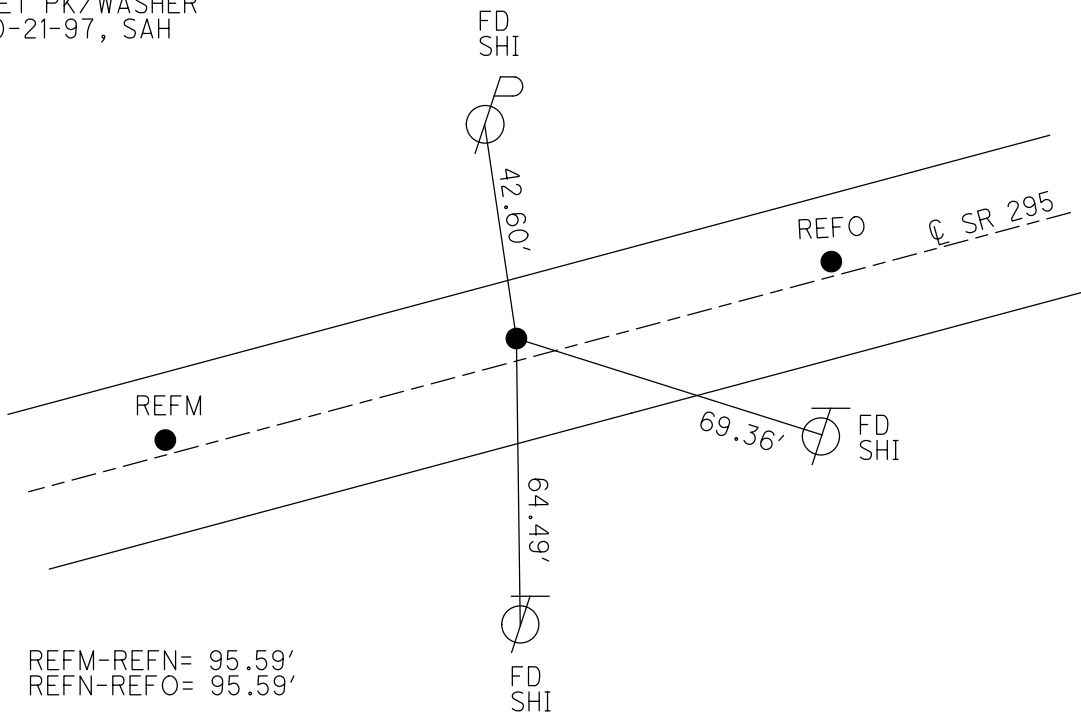

O.D.O.T. DISTRICT 2 SURVEY OFFICE (USE ONLY)

PERSONNEL

REFERENCE NO. 0

SHEET 15 OF 26

NOTES AUBLE

DATE 11/6/20

ROUTE SR 295

H.C. AUBLE

WEATHER SUNNY

COUNTY LUCAS

R.C. O'DONNELL

TEMP. 54°

TOWNSHIP PROVIDENCE

SECTION 33

DWG BY NIESE

PID NO PID

T 6 N R 9 E

TYPE MONUMENT MONBOX W/ 3/4" IPIN

ON SURFACE - ~~BELOW~~ ON

OFFSET Q PAVEMENT 1.0' LT : ~~RT~~

11.1' TO LT EDGE PAVEMENT


STATION: 82+30.7

HORZ.DATUM: NAD83(2011)

GEOID: NAVD88 2012A


GRID: NORTHING: 645237.196

EASTING: 1600707.038

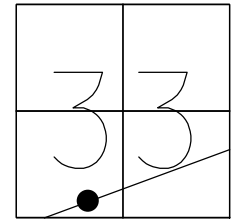

RECORD: P.T.
PRIOR REF16-US24
FD P.K./WASHER
5/28/97, BVD
D.N.F
SET P.K./WASHER
FROM TIES
10-21-97, SAH
FD MONBOX
SET 3/4" IPIN
8/8/17, JLL

NOTE: P.T.
REF: LUC-24-0.00
PID: 25490, 83984
NEW MON BOX SET PER PID
#83894 WITH STRADDLERS, NO
IRON PIN WAS FOUND INSIDE.
ODOT STAFF SET 3/4" IRON PIN
FROM STRADDLERS. SHOT W/GPS,
BUT DID NOT REFERENCE
YEAR 2017

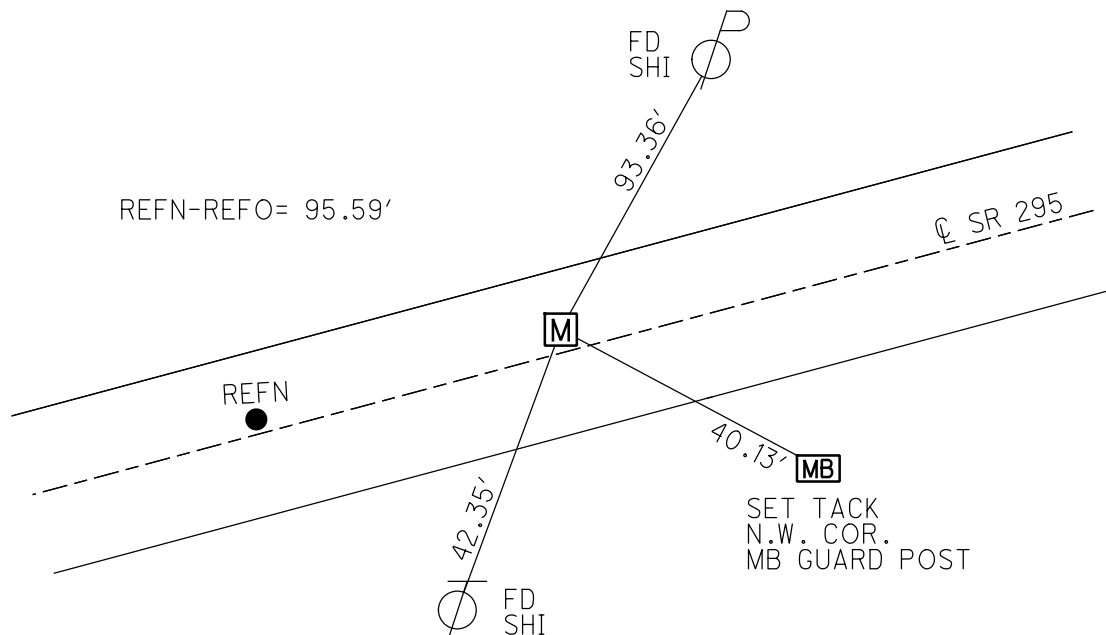

O.D.O.T. DISTRICT 2 SURVEY OFFICE (USE ONLY)

PERSONNEL

REFERENCE NO. P

SHEET 16 OF 26

NOTES LEU

DATE 8/8/17

ROUTE SR 295

H.C.

WEATHER

COUNTY LUCAS

R.C.

TEMP.

TOWNSHIP PROVIDENCE

DWG BY MILLER

PID 83894

SECTION 33

T 6 N R 9 E

TYPE MONUMENT FD MAG/W

ON SURFACE - ~~BELOW~~ ON

OFFSET 0.4' LT : RT

11.4' TO RT EDGE PAVEMENT



STATION: 87+35.6

HORZ.DATUM: NAD83(2011)

GEOID: 2012A


GRID: NORTHING: 645402.299

EASTING: 1601182.002

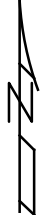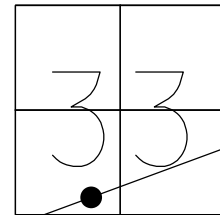

RECORD:
PRIOR REF17-US24
FD P.K./WASHER
5/28/97
SET P.K./WASHER
10-21-97, SAH
FD MAG/WASHER
REF14
8-8-17, JLL

NOTE:
REF: LUC-24-0.00
PID: 25490, 83984

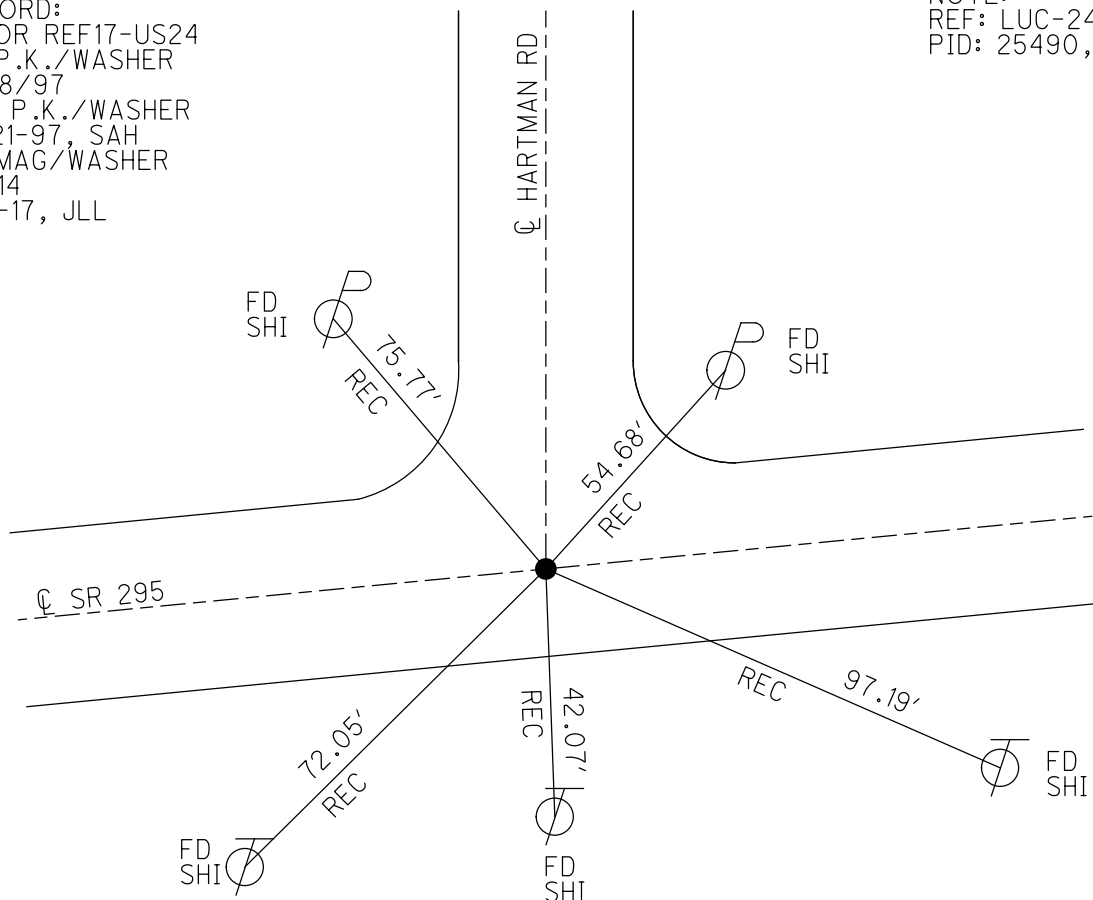

O.D.O.T. DISTRICT 2 SURVEY OFFICE (USE ONLY)

PERSONNEL

REFERENCE NO. Q

SHEET 17 OF 26

NOTES HUSS

DATE 5/28/97

ROUTE SR 295

H.C. VAN DUSEN

WEATHER CLOUDY/WINDY

COUNTY LUCAS

R.C. MOSER

TEMP. 61°

TOWNSHIP PROVIDENCE

DWG BY MILLER PID

SECTION 33

T 6 N R 9 E

TYPE MONUMENT P.K./WASHER

ON SURFACE - ~~BELOW~~ ON

OFFSET CL PAVEMENT 1.2' ~~LT~~ : RT

10.8' TO RT EDGE PAVEMENT


STATION: ±99+19

HORIZ.DATUM: NAD83(2011)


GEOID: 2012A

GRID: NORTHING:

EASTING:

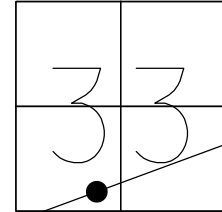

RECORD:
PRIOR REF17A-US24
SET P.K./WASHER
10-21-97, SAH

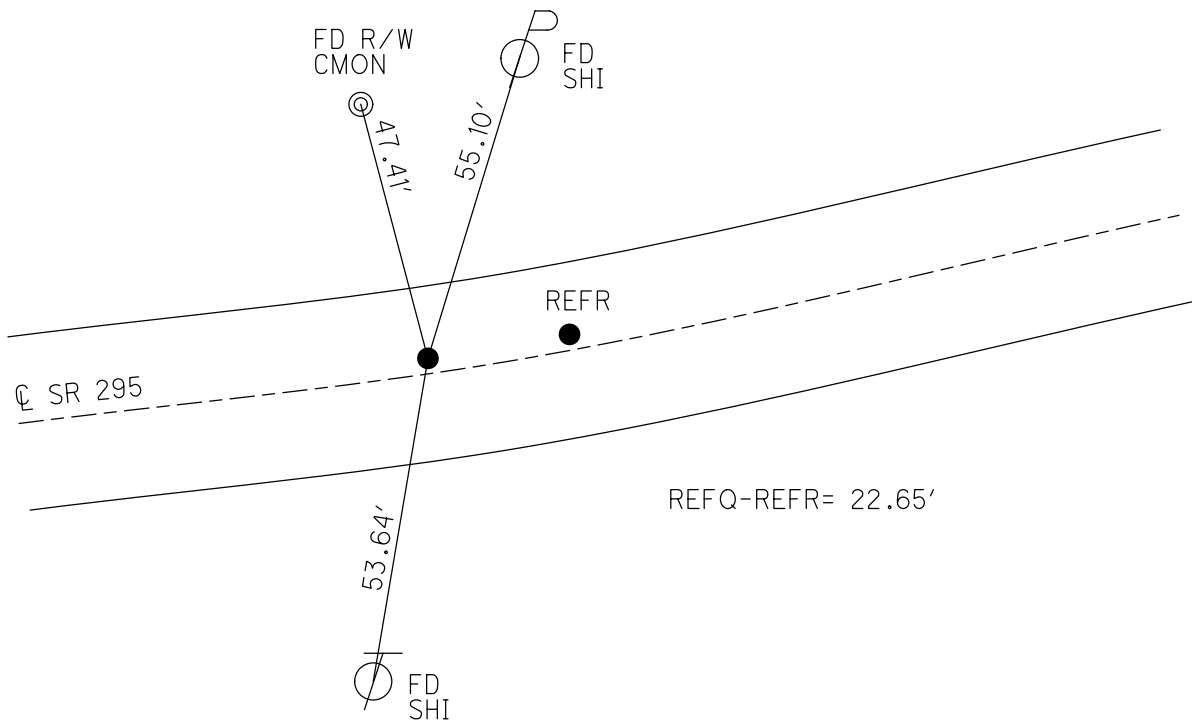

O.D.O.T. DISTRICT 2 SURVEY OFFICE (USE ONLY)

PERSONNEL

REFERENCE NO. R

SHEET 18 OF 26

NOTES LUE

DATE 8/8/17

ROUTE SR 295

H.C.

WEATHER

COUNTY LUCAS

R.C.

TEMP.

TOWNSHIP PROVIDENCE

SECTION 33

DWG BY MILLER

PID 83894

T 6 N R 9 E

TYPE MONUMENT MONBOX W/ 3/4" IPIN

ON SURFACE - ~~BELOW~~ ON

OFFSET $\angle$ PAVEMENT 1.2' ~~LT~~ : RT

 10.3' TO RT EDGE PAVEMENT


STATION: 99+41.7

HORZ.DATUM: NAD83(2011)

GEOID: 2012A


GRID: NORTHING: 645799.632

EASTING: 1602321.296

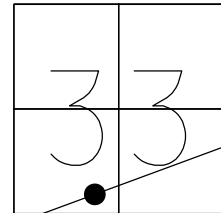

RECORD:
PRIOR REF18-US24
FD P.K./WASHER
5/28/97, BVD
SET P.K./WASHER
10-21-97, SAH

NOTE: P.C.
REF: LUC-24-0.00
PID: 25490, 83984
NEW MON BOX SET PER PID
#83894 WITH STRADDLERS, NO
IRON PIN WAS FOUND INSIDE.
ODOT STAFF SET 3/4" IRON PIN
FROM STRADDERS. SHOT W/GPS,
BUT DID NOT REFERENCE
YEAR 2017

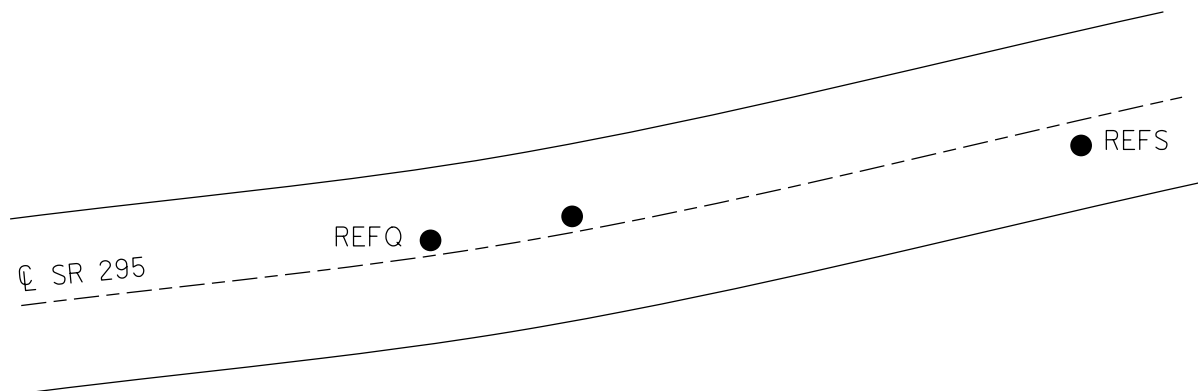

REFQ-REFR= 22.65'
REFR-REFS= 107.07' REC

O.D.O.T. DISTRICT 2 SURVEY OFFICE (USE ONLY)

PERSONNEL

REFERENCE NO. S

SHEET 19 OF 26

NOTES HUSS

DATE 5/28/97

ROUTE SR 295

H.C. VAN DUSEN

WEATHER PARTLY CLOUDY

COUNTY LUCAS

R.C. MOSER

TEMP. 61°

TOWNSHIP PROVIDENCE

SECTION 33

DWG BY MILLER PID

T 6 N R 9 E

TYPE MONUMENT P.K./WASHER

ON SURFACE - ~~BELOW~~ ON

OFFSET CL PAVEMENT 4.6' ~~±~~ : RT

7.2' TO RT EDGE PAVEMENT


STATION: ±100+49

HORIZ.DATUM: NAD83(2011)


GEOID: 2012A

GRID: NORTHING:

EASTING:

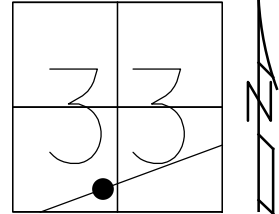

RECORD: P.I.
PRIOR REF19-US24
FD P.K./WASHER
5/28/97, BVD
SET P.K./WASHER
10-21-97, SAH

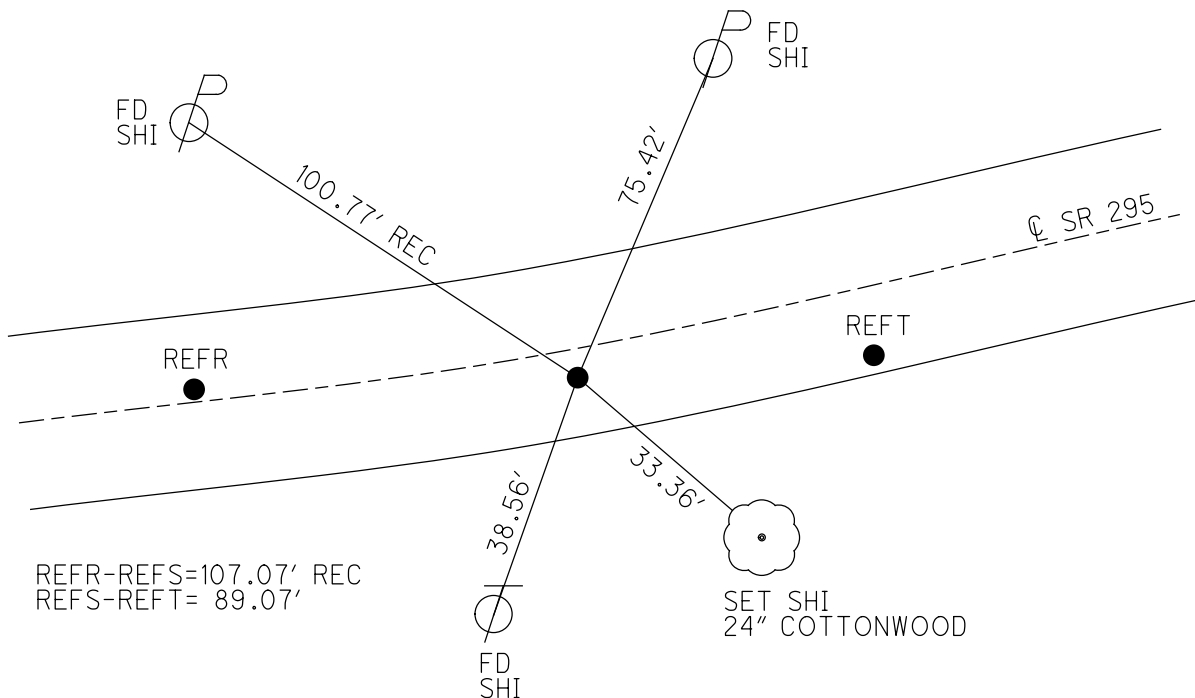

O.D.O.T. DISTRICT 2 SURVEY OFFICE (USE ONLY)

PERSONNEL

REFERENCE NO. T

SHEET 20 OF 26

NOTES HUSS

DATE 6/5/97

ROUTE SR 295

H.C. VAN DUSEN

WEATHER CLOUDY/RAIN

COUNTY LUCAS

R.C. CORDES

TEMP. 58°

TOWNSHIP PROVIDENCE

 COX

SECTION 33

DWG BY MILLER PID

T 6 N R 9 E

TYPE MONUMENT P.K. NAIL

ON SURFACE - ~~BELOW~~ ON

OFFSET CL PAVEMENT 9.4' ~~LT~~ : RT

 2.4' TO RT EDGE PAVEMENT


STATION: ±101+38

HORZ.DATUM: NAD83(2011)


GEOID: 2012A

GRID: NORTHING:

EASTING:

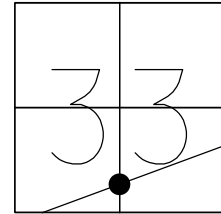

RECORD:
PRIOR REF 19A-US24
FD P.K.NAIL
6/5/97, BVD
SET P.K./WASHER
10-21-97, SAH

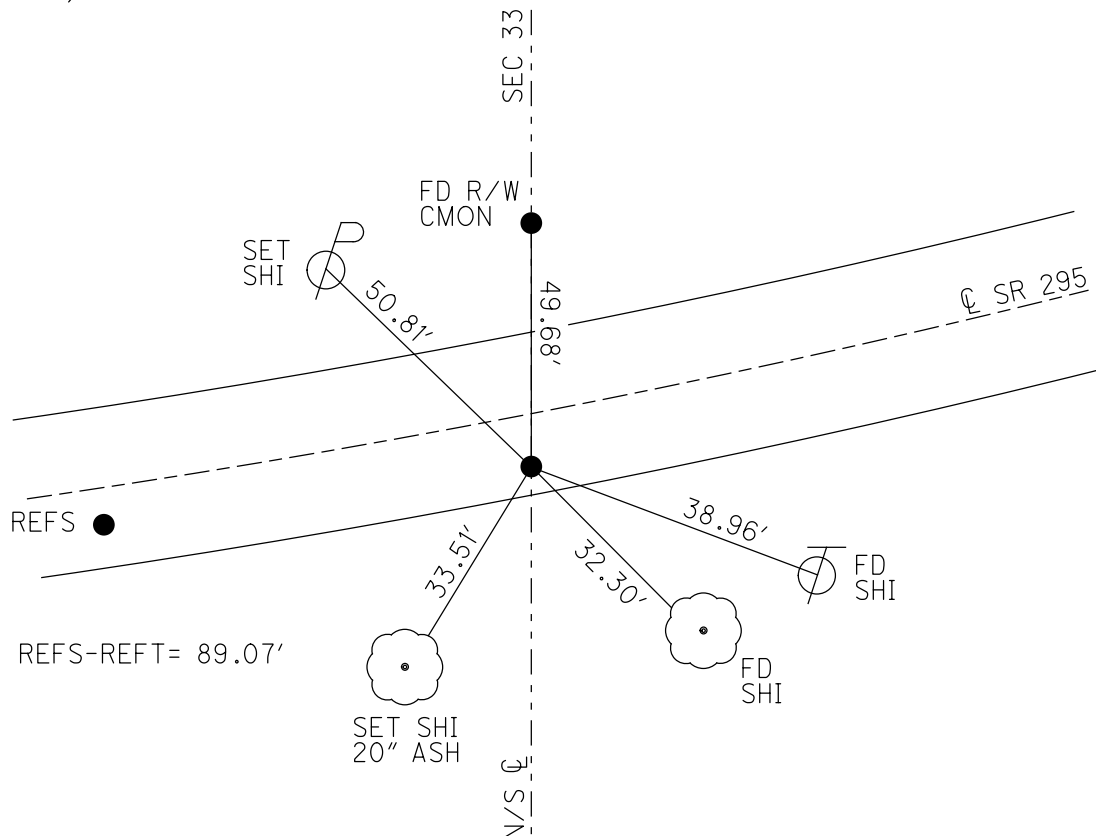

O.D.O.T. DISTRICT 2 SURVEY OFFICE (USE ONLY)

PERSONNEL

REFERENCE NO. U

SHEET 21 OF 26

NOTES LEU

DATE 8/8/17

ROUTE SR 295

H.C.

WEATHER

COUNTY LUCAS

R.C.

TEMP.

TOWNSHIP PROVIDENCE

DWG BY MILLER

PID

SECTION 33

T 6 N R 9 E

TYPE MONUMENT MONBOX W/ 3/4" IPIN

ON SURFACE - ~~BELOW~~ ON

OFFSET CL PAVEMENT ~~LT~~ : ~~RT~~

TO EDGE PAVEMENT


STATION: 101+57

HORZ.DATUM: NAD83(2011)

GEOID: 2012A


GRID: NORTHING: 645877.755

EASTING: 1602520.844

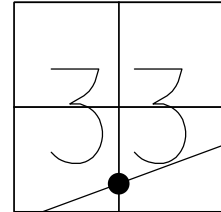

RECORD:

NOTE: P.T.
REF: LUC-24-0.00
PID: 25490, 83984
NEW MON BOX SET PER PID
#83894 WITH STRADDLERS, NO
IRON PIN WAS FOUND INSIDE.
ODOT STAFF SET 3/4" IRON PIN
FROM STRADDERS. SHOT W/GPS,
BUT DID NOT REFERENCE
YEAR 2017

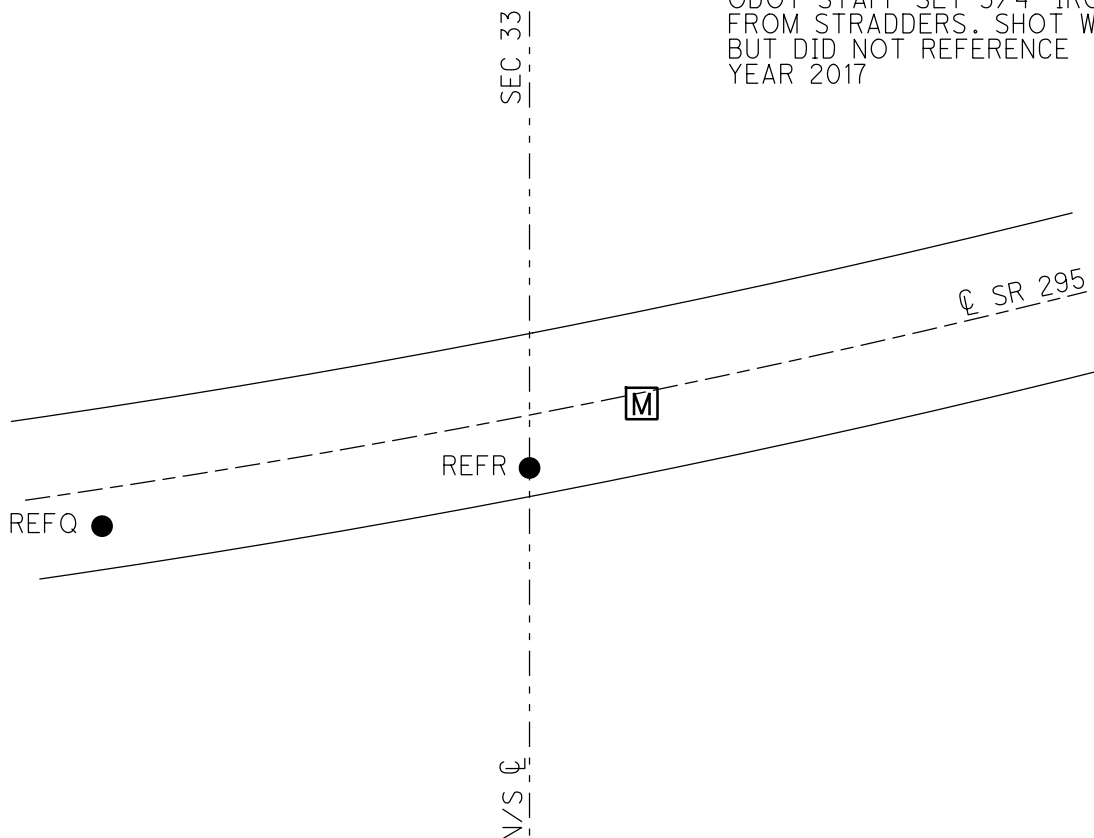

O.D.O.T. DISTRICT 2 SURVEY OFFICE (USE ONLY)

PERSONNEL

REFERENCE NO. V

SHEET 22 OF 26

NOTES HUSS

DATE 6/2/97

ROUTE SR 295

H.C. VAN DUSEN

WEATHER CLOUDY/RAIN

COUNTY LUCAS

R.C. CORDES
COX

TEMP. 58°

TOWNSHIP PROVIDENCE

DWG BY MILLER

PID 83894

SECTION 33

T 6 N R 9 E

TYPE MONUMENT P.K./WASHER

ON SURFACE - ~~BELOW~~ ON

OFFSET Q PAVEMENT ON ~~LT~~ : ~~RT~~

12.2' TO LT EDGE PAVEMENT


STATION: 120+76.2

HORIZ.DATUM: NAD83(2011)

GEOID: 2012A


GRID: NORTHING: 646644.288

EASTING: 1604280.877

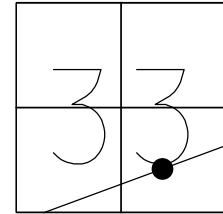

RECORD:
PRIOR REF20-US24
FD P.K./WASHER
6/2/97, BVD
FD SM R.R. SPIKE
SET P.K./WASHER
10-21-97, SAH
FD MONBOX
W/ 1" IPIN
REF17
8-8-17, JLL

NOTE:
REF: LUC-24-0.00
PID: 25490, 83984

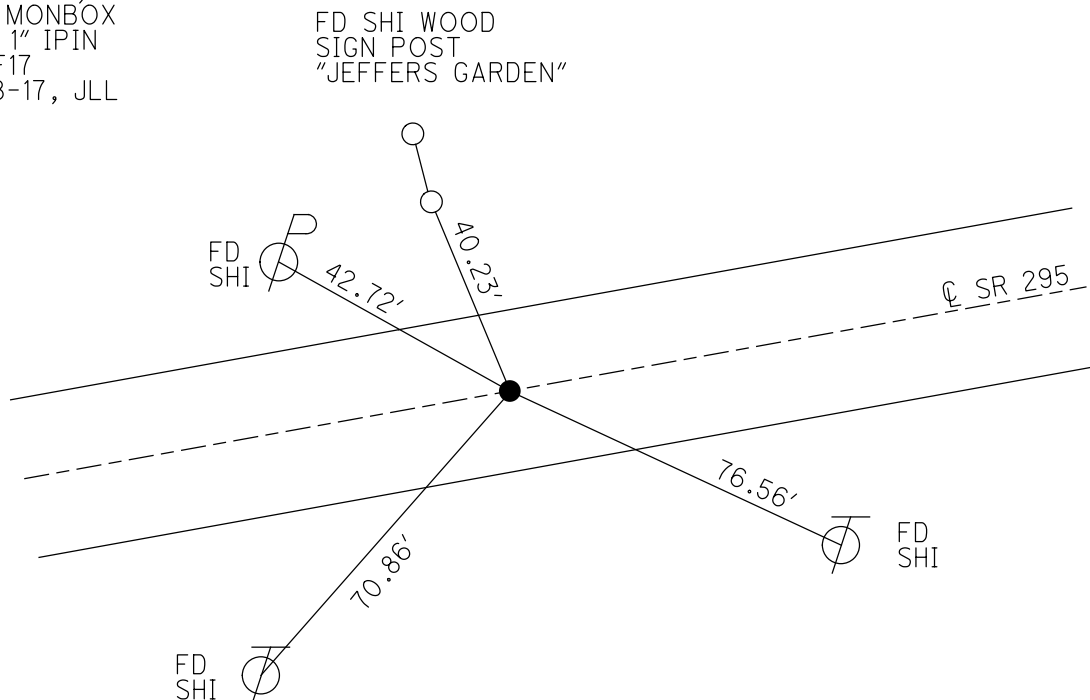

O.D.O.T. DISTRICT 2 SURVEY OFFICE (USE ONLY)

PERSONNEL

REFERENCE NO. W

SHEET 23 OF 26

NOTES LEU

DATE 8/8/17

ROUTE SR 295

H.C.

WEATHER

COUNTY LUCAS

R.C.

TEMP.

TOWNSHIP PROVIDENCE

DWG BY MILLER

PID 83894

SECTION 33

T 6 N R 9 E

TYPE MONUMENT P.K./WASHER

ON SURFACE - ~~BELOW~~ ON

OFFSET Q PAVEMENT ~~LT~~ : ~~RT~~

 TO EDGE PAVEMENT


STATION: 128+43.2

HORZ.DATUM: NAD83(2011)

GEOID: 2012A


GRID: NORTHING: 646944.052

EASTING: 1604986.577

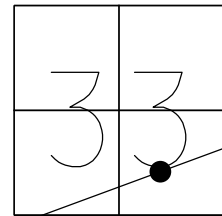

RECORD:

NOTE: P.C.
REF: LUC-24-0.00
PID: 25490, 83984
NEW MON BOX SET PER PID
#83894 WITH STRADDLERS, NO
IRON PIN WAS FOUND INSIDE.
ODOT STAFF SET 3/4" IRON PIN
FROM STRADDERS. SHOT W/GPS,
BUT DID NOT REFERENCE
YEAR 2017

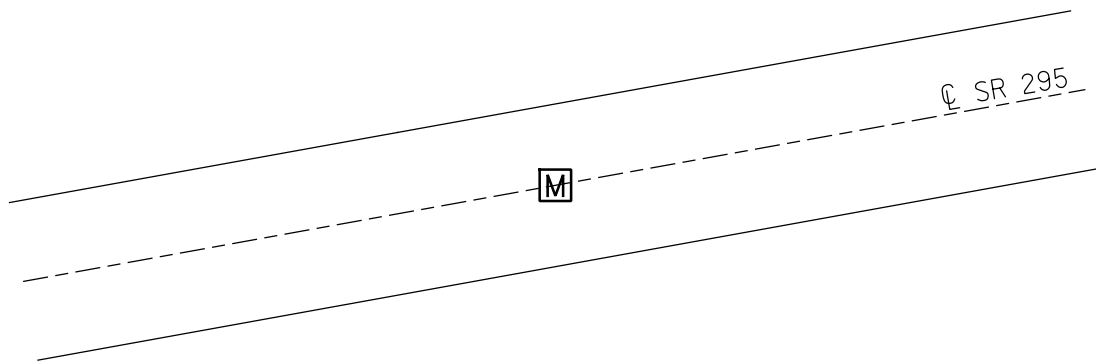

O.D.O.T. DISTRICT 2 SURVEY OFFICE (USE ONLY)

PERSONNEL

REFERENCE NO. X

SHEET 24 OF 26

NOTES HUSS
H.C. VAN DUSEN
R.C. CORDES
COX

DATE 6/2/97
WEATHER CLOUDY/RAIN
TEMP. 57°

ROUTE SR 295
COUNTY LUCAS
TOWNSHIP PROVIDENCE
SECTION 33
T 6 N R 9 E

DWG BY MILLER PID 83894

TYPE MONUMENT P.K./WASHER

ON SURFACE - ~~BELOW~~ ON

OFFSET Q PAVEMENT 5.6' ~~LT~~ : RT

6.1' TO RT EDGE PAVEMENT


STATION: 129+25

HORIZ.DATUM: NAD83(2011)

GEOID: 2012A


GRID: NORTHING: 646976.148

EASTING: 1605062.031

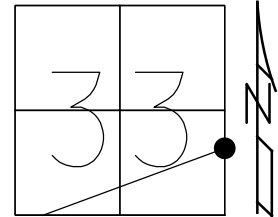


RECORD:
PRIOR REF21-US24
FD P.K.NAIL
6/2/97, BVD
SET P.K./WASHER
10-21-97, SAH
FD MONBOX
W/ 1" IPIN
REF19
8-8-17, JLL

NOTE:
REF: LUC-24-0.00
PID: 25490, 83984

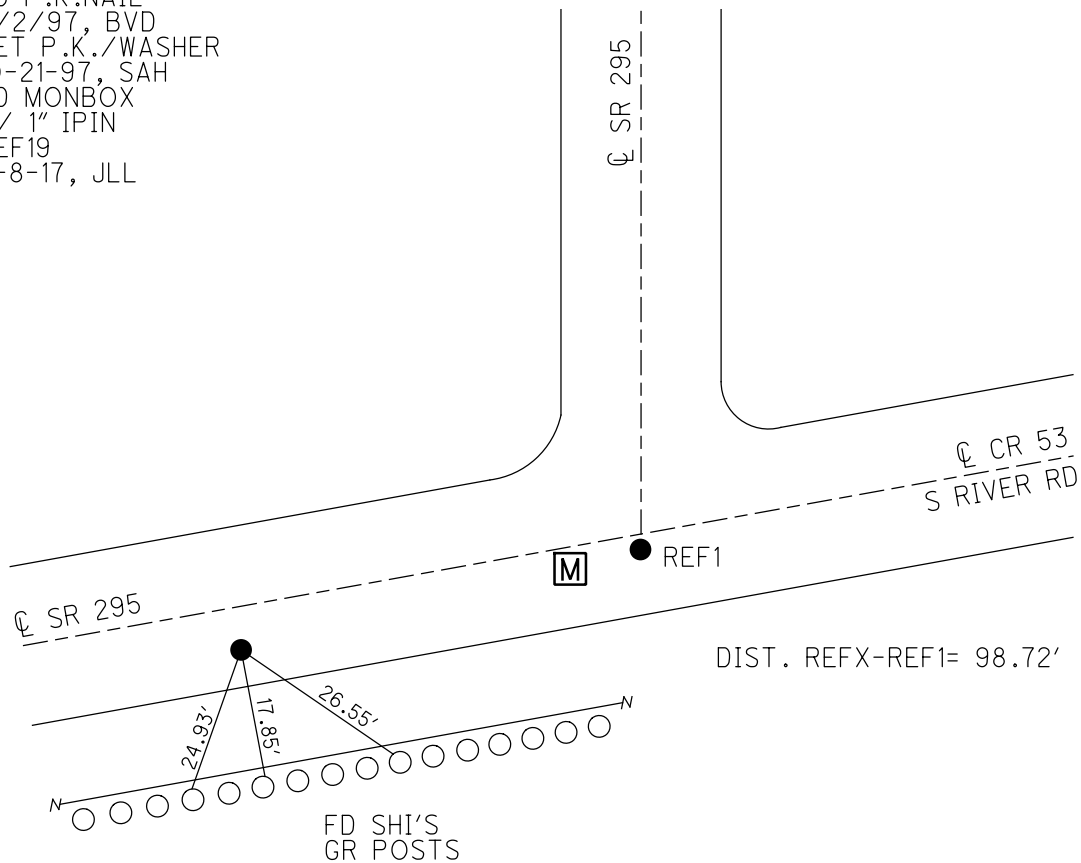


O.D.O.T. DISTRICT 2 SURVEY OFFICE (USE ONLY)

PERSONNEL _____ REFERENCE NO. Y SHEET 25 OF 26
NOTES LEU DATE 8/8/17 ROUTE SR 295
H.C. _____ WEATHER _____ COUNTY LUCAS
R.C. _____ TEMP. _____ TOWNSHIP PROVIDENCE
DWG BY MILLER PID 83894 SECTION 33
TYPE MONUMENT MON BOX W/ 3/4" IPIN T 6 N R 9 E
ON SURFACE - ~~BELOW~~ ON _____
OFFSET Q PAVEMENT _____ ~~LT~~ : ~~RT~~
_____ TO _____ EDGE PAVEMENT
STATION: 130+06.7
HORZ.DATUM: NAD83(2011) GEOID: 2012A
GRID: NORTHING: 647014.512 EASTING: 1605134.414

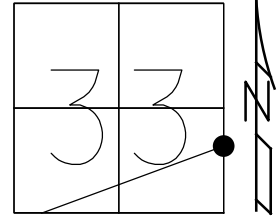

RECORD:

NOTE: P.T.
REF: LUC-24-0.00
PID: 25490, 83984
NEW MON BOX SET PER PID
#83894 WITH STRADDLERS, NO
IRON PIN WAS FOUND INSIDE.
ODOT STAFF SET 3/4" IRON PIN
FROM STRADDERS. SHOT W/GPS,
BUT DID NOT REFERENCE
YEAR 2017

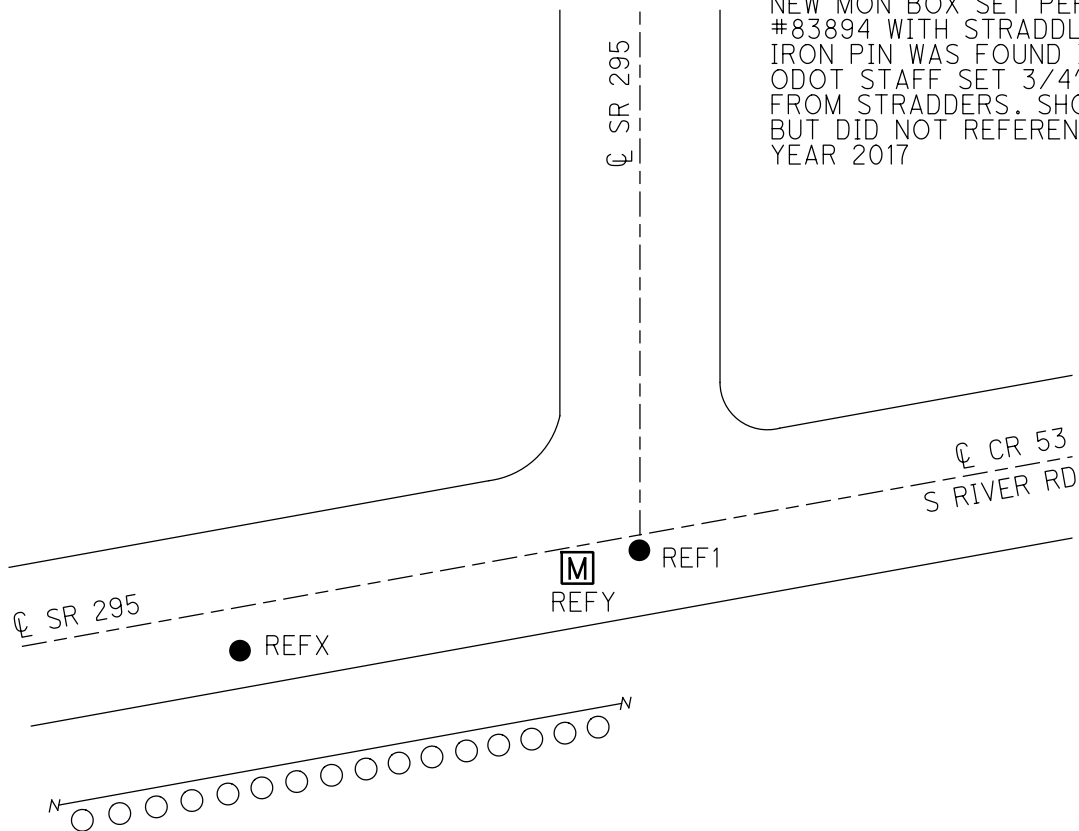

O.D.O.T. DISTRICT 2 SURVEY OFFICE (USE ONLY)

PERSONNEL

REFERENCE NO. 1

SHEET 1 OF 45

NOTES AUBLE

DATE 5/3/23

ROUTE SR 295

H.C. NIESE

WEATHER WINDY

COUNTY LUCAS

R.C. MILLER

TEMP. 53°

TOWNSHIP PROVIDENCE

DWG BY ASTON

PID CHIP SEAL

SECTION 33

T 6 N R 9 E

TYPE MONUMENT MONBOX W/ 1" IPIN

ON SURFACE - ~~BELOW~~ ON

OFFSET 2.1 ± : RT

9.7 TO RT EDGE PAVEMENT


STATION: 130+23.4

HORIZ.DATUM: NAD83(2011)

GEOID: NAVD88 2018


GRID: NORTHING: 647022.264

EASTING: 1605149.049

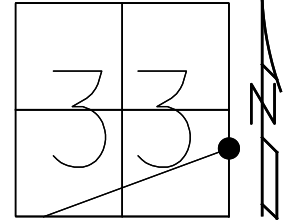

RECORD:
PRIOR REF22-US24
FD P.K./WASHER
6/2/97, BVD
SET P.K./WASHER
10-21-97, SAH
FD MONBOX
W/ 1" IPIN
REF21
8-8-17, JLL
FD MONBOX
9/29/23, JAM

LUCAS: LDP
N: 268016.212
E: 116002.928

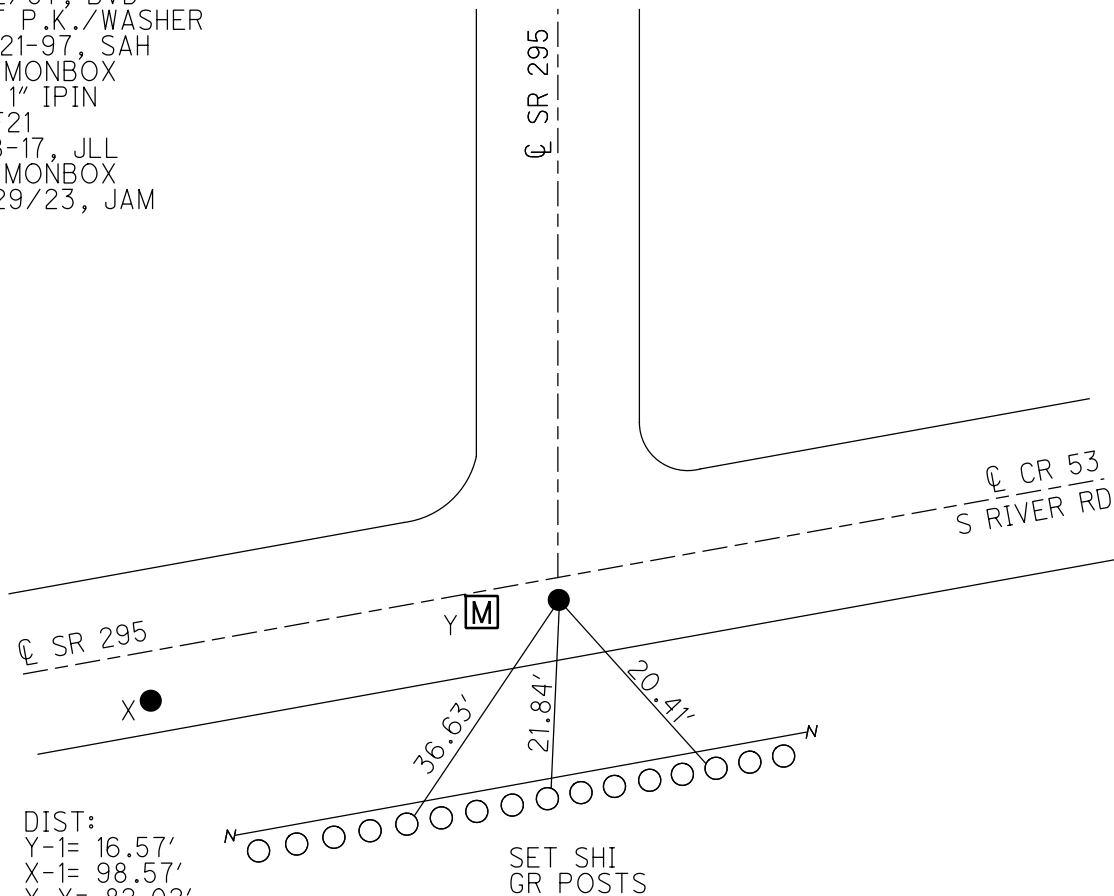

DIST:
Y-1= 16.57'
X-1= 98.57'
Y-X= 82.02'

O.D.O.T. DISTRICT 2 SURVEY OFFICE (USE ONLY)

PERSONNEL

REFERENCE NO. 2

SHEET 2 OF 45

NOTES AUBLE

DATE 5/3/23

ROUTE SR 295

H.C. NIESE

WEATHER WINDY

COUNTY LUCAS

R.C. MILLER

TEMP. 48°

TOWNSHIP PROVIDENCE

DWG BY ASTON

PID CHIP SEAL

SECTION 33

T 6 N R 9 E

TYPE MONUMENT MAG/ WASHER

ON SURFACE - ~~BELOW~~ ON

OFFSET Q PAVEMENT 4.8' LT : ~~RT~~

6.5' TO LT EDGE PAVEMENT


STATION: 138+70

HORZ.DATUM: NAD83(2011)

GEOID: NAVD88 2018

GRID: NORTHING: 647851.287


EASTING: 1605144.350

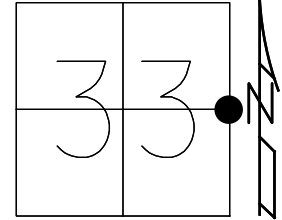

RECORD:

FD P.K./WASHER
8/28/02, DCH
SET MAG/WASHER
11/21/02, DCH
FD MAG NAIL
REF22
12/4/15, JLL
SET MAG/WASHER
7/17/17, DCH
FD MAG/ WASHER
REF2
5-3-23, TDN
9-29-23, JAM

LUCAS: LDP
N: 268845.143
E: 115987.334

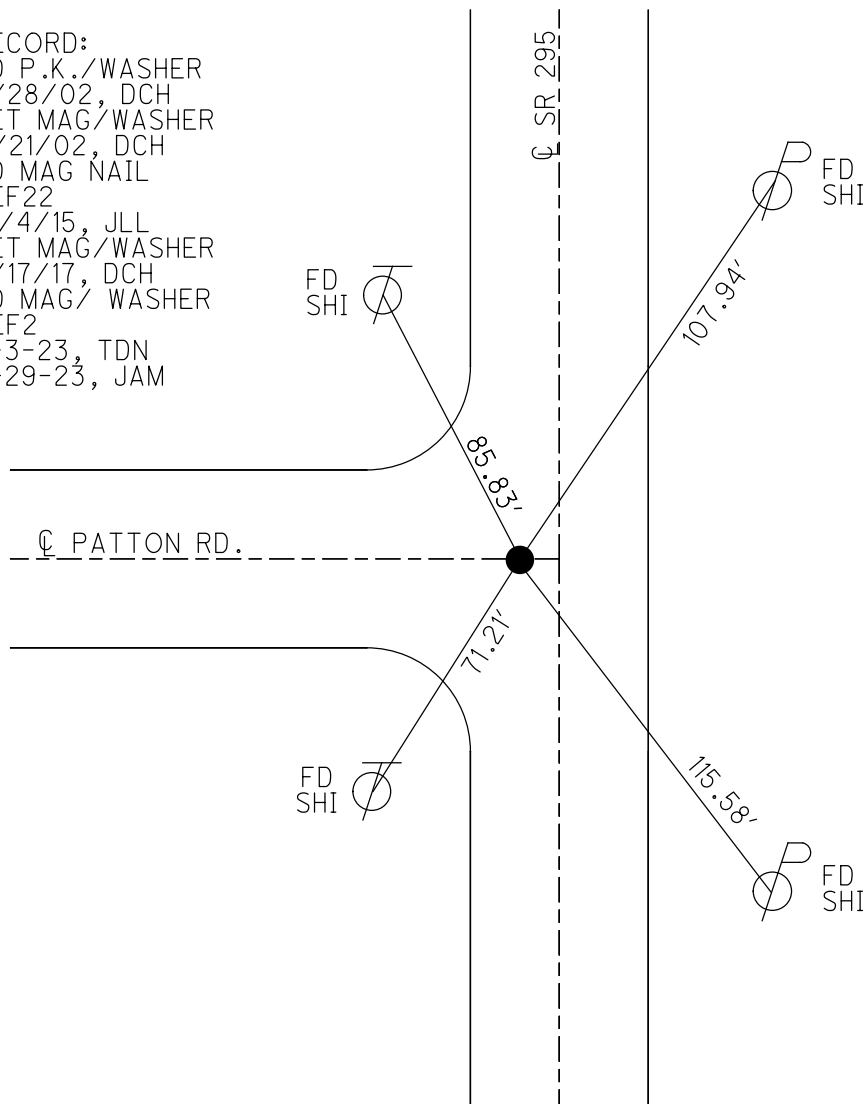

O.D.O.T. DISTRICT 2 SURVEY OFFICE (USE ONLY)

PERSONNEL

REFERENCE NO. 3

SHEET 3 OF 45

NOTES AUBLE

DATE 5-3-23

ROUTE SR 295

H.C. NIESE

WEATHER WINDY

COUNTY LUCAS

R.C. MILLER

TEMP. 53°

TOWNSHIP PROVIDENCE

SECTION 33

DWG BY ASTON

PID CHIP SEAL

T 6 N R 9 E

TYPE MONUMENT MAG/ WASHER

ON SURFACE - ~~BELOW~~ ON

OFFSET Q PAVEMENT 0.5' ~~LT~~ : RT

12' TO LT EDGE PAVEMENT


STATION: 165+11.69

HORZ.DATUM: NAD83(2011)

GEOID: NAVD88 2018


GRID: NORTHING: 650492.355

EASTING: 1605144.579

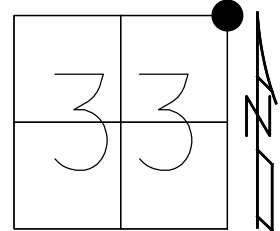

RECORD:
FD SM.R.R.SPIKE
8/28/02, DCH
SET MAG/WASHER
11/21/02, DCH
FD MAG NAIL
REF23
12/4/15, JLL
SET MAG/WASHER
7/17/17, DCH
FD MAG/ WASHER
REF3
5-3-23, TDN
FD MAG/ WASHER
2-29-23, JAM

LUCAS: LDP
N: 271486.208
E: 115952.847

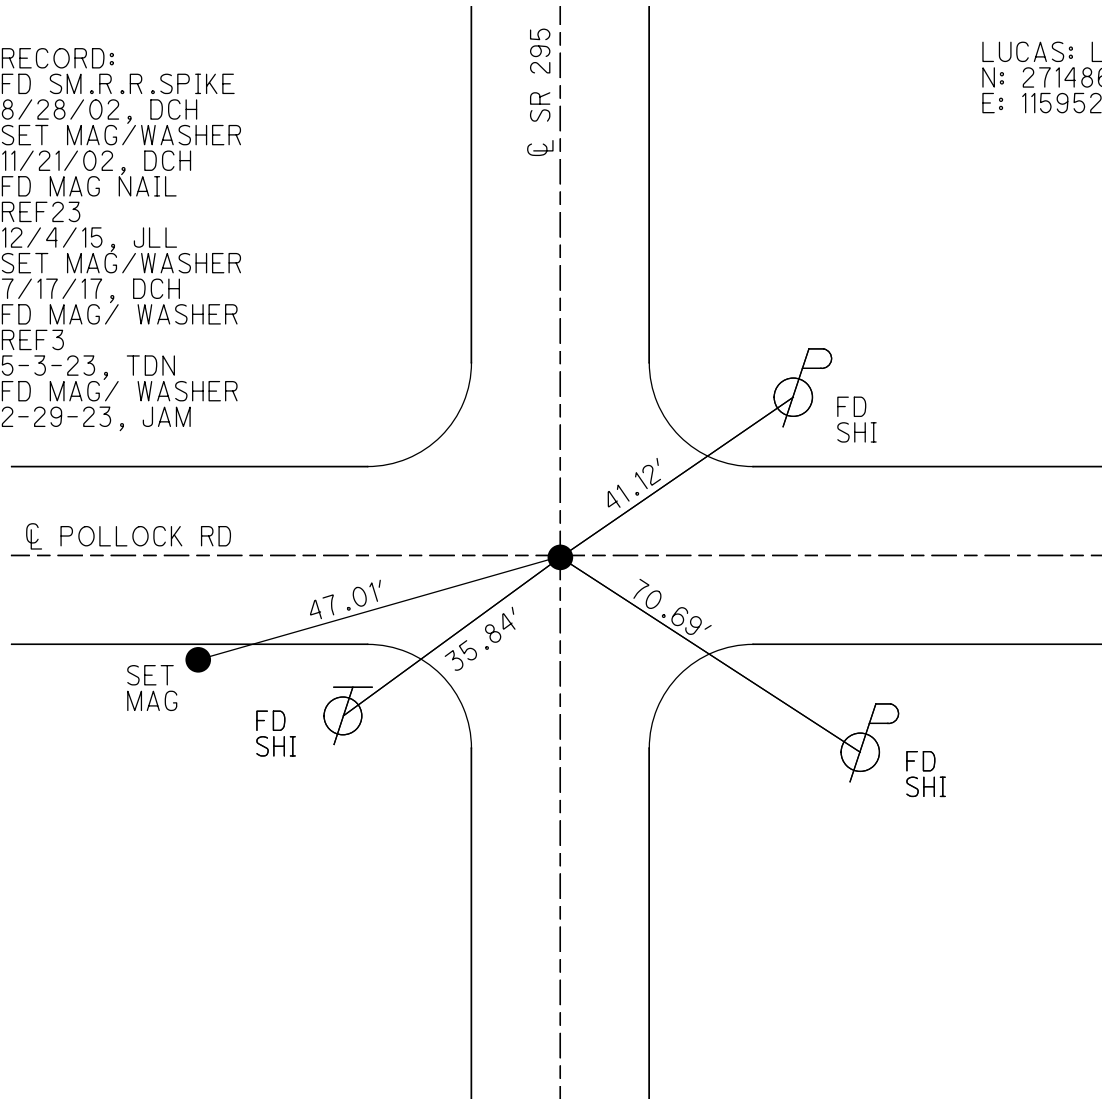

O.D.O.T. DISTRICT 2 SURVEY OFFICE (USE ONLY)

PERSONNEL

REFERENCE NO. 4

SHEET 4 OF 45

NOTES AUBLE

DATE 5-3-23

ROUTE SR 295

H.C. NIESE

WEATHER WINDY

COUNTY LUCAS

R.C. MILLER

TEMP. 53°

TOWNSHIP PROVIDENCE

DWG BY ASTON PID CHIP SEAL

SECTION 27

T 6 N R 9 E

TYPE MONUMENT MAG NAIL

ON SURFACE - ~~BELOW~~ ON

OFFSET Q PAVEMENT ON LT : RT
11' TO LT EDGE PAVEMENT


STATION: 191+61.88

HORIZ.DATUM: NAD83(2011)

GEOID: NAVD88 2018


GRID: NORTHING: 653142.529

EASTING: 1605132.872

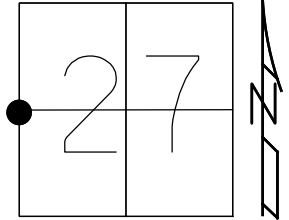

RECORD:
FD SM.R.R.SPIKE
8/29/02, DCH
SET MAG/WASHER
11/21/02, DCH
FD MAG NAIL
REF24
12/4/15, JLL
SET MAG/WASHER
7/17/17, DCH
FD MAG/WASHER
REF4
12/6/21, JFO
FD MAG/ WASHER
REF4
5-3-23, TDN
9-29-23, JAM

LUCAS: LDP
N: 274136.136
E: 115906.204

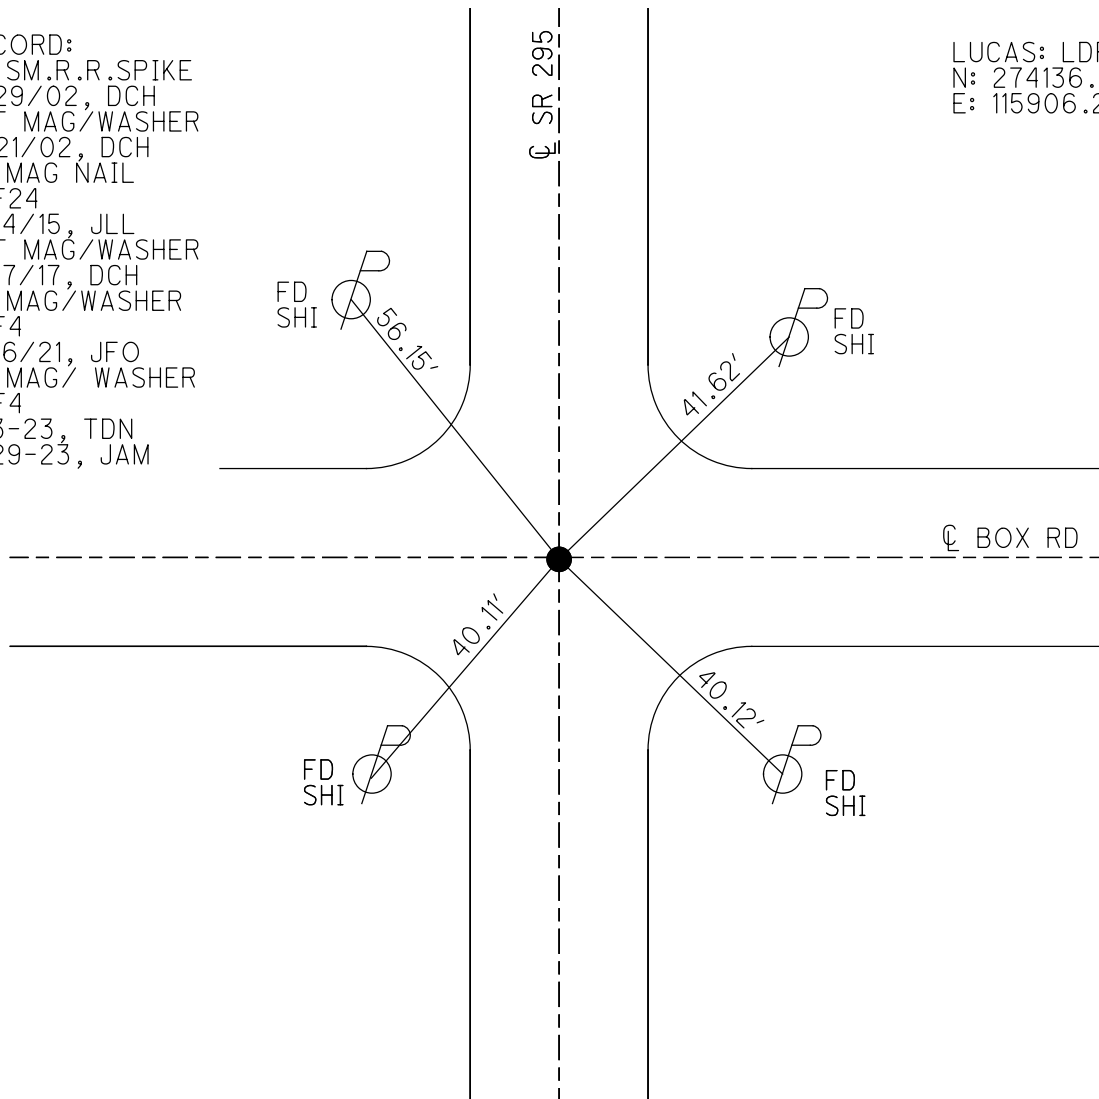

O.D.O.T. DISTRICT 2 SURVEY OFFICE (USE ONLY)

PERSONNEL

REFERENCE NO. 5

SHEET 5 OF 45

NOTES PRESTON-COLVIN

DATE 10-2-24

ROUTE SR 295

H.C.

WEATHER

COUNTY LUCAS

R.C. NEISE

TEMP.

TOWNSHIP PROVIDENCE

DWG BY PRESTON-COLVIN

PID PAVING TRAIN

SECTION 27

T 6 N R 9 E

TYPE MONUMENT MONBOX W/1" IPIN

ON SURFACE - ~~BELOW~~ ON

OFFSET 0.5' LT : ~~RT~~

11' TO LT EDGE PAVEMENT

STATION: 248+20.35

HORZ.DATUM: NAD83(2011)


GEOID: NAVD88 2018

GRID: NORTHING: 655800.979


EASTING: 1605120.783

LDP: NORTHING: 276794.354

EASTING: 115859.128

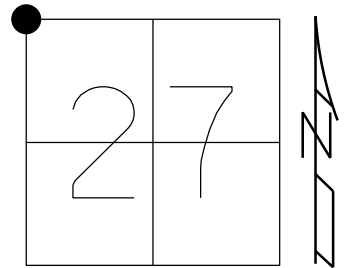

RECORD:
FD LG.R.R.SPIKE
8/29/02, DCH
SET MAG/WASHER
11/21/02, DCH
FD MONBOX
REF25
12/4/15, JLL
FD MONBOX
W/1" IPIN
REF5
12/6/21, JFO
FD MONBOX W/
1" IPIN
REF5
5-5-23, TDN
9-29-23, JAM
10-2-24, TDN

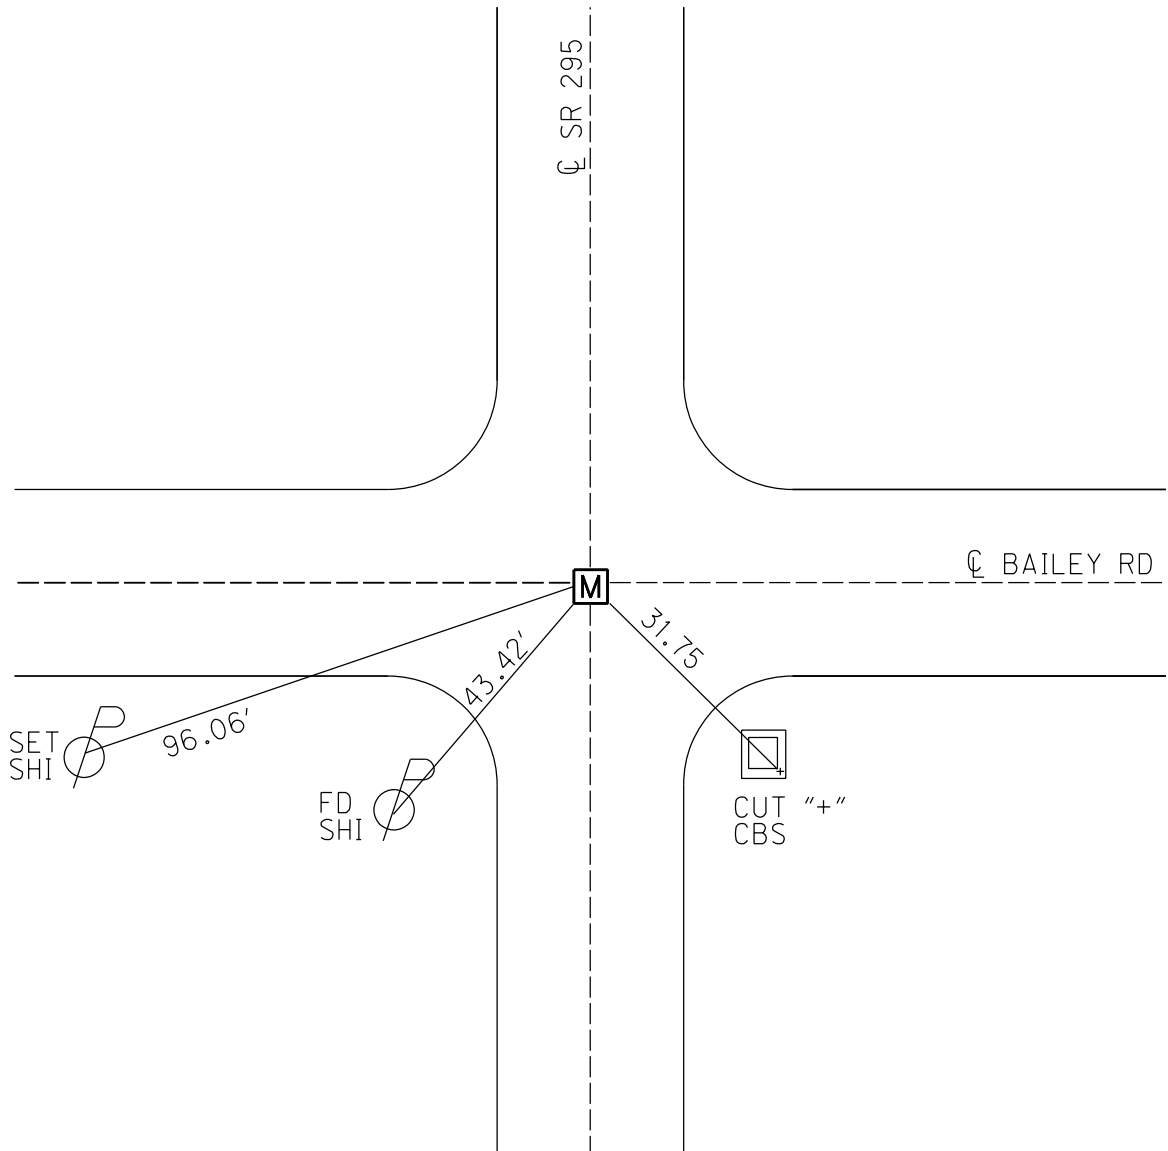

O.D.O.T. DISTRICT 2 SURVEY OFFICE (USE ONLY)

PERSONNEL

REFERENCE NO. 6

SHEET 6 OF 45

NOTES PRESTON-COLVIN

DATE 10-2-24

ROUTE SR 295

H.C. PRESTON-COLVIN

WEATHER SUNNY

COUNTY LUCAS

R.C. NEISE

TEMP. 70°

TOWNSHIP PROVIDENCE

DWG BY PRESTON-COLVIN

PID PAVING TRAIN

SECTION 22

T 6 N R 9 E

TYPE MONUMENT MAG/WASHER

ON SURFACE - ~~BELOW~~ ON

OFFSET ¢ PAVEMENT 2" ~~LT~~ : RT

9.5' TO RT EDGE PAVEMENT

STATION: 244+15.38

HORZ.DATUM: NAD83(2011)


GEOID: NAVD88 2018

GRID: NORTHING: 658395.963


EASTING: 1605118.134

LDP: NORTHING: 279389.260

EASTING: 115822.329

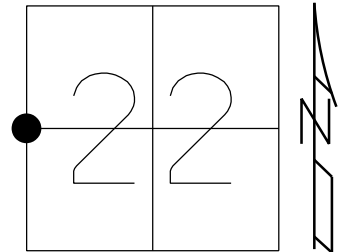

RECORD:
FD 3/4" IPIN
11/2/84
FD P.K.NAIL
8/29/02, DCH
SET MAG/WASHER
11/25/02, DCH
FD MAG ANIL
REF26
12/4/15, JLL
SET MAG/WASHER
7/17/17, DCH
FD MAG/WASHER
REF6
12/6/21, JFO
FD MAG/W
REF6
5-3-23, TDN
9-29-23, JAM
FD MAG/W
6/17/24, JAM
10/2/24, TDN

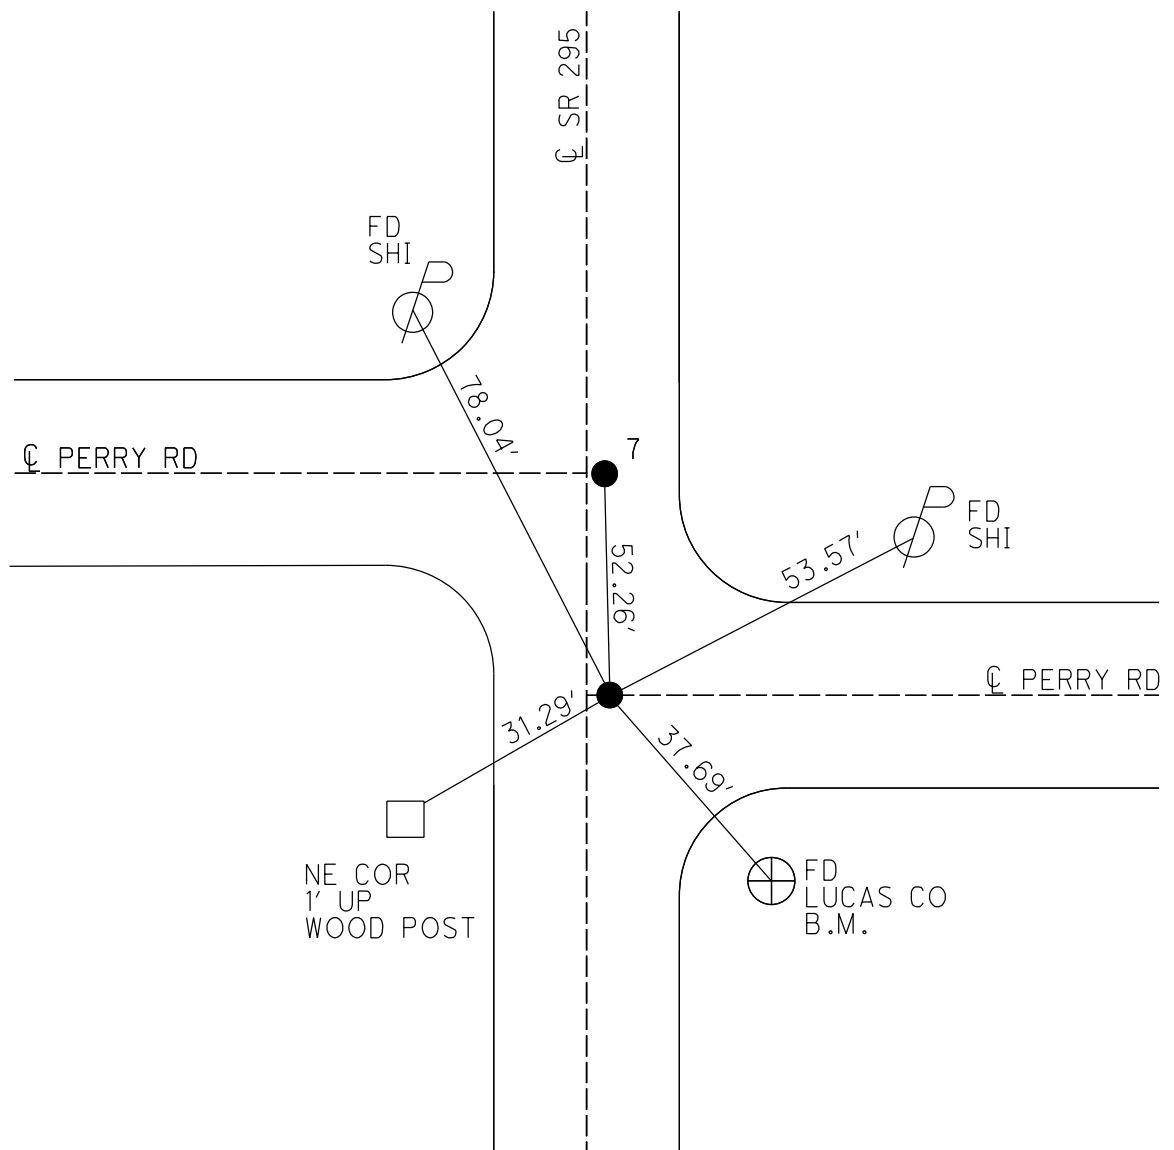

O.D.O.T. DISTRICT 2 SURVEY OFFICE (USE ONLY)

PERSONNEL

REFERENCE NO. 7

SHEET 7 OF 45

NOTES PRESTON-COLVIN

DATE 10-2-24

ROUTE SR 295

H.C. PRESTON-COLVIN

WEATHER SUNNY

COUNTY LUCAS

R.C. NEISE

TEMP. 70°

TOWNSHIP PROVIDENCE

DWG BY PRESTON-COLVIN

PID PAVING TRAIN

SECTION 22

T 6 N R 9 E

TYPE MONUMENT MAG/WASHER

ON SURFACE - ~~BELOW~~ ON

OFFSET $\angle$ PAVEMENT 1.5" ~~LT~~ : RT

9.5' TO RT EDGE PAVEMENT

STATION: 244+67.65

HORIZ.DATUM: NAD83(2011)


GEOID: NAVD88 2018

GRID: NORTHING: 658448.237


EASTING: 1605118.492

LDP: NORTHING: 279441.552

EASTING: 115822.002

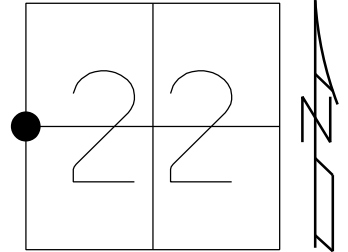

RECORD:
FD 3/4" IPIN
11/2/84
8/29/02, DCH
SET MAG/WASHER
11/25/02, DCH
FD MAG NAIL
REF27
12/4/15, JLL
SET MAG/WASHER
7/17/17, DCH
FD MAG/WASHER
REF7
12/6/21, JFO
FD MAG/WASHER
REF7
5-3-23, TDN
9-29-23, JAM
FD MAG/W
6/17/24, JAM
10/2/24, TDN

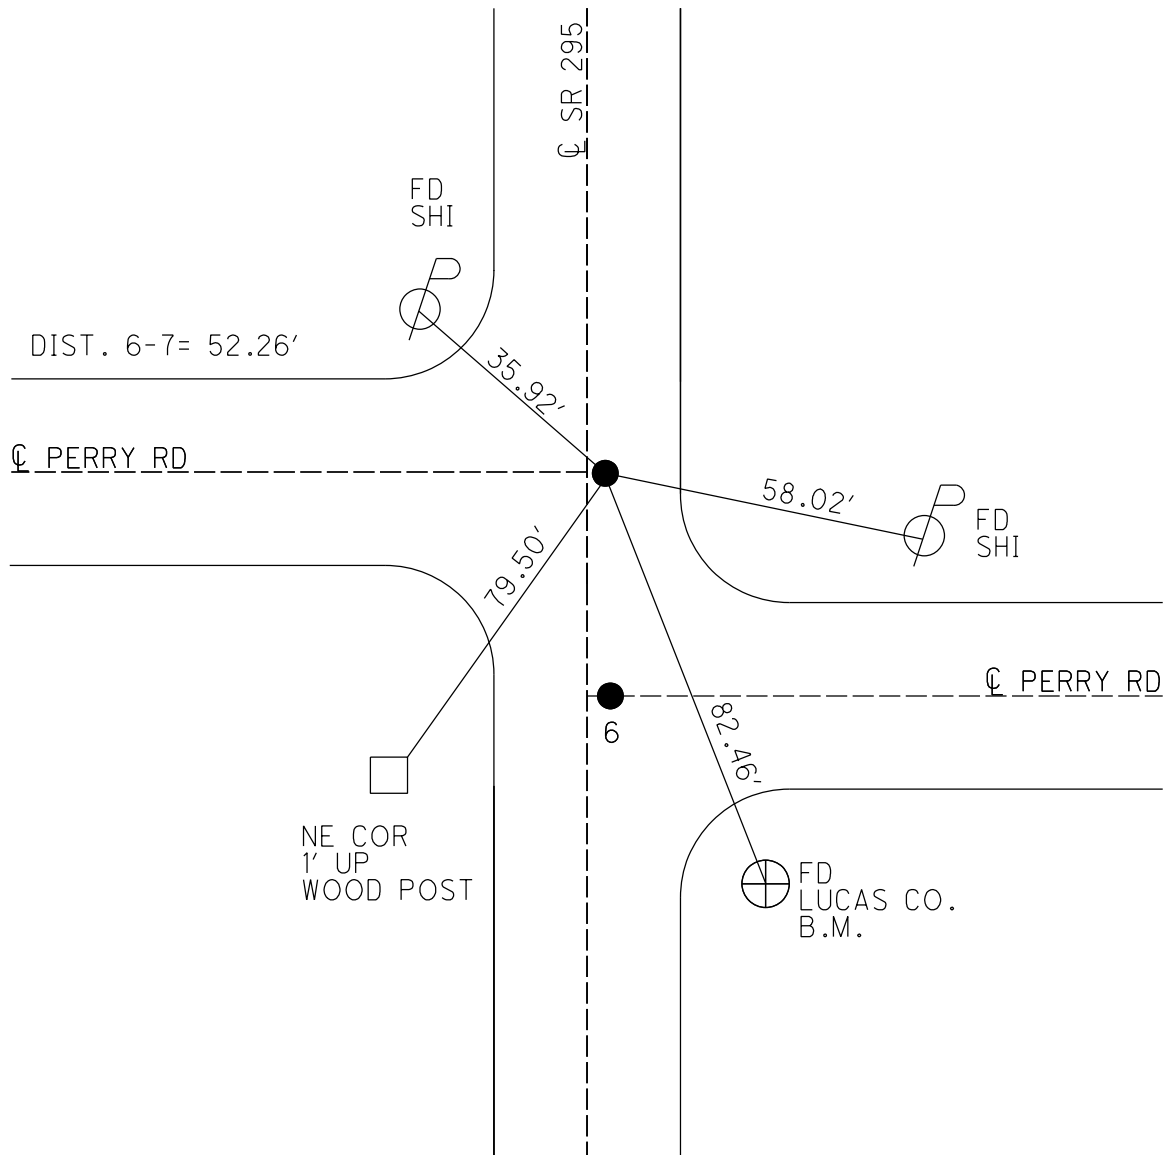

O.D.O.T. DISTRICT 2 SURVEY OFFICE (USE ONLY)

PERSONNEL

REFERENCE NO. 8

SHEET 8 OF 45

NOTES PRESTON-COLVIN

DATE 10-2-24

ROUTE SR 295

H.C. PRESTON-COLVIN

WEATHER SUNNY

COUNTY LUCAS

R.C. NEISE

TEMP. 70°

TOWNSHIP PROVIDENCE

DWG BY PRESTON-COLVIN PID PAVING TRAIN

SECTION 22

T 6 N R 9 E

TYPE MONUMENT MAG/WASHER

ON SURFACE - ~~BELOW~~ ON

OFFSET Q PAVEMENT 5' LT : ~~RT~~

6' TO LT EDGE PAVEMENT

STATION: 271+22.15

HORIZ.DATUM: NAD83(2011)


GEOID: NAVD88 2018

GRID: NORTHING: 661102.719


EASTING: 1605103.667

LDP: NORTHING: 282095.730

EASTING: 115772.207

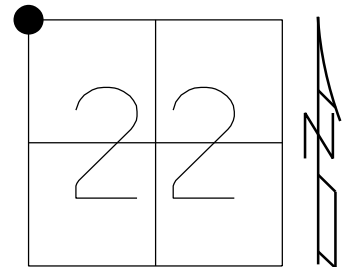

RECORD:
 FD STONE
 SET P.K.NAIL
 1/13/97, KAUFMAN
 FD P.K.NAIL
 8/29/02, DCH
 SET MAG/WASHER
 11/25/02, DCH
 FD DRILLHOLE
 IN CONCRETE
 REF28
 12/4/15, JLL
 SET MAG/WASHER
 7/17/17, DCH
 FD MAG/WASHER
 REF8
 5-3-23, TDN
 9-29-23, JAM
 FD MAG/W
 6/17/24, JAB
 10/2/24, TDN

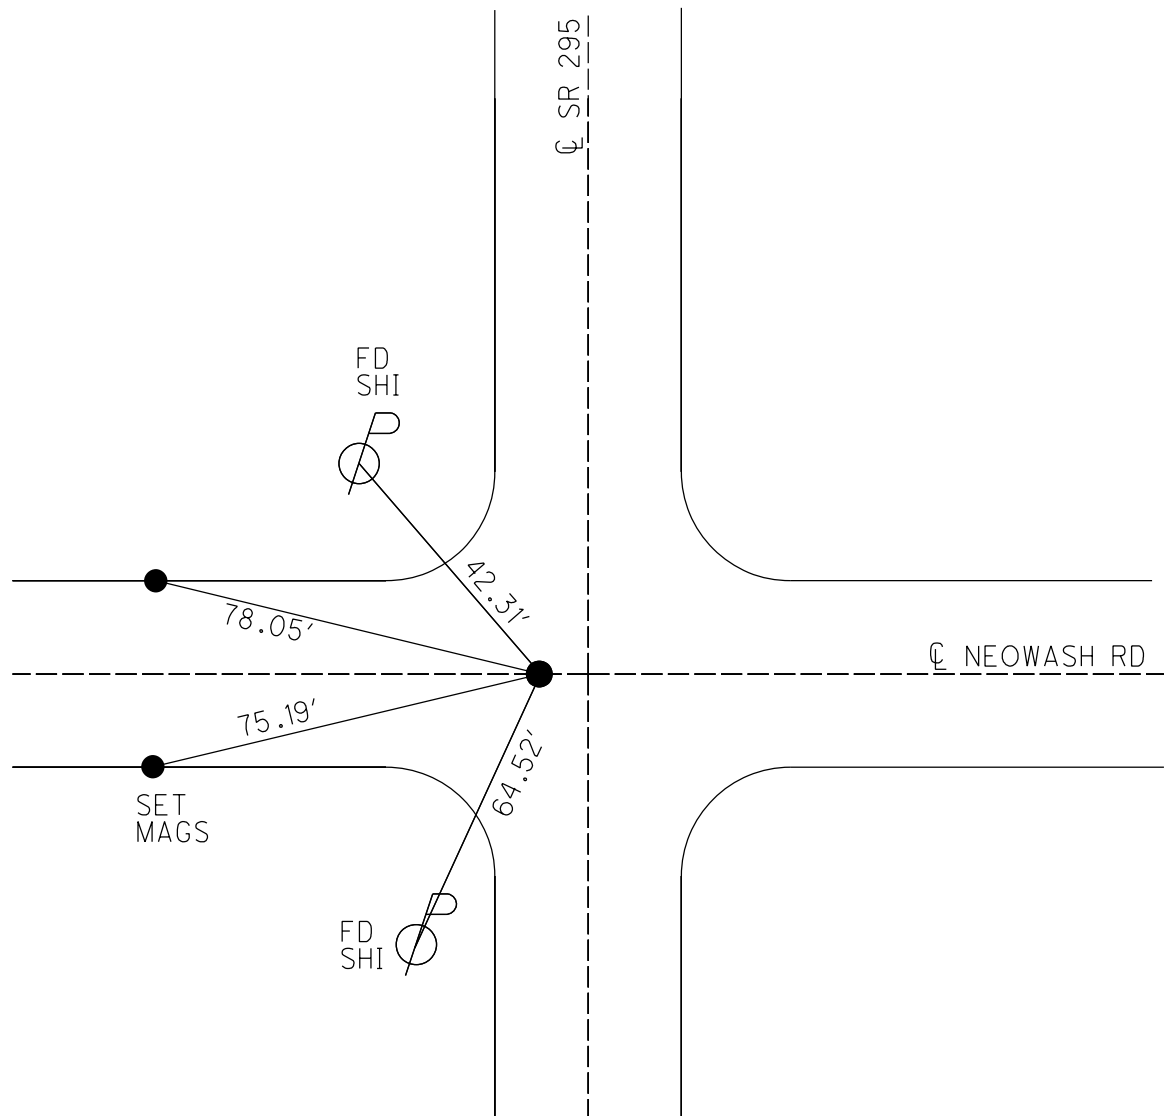

O.D.O.T. DISTRICT 2 SURVEY OFFICE (USE ONLY)

PERSONNEL

REFERENCE NO. 9

SHEET 9 OF 45

NOTES PRESTON-COLVIN

DATE 10-2-24

ROUTE SR 295

H.C. PRESTON-COLVIN

WEATHER SUNNY

COUNTY LUCAS

R.C. NEISE

TEMP. 70°

TOWNSHIP PROVIDENCE

DWG BY PRESTON-COLVIN

PID PAVING TRAIN

SECTION 15

T 6 N R 9 E

TYPE MONUMENT MAG/WASHER

ON SURFACE - ~~BELOW~~ ON

OFFSET CL PAVEMENT 4.5' LT : ~~RT~~

6' TO LT EDGE PAVEMENT

STATION: 295+75.45

HORIZ.DATUM: NAD83(2011)


GEOID: NAVD88 2018

GRID: NORTHING: 663755.994


EASTING: 1605092.744

LDP: NORTHING: 284748.936

EASTING: 115726.419

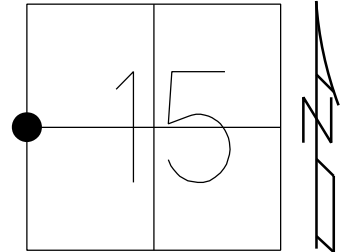

RECORD:
FD P.K.NAIL
8/29/02, DCH
SET MAG/WASHER
11/25/02, DCH
FD MAG NAIL
REF29
12/4/15, JLL
SET MAG/WASHER
7/17/17, DCH
FD MAG/WASHER
REF9
5-3-23, TDN
9-29-23, JAM
FD MAG/WASHER
6/17/24, JAB
10/2/24, TDN

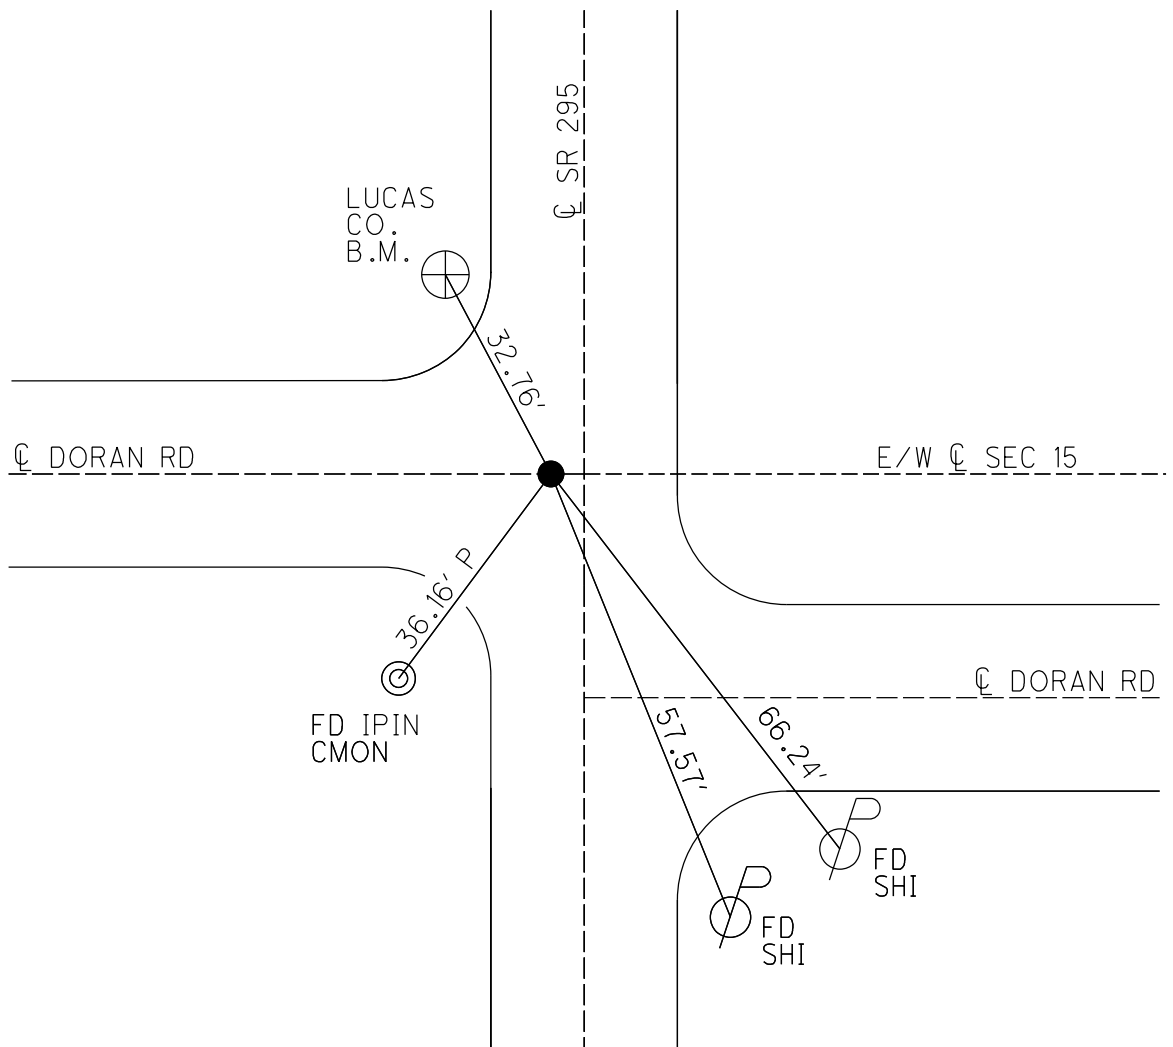

O.D.O.T. DISTRICT 2 SURVEY OFFICE (USE ONLY)

PERSONNEL

REFERENCE NO. 10

SHEET 10 OF 45

NOTES PRESTON-COLVIN

DATE 10-2-24

ROUTE SR 295

H.C. PRESTON-COLVIN

WEATHER SUNNY

COUNTY LUCAS

R.C. NEISE

TEMP. 70°

TOWNSHIP PROVIDENCE

DWG BY PRESTON-COLVIN PID PAVING TRAIN

SECTION 15

T 6 N R 9 E

TYPE MONUMENT MAG/WASHER

ON SURFACE - ~~BELOW~~ ON

OFFSET Q PAVEMENT 5' LT : ~~RT~~

TO EDGE PAVEMENT

STATION: 297+75.45

HORZ.DATUM: NAD83(2011)


GEOID: NAVD88 2018

GRID: NORTHING: 666412.988


EASTING: 1605084.271

LDP: NORTHING: 287405.655

EASTING: 115682.910

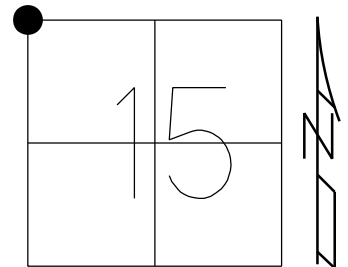

RECORD:
FD P.K.NAIL
8/29/02, DCH
SET MAG/WASHER
11/21/02, DCH
FD MAG NAIL
REF23
12/4/15, JLL
SET MAG/WASHER
7/17/17, DCH
FD MAG/WASHER
RE10
5-3-23, TDN
9-29-23, JAM
FD MAG/WASHER
6/17/24, JAB
10/2/24, TDN

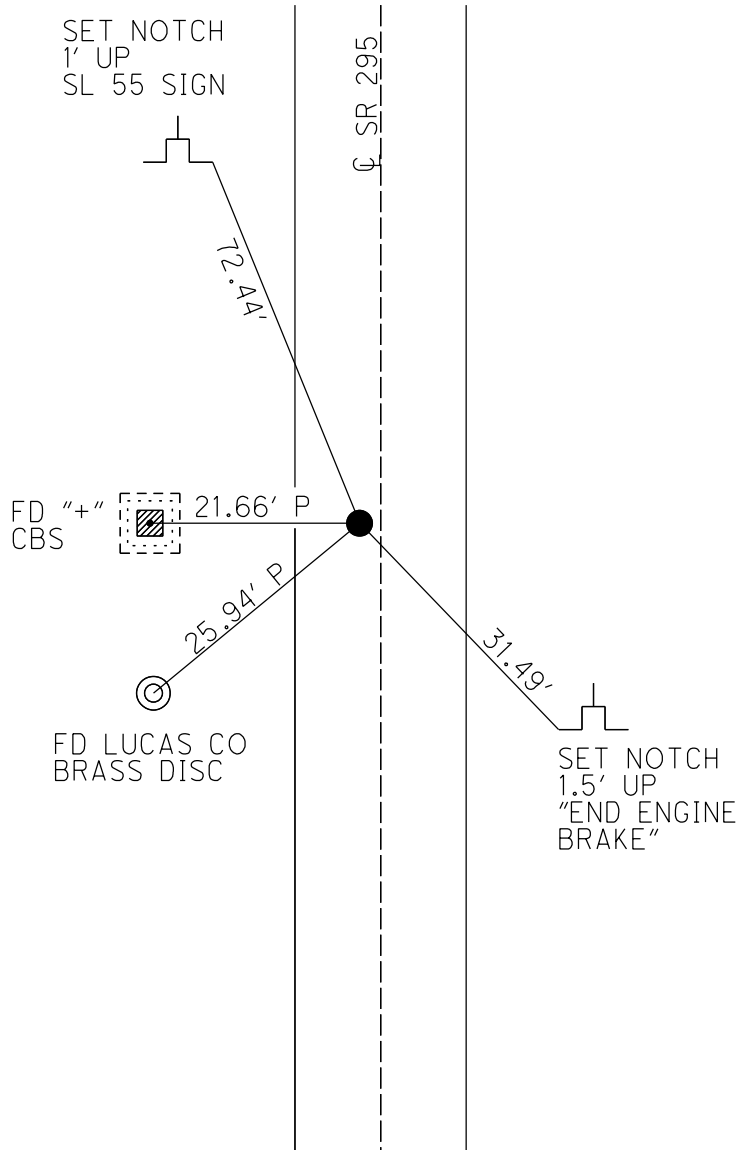

O.D.O.T. DISTRICT 2 SURVEY OFFICE (USE ONLY)

PERSONNEL

REFERENCE NO. 11

SHEET 11 OF 45

NOTES AUBLE

DATE 5-3-23

ROUTE SR 295

H.C. NIESE

WEATHER WINDY

COUNTY LUCAS

R.C. MILLER

TEMP. 48°

TOWNSHIP PROVIDENCE

SECTION 10

DWG BY ASTON

PID CHIP SEAL

T 6 N R 9 E

TYPE MONUMENT CMON W/DISK

ON SURFACE - ~~BELOW~~ ON

OFFSET ℄ PAVEMENT LT : RT

 TO EDGE PAVEMENT


STATION: 350+83.15

HORZ.DATUM: NAD83(2011)

GEOID: NAVD88 2018

GRID: NORTHING: 669063.601

EASTING: 1605064.415

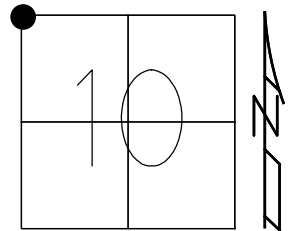

RECORD:
FD MONBOX
LID MISSING,
BOX FILLED
W/ASPHALT
8/29/02, DCH
FD MONBOX COVERED
AFTER RESURFACING
11/25/02, DCH
FD MONBOX
W/1" IPIN
REF31
12/4/15, JLL
FD CMON W/DISK
REF11
5-3-23, TDN
9-29-23, JAM

LUCAS: LDP
N: 290055.928
E: 115628.102

℄ CR 295

℄ NEAPOLIS-WATERVILLE RD.

[M]

O.D.O.T. DISTRICT 2 SURVEY OFFICE (USE ONLY)

PERSONNEL	REFERENCE NO. <u>12</u>	SHEET <u>12</u> OF <u>45</u>
NOTES	DATE <u>3/22/17</u>	ROUTE <u>SR 295</u>
H.C. <u>HOMAN</u>	WEATHER <u>SUNNY</u>	COUNTY <u>LUCAS</u>
R.C. <u>HELDMAN</u>	TEMP. <u>22°</u>	TOWNSHIP <u>WATERVILLE</u>
		SECTION <u>10</u>
		T <u>6</u> N R <u>9</u> E

TYPE MONUMENT MAG NAIL


~~ON SURFACE~~ - BELOW ON

LEFT - Q PAV'T - ~~RIGHT~~ 3'


8.5' TO LT EDGE PAVEMENT

S.L.M. 377+37.93

GRID: NORTHING: 671.718.339 EASTING: 1605049.399

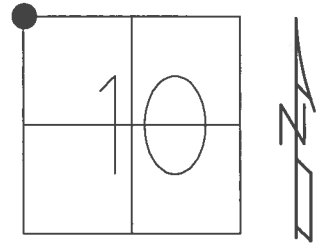

RECORD:
 FD P.K.NAIL
 8/29/02, DCH
 SET MAG/WASHER
 11/21/02, DCH
 FD MAG NAIL
 REF32
 12/4/15, JLL
 SET MAG/WASHER
 7/17/17, DCH

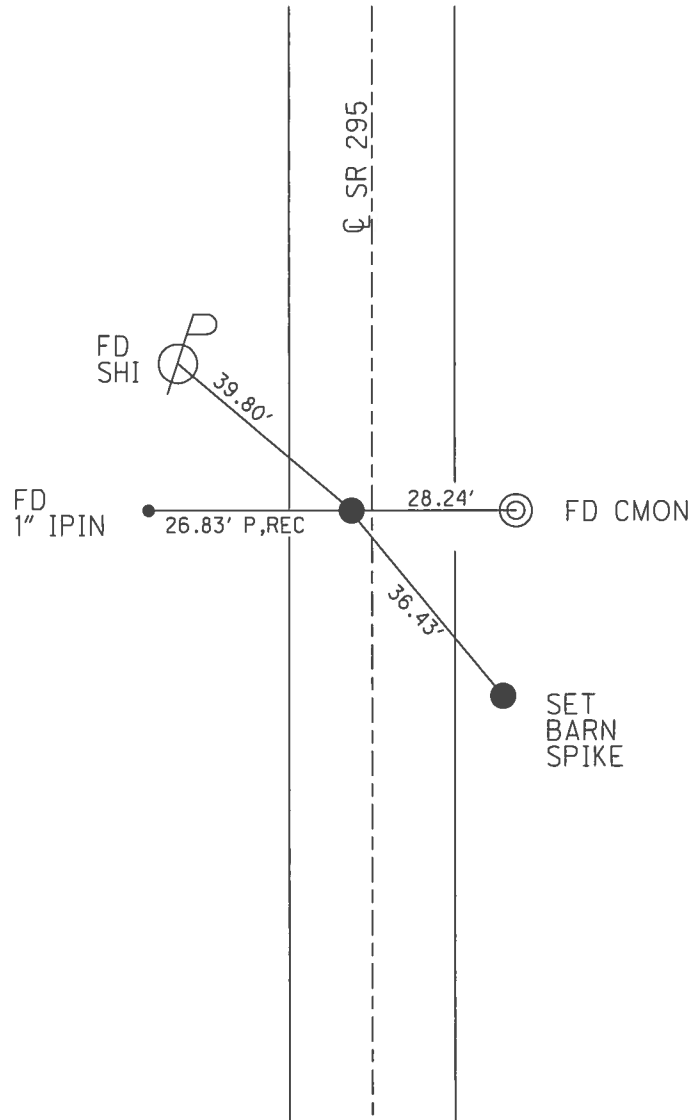

O.D.O.T. DISTRICT 2 SURVEY OFFICE (USE ONLY)

PERSONNEL

REFERENCE NO.

12 A

SHEET

13

OF

45

NOTES

HOMAN

DATE

3/22/17

ROUTE

SR 295

H.C.

HOMAN

WEATHER

SUNNY

COUNTY

LUCAS

R.C.

HELDMAN

TEMP.

23°

TOWNSHIP

WATERVILLE

SECTION

3

T 6 N

R 9 E

TYPE MONUMENT

MAG NAIL

ON SURFACE - ~~BELOW~~

ON

LEFT - ℄ PAV'T - ~~RIGHT~~

1'

10.5'

TO LT


EDGE PAVEMENT

S.L.M.

388+63.54

GRID: NORTHING:

EASTING:

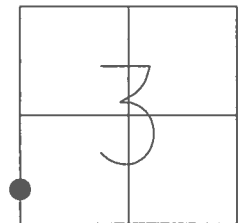


RECORD:

FD MAG NAIL

SET MAG/WASHER


7/17/17, DCH

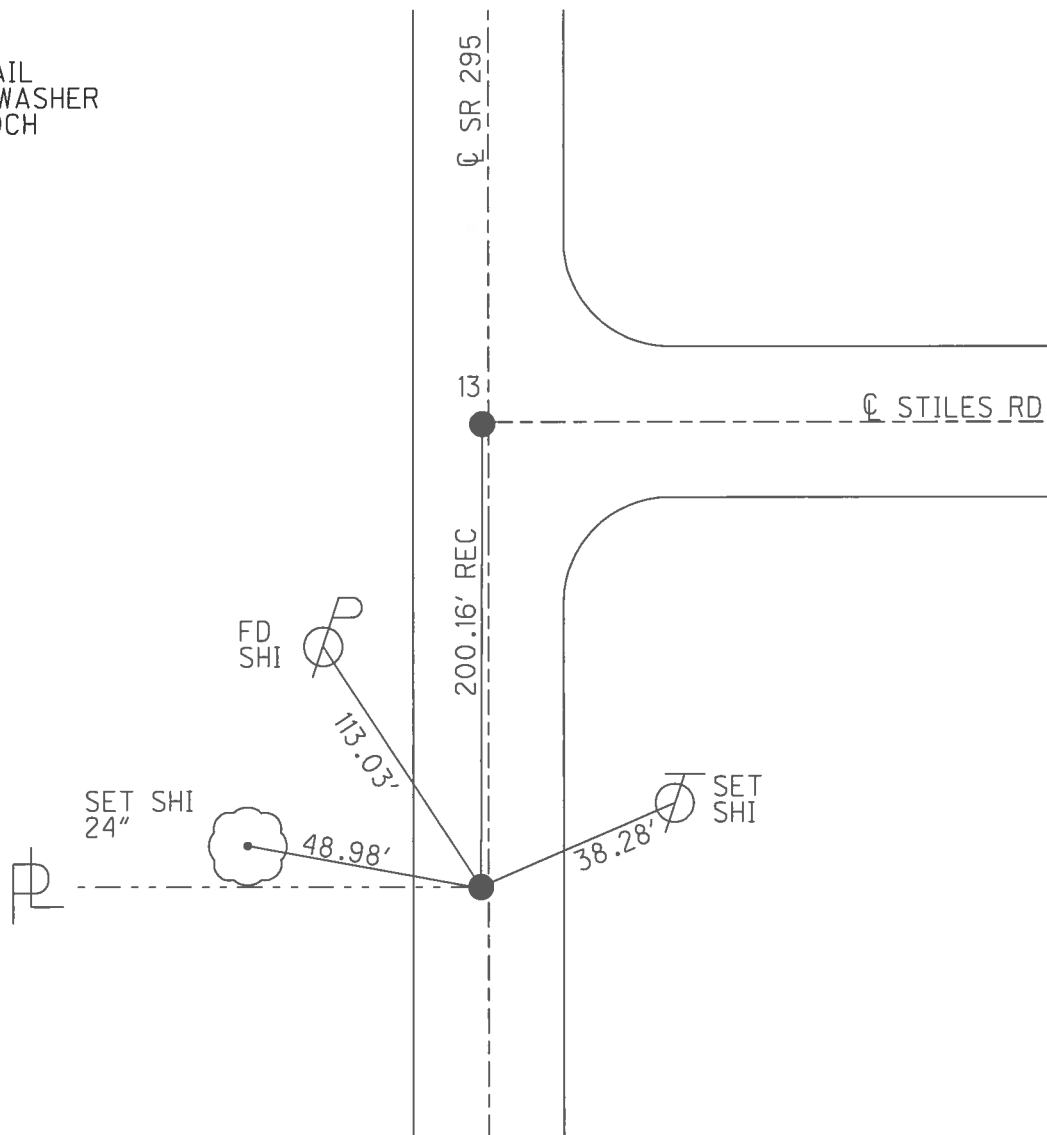

O.D.O.T. DISTRICT 2 SURVEY OFFICE (USE ONLY)


PERSONNEL	REFERENCE NO. <u>13</u>	SHEET <u>14</u> OF <u>45</u>
NOTES	DATE <u>3/22/17</u>	ROUTE <u>SR 295</u>
H.C. <u>HOMAN</u>	WEATHER <u>SUNNY</u>	COUNTY <u>LUCAS</u>
R.C. <u>HELDMAN</u>	TEMP. <u>23°</u>	TOWNSHIP <u>WATERVILLE</u>
		SECTION <u>3</u>
		T <u>6</u> N R <u>9</u> E

TYPE MONUMENT MAG NAIL
 ON SURFACE - ~~BELOW~~ ON
 LEFT - CL PAV'T - ~~RIGHT~~ 1'
10.5' TO LT EDGE PAVEMENT
 S.L.M. 390+63.7

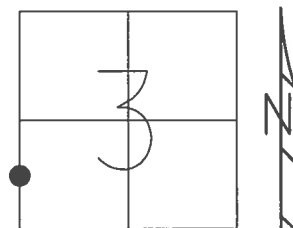

GRID: NORTHING: 673044.081 EASTING: 1605040.143

RECORD:
 FD P.K. NAIL
 9/3/02, DCH
 SET MAG/WASHER
 11/21/02, DCH
 FD MAG NAIL
 REF33
 12/4/15, JLL
 SET MAG/WASHER
 7/17/17, DCH

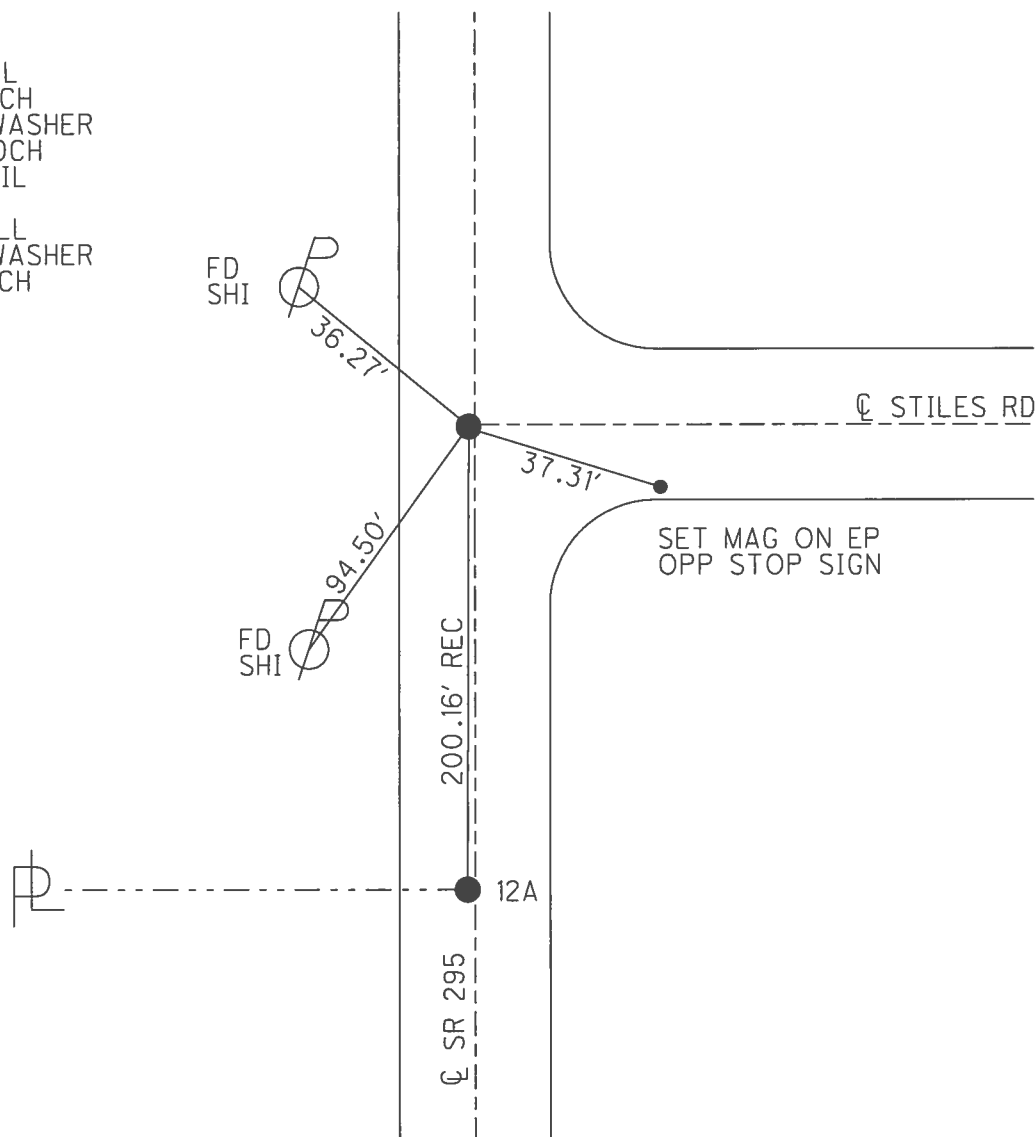


O.D.O.T. DISTRICT 2 SURVEY OFFICE (USE ONLY)


PERSONNEL	REFERENCE NO. <u>14</u>	SHEET <u>15</u> OF <u>45</u>
NOTES <u>BARRIERE</u>	DATE <u>6/10/24</u>	ROUTE <u>SR 295</u>
H.C. <u>MILLER</u>	WEATHER <u>CLOUDY</u>	COUNTY <u>LUCAS</u>
R.C. <u>BARRIERE</u>	TEMP. <u>56</u>	TOWNSHIP <u>WATERVILLE</u>
		SECTION <u>3</u>
DWG BY <u>BLUBAUGH</u>	PID <u> </u>	T <u>6</u> N R <u>9</u> E

TYPE MONUMENT MAG NAIL
 ON SURFACE - ~~BELOW~~ ON
 OFFSET Q PAVEMENT 1' LT : ~~RT~~
10' TO LT EDGE PAVEMENT
 STATION: 403+90.23

HORZ.DATUM: <u>NAD83 (11)</u>	GEOID: <u>18</u>
GRID: NORTHING: <u>674370.582</u>	EASTING: <u>1605031.224</u>
LDP: NORTHING: <u>295362.325</u>	EASTING: <u>115525.175</u>

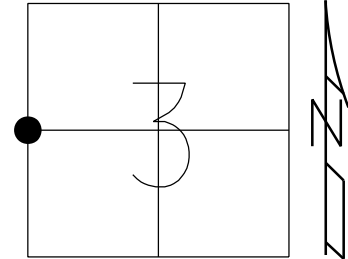

RECORD:
 FD P.K.NAIL
 9/3/02, DCH
 SET MAG/WASHER
 11/21/02, DCH
 FD MAG NAIL
 REF 34
 12/4/15, JLL
 SET MAG/WASHER
 7/17/17, DCH
 FD MAG/WASHER
 REF 14
 6/10/24, JAM

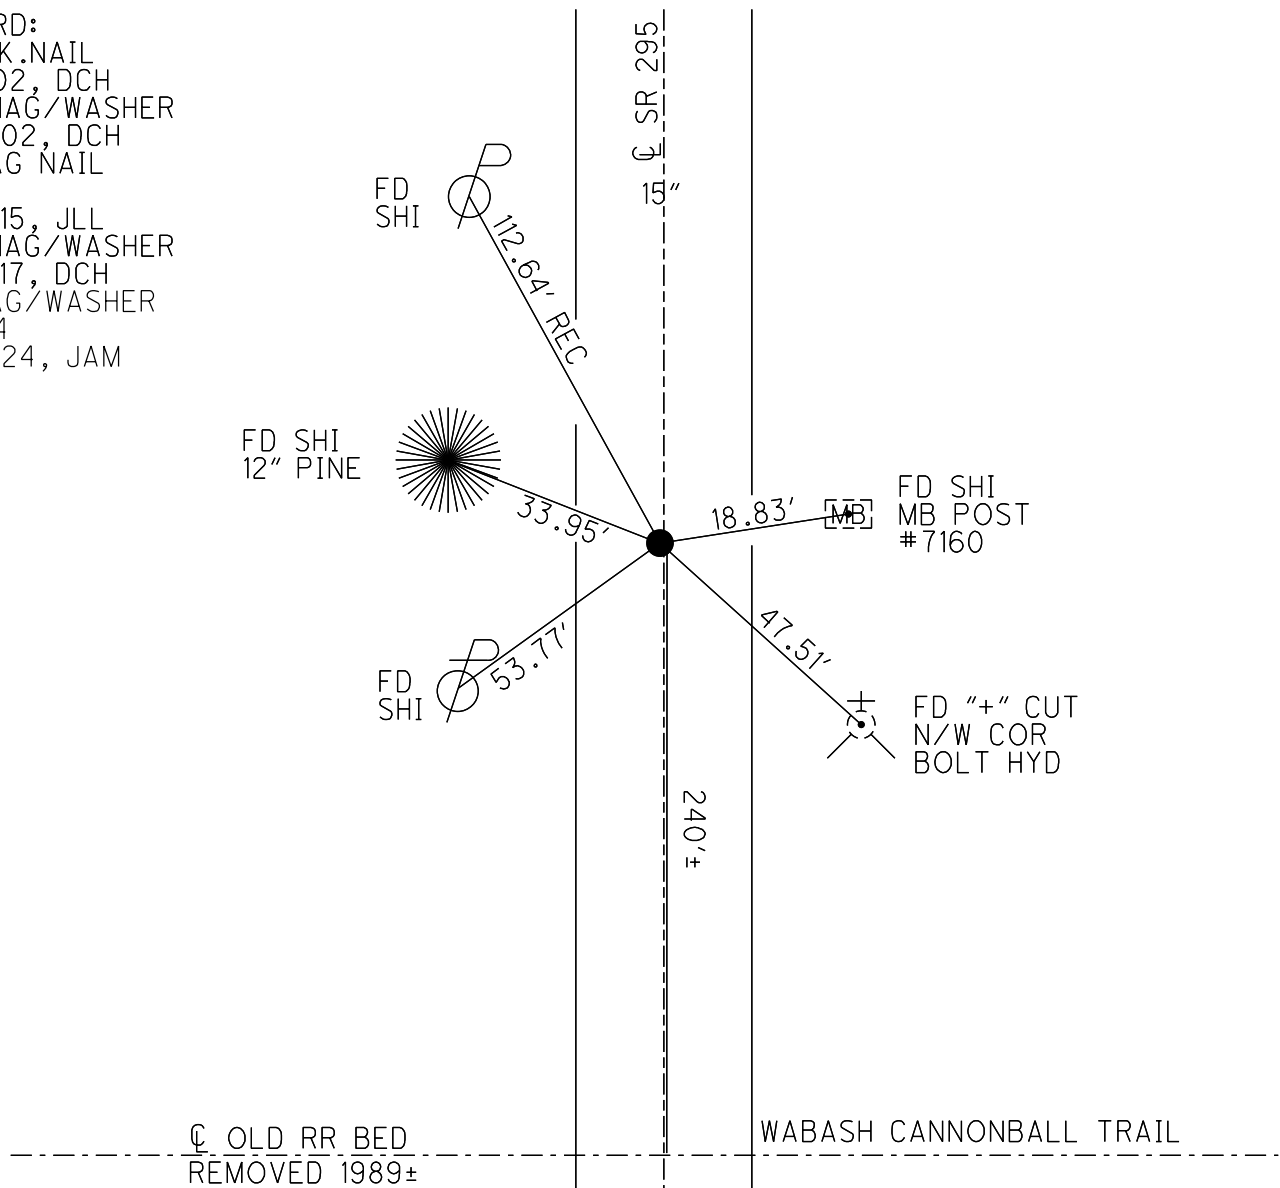


O.D.O.T. DISTRICT 2 SURVEY OFFICE (USE ONLY)


PERSONNEL	REFERENCE NO. <u>15</u>	SHEET <u>15</u> OF <u>45</u>
NOTES <u>MILLER</u>	DATE <u>6/10/24</u>	ROUTE <u>SR 295</u>
H.C. <u>MILLER</u>	WEATHER <u>CLOUDY</u>	COUNTY <u>LUCAS</u>
R.C. <u>BARRIERE</u>	TEMP. <u>54</u>	TOWNSHIP <u>WATERVILLE</u>
		SECTION <u>3</u>
DWG BY <u>BLUBAUGH</u>	PID <u> </u>	T <u>6</u> N R <u>9</u> E

TYPE MONUMENT MAG NAIL
 ON SURFACE - ~~BELOW~~ ON
 OFFSET Q PAVEMENT 2' LT : ~~RT~~
- TO - EDGE PAVEMENT
 STATION: 426+81.91

HORIZ.DATUM: <u>NAD83 (11)</u>	GEOID: <u>18</u>
GRID: NORTHING: <u>676662.204</u>	EASTING: <u>1605015.237</u>
LDP: NORTHING: <u>297653.734</u>	EASTING: <u>115478.965</u>

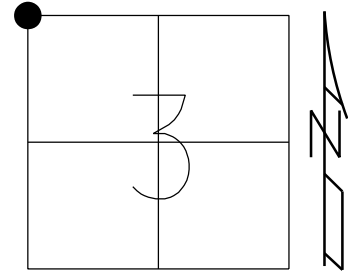

RECORD:
 FD 1" SQ.BOLT
 8/17/91
 FD P.K.NAIL
 9/3/02, DCH
 SET MAG/WASHER
 11/25/02, DCH
 FD MAG NAIL
 REF35
 12/4/15, JLL
 SET MAG/WASHER
 8/4/17, DCH
 FD MAG/WASHER
 REF15
 6/10/24, JAM

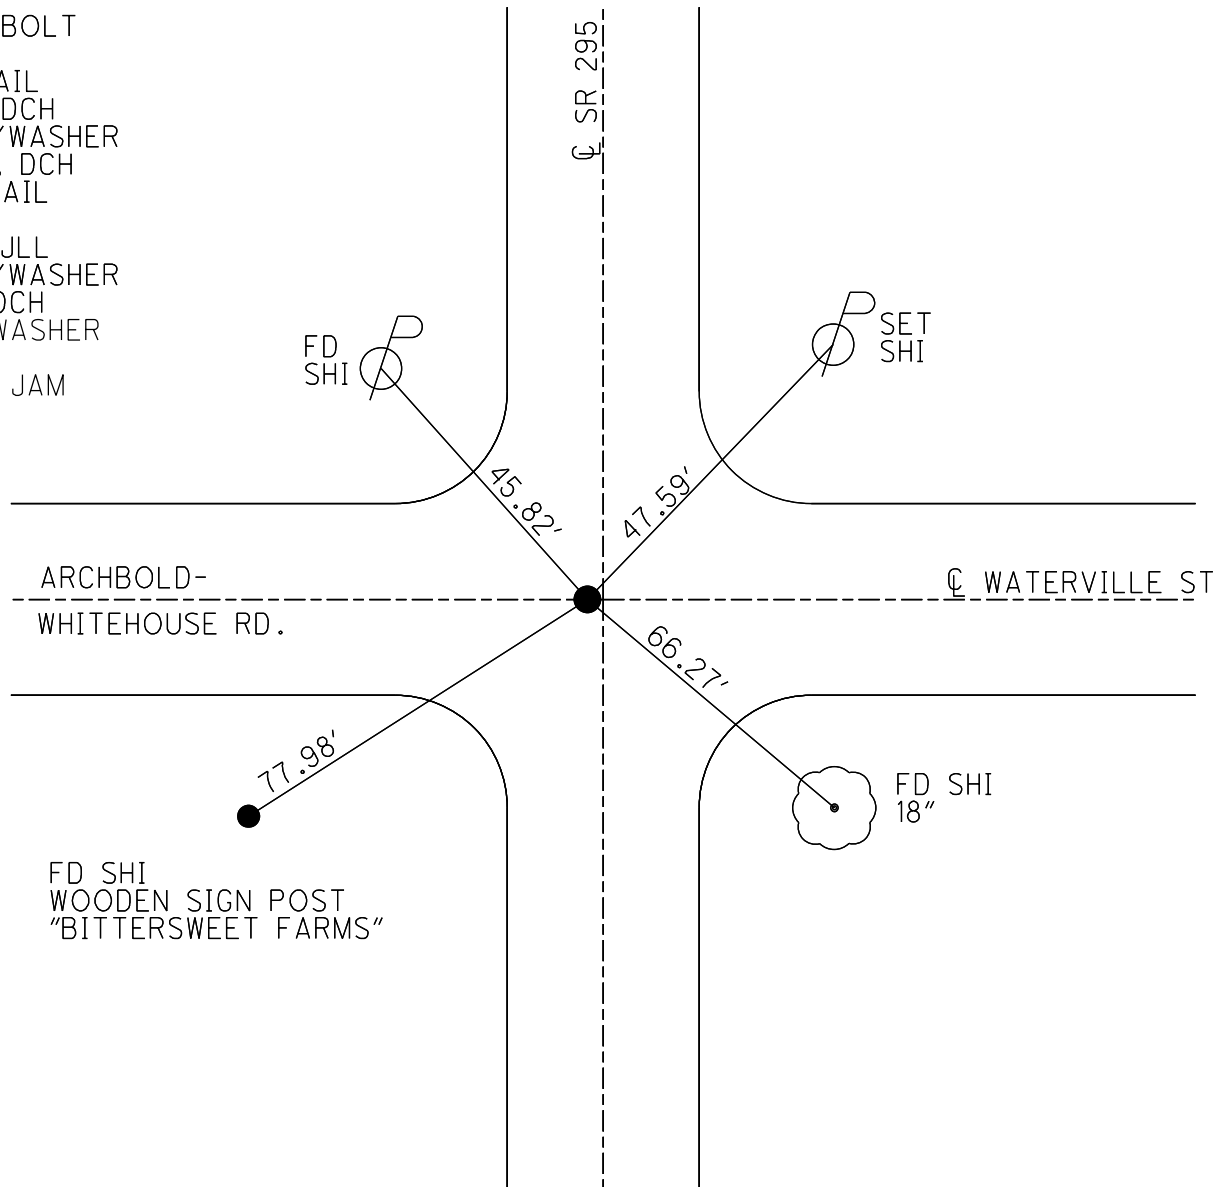

O.D.O.T. DISTRICT 2 SURVEY OFFICE (USE ONLY)

PERSONNEL

REFERENCE NO. 16

SHEET 17 OF 45

NOTES MILLER
H.C. MILLER
R.C. BARRIERE

DATE 6/10/24
WEATHER CLOUDY
TEMP. 54

ROUTE SR 295
COUNTY LUCAS
TOWNSHIP WATERVILLE
SECTION 33

DWG BY BLUBAUGH PID

T 7 N R 9 E

TYPE MONUMENT 3/4" IPIPE

ON SURFACE - ~~BELOW~~ ON

OFFSET Q PAVEMENT - LT : RT

- TO - EDGE PAVEMENT

STATION: 429+60.39

HORZ.DATUM: NAD83 (11)


GEOID: 18

GRID: NORTHING: 676940.678


EASTING: 1605013.336

LDP: NORTHING: 297932.118

EASTING: 115473.328

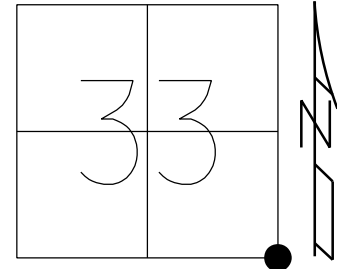

RECORD:
SET 3/4" IPIN
4/14/76
FD 3/4" IPIPE
REF37
3/22/17, DCH
FD IPIPE
REF 16
6/10/24

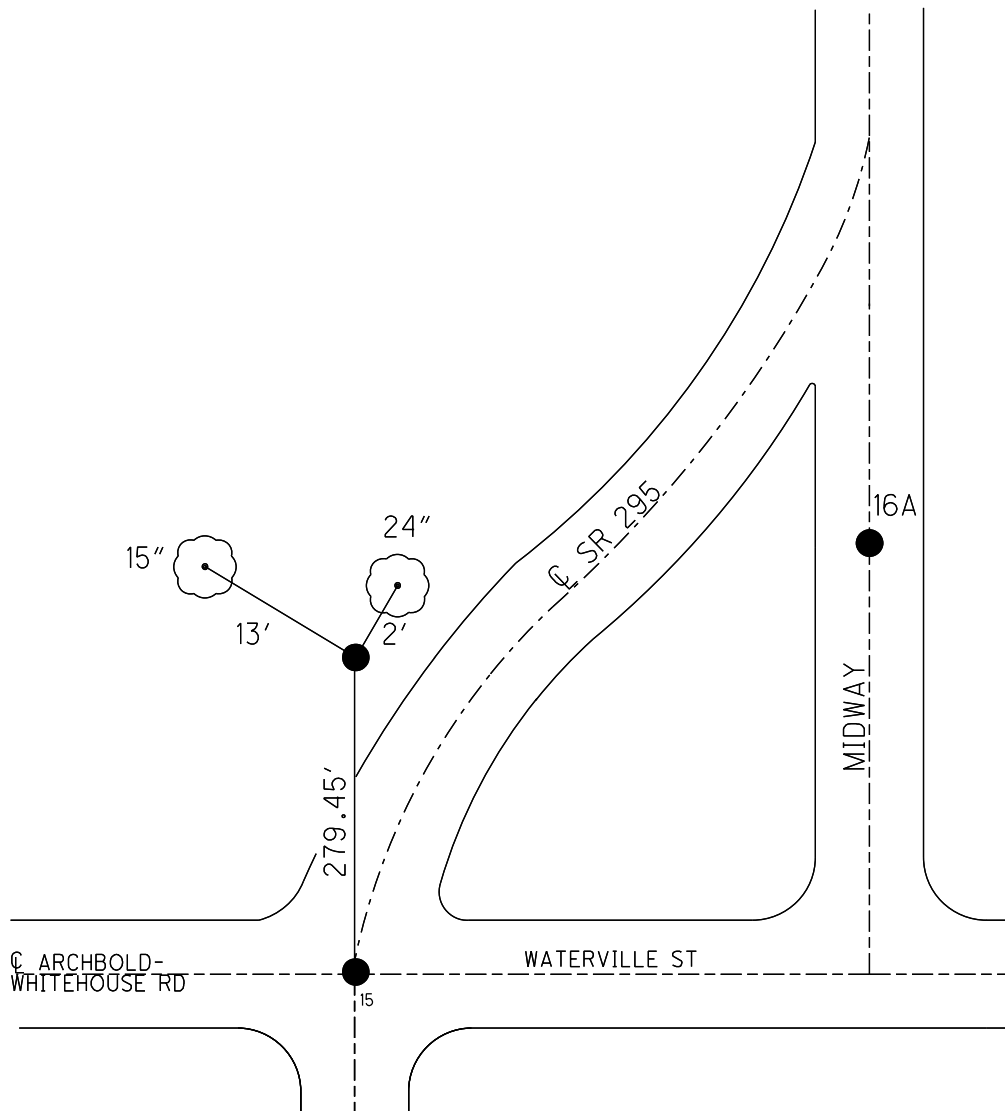

O.D.O.T. DISTRICT 2 SURVEY OFFICE (USE ONLY)

PERSONNEL

REFERENCE NO. 16 A

SHEET 18 OF 45

NOTES BARRIERE
H.C. MILLER
R.C. BARRIERE

DATE 6/10/24
WEATHER CLOUDY
TEMP. 56

ROUTE SR 295
COUNTY LUCAS
TOWNSHIP WATERVILLE
SECTION 33
T 7 N R 9 E

DWG BY BLUBAUGH PID

TYPE MONUMENT MAG/WASHER

ON SURFACE - BELOW ON

OFFSET $\odot$ PAVEMENT - LT : RT

- TO - EDGE PAVEMENT

STATION: 438+64.6

HORZ.DATUM: NAD83 (11)


GEOID: 18

GRID: NORTHING: 677526.395


EASTING: 1605752.328

LDP: NORTHING: 298527.557

EASTING: 116204.600

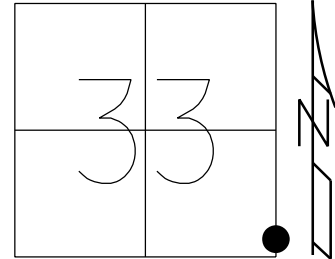

RECORD: P.I.
SET R.R.SPIKE
4/14/76
FD P.K.NAIL
REF38
3/22/17, DCH
FD PK NAIL (REPLACED)
RECREP16A
SET MAG/WASHER
REF16A
6/10/24, JAM

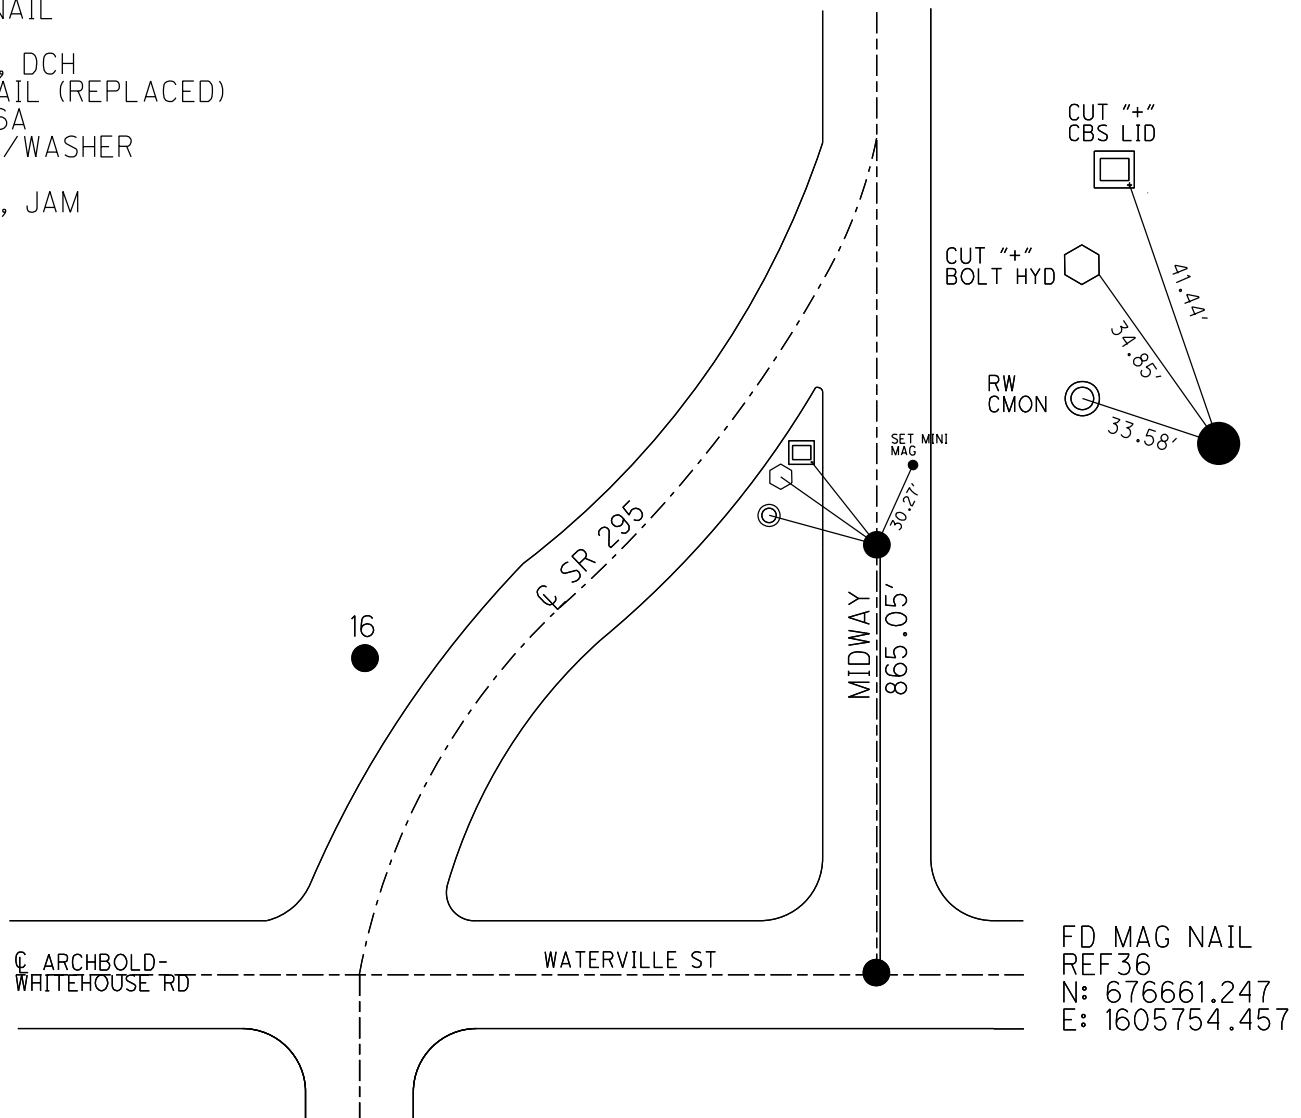

O.D.O.T. DISTRICT 2 SURVEY OFFICE (USE ONLY)

PERSONNEL

REFERENCE NO. 17

SHEET 19 OF 45

NOTES BARRIERE
H.C. MILLER
R.C. BARRIERE

DATE 6/10/24
WEATHER CLOUDY
TEMP. 54

ROUTE SR 295
COUNTY LUCAS
TOWNSHIP WATERVILLE
SECTION 33
T 7 N R 9 E

DWG BY BLUBAUGH PID

TYPE MONUMENT MAG/WASHER

ON SURFACE - ~~BELOW~~ ON

OFFSET Q PAVEMENT 3.6' LT : ~~RT~~

6.2' TO LT EDGE PAVEMENT

STATION: 456+06.55

HORZ.DATUM: NAD83 (11)


GEOID: 18

GRID: NORTHING: 679306.632

EASTING: 1605747.909


LDP: NORTHING: 300307.745

EASTING: 116176.681

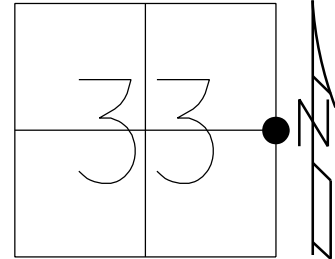

RECORD:
FD P.K.NAIL
9/3/02, DCH
SET MAG/WASHER
11/25/02, DCH
SET MAG/WASHER
8/4/17, DCH
FD MAG/WASHER
REF 17
6/10/24, JAM

RECORD:
P.K.NAIL
SV1
6/10/24, JAM
N: 300306.170
E: 116176.670

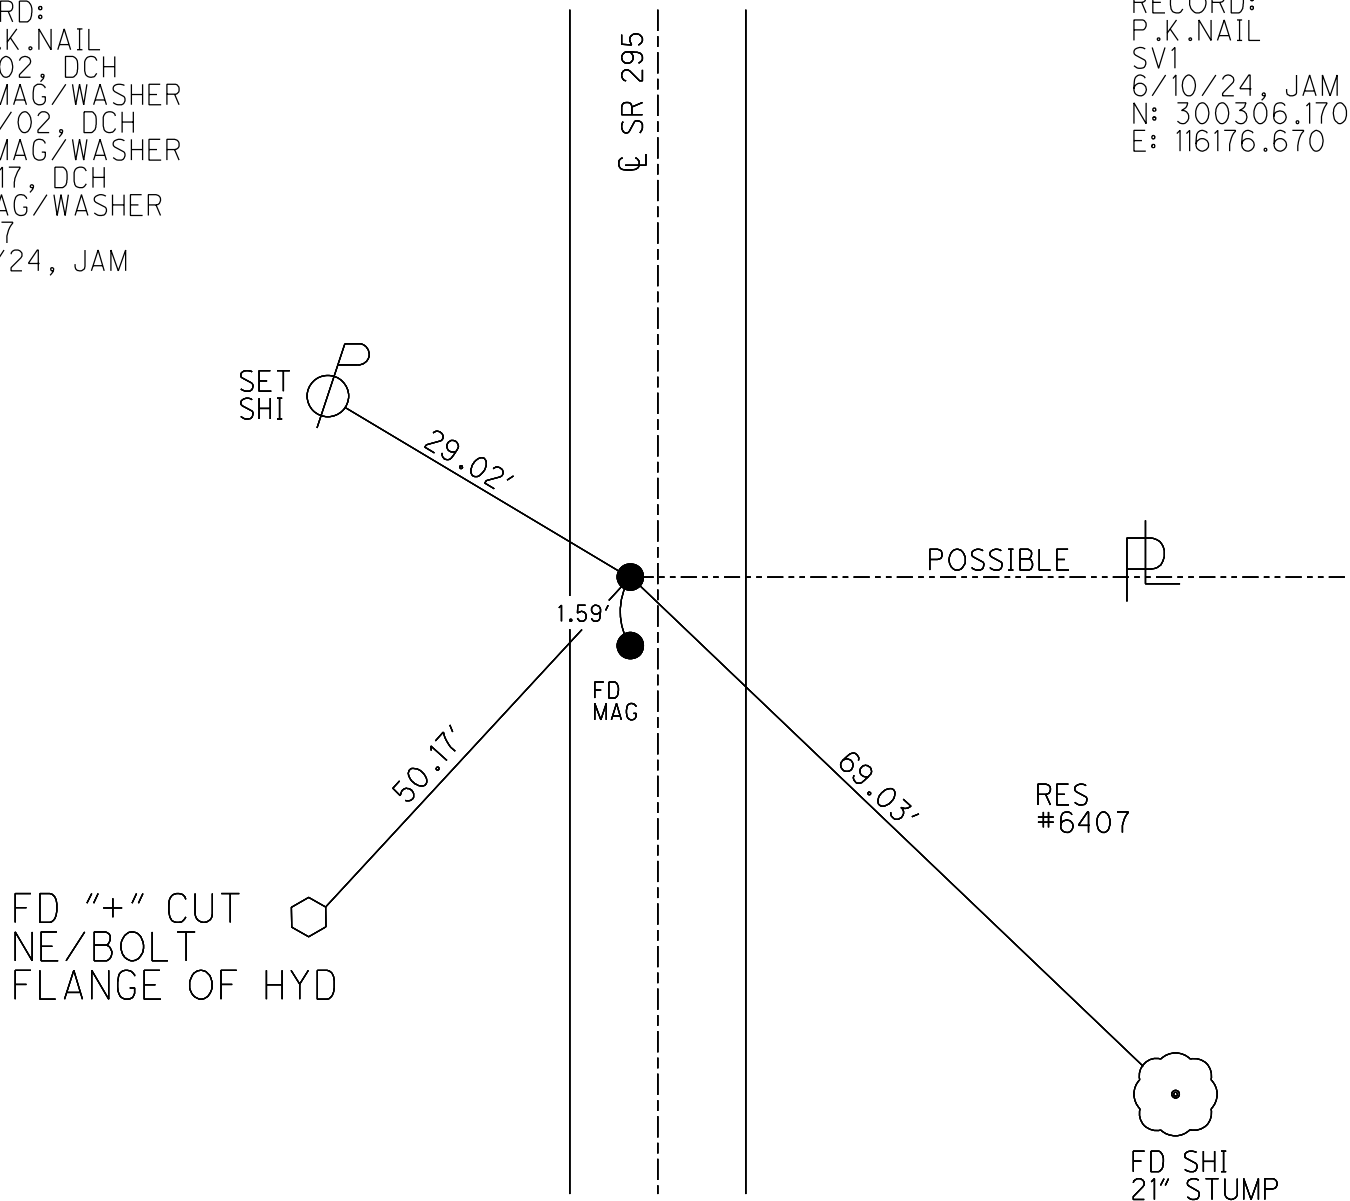

O.D.O.T. DISTRICT 2 SURVEY OFFICE (USE ONLY)

PERSONNEL

REFERENCE NO. 18

SHEET 20 OF 45

NOTES BARRIERE
H.C. MILLER
R.C. BARRIERE

DATE 6/10/24
WEATHER CLOUDY
TEMP. 54

ROUTE SR 295
COUNTY LUCAS
TOWNSHIP SWANTON
SECTION 33

DWG BY BLUBAUGH PID

T 7 N R 5 E

TYPE MONUMENT MAG/WASHER

ON SURFACE - ~~BELOW~~ ON

OFFSET Q PAVEMENT ON LT : RT

11.6' TO RT EDGE PAVEMENT

STATION: 469+99.53

HORZ.DATUM: NAD83 (11)


GEOID: 18

GRID: NORTHING: 680699.543


EASTING: 1605738.594

LDP: NORTHING: 301700.511

EASTING: 116149.066

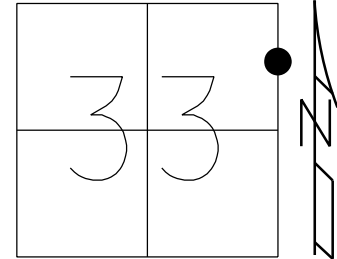

RECORD:
FD SQ.BOLT
5/22/02, DCH
SET MAG/WASHER
12/13/02, DCH
FD MAG/WASHER
REF18
6/20/16, JFO
FD MAG/WASHER
REF 18
6/10/24, JAM

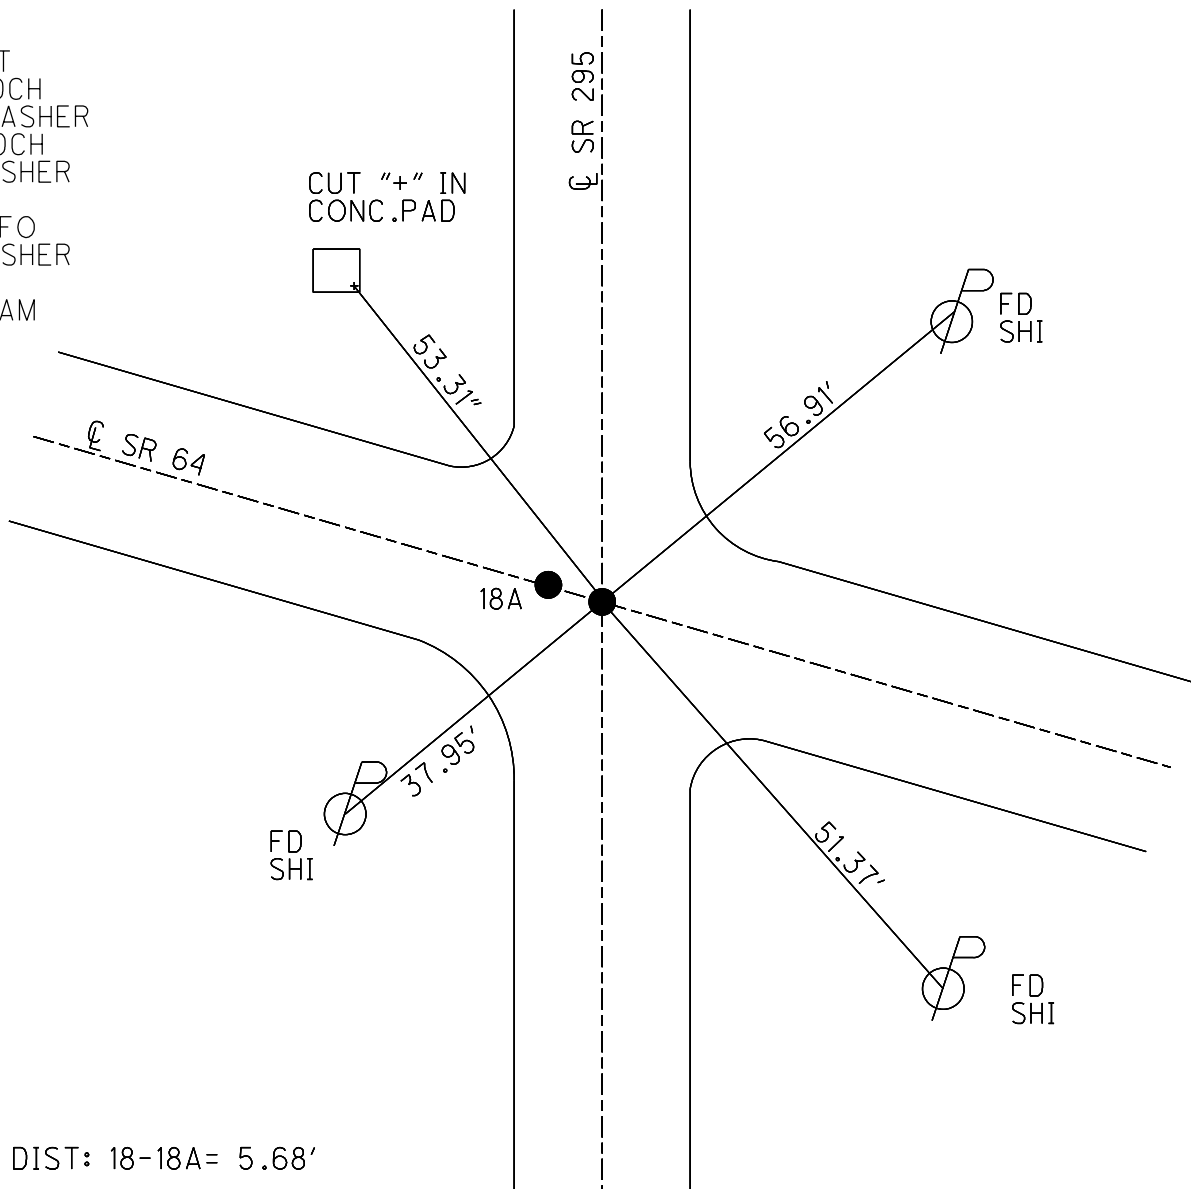


DIST: 18-18A= 5.68'

O.D.O.T. DISTRICT 2 SURVEY OFFICE (USE ONLY)


PERSONNEL

REFERENCE NO. 18 ASHEET 21 OF 45NOTES BARRIEREDATE 6/10/24ROUTE SR 295H.C. MILLERWEATHER CLOUDYCOUNTY LUCASR.C. BARRIERETEMP. 54TOWNSHIP SWANTONDWG BY BLUBAUGH

PID _____

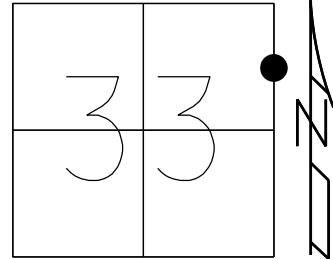SECTION 33T 7 N R 5 ETYPE MONUMENT MAG/WASHERON SURFACE - ~~BELOW~~ ONOFFSET Q PAVEMENT 5.67' LT : ~~RT~~11.6' TO RT EDGE PAVEMENTSTATION: 336+90HORZ.DATUM: NAD83 (11)GEOID: 18GRID: NORTHING: 680701.188EASTING: 1605733.149LDP: NORTHING: 301702.067EASTING: 116143.610

RECORD:
SET MAG/WASHER
12/13/02, DCH
FD MAG/WASHER
REFA18
6/20/16, JFO
6/10/24, JAM

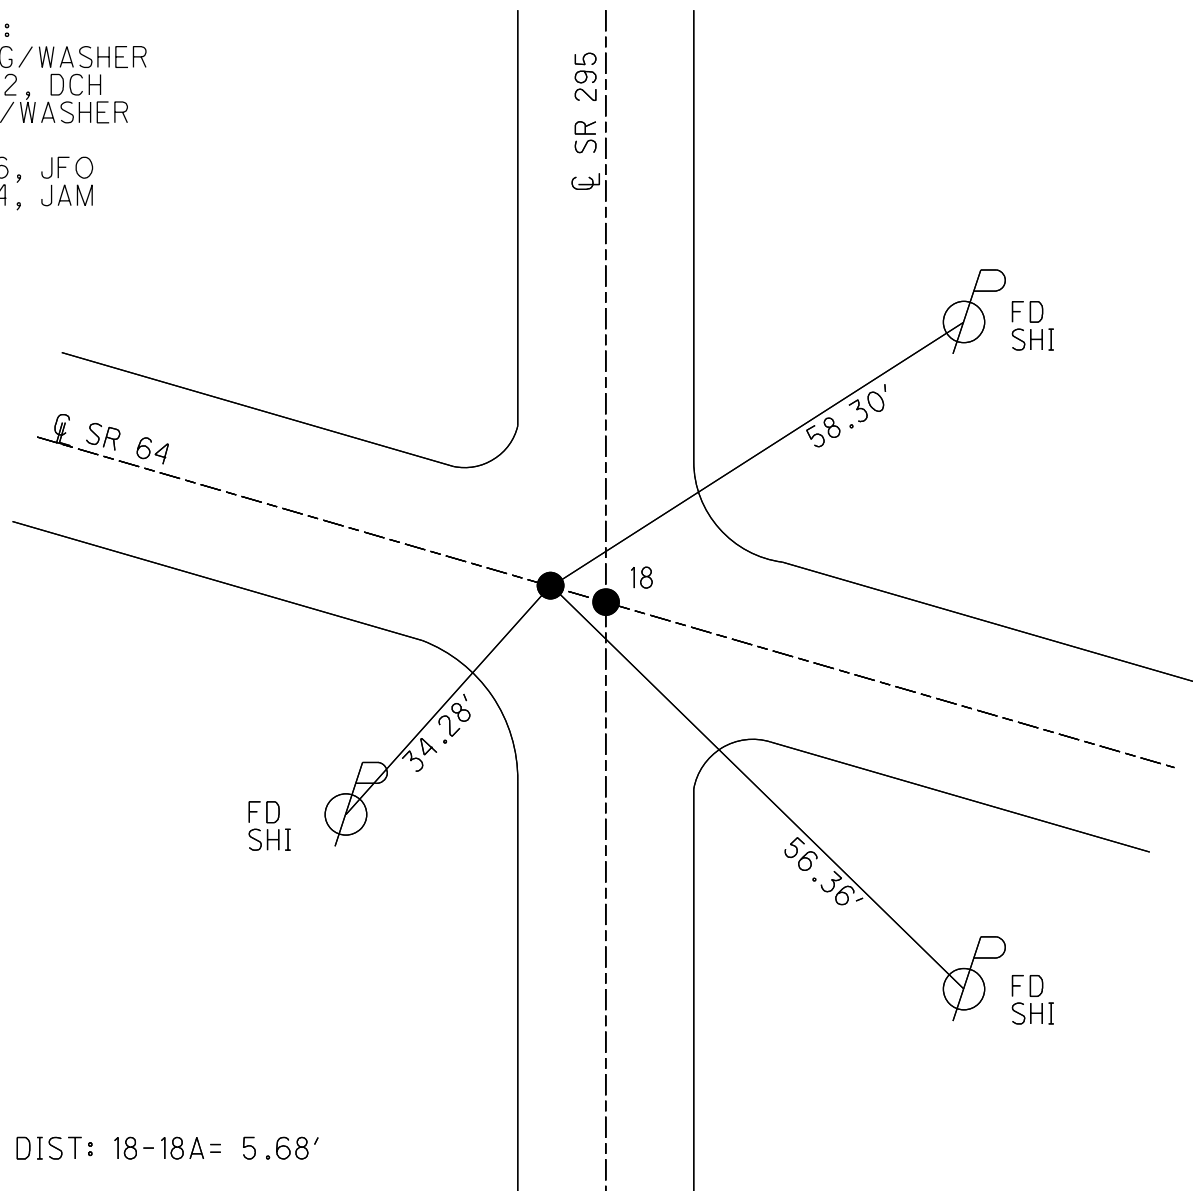


DIST: 18-18A= 5.68'

O.D.O.T. DISTRICT 2 SURVEY OFFICE (USE ONLY)


PERSONNEL _____ REFERENCE NO. 19 SHEET 22 OF 45
 NOTES BEUAMONT DATE 9/3/02 ROUTE SR 295
 H.C. HOMAN WEATHER P CLOUDY COUNTY LUCAS
 R.C. BEAUMONT TEMP. 80° TOWNSHIP SWANTON
 _____ SECTION 33
 _____ T 7 N R 9 E

TYPE MONUMENT SQUARE RR SPIKE
 ON SURFACE - ~~BELOW~~ ON
 LEFT - ℄ PAV'T - ~~RIGHT~~ 8.0'
1.0' TO LT EDGE PAVEMENT
 S.L.M. 352+20

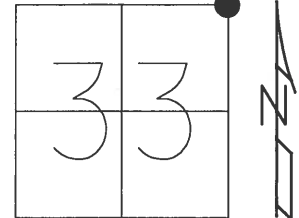

GRID: NORTHING: 681954.177 EASTING: 1605729.904


RECORD:
 SET MAG NAIL/WASHER
 11/25/02, DCH
 FD MAG NAIL
 REF41
 12/4/15, JLL
 FD MAG/WASHER
 REF19
 6/20/16, JFO
 UNCOVERED
 7/17/17, JFO

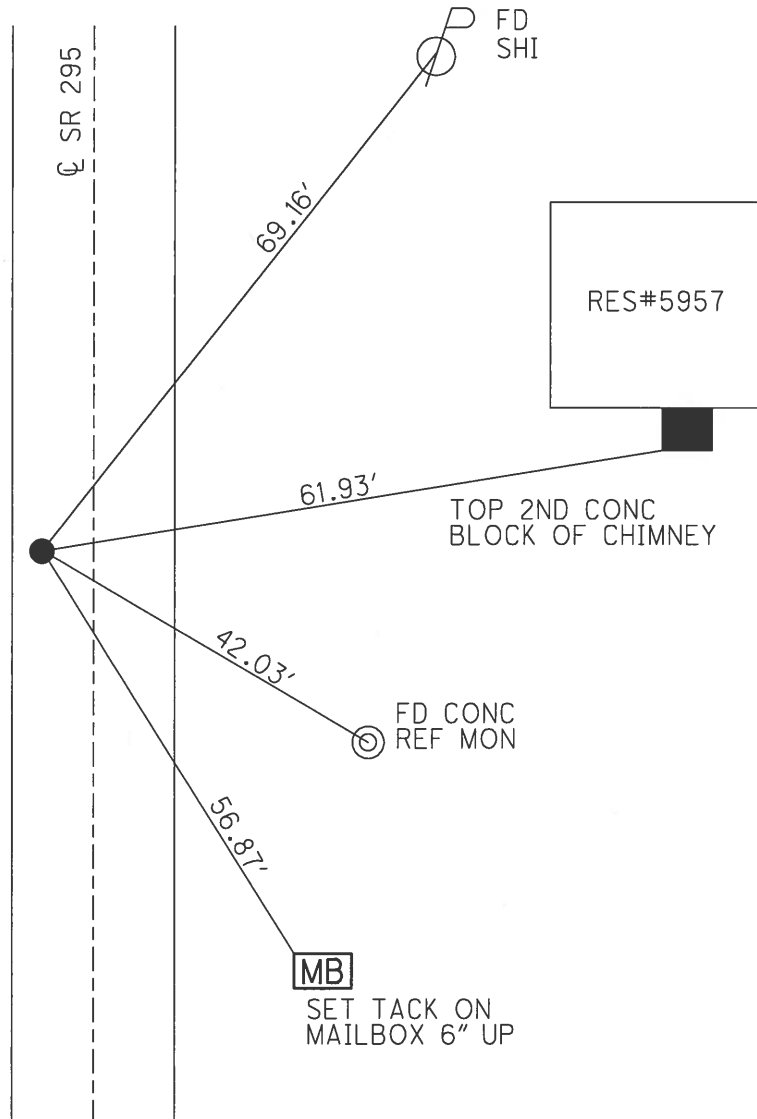

O.D.O.T. DISTRICT 2 SURVEY OFFICE (USE ONLY)


PERSONNEL	REFERENCE NO. <u>20</u>	SHEET <u>23</u> OF <u>45</u>
NOTES	DATE <u>6/20/16</u>	ROUTE <u>SR 295</u>
H.C. <u>RHOADES</u>	WEATHER <u>WINDY</u>	COUNTY <u>LUCAS</u>
R.C. <u>RHOADES</u>	TEMP. <u>80°</u>	TOWNSHIP <u>WATERVILLE</u>
		SECTION <u>27</u>
		T <u>7</u> N R <u>9</u> E

TYPE MONUMENT "+" CUT CONC.
 ON SURFACE - BELOW ON
 LEFT - Q PAV'T - ~~RIGHT~~ 1.6'
8.1' TO LT EDGE PAVEMENT
 S.L.M. 378+62.42
 GRID: NORTHING: 684599.686 EASTING: 1605820.264

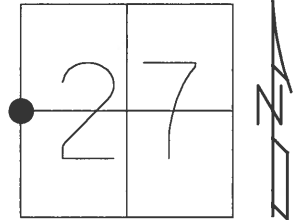

NOTE:
 POINT FALLS ON SOUTH PLATE
 OF NORTH EXPANSION JOINT OF
 STRUCTURE. NOTHING SET DUE TO
 POSSIBLE MOVEMENT OF STEEL
 JOINT.

RECORD:
 FD "+" CUT,
 8/20/01
 NOT COVERED,
 11/25/02
 P.K. NAILS SET TO WEST,
 NORTHWEST, AND TO EAST,
 AT 6' OFFSETS.
 FD "+" CUT
 REF 20
 6/20/16, JFO
 UNCOVERED
 7/17/17, JFO

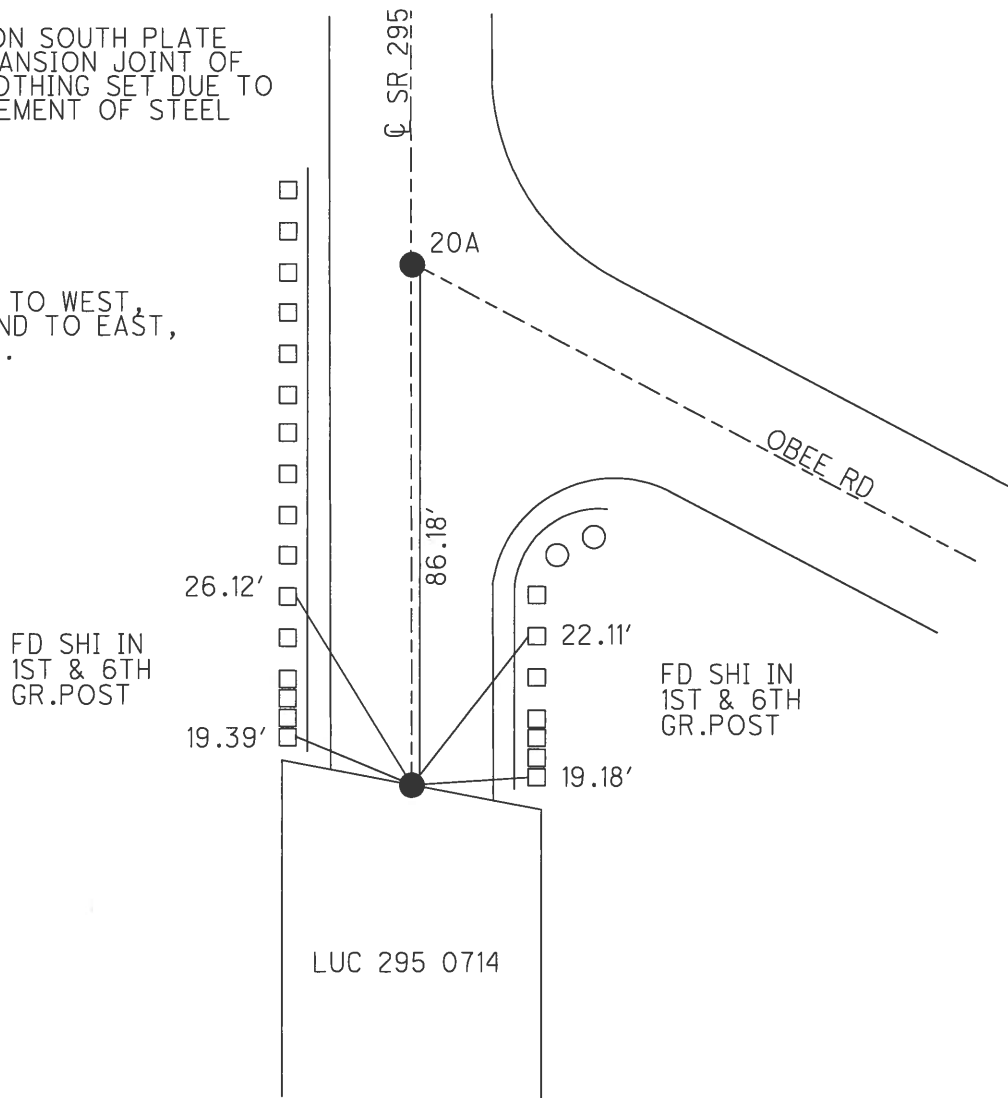

O.D.O.T. DISTRICT 2 SURVEY OFFICE (USE ONLY)

PERSONNEL

REFERENCE NO.

20 A

SHEET

24

OF

45

NOTES

LOEHRKE

DATE

8/6/91

ROUTE

SR 295

H.C.

CURTIS

WEATHER

CLOUDY

COUNTY

LUCAS

R.C.

LUCE

TEMP.

75°

TOWNSHIP

SWANTON

SECTION

27

T 7 N R 9 E

TYPE MONUMENT SQ HEADED SPIKE


ON SURFACE - ~~BELOW~~ ON

LEFT - Q PAV'T - ~~RIGHT~~ 1.0'

7.9' TO LT EDGE PAVEMENT

S.L.M. 379+53

GRID: NORTHING: EASTING:

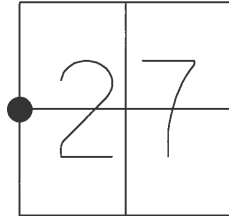

RECORD:

SET P.K.NAILS

3/14/92

DNF

8/20/01, BC

NEEDS TO BE RESET

11/25/02, DCH


D.N.F.

TIES ARE NOT GOOD

AND ALL RECORD

6/21/19, JFO

SET SHI
NEAR TOP
WOODEN
GR.POST

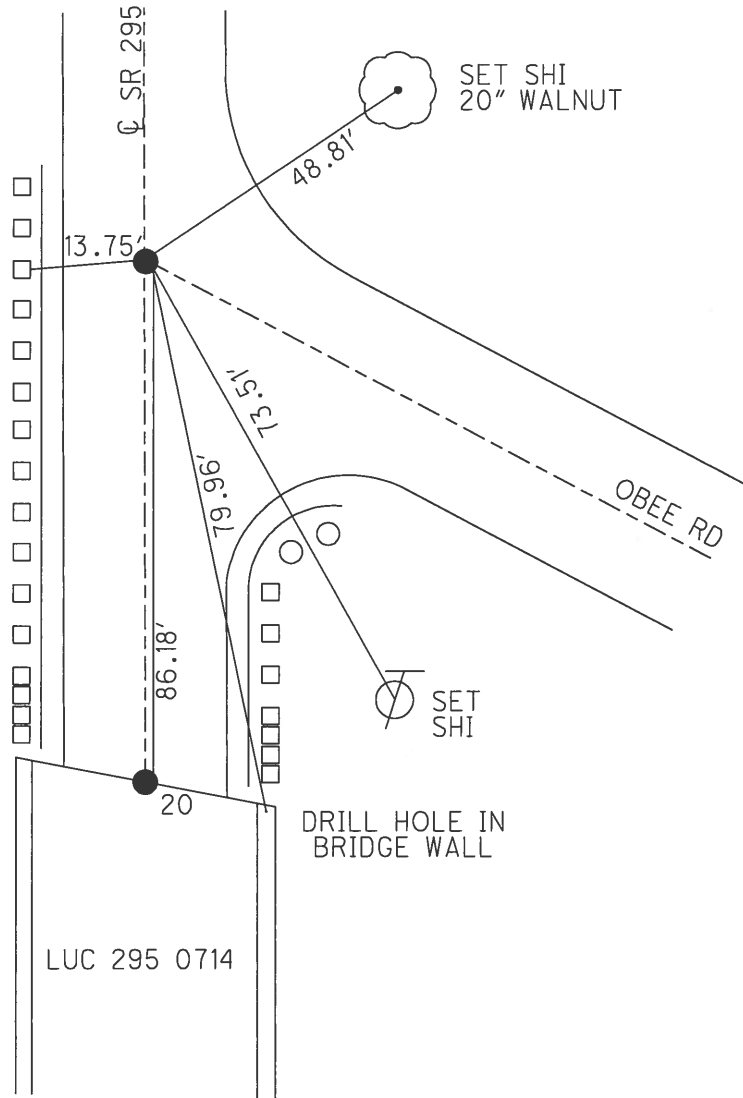

LUC 295 0714

O.D.O.T. DISTRICT 2 SURVEY OFFICE (USE ONLY)

PERSONNEL

REFERENCE NO. 21

SHEET 25 OF 45

NOTES BEAUMONT

DATE 9/3/02

ROUTE SR 295

H.C. HOMAN

WEATHER P CLOUDY

COUNTY LUCAS

R.C. BEUMONT

TEMP. 80°

TOWNSHIP SWANTON

SECTION 27

T 7 N R 9 E

TYPE MONUMENT P.K. NAIL


ON SURFACE - ~~BELOW~~ ON

LEFT - Q PAV'T - RIGHT ON

9.8 TO LT EDGE PAVEMENT

S.L.M. 386+79

GRID: NORTHING: 685410.948 EASTING: 1605847.981

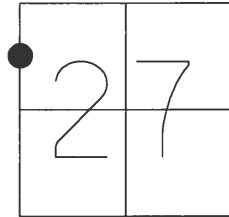

RECORD:
SET MAG/WASHER
11/25/02, DCH
FD MAG NAIL
REF21
6/20/16, JFO
SET MAG/WASHER
1 1/2" DOWN
NEWREF21
7/27/17, JFO

FD CONC
REF MON

26.54'

21A

99.98'

35.50'

FD CONC
REF MON

40.73'

FD
SHI

Q SR 295

O.D.O.T. DISTRICT 2 SURVEY OFFICE (USE ONLY)

PERSONNEL

REFERENCE NO. 21 A

SHEET 26 OF 45

NOTES BEAUMONT

DATE 9/3/02

ROUTE SR 295

H.C. HOMAN

WEATHER P CLOUDY

COUNTY LUCAS

R.C. BEAUMONT

TEMP. 80°

TOWNSHIP SWANTON

SECTION 27

T 7 N R 9 E

TYPE MONUMENT P.K. NAIL


ON SURFACE - ~~BELOW~~ ON

LEFT - C PAV'T - RIGHT ON


9.8' TO LT EDGE PAVEMENT

S.L.M. 387+79

GRID: NORTHING: 685510.961 EASTING: 1605848.321

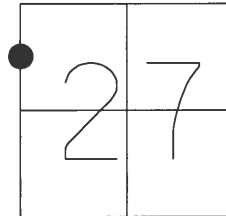

RECORD:
SET MAG/WASHER
11/25/02, DCH
FD MAG/WASHER
REFA21
6/20/16, JFO
UNCOVERED
7/17/17, JFO

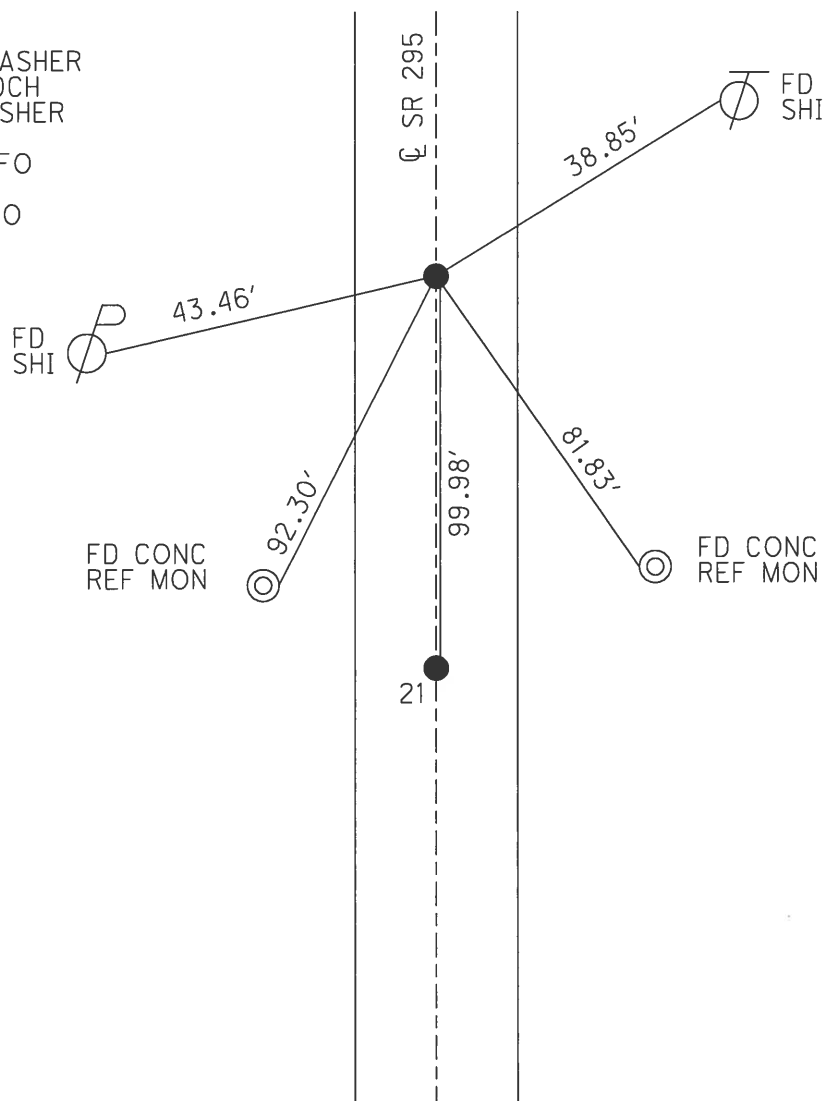

O.D.O.T. DISTRICT 2 SURVEY OFFICE (USE ONLY)

PERSONNEL

REFERENCE NO.

22

SHEET

27

OF

45

NOTES

BEUAMONT

DATE

9/3/02

ROUTE

SR 295

H.C.

HOMAN

WEATHER

P CLOUDY

COUNTY

LUCAS

R.C.

BEAUMONT

TEMP.

80°

TOWNSHIP

SWANTON

SECTION

27

T 7 N R 9 E

TYPE MONUMENT

P.K. NAIL

ON SURFACE - BELOW

ON

LEFT - Q PAV'T - ~~RIGHT~~ 0.5'


10 TO LT EDGE PAVEMENT

S.L.M.

392+32

GRID: NORTHING: 685964.775

EASTING: 1605849.649

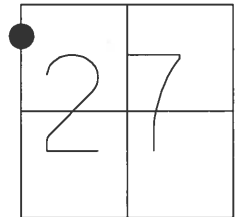

RECORD:
SET MAG/WASHER
11/26/02, DCH
FD MAG/WASHER
REF22
6/20/16, JFO
UNCOVERED
7/17/17, JFO

FD SHI 3RD
WOODEN
FENCE POST
SOUTH
OF POWER
POLE

FD SHI 6TH
WOODEN
FENCE POST
SOUTH
OF POWER
POLE



FD SHI

38.03'

37.22'

52.14'

Q SR 295

FD SHI

134.65' REC

O.D.O.T. DISTRICT 2 SURVEY OFFICE (USE ONLY)

PERSONNEL _____ REFERENCE NO. 23 SHEET 28 OF 45

NOTES RHOADES DATE 4/4/17 ROUTE SR 295
H.C. O'DONNELL WEATHER P CLOUDY COUNTY LUCAS
R.C. HELDMAN TEMP. 52° TOWNSHIP SWANTON
SECTION 22
T 7 N R 9 E

TYPE MONUMENT HARROW TOOTH


~~ON SURFACE~~ - BELOW 4"

LEFT - CL PAV'T - ~~RIGHT~~ 0.6'


11' TO LT EDGE PAVEMENT

S.L.M. 405+97

GRID: NORTHING: 687329.875 EASTING: 1605852.618

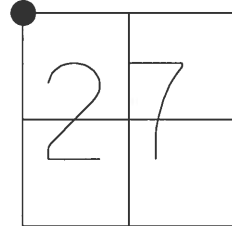

RECORD:
SET MAG/WASHER
11/26/02, DCH
FD HARROW TOOTH
4" DOWN
REF23
6/20/16, JFO
UNCOVERED
7/27/17, JFO

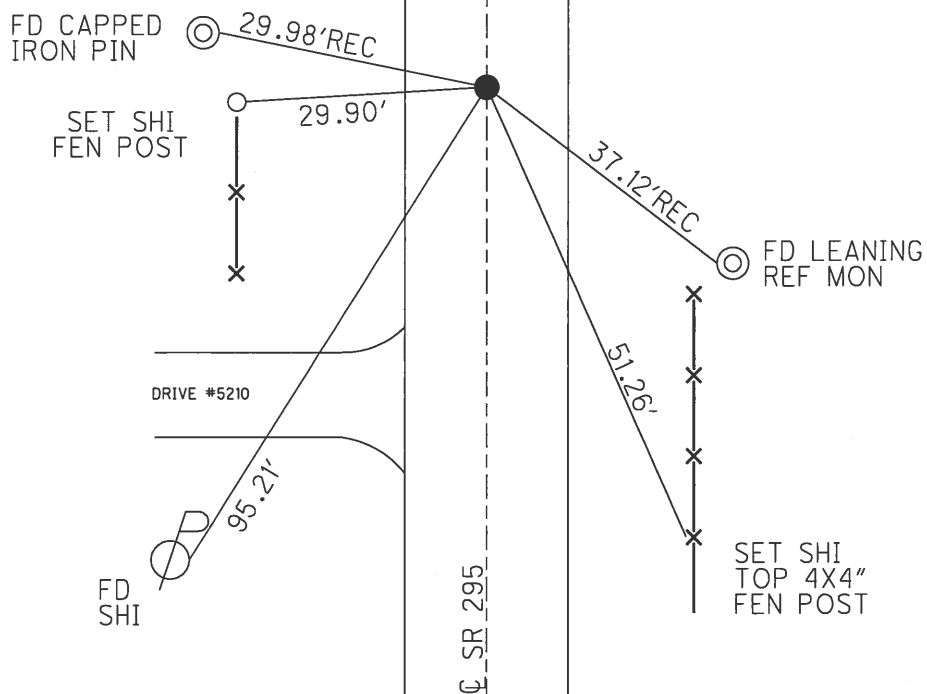

O.D.O.T. DISTRICT 2 SURVEY OFFICE (USE ONLY)

PERSONNEL

REFERENCE NO.

23 A

SHEET

29

OF

45

NOTES

RHOADES

DATE

6/21/16

ROUTE

SR 295

H.C.

O'DONNELL

WEATHER

WINDY

COUNTY

LUCAS

R.C.

RHOADES

TEMP.

78°

TOWNSHIP

SWANTON

KEFFER

SECTION

22

T 7 N R 9 E

TYPE MONUMENT MAG/WASHER



ON SURFACE - ~~BELOW~~ ON

LEFT - ℄ PAV'T - RIGHT ON

11' TO LT EDGE PAVEMENT

S.L.M. 408+38

GRID: NORTHING: 687568.868 EASTING: 1605854.966

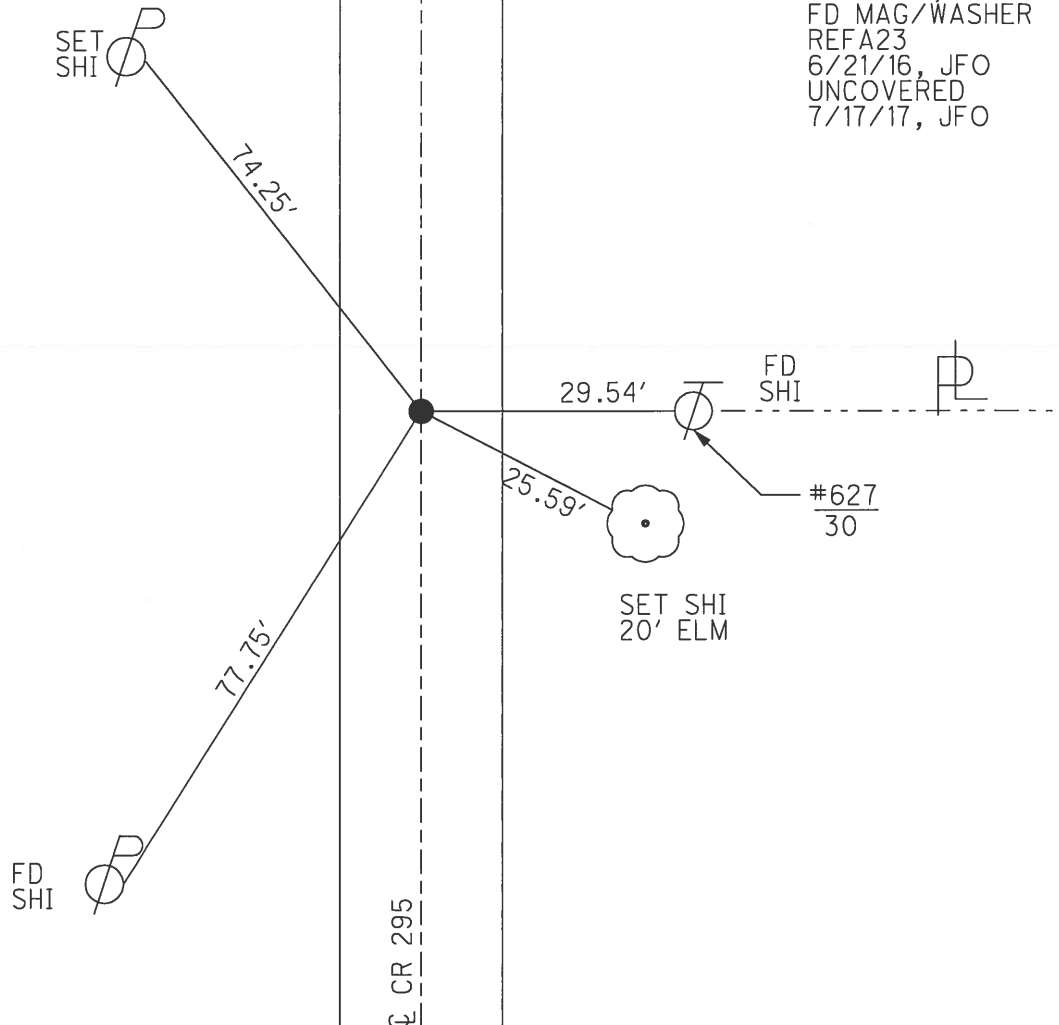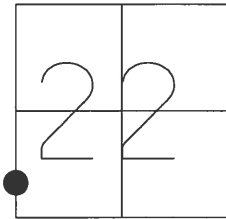

O.D.O.T. DISTRICT 2 SURVEY OFFICE (USE ONLY)

PERSONNEL

REFERENCE NO.

23 B

SHEET

30 OF 45

NOTES BEAUMONT

DATE 9/3/02

ROUTE SR 295

H.C. HOMAN

WEATHER P CLOUDY

COUNTY LUCAS

R.C. BEAUMONT

TEMP. 80°

TOWNSHIP SWANTON

SECTION 22

T 7 N R 9 E

TYPE MONUMENT P.K. NAIL


ON SURFACE - ~~BELOW~~ ON

LEFT - Q PAV'T - RIGHT ON


11' TO LT EDGE PAVEMENT

S.L.M. 411+08

GRID: NORTHING: 687841.309 EASTING: 1605857.473

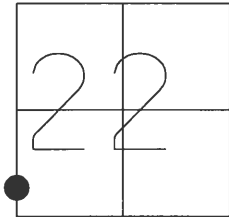


RECORD:
SET MAG/WASHER
11/26/02, DCH
FD MAG NAIL
REFB23
6/20/16, JFO
UNCOVERED
7/17/17, JFO

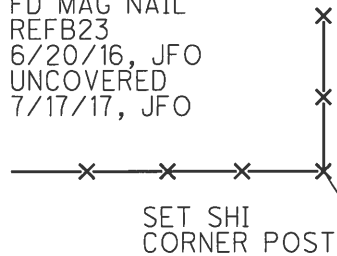


Q SR 295

50.06'

28.68'

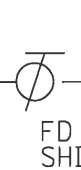


RES
#5101

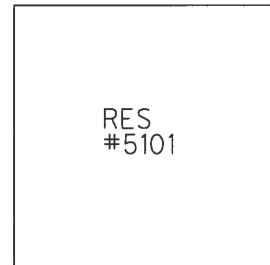

O.D.O.T. DISTRICT 2 SURVEY OFFICE (USE ONLY)


PERSONNEL	REFERENCE NO.	<u>23 C</u>	SHEET	<u>31</u>	OF	<u>45</u>
NOTES	BEAUMONT	DATE	<u>9/3/02</u>	ROUTE	<u>SR 295</u>	
H.C.	HOMAN	WEATHER	<u>SUNNY</u>	COUNTY	<u>LUCAS</u>	
R.C.	BEAUMONT	TEMP.	<u>85°</u>	TOWNSHIP	<u>SWANTON</u>	
				SECTION	<u>22</u>	
				T	<u>7</u>	N
				R	<u>9</u>	E

TYPE MONUMENT P.K. NAIL
 ON SURFACE - ~~BELOW~~ ON
 LEFT - Q PAV'T - RIGHT ON
11' TO LT EDGE PAVEMENT
 S.L.M. 413+81

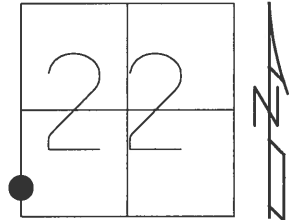

GRID: NORTHING: 688113.429 EASTING: 1605859.732

RECORD:
 FD HARROW TOOTH
 SPIKE 1" DOWN
 8/5/91
 SET MAG/WASHER
 11/26/02, DCH
 FD MAG/WASHER
 6/20/16, JFO
 UNCOVERED
 7/17/17, JFO

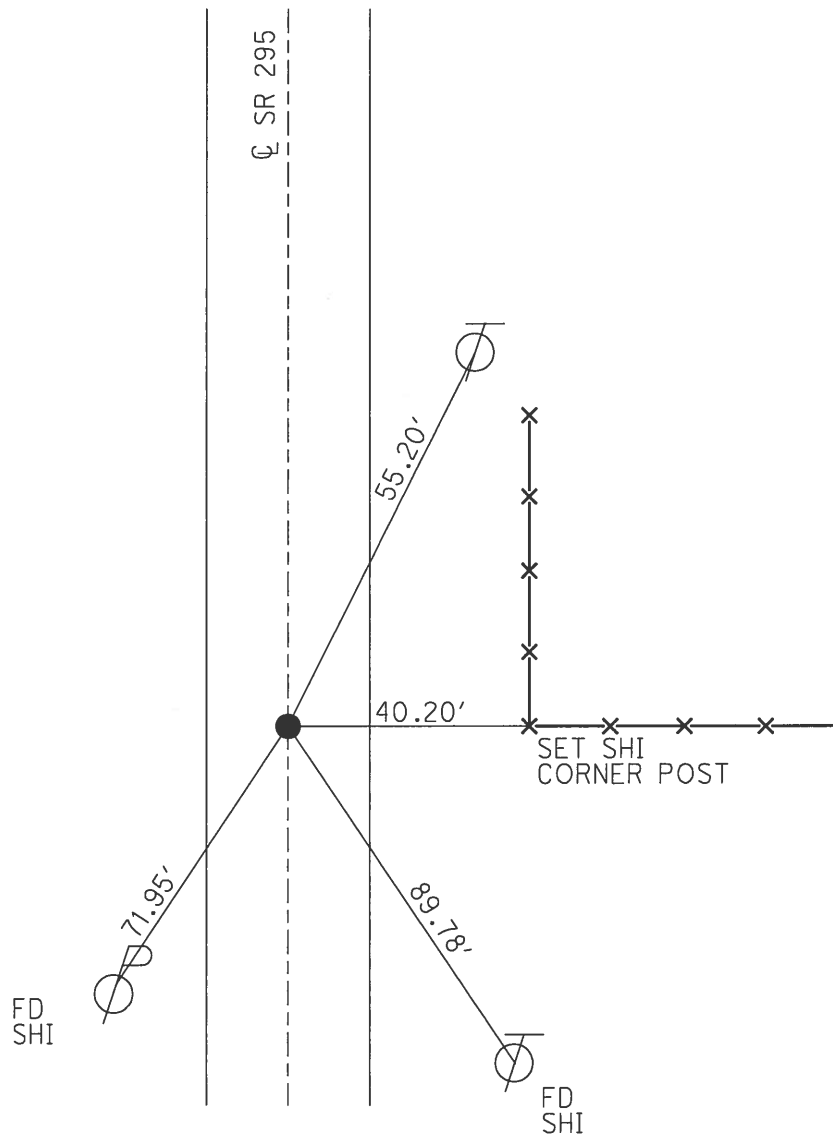


O.D.O.T. DISTRICT 2 SURVEY OFFICE (USE ONLY)

PERSONNEL _____ REFERENCE NO. 23 D SHEET 32 OF 45


NOTES	<u>BEAUMONT</u>	DATE	<u>9/3/02</u>	ROUTE	<u>SR 295</u>
H.C.	<u>HOMAN</u>	WEATHER	<u>SUNNY</u>	COUNTY	<u>LUCAS</u>
R.C.	<u>BEAUMONT</u>	TEMP.	<u>85°</u>	TOWNSHIP	<u>SWANTON</u>
				SECTION	<u>22</u>
				T <u>7</u> N	R <u>9</u> E

TYPE MONUMENT P.K. NAIL
 ON SURFACE - ~~BELOW~~ ON
 LEFT - Q PAV'T - RIGHT ON
11' TO LT EDGE PAVEMENT
 S.L.M. 416+53

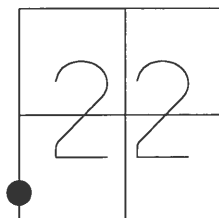

GRID: NORTHING: 688385.812 EASTING: 1605862.383

RECORD:
 FD RR SPIKE
 1" DOWN
 8/5/91
 SET MAG/WASHER
 11/26/02, DCH
 FD MAG/WASHER
 REFD23
 6/20/16, JFO
 UNCOVERED
 7/17/17, JFO

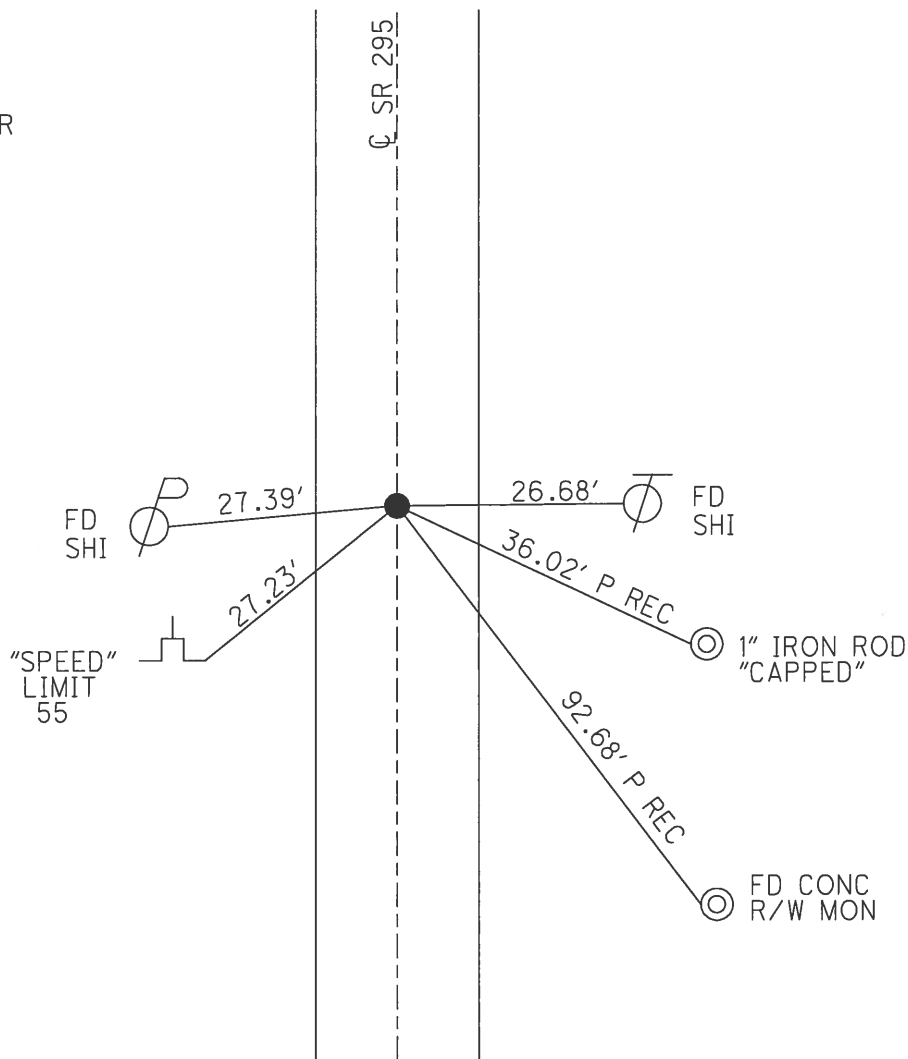

O.D.O.T. DISTRICT 2 SURVEY OFFICE (USE ONLY)

PERSONNEL

REFERENCE NO.

24

SHEET

33

OF

45

NOTES

HOMAN

DATE

9/9/02

ROUTE

SR 295

H.C.

HOMAN

WEATHER

SUNNY

COUNTY

LUCAS

R.C.

BROWN

TEMP.

85°

TOWNSHIP

SWANTON

SECTION

22

T 7 N

R 9 E

TYPE MONUMENT

P.K. NAIL

~~ON SURFACE~~ - BELOW

3"


LEFT - CL PAV'T - RIGHT

ON

11' TO LT EDGE PAVEMENT

S.L.M.

419+25

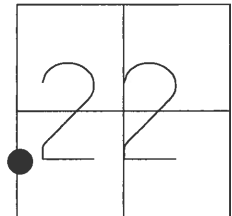

GRID: NORTHING:

688658.211

EASTING:

1605864.738

RECORD:

SET MAG/WASHER

11/26/02, DCH


FD MAG/WASHER

REF24

6/20/16, JFO

UNCOVERED

7/17/17, JFO

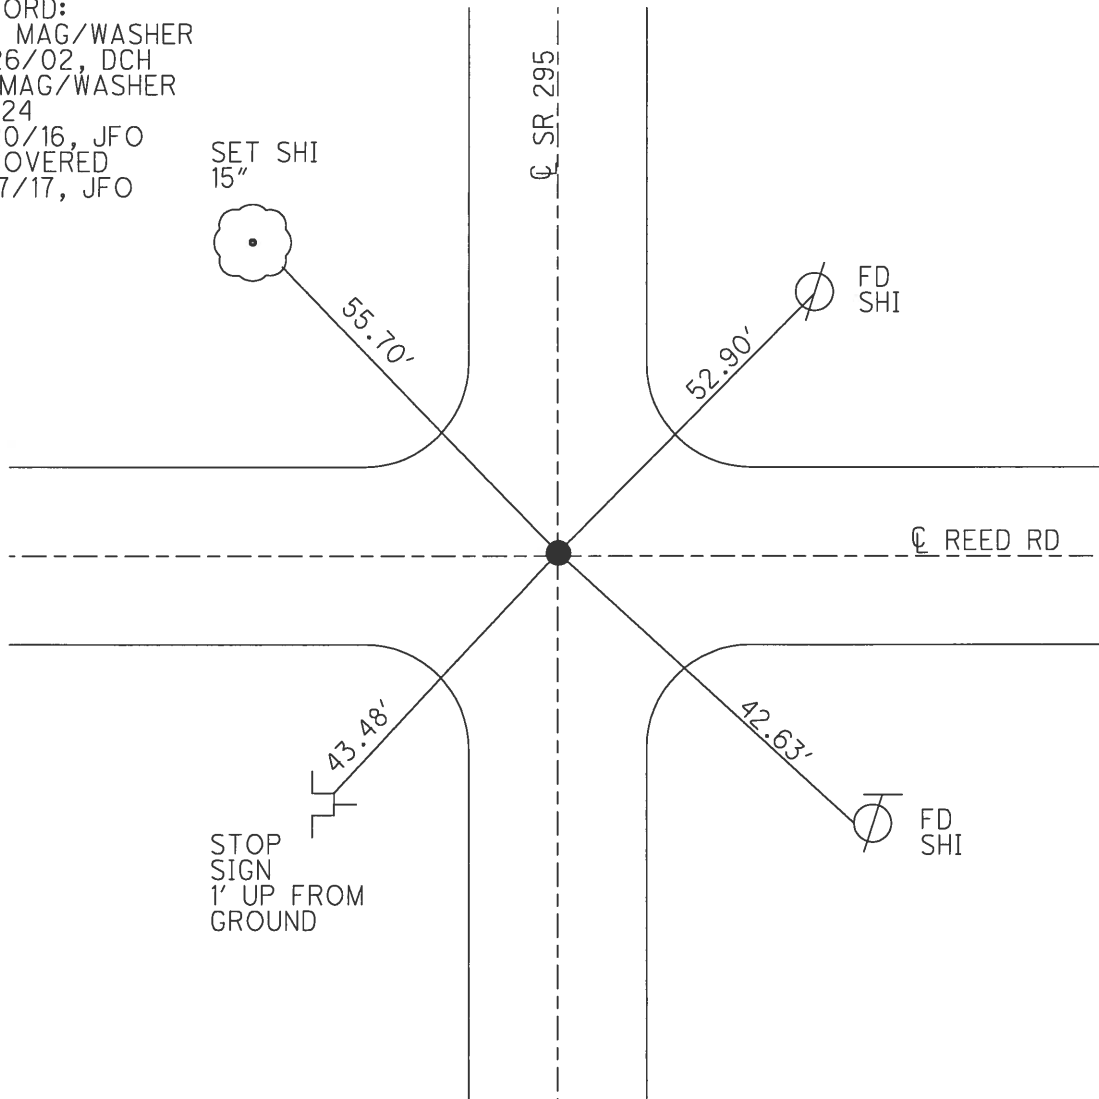

O.D.O.T. DISTRICT 2 SURVEY OFFICE (USE ONLY)

PERSONNEL _____ REFERENCE NO. 24 A SHEET 34 OF 45
NOTES HOMAN DATE 9/9/02 ROUTE SR 295
H.C. HOMAN WEATHER SUNNY COUNTY LUCAS
R.C. BROWN TEMP. 88° TOWNSHIP SWANTON
SECTION 22
T 7 N R 9 E

TYPE MONUMENT P.K. NAIL


ON SURFACE - ~~BELOW~~ ON

~~LEFT~~ - C PAV'T - RIGHT .5'


11' TO LT EDGE PAVEMENT

S.L.M. 422+36 @ 8 MILE MARKER

GRID: NORTHING: 688967.566 EASTING: 1605867.610

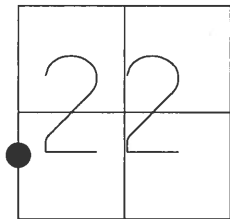

RECORD:
SET MAG/WASHER
11/26/02, DCH
FD MAG/WASHER
REFA24
6/20/16, JFO
UNCOVERED
7/17/17, JFO

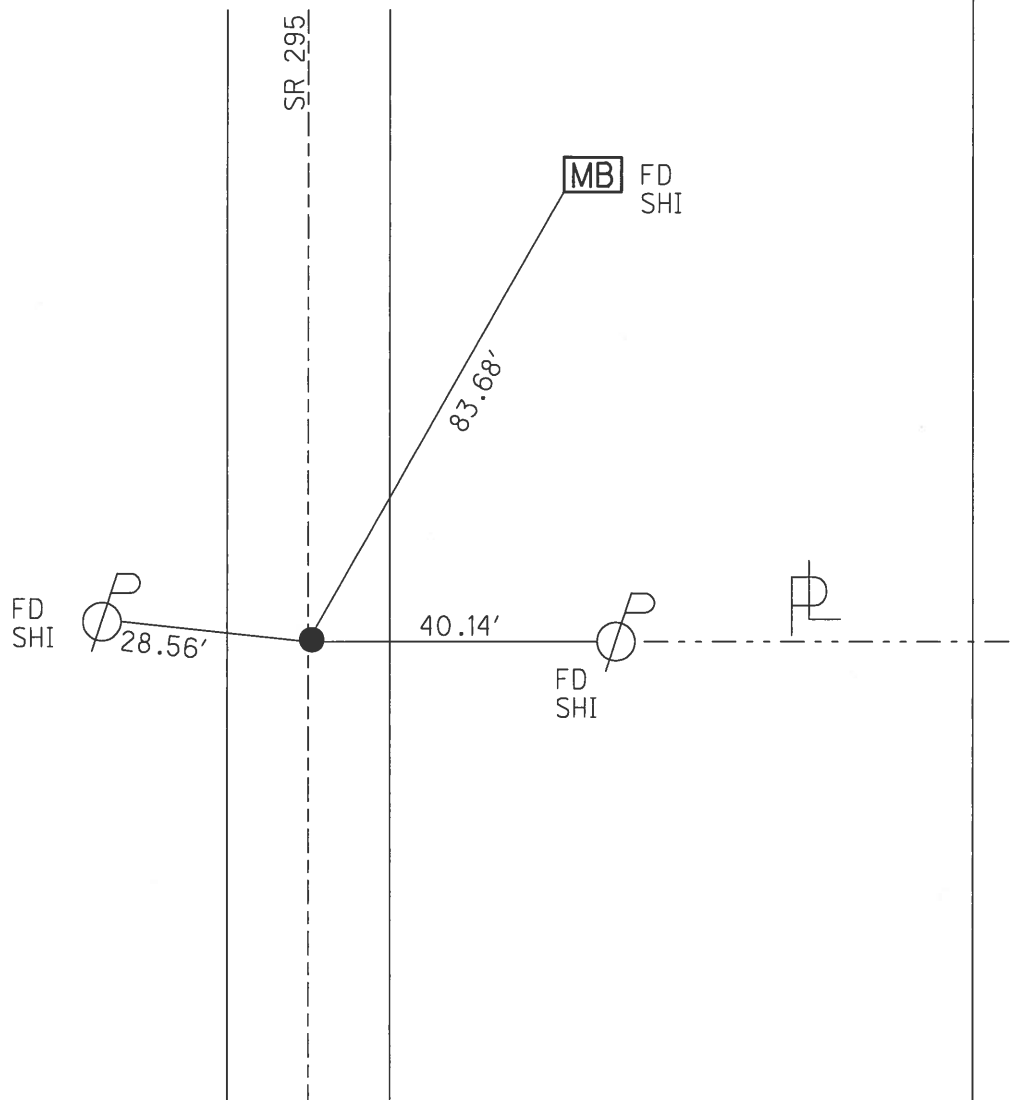

O.D.O.T. DISTRICT 2 SURVEY OFFICE (USE ONLY)

PERSONNEL _____ REFERENCE NO. 24 B SHEET 35 OF 45
NOTES RHOADES DATE 6/21/16 ROUTE SR 295
H.C. O'DONNELL WEATHER WINDY COUNTY LUCAS
R.C. RHOADES TEMP. 78° TOWNSHIP SWANTON
KEFFER SECTION 22
T 7 N R 9 E

TYPE MONUMENT LG.R.R.SPIKE


~~ON SURFACE~~ - BELOW 4"

~~LEFT~~ - Q PAV'T - RIGHT 1'


12' TO LT EDGE PAVEMENT

S.L.M. 425+45

GRID: NORTHING: 689276.886 EASTING: 1605870.504

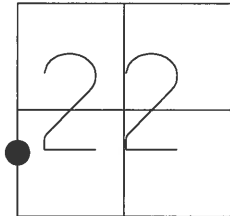

RECORD:
SET MAG/WASHER
11/26/02, DCH
FD LG.R.R.SPIKE
4" DOWN
REFB24
6/21/16, JFO
SET MAG/WASHER
NEWREFB24
7/27/17, JFO

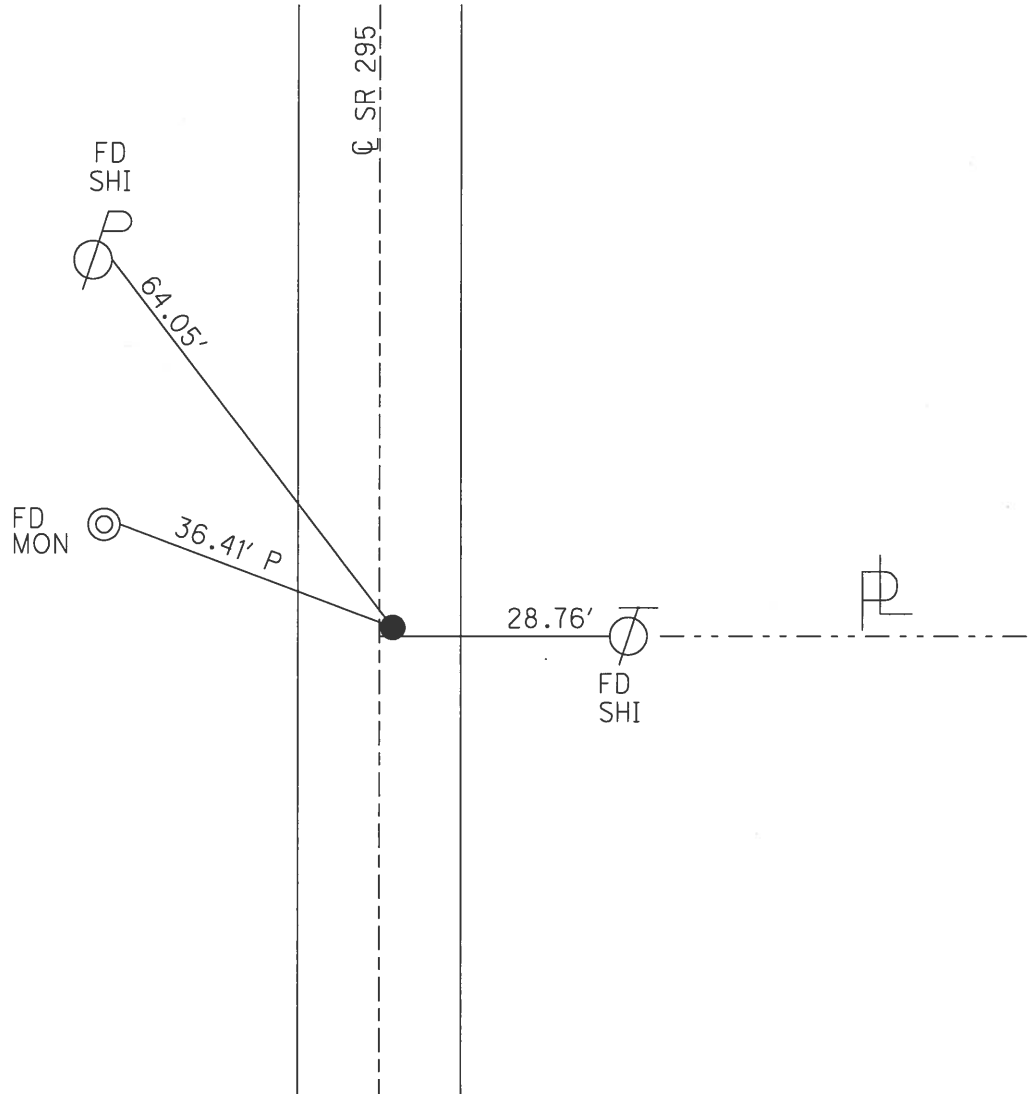

O.D.O.T. DISTRICT 2 SURVEY OFFICE (USE ONLY)

PERSONNEL

REFERENCE NO.

24C

SHEET

36

OF

45

NOTES

HOMAN

DATE

9/9/02

ROUTE

SR 295

H.C.

HOMAN

WEATHER

SUNNY

COUNTY

LUCAS

R.C.

BROWN

TEMP.

90°

TOWNSHIP

SWANTON

SECTION

22

T 7 N R 9 E

TYPE MONUMENT P.K. NAIL



ON SURFACE - ~~BELOW~~ ON

~~LEFT~~ - C PAV'T - RIGHT .5'

11' TO LT EDGE PAVEMENT

S.L.M. 428+54


GRID: NORTHING: 689586.369 EASTING: 1605873.331

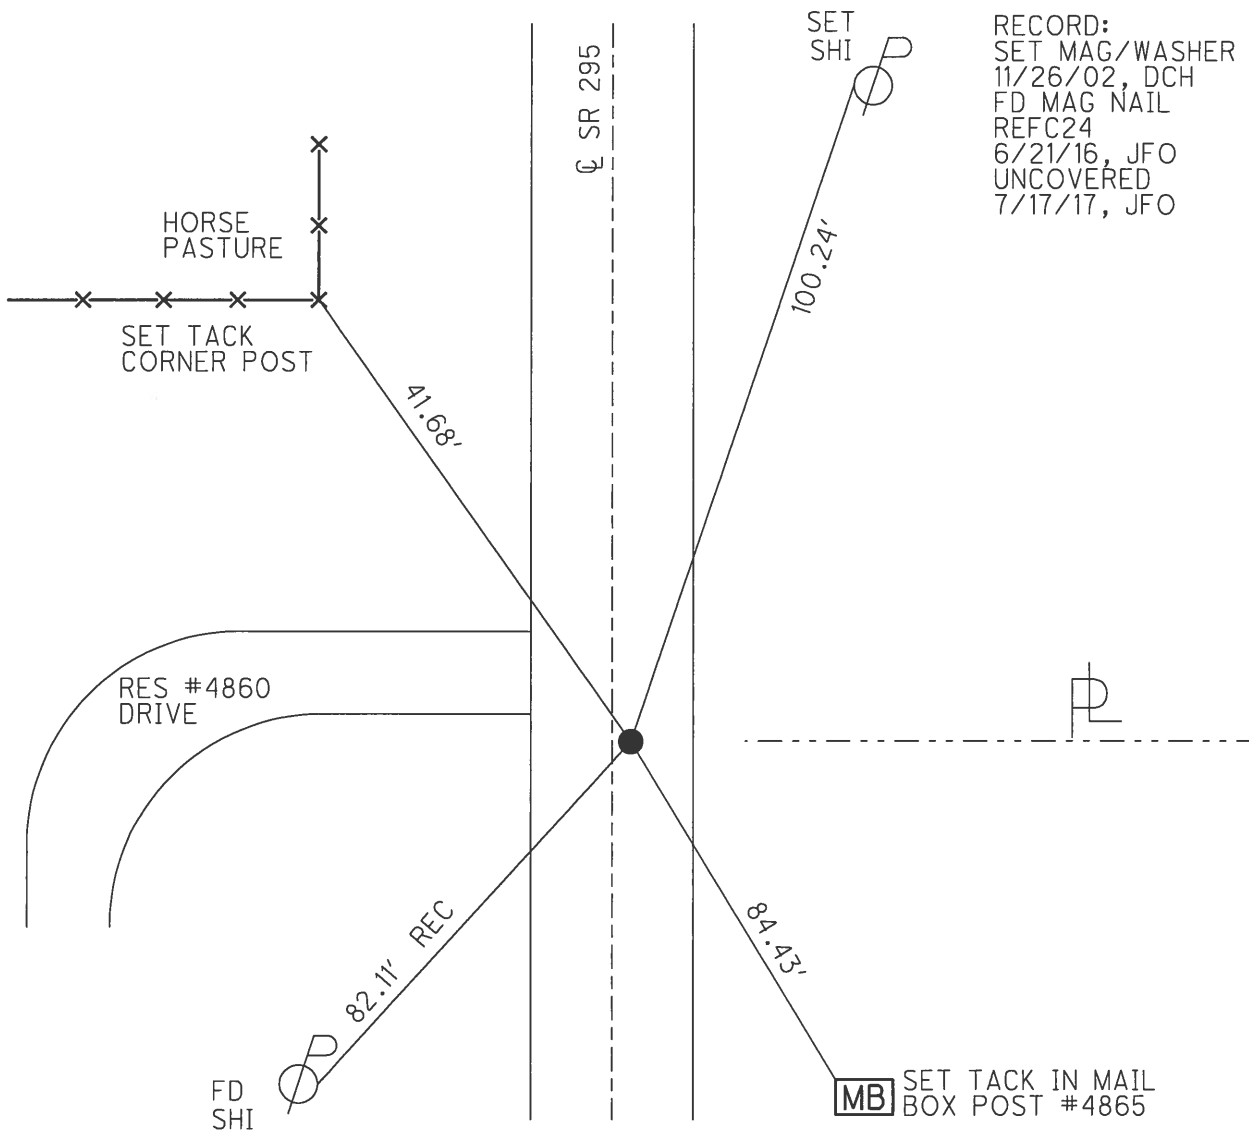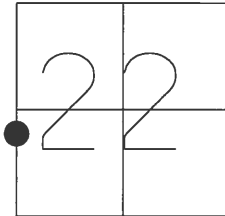


O.D.O.T. DISTRICT 2 SURVEY OFFICE (USE ONLY)

PERSONNEL	REFERENCE NO. <u>25</u>	SHEET <u>37</u> OF <u>45</u>
NOTES	DATE <u>9/9/02</u>	ROUTE <u>SR 295</u>
H.C. <u>HOMAN</u>	WEATHER <u>SUNNY</u>	COUNTY <u>LUCAS</u>
R.C. <u>BROWN</u>	TEMP. <u>90°</u>	TOWNSHIP <u>SWANTON</u>
		SECTION <u>22</u>
		T <u>7</u> N R <u>9</u> E

TYPE MONUMENT P.K. NAIL
 ON SURFACE - ~~BELOW~~ ON
~~LEFT~~ - Q PAV'T - RIGHT 1.5'
11' TO LT EDGE PAVEMENT
 S.L.M. 432+54

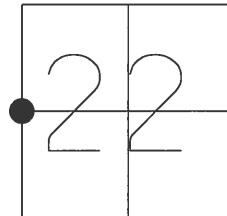


GRID: NORTHING: 689986.352 EASTING: 1605876.833

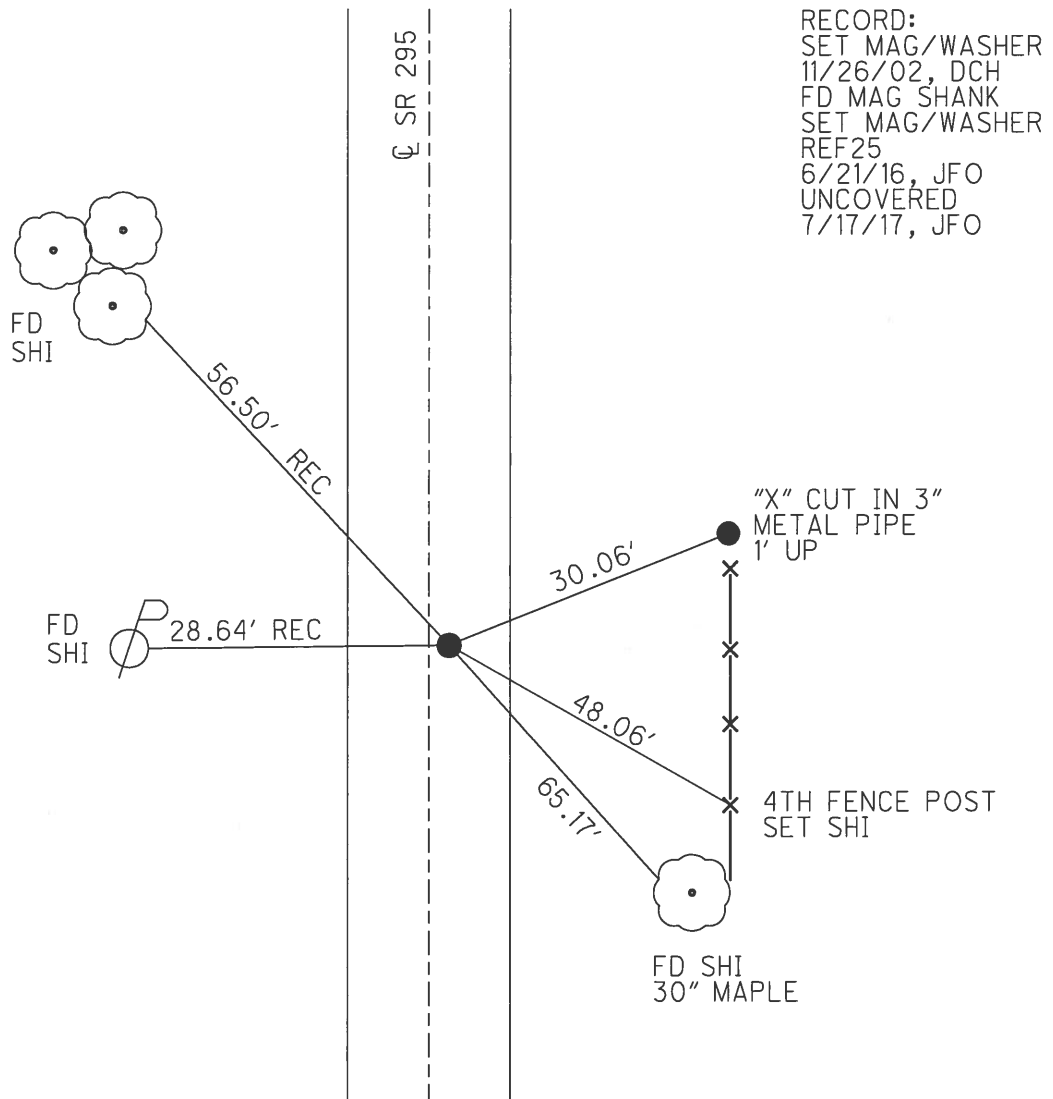


O.D.O.T. DISTRICT 2 SURVEY OFFICE (USE ONLY)

PERSONNEL _____ REFERENCE NO. 26 SHEET 38 OF 45
NOTES HOMAN DATE 9/9/02 ROUTE SR 295
H.C. HOMAN WEATHER SUNNY COUNTY LUCAS
R.C. BROWN TEMP. 90° TOWNSHIP SWANTON
SECTION 22
T 7 N R 9 E

TYPE MONUMENT P.K. NAIL
ON SURFACE - ~~BELOW~~ ON
LEFT - CL PAV'T - RIGHT ON
11' TO LT EDGE PAVEMENT
S.L.M. 445+67

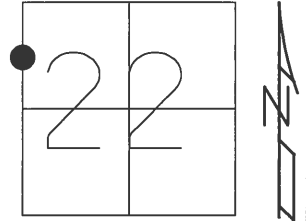

GRID: NORTHING: 691299.408 EASTING: 1605885.095

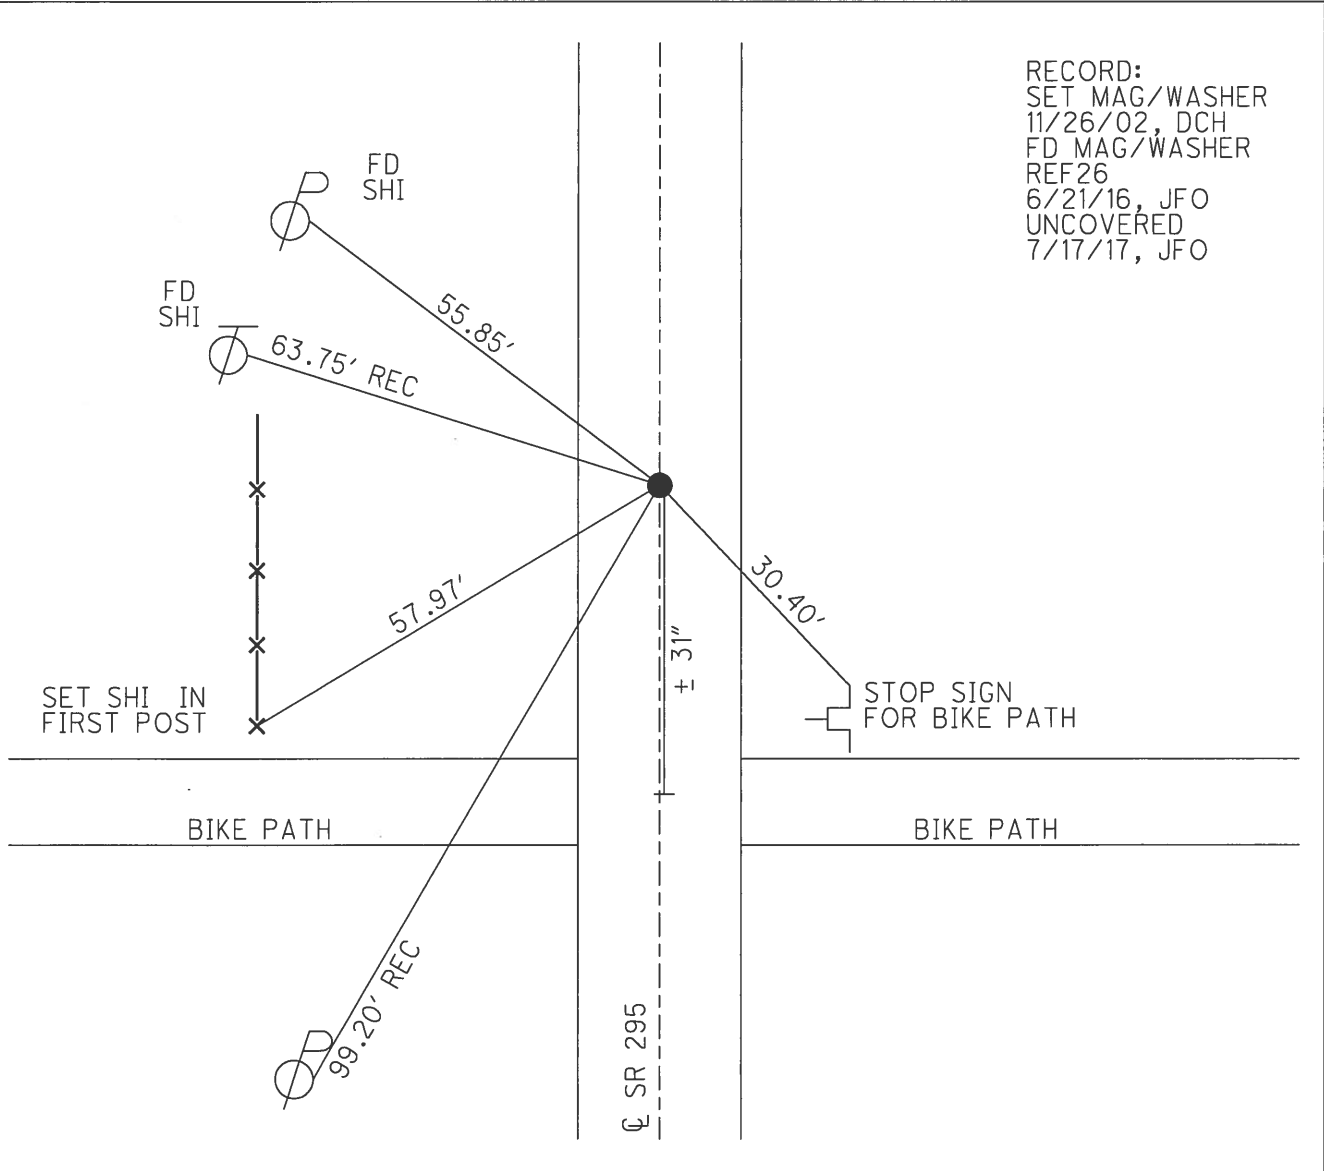

O.D.O.T. DISTRICT 2 SURVEY OFFICE (USE ONLY)

PERSONNEL

REFERENCE NO. 27

SHEET 39 OF 45


NOTES BROWN
H.C. HOMAN
R.C. BROWN

DATE 9/9/02
WEATHER SUNNY
TEMP. 90°


ROUTE SR 295
COUNTY LUCAS
TOWNSHIP SWANTON
SECTION 15
T 7 N R 9 E

TYPE MONUMENT P.K. NAIL
ON SURFACE - ~~BELOW~~ ON
LEFT - CL PAV'T - ~~RIGHT~~ ON
11' TO LT EDGE PAVEMENT
S.L.M. 458+82

GRID: NORTHING: 692614.038 EASTING: 1605893.288

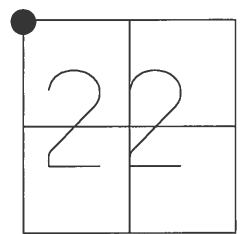

RECORD:
SET MAG/WASHER
11/26/02, DCH
FD MAG/WASHER
REF 27
6/21/16, JFO
UNCOVERED
7/27/17, JFO

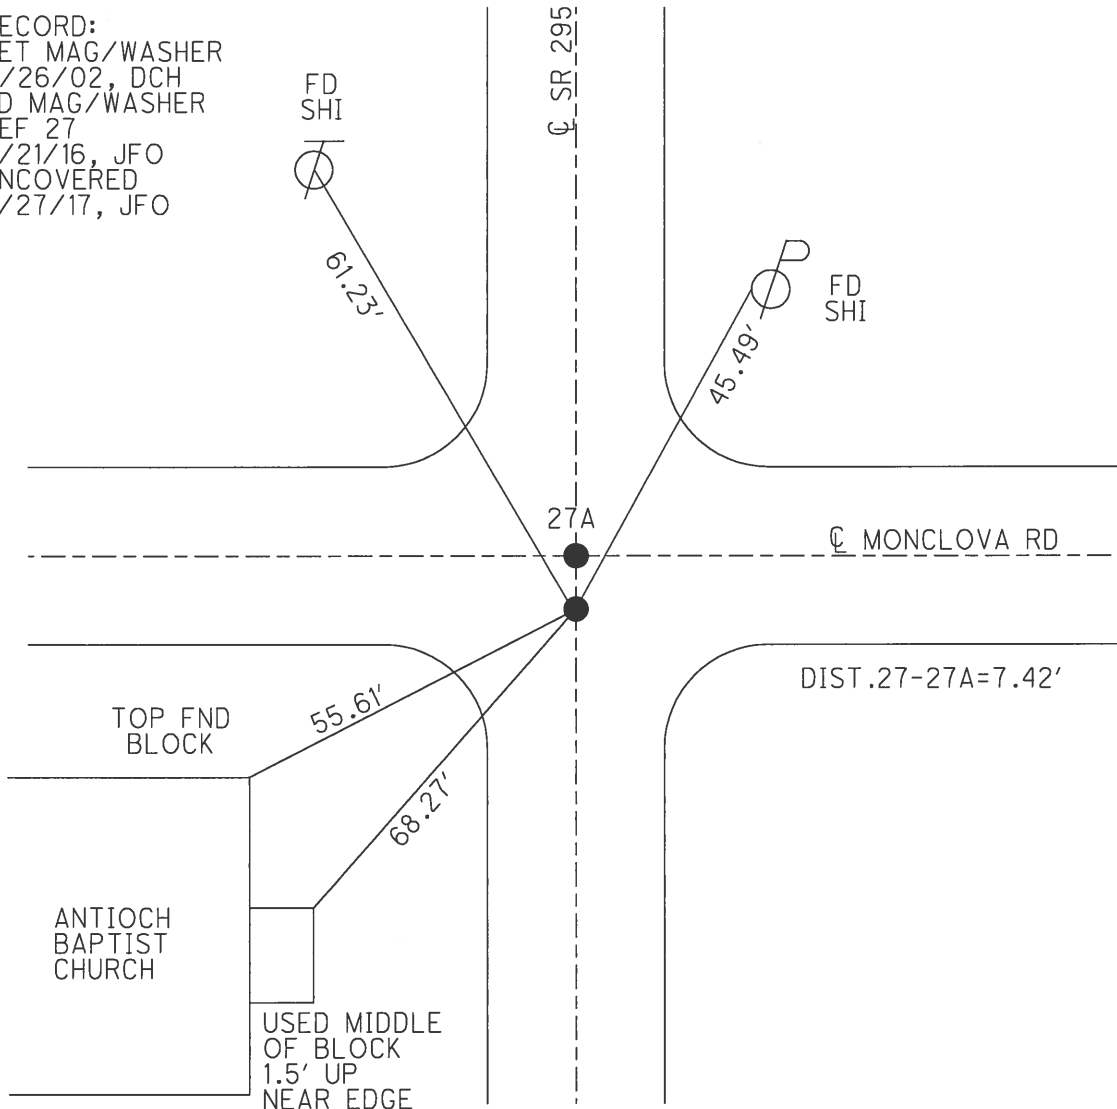

O.D.O.T. DISTRICT 2 SURVEY OFFICE (USE ONLY)

PERSONNEL

REFERENCE NO.

27 A SHEET 40 OF 45

NOTES BROWN

DATE 9/9/02

ROUTE SR 295

H.C. HOMAN

WEATHER SUNNY

COUNTY LUCAS

R.C. BROWN

TEMP. 90°

TOWNSHIP SWANTON

SECTION 15

T 7 N R 9 E

TYPE MONUMENT P.K.NAIL


ON SURFACE - ~~BELOW~~ ON

LEFT - $\odot$ PAV'T - RIGHT ON


11' TO LT EDGE PAVEMENT

S.L.M. 458+89

GRID: NORTHING: EASTING:

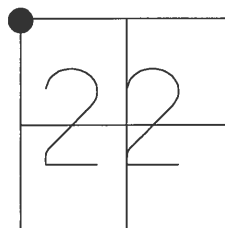

RECORD:
SET MAG/WASHER
11/26/02, DCH
D.N.F.
6/21/16, JFO

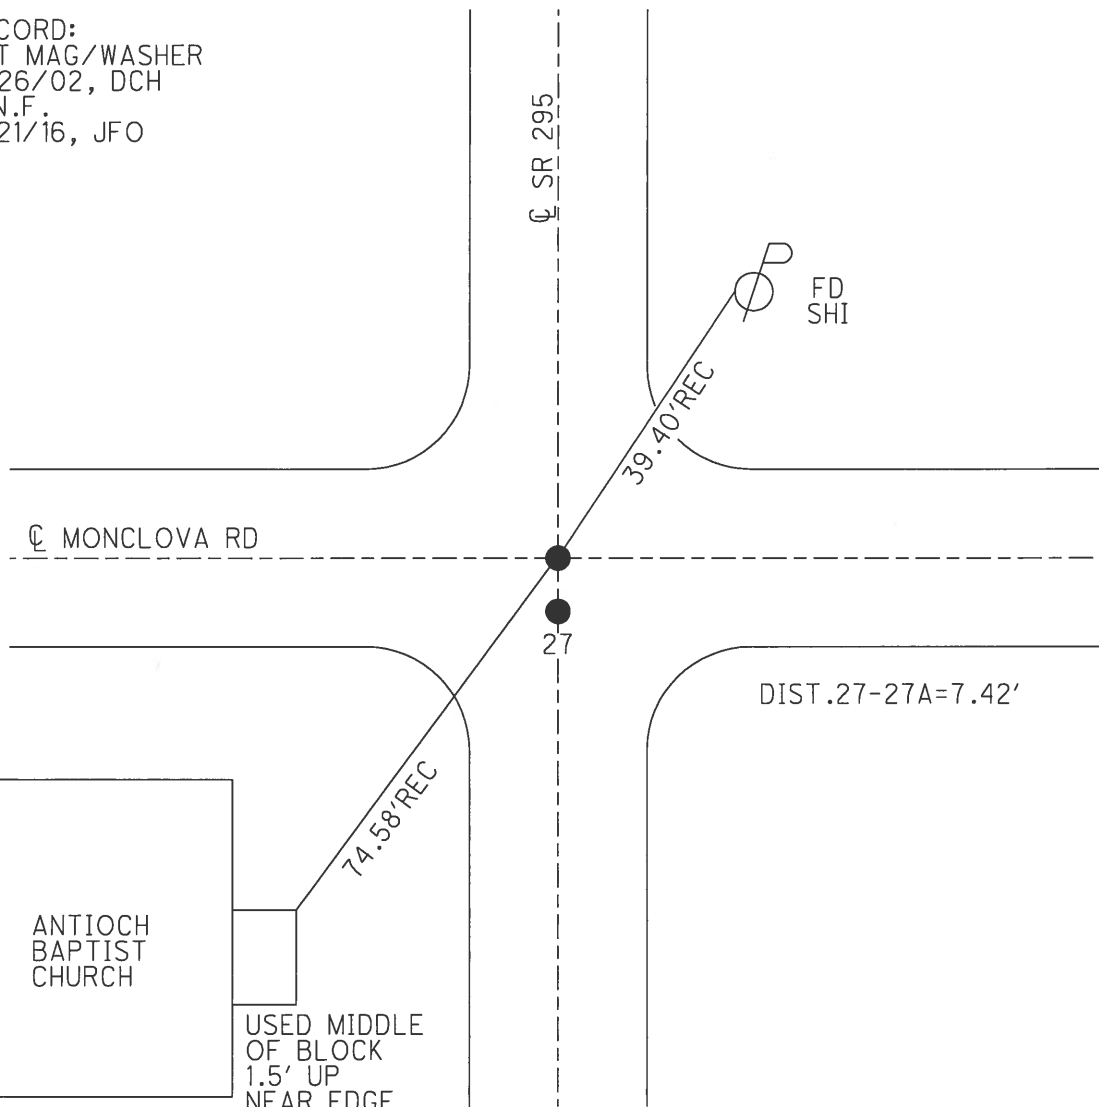


O.D.O.T. DISTRICT 2 SURVEY OFFICE (USE ONLY)

PERSONNEL _____ REFERENCE NO. 27 B SHEET 41 OF 45


NOTES BROWN DATE 9/9/02 ROUTE SR 295
H.C. HOMAN WEATHER SUNNY COUNTY LUCAS
R.C. BROWN TEMP. 90° TOWNSHIP SWANTON
SECTION 15
T 7 N R 9 E

TYPE MONUMENT P.K. NAIL
ON SURFACE - ~~BELOW~~ ON
LEFT - Q PAV'T - ~~RIGHT~~ 1'
10' TOLT EDGE PAVEMENT
S.L.M. 472+09

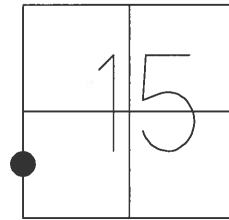

GRID: NORTHING: 693940.698 EASTING: 1605917.807

RECORD:
SET MAG/WASHER
11/26/02, DCH
FD MAG NAIL
REFB27
6/21/16, JFO
UNCOVERED
7/27/17, JFO

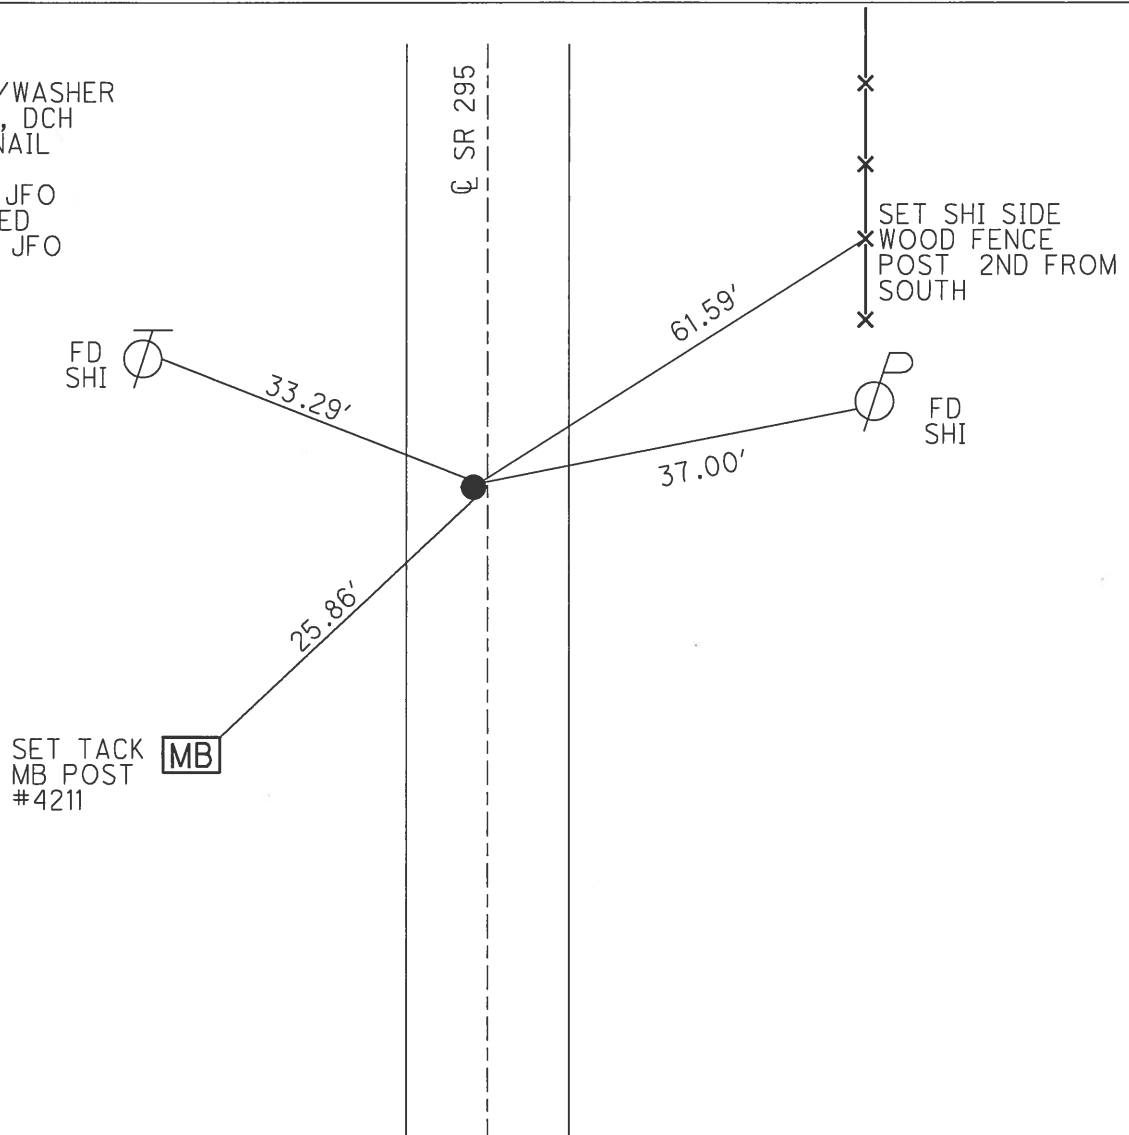

O.D.O.T. DISTRICT 2 SURVEY OFFICE (USE ONLY)

PERSONNEL

REFERENCE NO. 28

SHEET 42 OF 45

NOTES RHOADES

DATE 9/9/02

ROUTE SR 295

H.C. O'DONNELL

WEATHER SUNNY

COUNTY LUCAS

R.C. HELDMAN

TEMP. 87°

TOWNSHIP SWANTON

SECTION 15

T 7 N R 9 E

TYPE MONUMENT R.R.SPIKE


~~ON SURFACE~~ - BELOW 3"

LEFT - Q PAV'T - ~~RIGHT~~ 1.5'


9.5' TO LT EDGE PAVEMENT

S.L.M. 485+36

GRID: NORTHING: 695267.287 EASTING: 1605942.347

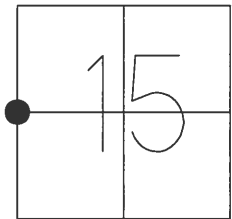

RECORD:
SET MAG/WASHER
DCH, 11/26/02
FD R.R.SPIKE
3" DOWN
6/21/16, JFO
UNCOVERED
7/27/17, JFO

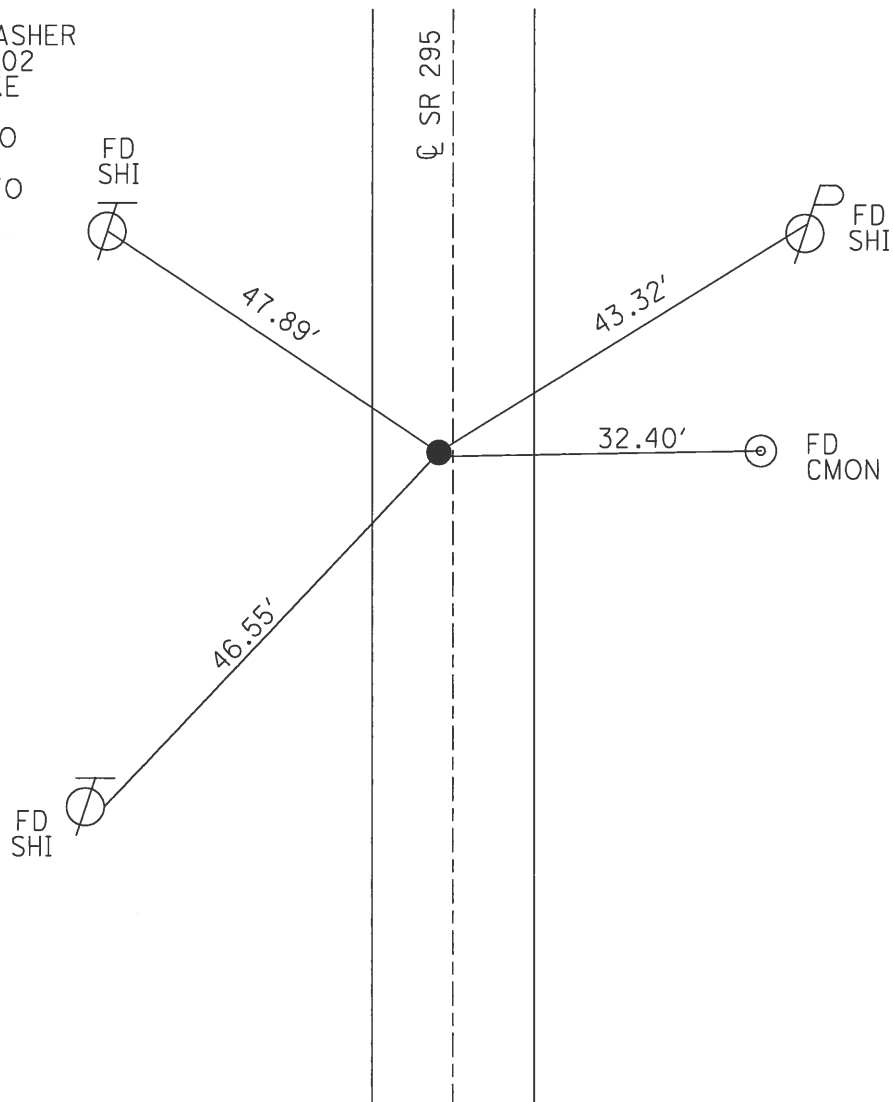


O.D.O.T. DISTRICT 2 SURVEY OFFICE (USE ONLY)


PERSONNEL _____ REFERENCE NO. 28 A SHEET 43 OF 45
NOTES BROWN DATE 9/9/02 ROUTE SR 295
H.C. HOMAN WEATHER SUNNY COUNTY LUCAS
R.C. BROWN TEMP. 87° TOWNSHIP SWANTON
SECTION 15
T 7 N R 9 E

TYPE MONUMENT P.K. SHANK
ON SURFACE - ~~BELOW~~ ON _____
LEFT - ℄ PAV'T - ~~RIGHT~~ 1.2'
9.8' TO LT EDGE PAVEMENT
S.L.M. 495+36

GRID: NORTHING: 696266.773 EASTING: 1605952.037

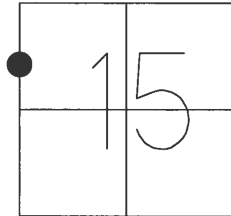

RECORD:
MAG/WASHER
11/26/02, DCH
FD MAG NAIL
REFA28
6/22/16, JFO
FD MAG SHANK
SET MAG/WASHER
7/27/17, JFO

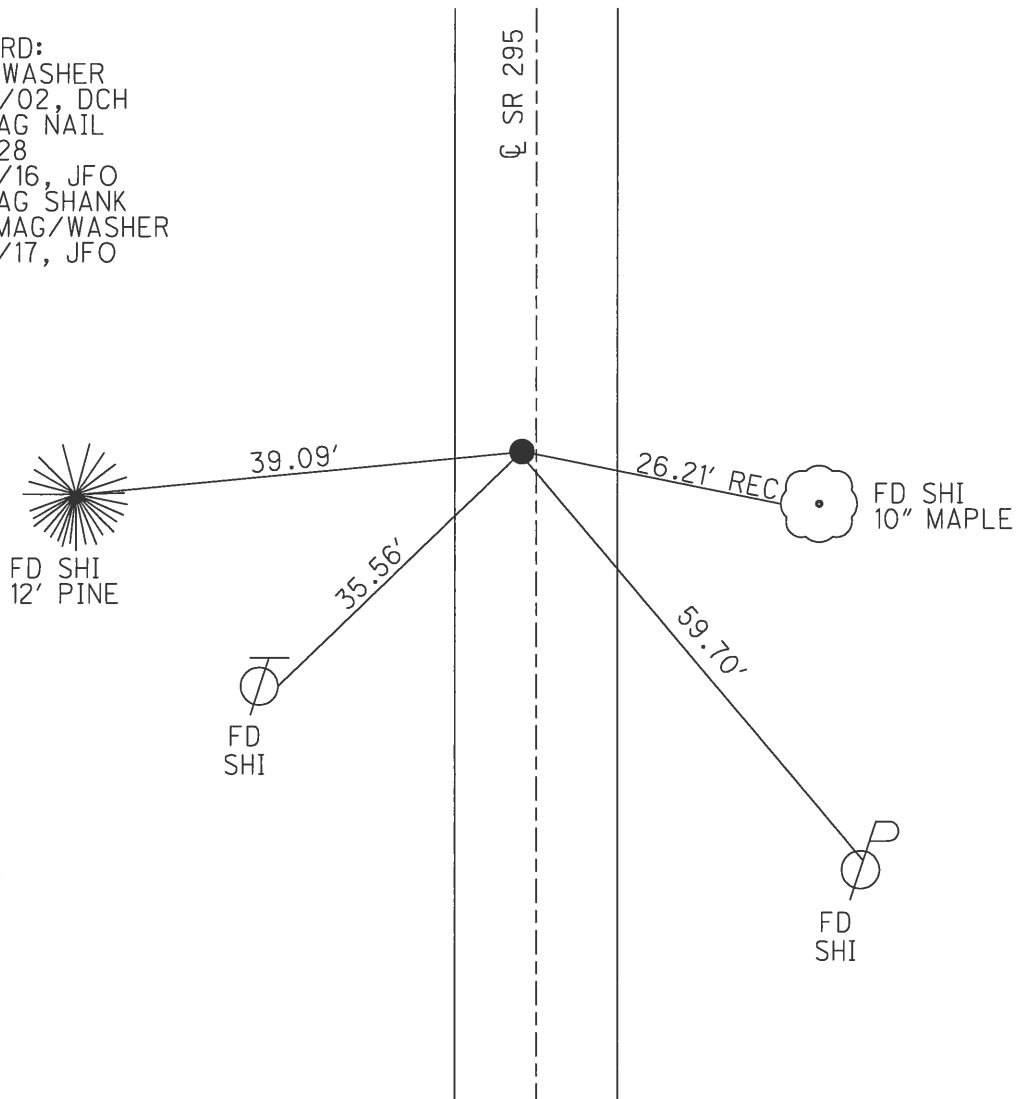

O.D.O.T. DISTRICT 2 SURVEY OFFICE (USE ONLY)

PERSONNEL

REFERENCE NO.

28 B

SHEET

44

OF

45

NOTES

BROWN

DATE

9/9/02

ROUTE

SR 295

H.C.

HOMAN

WEATHER

SUNNY

COUNTY

LUCAS

R.C.

BROWN

TEMP.

87°

TOWNSHIP

SWANTON

SECTION

15

T 7 N R 9 E


TYPE MONUMENT P.K. SHANK

ON SURFACE - ~~BELOW~~ ON

LEFT - Q PAV'T - ~~RIGHT~~ 1'


10' TO LT EDGE PAVEMENT

S.L.M. 498+68

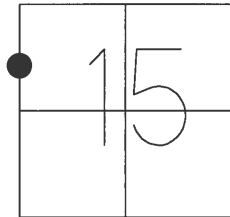

GRID: NORTHING: 696599.838 EASTING: 1605955.365

RECORD:
SET MAG/WASHER
11/26/02, DCH
FD MAG/WASHER
REFB28
6/22/16, JFO
UNCOVERED
7/27/17, JFO

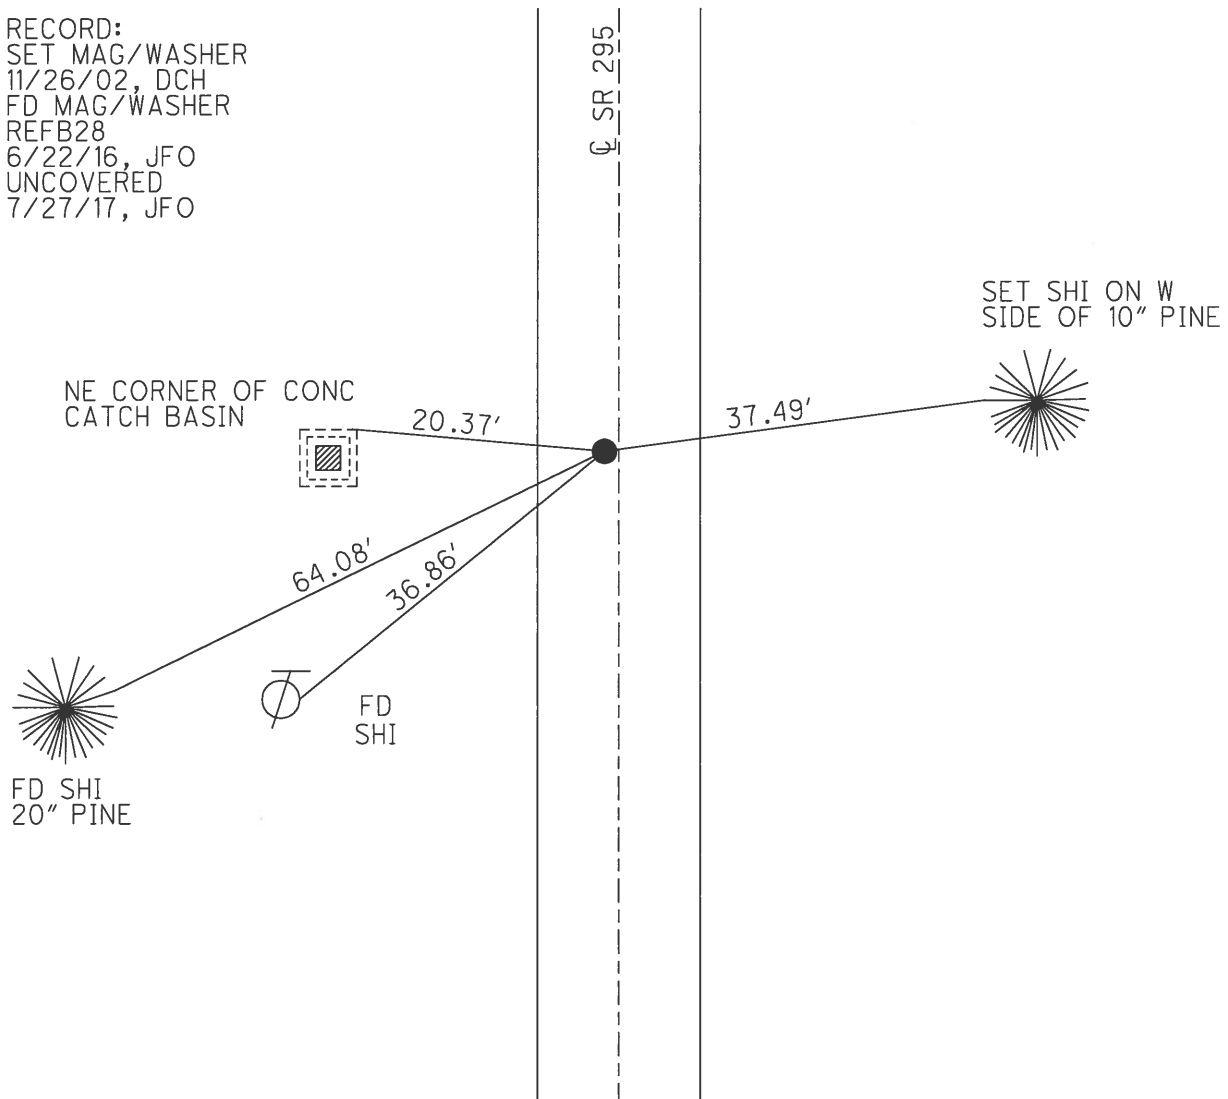

O.D.O.T. DISTRICT 2 SURVEY OFFICE (USE ONLY)

PERSONNEL

REFERENCE NO.

28 C

SHEET

45

OF

45

NOTES

STONE

DATE

4/27/82

ROUTE

SR 295

H.C.

NOUSER

WEATHER

COOL

COUNTY

LUCAS

R.C.

MICHALAK

TEMP.

50°

TOWNSHIP

SWANTON

SECTION

9

T 7 N R 9 E

TYPE MONUMENT MONBOX W/1" IPIN


ON SURFACE - ~~BELOW~~ ON

LEFT - ℄ PAV'T - RIGHT ON


- TO - EDGE PAVEMENT

S.L.M. 512+00.9

GRID: NORTHING: 697932.782 EASTING: 1605968.351

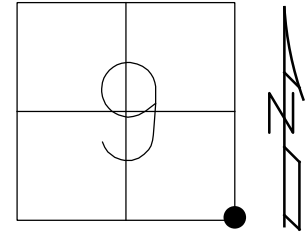

NOTE: REF 14 US 20A

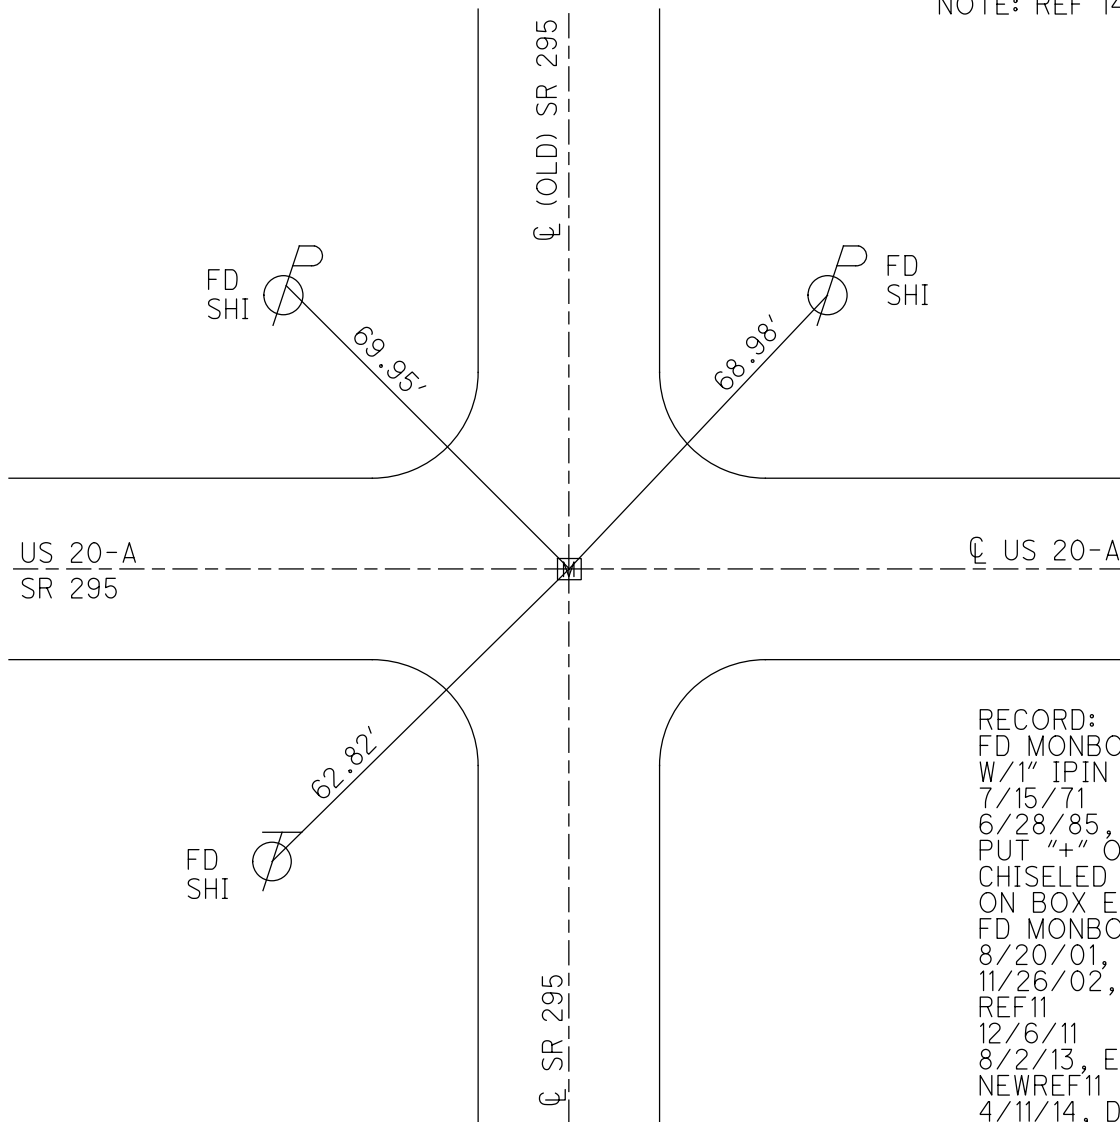

RECORD:
FD MONBOX
W/1" IPIN
7/15/71
6/28/85, IRS
PUT "+" ON LID
CHISELED MARKS
ON BOX EDGES
FD MONBOX
8/20/01, BC
11/26/02, DCH
REF11
12/6/11
8/2/13, EBW
NEWREF11
4/11/14, DCH

O.D.O.T. DISTRICT 2 SURVEY OFFICE (USE ONLY)

PERSONNEL

REFERENCE NO. 28 CA

SHEET 1 OF 9

NOTES WESTFALL

DATE 8/2/13

ROUTE SR 295

H.C. ROUSOS

WEATHER SUNNY

COUNTY LUCAS

R.C. WESTFALL

TEMP. 70°

TOWNSHIP SWANTON

KEFFER

SECTION 9

T 7 N R 9 E

TYPE MONUMENT SQ BOLT


~~ON SURFACE~~ - BELOW 1 1/2"

LEFT - ℄ PAV'T - RIGHT -

- TO - EDGE PAVEMENT

S.L.M. 525+18.9

GRID: NORTHING: 697948.754 EASTING: 1604650.413

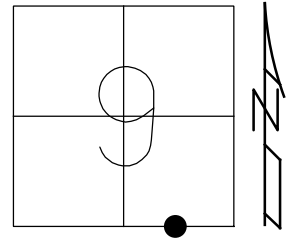

RECORD:

FD 1 1/2" SQ BOLT

3" DOWN

4/30/85

6/28/85, IRS

FD BOLT

1 1/2" DOWN

REF10

12/6/11, DCH

REF10


8/2/13, EBW

SET MAG/WASHER

NEWREF10

4/11/14, DCH

NOTE: REF 13 US 20A

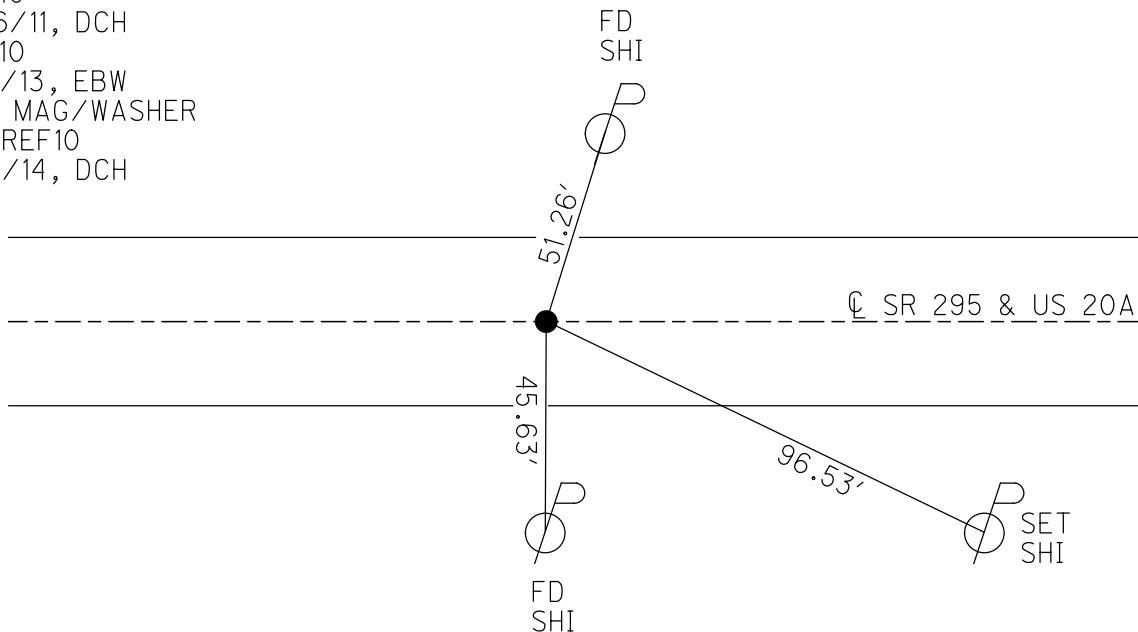

O.D.O.T. DISTRICT 2 SURVEY OFFICE (USE ONLY)

PERSONNEL

REFERENCE NO.

28 CB

SHEET

2

OF

9

NOTES

WESTFALL

DATE

8/2/13

ROUTE

SR 295

H.C.

ROUSOS

WEATHER

SUNNY

COUNTY

LUCAS

R.C.

WESTFALL

TEMP.

70°

TOWNSHIP

SWANTON

KEFFER

SECTION

9

T 7 N

R 9 E

TYPE MONUMENT

MONBOX W/ 5/8" IPIN

ON SURFACE - ~~BELOW~~


ON

LEFT - ℄ PAV'T - RIGHT -

- TO - EDGE PAVEMENT

S.L.M. 537+37.4

GRID: NORTHING: 697963.543 EASTING: 1603432.044

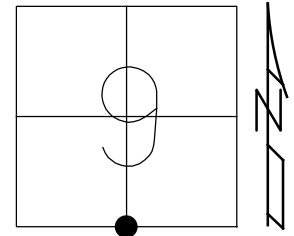

RECORD:

FD MONBOX

W/1 1/2" SQ BOLT

SET BY LUCAS CO

6/28/85, IS

FD MONBOX

REF9

12/6/11, DCH

FD MONBOX


W/ 5/8" IPIN

NEWREF9

8/2/13, EBW

4/11/14, DCH

NOTE: REF 12A US 20A

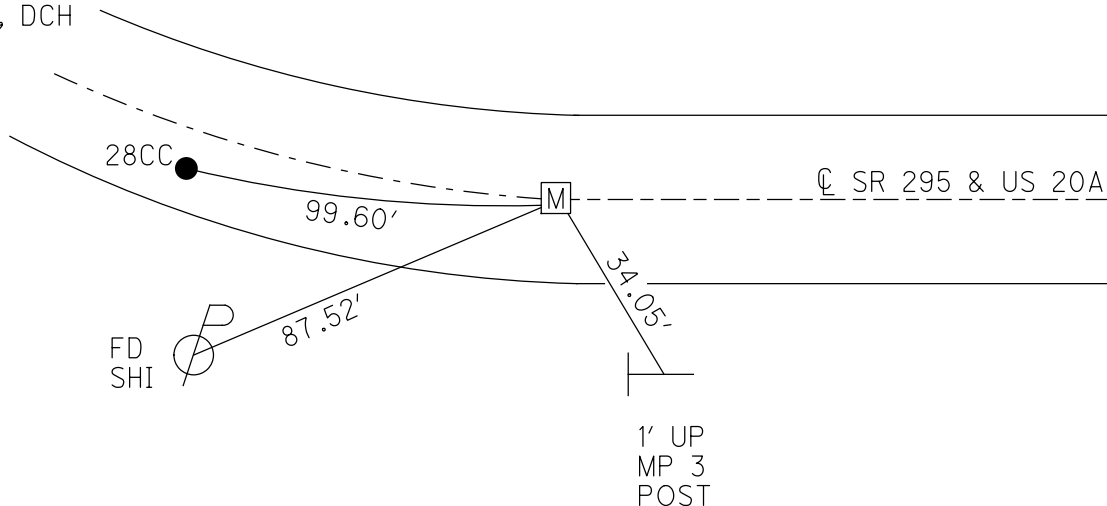

O.D.O.T. DISTRICT 2 SURVEY OFFICE (USE ONLY)

PERSONNEL _____ REFERENCE NO. 28 CC SHEET 3 OF 9

NOTES	<u>WESTFALL</u>	DATE	<u>8/2/13</u>	ROUTE	<u>SR 295</u>
H.C.	<u>ROUSOS</u>	WEATHER	<u>SUNNY</u>	COUNTY	<u>LUCAS</u>
R.C.	<u>WESTFALL</u>	TEMP.	<u>70°</u>	TOWNSHIP	<u>SWANTON</u>
	<u>KEFFER</u>			SECTION	<u>9</u>
				T <u>7</u> N	R <u>9</u> E

TYPE MONUMENT 1 1/2" SQ BOLT


~~ON SURFACE~~ - BELOW 1 1/2"

LEFT - ℄ PAV'T - RIGHT -

- TO - EDGE PAVEMENT


S.L.M. 538+37

GRID: NORTHING: 697964.710 EASTING: 1603332.463

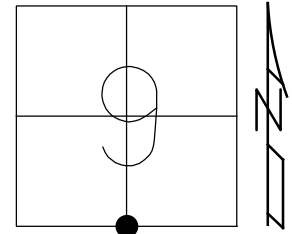

RECORD:
FD MONBOX
W/1 1/2" SQ BOLT
6/28/85, IS
FD BOLT
1 1/2" DOWN
REF8
12/6/11, DCH
SET MAG/WASHER
NEWREF8
8/2/13, EBW
4/11/14, DCH

NOTE: REF 12 US 20A

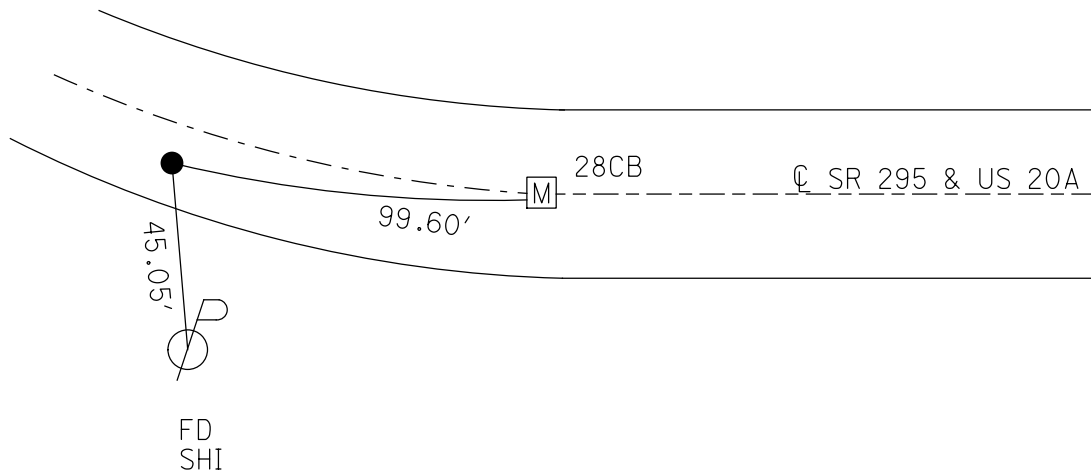

O.D.O.T. DISTRICT 2 SURVEY OFFICE (USE ONLY)

PERSONNEL

REFERENCE NO.

28 CD

SHEET

4

OF 9

NOTES

WESTFALL

DATE

8/2/13

ROUTE

SR 295

H.C.

ROUSOS

WEATHER

SUNNY

COUNTY

LUCAS

R.C.

WESTFALL

TEMP.

70°

TOWNSHIP

SWANTON

KEFFER

SECTION

9

T 7 N R 9 E

TYPE MONUMENT

MONBOX W/ 1" IPIN

ON SURFACE - ~~BELOW~~

ON


LEFT - $\odot$ PAV'T - RIGHT -

- TO - EDGE PAVEMENT

S.L.M. 558+72.9

GRID: NORTHING: 699300.745

EASTING: 1602017.285

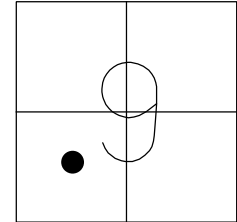

NOTE: REF 7B US 20A

RECORD:

FD MON BOX

W/1/2" IPIN


SV3986

12/6/11, DCH

NEWREFB7

8/2/13, EBW

4/11/14, DCH

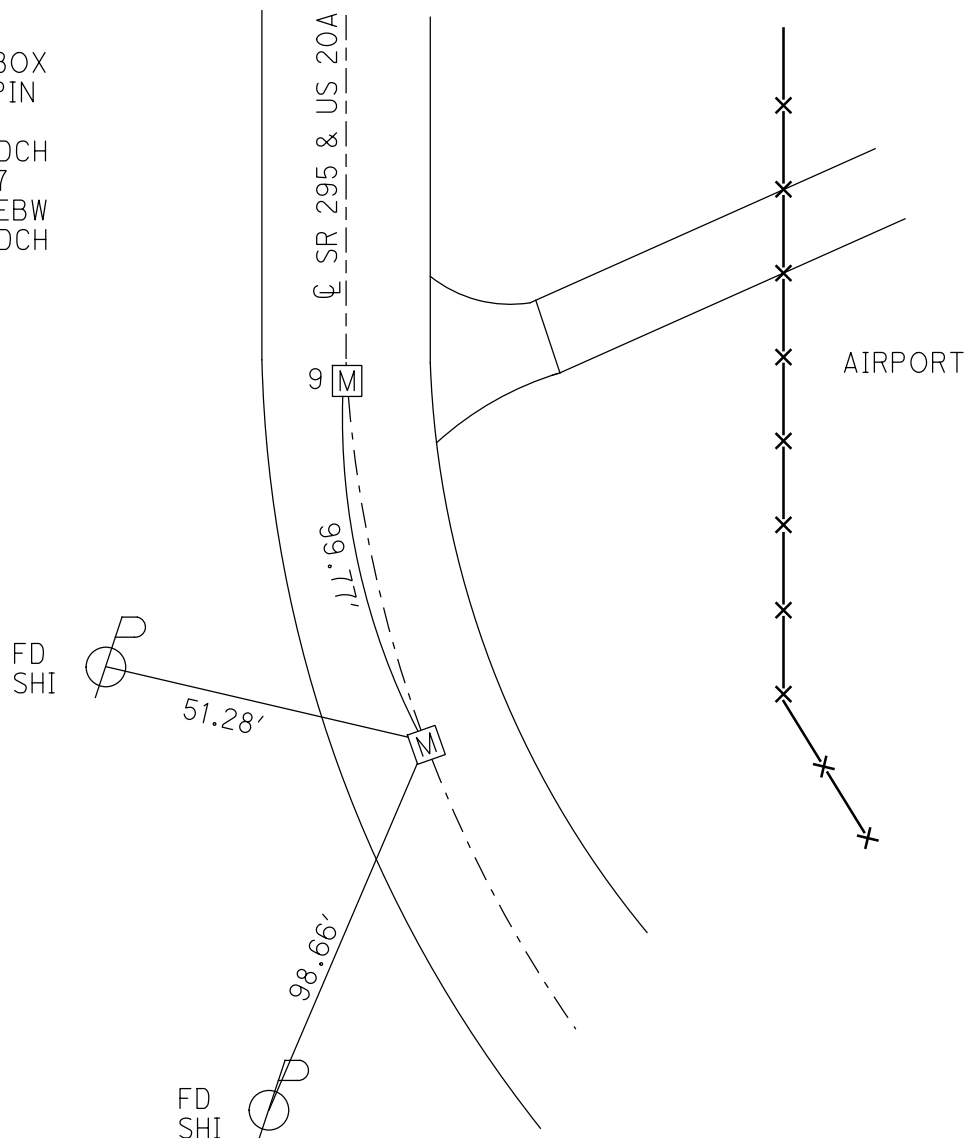


O.D.O.T. DISTRICT 2 SURVEY OFFICE (USE ONLY)

PERSONNEL	REFERENCE NO. <u>28 CE</u>	SHEET <u>5</u> OF <u>9</u>
NOTES <u>WESTFALL</u>	DATE <u>8/2/13</u>	ROUTE <u>SR 295</u>
H.C. <u>ROUSOS</u>	WEATHER <u>SUNNY</u>	COUNTY <u>LUCAS</u>
R.C. <u>WESTFALL</u>	TEMP. <u>70°</u>	TOWNSHIP <u>SWANTON</u>
<u>KEFFER</u>		SECTION <u>9</u>
		T <u>7</u> N R <u>9</u> E

TYPE MONUMENT MONBOX W/1" IPIN
 ON SURFACE - ~~BELOW~~ ON
 LEFT - Q PAV'T - RIGHT -
- TO - EDGE PAVEMENT
 S.L.M. 559+72.7

GRID: NORTHING: 699398.513 EASTING: 1602016.865

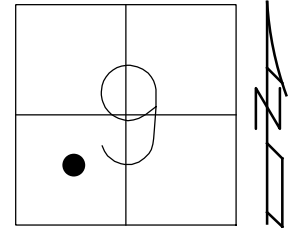

RECORD:
 FD MON BOX
 W/1" IPIN
 SV3985
 12/6/11, DCH
 NEWREFA7
 8/2/13, EBW
 4/11/14, DCH

SET
SHI

FD
SHI

141.32'

51.28'

Q SR 295 & US 20A

11.66


10

55.15'

SET P.K. NAIL
IN ASPHALT DR.

NOTE: REF 7A US 20A

AIRPORT

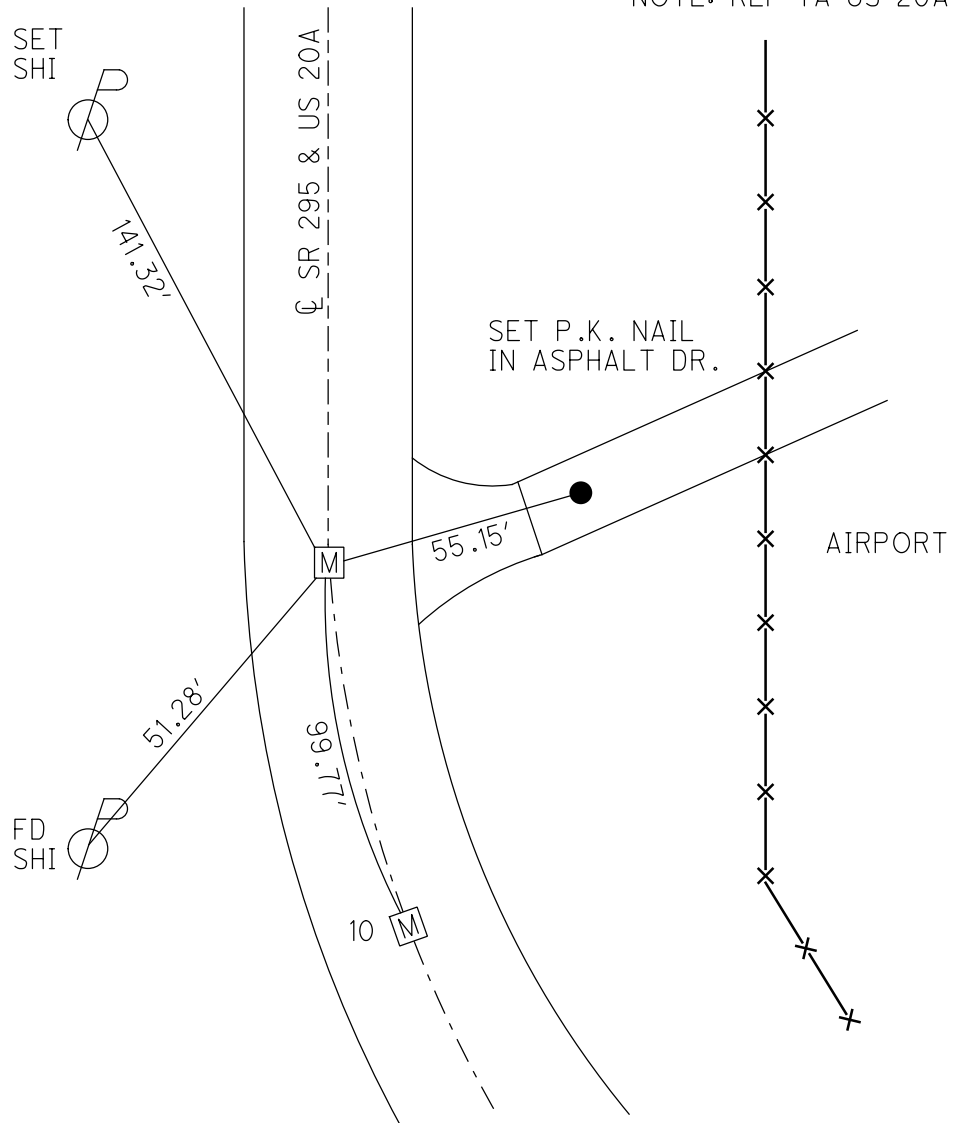

O.D.O.T. DISTRICT 2 SURVEY OFFICE (USE ONLY)

PERSONNEL

REFERENCE NO.

28 CF

SHEET

6

OF 9

NOTES

WESTFALL

DATE

8/2/13

ROUTE

SR 295

H.C.

ROUSOS

WEATHER

SUNNY

COUNTY

LUCAS

R.C.

WESTFALL

TEMP.

70°

TOWNSHIP

SWANTON

KEFFER

SECTION

9

T 7 N R 9 E

TYPE MONUMENT

2" SQ. BOLT

~~ON SURFACE~~ - BELOW


2"

LEFT - $\odot$ PAV'T - RIGHT -


- TO - EDGE PAVEMENT

S.L.M. 571+54.85

GRID: NORTHING: 700580.729 EASTING: 1602019.061

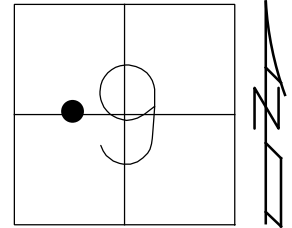

NOTE: REF 7 US 20A

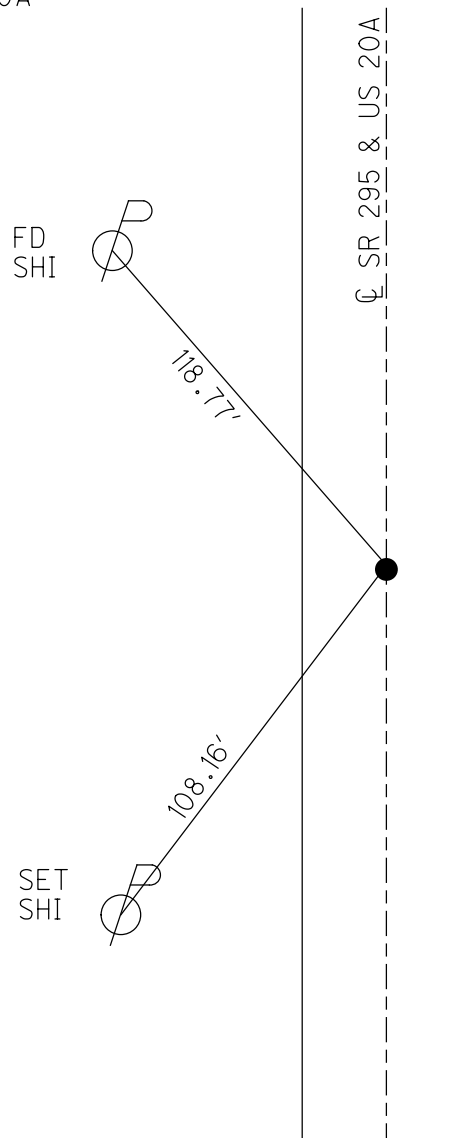


RECORD:
FD SQ BOLT
3" DEEP
6/28/85, IRS
FD SQ BOLT
REF7
12/6/11, DCH
SET MAG/WASHER
NEWREF7
8/2/13, EBW
4/11/14, DCH

RECORD:
FD R.R.SPIKE
1" DOWN
9/25/80, SMITH
FD R.R.SPIKE
1" DOWN
6/15/03
SET MAG/WASHER
1/13/04
FD MAG NAIL
REF6
12/6/11, DCH
FD R.R.SPIKE
8" DOWN
7/29/16, DCH
SET MAG/WASHER
NEWREF5
10/05/16, DCH

O.D.O.T. DISTRICT 2 SURVEY OFFICE (USE ONLY)

PERSONNEL	REFERENCE NO. <u>28 E</u>	SHEET <u>8</u> OF <u>9</u>
NOTES	DATE <u>6/15/03</u>	ROUTE <u>SR 295</u>
H.C. <u>HOMAN</u>	WEATHER <u>FAIR</u>	COUNTY <u>LUCAS</u>
R.C. <u>RYALL</u>	TEMP. <u>75°F</u>	TOWNSHIP <u>SWANTON</u>
		SECTION <u>9</u>
		T <u>7</u> N R <u>5</u> E


TYPE MONUMENT MAG NAIL
 ON SURFACE - ~~BELOW~~ ON
~~LEFT~~ - Q PAV'T - RIGHT 18.8'
8.2' TO S EDGE PAVEMENT
 S.L.M. 597+93

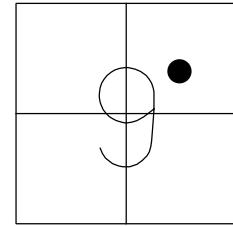

GRID: NORTHING: 701827.120 EASTING: 1603598.047

RECORD: P.I.
 FD MON BOX
 W/ 1" IPIN
 6/15/03, DCH
 SET MAG/WASHER
 1/13/04, DCH
 FD MAG/WASHER
 REF7
 4/6/11, KPM
 FD MAG NAIL
 REF7
 7/29/16
 SET P.K./WASHER
 NEWREF7
 10/05/16

NOTE: REF 7 SR 2

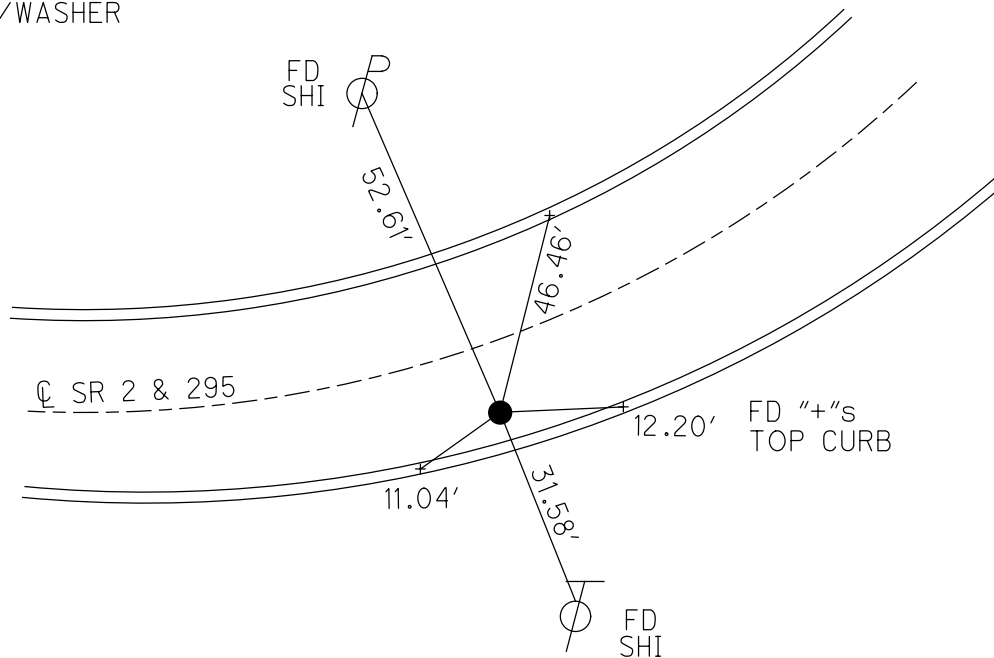

O.D.O.T. DISTRICT 2 SURVEY OFFICE (USE ONLY)

PERSONNEL

REFERENCE NO.

28 F

SHEET

9

OF 9

NOTES

HOMAN

DATE

7/29/16

ROUTE

SR 295

H.C.

HOMAN

WEATHER

SUNNY

COUNTY

LUCAS

R.C.

RYALL

TEMP.

84°F

TOWNSHIP

SWANTON

SECTION

9

T 7 N

R 5 E

TYPE MONUMENT MONBOX W/ IPIN


ON SURFACE - ~~BELOW~~ ON

LEFT - Q PAV'T - RIGHT ON

- TO - EDGE PAVEMENT

S.L.M. 623+96

GRID: NORTHING: 702942.925 EASTING: 1605937.436

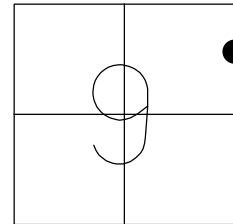

RECORD:

CL1

3/25/10, KPM


FD MON BOX

W/ IPIN

REF8

7/29/16, DCH

NOTE: REF 8 SR 2

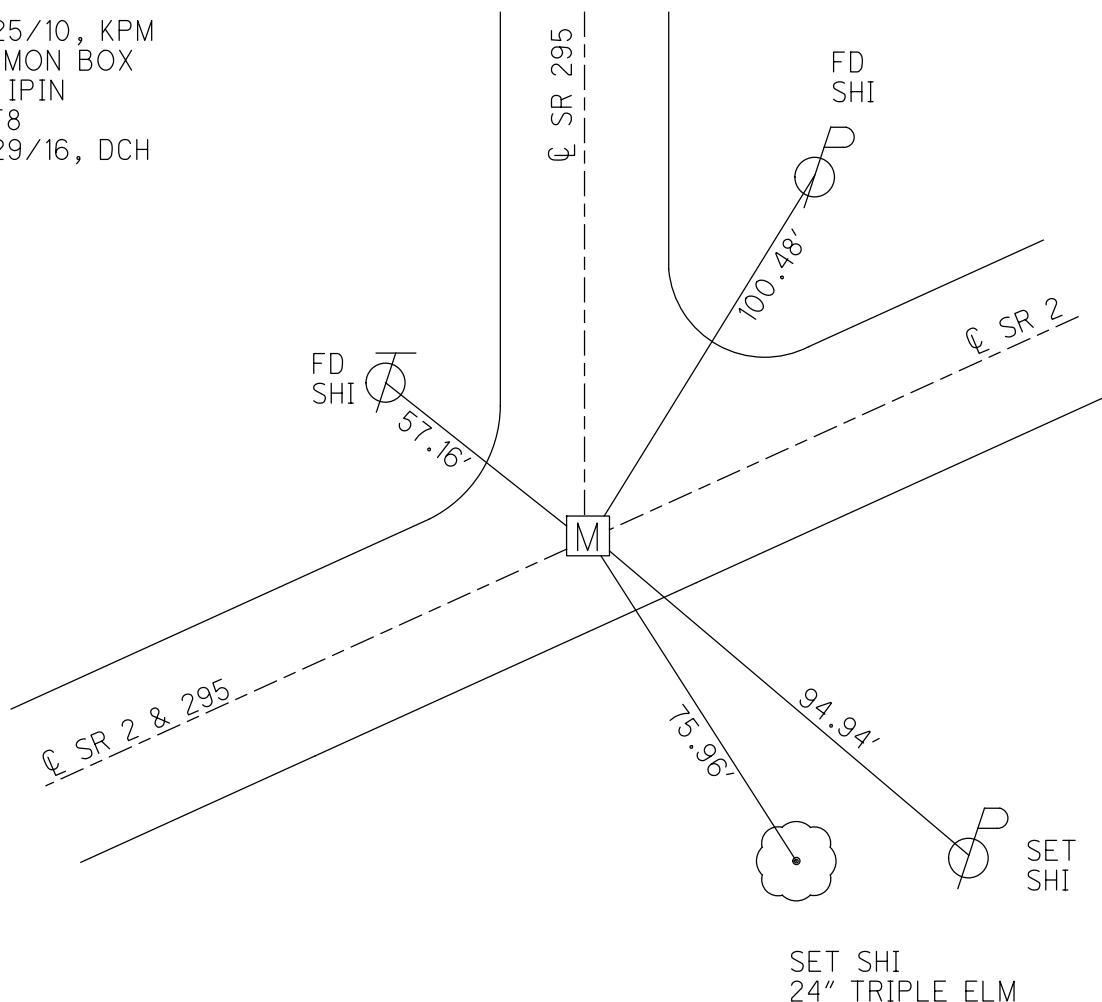

O.D.O.T. DISTRICT 2 SURVEY OFFICE (USE ONLY)

PERSONNEL

REFERENCE NO.

29

SHEET

1

OF 24

NOTES STONE

DATE _____

5/6/86

ROUTE

SR 295

H.C. CURTIS

WEATHER

CLOUDY

COUNTY

LUCAS

R.C. HOUSEHOLDER

TEMP.

$$75^\circ$$

TOWNSHIP

SWANTON

MICHALAK

SECTION

3,4,9,10

T 7 N R 9 S

TYPE MONUMENT SQ BOLT


ON SURFACE - ~~BELOW~~ _____ ON _____

LEFT - Q PAV'T - RIGHT

_____ TO _____ EDGE PAVEMENT

S.L.M. 625+78.18

GRID: NORTHING:____-____ EASTING:____-____

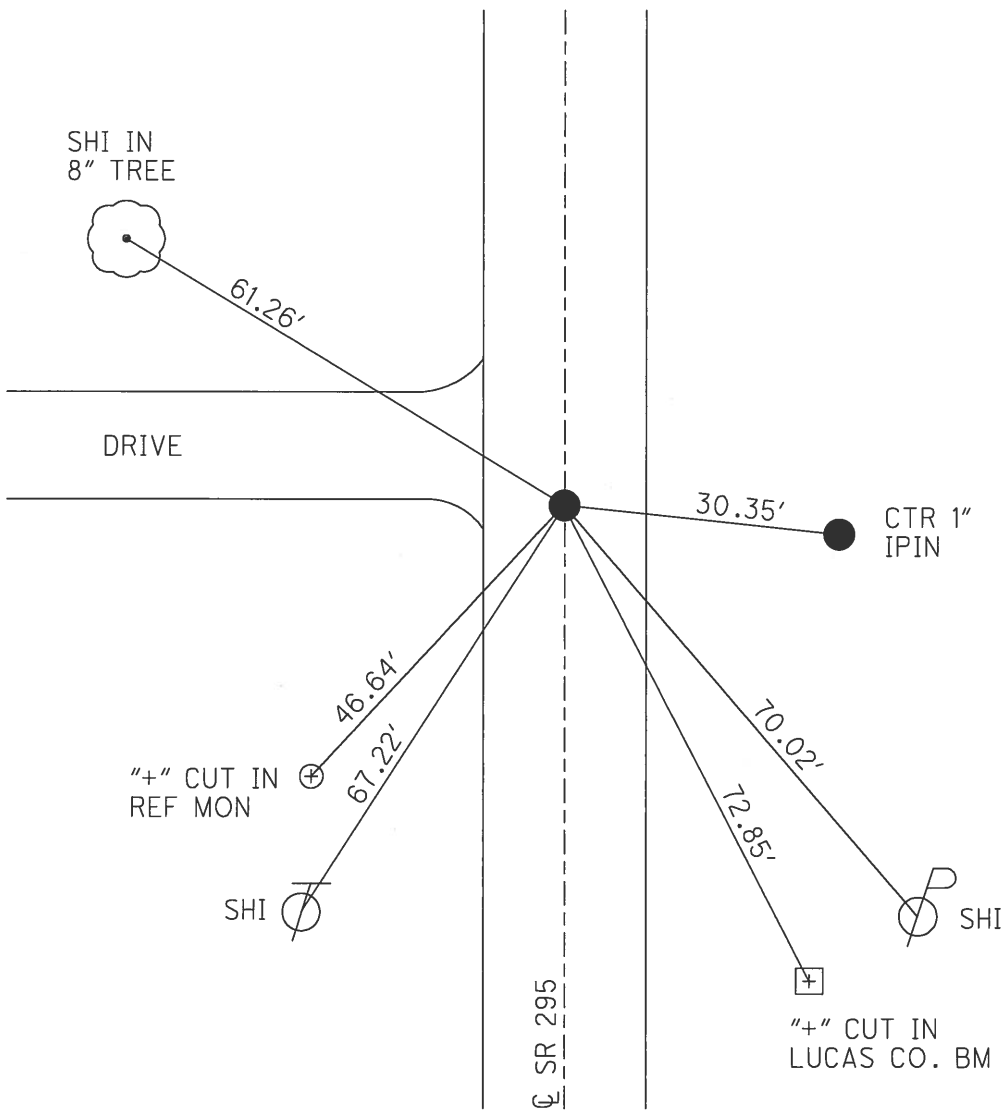

O.D.O.T. DISTRICT 2 SURVEY OFFICE (USE ONLY)

PERSONNEL

REFERENCE NO. 30

SHEET 2 OF 24

NOTES HUSS

DATE 6/28/12

ROUTE SR 295

H.C. HUSS

WEATHER CLEAR/HOT

COUNTY _____ LUCAS

R.C. CANTERBURY

TEMP. 93°

TOWNSHIP SWANTON

SECTION 4

T_7_N R_9_E

TYPE MONUMENT RR SPIKE



ON SURFACE ~~BELOW~~ ON

~~LEFT~~ - C PAV'T - RIGHT 2.4', 2.5' S.OF C W.

_____ TO _____ EDGE PAVEMENT

S.L.M. 638+97.13

GRID: NORTHING: 704535.639 EASTING: 1605968.261

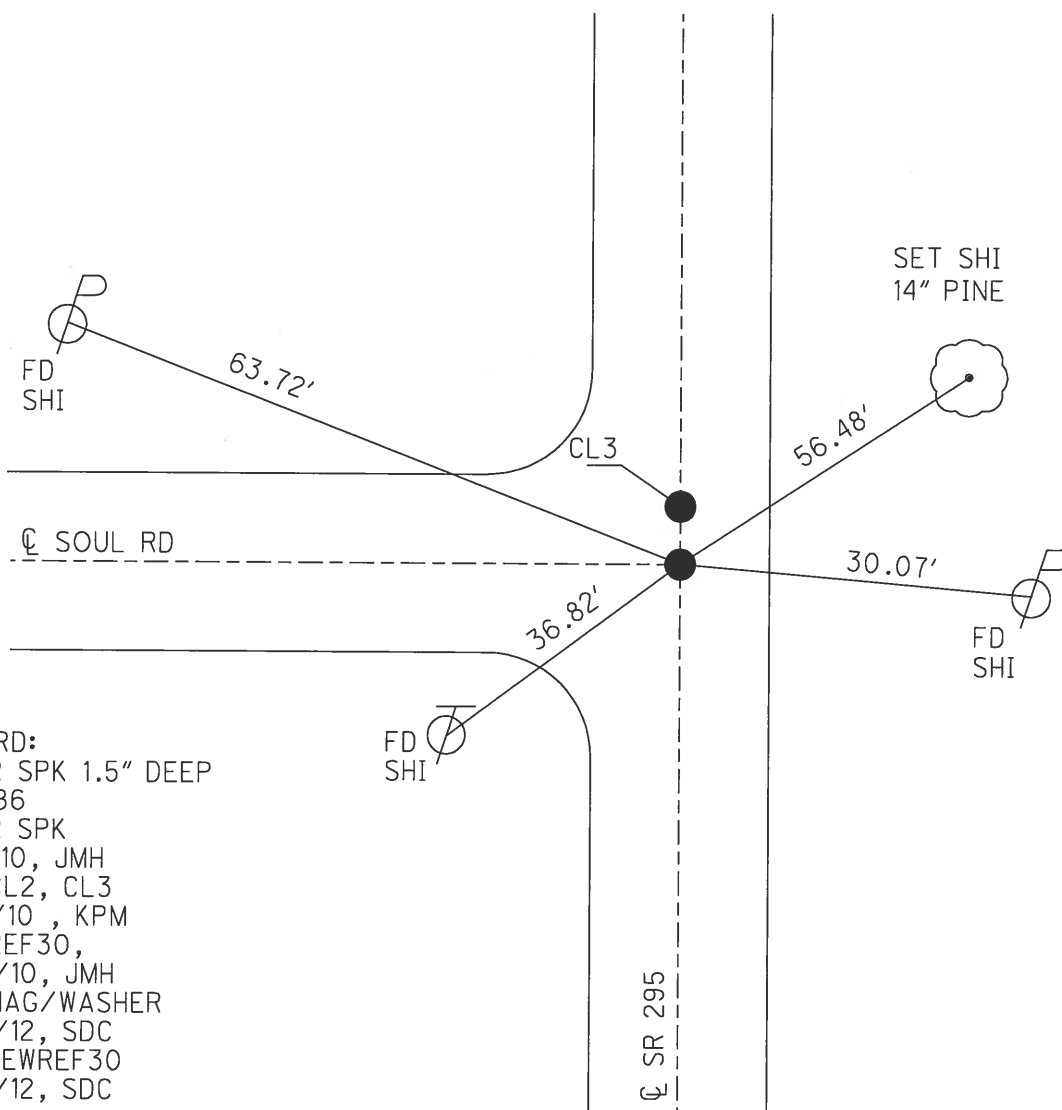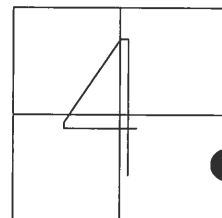

RECORD:
FD RR SPK 1.5" DEEP
8/11/86
FD RR SPK
9/15/10, JMH
GPS CL2, CL3
3/25/10, KPM
GPS REF30,
10/13/10, JMH
SET MAG/WASHER
10/16/12, SDC
GPS, NEWREF30
11/30/12, SDC

O.D.O.T. DISTRICT 2 SURVEY OFFICE (USE ONLY)

PERSONNEL

REFERENCE NO.

31

SHEET

3

OF 24

NOTES HUSS

DATE

6/28/12

ROUTE

SR 295

H.C. HUSS

WEATHER

CLEAR/HOT

COUNTY

LUCAS

R.C. CANTERBURY

TEMP.

94°

TOWNSHIP

SWANTON

SECTION

4

T 7 N R 9 E

TYPE MONUMENT

RR SPIKE

ON SURFACE - ~~BELOW~~

ON

LEFT - CL PAV'T - ~~RIGHT~~


1.4'

9.4' TO LT EDGE PAVEMENT

S.L.M. 652+24.68

GRID: NORTHING: 705862.923

EASTING: 1606002.424

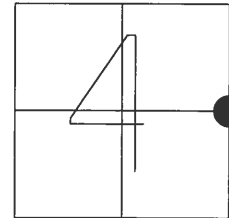

RECORD:

FD RR SPK

1.5" DEEP

8/11/86

FD RR SPK

9/15/10, JMH

GPS REF31,

10/13/10, JMH

GPS

3/25/10, CL4, KPM


1 SHOT TAKEN ONLY

SET MAG/WASHER

10/16/12, SDC

GPS, NEWREF31

11/30/12, SDC

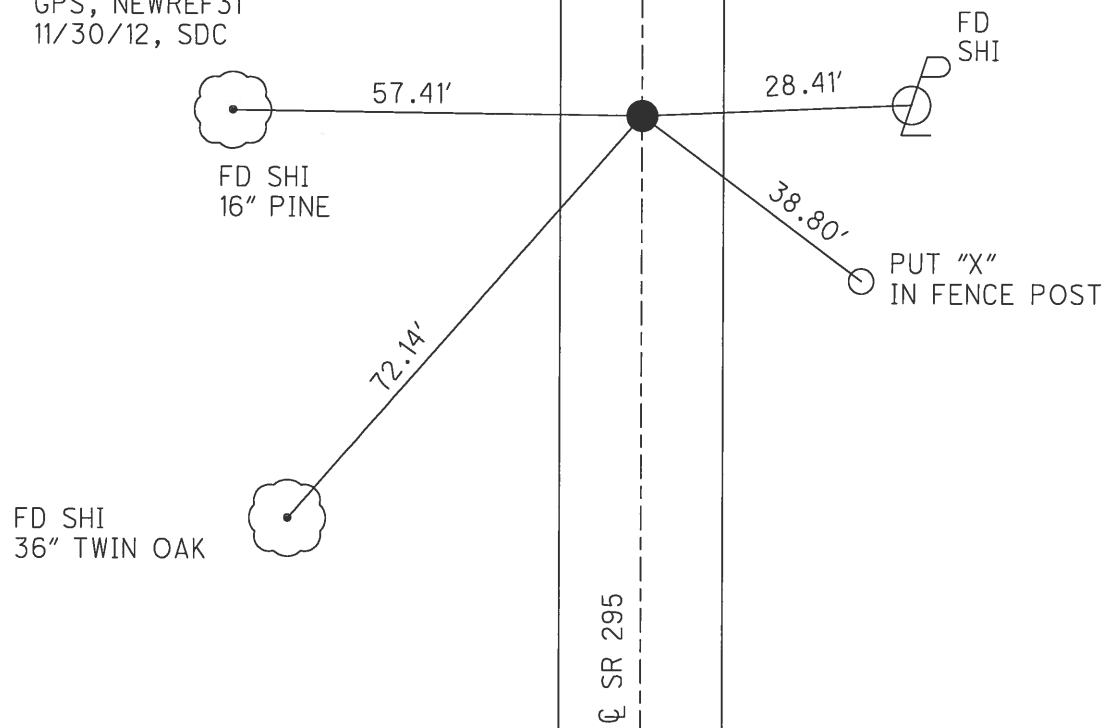

O.D.O.T. DISTRICT 2 SURVEY OFFICE(USE ONLY)

PERSONNEL

REFERENCE NO.

31 A

SHEET

4

OF 24

NOTES

HUSS

DATE

6/28/12

ROUTE

SR 295

H.C.

CANTERBUYR

WEATHER

CLEAR/HOT

COUNTY

LUCAS

R.C.

HUSS

TEMP.

94°

TOWNSHIP

SWANTON

SECTION

4

T 7 N R 9 E

TYPE MONUMENT

RR SPIKE

ON SURFACE - ~~BELOW~~

ON

~~LEFT~~ - C PAV'T - RIGHT

1.9'

8.8'

TO RT


EDGE PAVEMENT

S.L.M.

665+55.37

GRID: NORTHING: 707193.134

EASTING: 1606036.666

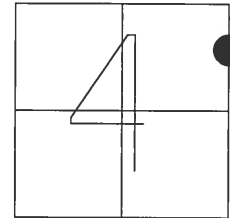

RECORD:

SET SM RR SPK

AT SURFACE

8/11/86

FD SM RR SPK

9/15/10, JMH

GPS REF A31

10/13/10, JMH

SET MAG/WASHER

10/16/12, SDC

GPS, NEWREFA31

11/30/12, SDC

FD SHI IN
MAILBOX POST

CARDINAL LN


ISLAND

SET SHI IN
ARROWHEAD PARK SIGNPOST

FD
SHI

FD
SHI

FD
SHI

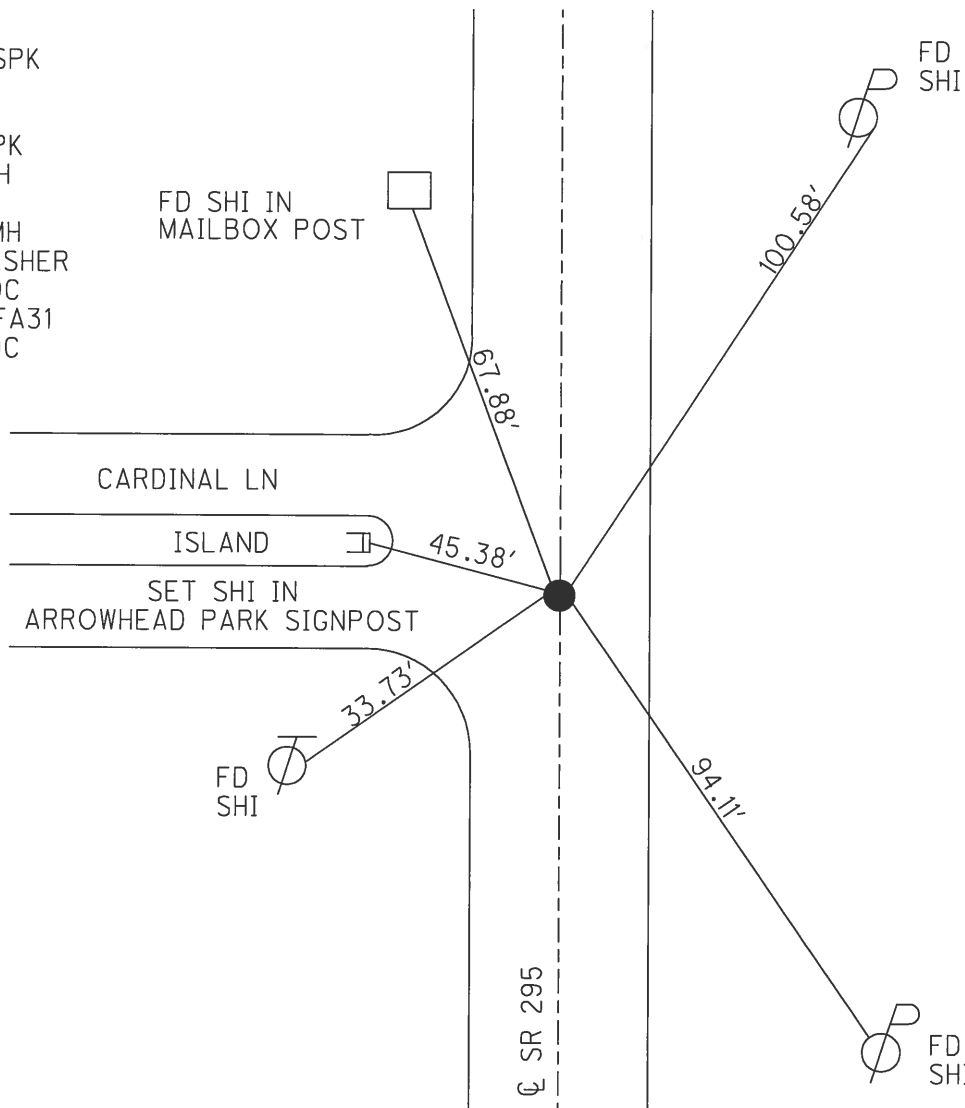

O.D.O.T. DISTRICT 2 SURVEY OFFICE (USE ONLY)

PERSONNEL

REFERENCE NO.

32

SHEET

5

OF 24

NOTES HUSS

DATE

6/29/12

ROUTE

SR 295

H.C. HUSS

WEATHER

CLEAR/FAIR

COUNTY

LUCAS

R.C. COUTCHER

TEMP.

80°

TOWNSHIP

SWANTON

HARBAUGH

SECTION

3-4, 33-34

T 8 N R 9 E

TYPE MONUMENT

SM RR SPIKE

ON SURFACE - ~~BELOW~~

ON

~~LEFT~~ - $\varnothing$ PAV'T - RIGHT

2.45'

TO EDGE PAVEMENT

S.L.M.

678+86.06

GRID: NORTHING: 708523.333

EASTING: 1606071.105

33	34
4	3



RECORD:

SET SM RR SPK

AT SURFACE 8/11/86

FD SM RR SPK 9/15/10, JMH

GPS REF32,


10/13/10, JMH

SET MAG/WASHER

10/16/12, SDC

GPS, NEWREF32

11/30/12, SDC

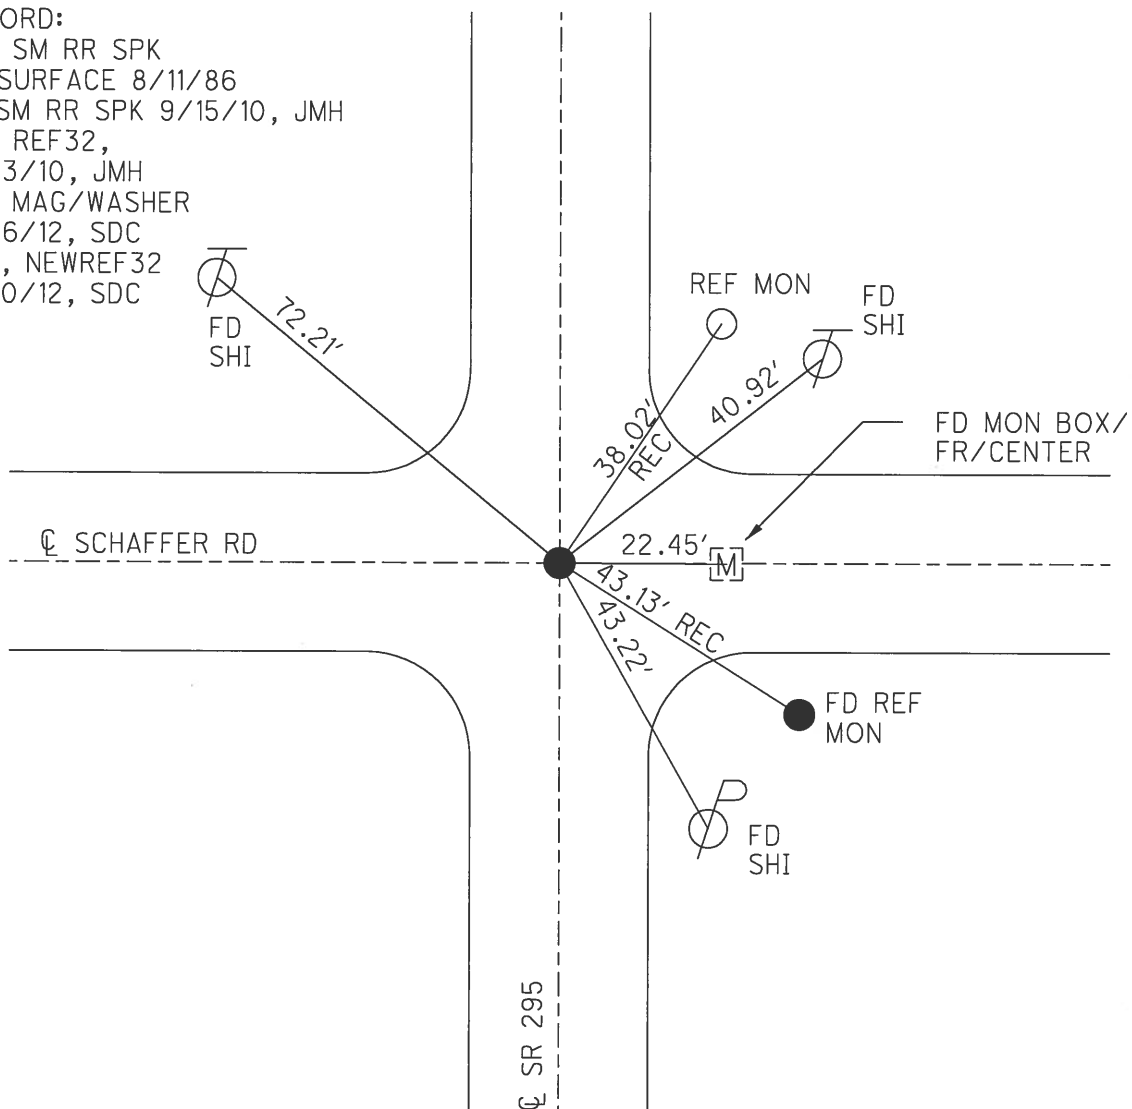

O.D.O.T. DISTRICT 2 SURVEY OFFICE(USE ONLY)

PERSONNEL

REFERENCE NO. 32 A SHEET 6 OF 24

NOTES HARBAUGH DATE 6/29/12 ROUTE SR 295
H.C. HUSS WEATHER SUNNY COUNTY LUCAS
R.C. COUTCHER TEMP. 80° TOWNSHIP SWANTON
SECTION 34
T 8 N R 9 E

TYPE MONUMENT P.K.SHANK


ON SURFACE - ~~BELOW~~ ON

LEFT - C PAV'T - ~~RIGHT~~ 1.5'

9.4' TO LT EDGE PAVEMENT


S.L.M. 692+05.08

GRID: NORTHING: 709842.189 EASTING: 1606086.518

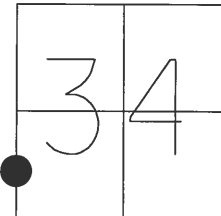

RECORD:

SET PK NAIL
AT SURFACE 8/11/86
FD PK NAIL 9/15/10 JMH
GPS REFA32, 10/13/10 JMH
SET MAG/WASHER
10/16/12, SDC
GPS, NEW REFA32
11/30/12, SDC

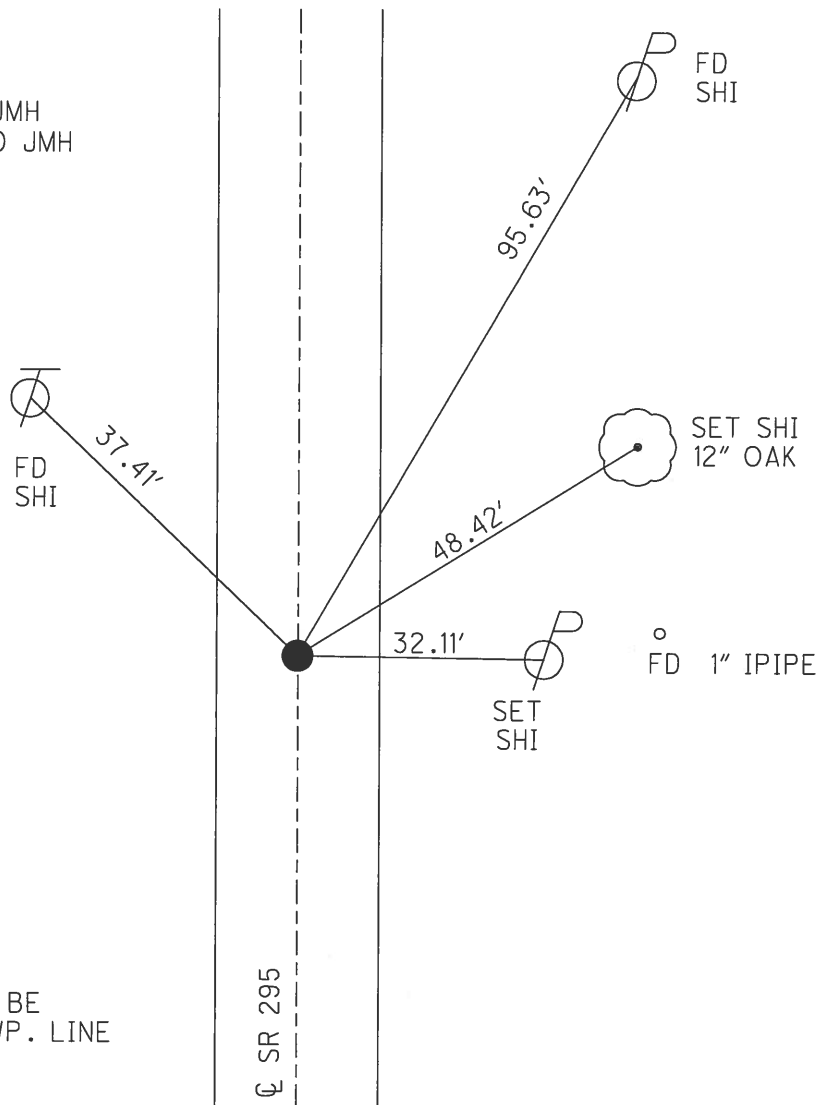


NOTE:
THIS POINT LOOKS TO BE
HARDING- SWANTON TWP. LINE

O.D.O.T. DISTRICT 2 SURVEY OFFICE (USE ONLY)


PERSONNEL _____ REFERENCE NO. 33 SHEET 7 OF 24
NOTES HARBAUGH DATE 6/29/12 ROUTE SR 295
H.C. HUSS WEATHER SUNNY COUNTY LUCAS
R.C. COUTCHER TEMP. 80° TOWNSHIP HARDING
SECTION 34
T 8 N R 9 E

TYPE MONUMENT " I. PIPE
~~ON SURFACE~~ - BELOW 1.5'
~~LEFT~~ = Q PAV'T - RIGHT 0.8'
9.4' TO RT EDGE PAVEMENT
S.L.M. 705+24.01

GRID: NORTHING: 711161.105 EASTING: 1606102.078

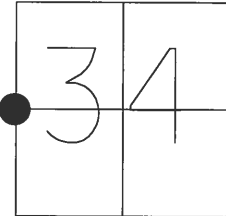

RECORD:
FD " IPIPE AT
1.5" DEEP
8/11/86
FD PK NAIL 1.5" DEEP
ATOP IPIPE
9/15/10, JMH
GPS REF33,
10/13/10, JMH
SET MAG/WASHER
10/16/12, SDC
GPS, NEWREF33
11/30/12, SDC

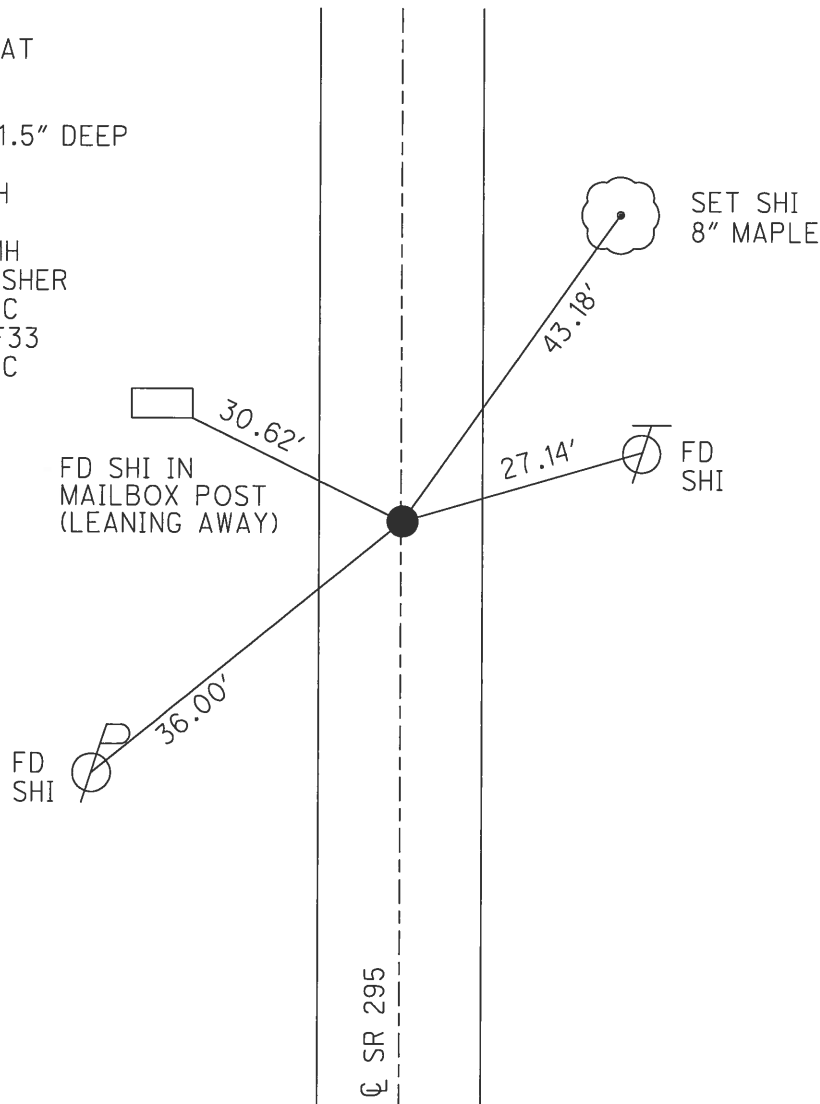

O.D.O.T. DISTRICT 2 SURVEY OFFICE (USE ONLY)

PERSONNEL

REFERENCE NO. 34

SHEET 8 OF 24

NOTES HARBAUGH

DATE 6/29/12

ROUTE SR 295

H.C. HUSS

WEATHER SUNNY

COUNTY LUCAS

R.C. COUTCHER

TEMP. 80°

TOWNSHIP HARDING

SECTION 34

T 8 N R 9 E

TYPE MONUMENT SQ BOLT



~~ON SURFACE~~ BELOW 0.2'

LEFT - ℄ PAV'T - RIGHT ON

TO EDGE PAVEMENT

S.L.M. 728+06.93

GRID: NORTHING: 713444.0270 EASTING: 1606111.8715

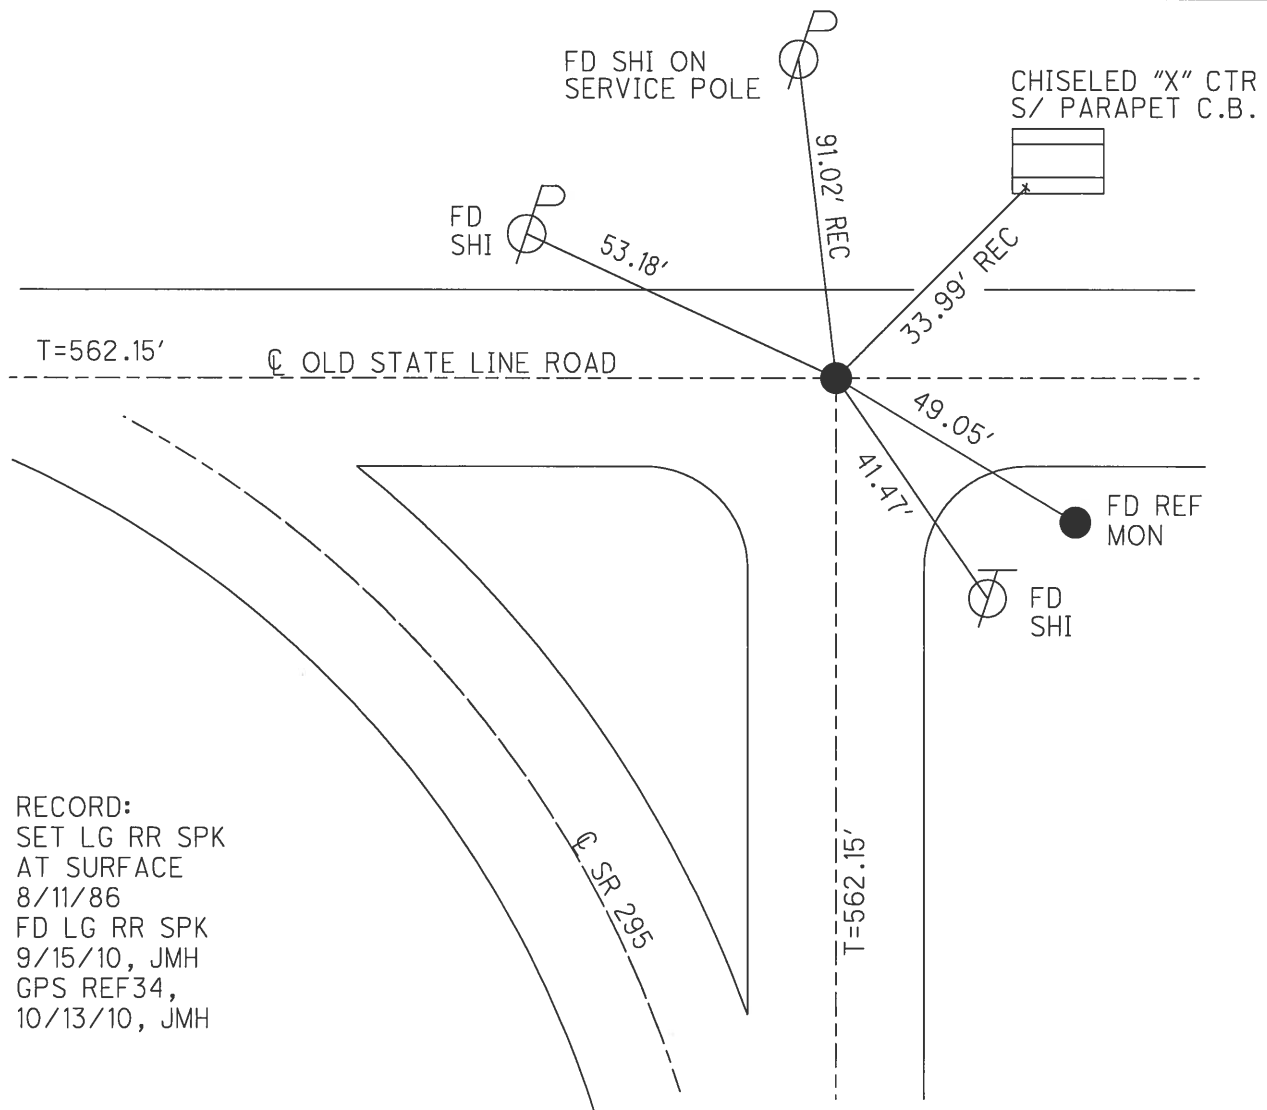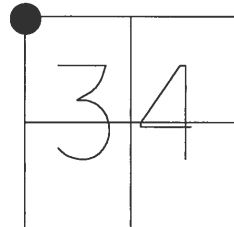

RECORD:
SET LG RR SPK
AT SURFACE
8/11/86
FD LG RR SPK
9/15/10, JMH
GPS REF34,
10/13/10, JMH

FD SHI IN N/S
26" TREE CLUSTER

O.D.O.T. DISTRICT 2 SURVEY OFFICE (USE ONLY)

PERSONNEL	REFERENCE NO. <u>35</u>	SHEET <u>10</u> OF <u>24</u>
NOTES HARBAUGH	DATE <u>6/29/12</u>	ROUTE <u>SR 295</u>
H.C. <u>HUSS</u>	WEATHER <u>SUNNY</u>	COUNTY <u>LUCAS</u>
R.C. <u>COUTCHER</u>	TEMP. <u>80°</u>	TOWNSHIP <u>HARDING</u>
		SECTION <u>33</u>
		T <u>8</u> N R <u>9</u> E

TYPE MONUMENT RR SPK



~~ON SURFACE~~ = BELOW -

LEFT - ℄ PAV'T - ~~RIGHT~~ 31.59'

- TO - EDGE PAVEMENT

S.L.M. 752+27.74

GRID: NORTHING: 713505.755 EASTING: 1603450.026

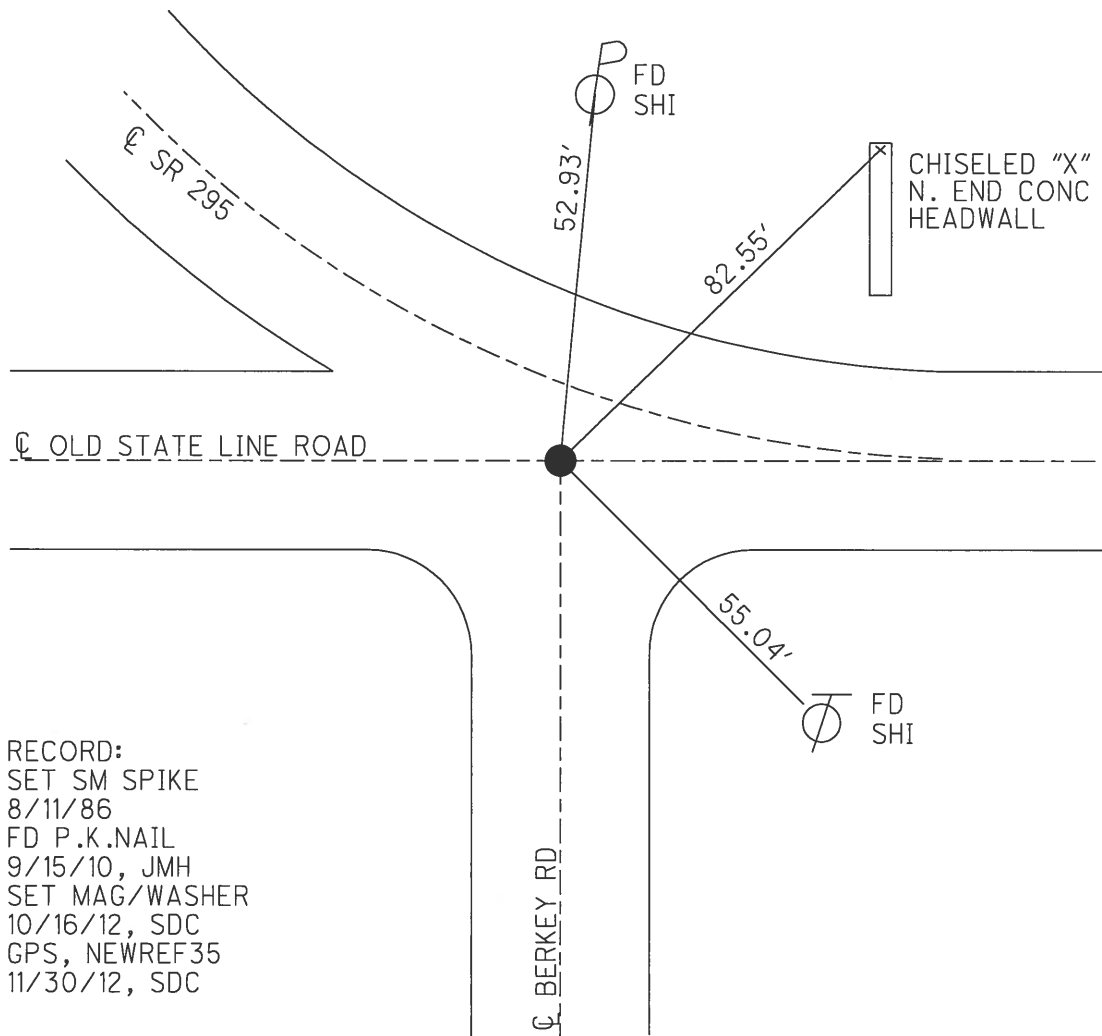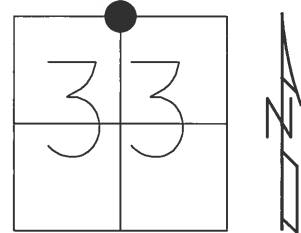

O.D.O.T. DISTRICT 2 SURVEY OFFICE (USE ONLY)

PERSONNEL

REFERENCE NO.

36

SHEET

11

OF 24

NOTES HARBAUGH

DATE

6/29/12

ROUTE

SR 295

H.C. HUSS

WEATHER

SUNNY

COUNTY

LUCAS

R.C. COUTCHER

TEMP.

80°

TOWNSHIP

HARDING

SECTION

9

T 8 N R 9 E

TYPE MONUMENT

MON BOX

ON SURFACE - ~~BELOW~~

ON

LEFT - ~~Q~~ PAV'T - ~~RIGHT~~


1.5'

10.9' TO LT EDGE PAVEMENT

S.L.M. 755+97.82

GRID: NORTHING: 713514.598

EASTING: 1603086.607

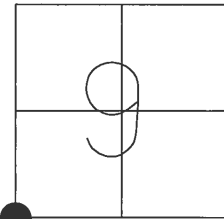

RECORD:

SET LG RR SPK

TO SURFACE,

$\Delta=88^{\circ}15'20''$ (MEAS.)

8/11/86

FD MON BOX, SOUTH OF $\mathcal{C}$ WITH

3" DISK W/ SCRIBE MARK 21" BELOW

SURFACE, S. OF $\mathcal{C}$,

10/06/10, JMH

GPS REF36,

4/6/11 KPM


CHISELED "X" ON
STEEL GUARD POST
FOR GAS VALVE

$\mathcal{C}$ OLD STATE LINE ROAD

FD
SHI

FD CHISELED "X"
SW. CORNER OF
CONC. C.B.

FD
SHI

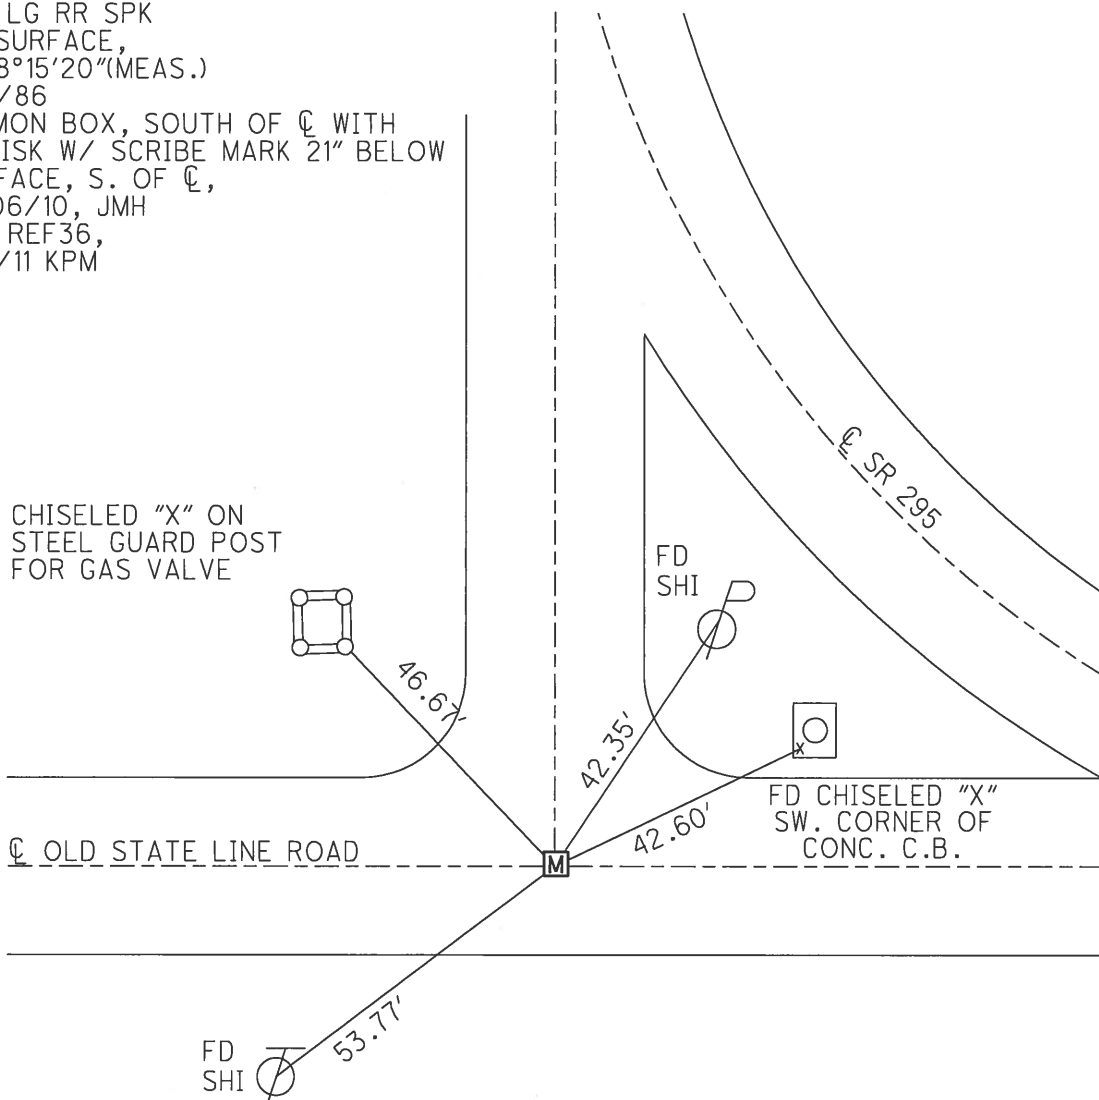


O.D.O.T. DISTRICT 2 SURVEY OFFICE (USE ONLY)


PERSONNEL	REFERENCE NO. <u>37</u>	SHEET <u>12</u> OF <u>24</u>	
NOTES HARBAUGH	DATE <u>6/29/12</u>	ROUTE <u>SR 295</u>	
H.C. HUSS	WEATHER <u>SUNNY</u>	COUNTY <u>LUCAS</u>	
R.C. COUTCHER	TEMP. <u>80°</u>	TOWNSHIP <u>HARDING</u>	
		SECTION <u>9</u>	
		T <u>10</u> N R <u>5</u> E	

TYPE MONUMENT P.K. NAIL
 ON SURFACE - ~~BELOW~~ ON
 LEFT - CL PAV'T - ~~RIGHT~~ 1.2'
9.5' TO LT EDGE PAVEMENT
 S.L.M. 770+90.06

GRID: NORTHING: 715235.719 EASTING: 1603074.277

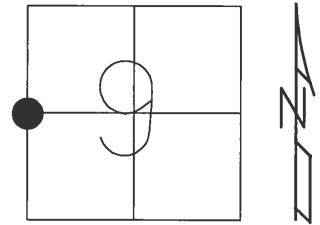

RECORD: SET PK NAIL
 TO SURFACE
 8/11/86
 FD P.K.NAIL,
 10/6/10
 GPS REF37,
 10/13/10, JMH
 SET MAG/WASHER
 10/16/12, SDC
 GPS, NEWREF37
 12/13/12, SDC

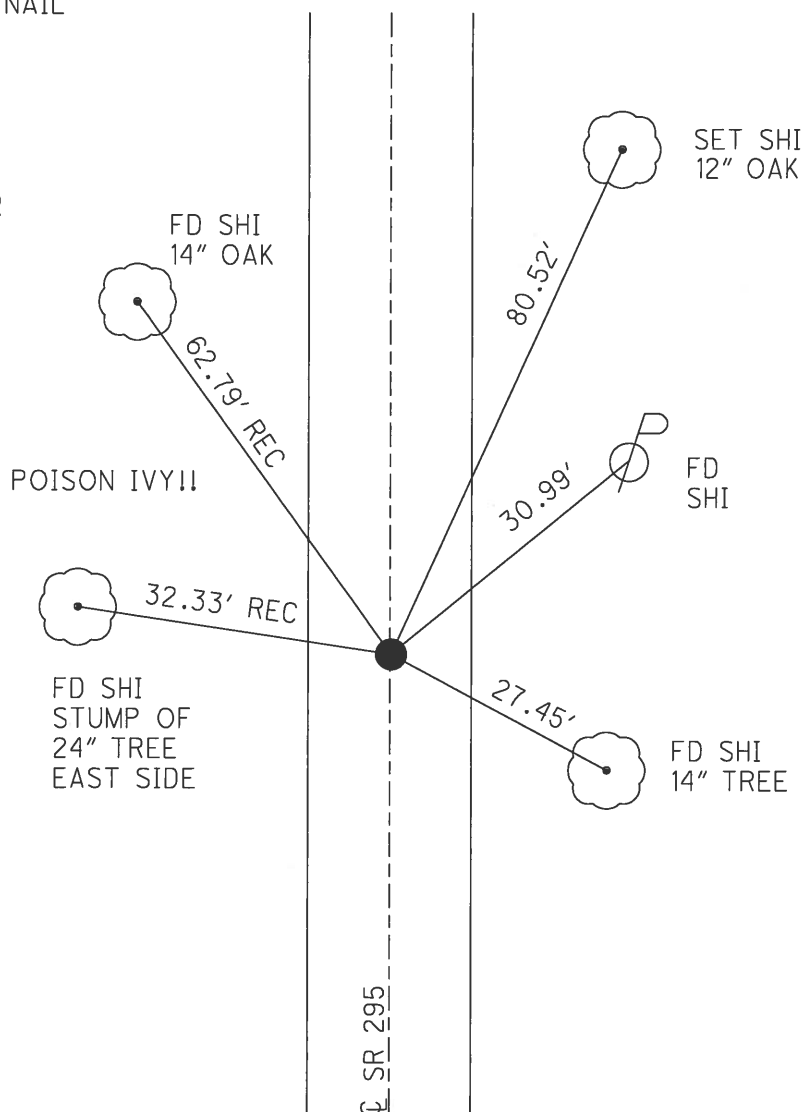

O.D.O.T. DISTRICT 2 SURVEY OFFICE(USE ONLY)

PERSONNEL	REFERENCE NO.	<u>38</u>	SHEET	<u>13</u>	OF	<u>24</u>
NOTES	<u>HARBAUGH</u>	DATE	<u>6/29/12</u>	ROUTE	<u>SR 295</u>	
H.C.	<u>HUSS</u>	WEATHER	<u>SUNNY</u>	COUNTY	<u>LUCAS</u>	
R.C.	<u>COUTCHER</u>	TEMP.	<u>80°</u>	TOWNSHIP	<u>HARDING</u>	
				SECTION	<u>9</u>	
				T	<u>10</u>	N
				R	<u>5</u>	E

TYPE MONUMENT R.R.SPIKE



~~ON SURFACE~~ BELOW ON

LEFT - ℄ PAV'T - ~~RIGHT~~ 0.8'

9.4' TO LT EDGE PAVEMENT

S.L.M. 784+09.97

GRID: NORTHING: 716555.660 EASTING: 1603065.973

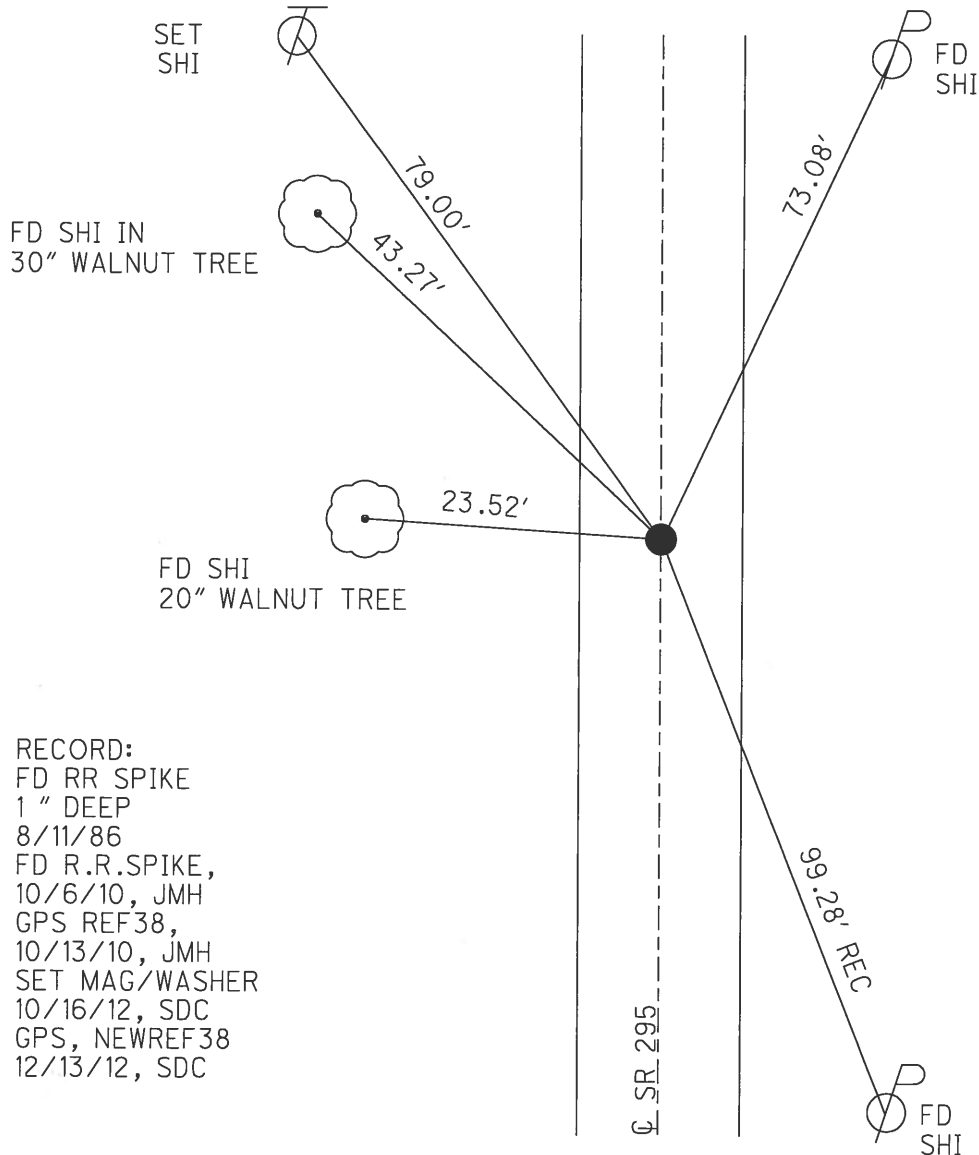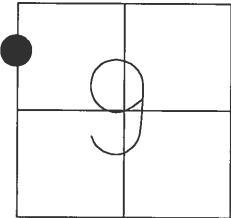


RECORD:
FD RR SPIKE
1 " DEEP
8/11/86
FD R.R.SPIKE,
10/6/10, JMH
GPS REF38,
10/13/10, JMH
SET MAG/WASHER
10/16/12, SDC
GPS, NEWREF38
12/13/12, SDC

O.D.O.T. DISTRICT 2 SURVEY OFFICE (USE ONLY)


PERSONNEL _____ REFERENCE NO. 39 SHEET 14 OF 24
NOTES HARBAUGH DATE 12/29/10 ROUTE SR 295
H.C. HUSS WEATHER FAIR COUNTY LUCAS
R.C. COUTCHER TEMP. 25° TOWNSHIP HARDING
SECTION 9
T 10 N R 5 E

TYPE MONUMENT MAG NAIL
ON SURFACE - ~~BELOW~~ ON
LEFT - ℄ PAV'T - ~~RIGHT~~ 1.3', ON ℄ W-E
TO EDGE PAVEMENT
S.L.M. 797+30.22

GRID: NORTHING: 717875.717 EASTING: 1603055.930

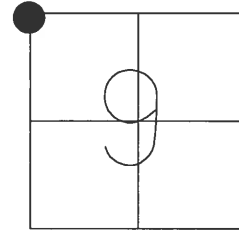

RECORD:
SET PK NAIL
TO SURFACE
8/11/86
FD PK NAIL
10/06/10, JMH
REF, 12/29/10, RJL
GPS REF 39
SET MAG/WASHER
10/16/12, SDC
GPS, NEWREF39
12/13/12, SDC

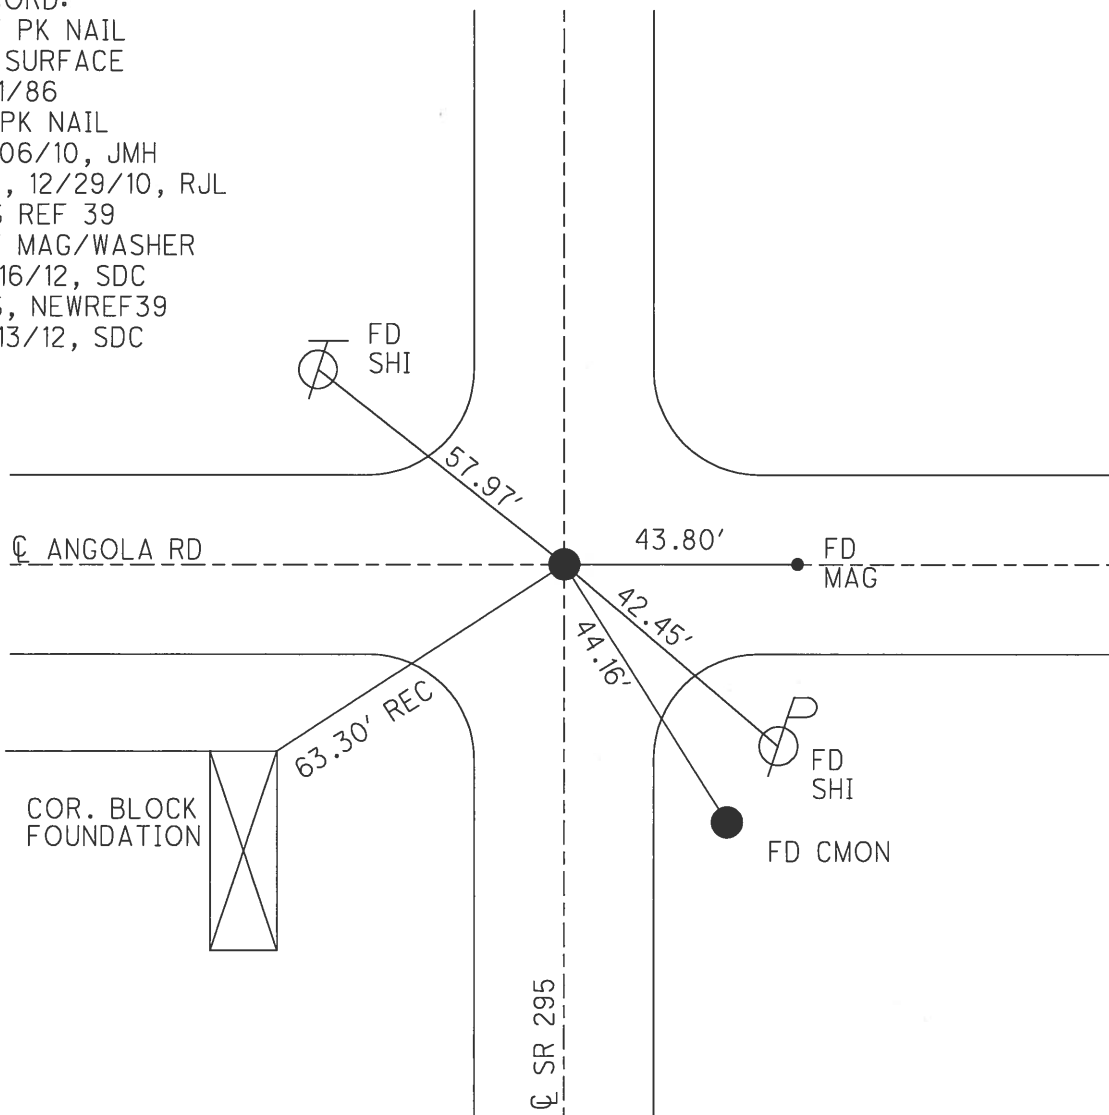

O.D.O.T. DISTRICT 2 SURVEY OFFICE (USE ONLY)

PERSONNEL

REFERENCE NO. 40

SHEET 15 OF 24

NOTES LUMBREZER

DATE 12/29/10

ROUTE SR 295

H.C. LUMBREZER

WEATHER CLOUDY

COUNTY LUCAS

R.C. HARBAUGH

TEMP. 25°

TOWNSHIP HARDING

SECTION 4

T 10 N R 5 E

TYPE MONUMENT P.K. NAIL



ON SURFACE - ~~BELOW~~ ON

LEFT - ℄ PAV'T - RIGHT ON

11' TO LT EDGE PAVEMENT

S.L.M. 823+52.38

GRID: NORTHING: 720498.001 EASTING: 1603046.852

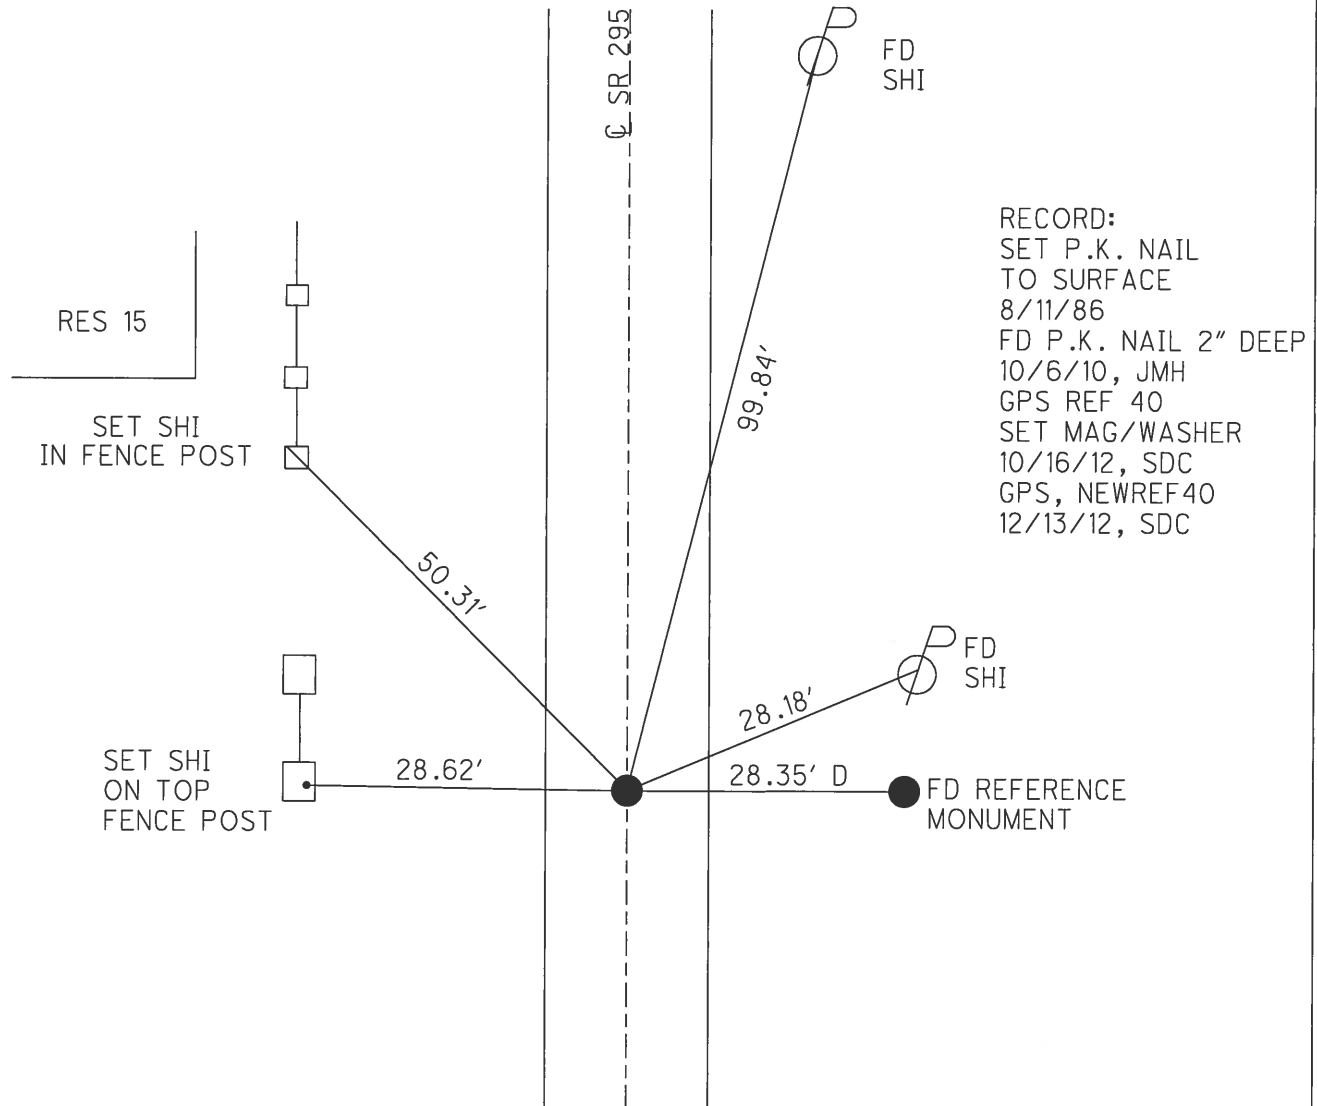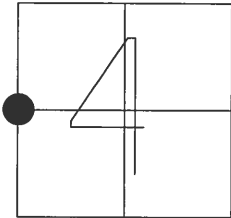


O.D.O.T. DISTRICT 2 SURVEY OFFICE (USE ONLY)


PERSONNEL _____ REFERENCE NO. 41 SHEET 16 OF 24
NOTES HARBAUGH DATE 7/2/12 ROUTE SR 295
H.C. HUSS WEATHER CLOUDY COUNTY LUCAS
R.C. COUTCHER TEMP. 80° TOWNSHIP SPENCER
SECTION 33
T 10 N R 5 E

TYPE MONUMENT _____ IPIN _____
ON SURFACE - ~~BELOW~~ _____ ON _____
~~LEFT~~ - ℄ PAV'T - RIGHT 1.1'
_____ TO _____ EDGE PAVEMENT
S.L.M. 849+75.27

GRID: NORTHING: 723120.919 EASTING: 1603026.492

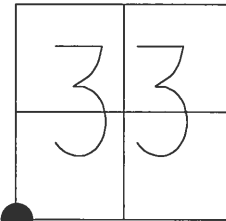

RECORD:
OK 8/11/86
FD P.K.NAIL (AND SPIKE?)
10/6/10, EAF
FD MAG NAIL
12/29/10, RGL
GPS REF 41
SET MAG/WASHER
10/16/12, SDC
GPS, NEWREF 41
12/13/12, SDC

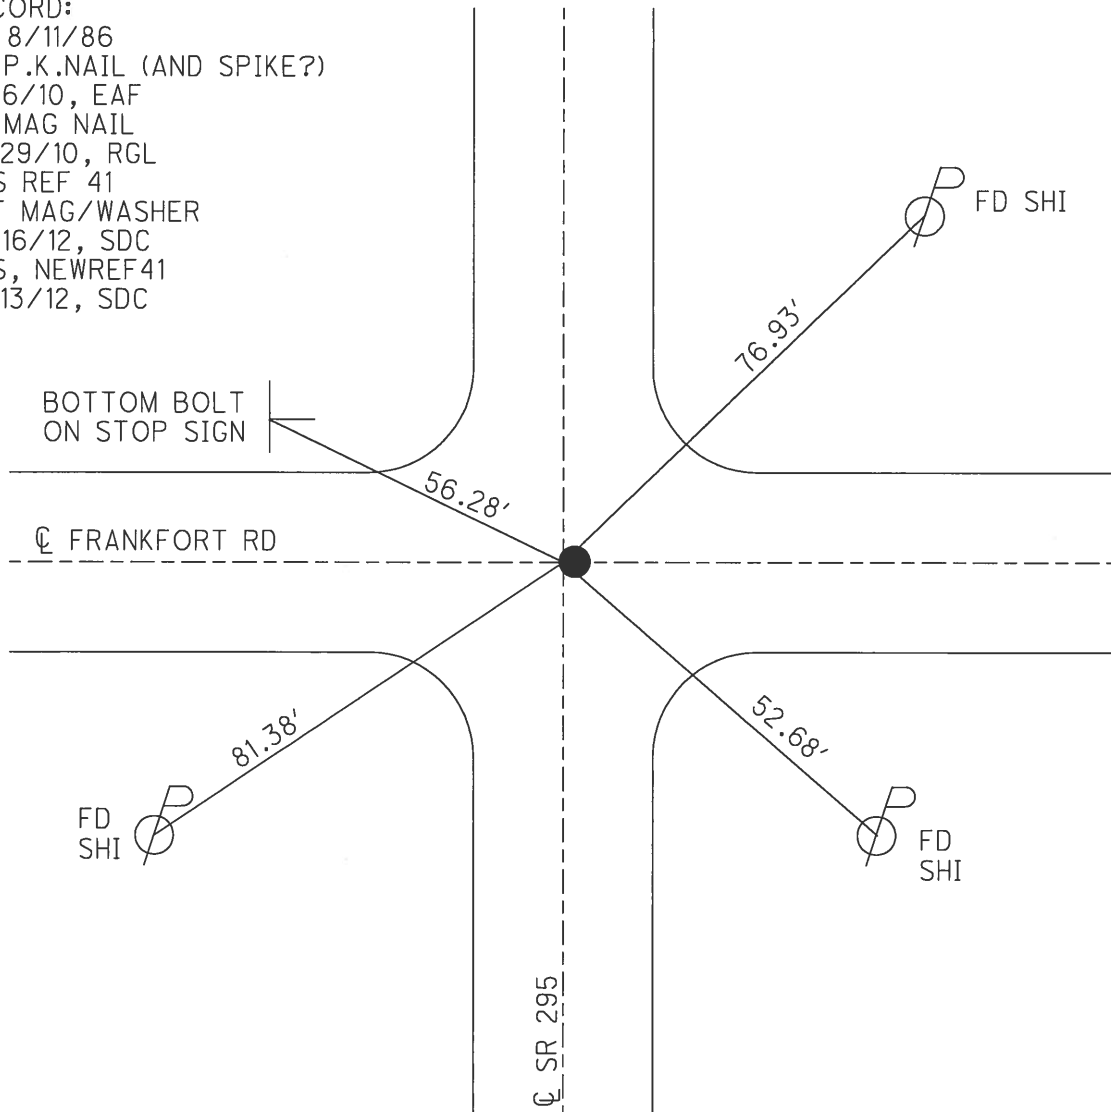

O.D.O.T. DISTRICT 2 SURVEY OFFICE(USE ONLY)

PERSONNEL

REFERENCE NO.

41 A

SHEET

17

OF 24

NOTES

HARBAUGH

DATE

7/2/12

ROUTE

SR 295

H.C.

HUSS

WEATHER

FAIR

COUNTY

LUCAS

R.C.

COUTCHER

TEMP.

80°

TOWNSHIP

SPENCER

SECTION

33

T 9 S

R 5 E

TYPE MONUMENT

P.K. NAIL

ON SURFACE - ~~BELOW~~

ON

LEFT - $\odot$ PAV'T - ~~RIGHT~~

1.9'


8.9' TO LT EDGE PAVEMENT

S.L.M.

873+07

GRID: NORTHING: 725453.026

EASTING: 1602989.956

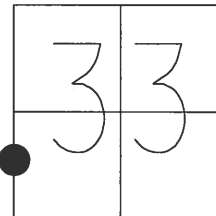

RECORD:

SET P.K. NAIL

TO SURFACE


8/11/86

SET MAG/WASHER

10/16/12, SDC

GPS, NEWREFA41

12/13/12, SDC

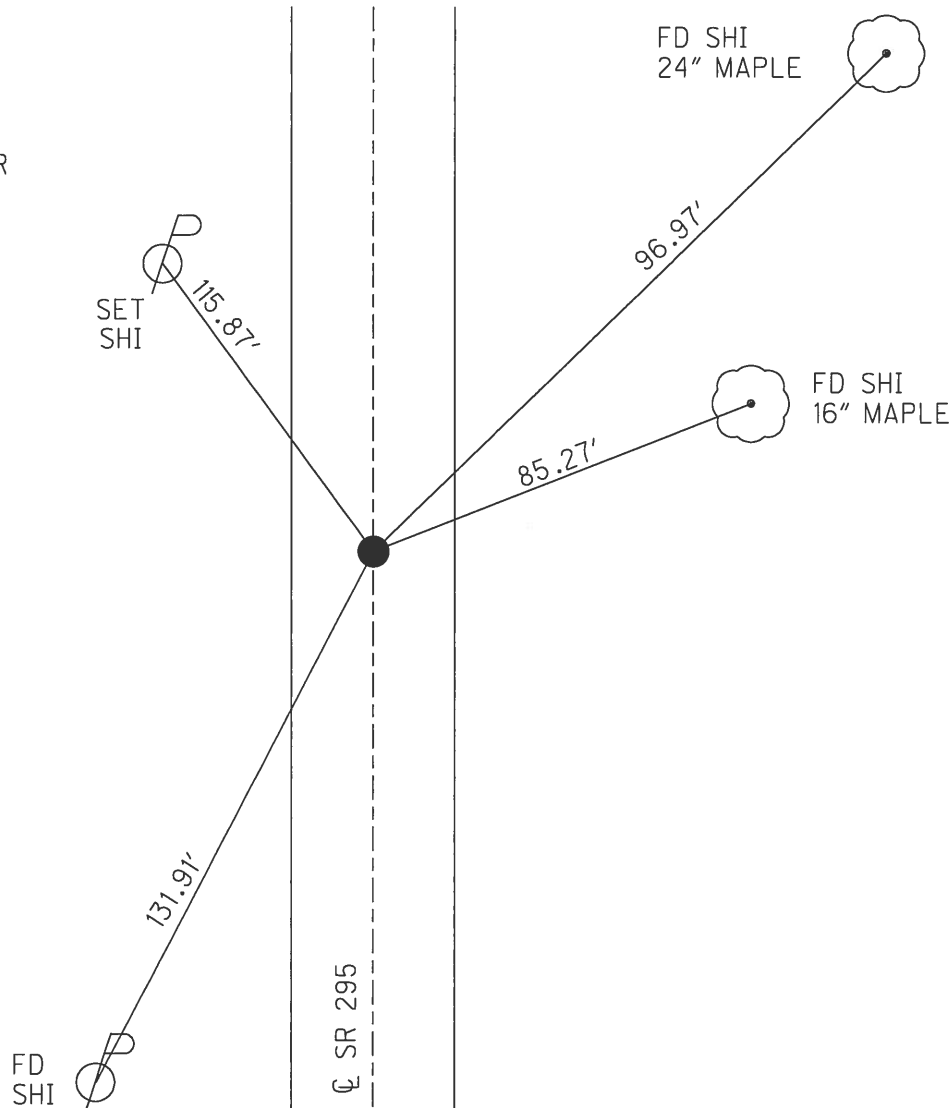


O.D.O.T. DISTRICT 2 SURVEY OFFICE(USE ONLY)


PERSONNEL	REFERENCE NO. <u>42</u>	SHEET <u>18</u> OF <u>24</u>
NOTES HARBAUGH	DATE <u>7/2/12</u>	ROUTE <u>SR 295</u>
H.C. HUSS	WEATHER <u>FAIR</u>	COUNTY <u>LUCAS</u>
R.C. COUTCHER	TEMP. <u>80°</u>	TOWNSHIP <u>SPENCER</u>
		SECTION <u>33</u>
		T <u>9</u> S R <u>5</u> E

TYPE MONUMENT P.K. NAIL
 ON SURFACE - ~~BELOW~~ ON
 LEFT - CL PAV'T - ~~RIGHT~~ 0.7'
10.3' TO LT EDGE PAVEMENT
 S.L.M. 875+24.78

GRID: NORTHING: 725670.126 EASTING: 1602988.327

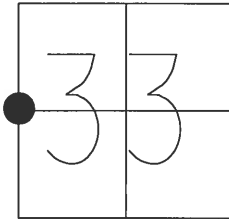

RECORD:
 SET PK NAIL
 TO SURFACE
 8/11/86
 FD PK NAIL
 10/06/10, EAF
 GPS REF 42
 SET MAG/WASHER
 GPS, NEWREF42
 12/13/12, SDC

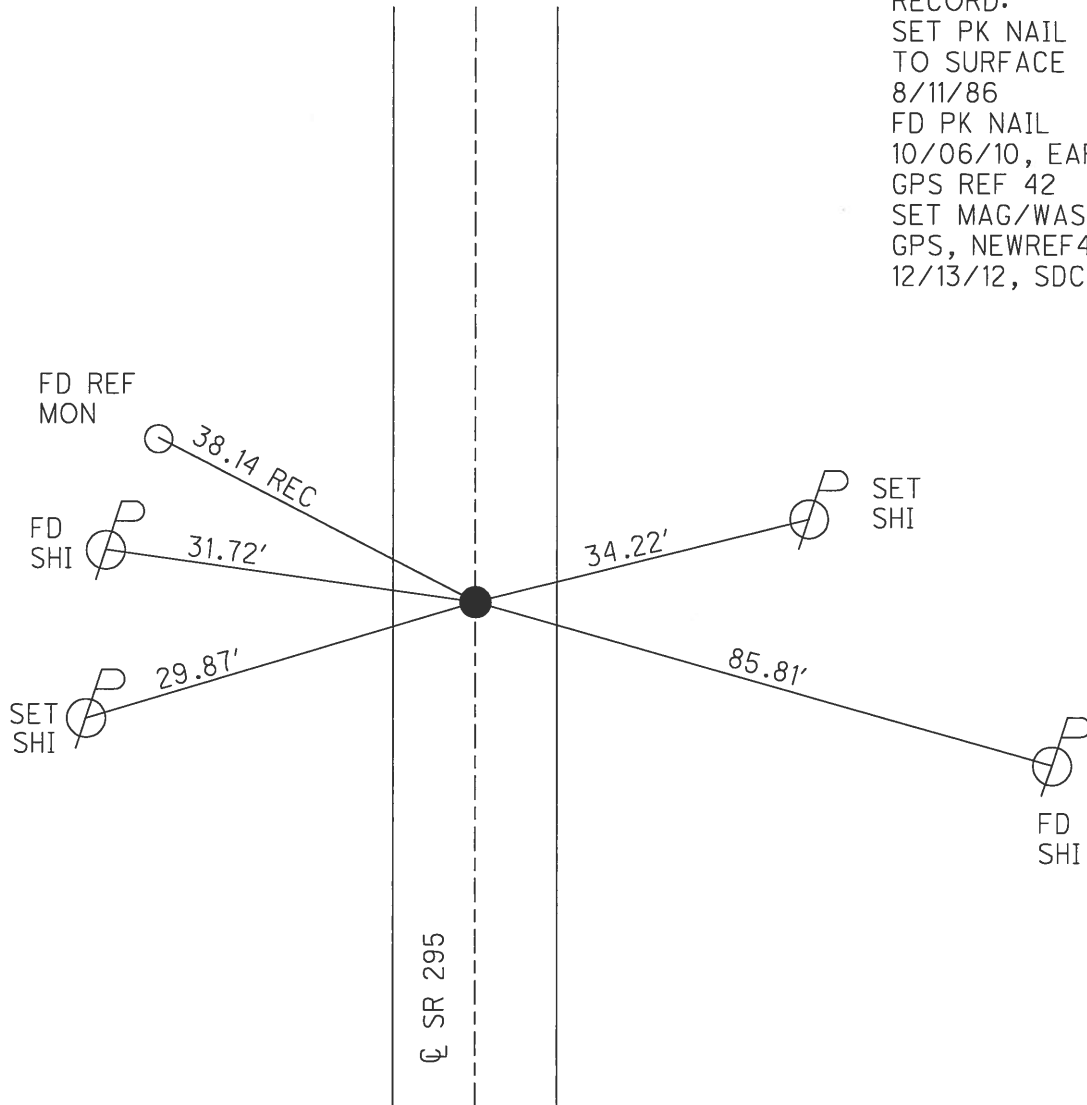


O.D.O.T. DISTRICT 2 SURVEY OFFICE (USE ONLY)


PERSONNEL _____ REFERENCE NO. 43 SHEET 19 OF 24
NOTES HARBAUGH DATE 7/2/12 ROUTE SR 295
H.C. HUSS WEATHER SUNNY COUNTY LUCAS
R.C. COUTCHER TEMP. 80° TOWNSHIP SPENCER
CANTERBURY SECTION 33
T 9 S R 5 E

TYPE MONUMENT _____ P.K. NAIL
ON SURFACE - ~~BELOW~~ _____ ON
LEFT - CL PAV'T - ~~RIGHT~~ 1.0', ON CL RT
_____ TO _____ EDGE PAVEMENT
S.L.M. 900+75.62

GRID: NORTHING: 728220.596 EASTING: 1602960.858

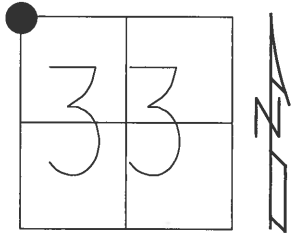

RECORD:
SET P.K. NAIL
TO SURFACE
8/11/86
FD PK NAIL
10/06/10, EAF
GPS REF 43
SET MAG/WASHER
10/25/12, SDC
GPS, NEWREF43
12/13/12, SDC


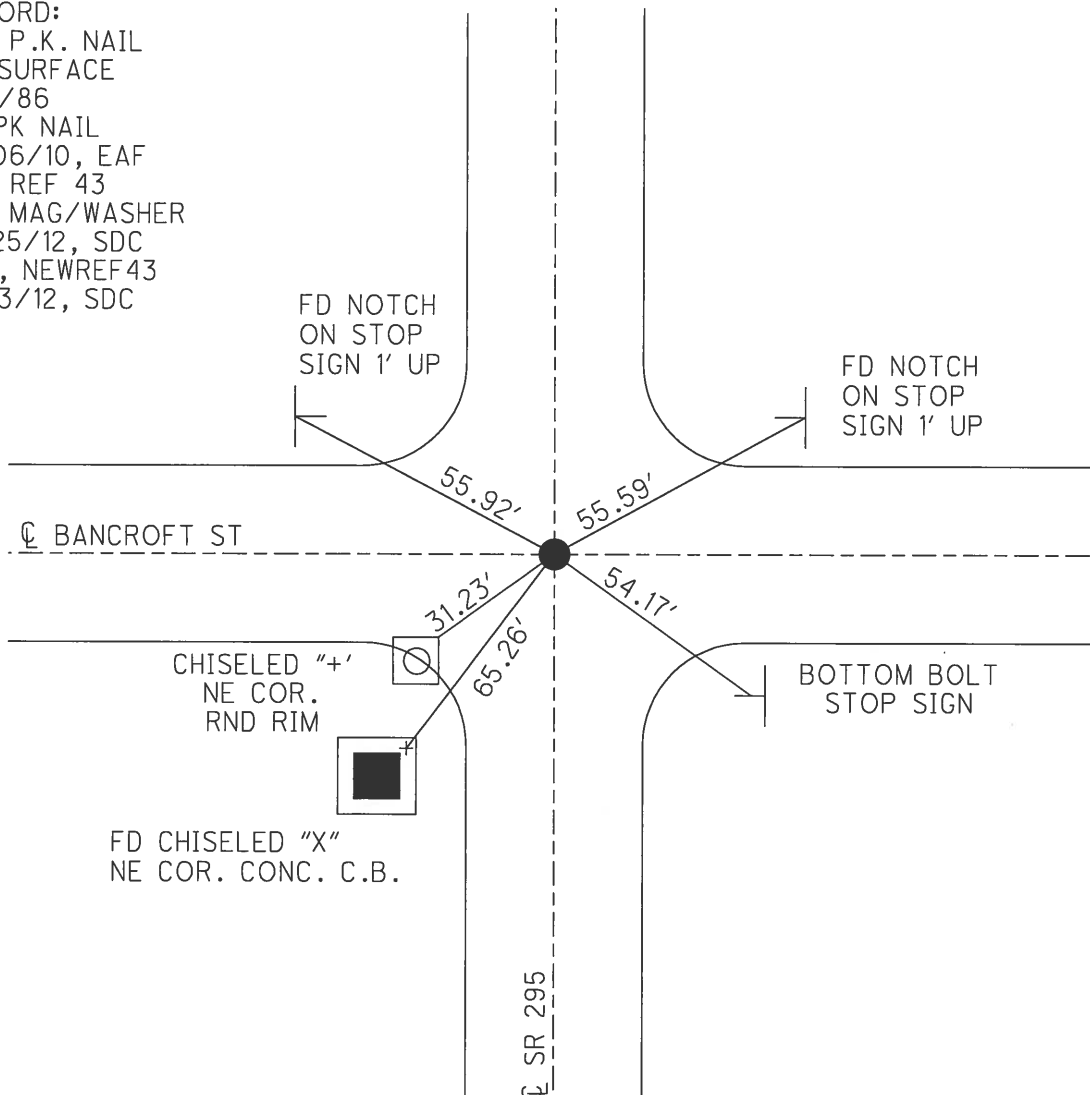


O.D.O.T. DISTRICT 2 SURVEY OFFICE (USE ONLY)

PERSONNEL _____ REFERENCE NO. 44 SHEET 20 OF 24
NOTES HARBAUGH DATE 7/2/12 ROUTE SR 295
H.C. HUSS WEATHER SUNNY COUNTY LUCAS
R.C. COUTCHER TEMP. 80° TOWNSHIP RICHFIELD
CANTERBURY SECTION 28
T 9 S R 5 E

TYPE MONUMENT _____ P.K. NAIL
ON SURFACE - ~~BELOW~~ ON _____
LEFT - ℄ PAV'T - ~~RIGHT~~ 2.4'
8.1' TO LT EDGE PAVEMENT
S.L.M. 927+70.21

GRID: NORTHING: 730915.408 EASTING: 1602945.008

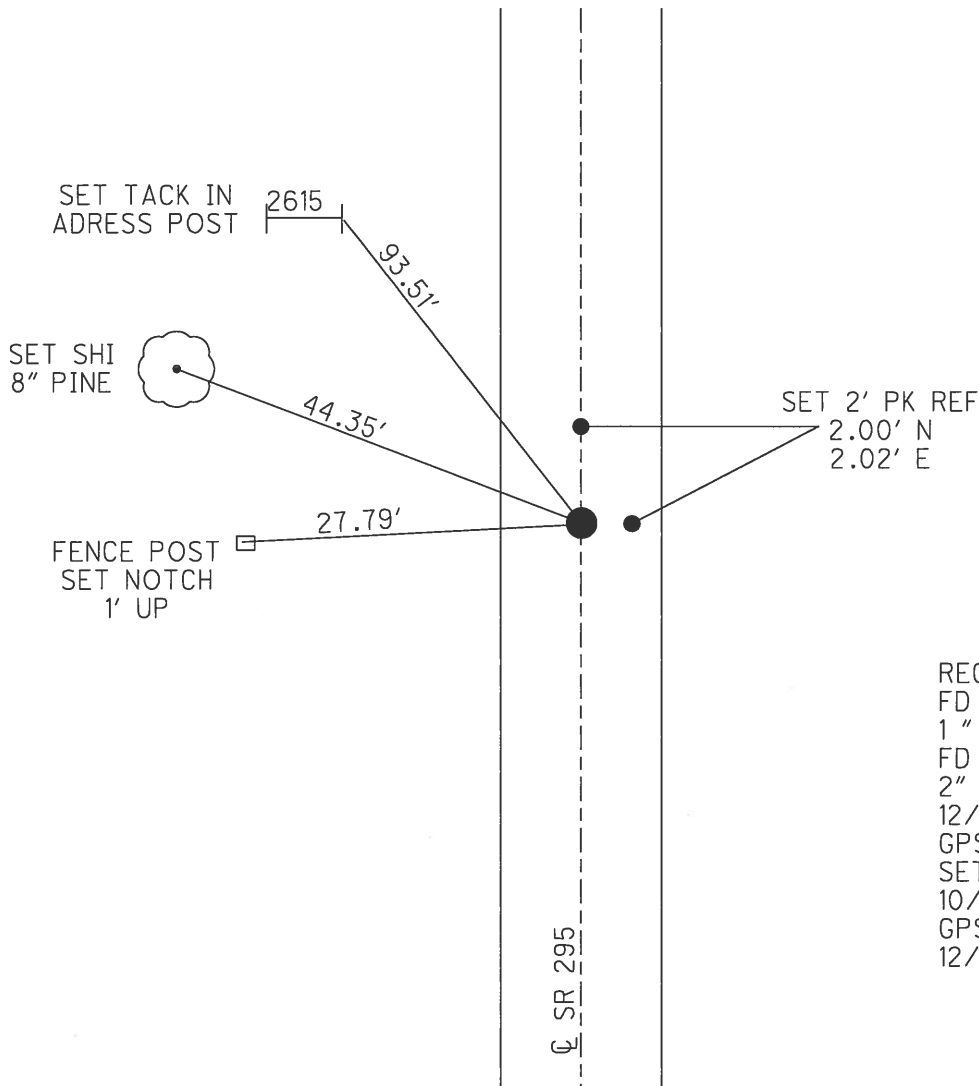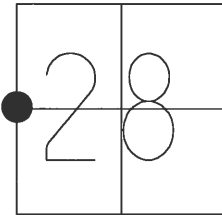

RECORD:
FD P.K.NAIL
1" DEEP, 8/11/86
FD P.K. SHANK
2" DEEP
12/29/10
GPS REF 44
SET MAG/WASHER
10/25/12, SDC
GPS, NEWREF44
12/13/12, SDC

O.D.O.T. DISTRICT 2 SURVEY OFFICE (USE ONLY)

PERSONNEL

REFERENCE NO. 44 A

SHEET 21 OF 24

NOTES HARBAUGH

DATE 7-2-12

ROUTE SR 295

H.C. HUSS

WEATHER FAIR

COUNTY LUCAS

R.C. COUTCHER

TEMP. 80°F

TOWNSHIP RICHFIELD

CANTERBURY

SECTION 28

DWG BY MAHLER

PID 107059

T 9 N R 5 E

TYPE MONUMENT P.K./WASHER

ON SURFACE - ~~BELOW~~ ON

OFFSET Q PAVEMENT ON, 1.0' S. Q US 20 LT : RT

- TO - EDGE PAVEMENT


STATION: 953+67.53

HORZ.DATUM: NAD83 (2011)


GEOID: NAVD88-2012A

GRID: NORTHING: 733512.807

EASTING: 1602925.437

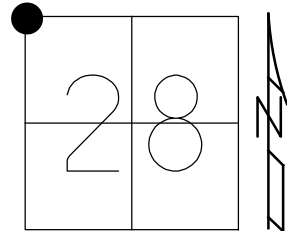

RECORD:
FD SQ BOLT
2" DEEP 1984
SET P.K./WASHER
12/18/1997, BWC
FD P.K. NAIL
REFA44
10/06/10, MC
FD BRASS DISK
W/LG. DIMPLE
IN CONC. PVMT
12-5-16, DCH

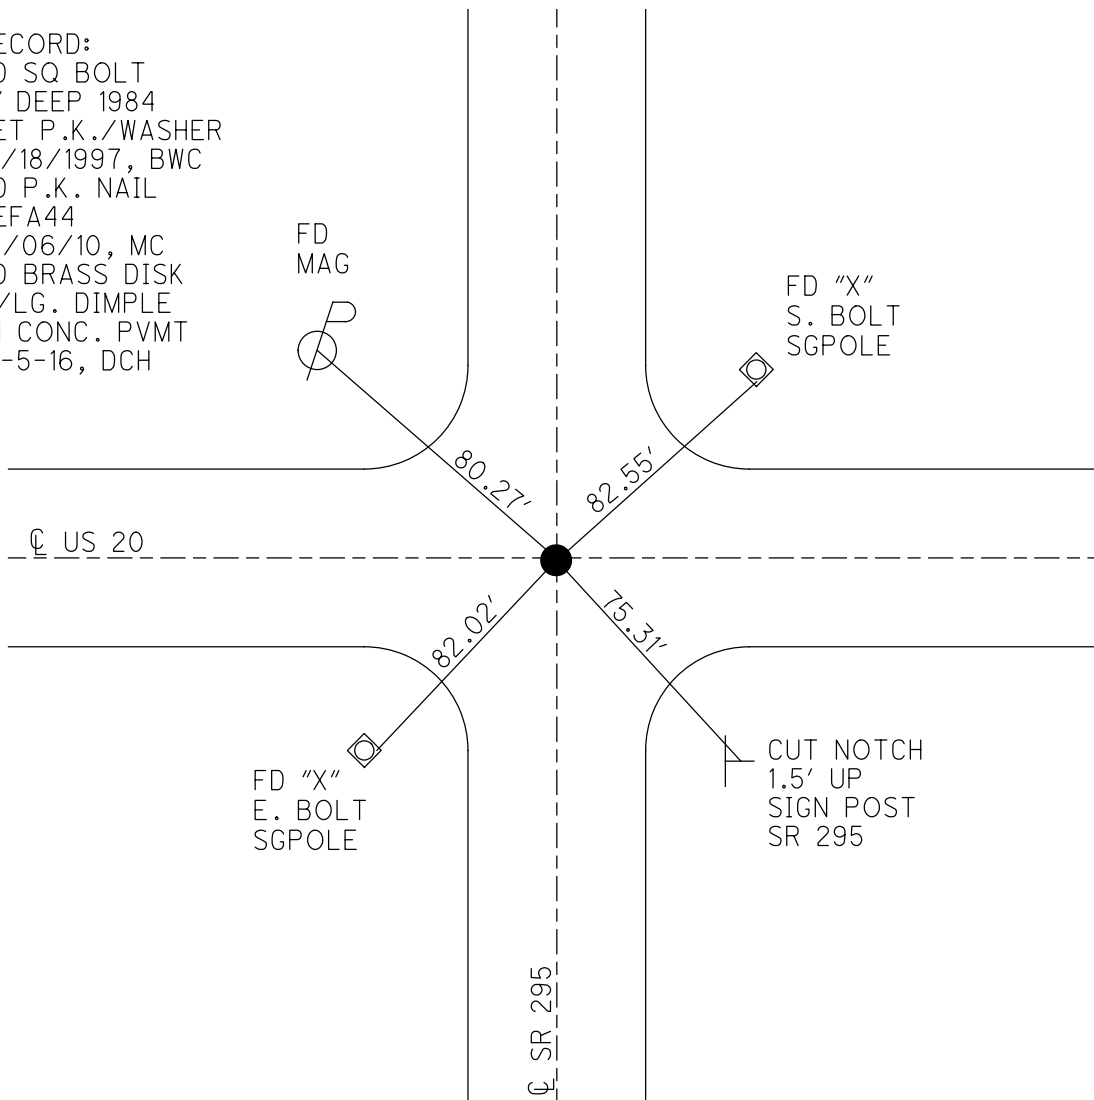

O.D.O.T. DISTRICT 2 SURVEY OFFICE (USE ONLY)

PERSONNEL

REFERENCE NO. 45

SHEET 22 OF 24

NOTES AUBLE

DATE 5-7-20

ROUTE SR 295

H.C. LEU

WEATHER BREEZY, CLEAR

COUNTY LUCAS

R.C. BALBAUGH

TEMP. 55°F

TOWNSHIP RICHFIELD

DWG BY MAHLER

PID 107059

SECTION 21

T 9 N R 5 E

TYPE MONUMENT MAG/WASHER

ON SURFACE - ~~BELOW~~ ON

OFFSET Q PAVEMENT 1.8' LT : ~~RT~~

8.8' TO LT EDGE PAVEMENT


STATION: 980+19.93

HORIZ.DATUM: NAD83 (2011)

GEOID: NAVD88-2012A

GRID: NORTHING: 736164.835

EASTING: 1602881.306

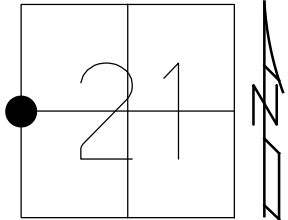

FD
SHI

58.62'

Q SR 295

FD REBAR
3.3' EB

30.74'

60.02'

SET NOTCH
1.4' UP
MP 21

RECORD:
FD P.K./WASHER
5/16/05
FD P.K. NAIL
10/06/10, MC
REF 45
SET MAG/WASHER
10/25/12, SDC
NEWREF 45
12/13/12, SDC
FD MAG/WASHER
3-6-19, JLL
REF 45
4-9-19, JLL

O.D.O.T. DISTRICT 2 SURVEY OFFICE (USE ONLY)

PERSONNEL

REFERENCE NO. 46

SHEET 23 OF 24

NOTES RHOADES
H.C. NIESE
R.C. ASTON
MILLER

DATE 11/15/23
WEATHER SUNNY
TEMP. 43°

ROUTE SR 295
COUNTY LUCAS
TOWNSHIP RICHFIELD
SECTION 21

DWG BY RHOADES PID 105618

T 9 N R 5 E

TYPE MONUMENT MAG/WASHER

ON SURFACE - ~~BELOW~~ ON

OFFSET CL PAVEMENT 1.0' ~~LT~~ : RT

- TO - EDGE PAVEMENT


STATION: 1137+31.20

HORIZ.DATUM: NAD83 (2011)

GEOID: NAVD88 2018


GRID: NORTHING: 738813.337

EASTING: 1602861.595

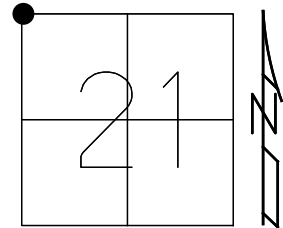

RECORD:
FD P.K./WASHER
5/16/05
FD P.K. NAIL
10/06/10, MC
REF 46
SET MAG/WASHER
10/25/12, SDC
NEWREF 46
12/13/12, SDC
FD P.K./WASHER
REF 46
4-9-19, JLL
FD MAG/WASHER
REF 46
9/1/23,
11/15/23, TDN

LUCAS LDP:
N: 359773.693
E: 112507.249

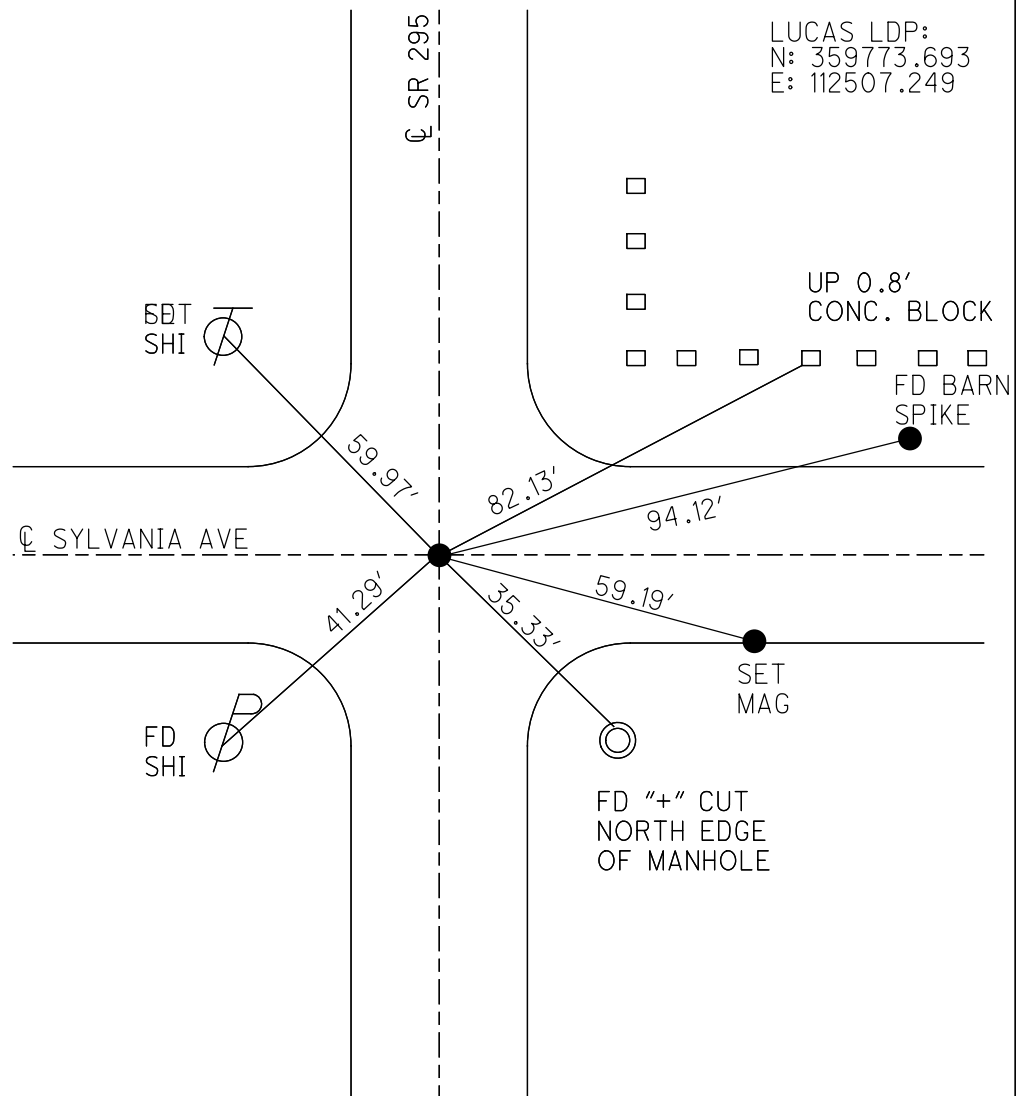

O.D.O.T. DISTRICT 2 SURVEY OFFICE (USE ONLY)

PERSONNEL

REFERENCE NO. 47

SHEET 24 OF 24

NOTES RHOADES

DATE 11/15/23

ROUTE SR 295

H.C. NIESE

WEATHER SUNNY

COUNTY LUCAS

R.C. ASTON

TEMP. 43°

TOWNSHIP RICHFIELD

MILLER

SECTION 16

DWG BY RHOADES PID 105618

T 9 N R 5 E

TYPE MONUMENT MAG/WASHER

ON SURFACE - ~~BELOW~~ ON

OFFSET Q PAVEMENT 2.0' LT : RT

9.0' TO LT EDGE PAVEMENT


STATION: 1163+03.87

HORZ.DATUM: NAD83 (2011)

GEOID: NAVD88 2018


GRID: NORTHING: 741385.847

EASTING: 1602827.495

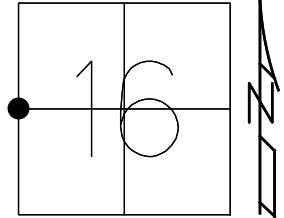

RECORD:
FD P.K./WASHER
5/16/05
SET MAG/WASHER
7/11/05, DCH
FD MAG/WASHER
REF47
10/06/10, EAF
FD MAG/WASHER
REF47
4-9-19, JLL
FD MAG NAIL
REF47
9/1/23,
SET MAG/WASHER
11/15/23, TDN

LUCAS LDP:
N: 362345.603
E: 112439.289

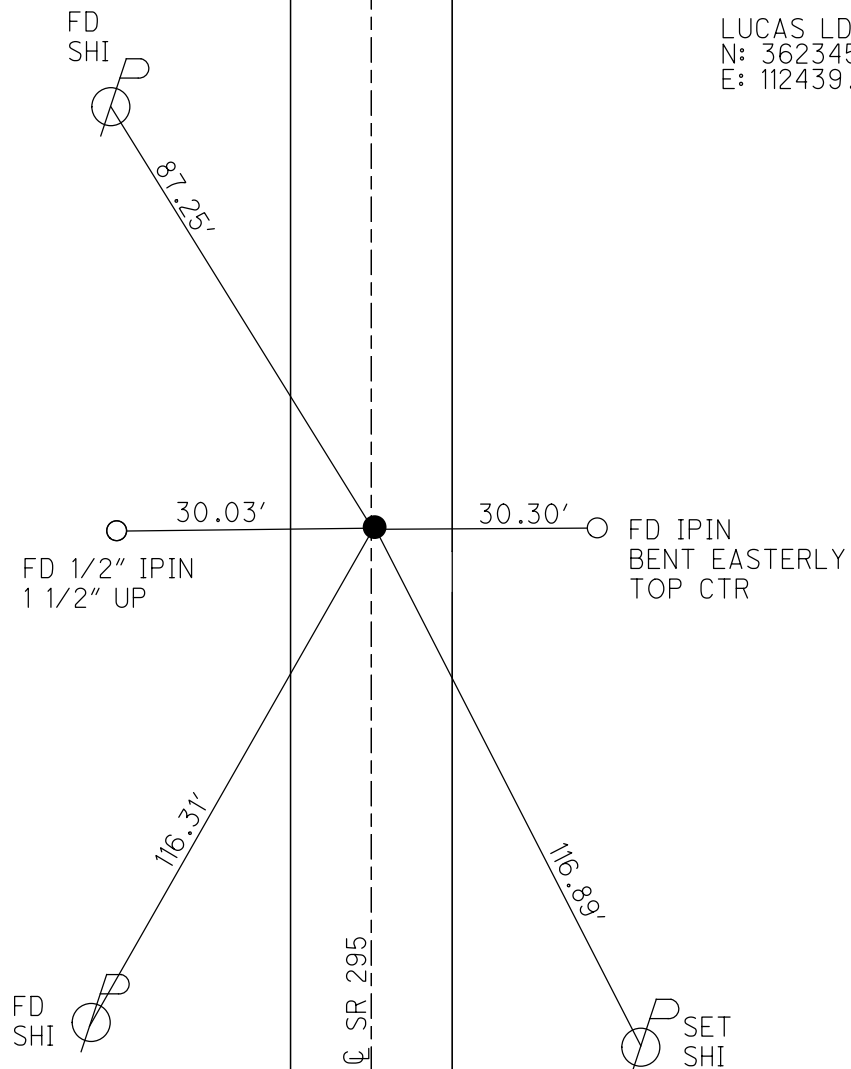

O.D.O.T. DISTRICT 2 SURVEY OFFICE (USE ONLY)

PERSONNEL

REFERENCE NO. 48

SHEET 1 OF 8

NOTES RHOADES

DATE 11/15/23

ROUTE SR 295

H.C. NIESE

WEATHER SUNNY

COUNTY LUCAS

R.C. ASTON

TEMP. 43°

TOWNSHIP RICHFIELD

MILLER

SECTION 9

DWG BY RHOADES

PID 105618

T 9 N R 5 E

TYPE MONUMENT MAG/WASHER

ON SURFACE - ~~BELOW~~ ON

OFFSET Q PAVEMENT 2.4' LT : RT

- TO - EDGE PAVEMENT



STATION: 1188+70.34

HORZ.DATUM: NAD83 (2011)

GEOID: NAVD88 2018

GRID: NORTHING: 743952.157

EASTING: 1602797.225

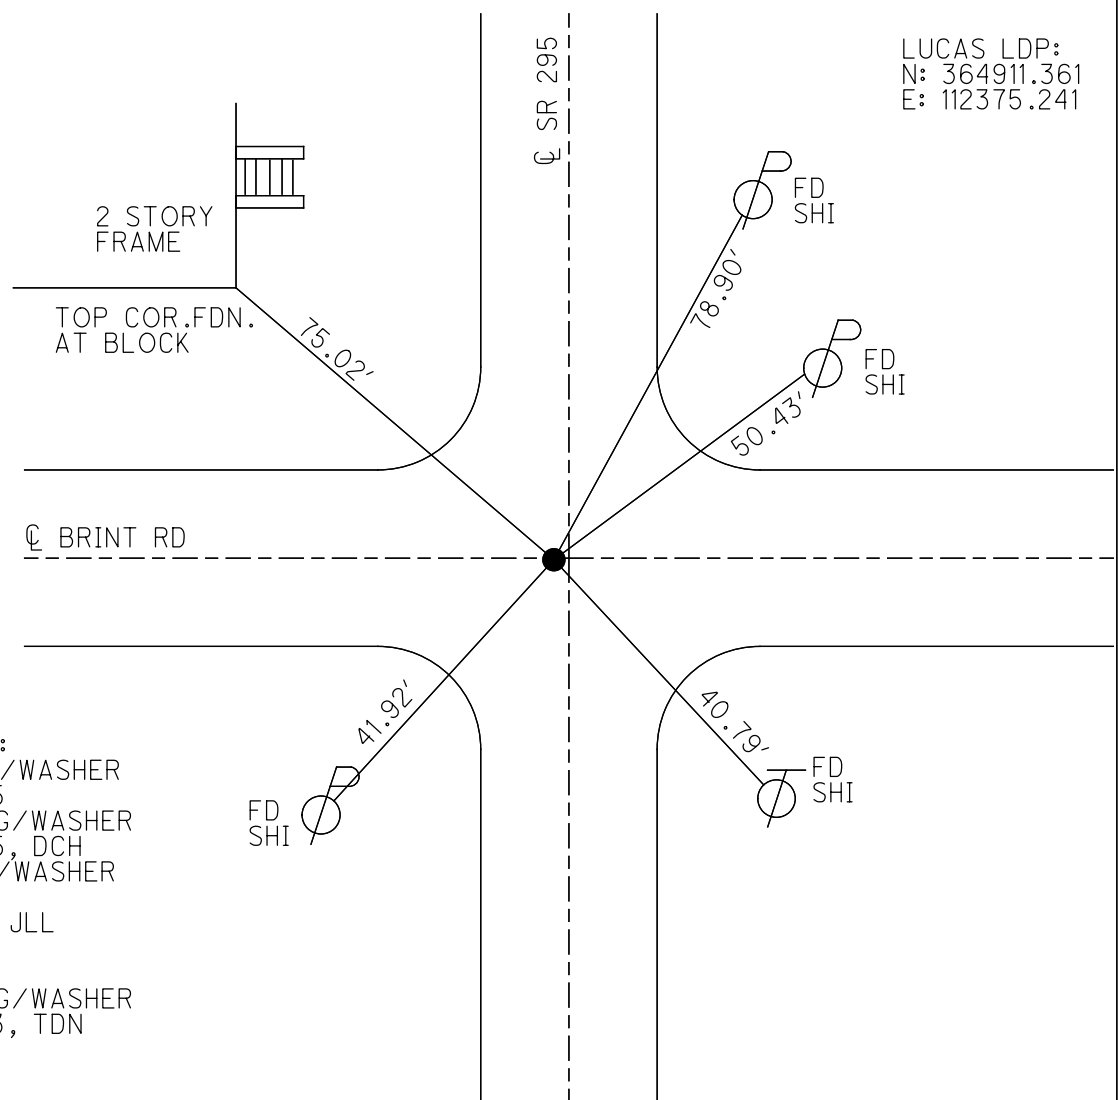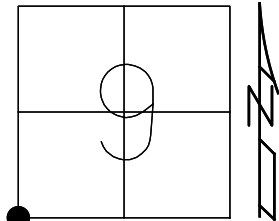

LUCAS LDP:
N: 364911.361
E: 112375.241

RECORD:
FD P.K./WASHER
5/17/05
SET MAG/WASHER
7/13/05, DCH
FD MAG/WASHER
REF48
3-6-19, JLL
REF48
9/1/23,
SET MAG/WASHER
11/15/23, TDN

O.D.O.T. DISTRICT 2 SURVEY OFFICE (USE ONLY)

PERSONNEL

REFERENCE NO. 49

SHEET 2 OF 8

NOTES RHOADES

DATE 11/15/23

ROUTE SR 295

H.C. NIESE

WEATHER SUNNY

COUNTY LUCAS

R.C. ASTON

TEMP. 43°

TOWNSHIP RICHFIELD

MILLER

SECTION 9

DWG BY RHOADES PID 105618

T 9 N R 5 E

TYPE MONUMENT MAG/WASHER

ON SURFACE - ~~BELOW~~ ON

OFFSET Q PAVEMENT 7' LT : ~~RT~~

3.3' TO LT EDGE PAVEMENT


STATION: 1215+69.59

HORIZ.DATUM: NAD83 (2011)

GEOID: NAVD88 2018


GRID: NORTHING: 746651.148

EASTING: 1602761.819

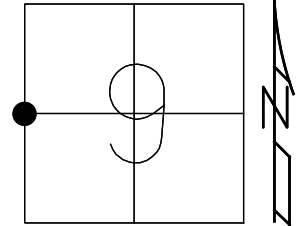

RECORD:
EAST/WEST 1/2 LINE
FD P.K./WASHER
5/17/05
SET MAG/WASHER
7/13/05, DCH
FD MAG/WASHER
REF49
3-6-19, JLL
FD MAG/WASHER
REF49
9/1/23,
SET MAG/WASHER
11/15/23, TDN

LUCAS LDP:
N: 367609.722
E: 112304.311

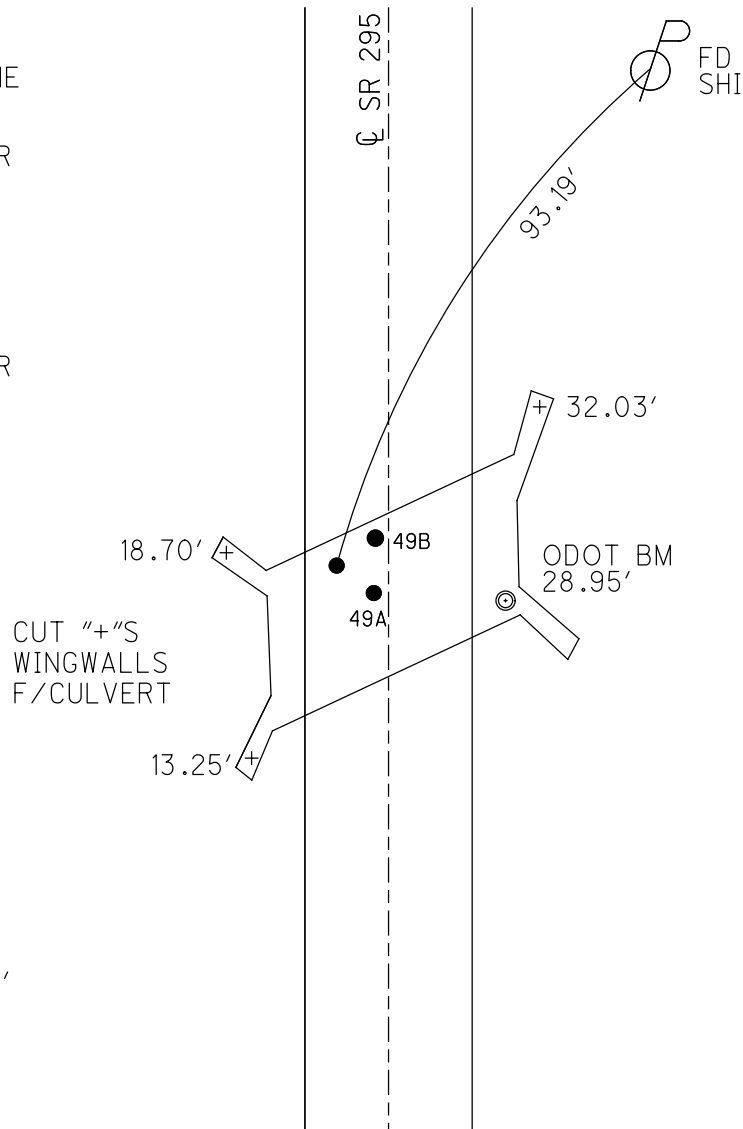

DIST.
49-49A = 6.67'
49A-49B = 1.45'
49-49B = 6.80'

O.D.O.T. DISTRICT 2 SURVEY OFFICE (USE ONLY)

PERSONNEL

REFERENCE NO. 49 A

SHEET 3 OF 8

NOTES RHOADES

DATE 11/15/23

ROUTE SR 295

H.C. NIESE

WEATHER SUNNY

COUNTY LUCAS

R.C. ASTON

TEMP. 43°

TOWNSHIP RICHFIELD

MILLER

SECTION 9

DWG BY RHOADES

PID 105618

T 9 N R 5 E

TYPE MONUMENT MAG/WASHER

ON SURFACE - ~~BELOW~~ ON

OFFSET Q PAVEMENT ON LT : RT

- TO - EDGE PAVEMENT


STATION: 1215+69.64

HORIZ.DATUM: NAD83 (2011)

GEOID: NAVD88 2018


GRID: NORTHING: 746651.282

EASTING: 1602768.474

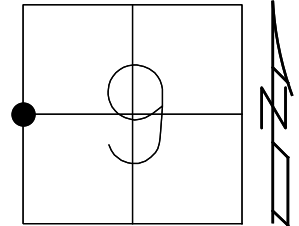

RECORD:
FD P.K./WASHER
5/17/05
SET MAG/WASHER
7/13/05, DCH
FD MAG/WASHER
REFA49
3-6-19, LEU
FD MAG/WASHER
REF49A
9/1/23,
SET MAG/WASHER
11/15/23, TDN

LUCAS LDP:
N: 367609.944
E: 112310.964

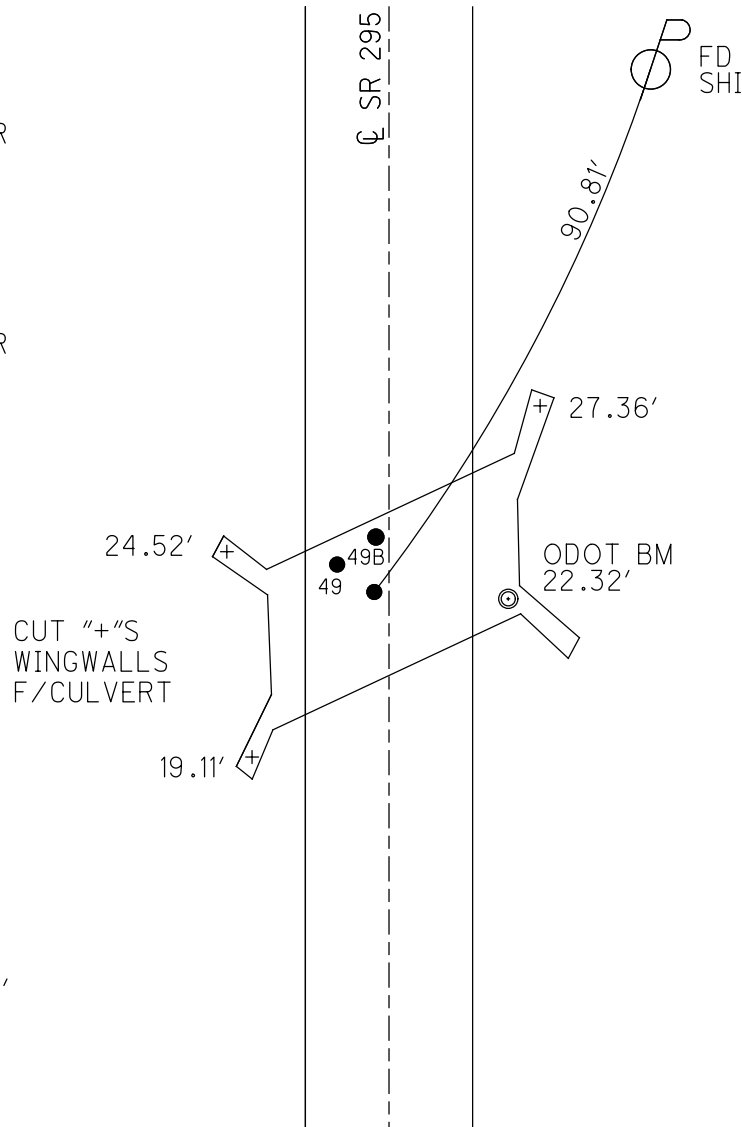

DIST.
49-49A = 6.67'
49A-49B = 1.45'
49-49B = 6.80'

O.D.O.T. DISTRICT 2 SURVEY OFFICE (USE ONLY)

PERSONNEL

REFERENCE NO. 49 B

SHEET 4 OF 8

NOTES RHOADES

DATE 11/15/23

ROUTE SR 295

H.C. NIESE

WEATHER SUNNY

COUNTY LUCAS

R.C. ASTON

TEMP. 43°

TOWNSHIP RICHFIELD

MILLER

SECTION 9

DWG BY RHOADES

PID 105618

T 9 N R 5 E

TYPE MONUMENT MAG/WASHER

ON SURFACE - ~~BELOW~~ ON

OFFSET Q PAVEMENT ON LT : RT

- TO - EDGE PAVEMENT


STATION: 1215+71.07

HORIZ.DATUM: NAD83 (2011)

GEOID: NAVD88 2018


GRID: NORTHING: 746652.744

EASTING: 1602768.415

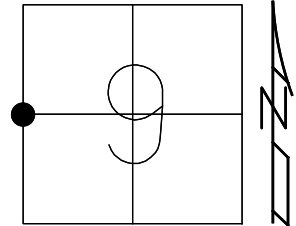

RECORD:
FD P.K./WASHER
5/17/05
SET MAG/WASHER
7/13/05, DCH
FD MAG/WASHER
REFB49
3-6-19, JLL
FD MAG/WASHER
REF49B
9/1/23,
SET MAG/WASHER
11/15/23, TDN

LUCAS LDP:
N: 367611.405
E: 112310.885

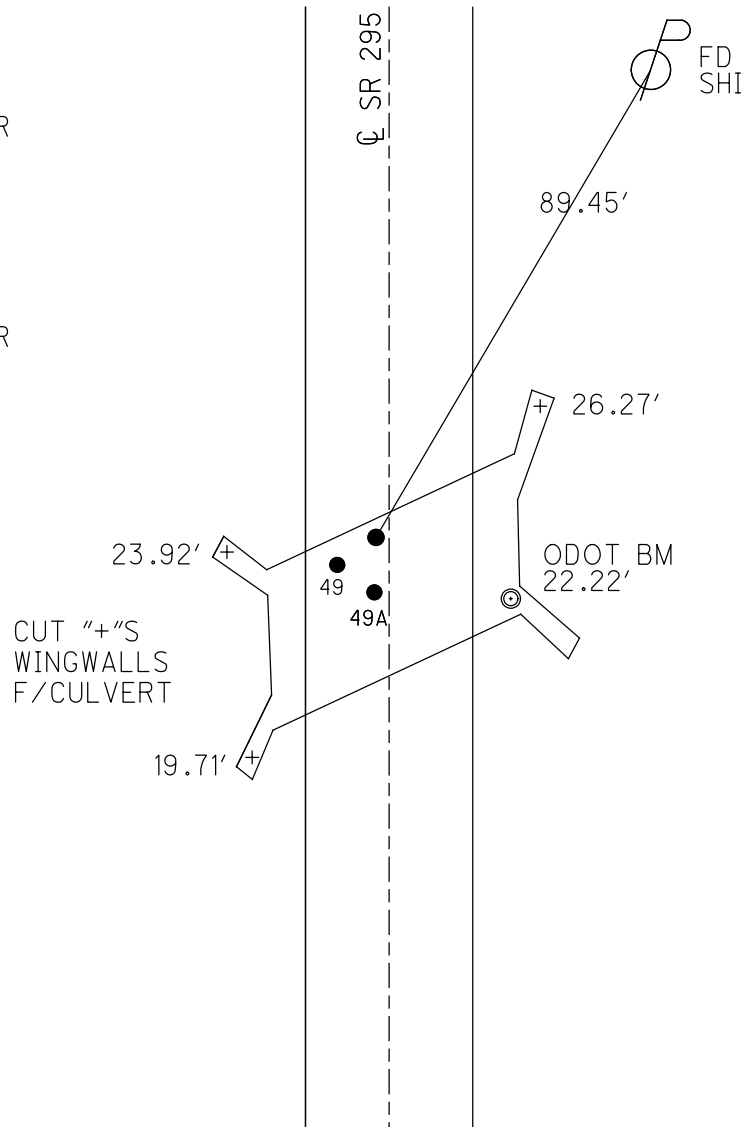

DIST.
49-49A = 6.67'
49A-49B = 1.45'
49-49B = 6.80'

O.D.O.T. DISTRICT 2 SURVEY OFFICE (USE ONLY)

PERSONNEL

REFERENCE NO. 50

SHEET 5 OF 8

NOTES RHOADES

DATE 11/15/23

ROUTE SR 295

H.C. NIESE

WEATHER SUNNY

COUNTY LUCAS

R.C. ASTON

TEMP. 43°

TOWNSHIP RICHFIELD

MILLER

SECTION 9

DWG BY RHOADES PID 105618

T 9 N R 5 E

TYPE MONUMENT MAG/WASHER

ON SURFACE - ~~BELOW~~ ON

OFFSET 2.5' LT : ~~RT~~

- TO - EDGE PAVEMENT


STATION: 1241+63.04

HORIZ.DATUM: NAD83 (2011)

GEOID: NAVD88 2018

GRID: NORTHING: 749244.405

EASTING: 1602730.354

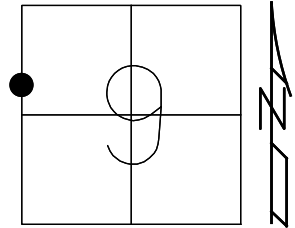

RECORD:
FD P.K./WASHER
5/17/05
SET MAG/WASHER
7/13/05, DCH
SHOT HOLE
3-6-19, JLL
SET MAG/WASHER
REF50
4-9-19, JLL
FD MAG/WASHER
REF50
9/1/23,
SET MAG/WASHER
11/15/23, TDN

BOTTOM
CONCRETE BASE
MARATHON
SIGN FDN

51

LUCAS LDP:
N: 370202.404
E: 112238.714

FD
SHI

NEAR CONRER
CONCRETE FDN.
OF BUILDING

STEP

CL SYLVANIA-METAMORA RD

50A

DIST. 50-51=106.55'

FD
SHI

31.57'

59.05'

41.99'

47.12'

FD
SHI

CL SR 295

UNKNOWN
FD MAG NAIL
STA. 1241+74.20
REF50A
N: 749255.599
E: 1602730.174

O.D.O.T. DISTRICT 2 SURVEY OFFICE (USE ONLY)

PERSONNEL

REFERENCE NO. 51

SHEET 6 OF 8

NOTES RHOADES

DATE 11/15/23

ROUTE SR 295

H.C. NIESE

WEATHER SUNNY

COUNTY LUCAS

R.C. ASTON

TEMP. 43°

TOWNSHIP RICHFIELD

MILLER

SECTION 9

DWG BY RHOADES

PID 105618

T 9 N R 5 E

TYPE MONUMENT MAG/WASHER

ON SURFACE - ~~BELOW~~ ON

OFFSET Q PAVEMENT 2.5' LT : RT

7.3' TO LT EDGE PAVEMENT


STATION: 1242+69.63

HORZ.DATUM: NAD83 (2011)

GEOID: NAVD88 2018


GRID: NORTHING: 749350.908

EASTING: 1602728.965

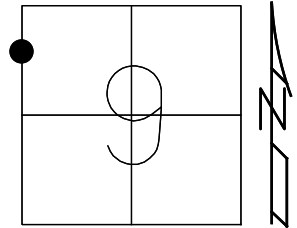

RECORD:
FD PK/WASHER
5/17/05
SET MAG/WASHER
7/13/05, DCH
FD MAG/WASHER
REF51
3-6-19, JLL
FD MAG/WASHER
REF51
9/1/23,
SET MAG/WASHER
11/15/23, TDN

LUCAS LDP:
N: 370308.882
E: 112235.923

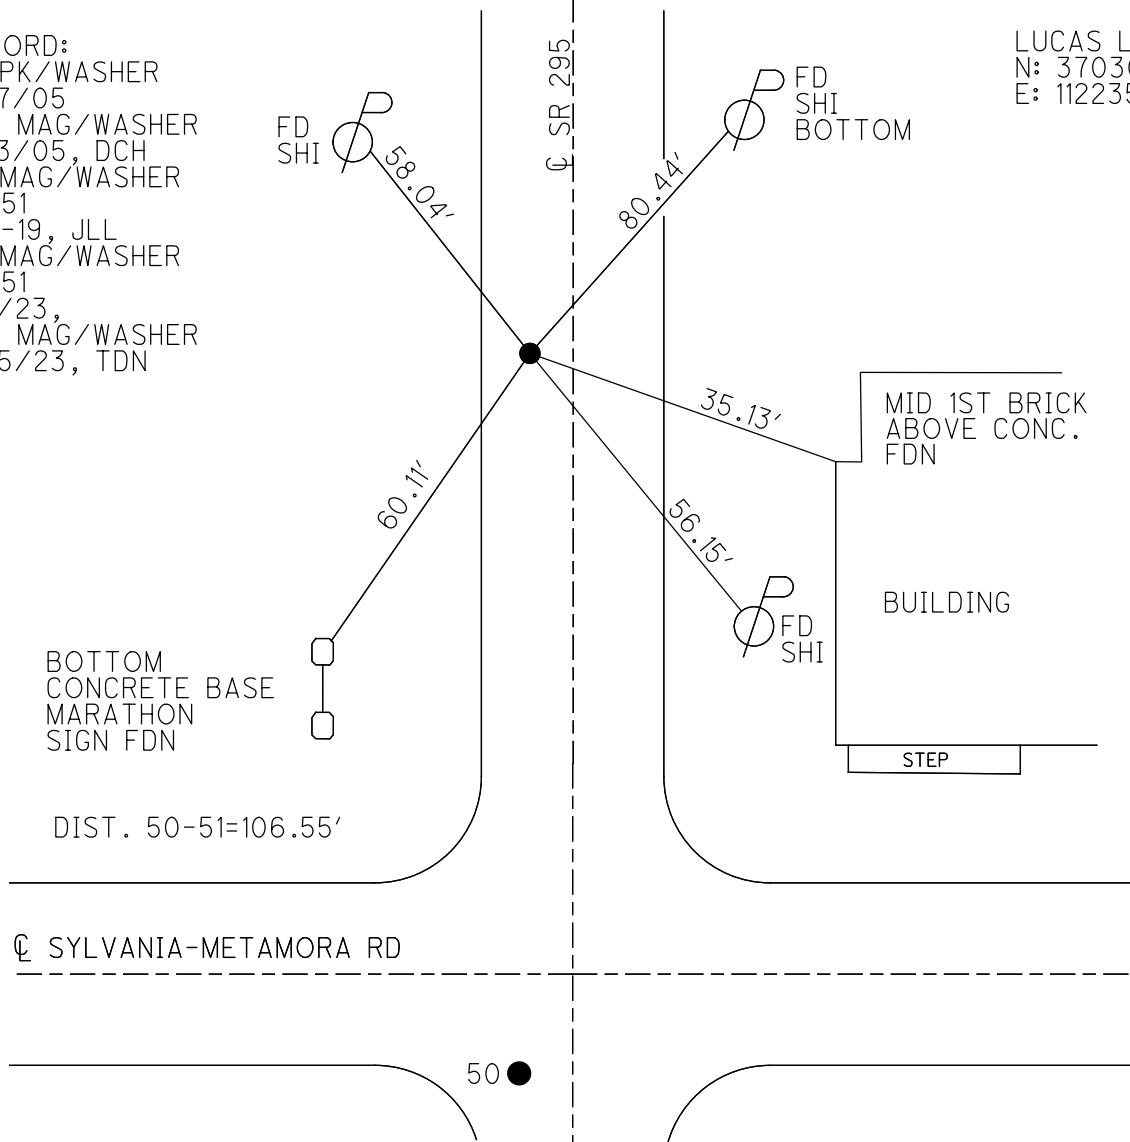

O.D.O.T. DISTRICT 2 SURVEY OFFICE (USE ONLY)

PERSONNEL

REFERENCE NO. 52

SHEET 7 OF 8

NOTES RHOADES

DATE 11/15/23

ROUTE SR 295

H.C. NIESE

WEATHER SUNNY

COUNTY LUCAS

R.C. ASTON

TEMP. 43°

TOWNSHIP RICHFIELD

MILLER

SECTION 9

DWG BY RHOADES

PID 105618

T 9 N R 5 E

TYPE MONUMENT MAG/WASHER

ON SURFACE - ~~BELOW~~ ON

OFFSET Q PAVEMENT 1.5' LT : RT

8.9' TO LT EDGE PAVEMENT


STATION: 1252+42.26

HORIZ.DATUM: NAD83 (2011)

GEOID: NAVD88 2018


GRID: NORTHING: 750323.518

EASTING: 1602716.714

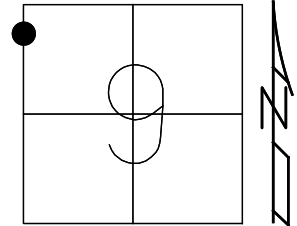

RECORD:
FD MAG/WASHER
5/17/05
FD MAG/WASHER
IN CONC.
APPROACH SLAB
REF52
3-6-19, JLL
FD P.K.NAIL
REF52
9/1/23,
11/15/23, TDN

LUCAS LDP:
N: 371281.270
E: 112210.871

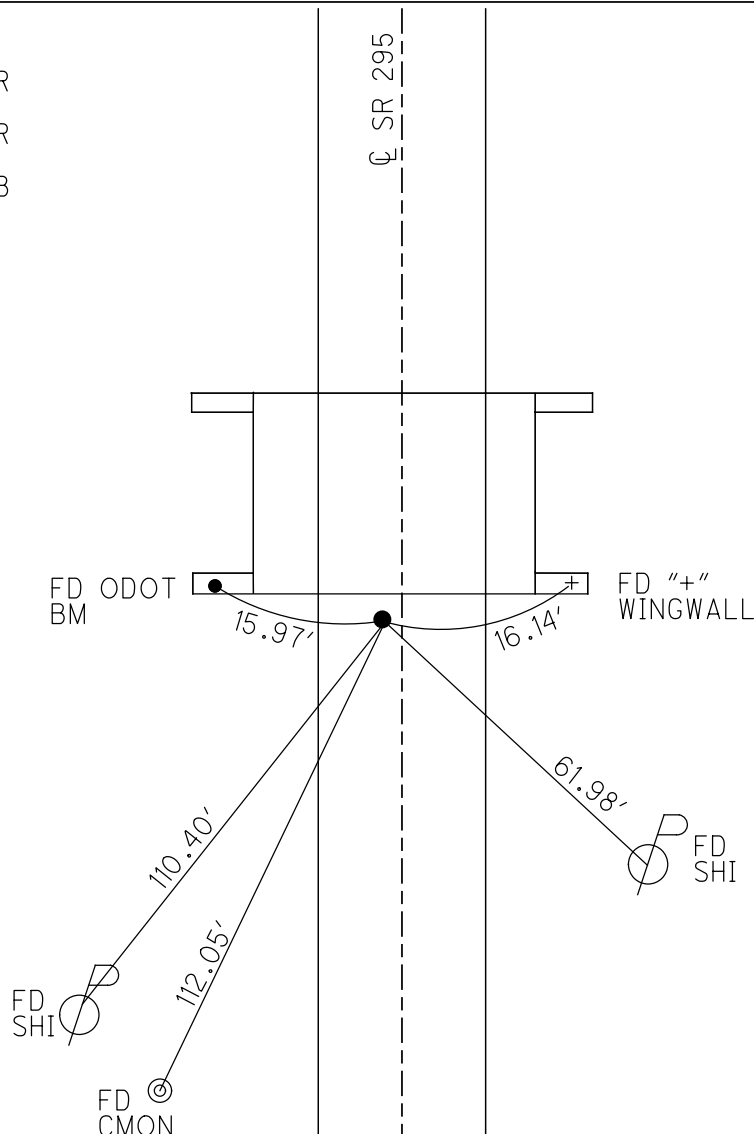

O.D.O.T. DISTRICT 2 SURVEY OFFICE (USE ONLY)

PERSONNEL

REFERENCE NO. 53

SHEET 8 OF 8

NOTES RHOADES
H.C. NIESE
R.C. ASTON
MILLER

DATE 11/15/23
WEATHER SUNNY
TEMP. 43°

ROUTE SR 295
COUNTY LUCAS
TOWNSHIP RICHFIELD
SECTION 9

DWG BY RHOADES PID 105618

T 9 N R 5 E

TYPE MONUMENT 1" IPIN

~~ON SURFACE~~ - BELOW 4"

OFFSET CL PAVEMENT ON LT : RT

10.7' TO LT EDGE PAVEMENT



STATION: 1263+74.37

HORZ.DATUM: NAD83 (2011)

GEOID: NAVD88 2018

GRID: NORTHING: 751455.584

EASTING: 1602698.499

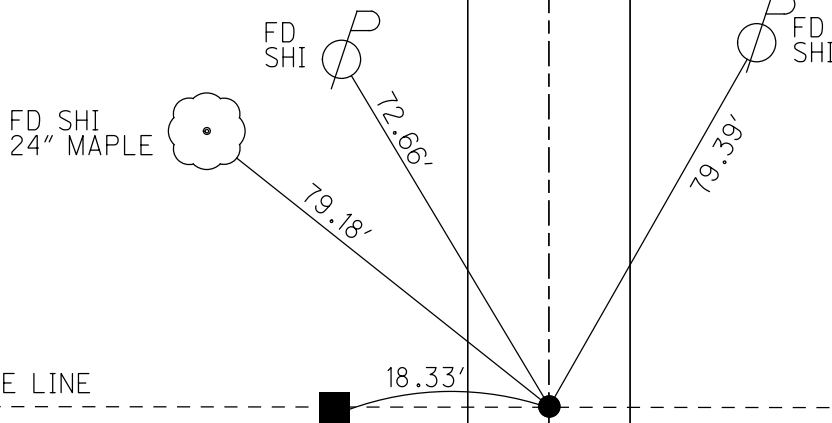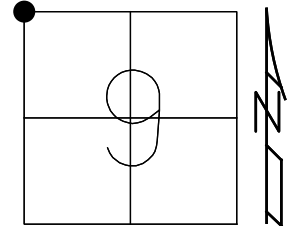

LUCAS LDP:
N: 372413.024
E: 112177.756

DRILL HOLE
ON TOP OF
STATE LINE
MONUMENT
*STATE LINE
MONUMENT APPEARS
TO HAVE BEEN MOVED,
TOP IS BROKEN OFF

RECORD:
FD P.K./WASHER
5/17/05
SET MAG/WASHER
7/13/05, DCH
FD MAG/WASHER
REF53
3-6-19, JLL
FD 1" IPIN
4" DOWN
REF53
9/1/23,
11/15/23, TDN

CL SR 295