


O.D.O.T. DISTRICT 2 SURVEY OFFICE (USE ONLY)

PERSONNEL _____ REFERENCE NO. 1 SHEET 1 OF 30
NOTES RHOADES DATE 7/20/17 ROUTE SR 590
H.C. O'DONNELL WEATHER SUNNY COUNTY OTTAWA
R.C. POORE TEMP. 82° TOWNSHIP HARRIS
SECTION 22
T 6 N R 14 E


TYPE MONUMENT MAG/WASHER
ON SURFACE - ~~BELOW~~ ON _____
LEFT - ℄ PAV'T - ~~RIGHT~~ 2' _____
7.8' TO LT. EDGE PAVEMENT
S.L.M. 0+00

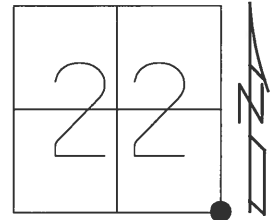


GRID: NORTHING: 653518.803 EASTING: 1770887.062

RECORD: P.I.
1927 PLAN
STA. 130+69.20
FD STONE
1973/1983
FD P.K./WASHER
7/5/01, BVD
SET P.K./WASHER
STA. 773+46
9/4/01, BVD
FD P.K./WASHER
1/24/06, RGN
SET MAG/WASHER
5/28/09, SAH
FD P.K./WASHER
REF30
3/28/16, JFO
SET MAG/WASHER
7/20/17, JFO
UNCOVERED
11/8/17, JFO

NOTE:
SAN. CO. REF 30

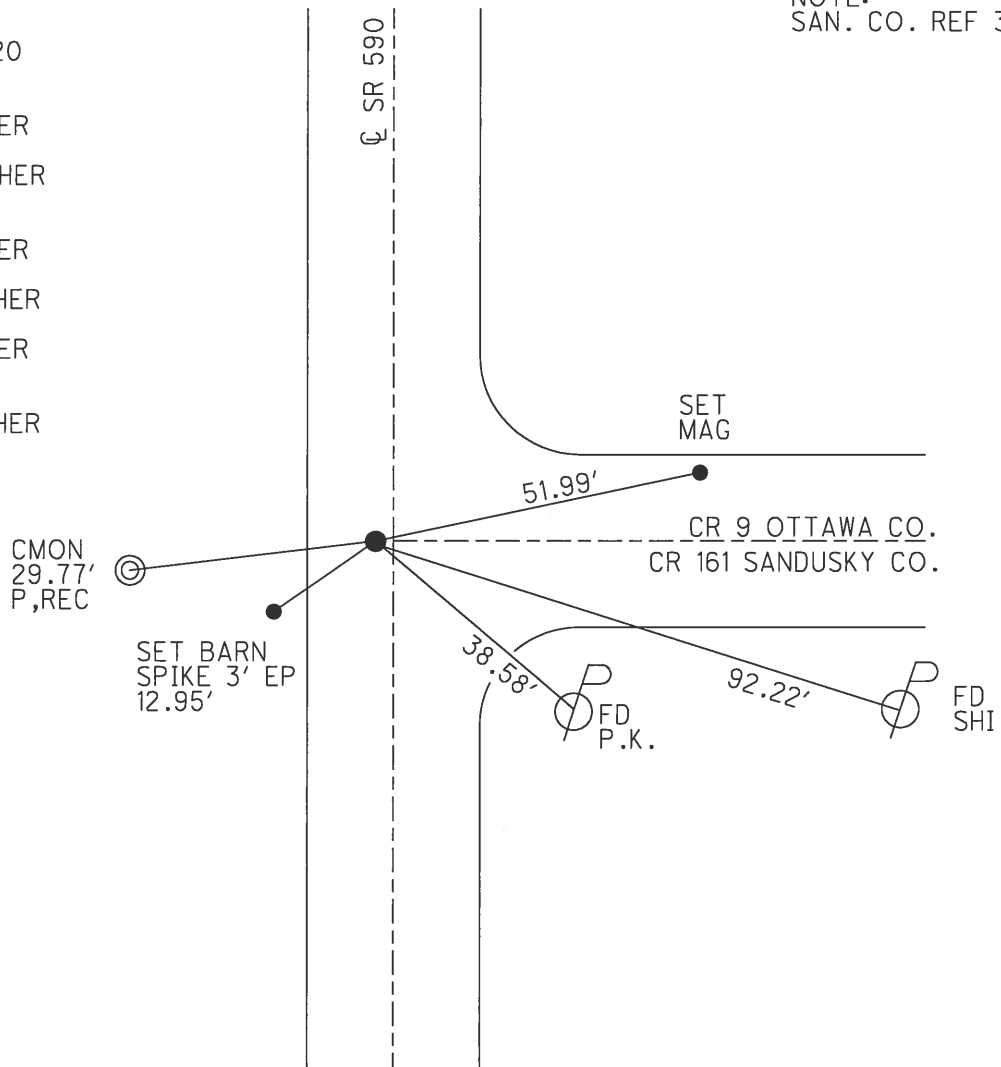

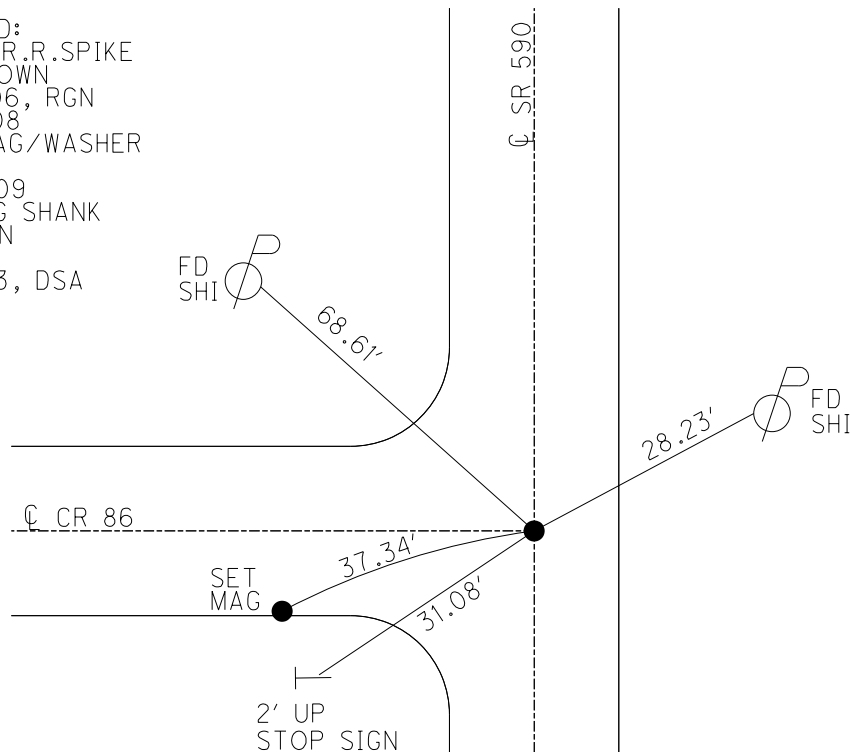

O.D.O.T. DISTRICT 2 SURVEY OFFICE (USE ONLY)

PERSONNEL

REFERENCE NO. 3

SHEET 3 OF 30

NOTES RHOADES

DATE 8/4/23

ROUTE SR 590

H.C. AUBLE

WEATHER SUNNY

COUNTY OTTAWA

R.C. ASTON

TEMP. 84°

TOWNSHIP HARRIS

SECTION 22

DWG BY RHOADES

PID PAVETRAIN

T 6 N R 14 E

TYPE MONUMENT MAG/WASHER

ON SURFACE - ~~BELOW~~ ON

OFFSET CL PAVEMENT 2' LT : ~~RT~~

9.1' TO LT EDGE PAVEMENT



STATION: 39+70

HORIZ.DATUM: NAD83 2011

GEOID: NAVD88 2018

GRID: NORTHING: 657478.143

EASTING: 1770873.866

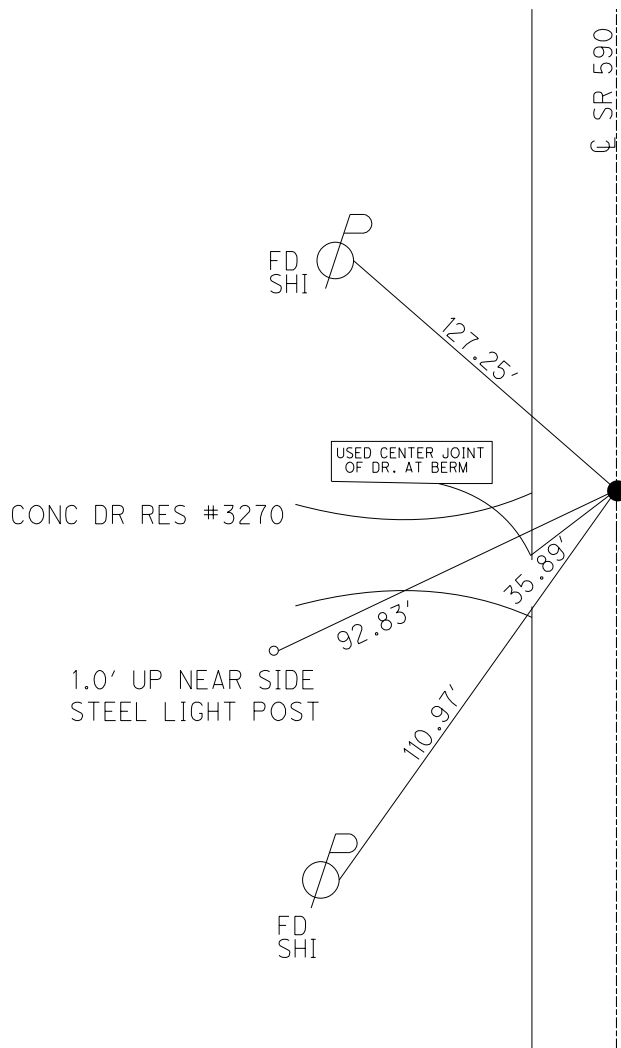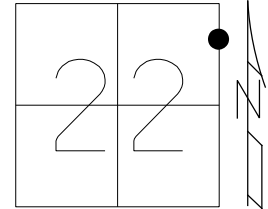

RECORD:
FD P.K./WASHER
0.1' DOWN
7/10/08
SET MAG/WASHER
SV103
5/28/09, SAH
FD MAG/WASHER
REF3
8/4/23, DSA

O.D.O.T. DISTRICT 2 SURVEY OFFICE (USE ONLY)

PERSONNEL

REFERENCE NO. 4

SHEET 4 OF 30

NOTES RHOADES

DATE 12/29/23

ROUTE SR 590

H.C. MILLER

WEATHER CLOUDY

COUNTY OTTAWA

R.C. RHOADES

TEMP. 40°

TOWNSHIP HARRIS

SECTION 22

DWG BY RHOADES

PID PAVETRAIN

T 6 N R 14 E

TYPE MONUMENT MAG SHANK

~~ON SURFACE~~ - BELOW ON

OFFSET Q PAVEMENT 1.6' LT : ~~RT~~

- TO - EDGE PAVEMENT


STATION: 52+82

HORIZ.DATUM: NAD83 2011


GEOID: NAVD88 2018

GRID: NORTHING: 658796.238

EASTING: 1770866.606

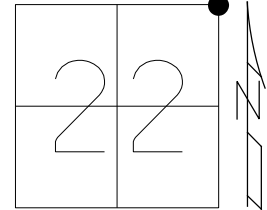

RECORD:
FD MAG/WASHER
SV104
7/10/08, RGN
SET MAG/WASHER
5/28/09, SAH
FD MAG SHANK
NEWREF4
12/29/23, JAM

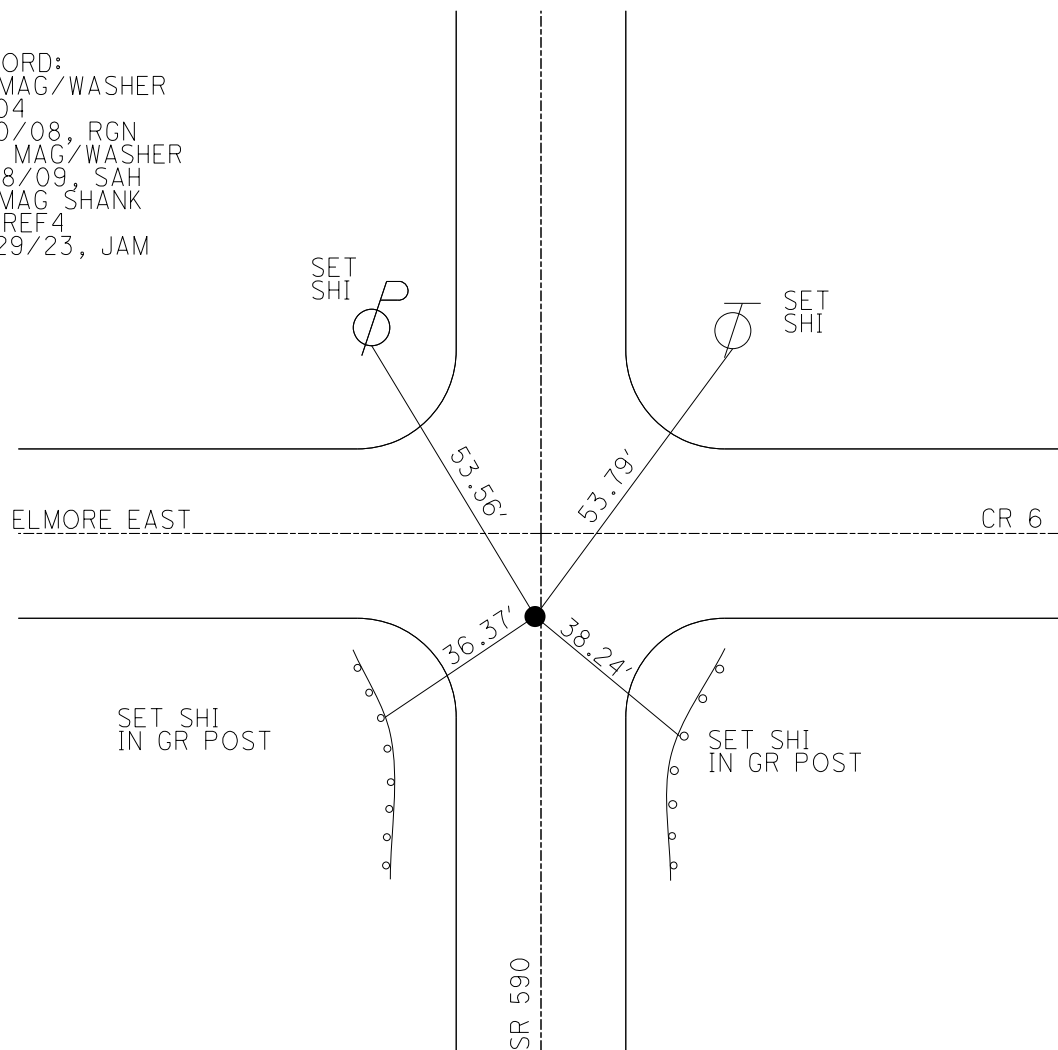

O.D.O.T. DISTRICT 2 SURVEY OFFICE (USE ONLY)

PERSONNEL

REFERENCE NO.

5

SHEET

5

OF 30

NOTES

HUSS

DATE

1/24/06

ROUTE

SR 590

H.C.

MATT H

WEATHER

CLDY/WINDY

COUNTY

OTTAWA

R.C.

RYAN H

TEMP.

29°

TOWNSHIP

HARRIS

SECTION

15

T_6 N R_14 E

TYPE MONUMENT

P.K./WASHER

ON SURFACE - ~~BELOW~~

ON

~~LEFT~~ - C PAV'T - ~~RIGHT~~

ON

10' TO RT EDGE PAVEMENT


S.L.M.

 $78+90.7$

GRID: NORTHING: 661411.611

EASTING: 1770863.152


RECORD:
SET MAG/WASHER
5/28/09, SAH
GPS SV105,
7/01/08, 7/10/08

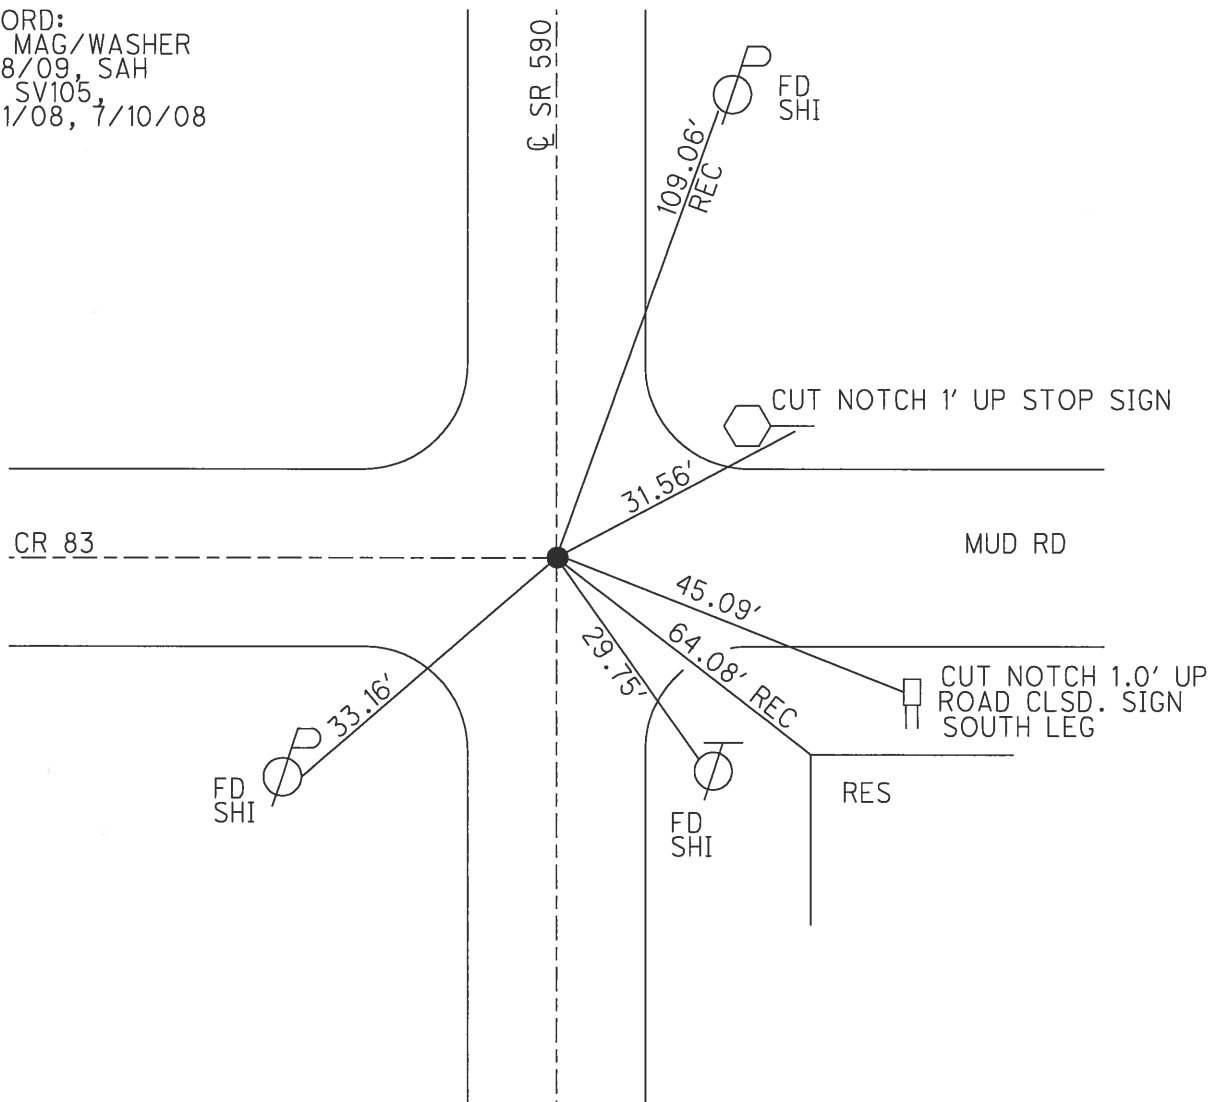

O.D.O.T. DISTRICT 2 SURVEY OFFICE (USE ONLY)


PERSONNEL	REFERENCE NO. <u>6</u>	SHEET <u>6</u> OF <u>30</u>
NOTES	DATE <u>1/24/06</u>	ROUTE <u>SR 590</u>
H.C. <u>HUSS</u>	WEATHER <u>CLDY/WINDY</u>	COUNTY <u>OTTAWA</u>
R.C. <u>MATT H</u>	TEMP. <u>29°</u>	TOWNSHIP <u>HARRIS</u>
<u>RYAN H</u>		SECTION <u>10</u>
<u>NUHFER</u>		T <u>6</u> N R <u>14</u> E

TYPE MONUMENT P.K./WASHER
 ON SURFACE - ~~BELOW~~ ON
 LEFT - CL PAV'T - ~~RIGHT~~ 0.6'
11.0' TO RT EDGE PAVEMENT
 S.L.M. 105+65

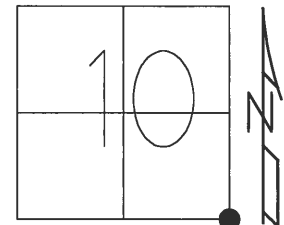

GRID: NORTHING: 664045.906 EASTING: 1770856.022

RECORD:
 SET MAG/WASHER
 6/09/09, SAH
 GPS SV106,
 7/01/08, 7/10/08

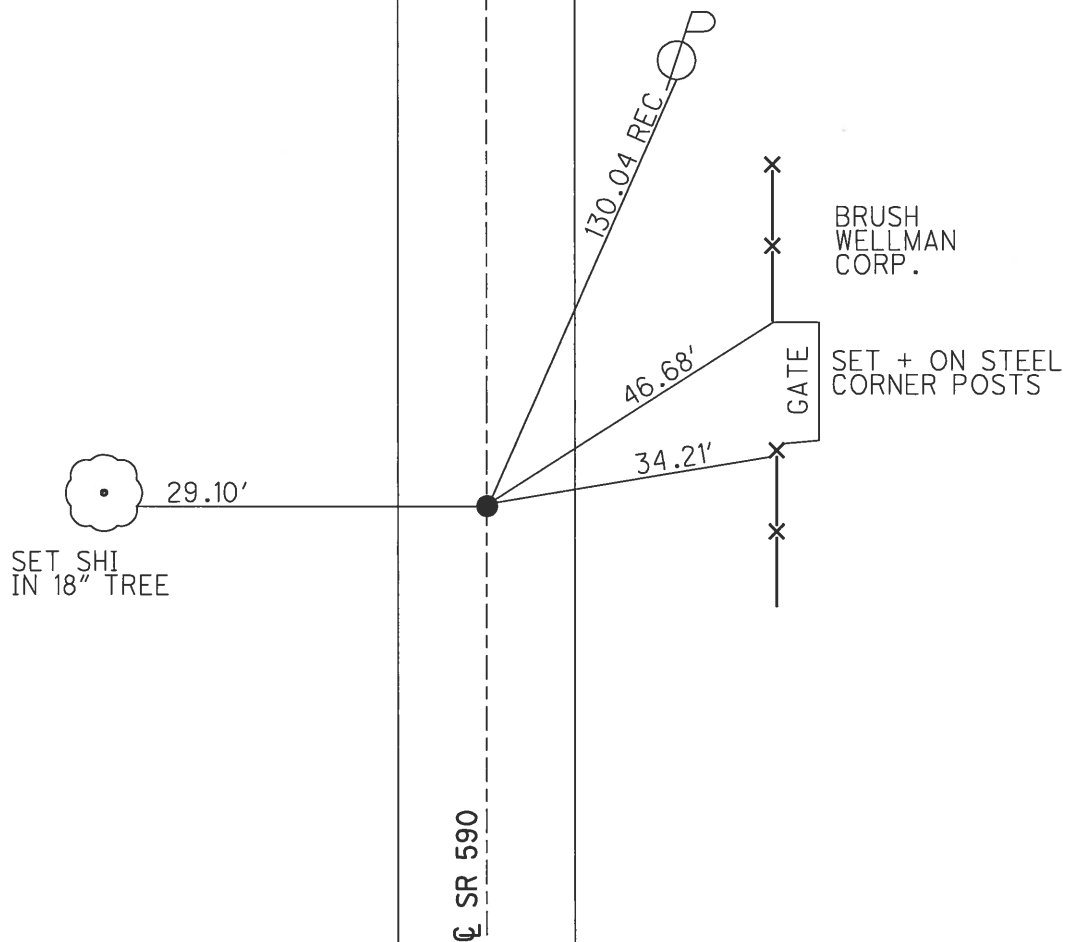

O.D.O.T. DISTRICT 2 SURVEY OFFICE (USE ONLY)

PERSONNEL

REFERENCE NO. 7 SHEET 7 OF 30

NOTES HUSS
H.C. MATT H
R.C. RYAN H
NUHFER

DATE 1/24/06
WEATHER CLDY/WINDY
TEMP. 29°

ROUTE SR 590
COUNTY OTTAWA
TOWNSHIP HARRIS
SECTION 10
T 6 N R 14 E

TYPE MONUMENT P.K. NAIL


~~ON SURFACE~~ - BELOW BELOW

LEFT - ℄ PAV'T - ~~RIGHT~~ 1.0'


- TO - EDGE PAVEMENT

S.L.M. 115+55

GRID: NORTHING: - EASTING: -

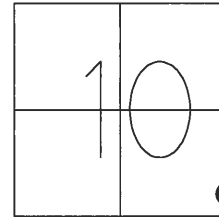

RECORD: T.S.
DNF
1/27/06, SAH
DNF
P.P WITH SHI FD
11/14/91
DNF POINT

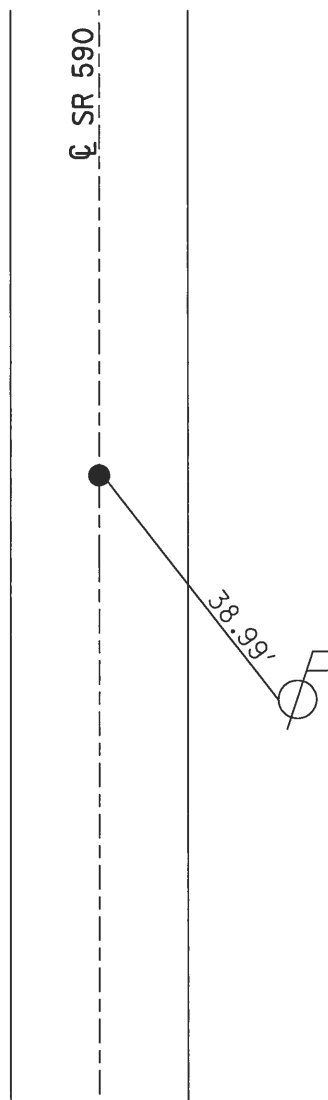

ORD:
 MAG/WASHER
 9/09, SAH
 SV-A108,
 /08

The diagram shows a four-way intersection with the following features:

- Proposed Centerlines:** Dashed lines labeled "C CR 18" (horizontal) and "C SR 590" (vertical).
- Right-of-Way Lines:** Solid lines forming the intersection boundaries.
- Utility Locations:** Circles with a crossbar, labeled "FD MAG" (Fire Department Main Gas) and "SET SHI" (Setback Street Light).
- Distances:**
 - 42.93' (from intersection to top-left utility)
 - 67.16' (from intersection to top-right utility)
 - 74.37' (from intersection to bottom-left utility)
 - 65.97' (from intersection to bottom-right utility)
 - 48.59' (from intersection to right-side utility)
- Other Labels:**
 - "8A" near the top centerline.
 - "DIST. 8-8A= 9.10'" on the right side.

O.D.O.T. DISTRICT 2 SURVEY OFFICE (USE ONLY)

PERSONNEL

REFERENCE NO.

8A

SHEET

9

OF

30

NOTES

HUSS

DATE

1/27/06

ROUTE

SR 590

H.C.

NUHFER

WEATHER

CLEAR

COUNTY

OTTAWA

R.C.

RYAN H

TEMP.

30°

TOWNSHIP

HARRIS

SECTION

10

T 6 N R 14 E

TYPE MONUMENT

P.K. SHANK

ON SURFACE - BELOW

0.3'

LEFT - C PAV'T - RIGHT

4.4'


- TO - EDGE PAVEMENT

S.L.M.


118+01.30


GRID: NORTHING:

EASTING:

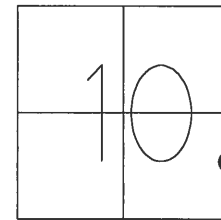

RECORD:
SET MAG/WASHER
6/09/09, SAH
GPS, SV-B108,
8/11/08

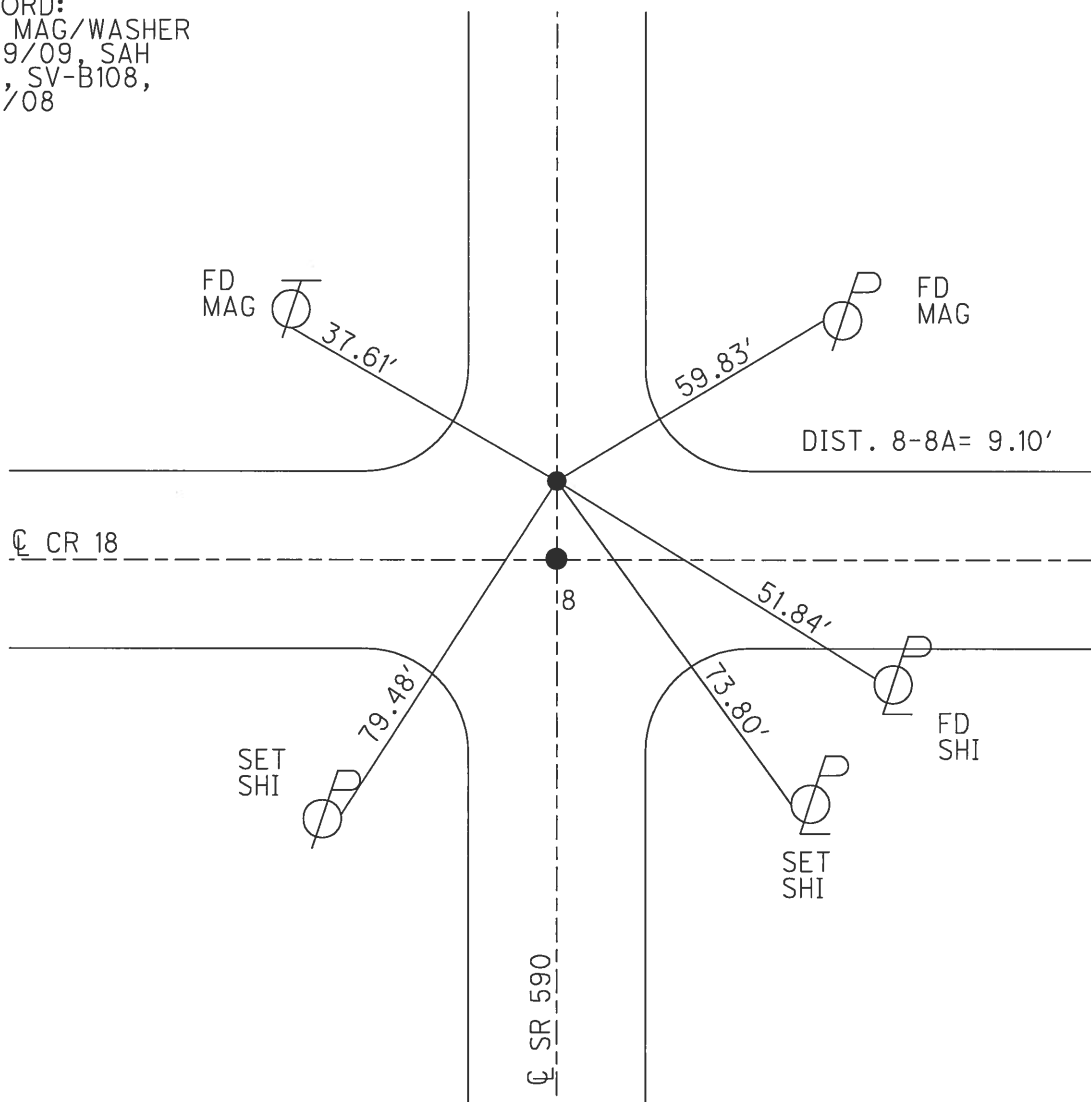

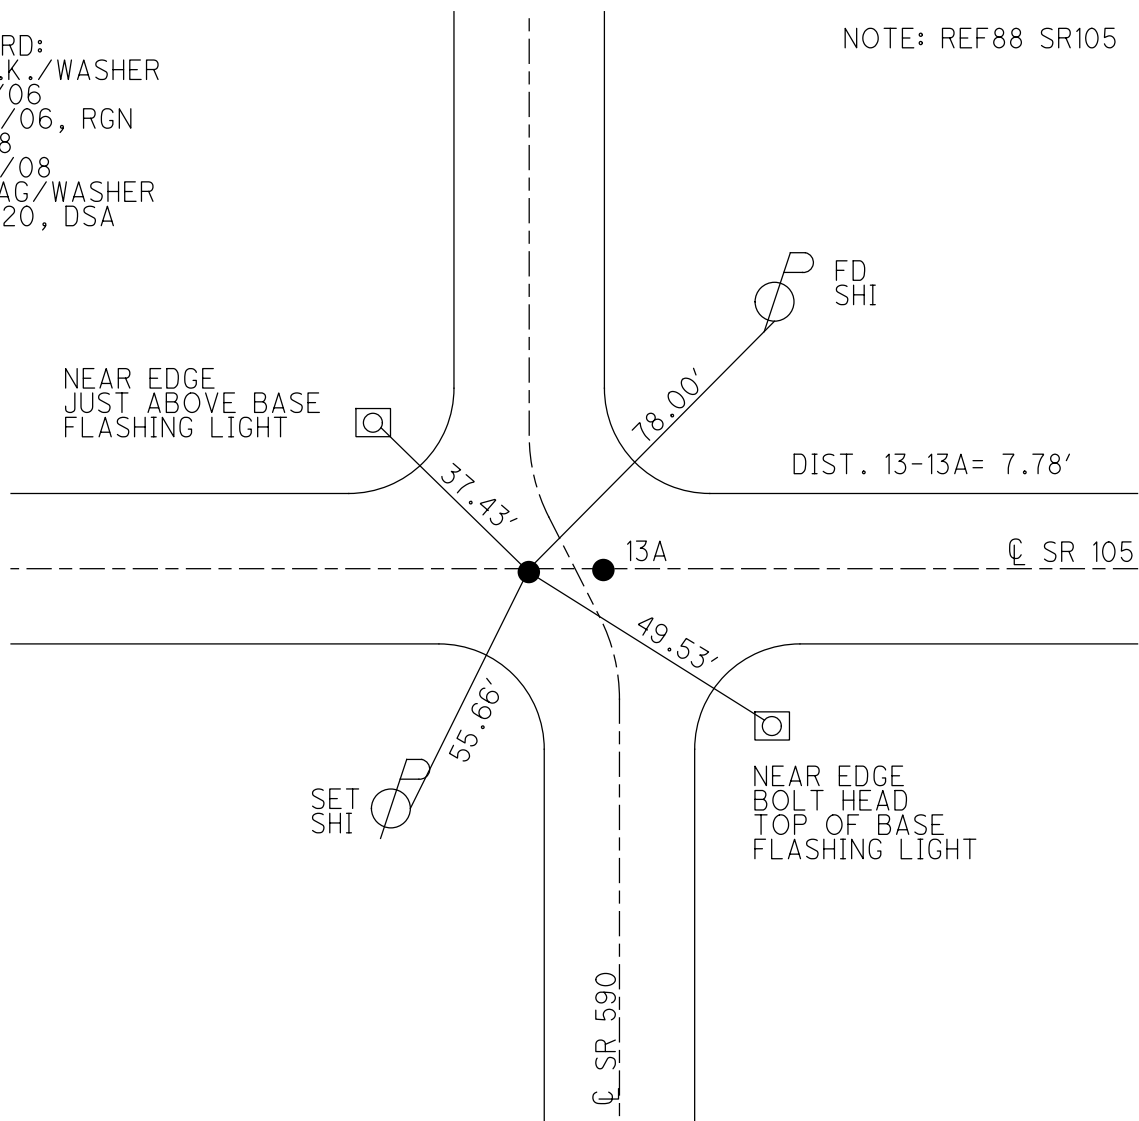

O.D.O.T. DISTRICT 2 SURVEY OFFICE (USE ONLY)

PERSONNEL

REFERENCE NO. 13 A

SHEET 11 OF 30

NOTES HUSS

DATE 1/27/06

ROUTE SR 590

H.C. NUHFER

WEATHER CLEAR

COUNTY OTTAWA

R.C. RYAN H.

TEMP. 31°

TOWNSHIP HARRIS

SECTION 10

DWG BY RHOADES

PID PAVING TRAIN

T 6 N R 14 E

TYPE MONUMENT P.K./WASHER

ON SURFACE - ~~BELOW~~ ON

OFFSET CL PAVEMENT 1.5' LT : ~~RT~~

- TO - EDGE PAVEMENT


STATION: 129+37.3

HORZ.DATUM: NAD83 2011

GEOID: 2012A


GRID: NORTHING: 666372.317

EASTING: 1770725.868

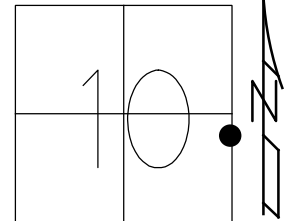

RECORD:
FD P.K./WASHER
1/27/06
12/01/06, RGN
SVB88
8/04/08
FD MAG/WASHER
7-31-20, DSA

NOTE: REF88A SR105

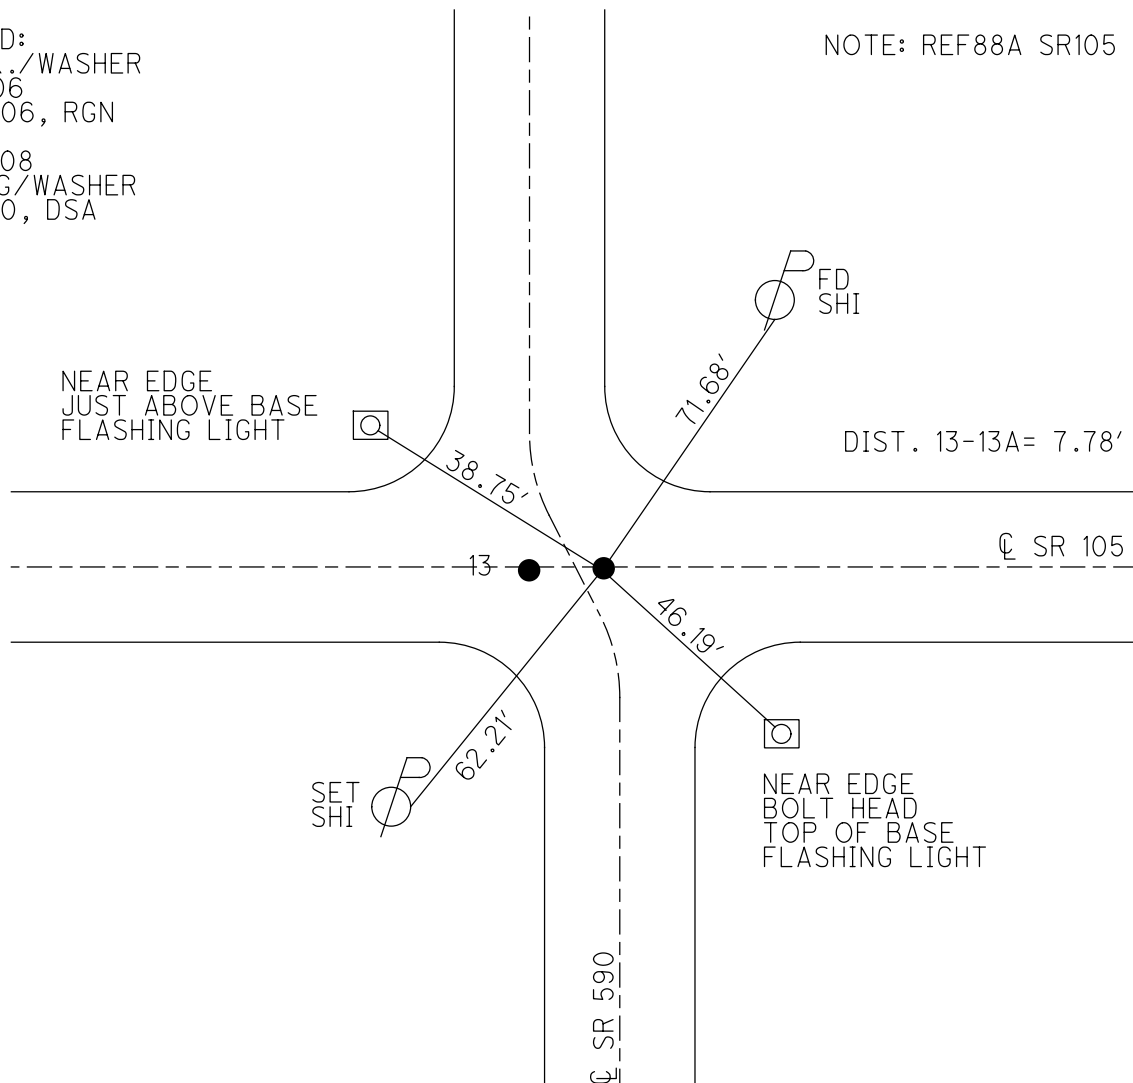

O.D.O.T. DISTRICT 2 SURVEY OFFICE (USE ONLY)

PERSONNEL

REFERENCE NO. 14

SHEET 12 OF 30

NOTES GARRETT

DATE 7/31/20

ROUTE SR 590

H.C. AUBLE

WEATHER SUNNY

COUNTY OTTAWA

R.C. MAHLER

TEMP. 72°

TOWNSHIP HARRIS

DWG BY RHOADES

PID PAVING TRAIN

SECTION 10

T 6 N R 14 E

TYPE MONUMENT MAG/WASHER

ON SURFACE - ~~BELOW~~ ON

OFFSET CL PAVEMENT 4.4' LT : ~~RT~~

5.5' TO LT EDGE PAVEMENT


STATION: 133+93.3

HORZ.DATUM: NAD83 2011


GEOID: 2012A

GRID: NORTHING: 666826.561

EASTING: 1770716.122

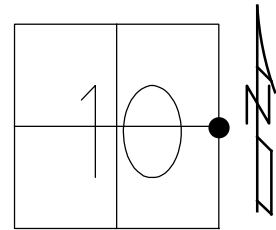

RECORD:
FD P.K./WASHER
1/27/06, RGN
FD P.K./WASHER
SV114
8/11/08, MC
SET MAG/WASHER
6/09/09, SAH
FD MAG/WASHER
REF14
7/31/20, DSA

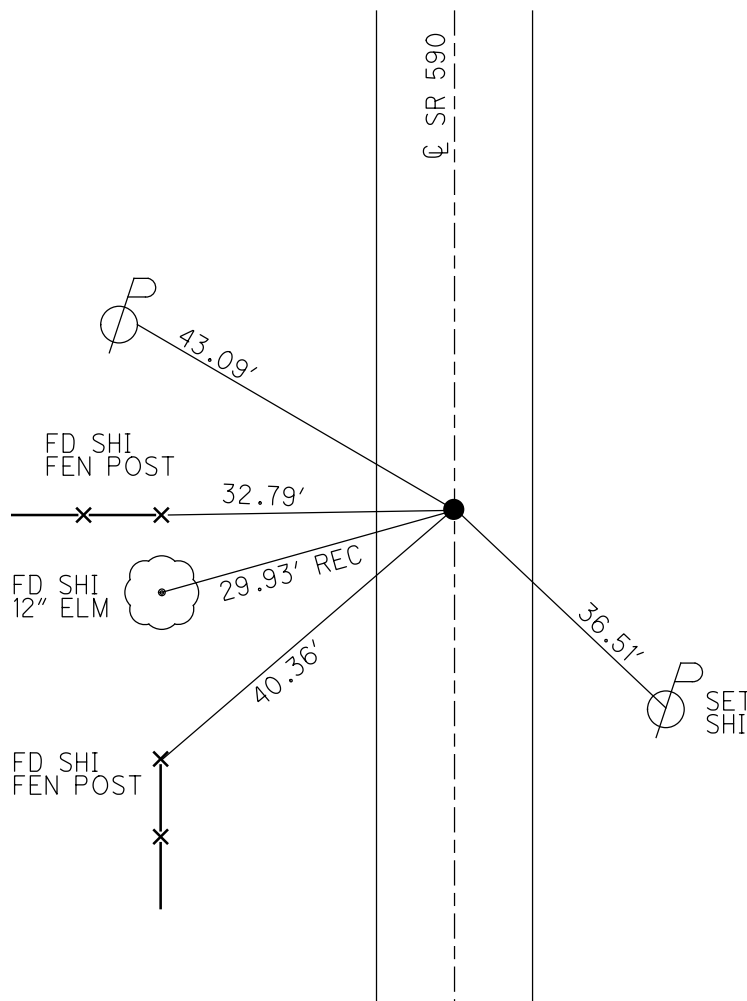

O.D.O.T. DISTRICT 2 SURVEY OFFICE (USE ONLY)

PERSONNEL

REFERENCE NO. 15

SHEET 13 OF 30

NOTES RHOADES

DATE 12/29/23

ROUTE SR 590

H.C. MILLER

WEATHER CLOUDY

COUNTY OTTAWA

R.C. RHOADES

TEMP. 40°

TOWNSHIP HARRIS

SECTION 22

DWG BY RHOADES

PID PAVETRAIN

T 6 N R 14 E

TYPE MONUMENT MAG/WASHER

ON SURFACE - ~~BELOW~~ ON

OFFSET Q PAVEMENT 4.3' LT : ~~RT~~

5.1' TO LT EDGE PAVEMENT


STATION: 160+33.2

HORIZ.DATUM: NAD83 2011

GEOID: NAVD88 2018

GRID: NORTHING: 669462.337

EASTING: 1770703.316

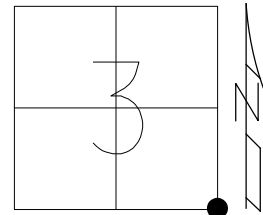

RECORD:

FD P.K./WASHER

1/27/06, RGN

FD P.K./WASHER

SV115

8/11/08, MC

SET MAG/WASHER


6/9/09, SAH

FD MAG/WASHER

REF15

7/31/20, DSA

12/29/23, JAM

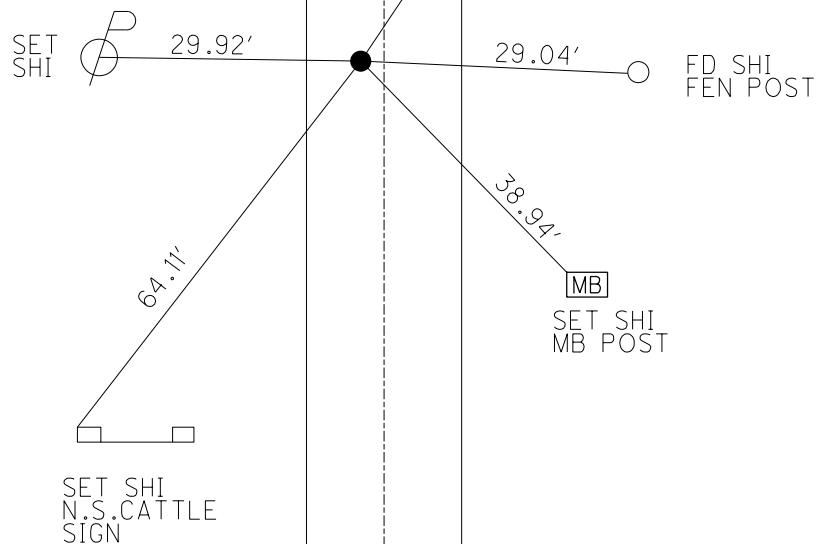

O.D.O.T. DISTRICT 2 SURVEY OFFICE (USE ONLY)

PERSONNEL

REFERENCE NO. 16

SHEET 14 OF 30

NOTES GARRETT

DATE 7/31/20

ROUTE SR 590

H.C. AUBLE

WEATHER SUNNY

COUNTY OTTAWA

R.C. MAHLER

TEMP. 72°

TOWNSHIP HARRIS

SECTION 3

DWG BY RHOADES

PID PAVING TRAIN

T 6 N R 14 E

TYPE MONUMENT MAG/WASHER

ON SURFACE - ~~BELOW~~ ON

OFFSET Q PAVEMENT 0.5' LT : ~~RT~~

9.3' TO LT EDGE PAVEMENT


STATION: 186+79.6

HORIZ.DATUM: NAD83 2011

GEOID: 2012A

GRID: NORTHING: 672073.088

EASTING: 1770703.073

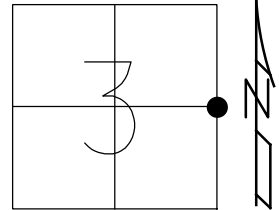

RECORD:
FD MAG NAIL
1/27/06, RGN
FD MAG NAIL
SVB116
8/11/08, MC
SET MAG/WASHER
6/9/09, SAH
FD MAG/WASHER
REF16
7/31/20, DSA

FD SHI
CONC JOINT
BOX CULVERT

26.65'

16A

BR 03.53

31.80'

SET
SHI

54.42'

SET
SHI

DIST. 16-16A= 29.98'

Q SR 590

O.D.O.T. DISTRICT 2 SURVEY OFFICE (USE ONLY)

PERSONNEL

REFERENCE NO. 16 A

SHEET 15 OF 30

NOTES GARRETT

DATE 7/31/20

ROUTE SR 590

H.C. AUBLE

WEATHER SUNNY

COUNTY OTTAWA

R.C. MAHLER

TEMP. 72°

TOWNSHIP HARRIS

SECTION 3

DWG BY RHOADES

PID PAVING TRAIN

T 6 N R 14 E

TYPE MONUMENT MAG/WASHER

ON SURFACE - ~~BELOW~~ ON

OFFSET Q PAVEMENT 0.3' LT : ~~RT~~

9.2' TO LT EDGE PAVEMENT


STATION: 186+79.6

HORIZ.DATUM: NAD83 2011


GEOID: 2012A

GRID: NORTHING: 672103.156

EASTING: 1770703.036

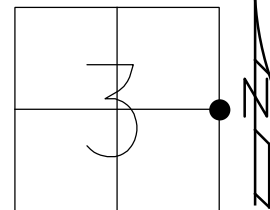


RECORD:
FD LG.R.R.SPIKE
1/27/06, RGN
FD R.R.SPIKE
SVA116
8/11/08, MC
SET MAG/WASHER
6/9/09, SAH
FD MAG/WASHER
REFA16
7/31/20, DSA

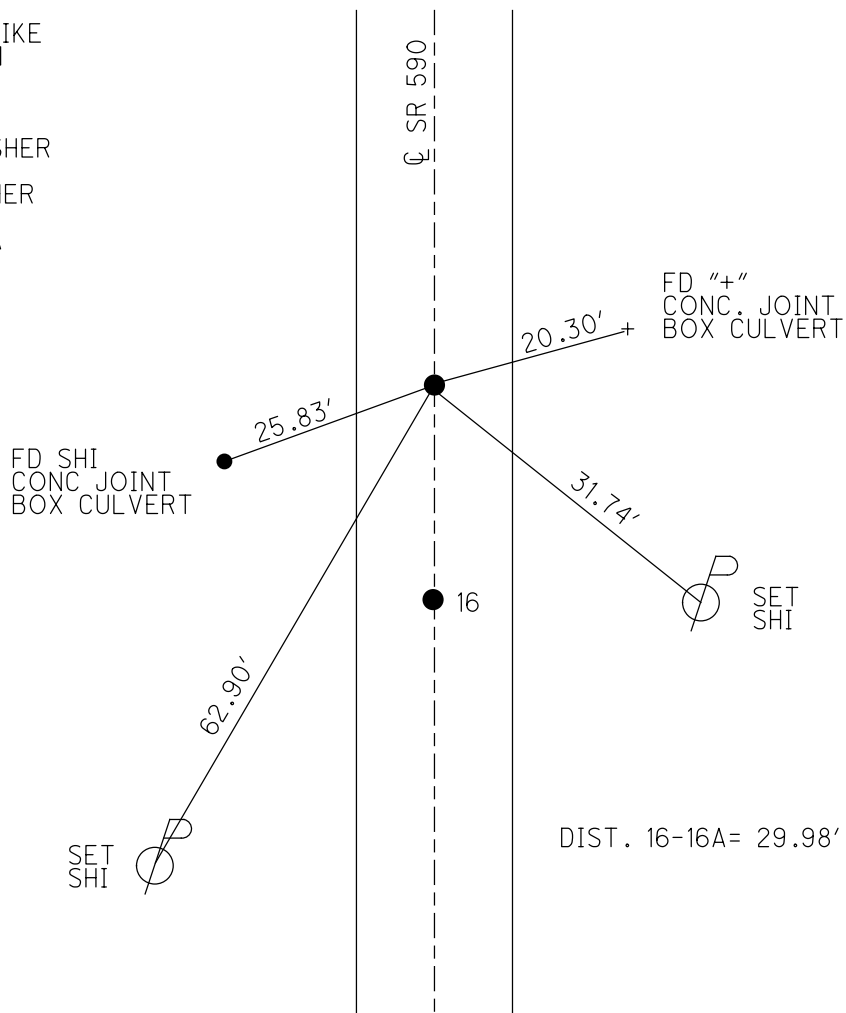

O.D.O.T. DISTRICT 2 SURVEY OFFICE (USE ONLY)

PERSONNEL	REFERENCE NO. <u>17</u>	SHEET <u>16</u> OF <u>30</u>	
NOTES	RHOADES	DATE <u>5/15/13</u>	ROUTE <u>SR 590</u>
H.C.	CODER	WEATHER <u>WINDY</u>	COUNTY <u>OTTAWA</u>
R.C.	ROUSOS	TEMP. <u>78°</u>	TOWNSHIP <u>HARRIS</u>
			SECTION <u>3</u>
			T <u>6</u> N R <u>14</u> E


TYPE MONUMENT MONBOX
 ON SURFACE - ~~BELOW~~ ON
 LEFT - ℄ PAV'T - RIGHT ON
12' TO RT EDGE PAVEMENT
 S.L.M. 213+25

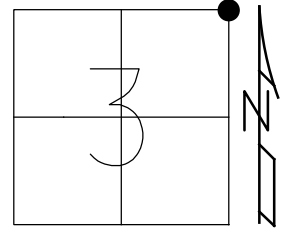

GRID: NORTHING: 674743.840 EASTING: 1770702.899

RECORD: P.I.
 STA 526+94.40
 FD STONE
 6" DOWN
 SET 3/4" IPIPE
 8/13/76
 SET P.K./WASHER
 9/27/93, RCC
 FD P.K.NAIL
 SV117
 8/13/08, MC
 FD P.K./WASHER
 1/3/12, MC
 FD P.K.NAIL
 5/15/13, SDC
 FD MONBOX
 NEWREF33
 5/1/14, TMR

NOTE: REF33 SR 163

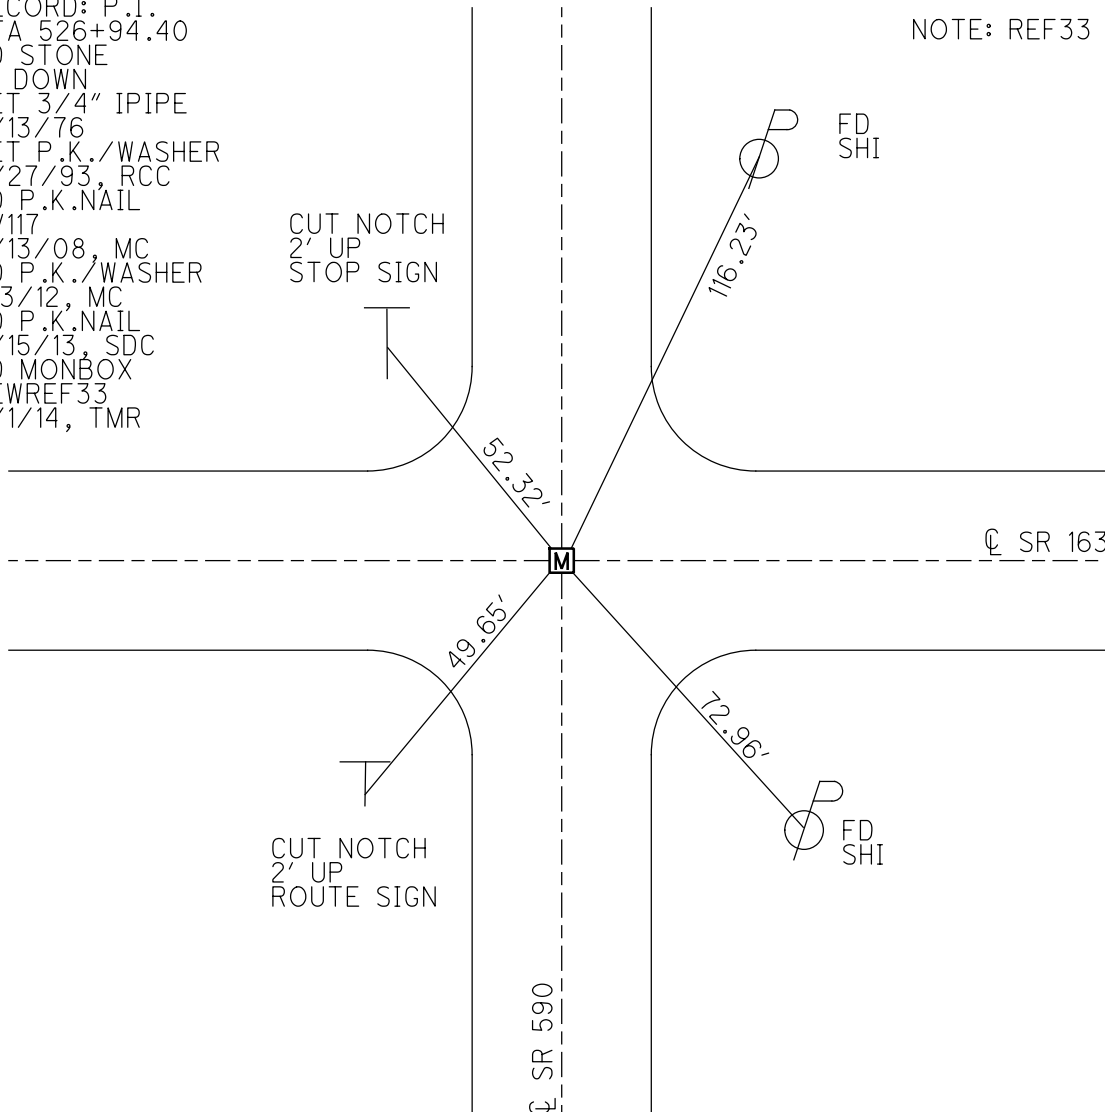

O.D.O.T. DISTRICT 2 SURVEY OFFICE (USE ONLY)

PERSONNEL

REFERENCE NO. 18

SHEET 17 OF 30

NOTES RHOADES

DATE 2/26/18

ROUTE SR 590

H.C. O'DONNELL

WEATHER SUNNY

COUNTY OTTAWA

R.C. RHOADES

TEMP. 39°

TOWNSHIP BENTON

DWG BY MILLER PID 101240

SECTION 34

T 7 N R 14 E

TYPE MONUMENT MAG/WASHER

ON SURFACE - ~~BELOW~~ ON

OFFSET CL PAVEMENT 6' LT : ~~RT~~

4' TO LT EDGE PAVEMENT


STATION: 239+96

HORIZ.DATUM: NAD83-2011


GEOID: NAVD88-2012A

GRID: NORTHING: 677405.207

EASTING: 1770714.823

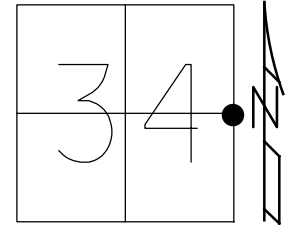

DIST. 18-18A= 1.65'

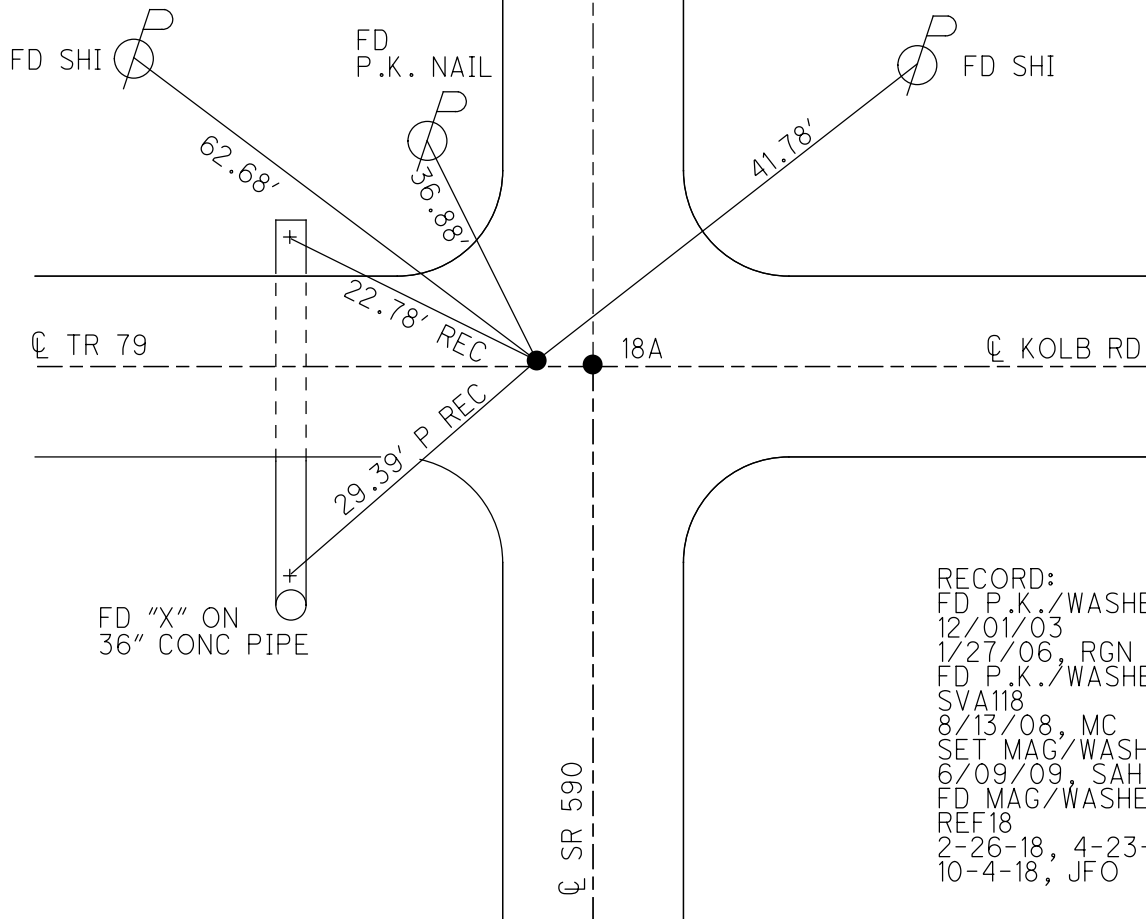

RECORD:
FD P.K./WASHER
12/01/03
1/27/06, RGN
FD P.K./WASHER
SVA118
8/13/08, MC
SET MAG/WASHER
6/09/09, SAH
FD MAG/WASHER
REF18
2-26-18, 4-23-18
10-4-18, JFO

O.D.O.T. DISTRICT 2 SURVEY OFFICE (USE ONLY)

PERSONNEL

REFERENCE NO. 18 A

SHEET 18 OF 30

NOTES RHOADES

DATE 2/26/18

ROUTE SR 590

H.C. O'DONNELL

WEATHER SUNNY

COUNTY OTTAWA

R.C. RHOADES

TEMP. 39°

TOWNSHIP BENTON

DWG BY MILLER

PID 101240

SECTION 34

T 7 N R 14

TYPE MONUMENT MAG/WASHER

ON SURFACE - ~~BELOW~~ ON

OFFSET CL PAVEMENT 4.4' LT : ~~RT~~

5.5' TO LT EDGE PAVEMENT


STATION: 239+96

HORZ.DATUM: NAD83-2011


GEOID: NAVD88-2012A

GRID: NORTHING: 677404.603

EASTING: 1770716.359

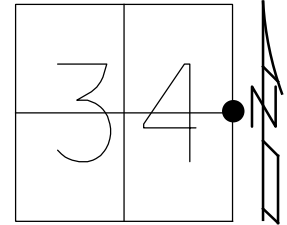

DIST. 18-18A= 1.65'

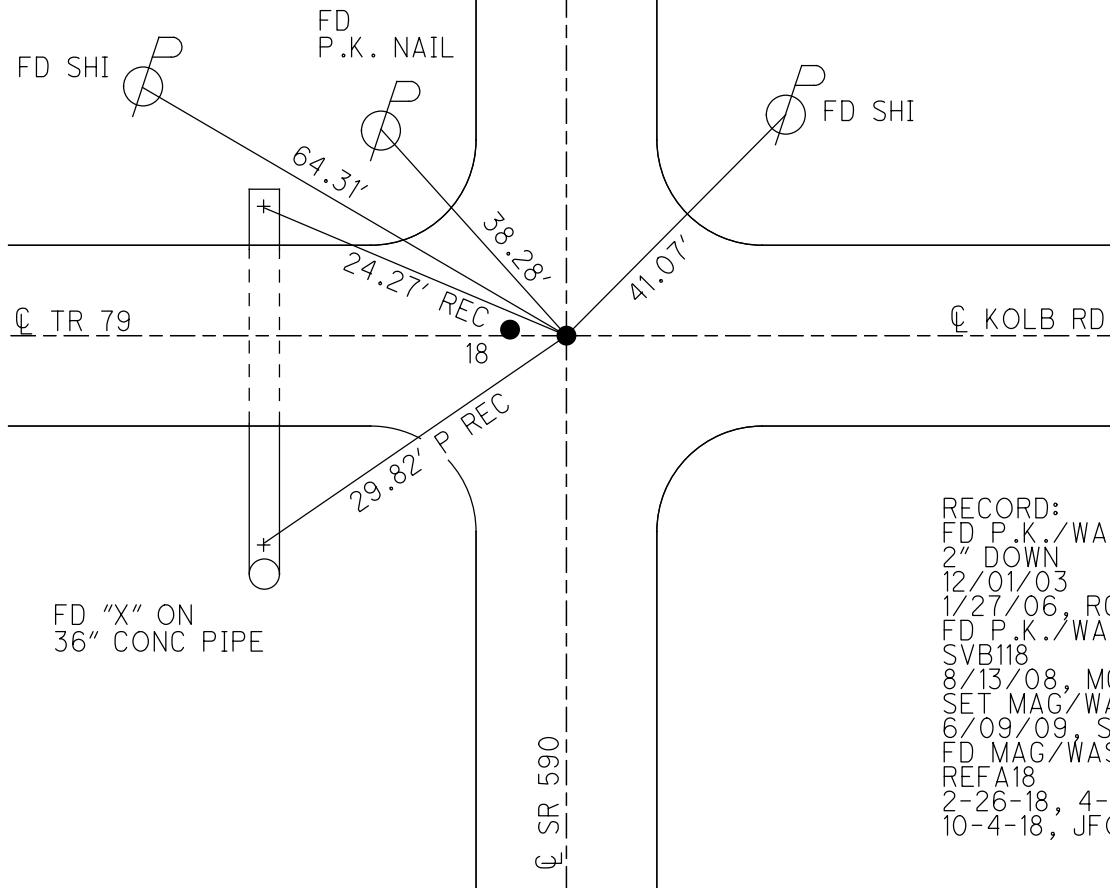

RECORD:
FD P.K./WASHER
2" DOWN
12/01/03
1/27/06, RGN
FD P.K./WASHER
SVB118
8/13/08, MC
SET MAG/WASHER
6/09/09, SAH
FD MAG/WASHER
REFA18
2-26-18, 4-23-18
10-4-18, JFO

O.D.O.T. DISTRICT 2 SURVEY OFFICE (USE ONLY)

PERSONNEL

REFERENCE NO. 19

SHEET 19 OF 30

NOTES RHOADES DATE 2/26/18
H.C. O'DONNELL WEATHER SUNNY
R.C. RHOADES TEMP. 41°

ROUTE SR 590
COUNTY OTTAWA
TOWNSHIP BENTON
SECTION 34
T 7 N R 14 E

DWG BY MILLER PID 101240

TYPE MONUMENT MAG/WAHER

ON SURFACE - ~~BELOW~~ ON

OFFSET CL PAVEMENT 5.2' LT : ~~RT~~

4' TO LT EDGE PAVEMENT


STATION: 266+60

HORZ.DATUM: NAD83-2011

GEOID: NAVD88-2012A


GRID: NORTHING: 680058.606

EASTING: 1770734.601

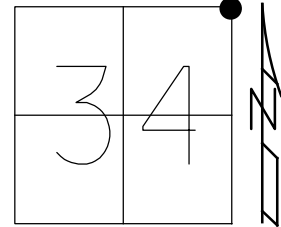

RECORD:
FD P.K./WASHER
0.3' DOWN
6/9/08
SV119
8/13/08, MC
SET MAG/WASHER
6/09/09, SAH
FD MAG/WASHER
REF19
2-26-18, 4-23-18
10-4-18, JFO

FD SHI
FEN POST

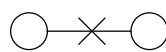

28.71'

FD
SHI



30.27' REC

CL SR 590

42.24' P REC

FD
CMON

44.75'

62.59'

SET
SHI

CL 3RD ST

O.D.O.T. DISTRICT 2 SURVEY OFFICE (USE ONLY)

PERSONNEL

REFERENCE NO. 20

SHEET 20 OF 30

NOTES BARRIERE
H.C. MILLER
R.C. BLUBAUGH

DATE 8/21/24
WEATHER SUNNY
TEMP. 63°

ROUTE SR 590
COUNTY OTTAWA
TOWNSHIP BENTON
SECTION 27
T 7 N R 14 E

DWG BY BARRIERE PID 107604

TYPE MONUMENT MAG NAIL/WASHER

ON SURFACE - BELOW ON

OFFSET Q PAVEMENT 5.5' LT LT : RT

TO EDGE PAVEMENT

STATION: 293+09

HORIZ.DATUM: NAD83 (2011)


GEOID: 18

GRID: NORTHING: 682729.766


EASTING: 1770859.048

LDP: NORTHING: 342048.701

EASTING: 130567.954

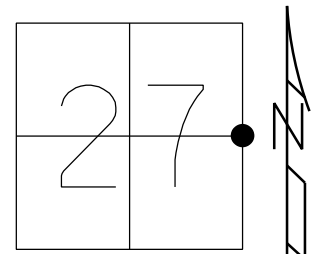

RECORD:
FD P.K./WASHER
1/30/06, MC
SV-120
8-13-08, MC
SET MAG/WASHER
6-9-09, SAH
FD MAG/WASHER
REF20
2-26-18, 4-23-18
10-4-18, JFO
FD MAG/WASHER
REF20
4/10/23, TDN
5/31/25, JAM

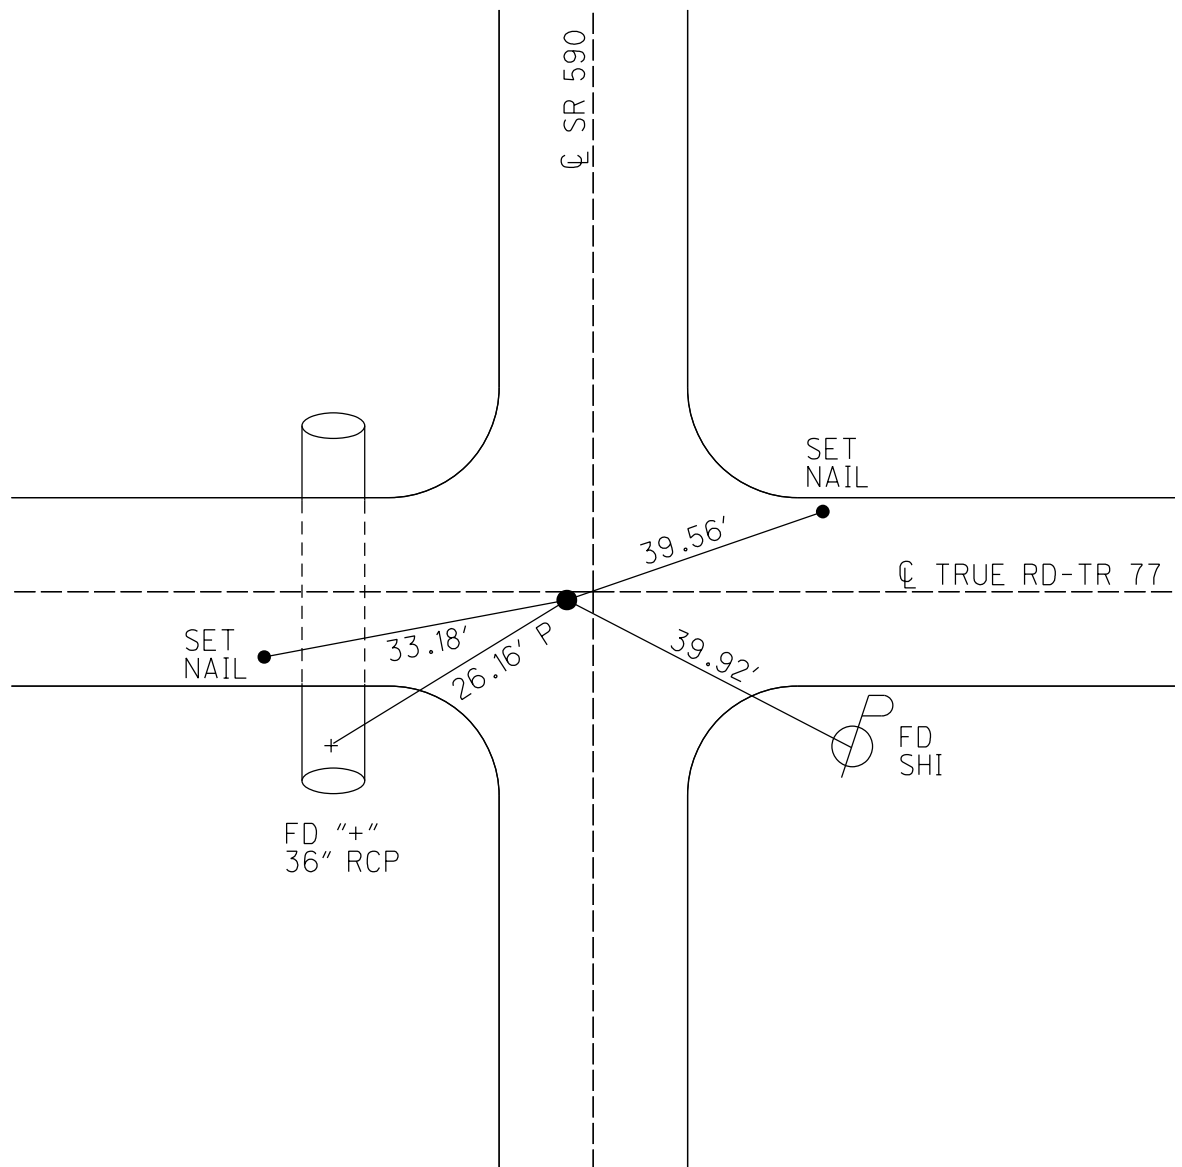

O.D.O.T. DISTRICT 2 SURVEY OFFICE (USE ONLY)

PERSONNEL

REFERENCE NO. 21

SHEET 21 OF 30

NOTES MILLER
H.C. MILLER
R.C. BLUBAUGH

DATE 8/21/24
WEATHER SUNNY
TEMP. 63°

ROUTE SR 590
COUNTY OTTAWA
TOWNSHIP BENTON
SECTION 22

DWG BY BARRIERE PID 107604

T 7 N R 14 E

TYPE MONUMENT MONBOX W/ 7/8" IPIN

ON SURFACE - BELOW ON

OFFSET Q PAVEMENT ON LT : RT

8.7' TO LT EDGE PAVEMENT

STATION: 319+72

HORIZ.DATUM: NAD83 (2011)


GEOID: 18

GRID: NORTHING: 685349.138


EASTING: 1770795.060

LDP: NORTHING: 344702.428

EASTING: 130573.842

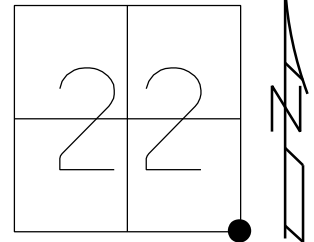

RECORD:
FD P.K./WASHER
7/9/08
SV121
8/13/08, MC
SET MAG/WASHER
6/09/09, SAH
FD MAG/WASHER
2-26-18, 4-23-18
10-4-18, JFO
FD MAG/WASHER
REF21
4/10/23, TDN
FD MAG/WASHER
REF21
5/31/24, JAM
FD MONBOX W/ 7/8" IPIN
CKREF21
8/21/24

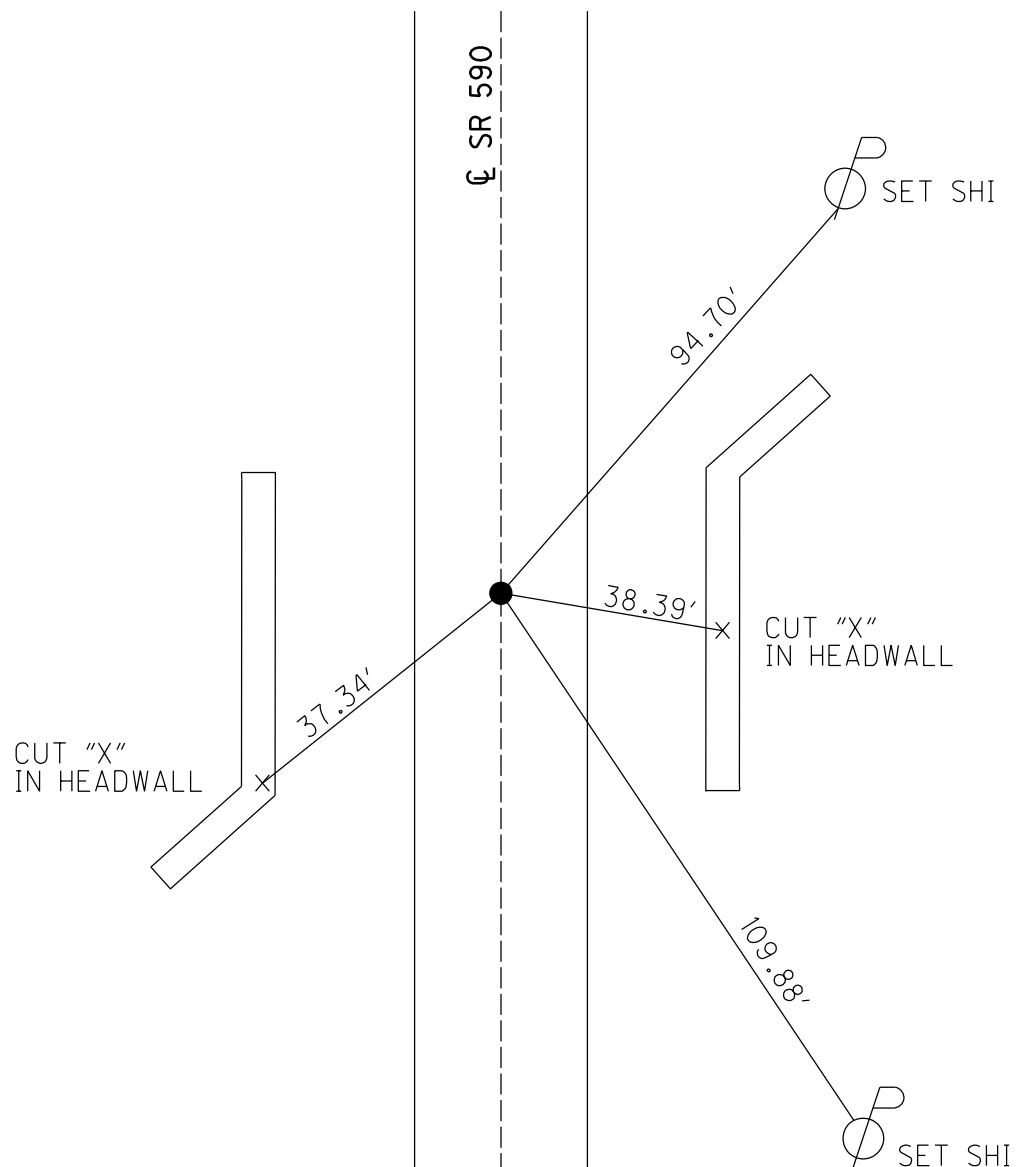

O.D.O.T. DISTRICT 2 SURVEY OFFICE (USE ONLY)

PERSONNEL

REFERENCE NO. 21A

SHEET 22 OF 30

NOTES BARRIERE
H.C. MILLER
R.C. BLUBAUGH

DATE 5/31/24
WEATHER SUNNY
TEMP. 52°

ROUTE SR 590
COUNTY OTTAWA
TOWNSHIP BENTON
SECTION 22

DWG BY BARRIERE PID 107604

T 7 N R 14 E

TYPE MONUMENT MAG NAIL/WASHER

ON SURFACE - BELOW ON

OFFSET Q PAVEMENT 7' RT LT : RT

TO EDGE PAVEMENT

STATION: 341+54

HORIZ.DATUM: OH NORTH LDP


GEOID: 18

GRID: NORTHING: 687565.987


EASTING: 1770911.486

LDP: NORTHING: 346885.377

EASTING: 130587.196

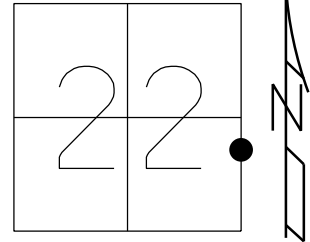

RECORD:
FD LG.R.R.SPIKE
0.25' DOWN
7/9/08
SV121
8/04/08, MC
SET MAG/WASHER
6/09/09, SAH
FD MAG/WASHER
REFA21
2-26-18, 4-23-18
10-4-18, JFO
FD MAG/WASHER
REFA21
4/10/23, TDN
FD MAG/WASHER
REF21A
5/25/24, JAM

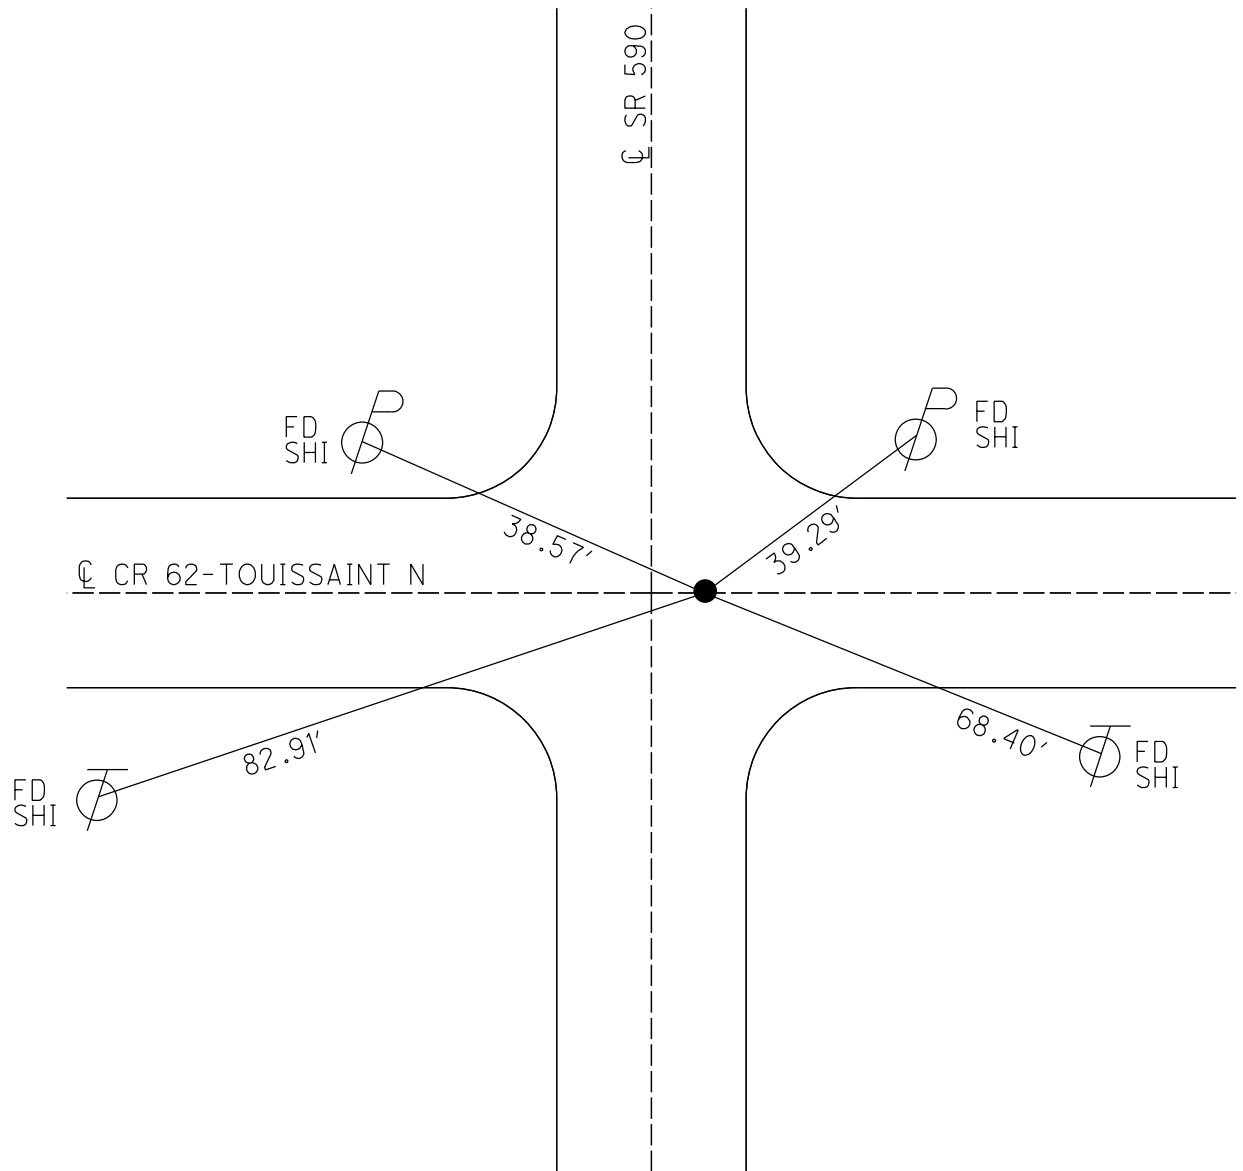

O.D.O.T. DISTRICT 2 SURVEY OFFICE (USE ONLY)

PERSONNEL

REFERENCE NO. 22

SHEET 23 OF 30

NOTES BARRIERE
H.C. MILLER
R.C. BLUBAUGH

DATE 5/31/24
WEATHER SUNNY
TEMP. 52°

ROUTE SR 590
COUNTY OTTAWA
TOWNSHIP BENTON
SECTION 22

DWG BY BARRIERE PID 107604

T 7 N R 14 E

TYPE MONUMENT MAG NAIL/WASHER

ON SURFACE - BELOW ON

OFFSET $\varnothing$ PAVEMENT 3.8' RT LT : RT

6.5' TO RT EDGE PAVEMENT

STATION: 346+33

HORZ.DATUM: OH NORTH/OTT LDP


GEOID: 18

GRID: NORTHING: 688041.318

EASTING: 1770917.684


LDP: NORTHING: 347360.792

EASTING: 130590.114

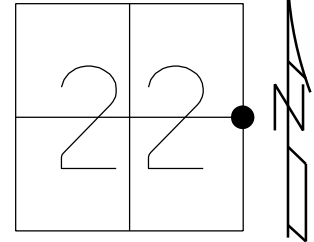

RECORD:
FD P.K./WASHER
7/10/08
SV122,
8/13/08, MC
SET MAG/WASHER
6/09/09, SAH
FD MAG/WASHER
REF22
2-26-18, 4-23-18
10-4-18, JFO
FD MAG/WASHER
REF22
4/10/23, TDN
FD MAG/WASHER
REF22
5/31/24, JAM

NOTE:
4.75 x 7.5" HIGH POINTED
SANDSTONE FD BY CO.
14.25" DOWN

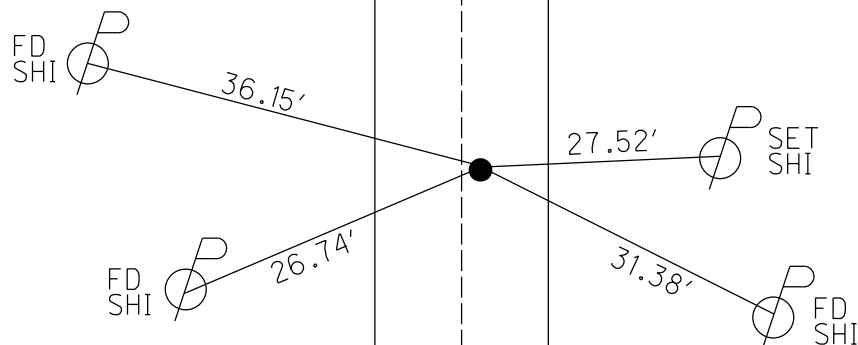

CONC DR
RES #2493

O.D.O.T. DISTRICT 2 SURVEY OFFICE (USE ONLY)

PERSONNEL

REFERENCE NO. 23

SHEET 24 OF 30

NOTES RHOADES

DATE 2/26/18

ROUTE SR 590

H.C. O'DONNELL

WEATHER SUNNY

COUNTY OTTAWA

R.C. RHOADES

TEMP. 41°

TOWNSHIP BENTON

SECTION 15

DWG BY MILLER PID 101240

T 7 N R 14 E

TYPE MONUMENT MAG/WASHER

ON SURFACE - ~~BELOW~~ ON

OFFSET Q PAVEMENT 1.2' ~~LT~~ : RT

8.4' TO RT EDGE PAVEMENT


STATION: 373+00

HORIZ.DATUM: NAD83-2011


GEOID: NAVD88-2012A

GRID: NORTHING: 690665.411

EASTING: 177867.333

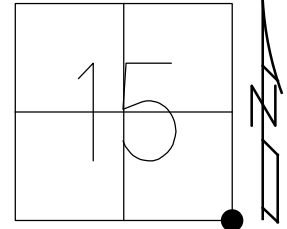

RECORD:
FD MAG NAIL
12/1/03
FD P.K./WASHER
7/10/08
SV123
8/13/08, MC
SET MAG/WASHER
6/09/09, SAH
FD MAG/WASHER
REF23
2-26-18, 4-23-18
10-4-18, JFO

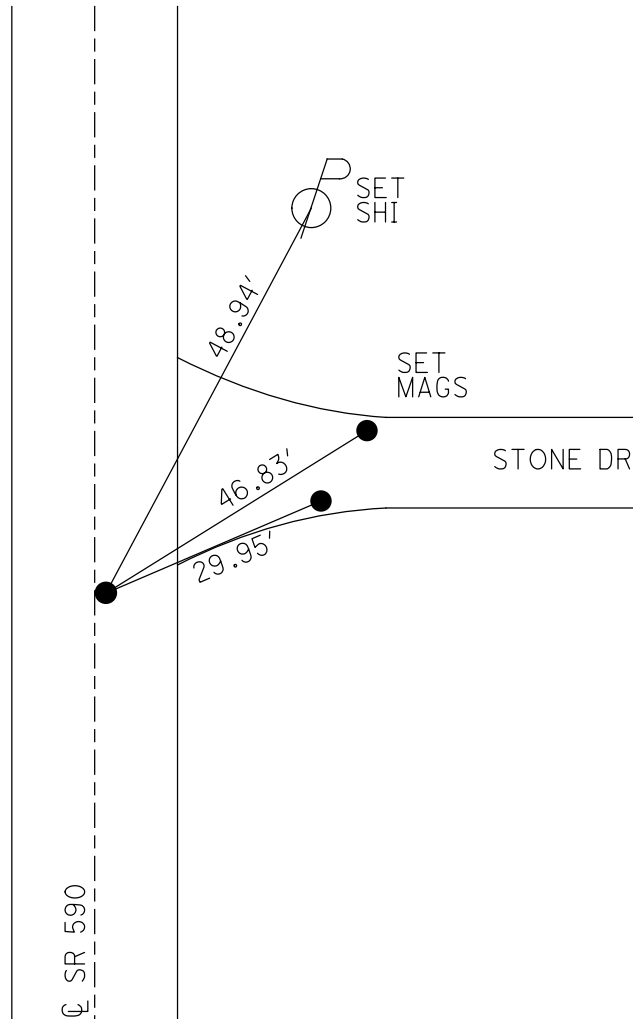

O.D.O.T. DISTRICT 2 SURVEY OFFICE (USE ONLY)

PERSONNEL

REFERENCE NO. 24

SHEET 25 OF 30

NOTES RHOADES

DATE 12/29/23

ROUTE SR 590

H.C. MILLER

WEATHER CLOUDY

COUNTY OTTAWA

R.C. RHOADES

TEMP. 40°

TOWNSHIP BENTON

SECTION 15

DWG BY RHOADES

PID PAVETRAIN

T 7 N R 14 E

TYPE MONUMENT MAG/WASHER

ON SURFACE - ~~BELOW~~ ON

OFFSET $\mathcal{Q}$ PAVEMENT 1.1' ~~LT~~ : RT

8.3' TO RT EDGE PAVEMENT


STATION: 399+59.27

HORIZ.DATUM: NAD83 2011


GEOID: NAVD88 2018

GRID: NORTHING: 693321.474

EASTING: 1770895.684

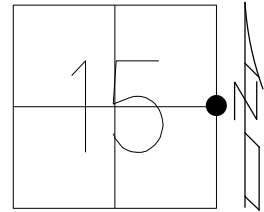

RECORD:
FD P.K./WASHER
12/01/03, RGN
FD P.K./WASHER
7/10/08
SVB124
8/13/08, MC
SET MAG/WASHER
6/09/09, SAH
FD MAG/WASHER
REF24
2-26-18, 4-23-18
10-4-18, JFO
FD MAG/WASHER
12/29/23, JAM

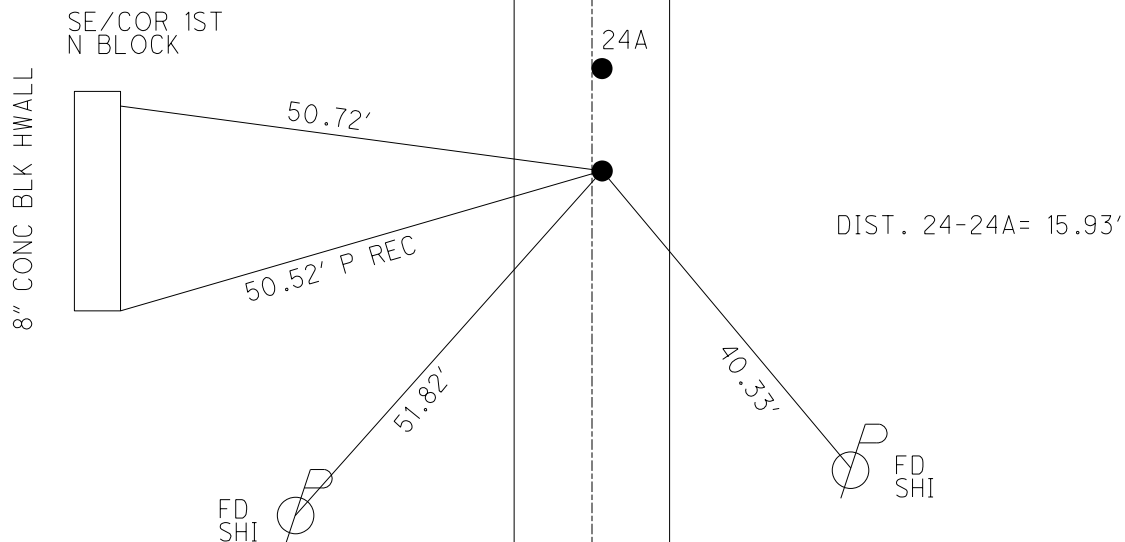

O.D.O.T. DISTRICT 2 SURVEY OFFICE (USE ONLY)

PERSONNEL

REFERENCE NO. 24 A

SHEET 26 OF 30

NOTES RHOADES

DATE 2/26/18

ROUTE SR 590

H.C. O'DONNELL

WEATHER SUNNY

COUNTY OTTAWA

R.C. RHOADES

TEMP. 48°

TOWNSHIP BENTON

SECTION 15

DWG BY MILLER

PID 101240

T 7 N R 14 E

TYPE MONUMENT MAG/WASHER

ON SURFACE - ~~BELOW~~ ON

OFFSET CL PAVEMENT 1.1' ~~LT~~ : RT

8.3' TO RT EDGE PAVEMENT


STATION: 399+75.2

HORZ.DATUM: NAD83-2011

GEOID: NAVD88-2012A


GRID: NORTHING: 693337.429

EASTING: 1770895.761

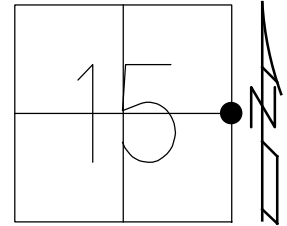

RECORD:
FD P.K./WASHER
12/01/03, RGN
FD P.K./WASHER
7/10/08
SVA124
8/13/08, MC
SET MAG/WASHER
6/09/09, SAH
FD MAG/WASHER
REFA24
2-26-18, 4-23-18
10-4-18, JFO

DIST. 24-24A= 15.93'

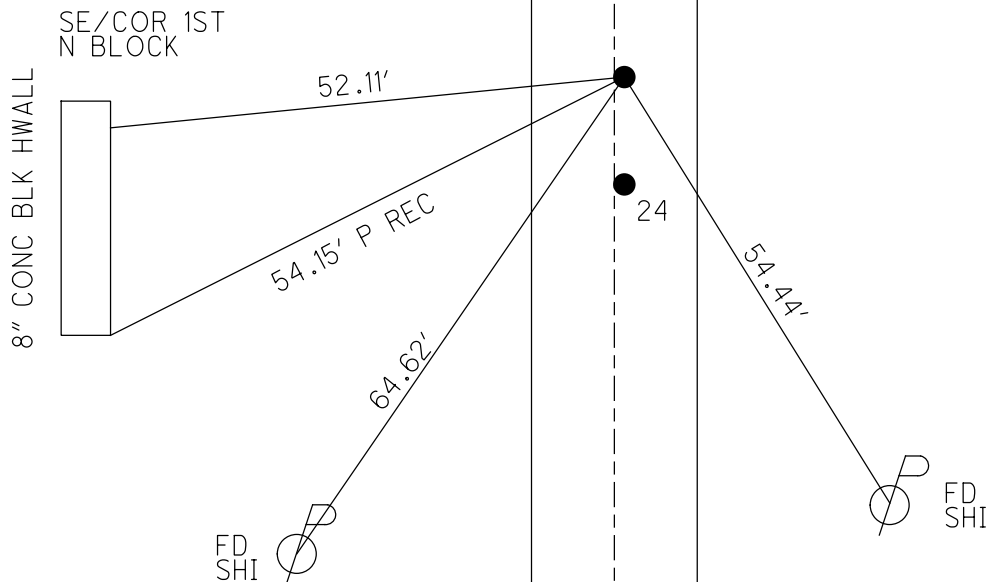

O.D.O.T. DISTRICT 2 SURVEY OFFICE (USE ONLY)

PERSONNEL

REFERENCE NO. 25

SHEET 27 OF 30

NOTES RHOADES

DATE 2/26/18

ROUTE SR 590

H.C. O'DONNELL

WEATHER SUNNY

COUNTY OTTAWA

R.C. RHOADES

TEMP. 48°

TOWNSHIP BENTON

DWG BY MILLER PID 101240

SECTION 15

T 7 N R 14 E

TYPE MONUMENT MAG/WASHER

ON SURFACE - ~~BELOW~~ ON

OFFSET Q PAVEMENT 2' ~~LT~~ : RT

8.4' TO RT EDGE PAVEMENT



STATION: 420+43

HORIZ.DATUM: NAD83-2011

GEOID: NAVD88-2012A

GRID: NORTHING: 695382.412

EASTING: 1770931.460

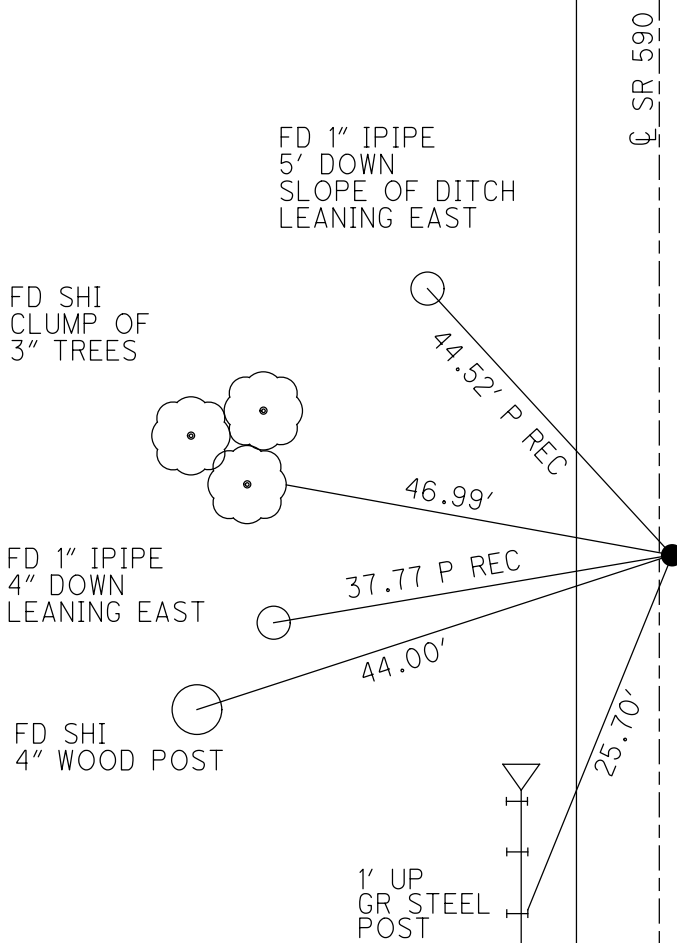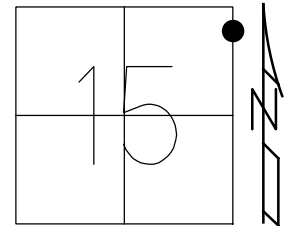

RECORD:
FD P.K.NAIL
12/01/03, RGN
FD P.K.NAIL
7/10/08
SV125
8/13/08, MC
SET MAG/WASHER
REF25
2-26-18, JFO
FD MAG/WASHER
4-23-18,
10-4-18, JFO

O.D.O.T. DISTRICT 2 SURVEY OFFICE (USE ONLY)

PERSONNEL

REFERENCE NO. 26

SHEET 28 OF 30

NOTES RHOADES

DATE 2/26/18

ROUTE SR 590

H.C. O'DONNELL

WEATHER SUNNY

COUNTY OTTAWA

R.C. RHOADES

TEMP. 48°

TOWNSHIP BENTON

SECTION 15

DWG BY MILLER

PID 101240

T 7 N R 14 E

TYPE MONUMENT MAG/WASHER

ON SURFACE - ~~BELOW~~ ON

OFFSET Q PAVEMENT 0.8' LT : ~~RT~~

10.4' TO RT EDGE PAVEMENT



STATION: 426+47

HORZ.DATUM: NAD83-2011

GEOID: NAVD88-2012A

GRID: NORTHING: 695984.719

EASTING: 1770941.998

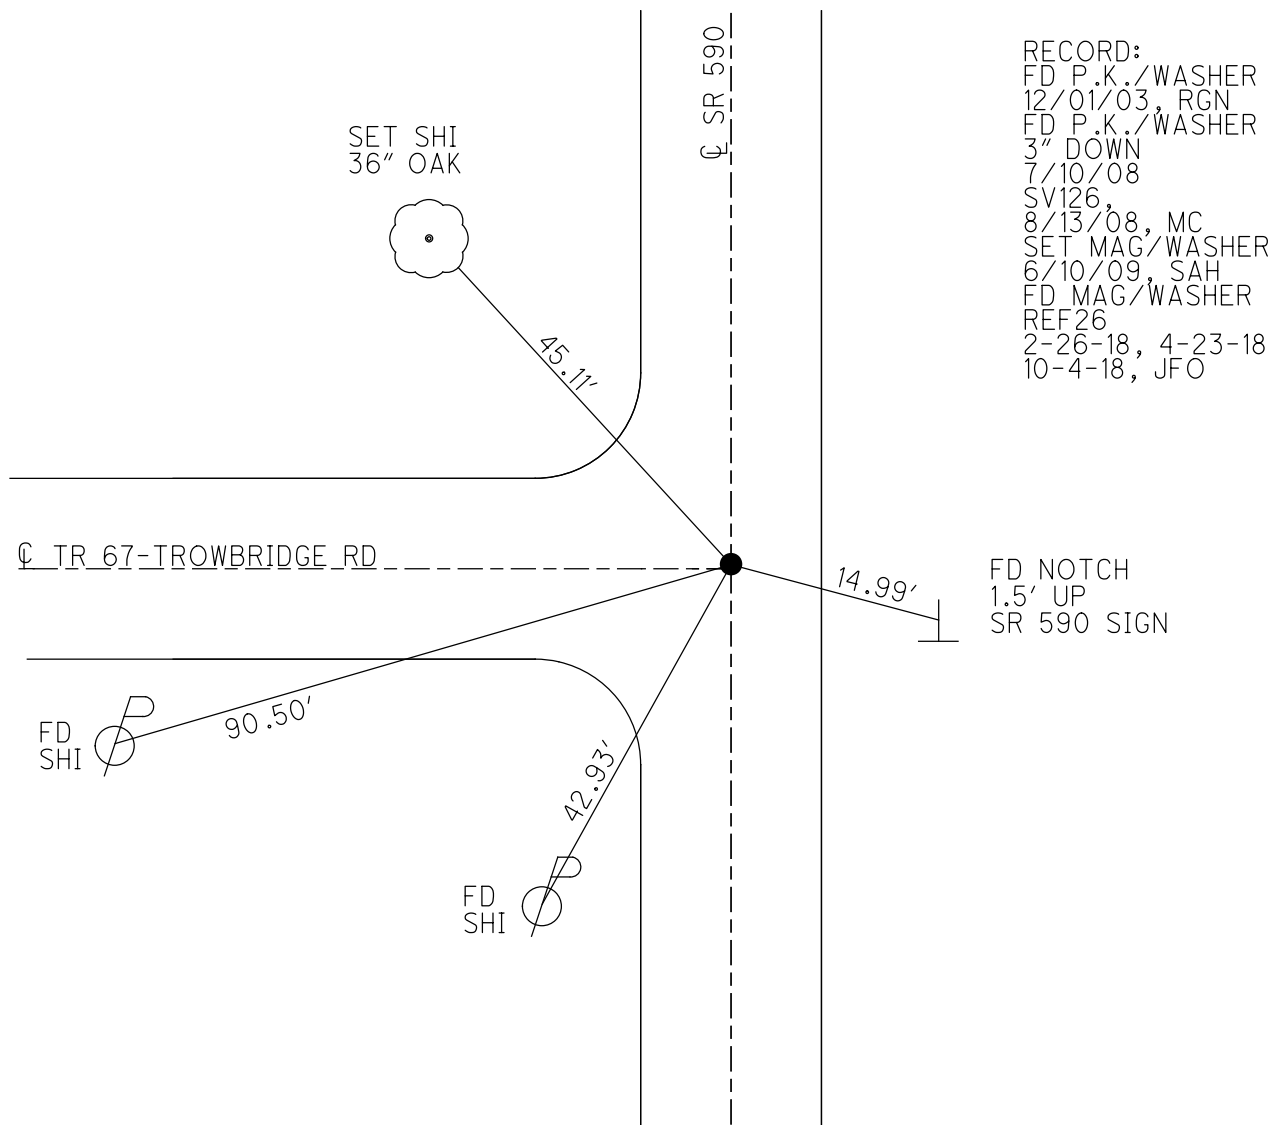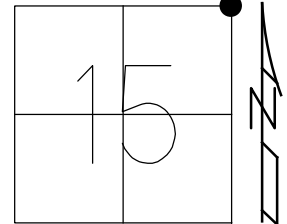

O.D.O.T. DISTRICT 2 SURVEY OFFICE (USE ONLY)

PERSONNEL

REFERENCE NO. 27

SHEET 29 OF 30

NOTES RHOADES

DATE 12/29/23

ROUTE SR 590

H.C. MILLER

WEATHER CLOUDY

COUNTY OTTAWA

R.C. RHOADES

TEMP. 40°

TOWNSHIP BENTON

SECTION 10

DWG BY RHOADES

PID PAVETRAIN

T 7 N R 14 E

TYPE MONUMENT MAG/WASHER

ON SURFACE - ~~BELOW~~ ON

OFFSET Q PAVEMENT 2.1' ~~LT~~ : RT

- TO - EDGE PAVEMENT


STATION: 467+22

HORIZ.DATUM: NAD83 2011

GEOID: NAVD88 2018

GRID: NORTHING: 700047.800

EASTING: 1771004.200

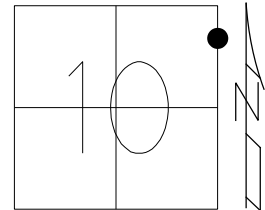

RECORD:

P.K./WASHER

12/01/03, RGN

FD P.K./WASHER

7/10/08

SV127

8/13/08, MC

SET MAG/WASHER

6/10/09, SAH

FD MAG/WASHER

REF27

2-26-18, 4-23-18

10-4-18, JFO

12/29/23, JAM

FD
SHI

37.32'

Q SR 590

61.07'

Q TR 81-TROWBRIDGE RD.

45.33'

FD
SHI

O.D.O.T. DISTRICT 2 SURVEY OFFICE (USE ONLY)

PERSONNEL

REFERENCE NO. 28

SHEET 30 OF 30

NOTES RHOADES

DATE 12/29/23

ROUTE SR 590

H.C. MILLER

WEATHER CLOUDY

COUNTY OTTAWA

R.C. RHOADES

TEMP. 40°

TOWNSHIP BENTON

SECTION 3

DWG BY RHOADES

PID PAVETRAIN

T 7 N R 14 E

TYPE MONUMENT LG.R.R.SPIKE

~~ON SURFACE~~ - BELOW 1"

OFFSET Q PAVEMENT ON LT : RT

- TO - EDGE PAVEMENT

STATION: 506+30

HORIZ.DATUM: NAD83 2011

GEOID: NAVD88 2018

GRID: NORTHING: 703943.487

EASTING: 1771050.254

