

O.D.O.T. DISTRICT 2 SURVEY OFFICE (USE ONLY)

PERSONNEL

REFERENCE NO. 1

SHEET 4 OF 26

NOTES ASTON
H.C. NIESE
R.C. PRESTON-COLVIN

DATE 5/21/24
WEATHER SUNNY
TEMP. 75°

ROUTE SR 235
COUNTY WOOD
TOWNSHIP JACKSON
SECTION 35

DWG BY BARRIERE PID 101290

T 3 N R 9 E

TYPE MONUMENT LG RR SPIKE

ON SURFACE - BELOW 6" DOWN

OFFSET $\angle$ PAVEMENT 1.8' LT ~~LT~~ : RT

TO EDGE PAVEMENT

STATION: 0+00

HORIZ.DATUM: WOOD LDP


GEOID: 2018

GRID: NORTHING:


EASTING:

LDP: NORTHING: 549689.883

EASTING: 1613801.891

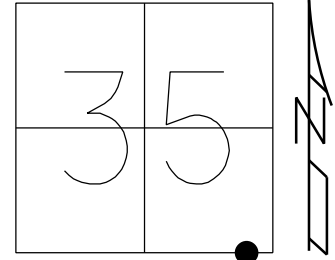

RECORD:
SET P.K./WASHER
10-27-93, MB
FD LG.R.R.SPIKE
3 1/2" DOWN
REF1
6-18-18, JLL
DNF
4-27-21, JFO
FD LG RSPK
6" DOWN
REF1
2/3/23, TDN
8/14/23, TDN
FD LG RSPK
6" DOWN
5/21/24, TDN

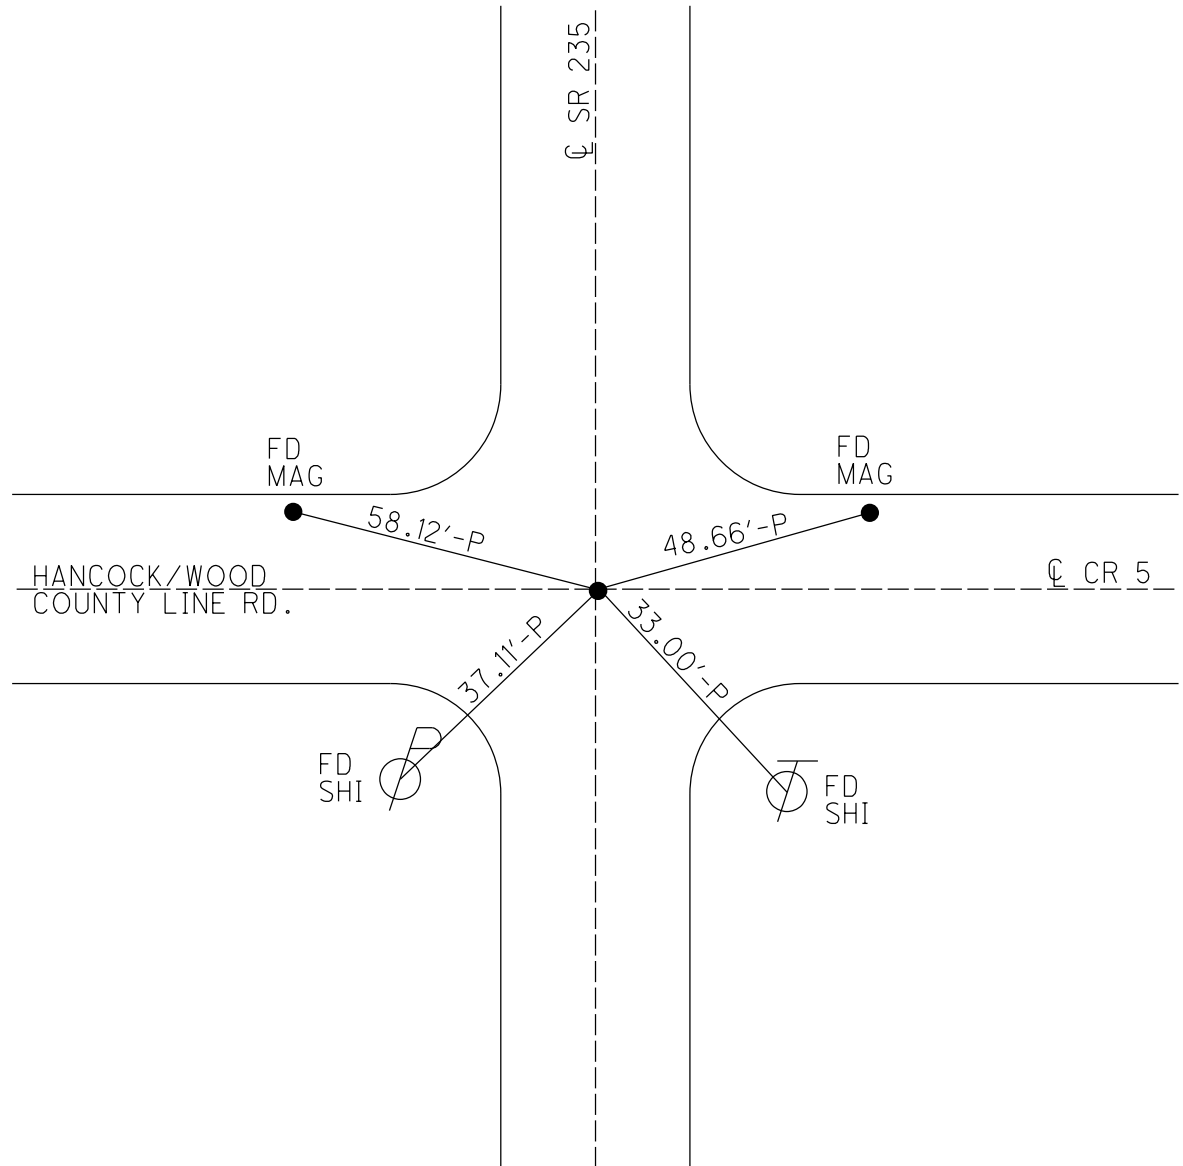

O.D.O.T. DISTRICT 2 SURVEY OFFICE (USE ONLY)

PERSONNEL

REFERENCE NO. 2

SHEET 4 OF 26

NOTES NIESE

DATE 10/25/24

ROUTE SR 235

H.C. NIESE

WEATHER CLOUDY

COUNTY WOOD

R.C. PRESTON-COLVIN

TEMP. 53°

TOWNSHIP JACKSON

DWG BY BARRIERE

PID 101290

SECTION 35

T 3 N R 9 E

TYPE MONUMENT MAG NAIL/WASHER

ON SURFACE - BELOW ON

OFFSET $\varnothing$ PAVEMENT LT : RT


 TO EDGE PAVEMENT

STATION: 26+96.8

HORZ.DATUM: NAD83(2011)/WOOD LDP GEOID: 2018

GRID: NORTHING: 373658.809 EASTING: 126512.778

LDP: NORTHING: 552317.132 EASTING: 1614410.791

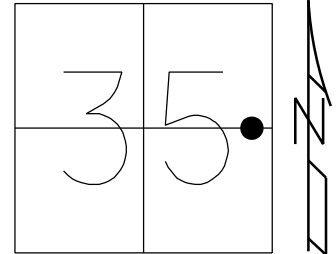

RECORD:

$\Delta = 0^{\circ} 05' \text{ LT}$

SET P.K./WASHER

10-27-93, MB

SET MAG/WASHER

08-03-04, MC

FD MAG/WASHER

REF2

6-08-18, JLL

FD MAG NAIL

REF2

4-27-21

9-16-21, JFO

1/11/23, JMR

2/1/23, JAM

5/23/23, TDN

8/14/23, TDN

SET MAG/WASHER

10/25/24, TDN

COR.CONC.
FND. PUMP
STATION
2' UP FROM
BOTT. SIDING



39.52'


42.98'

FD
SHI

30.84'

FD SHI
FEN POST

42.91'

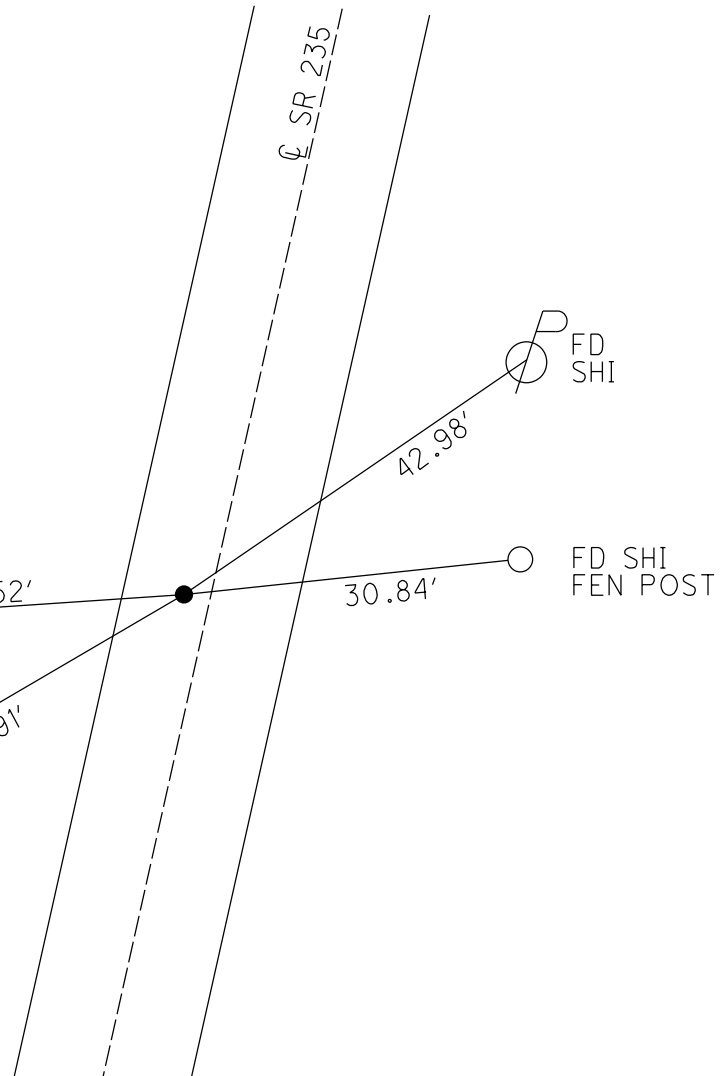

O.D.O.T. DISTRICT 2 SURVEY OFFICE (USE ONLY)

PERSONNEL

REFERENCE NO. 2 A

SHEET 4 OF 26

NOTES NIESE

DATE 10/25/24

ROUTE SR 235

H.C. NIESE

WEATHER CLOUDY

COUNTY WOOD

R.C. PRESTON-COLVIN

TEMP. 53°

TOWNSHIP JACKSON

DWG BY BARRIERE

PID 101290

SECTION 35

T 3 N R 9 E

TYPE MONUMENT MAG NAIL/WASHER

ON SURFACE - BELOW ON

OFFSET $\varnothing$ PAVEMENT 2.3' LT LT : RT


7.6' TO LT EDGE PAVEMENT

STATION: 49+67.08


HORIZ.DATUM: NAD83(2011)/WOOD LDP GEOID: 2018

GRID: NORTHING: 375878.824 EASTING: 126992.619

LDP: NORTHING: 554530.440 EASTING: 1614919.811

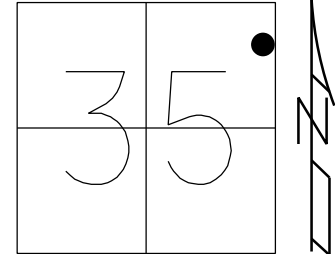

RECORD:
SET P.K./WASHER
10-27-93, MB
SET MAG/WASHER
8-3-04 M.C.
FD MAG/WASHER
REFA2
6-8-18, JLL
FD MAG/WASHER
REFA2
4-27-21
9-16-21, JFO
1/11/23, JMR
2/1/23, JAM
5/23/23, DSA
8/14/23, TDN
SET MAG/WASHER
10/24/25, TDN

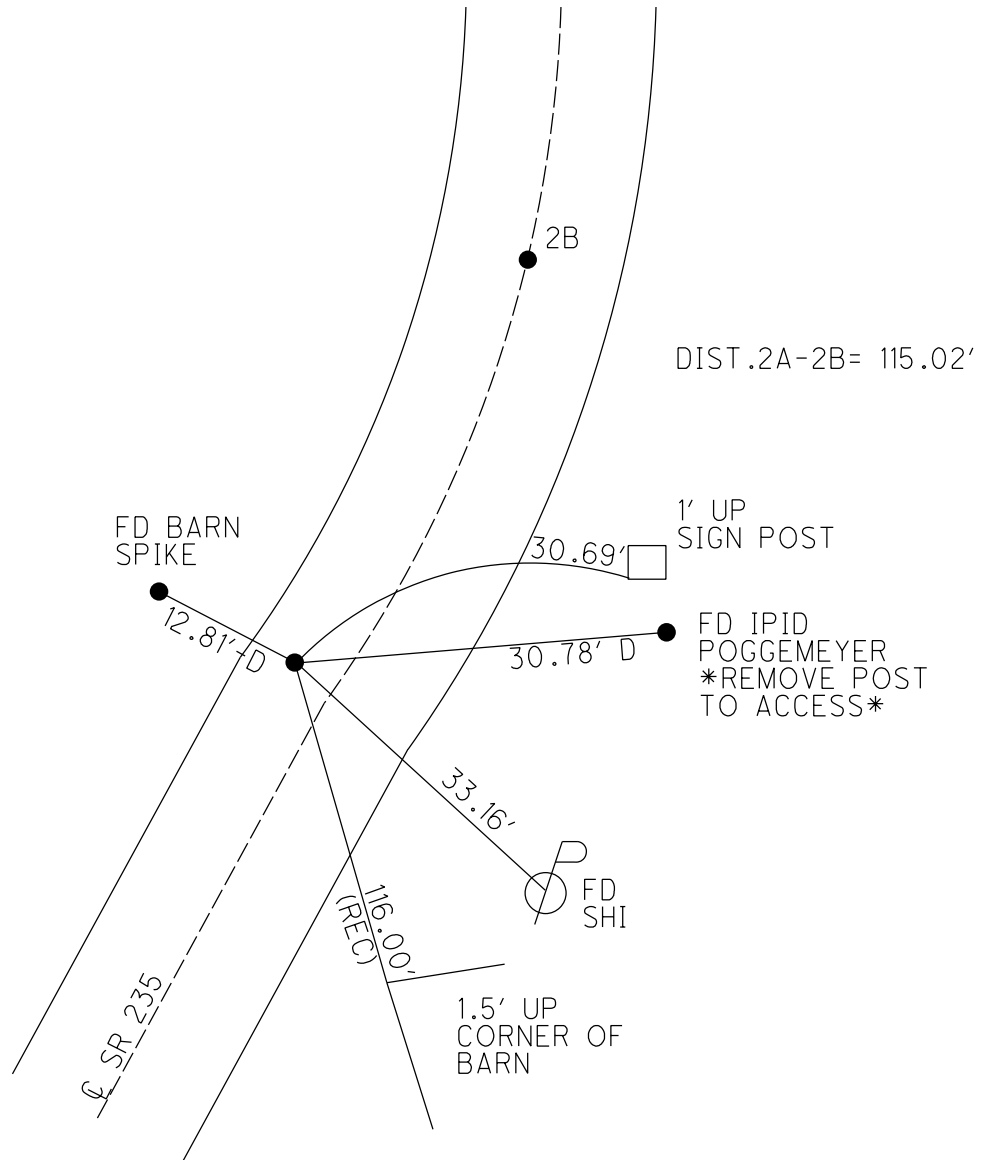

O.D.O.T. DISTRICT 2 SURVEY OFFICE (USE ONLY)

PERSONNEL

REFERENCE NO. 2 B

SHEET 4 OF 26

NOTES NIESE

DATE 10/25/24

ROUTE SR 235

H.C. NIESE

WEATHER CLOUDY

COUNTY WOOD

R.C. PRESTON-COLVIN

TEMP. 53°

TOWNSHIP JACKSON

DWG BY BARRIERE

PID 101290

SECTION 35

T 3 N R 9 E

TYPE MONUMENT MAG NAIL/WASHER

ON SURFACE - BELOW ON

OFFSET Q PAVEMENT ON LT : RT


8.8' TO RT EDGE PAVEMENT

STATION: 50+82.98


HORIZ.DATUM: NAD83(2011)/WOOD LDP GEOID: 2018

GRID: NORTHING: 375991.222 EASTING: 127017.072

LDP: NORTHING: 554642.496 EASTING: 1614945.741

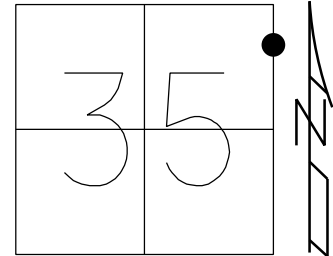

RECORD: P.I.
 $\Delta = 6^\circ 43''$ LT
 SET P.K./WASHER
 10-27-93, MB
 SET PK/WASHER
 8-3-04, M.C.
 FD MAG/WASHER
 REFB2
 6-8-21, JLL
 FD MAG/WASHER
 REFB2
 4-27-21
 9-16-21, JFO
 1/11/23, JMR
 2/1/23, JAM
 5/23/23, TDN
 8/14/23, TDN
 SET MAG/WASHER
 NEWREF2B
 10/25/24, TDN

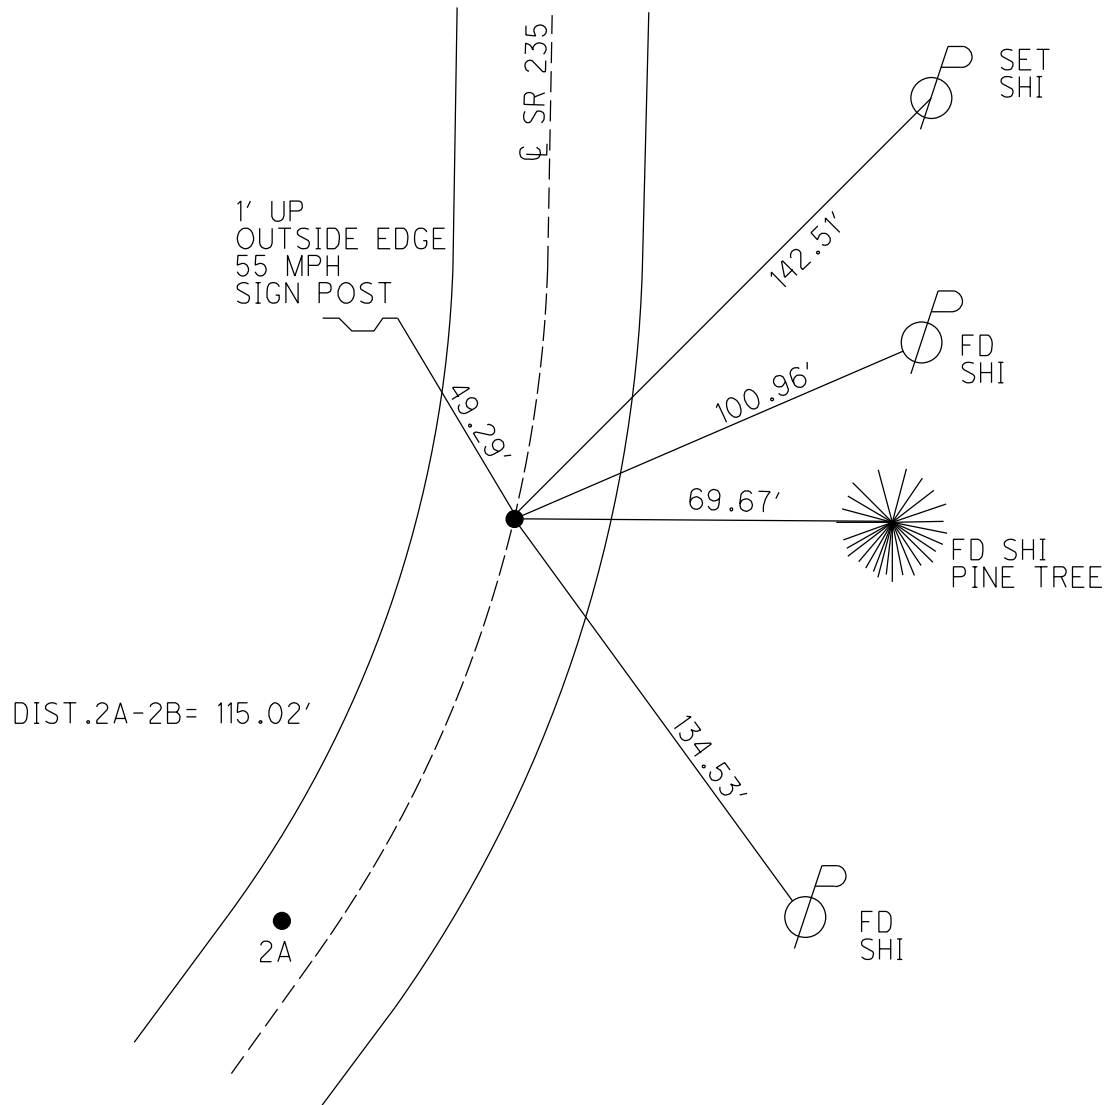

O.D.O.T. DISTRICT 2 SURVEY OFFICE (USE ONLY)

PERSONNEL

REFERENCE NO. 3

SHEET 5 OF 8

NOTES AUBLE

DATE 5-23-23

ROUTE SR 235

H.C. NIESE

WEATHER CALM

COUNTY WOOD

R.C. AUBLE

TEMP. 74° F

TOWNSHIP JACKSON

SECTION 25

DWG BY AUBLE

PID PAVETRAIN

T 3 N R 9 E

TYPE MONUMENT MAG/WASHER

ON SURFACE - ~~BELOW~~ ON

OFFSET CL PAVEMENT 2.5' LT : ~~RT~~

- TO - EDGE PAVEMENT


STATION: 53+76.82

HORIZ.DATUM: NAD83(2011)

GEOID: NAVD88 2018


GRID: NORTHING: 554935.199

EASTING: 1614977.520

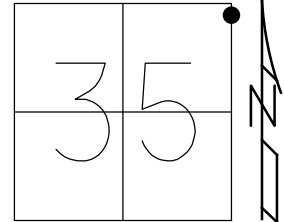

RECORD:

FD P.K./WASHER
FD MAG/WASHER
5/6/04, RGN
SET MAG/WASHER
8-3-04, MC
FD MAG/WASHER
REF3
6/1/18, JLL
4-27-21
9-16-21, JFO
1/11/23, JMR
2/1/23, JAM
8/14/23, TDN

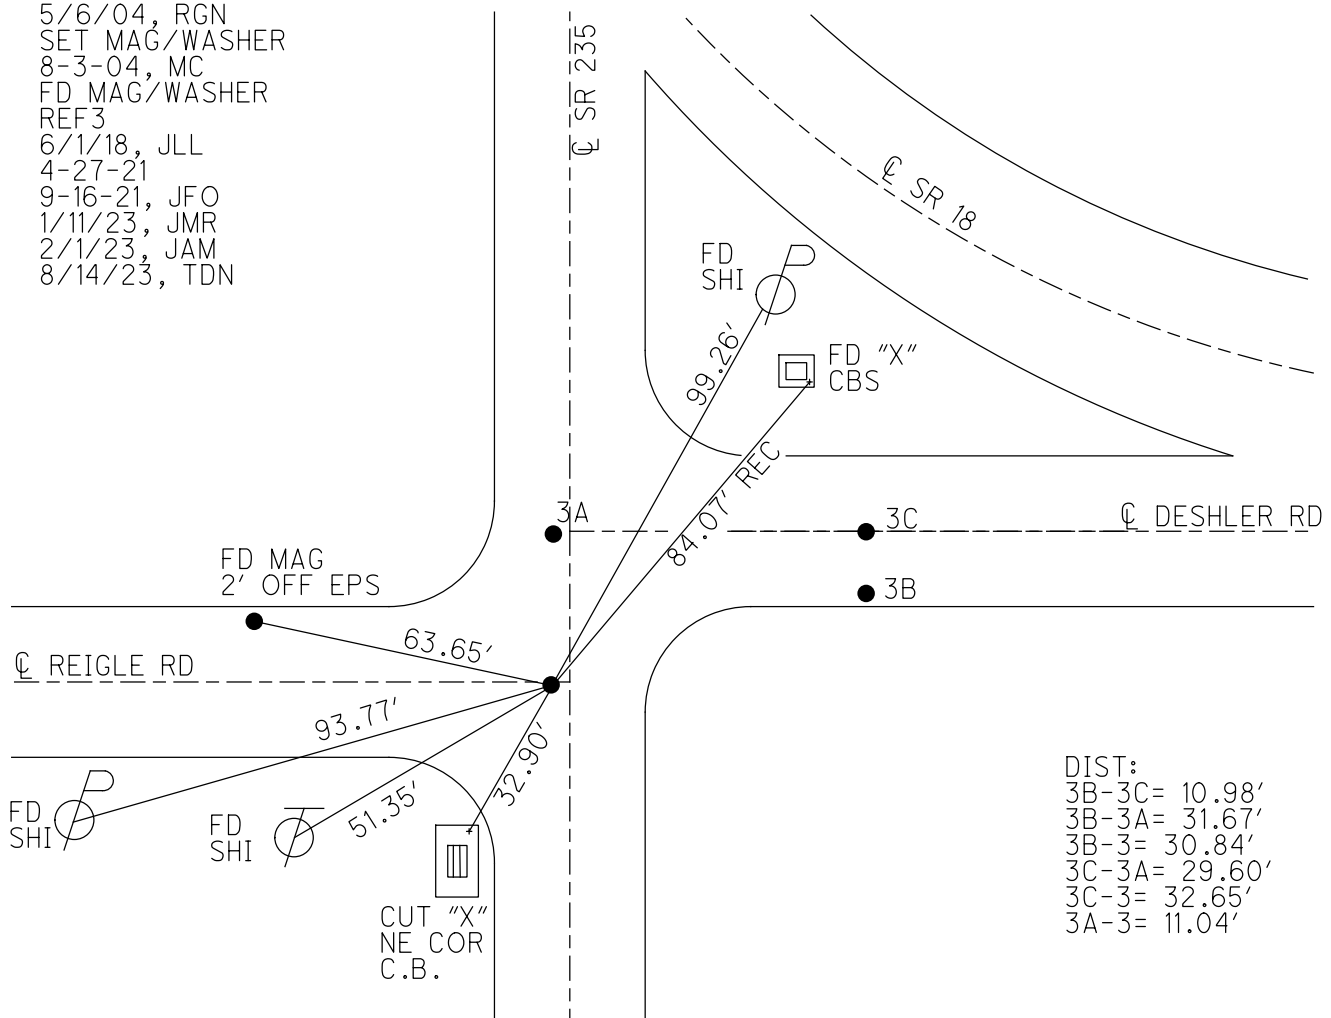

DIST:
3B-3C= 10.98'
3B-3A= 31.67'
3B-3= 30.84'
3C-3A= 29.60'
3C-3= 32.65'
3A-3= 11.04'

O.D.O.T. DISTRICT 2 SURVEY OFFICE (USE ONLY)

PERSONNEL

REFERENCE NO. A 3

SHEET 4 OF 26

NOTES NIESE

DATE 10/28/24

ROUTE SR 235

H.C. NIESE

WEATHER CALM

COUNTY WOOD

R.C. PRESTON-COLVIN

TEMP. 42°

TOWNSHIP JACKSON

DWG BY BARRIERE

PID 101290

SECTION 26

T 3 N R 9 E

TYPE MONUMENT MAG NAIL/WASHER

ON SURFACE - BELOW ON

OFFSET $\angle$ PAVEMENT 2.5' LT LT : RT


TO EDGE PAVEMENT

STATION: 53+76.82

HORIZ.DATUM: NAD83(2011)/WOOD LDP GEOID: 2018


GRID: NORTHING: 376295.312 EASTING: 127046.020

LDP: NORTHING: 554946.152 EASTING: 1614978.692

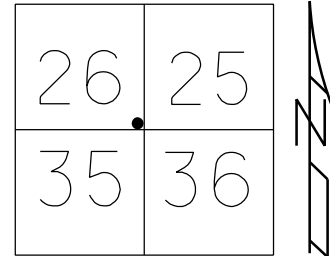

RECORD: P.I.
STA 346+43.13
1927 PLANS
FD P.K./WASHER
FD MAG/WASHER
5/6/04, RGN
SET MAG/WASHER
8-3-04, MC
FD MAG/WASHER
REFA3
6/1/18, JLL
4-27-21
9-16-21, JFO
1/11/23, JMR
2/1/23, JAM
8/14/23, TDN
SET MAG/WASHER
10/28/24, TDN

NOTE: SR 18 REF15A

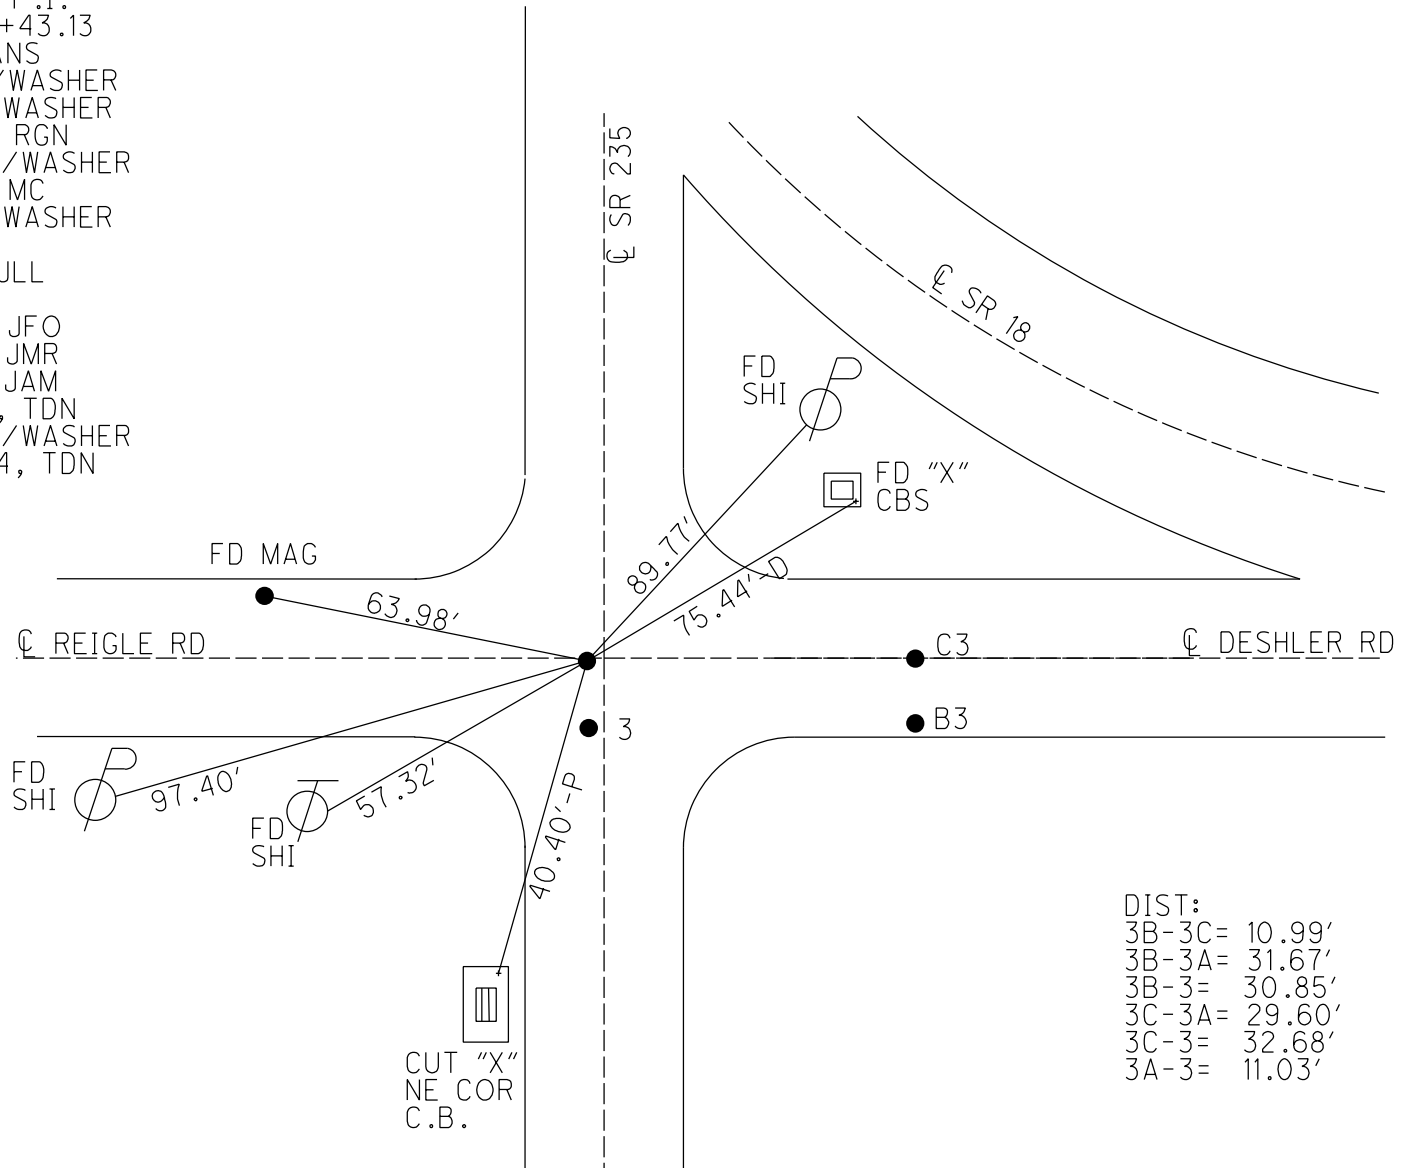

O.D.O.T. DISTRICT 2 SURVEY OFFICE (USE ONLY)

PERSONNEL

REFERENCE NO. B 3

SHEET 4 OF 26

NOTES NIESE
H.C. NIESE
R.C. PRESTON-COLVIN

DATE 10/28/24
WEATHER CALM
TEMP. 42°

ROUTE SR 235
COUNTY WOOD
TOWNSHIP JACKSON
SECTION 25

DWG BY BARRIERE PID 101290

T 3 N R 9 E

TYPE MONUMENT MAG NAIL/WASHER

ON SURFACE - BELOW ON

OFFSET $\varnothing$ PAVEMENT 28.6' RT LT : RT

TO EDGE PAVEMENT

STATION: 53+77

HORIZ.DATUM: NAD83(2011)/WOOD LDP GEOID: 2018

GRID: NORTHING: 376284.612 EASTING: 127075.797


LDP: NORTHING: 554935.061 EASTING: 1615008.323

26	25
35	36



RECORD:
SW COR. SEC. 25
FD P.K./WASHER
OVER STONE
FD MAG/WASHER
5/6/04, RGN
SET MAG/WASHER
8/3/04, MC
FD MAG/WASHER
2" DOWN
REFB3
6/1/18, JLL
FD SM.R.R.SPIKE
1 1/2" DOWN
REFB3
4/27/21
9/16/21, JFO
1/11/23, JMR
FD SM RSPK
2" DOWN
REFB3
2/1/23, JAM
8/14/23, TDN
SET MAG/WASHER
10/28/24, TDN

NOTE: SR 18 REFC15

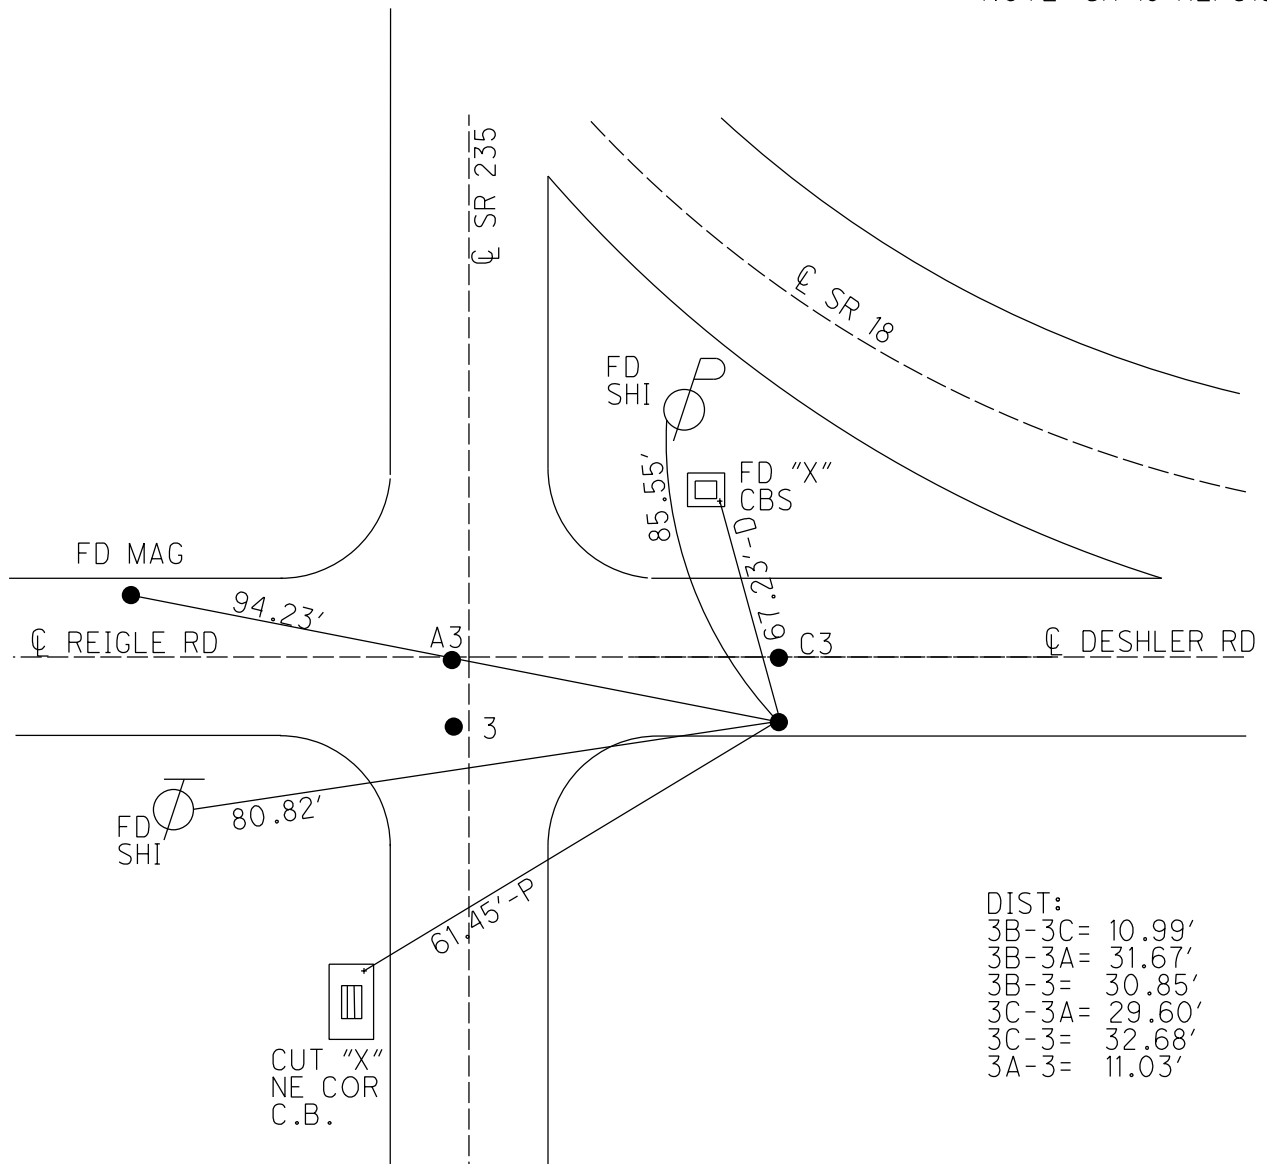

DIST:
3B-3C= 10.99'
3B-3A= 31.67'
3B-3= 30.85'
3C-3A= 29.60'
3C-3= 32.68'
3A-3= 11.03'

O.D.O.T. DISTRICT 2 SURVEY OFFICE (USE ONLY)

PERSONNEL

REFERENCE NO. C 3

SHEET 4 OF 26

NOTES NIESE
H.C. NIESE
R.C. PRESTON-COLVIN

DATE 10/28/24
WEATHER CALM
TEMP. 42°

ROUTE SR 235
COUNTY WOOD
TOWNSHIP JACKSON
SECTION 25

DWG BY BARRIERE PID 101290

T 3 N R 9 E

TYPE MONUMENT MAG NAIL/WASHER

ON SURFACE - BELOW ON

OFFSET Q PAVEMENT 27.5' RT LT : RT

TO EDGE PAVEMENT

STATION: 53+87

HORIZ.DATUM: NAD83(2011)/WOOD LDP GEOID: 2018

GRID: NORTHING: 376284.612 EASTING: 127075.797


LDP: NORTHING: 554935.061 EASTING: 1615008.323

26	25
35	36



RECORD:
FD P.K./WASHER
2" DOWN
FD MAG/WASHER
5/6/04, RGN
SET MAG/WASHER
8-3-04, MC
SET MAG/WASHER
REFC3
6/1/18, JLL
FD MAG/WASHER
REFC3
4-27-21
9-16-21, JFO
1/11/23, JMR
2/1/23, JAM
8/14/23, TDN
SET MAG/WASHER
10/28/24, TDN

NOTE: SR 18 REFB15

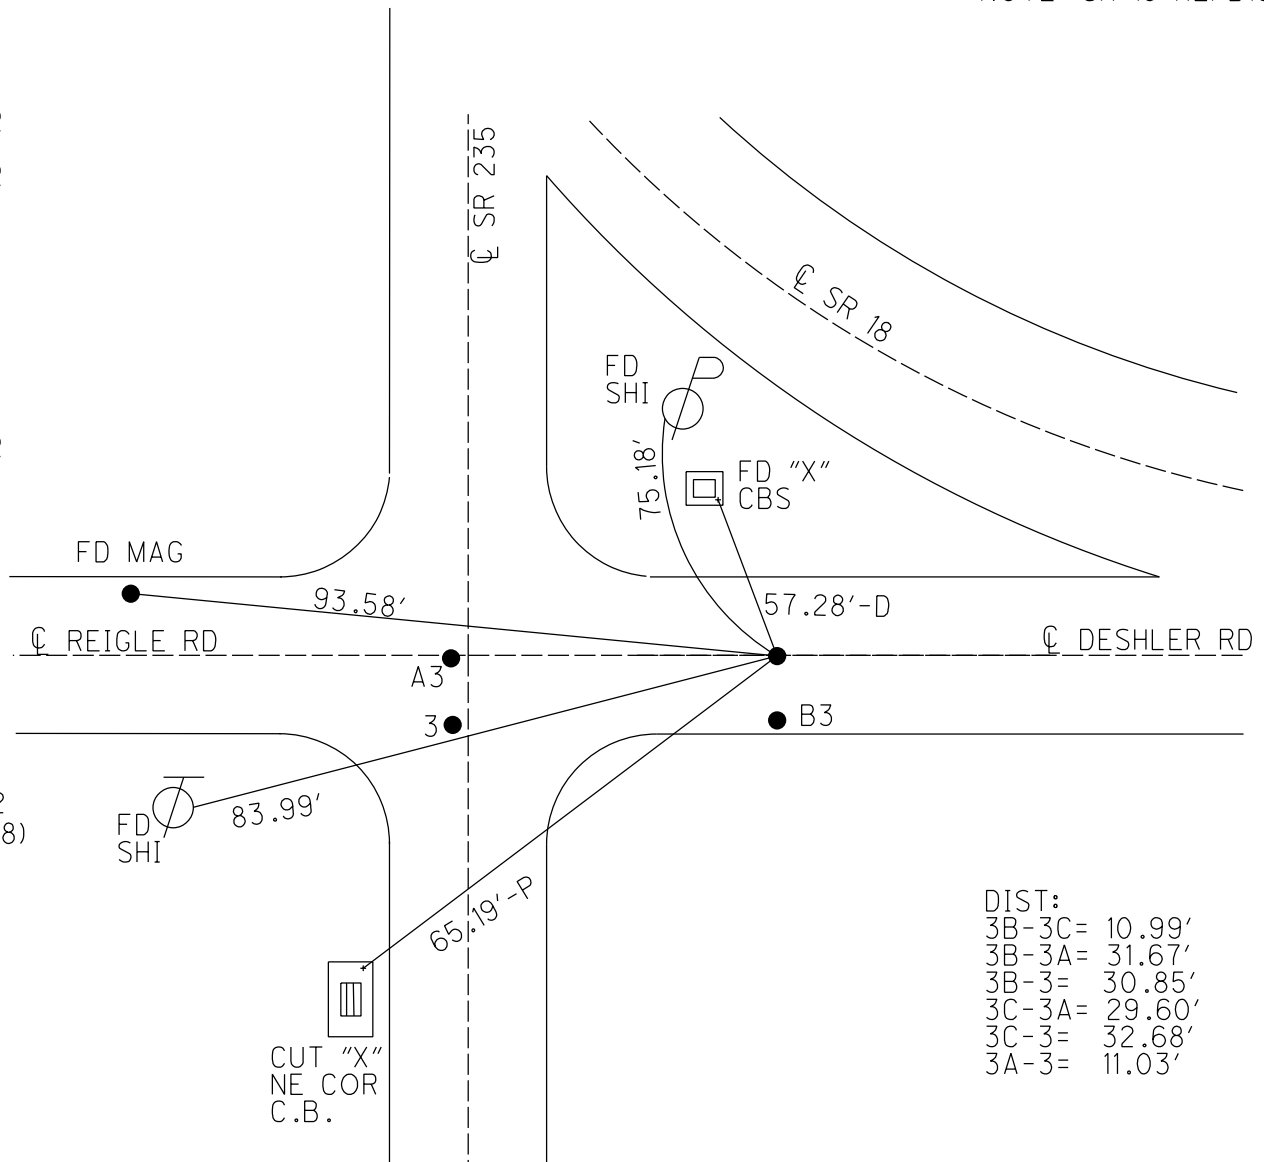

RECORD: P.I.
REC STA. 346+42
1927 PLANS (SR-18)
 $\Delta = 90^\circ 39'$
D = $19^\circ 0'$
R = 302.943
T = 306.423
L = 477.105
E = 127.932

DIST:
3B-3C= 10.99'
3B-3A= 31.67'
3B-3= 30.85'
3C-3A= 29.60'
3C-3= 32.68'
3A-3= 11.03'

O.D.O.T. DISTRICT 2 SURVEY OFFICE (USE ONLY)

PERSONNEL

REFERENCE NO. 4

SHEET 4 OF 26

NOTES NIESE
H.C. NIESE
R.C. PRESTON-COLVIN

DATE 5/21/24
WEATHER CALM
TEMP. 45°

ROUTE SR 235
COUNTY WOOD
TOWNSHIP JACKSON
SECTION 25
T 3 N R 9 E

DWG BY BARRIERE PID 101290

TYPE MONUMENT MAG NAIL/WASHER

ON SURFACE - BELOW ON

OFFSET Q PAVEMENT ON LT : RT


TO EDGE PAVEMENT

STATION: 80+17.37

HORIZ.DATUM: NAD83(2011)/WOOD LDP GEOID: 2018


GRID: NORTHING: 378924.939 EASTING: 127076.686

LDP: NORTHING: 557574.922 EASTING: 1615044.014

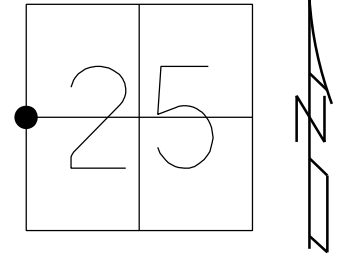

RECORD:
SET PK/WASHER
4-17-91, MB
FD SM RR SPIKE
REF4
2/1/23, JAM
5/21/24, TDN
SET MAG/WASHER
10/28/24, TDN

NOTE: SR 18 REF14

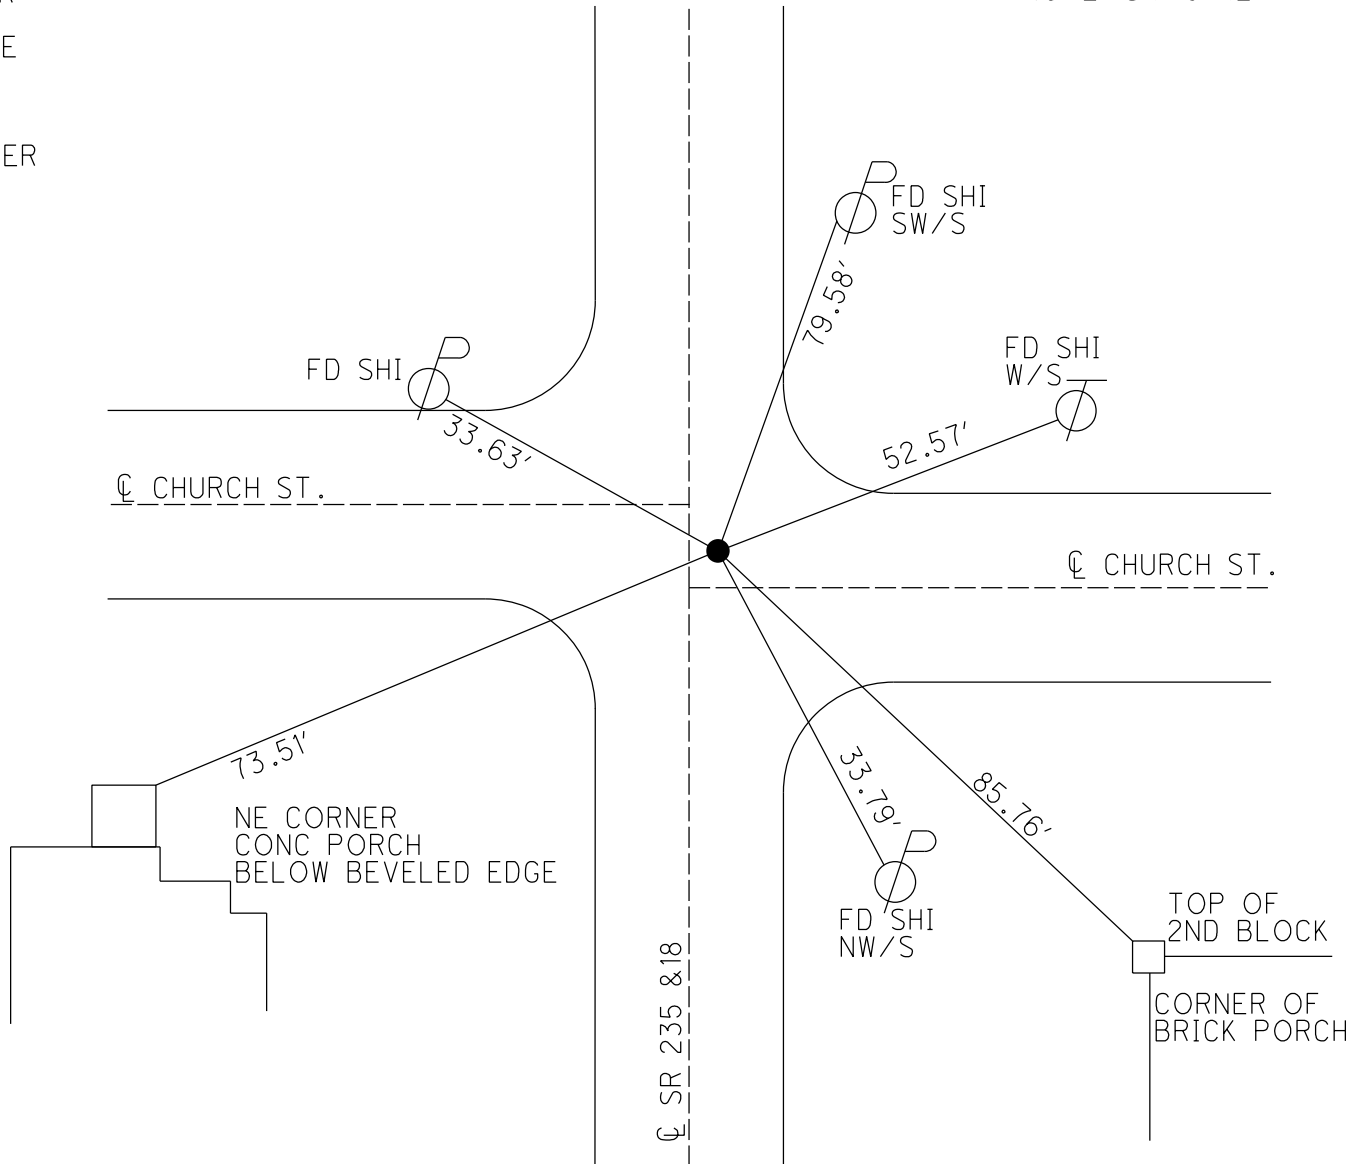

O.D.O.T. DISTRICT 2 SURVEY OFFICE (USE ONLY)

PERSONNEL

REFERENCE NO. A4

SHEET 4 OF 26

NOTES NIESE

DATE 10/28/24

ROUTE SR 235

H.C. NIESE

WEATHER CLEAR

COUNTY WOOD

R.C. PRESTON-COLVIN

TEMP. 47°

TOWNSHIP JACKSON

DWG BY BARRIERE

PID 101290

SECTION 25

T 3 N R 9 E

TYPE MONUMENT MAG NAIL/WASHER

ON SURFACE - BELOW ON

OFFSET $\varnothing$ PAVEMENT 1' LT ~~LT~~ : RT


TO EDGE PAVEMENT

STATION:

HORZ.DATUM: NAD83(2011)/WOOD LDP GEOID: 2018


GRID: NORTHING: 379244.199 EASTING: 127076.001

LDP: NORTHING: 557894.136 EASTING: 1615047.537

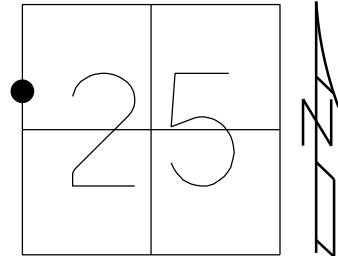

RECORD:
FD MAG
REFA4
2/1/23, JAM
5/21/24, TDN
SET MAG/WASHER
10/28/24, TDN

NOTE: SR 18 REFA13

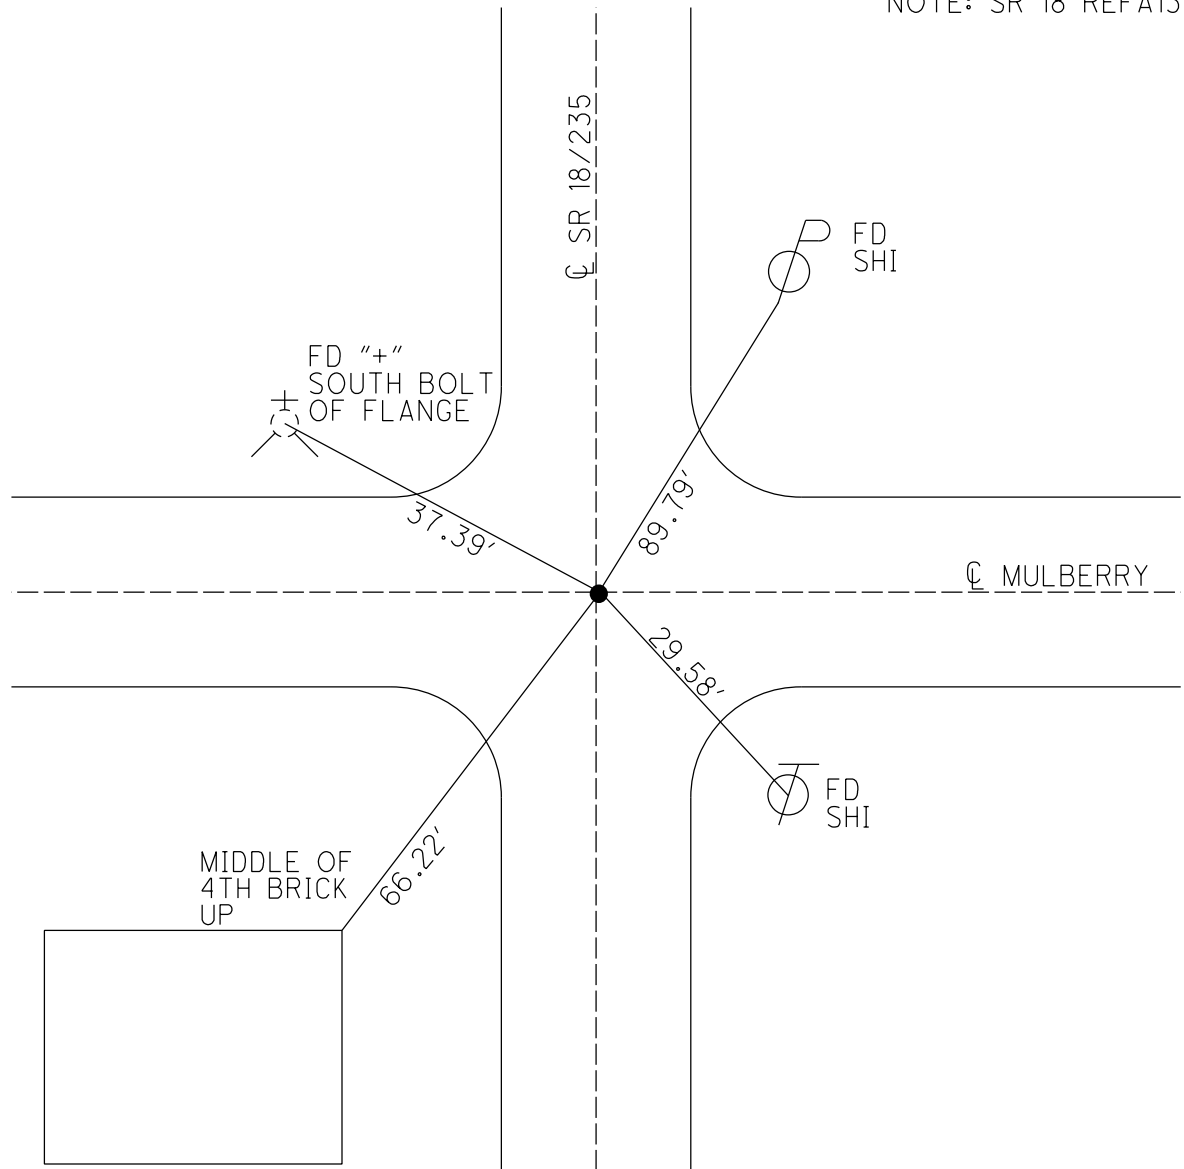

O.D.O.T. DISTRICT 2 SURVEY OFFICE (USE ONLY)

PERSONNEL

REFERENCE NO. A4

SHEET 4 OF 26

NOTES NIESE

DATE 10/28/24

ROUTE SR 235

H.C. NIESE

WEATHER CLEAR

COUNTY WOOD

R.C. PRESTON-COLVIN

TEMP. 47°

TOWNSHIP JACKSON

DWG BY BARRIERE

PID 101290

SECTION 25

T 3 N R 9 E

TYPE MONUMENT MAG NAIL/WASHER

ON SURFACE - BELOW ON

OFFSET $\varnothing$ PAVEMENT 1.6' RT LT : RT


TO EDGE PAVEMENT

STATION: 106+47.77

HORIZ.DATUM: NAD83(2011)/WOOD LDP GEOID: 2018


GRID: NORTHING: 381555.564 EASTING: 127071.129

LDP: NORTHING: 560205.168 EASTING: 1615073.130

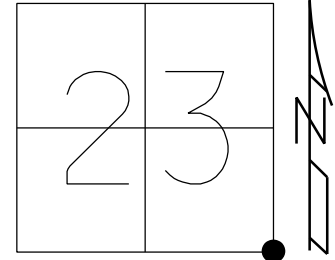

SET PK/WASHER
4-17-91, MB
SET MAG/WASHER
7/26/05, DCH
FD MAG/WASHER
REF13 (SR18)
6/12/20
9/16/21, JFO
FD MAG/WASHER
REF5 (SR235)
2/1/23, JAM
SET MAG/WASHER
(REF13 SR18)
10/28/24, TDN

NOTE: SR 18 REF13

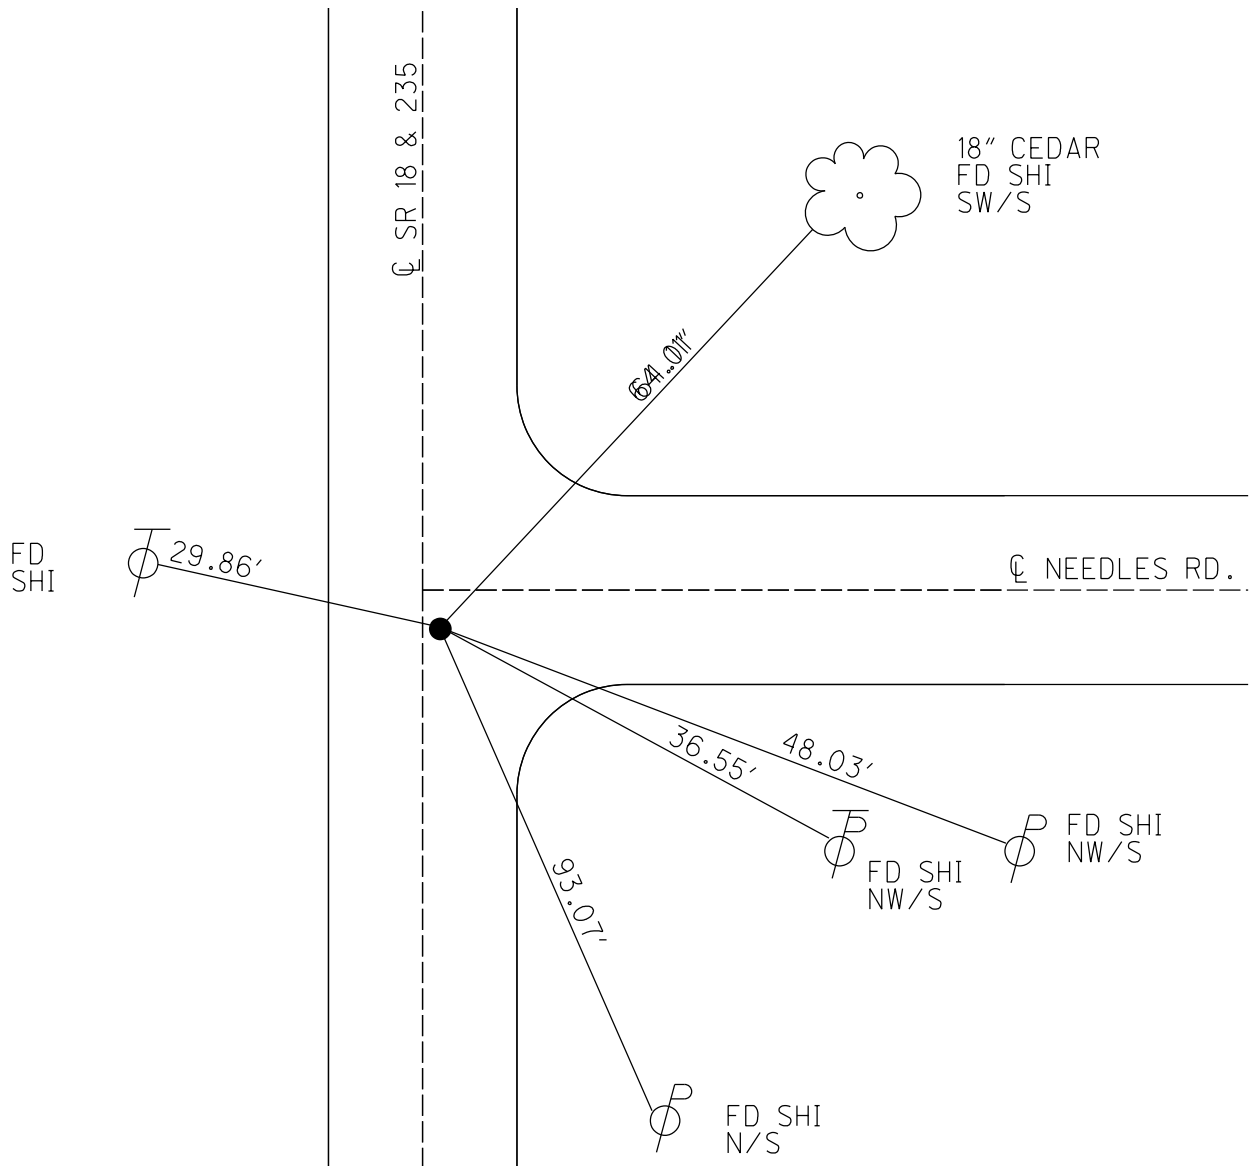

O.D.O.T. DISTRICT 2 SURVEY OFFICE (USE ONLY)

PERSONNEL

REFERENCE NO. 6

SHEET 3 OF 26

NOTES AUBLE

DATE 5-23-23

ROUTE SR 235

H.C. NIESE

WEATHER CALM

COUNTY WOOD

R.C. AUBLE

TEMP. 74°F

TOWNSHIP JACKSON

DWG BY ASTON

PID PAVETRAIN

SECTION 23

T 3 N R 9 E

TYPE MONUMENT MAG/WASHER

ON SURFACE - BELOW ON

OFFSET Q PAVEMENT 1.4 LT : RT

7.9' TO LT EDGE PAVEMENT



STATION: 132+92.51

HORZ.DATUM: NAD83(2011)

GEOID: 18

GRID: NORTHING: 562849.825

EASTING: 1615087.890

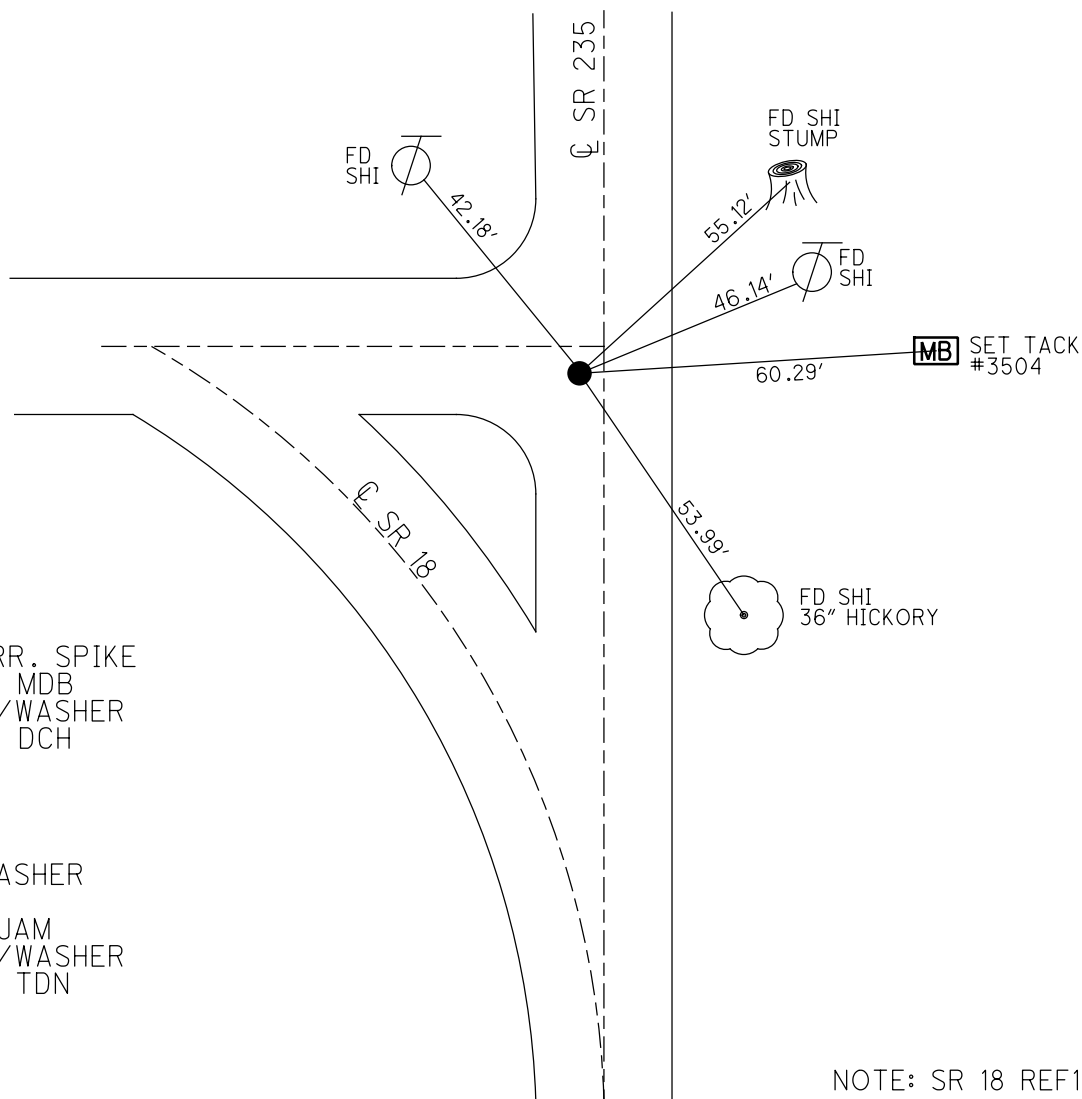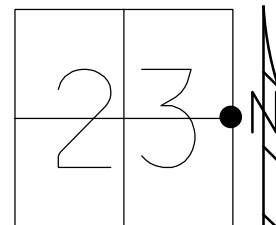

RECORD:
 SET SM RR. SPIKE
 6-26-86, MDB
 SET MAG/WASHER
 7-26-05, DCH
 REF6
 8-27-15
 REF12
 09-04-15
 FD PK/WASHER
 REF6
 2/1/23, JAM
 SET MAG/WASHER
 8/14/23, TDN

NOTE: SR 18 REF12

O.D.O.T. DISTRICT 2 SURVEY OFFICE (USE ONLY)

PERSONNEL

REFERENCE NO. 7

SHEET 4 OF 26

NOTES PRESTON-COLVIN

H.C. ASTON

R.C. NIESE

DATE 8-2-24

WEATHER CLOUDY

TEMP. 73°

ROUTE SR 235

COUNTY WOOD

TOWNSHIP JACKSON

SECTION 23

DWG BY PRESTON-COLVIN

PID CHIPSEAL

T 3 N R 9 E

TYPE MONUMENT MAG/WASHER

ON SURFACE - BELOW ON

OFFSET Q PAVEMENT 7.7" ~~±~~ : RT

1.3' TO RT EDGE PAVEMENT

STATION: 159+40.11

HORIZ.DATUM: NAD83 (2011)


GEOID: 2018

GRID: NORTHING: 565497.971

EASTING: 1615080.459

LDP: NORTHING: 386848.5

EASTING: 127008.7

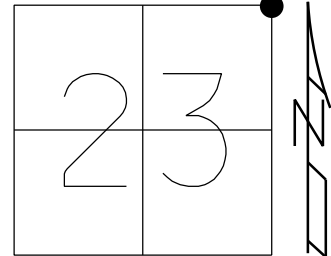

RECORD:
SET SM R.R. SPIKE
6-26-86, MDB

SET MAG/WASHER
11-3-03, DCH


GPS, REF7
8-27-15

SET MAG/WASHER
GPS, NEWREF7
7-28-16, DCH

FD MAG/WASHER
REF7
8-2-24, TDN

FD MAG/WASHER
9-18-24

ROAD CLOSED
SIGN 1' UP
LEFT LEG POST

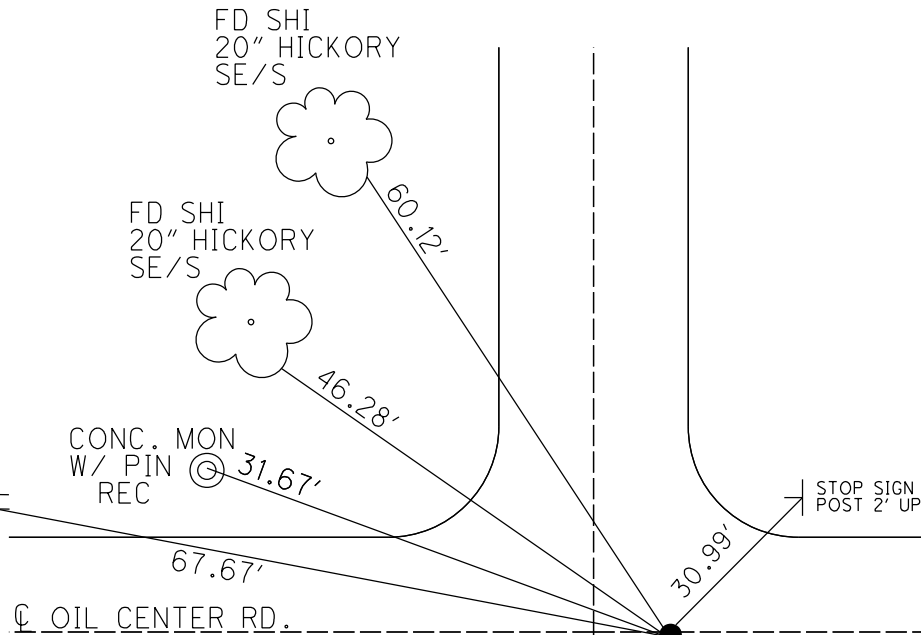

O.D.O.T. DISTRICT 2 SURVEY OFFICE (USE ONLY)

PERSONNEL

REFERENCE NO. 8

SHEET 5 OF 26

NOTES PRESTON-COLVIN

DATE 8-2-24

ROUTE SR 235

H.C. ASTON

WEATHER CLOUDY

COUNTY WOOD

R.C. NIESE

TEMP. 73°

TOWNSHIP JACKSON

DWG BY PRESTON-COLVIN PID CHIPSEAL

SECTION 14

T 3 N R 9 E

TYPE MONUMENT MAG/WASHER

~~ON SURFACE~~ - BELOW 1"

OFFSET Q PAVEMENT 10.5' ~~LT~~ : RT

ON TO RT EDGE PAVEMENT

STATION: 186+45.24

HORIZ.DATUM: NAD83 (2011)


GEOID: 2018

GRID: NORTHING: 567202.4013

EASTING: 1615101.2521

LDP: NORTHING: 389553.2

EASTING: 126993.9

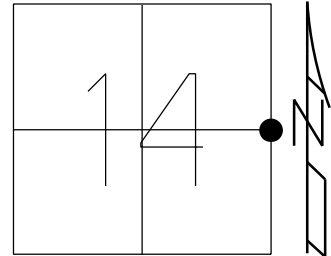


RECORD:
SET SM R.R. SPIKE
6-26-86, MDB

GPS REF8
8-27-15

SET MAG/WASHER
GPS, NEWREF8
7-28-16,DCH

FD MAG/WASHER
REF7
8-2-24,TDN

FD MAG/WASHER
9-18-24,TDN

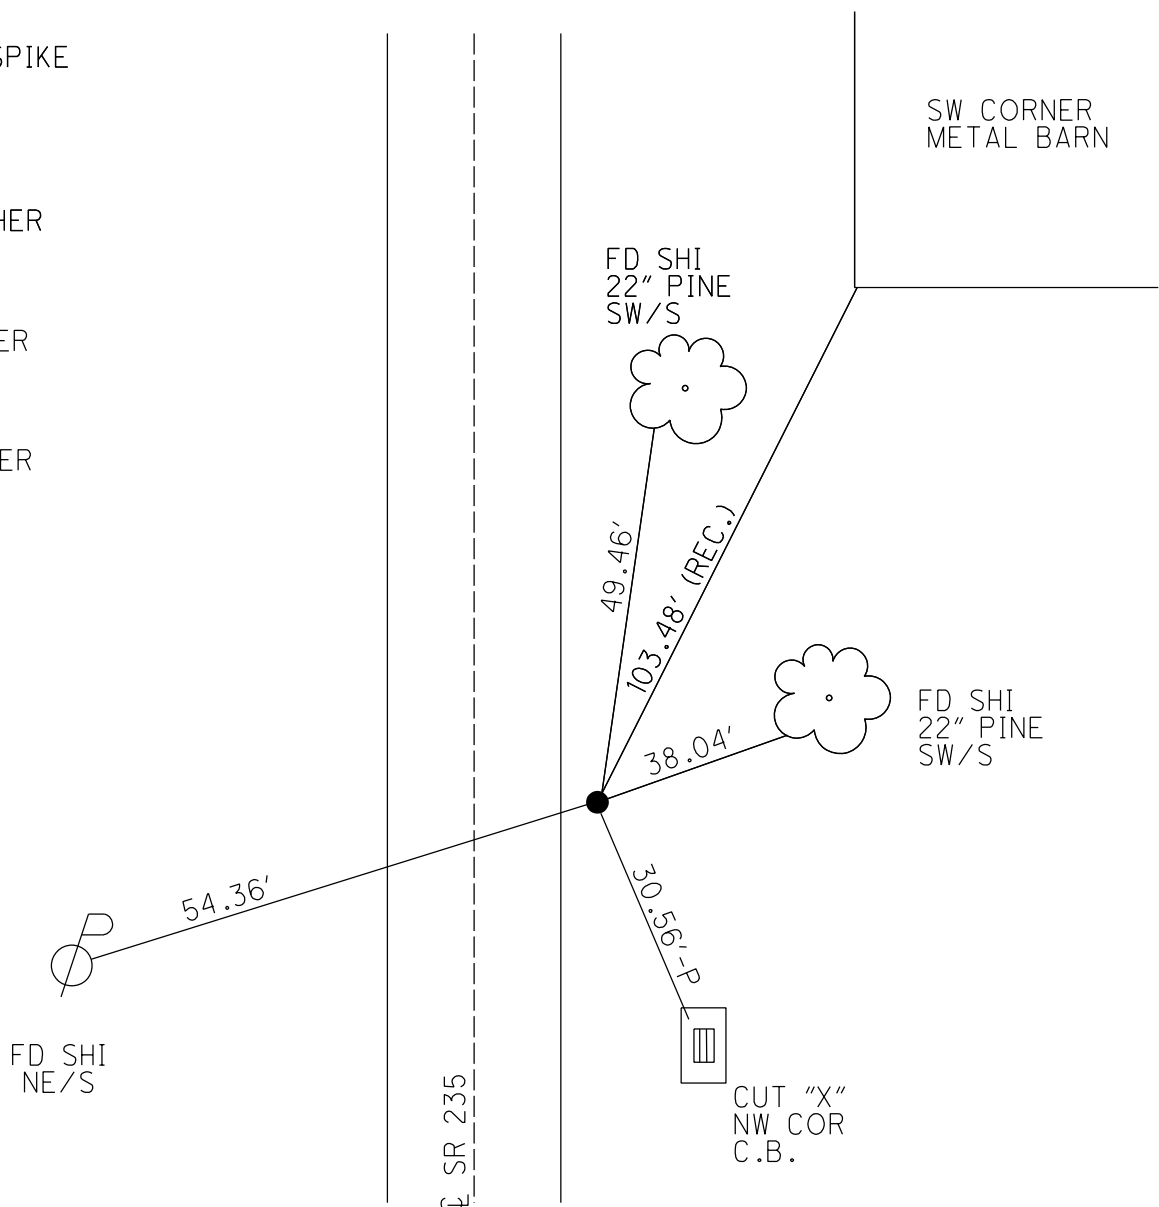

O.D.O.T. DISTRICT 2 SURVEY OFFICE (USE ONLY)

PERSONNEL

REFERENCE NO. 9

SHEET 6 OF 26

NOTES ASTON

DATE 8-21-24

ROUTE SR 235

H.C. NIESE

WEATHER CLEAR

COUNTY WOOD

R.C. PRESTON-COLVIN

TEMP. 65°

TOWNSHIP JACKSON

SECTION 14

DWG BY PRESTON-COLVIN PID CHIPSEAL

T 3 N R 9 E

TYPE MONUMENT MONBOX

~~ON SURFACE~~ - BELOW 1"

OFFSET $\varnothing$ PAVEMENT 19.0' LT : ~~RT~~

9.8' TO RT EDGE PAVEMENT

STATION: 213+50.79

HORIZ.DATUM: NAD83 (2011)


GEOID: 2018

GRID: NORTHING: 570907.9

EASTING: 1615120

LDP: NORTHING: 392258.8

EASTING: 126976.7

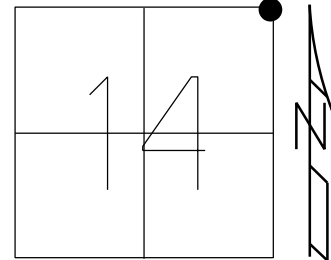

RECORD:
SET SM R.R. SPIKE
6-26-86, MDB


FD STONE
IN MONBOX
GPS, REF9

NEWMONBOX
8-27-15

FD STONE IN MONBOX
1.5' DEEP
REF9

8-21-24, TDN

FD MONBOX
9-18-24

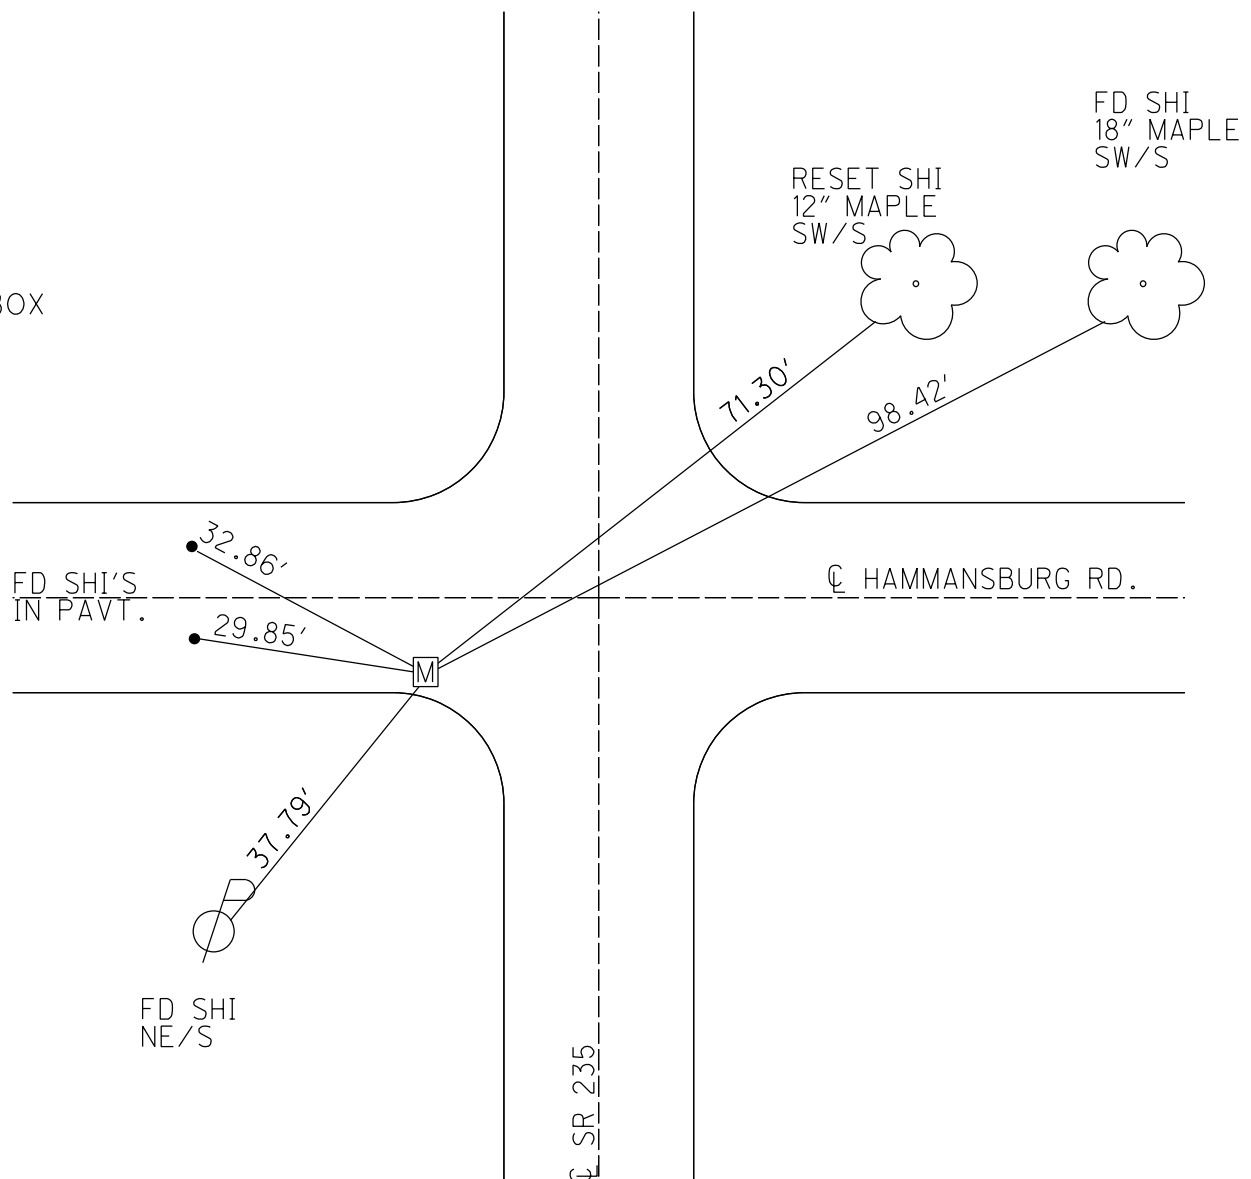

O.D.O.T. DISTRICT 2 SURVEY OFFICE (USE ONLY)

PERSONNEL

REFERENCE NO. 9A

SHEET 7 OF 26

NOTES ASTON

DATE 8-21-24

ROUTE SR 235

H.C. NIESE

WEATHER CLEAR

COUNTY WOOD

R.C. PRESTON-COLVIN

TEMP. 65°

TOWNSHIP JACKSON

SECTION 11

DWG BY PRESTON-COLVIN PID CHIPSEAL

T 3 N R 9 E

TYPE MONUMENT STONE

~~ON SURFACE~~ - BELOW 8"

OFFSET 14' Q PAVEMENT 24' LT : ~~RT~~

TO LT EDGE PAVEMENT

STATION: 226+40.03

HORIZ.DATUM: NAD83 (2011)


GEOID: 2018

GRID: NORTHING: 572198

EASTING: 1615114


LDP: NORTHING: 393548.9

EASTING: 126953.9

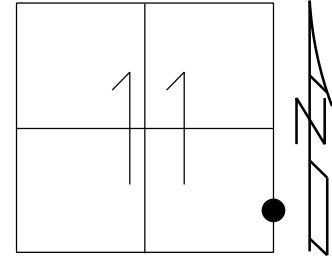

RECORD:
FD STONE
8" BELOW
GPS, REF10
10-22-14

FD STONE
REF10
8-21-24,TDN

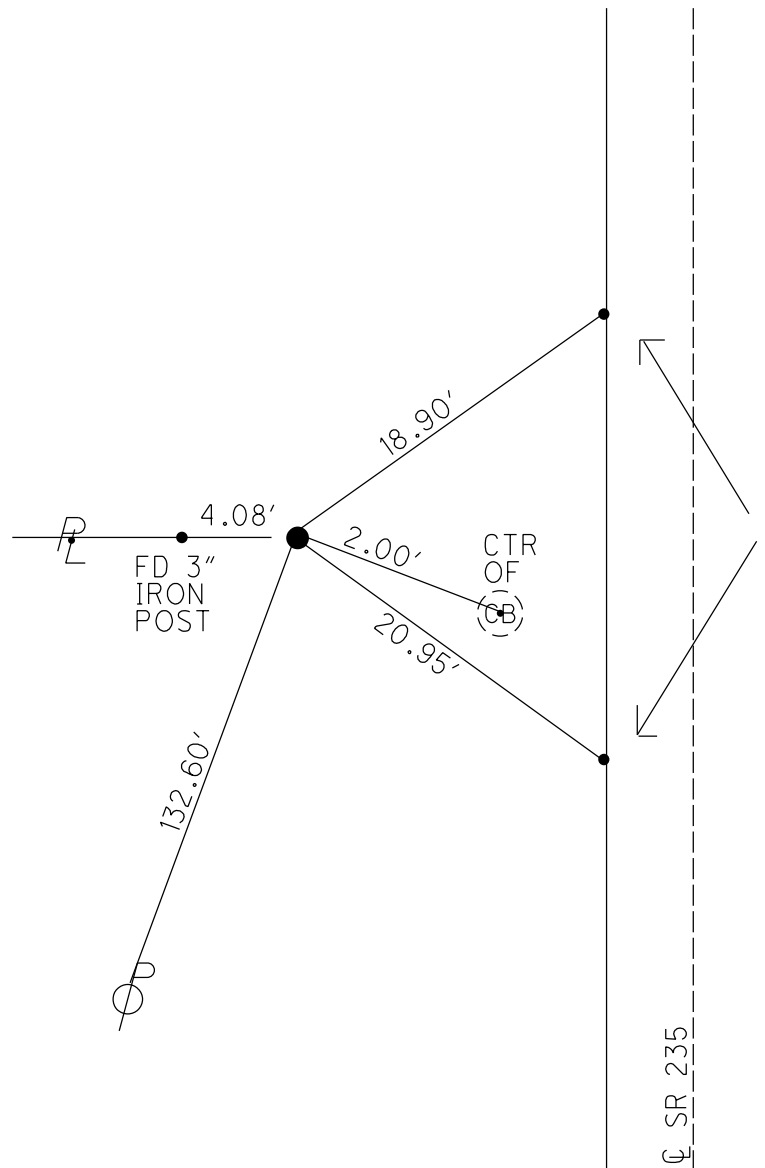

PK & WASHER
ON WHITE LINE
10-7-96 BVD

O.D.O.T. DISTRICT 2 SURVEY OFFICE (USE ONLY)

PERSONNEL

REFERENCE NO. 10

SHEET 8 OF 26

NOTES ASTON
H.C. NIESE
R.C. PRESTON-COLVIN

DATE 8-21-24
WEATHER CLEAR
TEMP. 65°

ROUTE SR 235
COUNTY WOOD
TOWNSHIP JACKSON
SECTION 11
T 3 N R 9 E

DWG BY PRESTON-COLVIN PID CHIPSEAL

TYPE MONUMENT 1/4" IPIPE

~~ON SURFACE~~ - BELOW 0.2"

OFFSET CL PAVEMENT 13.5" LT : ~~RT~~

4.4" TO LT EDGE PAVEMENT

STATION: 239+33.78

HORIZ.DATUM: NAD83 (2011)


GEOID: 2018

GRID: NORTHING: 573491

EASTING: 1615107

LDP: NORTHING: 394841.8

EASTING: 126929.7

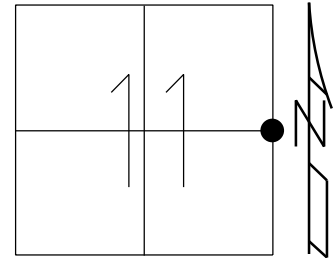


RECORD:
FD 1/2" IPIN
3" BELOW
SLIGHT LEAN WEST
GPS, REF11
10-22-14

GPS, REF10
8-27-15

NOT COVERED
GPS, NEWREF10
7-28-16, DCH

FD 1/4" IPIPE
REF10
8-21-24, TDN

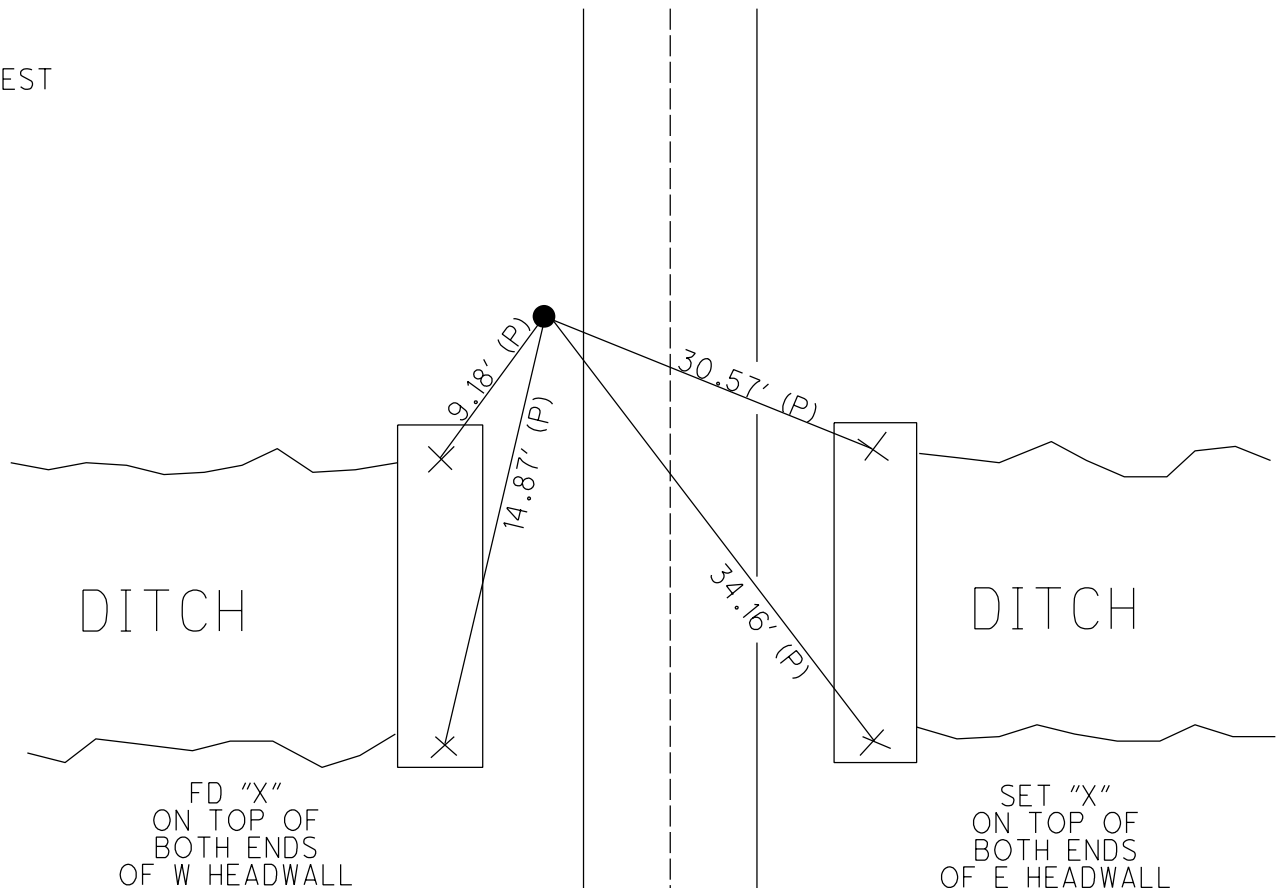

CL SR 235

O.D.O.T. DISTRICT 2 SURVEY OFFICE (USE ONLY)

PERSONNEL

REFERENCE NO. 11

SHEET 9 OF 26

NOTES ASTON

DATE 8-21-24

ROUTE SR 235

H.C. NIESE

WEATHER CLEAR

COUNTY WOOD

R.C. PRESTON-COLVIN

TEMP. 65°

TOWNSHIP JACKSON

DWG BY PRESTON-COLVIN PID CHIPSEAL

SECTION 11

T 3 N R 9 E

TYPE MONUMENT MAG/WASHER

ON SURFACE - ~~BELOW~~ ON

OFFSET Q PAVEMENT 17.5" LT : ~~RT~~

- TO - EDGE PAVEMENT

STATION: 264+33.97

HORIZ.DATUM: NAD83 (2011)


GEOID: 2018

GRID: NORTHING: 575990.7

EASTING: 1615062

LDP: NORTHING: 397340.9

EASTING: 126851.9

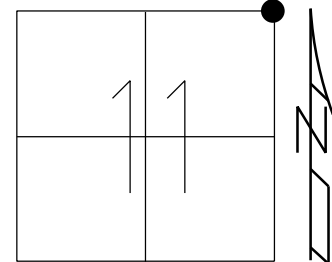


RECORD:
FD MAG SPIKE
@ SURFACE
GPS, REF12
10-22-14


GPS, REF11
8-27-15


SET MAG/WASHER
GPS, NEWREF11
7-28-16, DCH


FD MAG/WASHER
REF11
8-21-24, TDN

FD MAG/WASHER
9-18-24, TDN

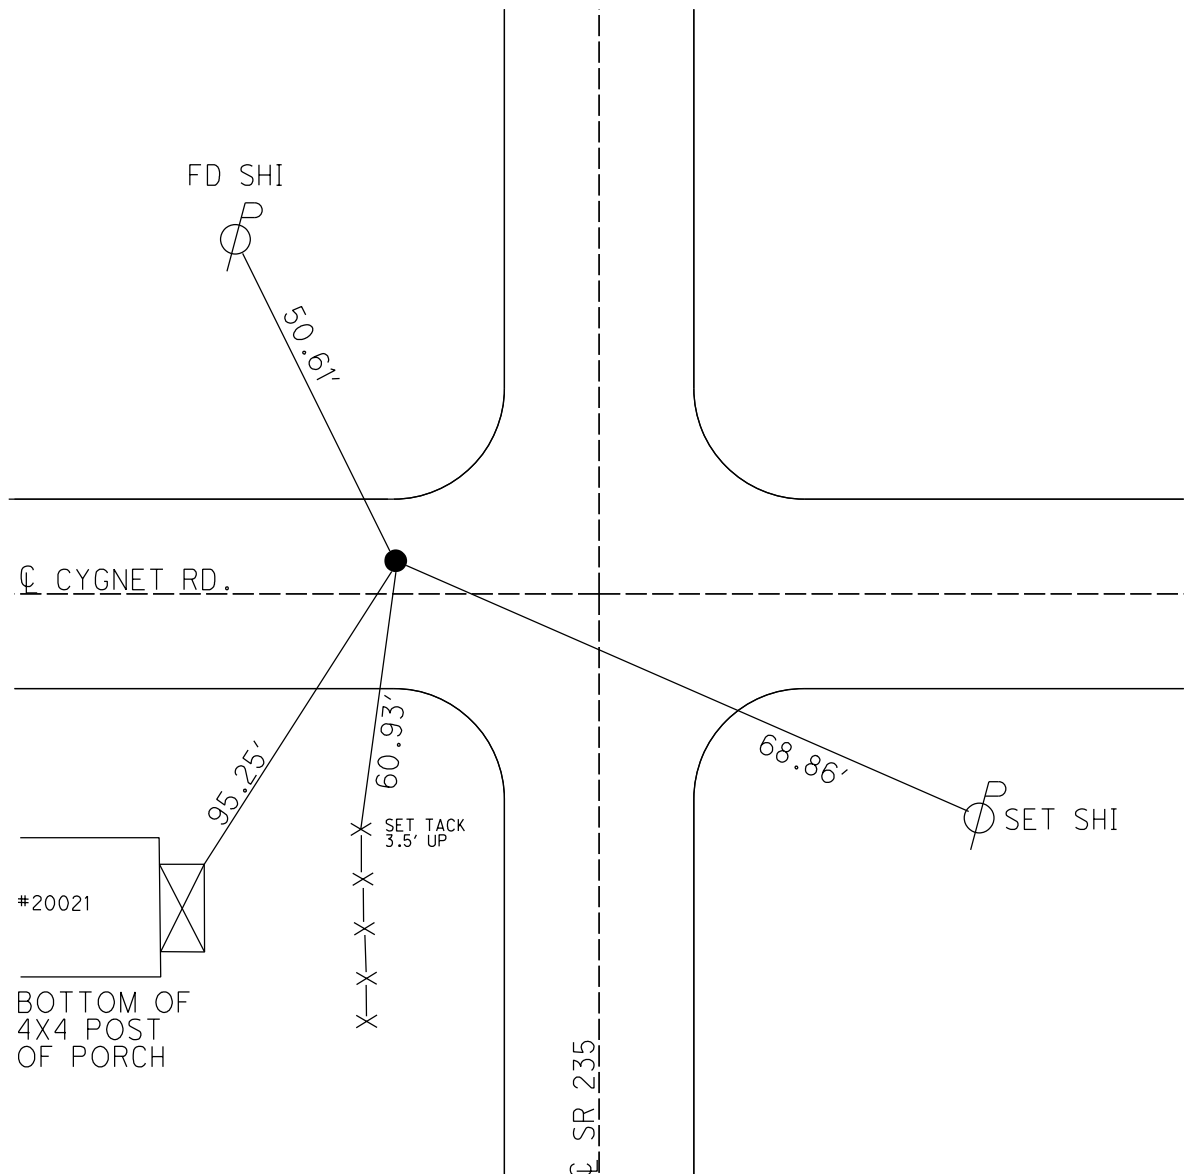

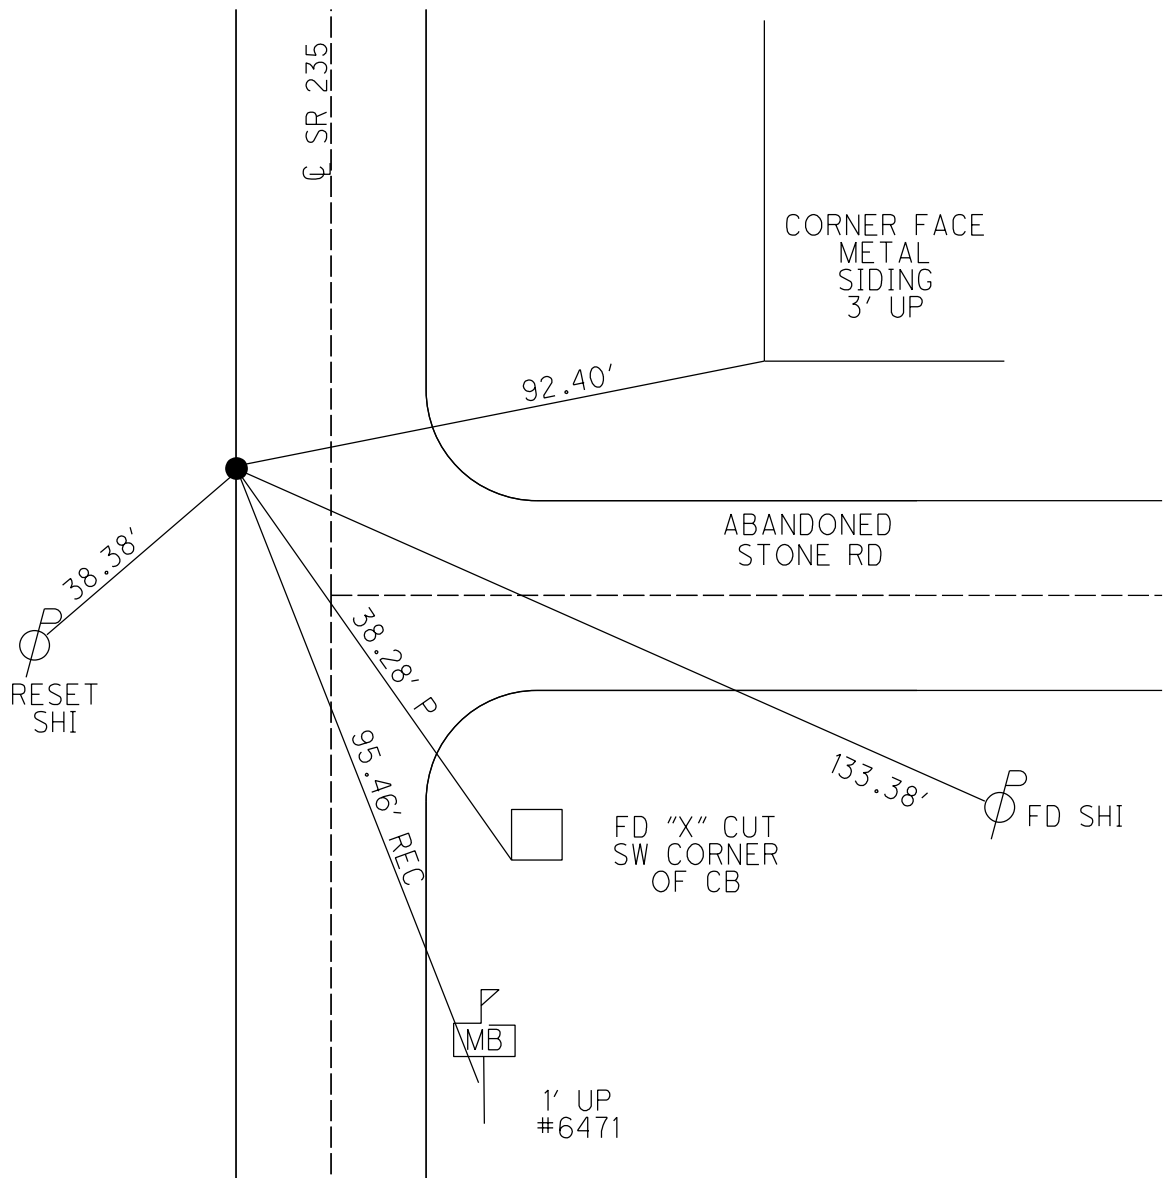

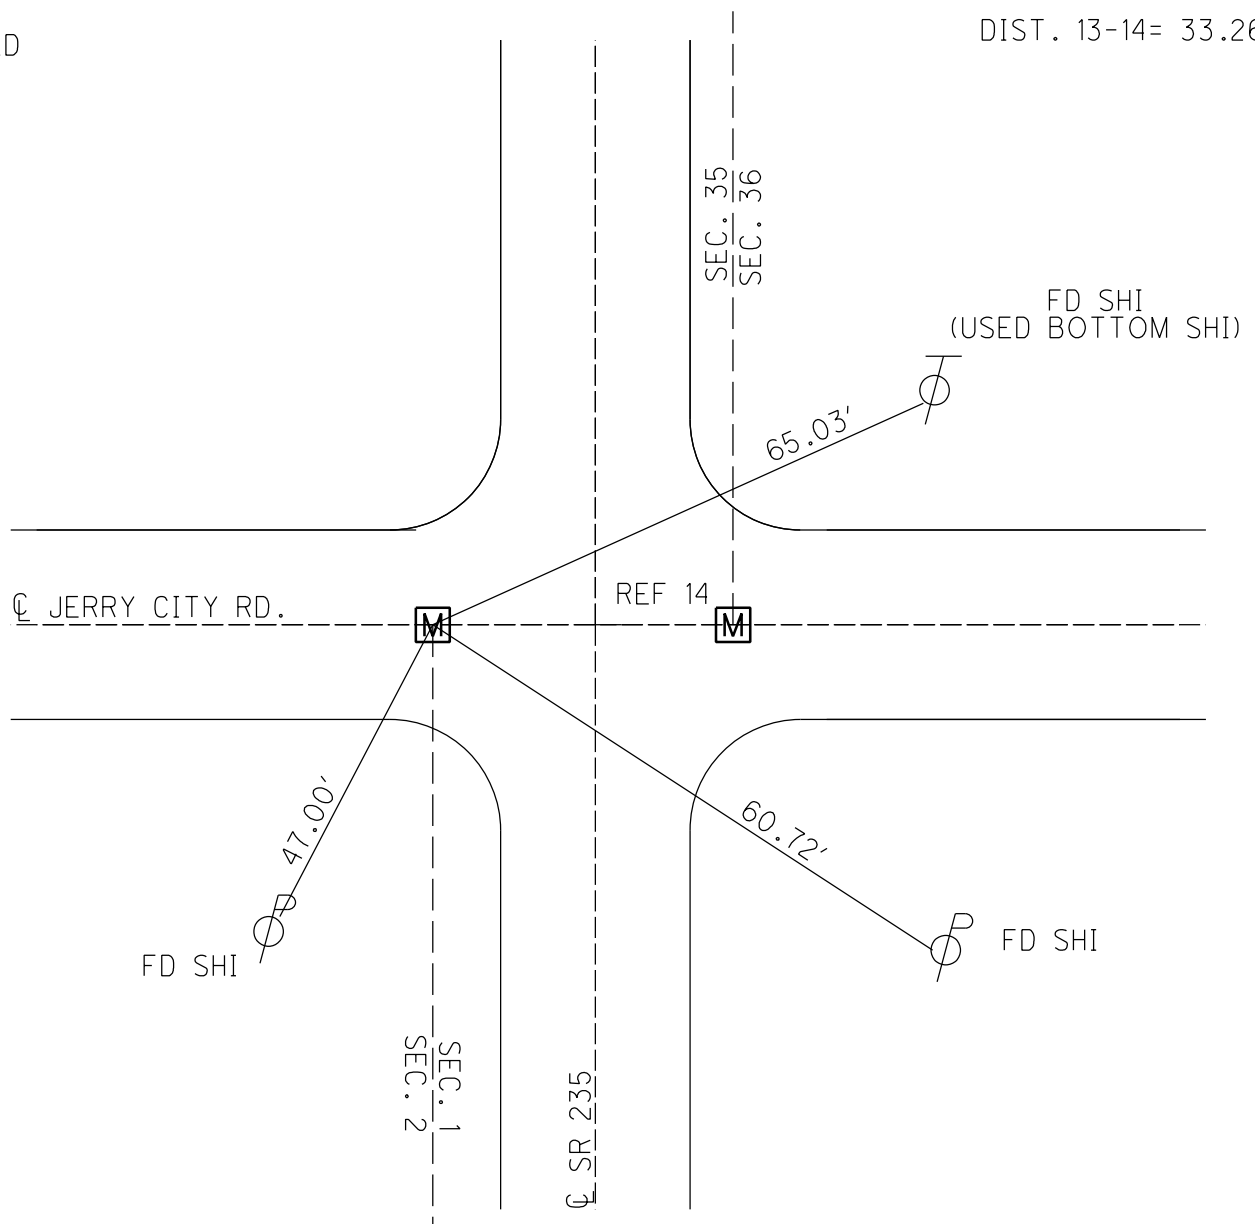

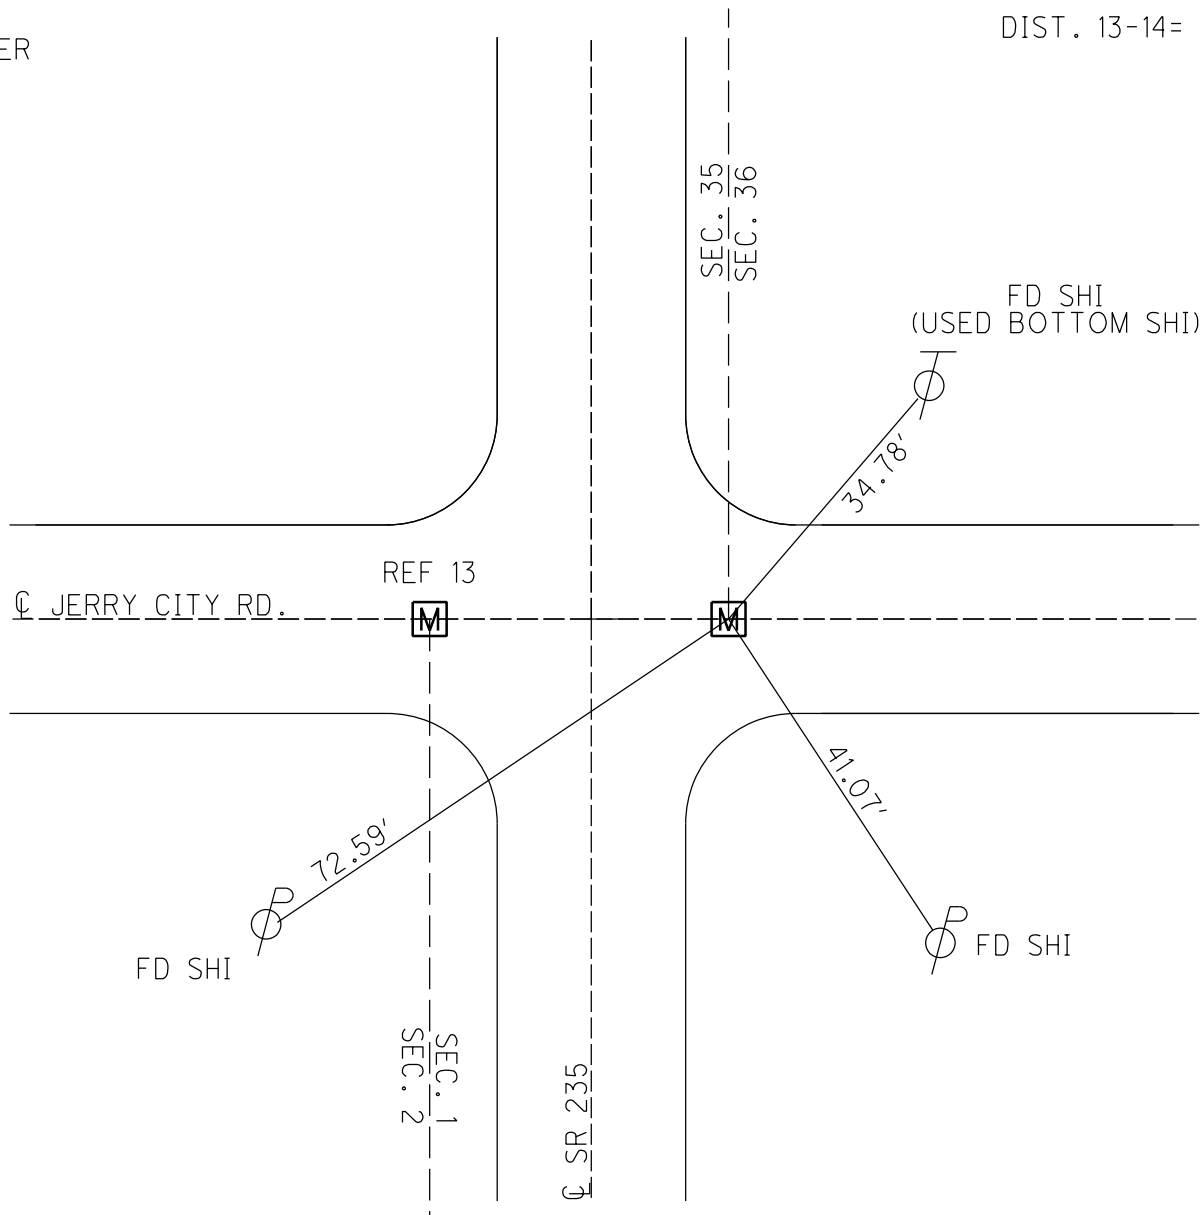

O.D.O.T. DISTRICT 2 SURVEY OFFICE (USE ONLY)

PERSONNEL

REFERENCE NO. 14A

SHEET 13 OF 26

NOTES ASTON
H.C. NIESE
R.C. PRESTON-COLVIN

DATE 8-21-24
WEATHER CLEAR
TEMP. 65°

ROUTE SR 235
COUNTY WOOD
TOWNSHIP MILTON
SECTION 35
T 4 N R 9 E

DWG BY PRESTON-COLVIN PID CHIPSEAL

TYPE MONUMENT MAG/WASHER

ON SURFACE - ~~BELOW~~ ON

OFFSET 10.2' Q PAVEMENT 1.3' LT : ~~RT~~
TO RT EDGE PAVEMENT

STATION: 332+42.39

HORIZ.DATUM: NAD83 (2011)


GEOID: 2018

GRID: NORTHING: 582765.9

EASTING: 1615098

LDP: NORTHING: 404116.6

EASTING: 126798.8

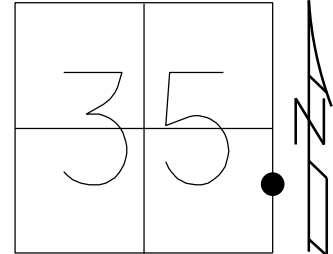

RECORD:
NOTE: NO PERMANET
REF TIES AVAILABLE
POINTS HELD- RESET
USING TEMPORAY HUBS 2003

FD MAG/WASHER
11-3-03, DCH


FD MAG NAIL
GPS, REF16
10-22-14

GPS, REFA14
8-27-15

ALL TIES DESTROYED
SET MAG/WASHER
W/COORDINATES
GPS, NEWREFA14
9-6-16, JFO

FD MAG/WASHER
REF14A
8-21-24,TDN

FD MAG/WASHER
9-18-24,TDN

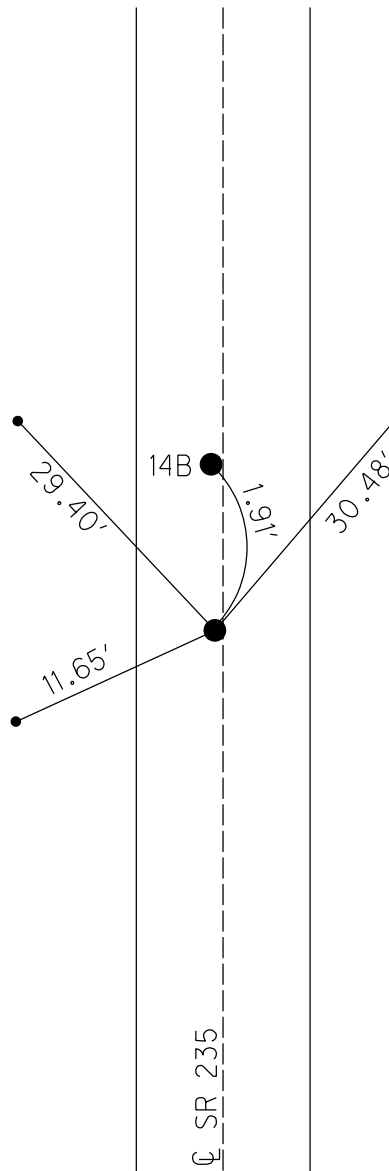

O.D.O.T. DISTRICT 2 SURVEY OFFICE (USE ONLY)

PERSONNEL

REFERENCE NO. 14B

SHEET 14 OF 26

NOTES ASTON
H.C. NIESE
R.C. PRESTON-COLVIN

DATE 8-21-24
WEATHER CLEAR
TEMP. 65°

ROUTE SR 235
COUNTY WOOD
TOWNSHIP MILTON
SECTION 35
T 4 N R 9 E

DWG BY PRESTON-COLVIN PID CHIPSEAL

TYPE MONUMENT MAG/WASHER

ON SURFACE - ~~BELOW~~ ON

OFFSET Q PAVEMENT 0.5' LT : ~~RT~~

9.4' TO RT EDGE PAVEMENT

STATION: 332+44.34

HORZ.DATUM: NAD83 (2011)


GEOID: 2018

GRID: NORTHING: 582767.7

EASTING: 1615097

LDP: NORTHING: 404118.3

EASTING: 126798

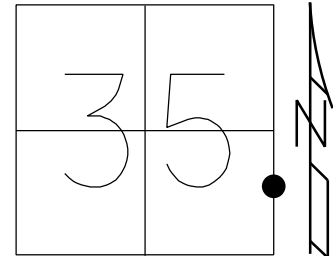

RECORD:
NOTE: NO PERMANET
REF TIES AVAILABLE
POINTS HELD- RESET
USING TEMPORAY HUBS 2003

FD MAG/WASHER
11-3-03, DCH


FD MAG NAIL
GPS, REF16
10-22-14

GPS, REFA14
8-27-15

ALL TIES DESTROYED
SET MAG/WASHER
W/COORDINATES
GPS, NEWREFA14
9-6-16, JFO

FD MAG/WASHER
REF14A
8-21-24,TDN

FD MAG/WASHER
9-18-24,TDN

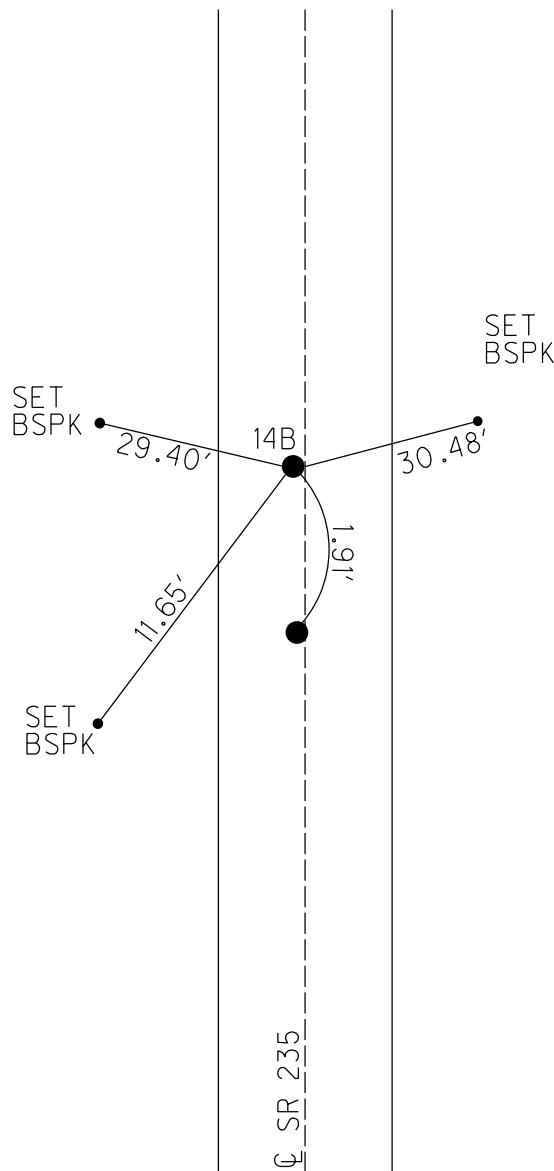

O.D.O.T. DISTRICT 2 SURVEY OFFICE (USE ONLY)

PERSONNEL

REFERENCE NO. 15

SHEET 15 OF 26

NOTES ASTON
H.C. NIESE
R.C. PRESTON-COLVIN

DATE 8-21-24
WEATHER BREEZY
TEMP. 65°

ROUTE SR 235
COUNTY WOOD
TOWNSHIP MILTON
SECTION 35
T 4 N R 9 E

DWG BY PRESTON-COLVIN PID CHIPSEAL

TYPE MONUMENT MONBOX W/1" IPIN

ON SURFACE - ~~BELOW~~ ON

OFFSET Q PAVEMENT ON LT : RT
8.8' TO RT EDGE PAVEMENT

STATION: 345+69.12

HORIZ.DATUM: NAD83 (2011)


GEOID: 2018

GRID: NORTHING: 584092.4

EASTING: 1615098

LDP: NORTHING: 405443

EASTING: 126781.3

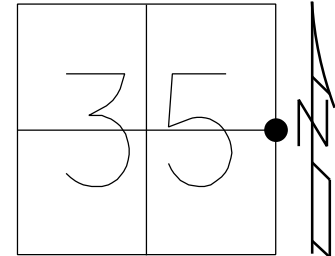

RECORD:
SET MAG & WASHER
11-3-03, DCH

GPS, REF15
8-27-15.

SET MAG/WASHER
GPS, NEWREF15
7-28-16, DCH

FD MONBOX
W/1" IPIN
REF15
8-21-24, TDN


FD MONBOX
9-18-24, TDN

FD "X" ON
COR. CBS

FD SHI
NE/S

FD BARN SPIKES
3" BELOW SURFACE

FIELD DRIVE

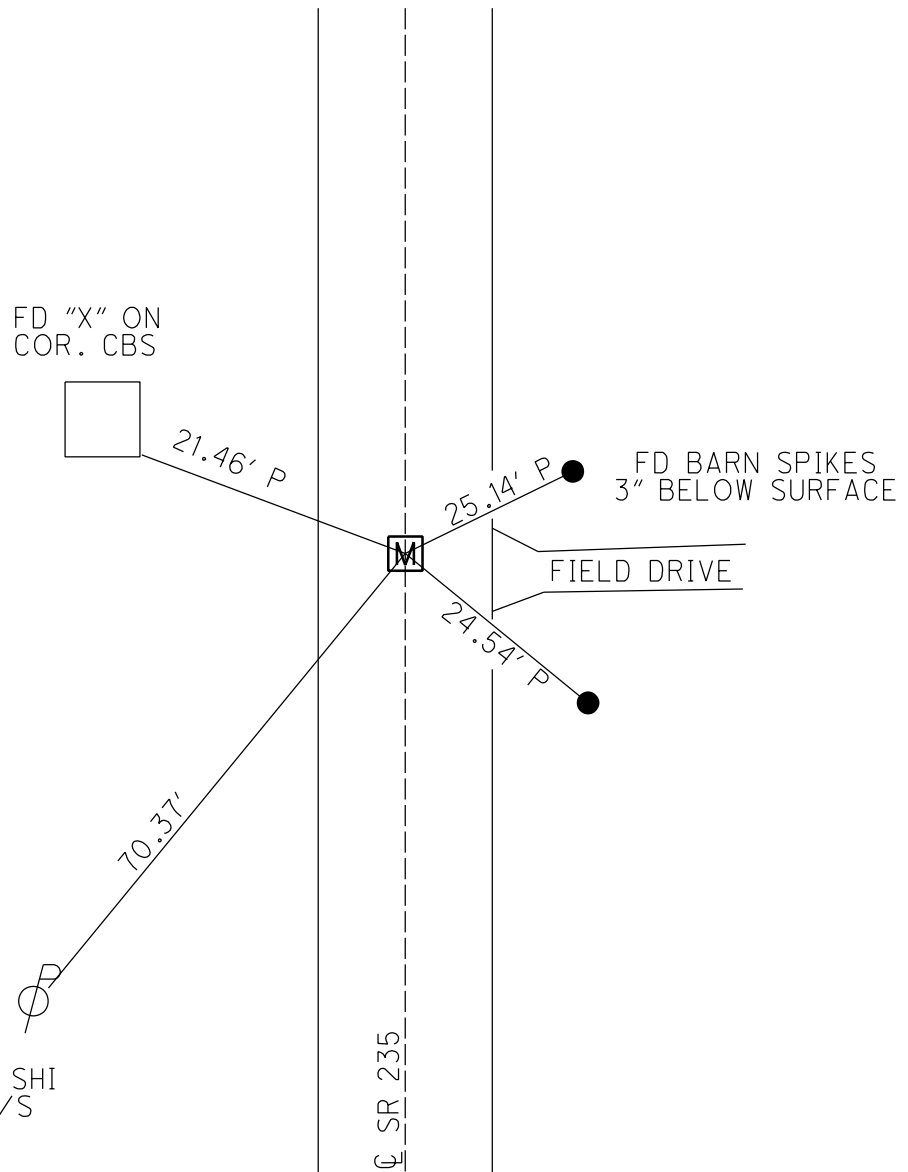

O.D.O.T. DISTRICT 2 SURVEY OFFICE (USE ONLY)

PERSONNEL

REFERENCE NO. 16

SHEET 16 OF 26

NOTES ASTON
H.C. NIESE
R.C. PRESTON-COLVIN

DATE 8-21-24
WEATHER BREEZY
TEMP. 70°

ROUTE SR 235
COUNTY WOOD
TOWNSHIP MILTON
SECTION 35
T 4 N R 9 E

DWG BY PRESTON-COLVIN PID CHIPSEAL

TYPE MONUMENT MAG/WASHER

ON SURFACE - ~~BELOW~~ ON

OFFSET Q PAVEMENT 3' LT : RT

8.1' TO RT EDGE PAVEMENT

STATION: 372+43.52

HORIZ.DATUM: NAD83 (2011)


GEOID: 2018

GRID: NORTHING: 586766.8


EASTING: 1615086

LDP: NORTHING: 408117.3

EASTING: 126734.2

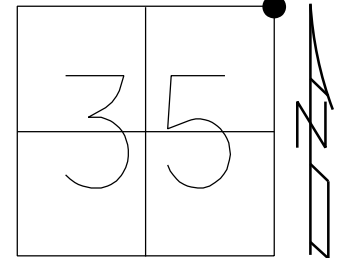

RECORD:
SET MAG/WASHER
10-10-03, DCH
FD MAG/SHANK
REF19
10-23-14
REF16
8-26-15
SET MAG/WASHER
NEWREF16
7-28-16, DCH
FD MAG/WASHER
REF16
4-29-22, DSA
FD MAG/WASHER
REF16
8-21-24, TDN
FD MAG/WASHER
9-18-21, TDN

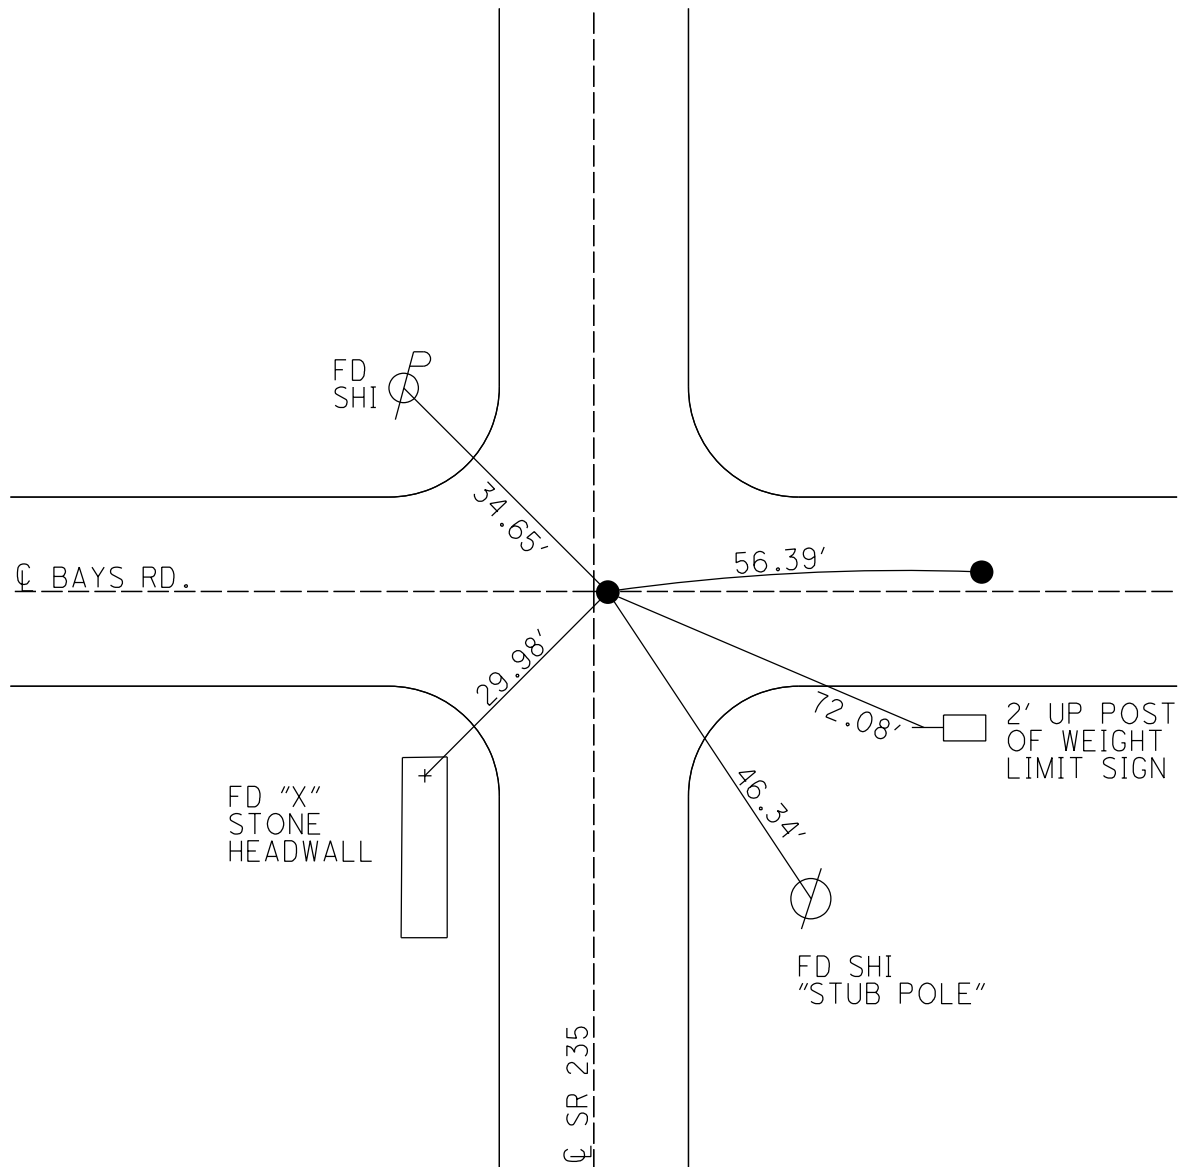

O.D.O.T. DISTRICT 2 SURVEY OFFICE (USE ONLY)

PERSONNEL

REFERENCE NO. 17

SHEET 17 OF 26

NOTES ASTON
H.C. NIESE
R.C. PRESTON-COLVIN

DATE 8-21-24
WEATHER BREEZY
TEMP. 70°

ROUTE SR 235
COUNTY WOOD
TOWNSHIP MILTON
SECTION 26
T 4 N R 9 E

DWG BY PRESTON-COLVIN PID CHIPSEAL

TYPE MONUMENT MAG/WASHER

ON SURFACE - ~~BELOW~~ ON

OFFSET Q PAVEMENT 7.6' ~~LT~~ : RT

1.7' TO RT EDGE PAVEMENT

STATION: 398+95.74

HORIZ.DATUM: NAD83 (2011)


GEOID: 2018

GRID: NORTHING: 589419


EASTING: 1615083

LDP: NORTHING: 410769.4

EASTING: 126696.3

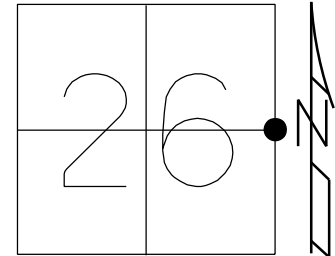

RECORD
SET MAG/WASHER
10-10-03, DCH
FD R.R.SPIKE
REF20
10-22-14
REF17
8-26-15
SET MAG/WASHER
NEWREF17
7-28-16, DCH
FD MAG/WASHER
REF17
4-29-22, DSA
FD MAG/WASHER
REF17
8-21-24, TDN
FD MAG/WASHER
9-18-24, TDN

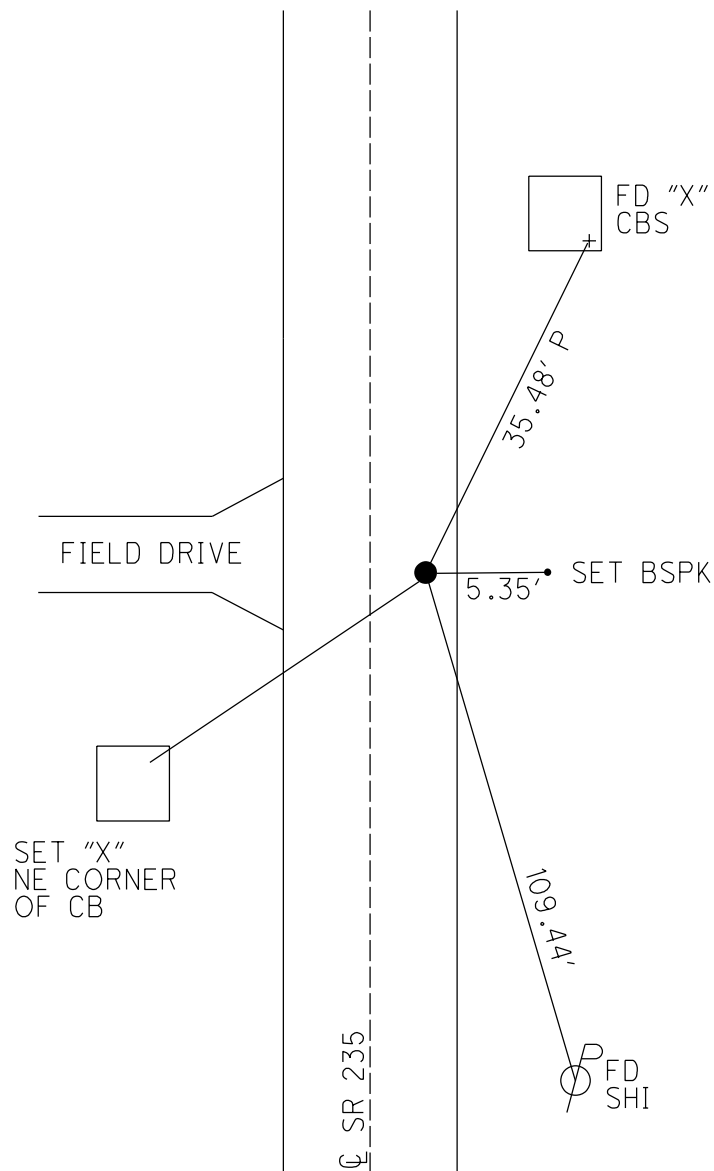

O.D.O.T. DISTRICT 2 SURVEY OFFICE (USE ONLY)

PERSONNEL

REFERENCE NO. 18

SHEET 18 OF 26

NOTES ASTON
H.C. NIESE
R.C. PRESTON-COLVIN

DATE 8-21-24
WEATHER BREEZY
TEMP. 70°

ROUTE SR 235
COUNTY WOOD
TOWNSHIP MILTON
SECTION 26
T 4 N R 9 E

DWG BY PRESTON-COLVIN PID CHIPSEAL

TYPE MONUMENT MAG/WASHER

ON SURFACE - ~~BELOW~~ ON

OFFSET Q PAVEMENT 11.4' ~~LT~~ : RT

2.2' TO RT EDGE PAVEMENT

STATION: 425+47.72

HORIZ.DATUM: NAD83 (2011)


GEOID: 2018

GRID: NORTHING: 592070.9


EASTING: 1615081

LDP: NORTHING: 413421.3

EASTING: 126658.9

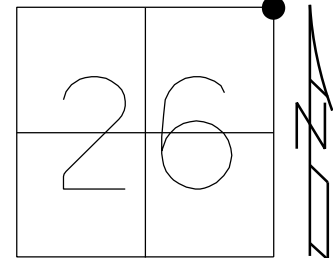

RECORD: P.O.T.
FD R.R.SPIKE
1 1/2" DOWN
5/1/79
8/24/81
SET P.K./WASHER
10-7-96, BVD
FD NAIL/SHINER
5/6/04, RGN
SET P.K./WASHER
5/6/04, RGN
FD R.R.SPIKE
7/2/12, DCH
FD MINE SPIKE
10-23-14
8-26-15
SET MAG/WASHER
7-28-16, DCH
FD MAG/WASHER
5/14/18, JLL
FD MAG/WASHER
6/24/19
10/4/21, DSA
FD MAG/WASHER
4-29-22, DSA
FD MAG/WASHER
REF18
8-21-24, TDN
FD MAG/WASHER
9-18-24, TDN

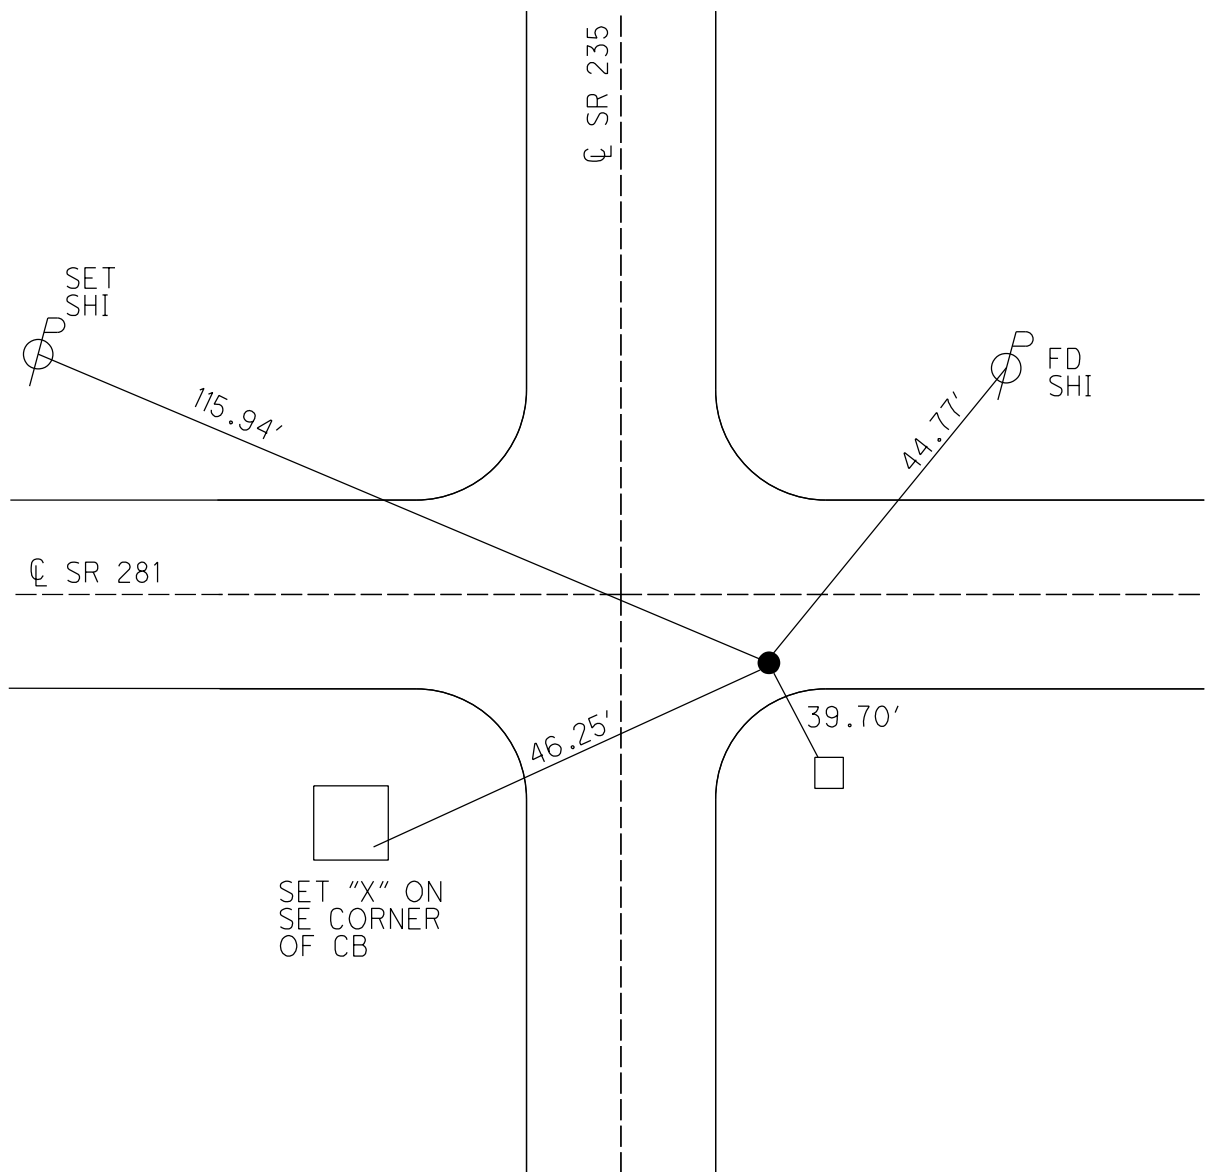

O.D.O.T. DISTRICT 2 SURVEY OFFICE (USE ONLY)

PERSONNEL

REFERENCE NO.

18 A

SHEET

19

OF 26

NOTES

HOMAN

DATE

9-25-03

ROUTE

SR 235

H.C.

NUHFER

WEATHER

SUNNY

COUNTY

WOOD

R.C.

BALLMER

TEMP.

60°F

TOWNSHIP

MILTON

SECTION

23

T 4 N

R 9 E

TYPE MONUMENT

STONE

~~ON SURFACE~~ - BELOW

6"

~~LEFT~~ - Q PAV'T - RIGHT


16'

7' RT TO RT EDGE PAVEMENT

S.L.M. 437+75

Grid: Northing: -

Easting: -

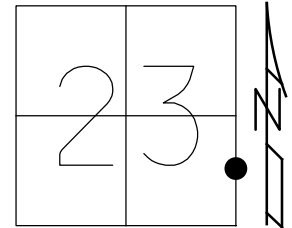

RECORD:

FD STONE

7/30/96, VD


6" DOWN

9/25/03, DCH

DNF STONE

5/22/03, DCH

10/23/14

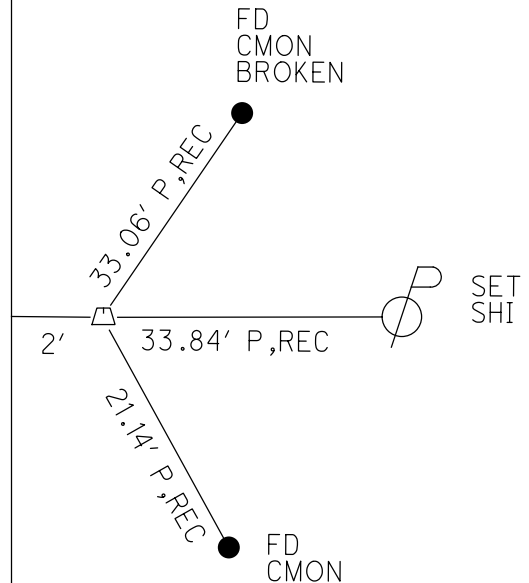

Q SR 235

O.D.O.T. DISTRICT 2 SURVEY OFFICE (USE ONLY)

PERSONNEL _____ REFERENCE NO. 19 SHEET 20 OF 26
NOTES LEU DATE 7/2/18 ROUTE SR 235
H.C. LEU WEATHER PTLY CLOUDY COUNTY WOOD
R.C. HAGEMEYER TEMP. 83° TOWNSHIP MILTON
SECTION 23
T 4 N R 9 E

TYPE MONUMENT 3/4" IPID W/ODOT ALUM.CAP


ON SURFACE - ~~BELOW~~ ON

~~LEFT~~ - Q PAV'T - RIGHT 11.9'


1.4' RT TO RT EDGE PAVEMENT

S.L.M. 451+08

Grid: Northing: 594776.429 Easting: 1615248.828

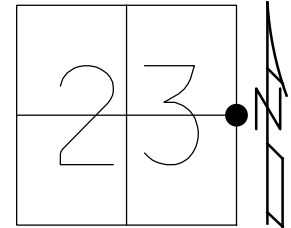

RECORD:
FD IPIPE BENT
SET 3/4" IPIN
7-9-98
D.N.F.
5-22-03
FD IPIPE
9-25-03, DCH
D.N.F.
10-23-14
8-26-15
7-28-16
SET IPID
W/ODOT ALUM.CAP
REF19
7/2/18, JLL

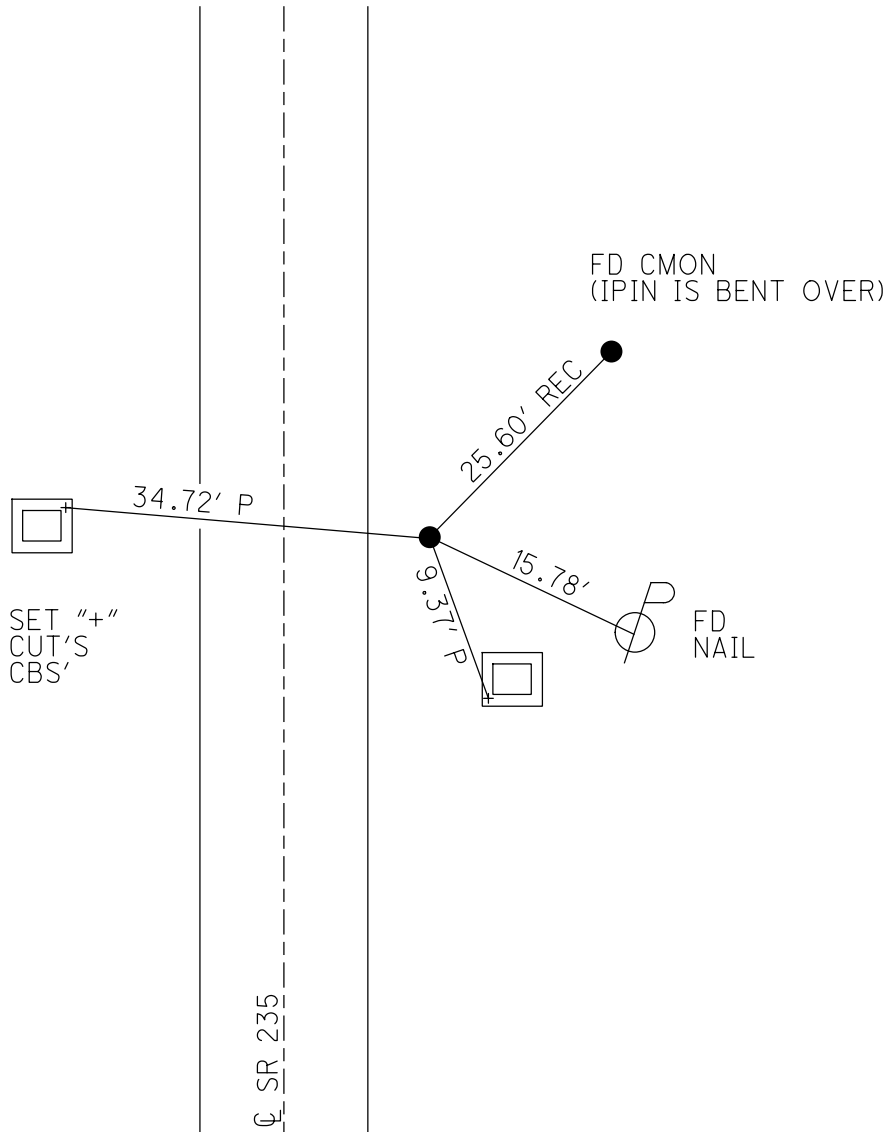

O.D.O.T. DISTRICT 2 SURVEY OFFICE (USE ONLY)

PERSONNEL

REFERENCE NO.

19 A

SHEET

21

OF 26

NOTES

HOMAN

DATE

9-25-03

ROUTE

SR 235

H.C.

NUHFER

WEATHER

SUNNY

COUNTY

WOOD

R.C.

BALLMER

TEMP.

60°F

TOWNSHIP

MILTON

SECTION

23

T 4 N

R 9 E

TYPE MONUMENT

STONE

~~ON SURFACE~~

- BELOW

6"

~~LEFT - C~~

Q

PAV'T - RIGHT

18'

9.5' RT TO RT

EDGE PAVEMENT

S.L.M.


458+68.82

Grid: Northing:

595391.650

Easting:

1615134.220

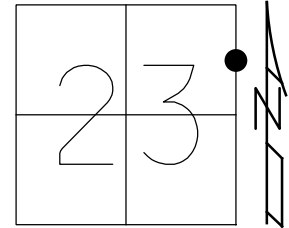

RECORD:

STONE BROKEN

5-22-03

6" DOWN

9-25-03, DCH

FD STONE

SIDE OF DITCH

BANK 6" DOWN

REF22

10-23-14, EBW

DNF


8-26-15

7-28-16, DCH

FD STONE

REFA19

5/14/18, JLL

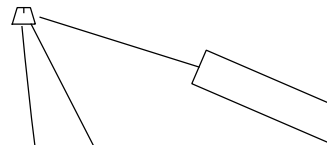

TOP CTR
12" STEEL
DRAIN TILE
8.74' D, REC



TOP CTR. CMP
DRIVE PIPE
12.60' D, REC



FD SHI
70.42'
P, REC

Q SR 235

O.D.O.T. DISTRICT 2 SURVEY OFFICE (USE ONLY)

PERSONNEL _____ REFERENCE NO. 19 B SHEET 22 OF 26
NOTES HOMAN DATE 9-25-03 ROUTE SR 235
H.C. NUHFER WEATHER SUNNY COUNTY WOOD
R.C. BALLMER TEMP. 60°F TOWNSHIP MILTON

SECTION 23
T 4 N R 9 E

TYPE MONUMENT STONE


ON SURFACE - ~~BELOW~~ ON

~~LEFT~~ - Q PAV'T - RIGHT 18.9'


9.5' TO RT EDGE PAVEMENT

S.L.M. 465+33.85

Grid: Northing: 596056.530 Easting: 1615149.770

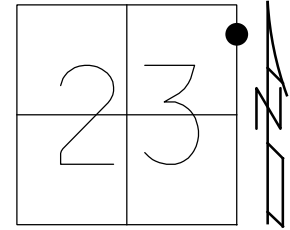

RECORD:
FD STONE
9-25-03
FD STONE
W/DRILLH
REF23
10-23-14, EBW
8-26-15
7-28-16, DCH
9/21/17, JFO
REFB19
5/14/18, JLL

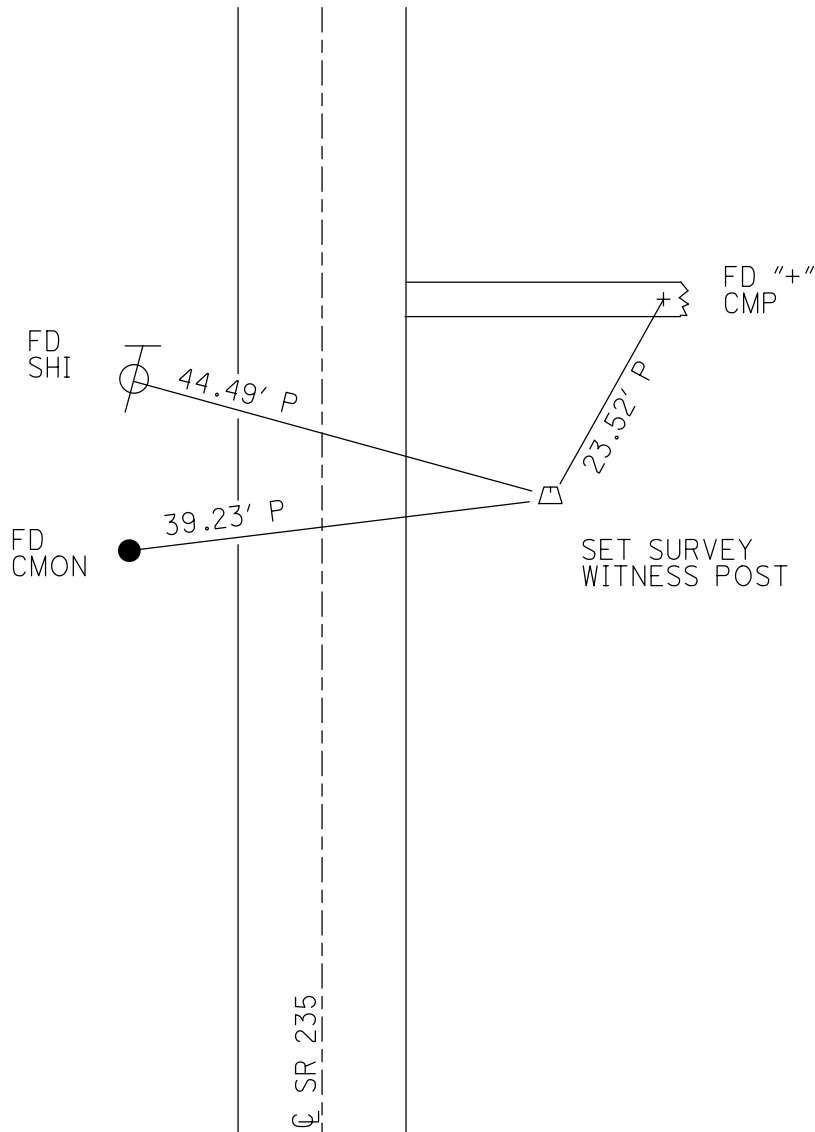

O.D.O.T. DISTRICT 2 SURVEY OFFICE (USE ONLY)

PERSONNEL

REFERENCE NO. 20

SHEET 23 OF 26

NOTES NIESE
H.C. PRESTON-COLVIN
R.C. BLUNAUGH
BARRIERE

DATE 8-23-24
WEATHER CLEAR
TEMP. 60°F

ROUTE SR 235
COUNTY WOOD
TOWNSHIP MILTON
SECTION 23
T 4 N R 9 E

DWG BY PRESTON-COLVIN PID CHIPSEAL

TYPE MONUMENT MAG SPIKE

ON SURFACE - ~~BELOW~~ ON

OFFSET CL PAVEMENT 11.9' ~~LT~~ : RT

3.0' TO RT EDGE PAVEMENT

STATION: 478+63.62

HORIZ.DATUM: NAD83 (2011)


GEOID: 2018

GRID: NORTHING: 597385.9


EASTING: 1615179

LDP: NORTHING: 418737.5

EASTING: 126678.3

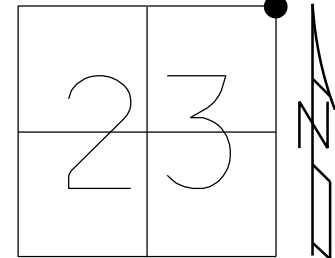

RECORD:
SET SM.R.R.SPIKE
6-27-86, MDB
SET P.K./WASHER
10-7-96, BVD
FD P.K./WASHER
2003
FD R.R.SPIKE
1" DOWN
REF24
10-23-14, EBW
FD P.K./WASHER
REF20
8-26-15, JFO
SET MAG/WASHER
NEWREF20
7-28-16, DCH
REF20
9/21/17, JFO
5/11/18, JFO
FR MAG SPIKE
REF20
8-23-24, TDN
FD MAG SPIKE
9-18-24, TDN

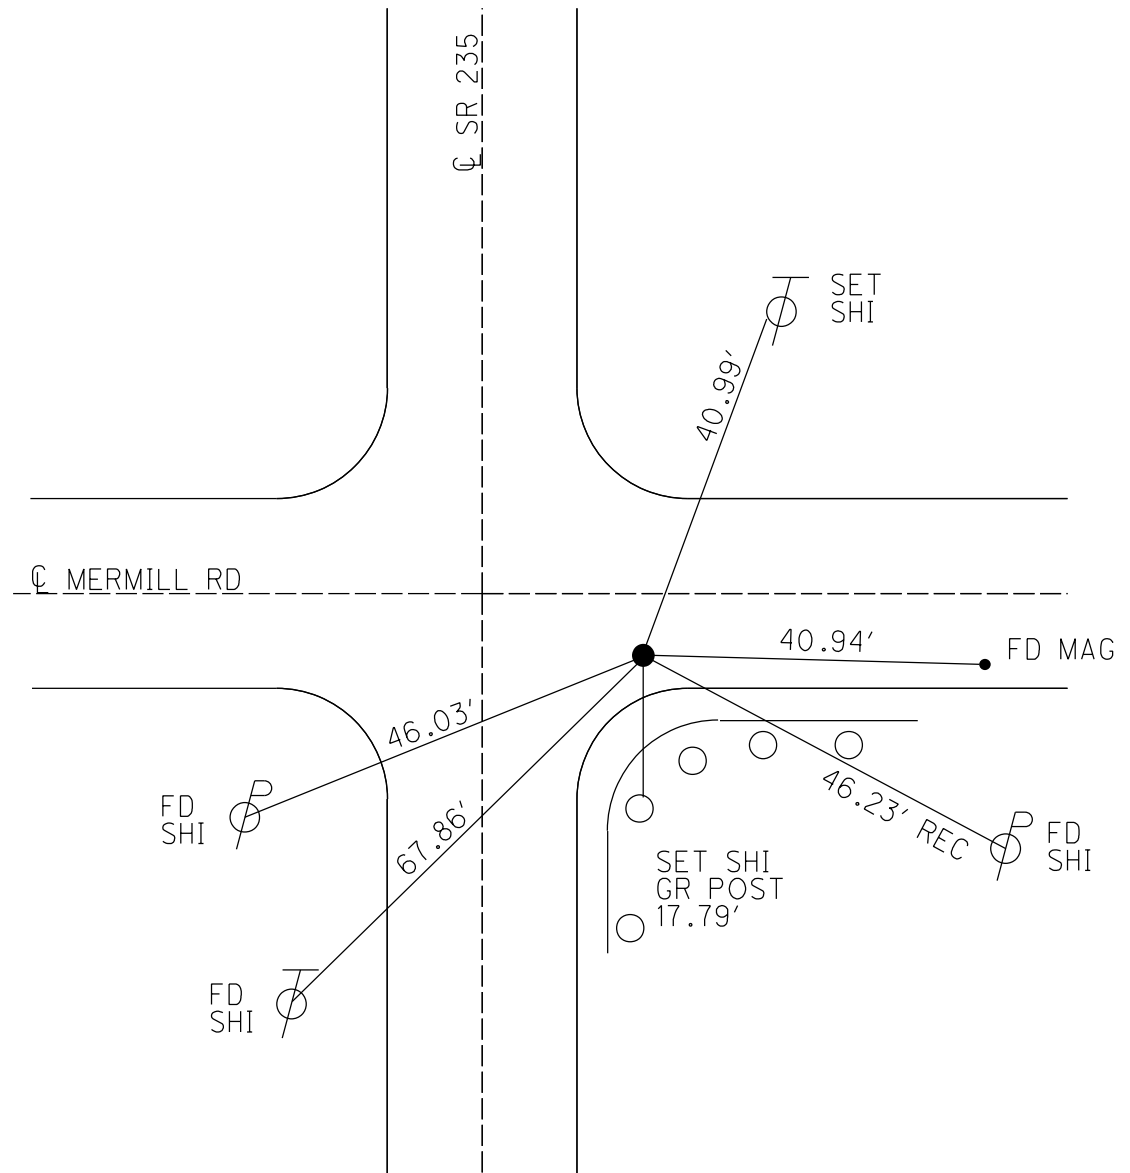

O.D.O.T. DISTRICT 2 SURVEY OFFICE (USE ONLY)

PERSONNEL

REFERENCE NO. 21

SHEET 24 OF 26

NOTES NIESE

DATE 8-23-24

ROUTE SR 235

H.C. PRESTON-COLVIN

WEATHER CLEAR

COUNTY WOOD

R.C. BLUNAUGH

TEMP. 60°F

TOWNSHIP MILTON

BARRIERE

SECTION 14

DWG BY PRESTON-COLVIN

PID CHIPSEAL

T 4 N R 9 E

TYPE MONUMENT MAG/WASHER

ON SURFACE - ~~BELOW~~ ON

OFFSET 6.4' TO RT EDGE PAVEMENT

STATION: 505+18.83

HORZ.DATUM: NAD83 (2011)


GEOID: 2018

GRID: NORTHING: 600040.8

EASTING: 1615218

LDP: NORTHING: 421392.9

EASTING: 126690.4

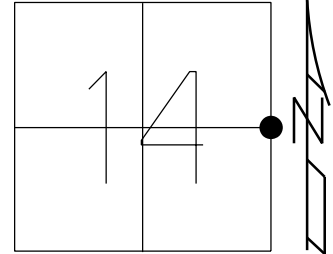

RECORD:
SET SM RR SPK
6-27-86, MDB

SET MAG/WASHER
10-10-03, DCH

FD MAG
GPS, REF25
10-23-14

GPS, REF21
8-26-15

FD MAG/WASHER
REF 21
8-23-24, TDN

FD MAG/WASHER
9-18-24, TDN

FD R/W MON
MEAS. @ BENT
(WESTERLY)
REC

FD SHI P
37.56'

28.78'

15.65'

SET
B.S

25.69'

FD BARN SPIKE
6' OFF EP

RES#10425

SR 235

O.D.O.T. DISTRICT 2 SURVEY OFFICE (USE ONLY)

PERSONNEL

REFERENCE NO. 22

SHEET 25 OF 26

NOTES NIESE
H.C. PRESTON-COLVIN
R.C. BLUNAUGH
BARRIERE

DATE 8-23-24
WEATHER CLEAR
TEMP. 60°F

ROUTE SR 235
COUNTY WOOD
TOWNSHIP MILTON
SECTION 14
T 4 N R 9 E

DWG BY PRESTON-COLVIN PID CHIPSEAL

TYPE MONUMENT MONBOX

ON SURFACE - ~~BELOW~~ ON

OFFSET Q PAVEMENT 0.5" ~~LT~~ : RT

8.1' TO RT EDGE PAVEMENT

STATION: 531+78.20

HORIZ.DATUM: NAD83 (2011)


GEOID: 2018

GRID: NORTHING: 602699.9

EASTING: 1615258

LDP: NORTHING: 424052.6

EASTING: 126696.2

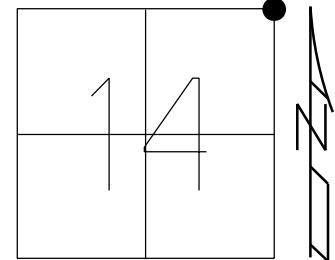

RECORD:
SET SM RR SPK
6-27-86, MDB

SET MAG/WASHER
10-10-03, DCH


NOT COVERED
08-05-04, MCB

FD MON BOX
IPIN INSIDE
10-23-14

GPS, REF22
8-26-15

FD MONBOX
W/ 5/8" IPIN
8-23-27.TDN

FD MONBOX
9-18-24,TDN

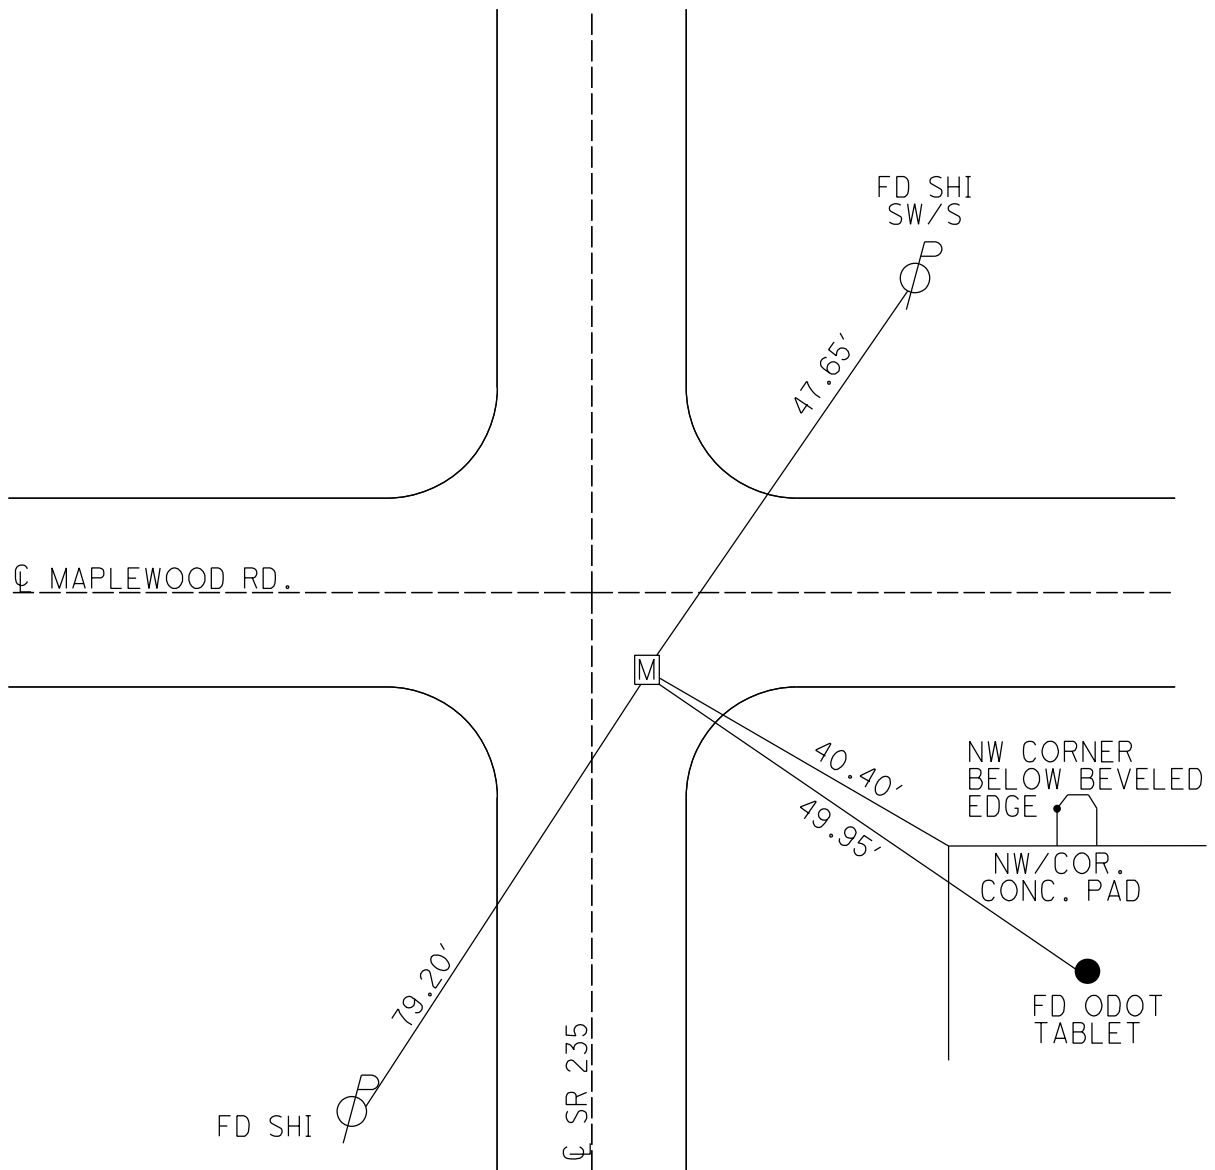

O.D.O.T. DISTRICT 2 SURVEY OFFICE (USE ONLY)

PERSONNEL

REFERENCE NO. 24

SHEET 26 OF 26

NOTES RHOADES

DATE 8/11/17

ROUTE SR 235

H.C. O'DONNELL

WEATHER CLOUDY

COUNTY WOOD

R.C. RHOADES

TEMP. 67°

TOWNSHIP MILTONDWG BY RHOADESPID PAVETRAIN

T_4_N R_9_E

TYPE MONUMENT MAG/WASHER

ON SURFACE - ~~BELOW~~ ON _____

OFFSET C PAVEMENT 3' LT : RT


6.9' TO LT EDGE PAVEMENT

STATION: 585+05.63

HORZ.DATUM: NAD83 2011

GEOID: NAVD88 2018

GRID: NORTHING: 608027.079

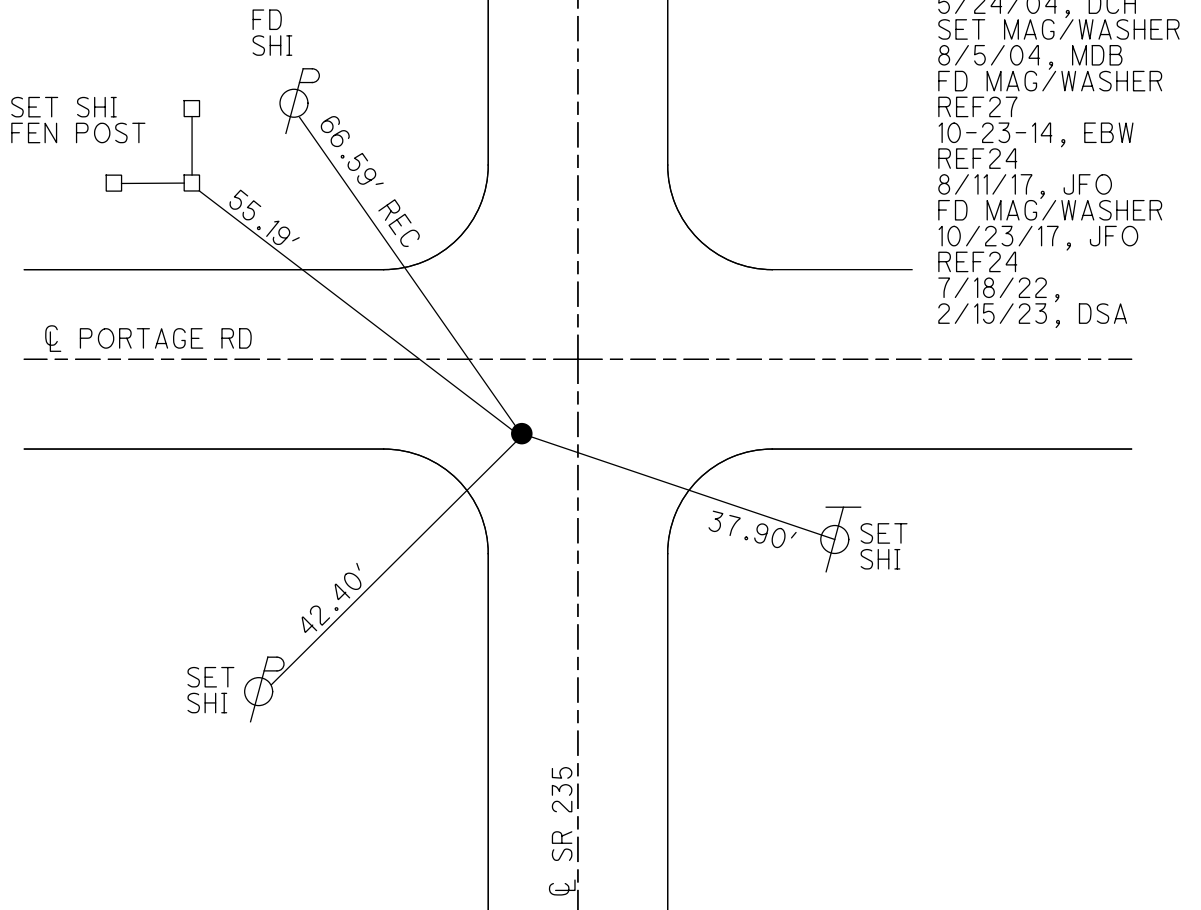EASTING: 1615309.113

RECORD:
SET SM.R.R.SPIKE
6-27-86, MDB
SET P.K./WASHER
10-7-96, BVD
FD SM.R.R.SPIKE
5/24/04, DCH
SET MAG/WASHER
8/5/04, MDB
FD MAG/WASHER
REF27
10-23-14, EBW
REF24
8/11/17, JFO
FD MAG/WASHER
10/23/17, JFO
REF24
7/18/22,
2/15/23, DSA

O.D.O.T. DISTRICT 2 SURVEY OFFICE (USE ONLY)

PERSONNEL

REFERENCE NO. 25

SHEET 1 OF 23

NOTES RHOADES

DATE 8/11/17

ROUTE SR 235

H.C. O'DONNELL

WEATHER CLOUDY

COUNTY WOOD

R.C. RHOADES

TEMP. 67°

TOWNSHIP MILTONDWG BY RHOADESPID PAVETRAIN

T 4 N R 9 F

TYPE MONUMENT MAG/WASHER

ON SURFACE - ~~BELOW~~ ON _____

OFFSET C PAVEMENT 4.2' ~~LT~~ : RT


5.5' TO RT EDGE PAVEMENT

STATION: 611+57.26


HORZ.DATUM: NAD83 2011

GEOID: NAVD88 2018

GRID: NORTHING: 610678.526

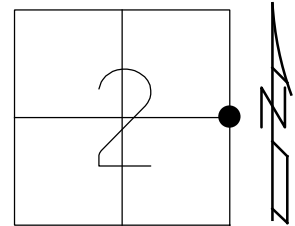EASTING: 1615346.831

RECORD:
SET SM.R.R.SPIKE
7-8-86, MDB
SET P.K./WASHER
10-8-96, BVD
FD P.K./WASHER
5/28/04, RGN
SET PK/WASHER
8/5/04, MDB
FD MAG NAIL
REF28
10-23-14, EBW
9-7-16, JFO
FD MAG/WASHER
REF25
8/11/17, JFO
10/23/17, JFO
FD MAG/WASHER
REF25
7/18/22,
2/15/23, DSA

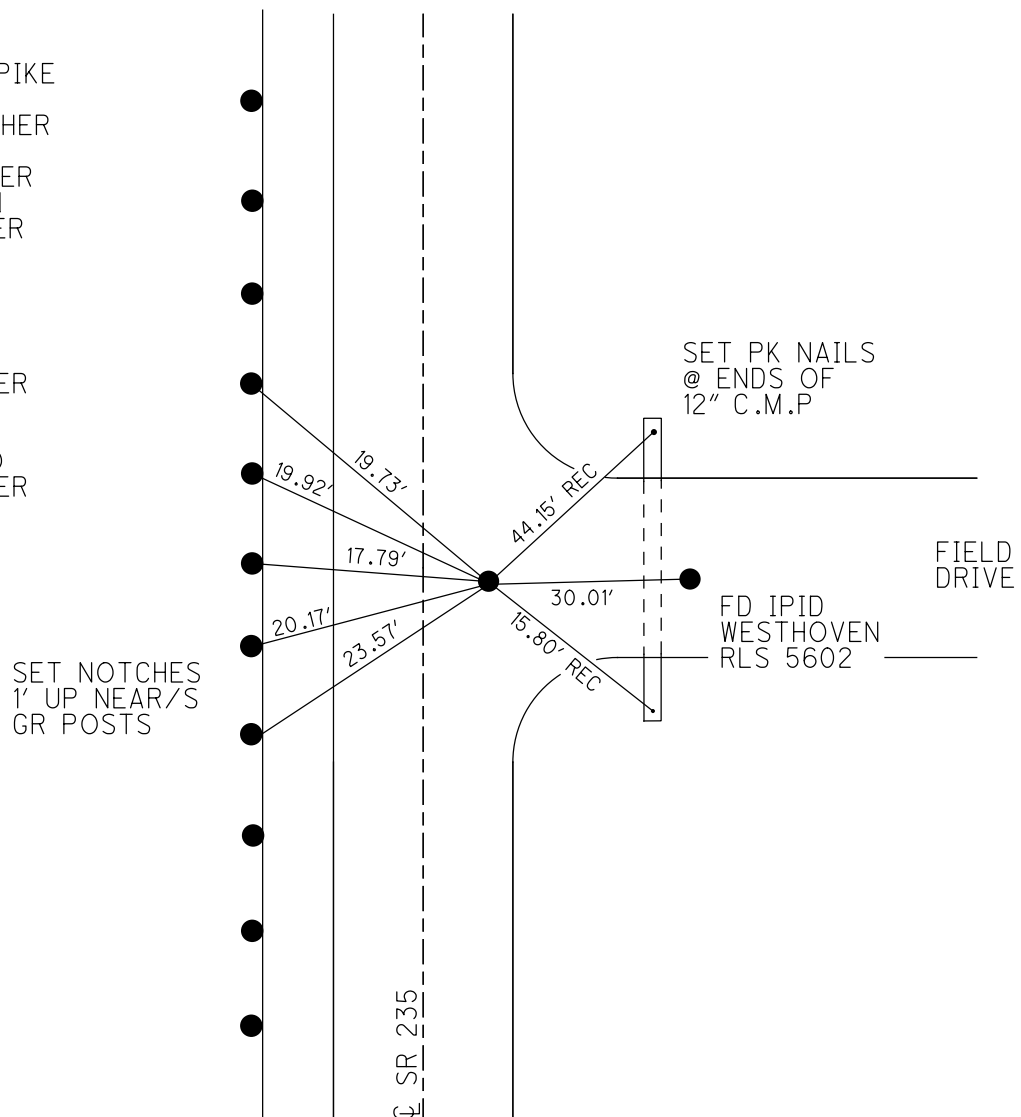

O.D.O.T. DISTRICT 2 SURVEY OFFICE (USE ONLY)

PERSONNEL

REFERENCE NO. 26

SHEET 2 OF 23

NOTES RHOADES

DATE 8/11/17

ROUTE SR 235

H.C. O'DONNELL

WEATHER CLOUDY

COUNTY WOOD

R.C. RHOADES

TEMP. 67°

TOWNSHIP WESTON

SECTION 2

DWG BY RHOADES PID PAVETRAIN

T 5 N R 9 E

TYPE MONUMENT MAG/WASHER

ON SURFACE - ~~BELOW~~ ON

OFFSET CL PAVEMENT 4' ~~LT~~ : RT

5.2' TO RT EDGE PAVEMENT


STATION: 637+62

HORZ.DATUM: NAD83 2011


GEOID: NAVD88 2018

GRID: NORTHING: 613350.025

EASTING: 1615372.611

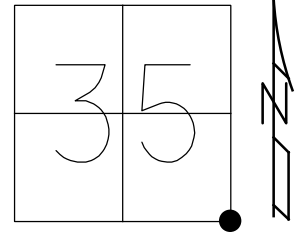

RECORD:
SET P.K./WASHER
10-8-96, SAH
FD P.K./WASHER
5/28/17, RGN
SET MAG/WASHER
8/5/04, MDB
FD MAG NAIL
REF29
10-23-14
FD MAG/WASHER
REF26
8/11/17, JFO
10/23/17, JFO
FD MAG/WASHER
REF26
7/18/22,
2/15/23, DSA

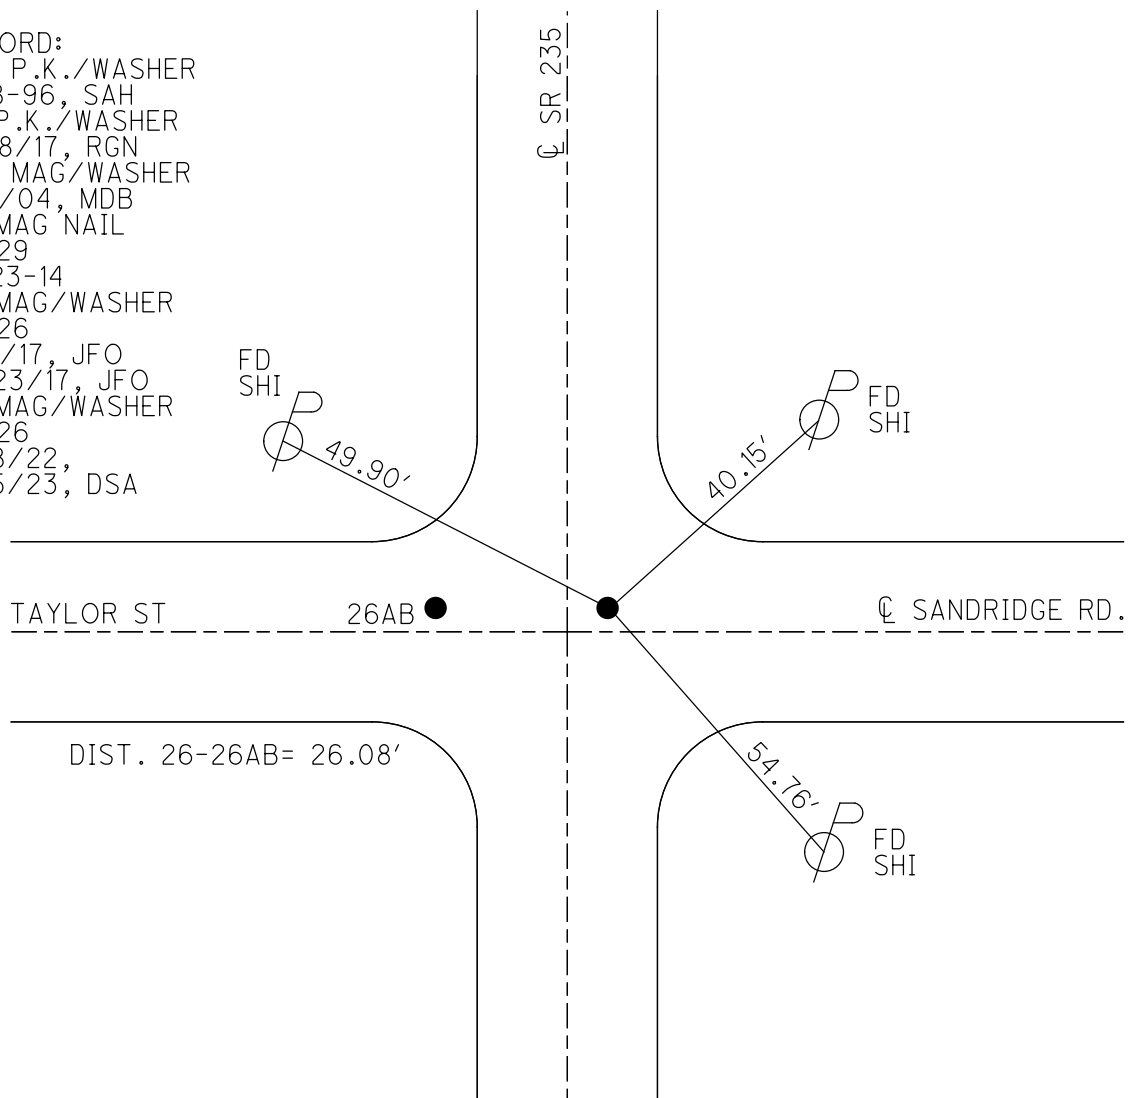

O.D.O.T. DISTRICT 2 SURVEY OFFICE (USE ONLY)

PERSONNEL

REFERENCE NO. 26 AB

SHEET 3 OF 23

NOTES RHOADES

DATE 8-14-23

ROUTE SR 235

H.C. AUBLE

WEATHER CLOUDY

COUNTY WOODR.C. NIESE

TEMP. 72°

TOWNSHIP WESTONSECTION 35

T_5_N R_9_E

DWG BY RHOADESPID PAVETRAIN

TYPE MONUMENT MAG/WASHER

ON SURFACE - ~~BELOW~~ _____ ON

OFFSET C PAVEMENT 22' LT : RT


12.9' LT TO LT EDGE PAVEMENT

STATION: 637+88

HORZ.DATUM: NAD83 2011

GEOID: NAVD88 2018

GRID: NORTHING: 613350.623

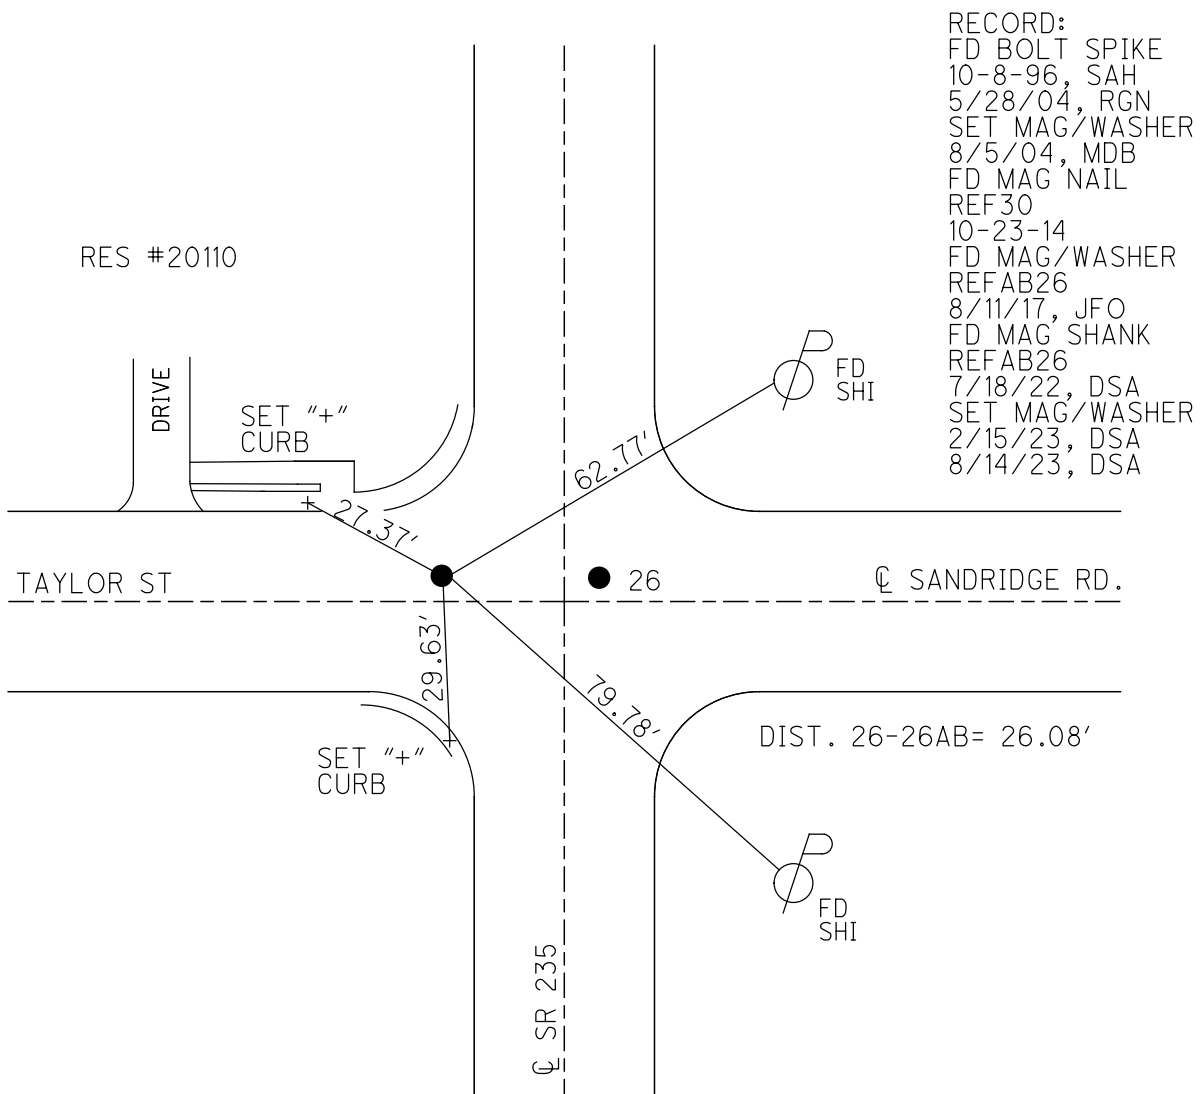EASTING: 1615346.564

O.D.O.T. DISTRICT 2 SURVEY OFFICE (USE ONLY)

PERSONNEL

REFERENCE NO. 26 A

SHEET 4 OF 23

NOTES RHOADES

DATE 8/11/17

ROUTE SR 235

H.C. O'DONNELL

WEATHER CLOUDY

COUNTY WOOD

R.C. RHOADES

TEMP. 71°

TOWNSHIP WESTON

DWG BY RHOADES PID PAVETRAIN

SECTION 35

T 5 N R 9 E

TYPE MONUMENT MAG/WASHER

ON SURFACE - ~~BELOW~~ ON

OFFSET Q PAVEMENT 19.2' LT : ~~RT~~

10' LT TO LT EDGE PAVEMENT



STATION: 651+59.52

HORIZ.DATUM: NAD83 2011

GEOID: NAVD88 2018

GRID: NORTHING: 614680.547

EASTING: 1615363.135

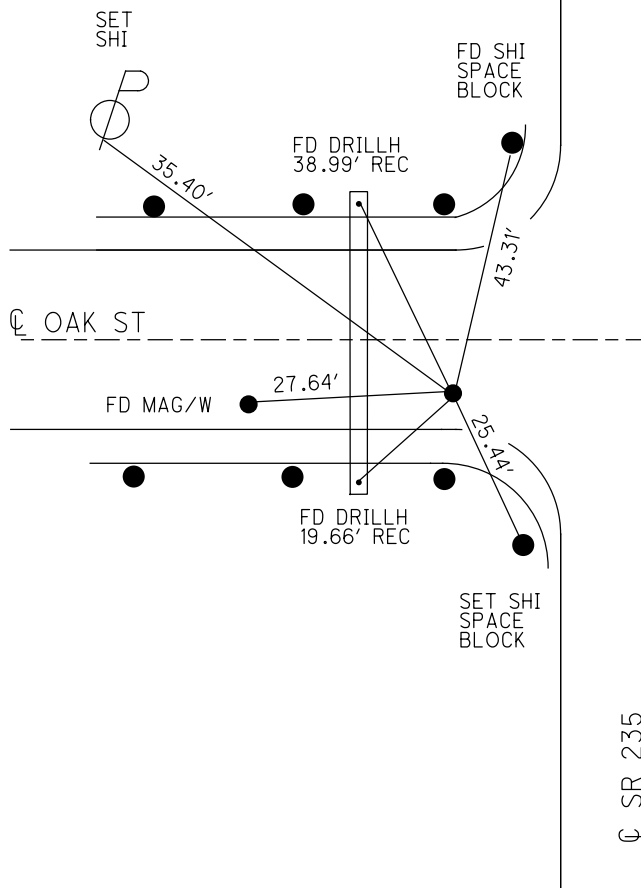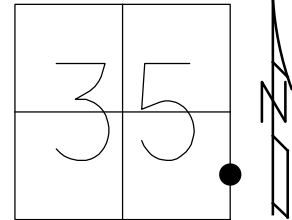

RECORD:
SET SM.R.R.SPIKE
7-8-86, MDB
SET PK/WASHER
10-8-96, SAH
FD P.K./WASHER
5/28/04, RGN
SET MAG/WASHER
08-05-04, MDB
FD MAG/WASHER
REF31
10-23-14
FD MAG/WASHER
REFA26
8/11/17, JFO
FD MAG SHANK
REFA26
7/18/22, DSA
SET MAG/WASHER
2/15/23, DSA

O.D.O.T. DISTRICT 2 SURVEY OFFICE (USE ONLY)

PERSONNEL

REFERENCE NO. 27

SHEET 5 OF 23

NOTES NUHFER

DATE 5/28/04

ROUTE SR 235

H.C. NUHFER

WEATHER CLOUDY

COUNTY WOOD

R.C. HOFFMAN

TEMP. 62°

TOWNSHIP WESTON

SECTION 35

DWG BY RHOADES PID

T 5 N R 9 E

TYPE MONUMENT 3/4" IPIN

ON SURFACE - ~~BELOW~~ ON


OFFSET CL PAVEMENT 20.5' LT : ~~RT~~

11.5' TO LT EDGE PAVEMENT

STATION: 664+27

HORIZ.DATUM: GEOID:

GRID: NORTHING: EASTING:

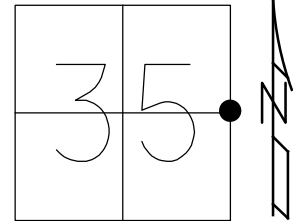

RECORD:
DID NOT FIND IRON PIN
POST ARE LEANING TO
BAD TO RESET
05-12-04, RGN

DNF
LOOKED FOR BUT
COULD NOT
LOCATE, FAIRLY NEW
RIP RAP IN AREA. COULD
HAVE BEEN DESTROYED
AND NEW G-RAIL
10-23-14

FD "X" TOP
W-END CMP
(REPLACES
WITH PLASTIC)

20.12'

40.72'

DNF CUT "X"
W/S CONC. MH

CL SR 235

O.D.O.T. DISTRICT 2 SURVEY OFFICE (USE ONLY)

PERSONNEL

REFERENCE NO. 28

SHEET 6 OF 23

NOTES RHOADES

DATE 8/11/17

ROUTE SR 235

H.C. O'DONNELL

WEATHER CLOUDY

COUNTY WOOD

R.C. RHOADES

TEMP. 71°

TOWNSHIP WESTON

SECTION 35

DWG BY RHOADES

PID PAVETRAIN

T 5 N R 9 E

TYPE MONUMENT LG.R.R.SPIKE

~~ON SURFACE~~ - BELOW 3"

OFFSET Q PAVEMENT 6.5' LT : ~~RT~~

2.7' TO LT EDGE PAVEMENT



STATION: 691+50.82

HORZ.DATUM: NAD83 2011

GEOID: NAVD88 2018

GRID: NORTHING: 618671.787

EASTING: 1615395.702

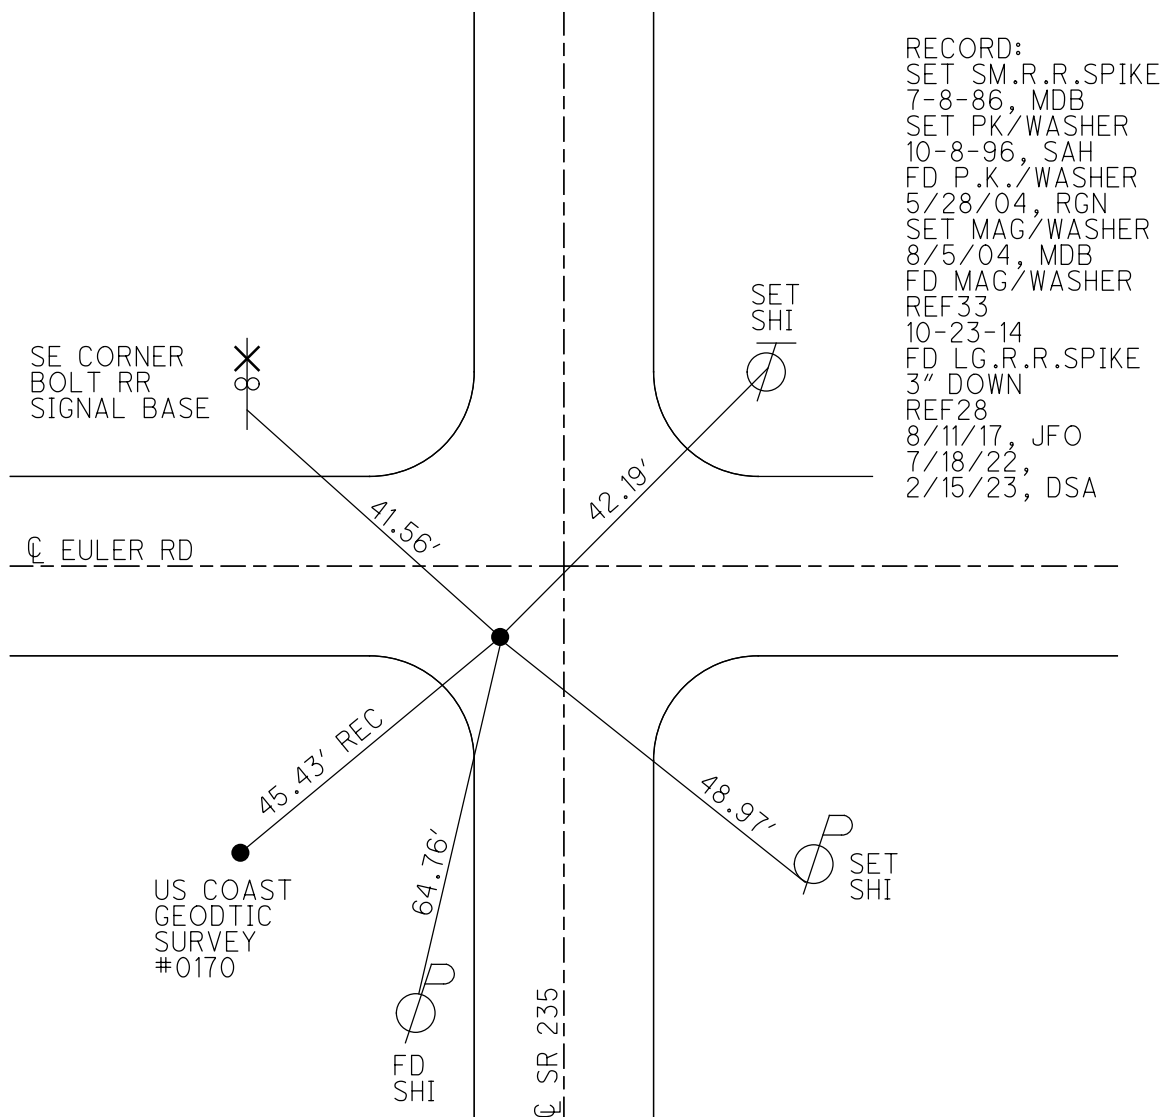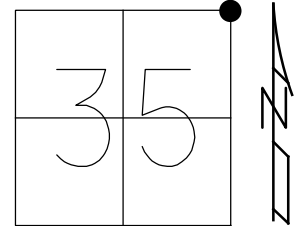

O.D.O.T. DISTRICT 2 SURVEY OFFICE (USE ONLY)

PERSONNEL	REFERENCE NO.	<u>29</u>	SHEET	<u>7</u>	OF	<u>7</u>
NOTES	<u>RHOADES</u>	DATE	<u>8-26-15</u>	ROUTE	<u>SR 235</u>	
H.C.	<u>O'DONNELL</u>	WEATHER	<u>CLOUDY</u>	COUNTY	<u>WOOD</u>	
R.C.	<u>RHOADES</u>	TEMP.	<u>65°F</u>	TOWNSHIP	<u>WESTON</u>	
				SECTION	<u>26</u>	
				T	<u>5</u>	N
				R	<u>9</u>	E

TYPE MONUMENT PK/WASHER


ON SURFACE - ~~BELOW~~ ON

~~LEFT~~ - CL PAV'T - RIGHT 0.4'

8.5' TO RT EDGE PAVEMENT

S.L.M. 717+88.49

Grid: Northing: 621309.439 Easting: 1615407.523

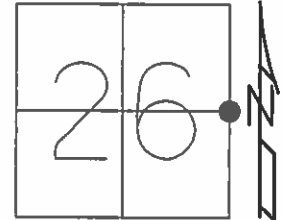


RECORD:
SET SM. RR SPIKE
7-8-86, MDB

SET PK/WASHER
10-8-96, SAH

CHIPPED OUT
08-05-04, MDB

FD PK/WASHER
GPS, REF34
10-23-14

SET MAG/WASHER
GPS, NEWREF29
9-8-16, JFO

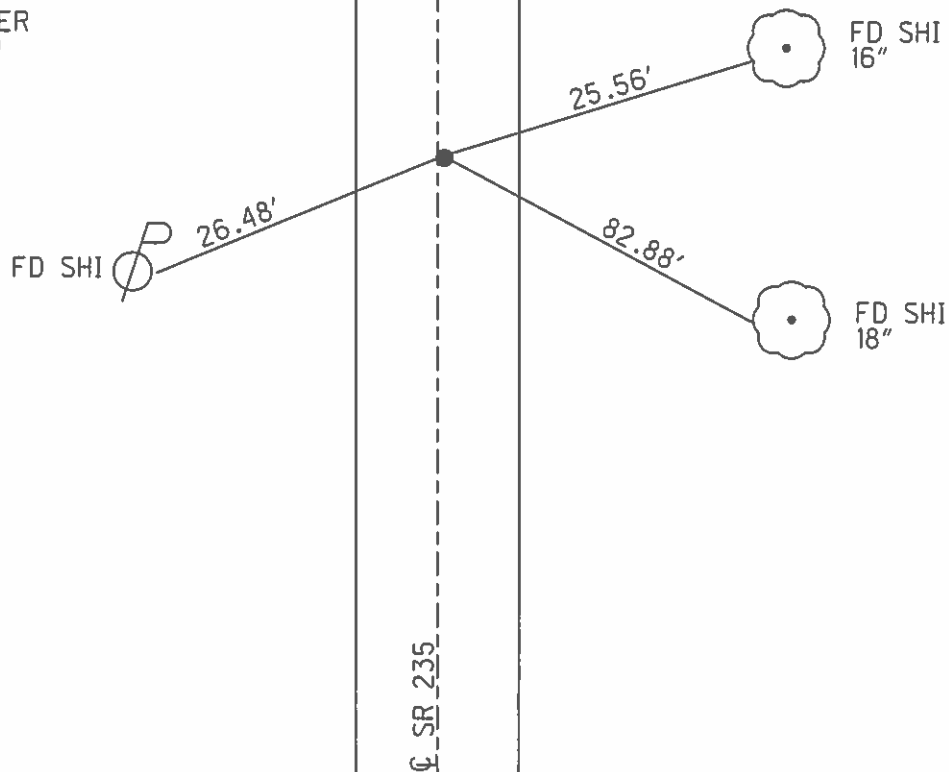

O.D.O.T. DISTRICT 2 SURVEY OFFICE (USE ONLY)

PERSONNEL

REFERENCE NO. 30

SHEET 1 OF 16

NOTES LEU
H.C. HOMAN
R.C. KEFFER

DATE 7-13-2016
WEATHER SUNNY
TEMP. 76°

ROUTE SR 235
COUNTY WOOD
TOWNSHIP WESTON
SECTION 25
T 5 N R 9 E

DWG BY AUBLE PID 85271

TYPE MONUMENT PK/WASHER

ON SURFACE - ~~BELOW~~ ON

OFFSET CL PAVEMENT 0.5' ~~LT~~ : RT
- TO - EDGE PAVEMENT


STATION: 744+41.03

HORIZ.DATUM: NAD83(2011)


GEOID: NAVD88 2012A

GRID: NORTHING: 623961.810

EASTING: 1615438.604

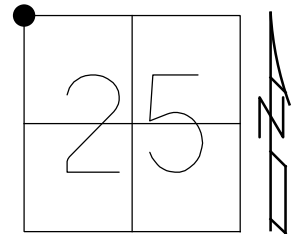

NOTE: REF 11 US 6

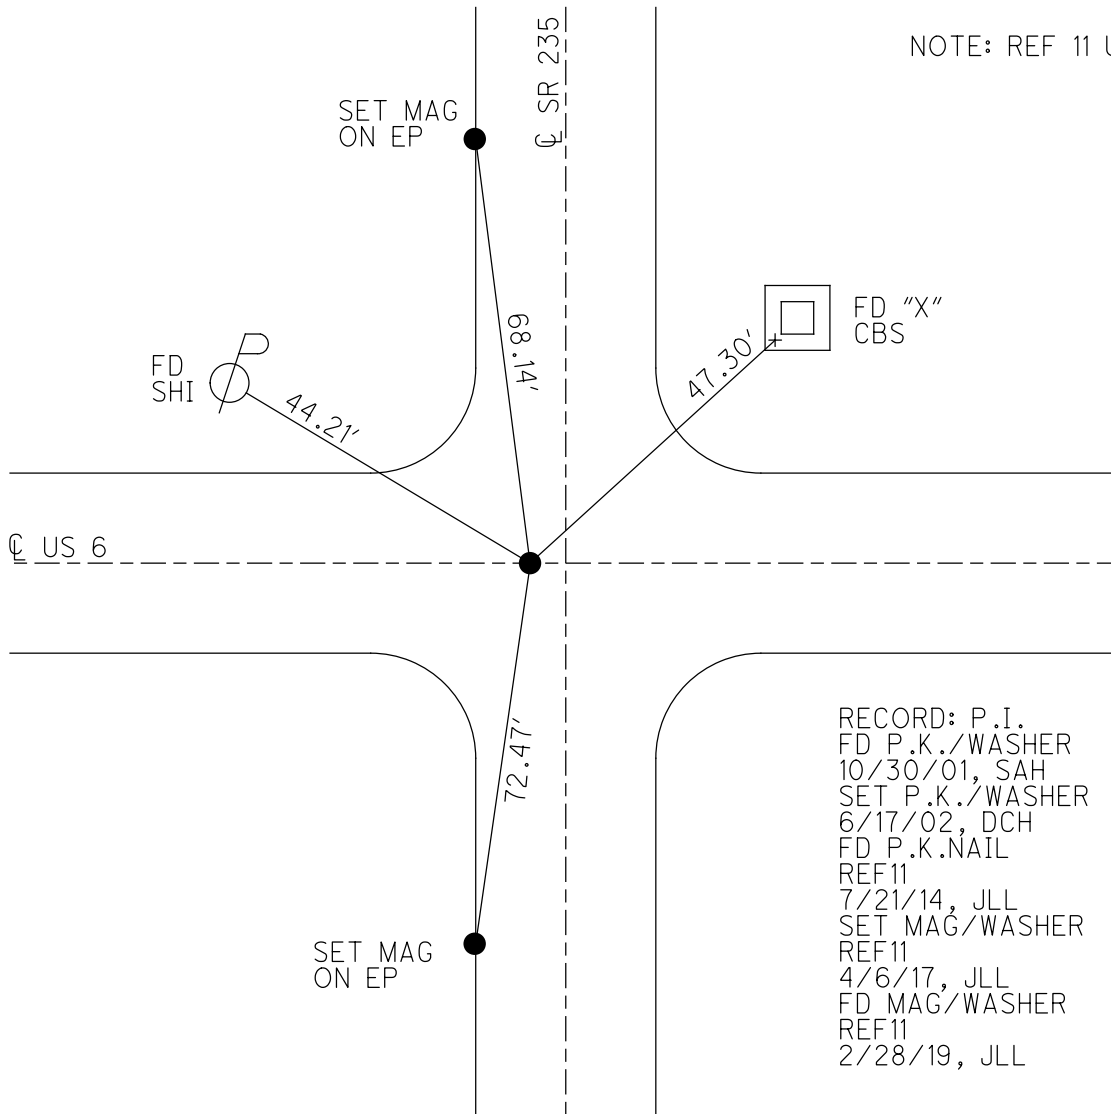

RECORD: P.I.
FD P.K./WASHER
10/30/01, SAH
SET P.K./WASHER
6/17/02, DCH
FD P.K.NAIL
REF11
7/21/14, JLL
SET MAG/WASHER
REF11
4/6/17, JLL
FD MAG/WASHER
REF11
2/28/19, JLL

O.D.O.T. DISTRICT 2 SURVEY OFFICE (USE ONLY)

PERSONNEL

REFERENCE NO. 31

SHEET 2 OF 16

NOTES RHOADES

DATE 8/26/15

ROUTE SR 235

H.C. O'DONNELL

WEATHER CLOUDY

COUNTY WOOD

R.C. RHOADES

TEMP. 60°

TOWNSHIP WESTON

DWG BY RHOADES PID PVTRAIN

SECTION 23

T 5 N R 9 E

TYPE MONUMENT SM.R.R.SPIKE

ON SURFACE - ~~BELOW~~ ON

OFFSET Q PAVEMENT 0.3' LT : ~~RT~~

8.7' TO LT EDGE PAVEMENT


STATION: 770+89.06

HORZ.DATUM: NAD83 2011


GEOID: NAVD88 2012A

GRID: NORTHING: 626609.469

EASTING: 1615480.383

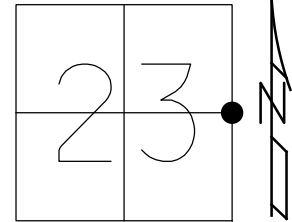

RECORD:
SET R.R.SPIKE
8-27-92, CL
FD R.R.SPIKE
4-14-00
FD SM.R.R.SPIKE
REF36
8-25-15, JFO
SET MAG/WASHER
NEWREF31
7-15-16, JLL
FD MAG/WASHER
REF31
7/8/22, DSA

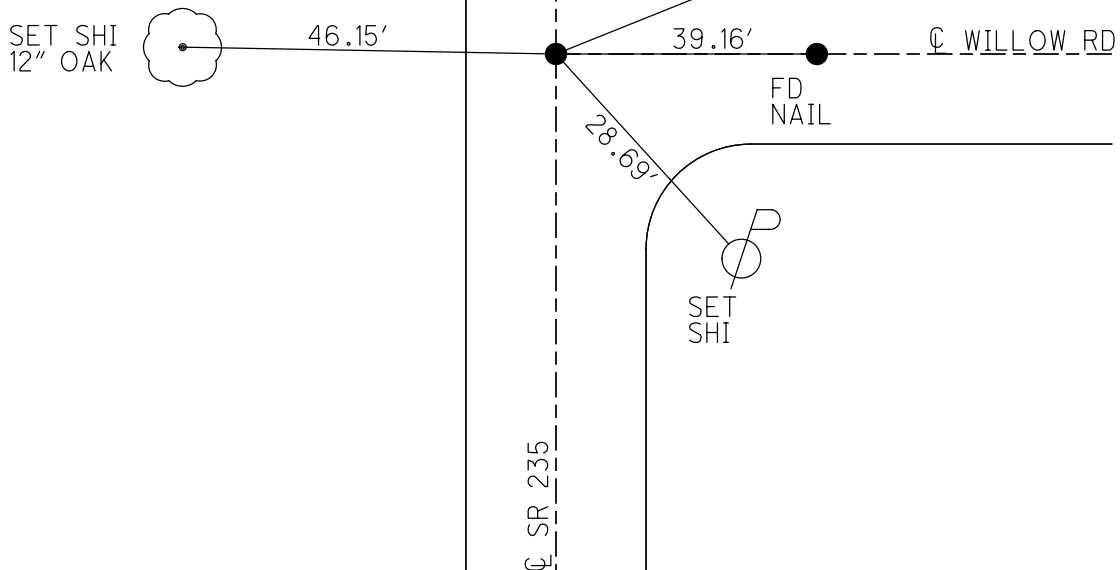

O.D.O.T. DISTRICT 2 SURVEY OFFICE (USE ONLY)

PERSONNEL

REFERENCE NO. 31 A

SHEET 3 OF 16

NOTES RHOADES

DATE 8/26/15

ROUTE SR 235

H.C. O'DONNELL

WEATHER CLOUDY

COUNTY WOOD

R.C. RHOADES

TEMP. 60°

TOWNSHIP WESTON

SECTION 23

DWG BY RHOADES

PID PVTRAIN

T 5 N R 9 E

TYPE MONUMENT P.K./WASHER

ON SURFACE - ~~BELOW~~ ON

OFFSET Q PAVEMENT 1.2' LT : ~~RT~~

8.5' TO LT EDGE PAVEMENT


STATION: 784+22.30

HORIZ.DATUM: NAD83 2011

GEOID: NAVD88 2012A

GRID: NORTHING: 627942.837

EASTING: 1615496.265

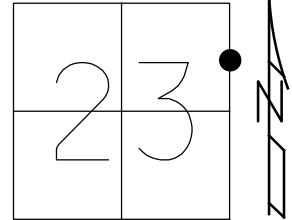

RECORD:
FD P.K./WASHER
8-27-92, CL
4-14-00
FD PK NAIL
REF37
8-25-15, JFO
SET MAG/WASHER
NEWREFA31
7-18-16, JLL
FD MAG/WASHER
REFA31
7/8/22, DSA

SET SHI
46" WILLOW



74.38'

FD
PK/W

40.60'



48.91'



SET TACK
IN 2X4" POST
2' UP

32.64'



PK SHI
SW/S

Q SR 235

O.D.O.T. DISTRICT 2 SURVEY OFFICE (USE ONLY)

PERSONNEL

REFERENCE NO. 32

SHEET 4 OF 16

NOTES RHOADES

DATE 8/26/15

ROUTE SR 235

H.C. O'DONNELL

WEATHER CLOUDY

COUNTY WOOD

R.C. RHOADES

TEMP. 60°

TOWNSHIP WESTON

DWG BY RHOADES PID PVTRAIN

SECTION 23

T 5 N R 9 E

TYPE MONUMENT P.K.NAIL

~~ON SURFACE~~ - BELOW 1.5"

OFFSET Q PAVEMENT 1.0' LT : ~~RT~~

- TO - EDGE PAVEMENT


STATION: 797+54.27

HORIZ.DATUM: NAD83 2011


GEOID: NAVD88 2012A

GRID: NORTHING: 629274.497

EASTING: 16115511.953

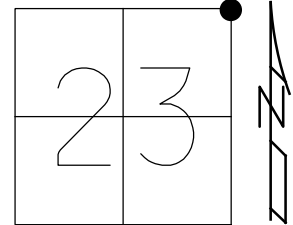

RECORD:
FD P.K./WASHER
8-27-92, CL
4-14-00
FD P.K./NAIL
REF38
8-25-15, JFO
SET MAG/WASHER
NEWREF32
7-18-16, JLL
FD MAG/WASHER
REF32
7/8/22, DSA

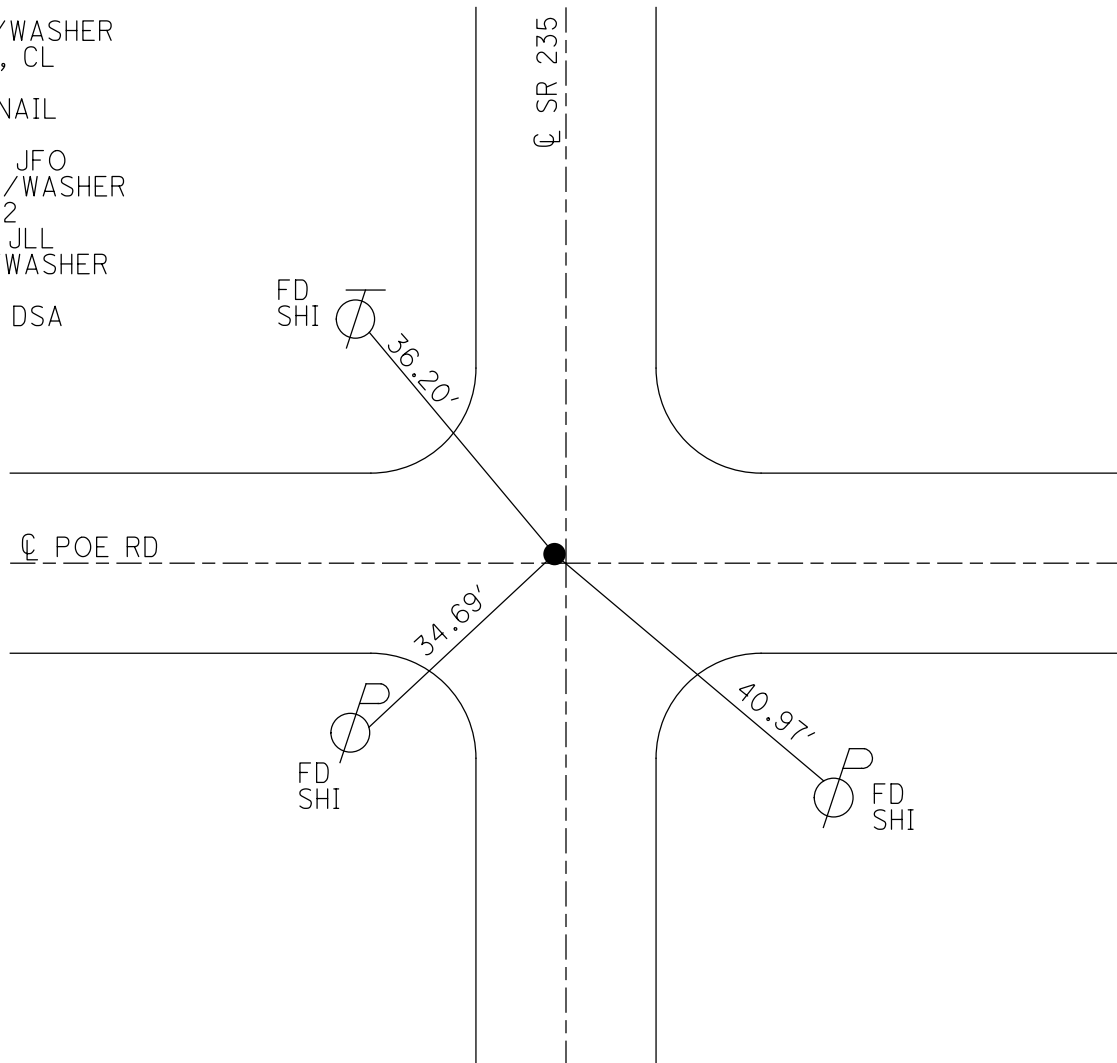

O.D.O.T. DISTRICT 2 SURVEY OFFICE (USE ONLY)

PERSONNEL

REFERENCE NO. 33

SHEET 5 OF 16

NOTES RHOADES

DATE 8/26/15

ROUTE SR 235

H.C. O'DONNELL

WEATHER CLOUDY

COUNTY WOOD

R.C. RHOADES

TEMP. 60°

TOWNSHIP WASHINGTON

DWG BY RHOADES PID PVTRAIN

SECTION 14

T 6 N R 9 E

TYPE MONUMENT P.K.NAIL

~~ON SURFACE~~ - BELOW 3.5'

OFFSET CL PAVEMENT 2.6' ~~LT~~ : RT

6' TO RT EDGE PAVEMENT


STATION: 823+94.78

HORZ.DATUM: NAD83 2011


GEOID: NAVD88 2012A

GRID: NORTHING: 631914.853

EASTING: 1615545.305

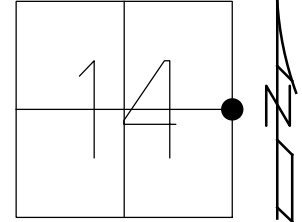

RECORD:
FD P.K./WASHER
8-27-92, CL
4-14-00
FD P.K.NAIL
REF39
10-24-14
FD P.K.NAIL
3.5" DOWN
REF39
8-25-15, JFO
SET MAG/WASHER
NEWREF33
7-18-16, JLL
FD MAG/WASHER
REF33
7/8/22, DSA

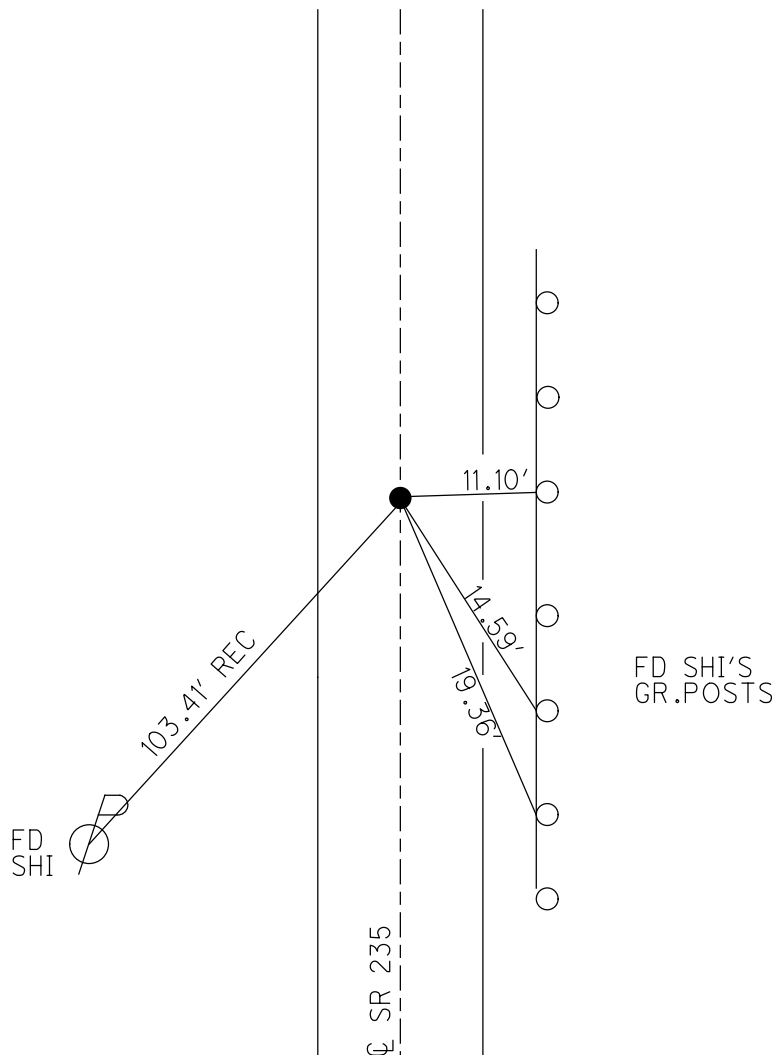

O.D.O.T. DISTRICT 2 SURVEY OFFICE (USE ONLY)

PERSONNEL

REFERENCE NO. 34

SHEET 6 OF 16

NOTES RHOADES

DATE 8/26/15

ROUTE SR 235

H.C. O'DONNELL

WEATHER CLOUDY

COUNTY WOOD

R.C. RHOADES

TEMP. 60°

TOWNSHIP WASHINGTON

SECTION 14

DWG BY RHOADES

PID PVTRAIN

T 6 N R 9 E

TYPE MONUMENT P.K.NAIL

~~ON SURFACE~~ - BELOW 1.5"

OFFSET CL PAVEMENT 1.2' ~~LT~~ : RT

- TO - EDGE PAVEMENT


STATION: 850+44.99

HORIZ.DATUM: NAD83 2011


GEOID: NAVD88 2012A

GRID: NORTHING: 634564.861

EASTING: 1615578.349

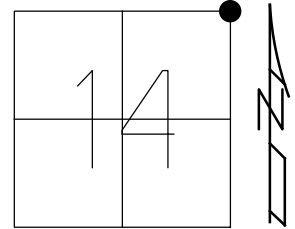

RECORD:
FD P.K./WASHER
8-27-92, CL
4-14-00
FD P.K.NAIL
1.5" DOWN
REF40
10-24-14
FD P.K.NAIL
1.5" DOWN
REF40
8-25-15, JFO
SET MAG/WASHER
NEWREF34
7-18-16, JLL
FD MAG/WASHER
REF34
7/8/22, DSA

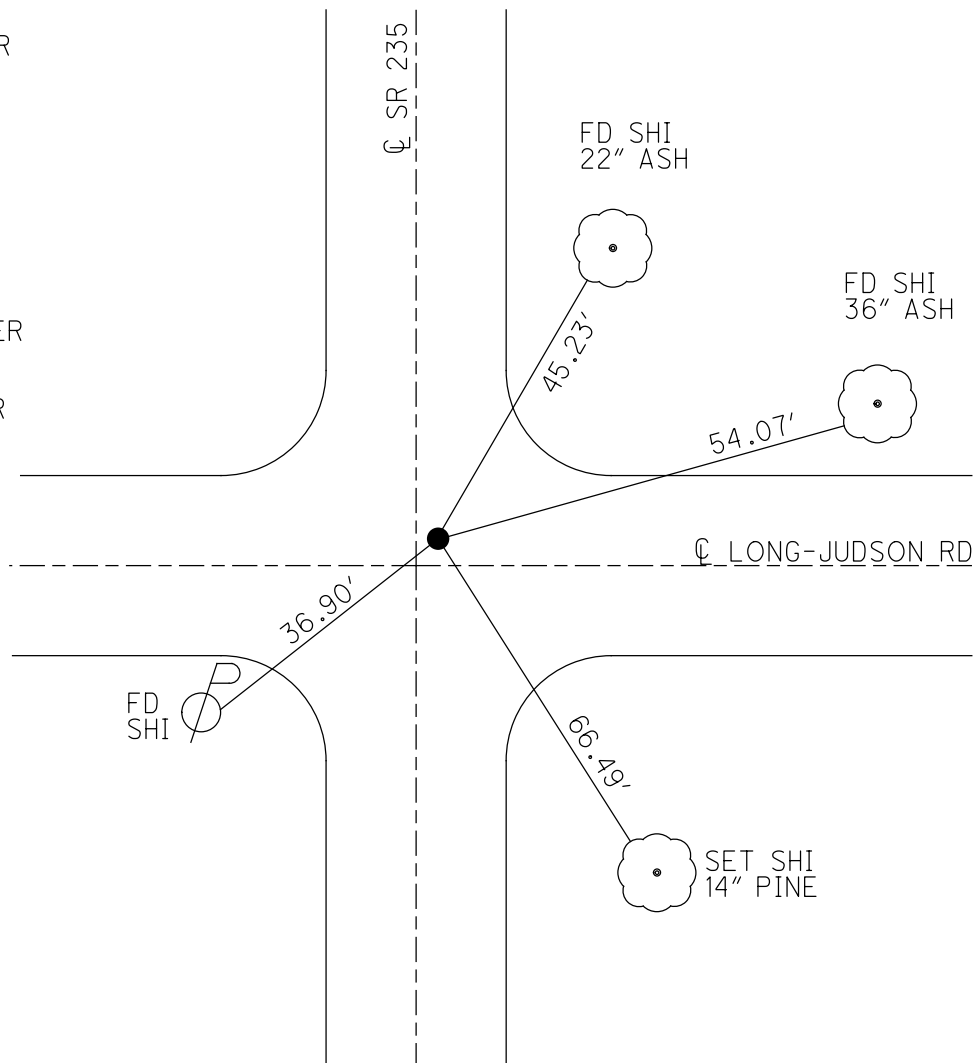

O.D.O.T. DISTRICT 2 SURVEY OFFICE (USE ONLY)

PERSONNEL

REFERENCE NO. 35

SHEET 7 OF 16

NOTES RHOADES

DATE 8-26-15

ROUTE SR 235

H.C. O'DONNELL

WEATHER CLOUDY

COUNTY WOOD

R.C. RHOADES

TEMP. 60°F

TOWNSHIP WASHINGTON

SECTION 11

T 6 N R 9 E

TYPE MONUMENT P.K./WASHER


ON SURFACE - ~~BELOW~~ ON

LEFT - CL PAV'T - ~~RIGHT~~ 3.5'

6.3' TO LT EDGE PAVEMENT

S.L.M. 876+77.16

Grid: Northing: 637196.782 Easting: 1615609.806

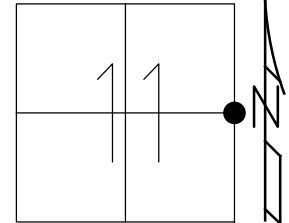

RECORD:

FD 1" SQ.BOLT

OVER STONE

1' LT OF CL

5/10/76, BURNSIDE

FD P.K./WASHER

8-27-92, CL

FD P.K./WASHER

7-20-00

FD MAG NAIL

REF41


10-24-14

8-25-15, JFO

SET MAG/WASHER

NEWREF35

7-18-16, JLL

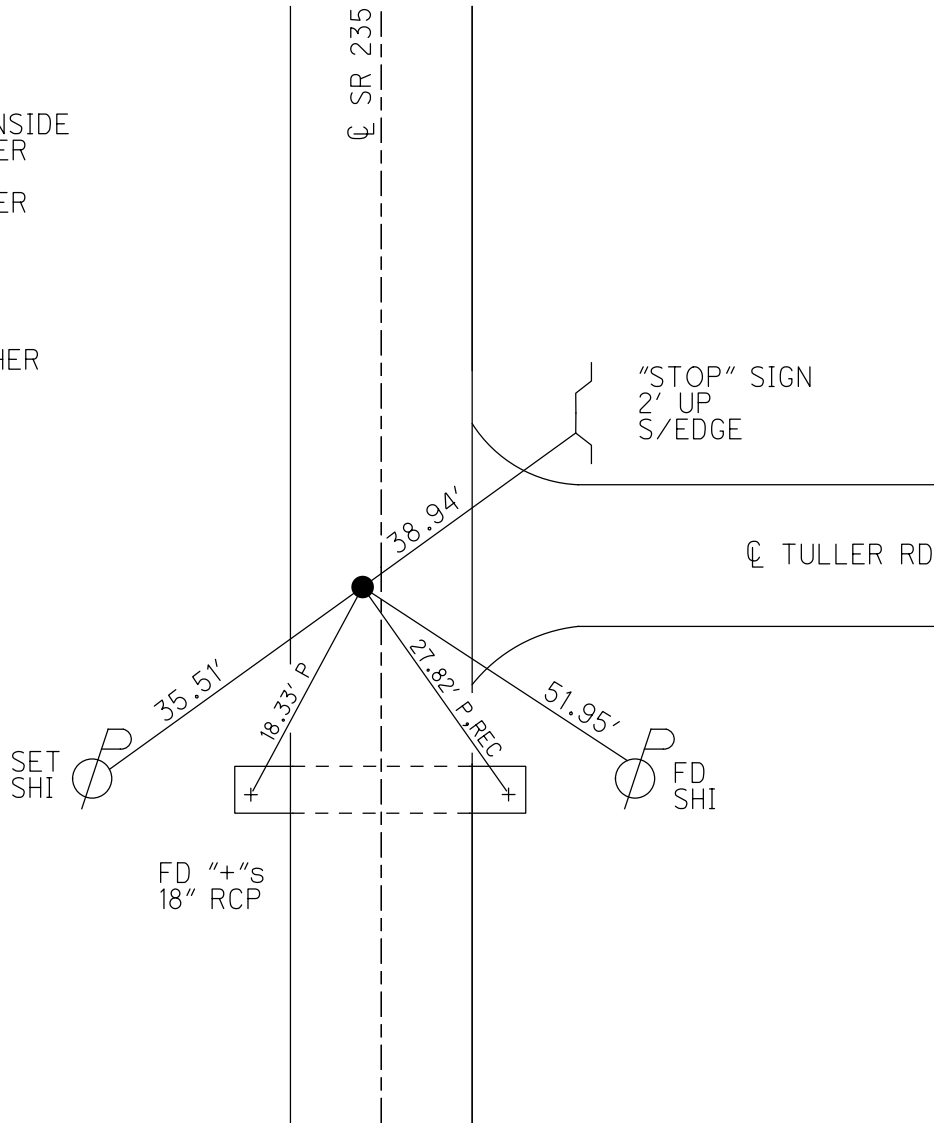

O.D.O.T. DISTRICT 2 SURVEY OFFICE (USE ONLY)

PERSONNEL

REFERENCE NO.

36

SHEET

8

OF 16

NOTES

RHOADES

DATE

8-26-15

ROUTE

SR 235

H.C.

O'DONNELL

WEATHER

CLOUDY

COUNTY

WOOD

R.C.

RHOADES

TEMP.

60°F

TOWNSHIP

WASHINGTON

SECTION

11

T 6 N R 9 E

TYPE MONUMENT

P.K.NAIL

ON SURFACE - ~~BELOW~~


ON

~~LEFT~~ - Q PAV'T - RIGHT 8.5'

- TO - EDGE PAVEMENT


S.L.M. 903+26.53

Grid: Northing: 639845.772 Easting: 1615653.981

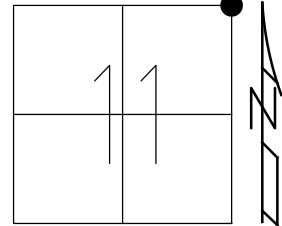

RECORD:

FD R.R.SPIKE
5/10/76, BURNSIDE
5/15/79, SMITH
FD P.K./WASHER
8-27-92, CL
4-14-00
FD P.K. NAIL
REF42
10-24-14
8-25-15, JFO
SET MAG/WASHER
NEWREF36
7-18-16, JLL
FD MAG/WASHER
REF36
7/26/18, JFO

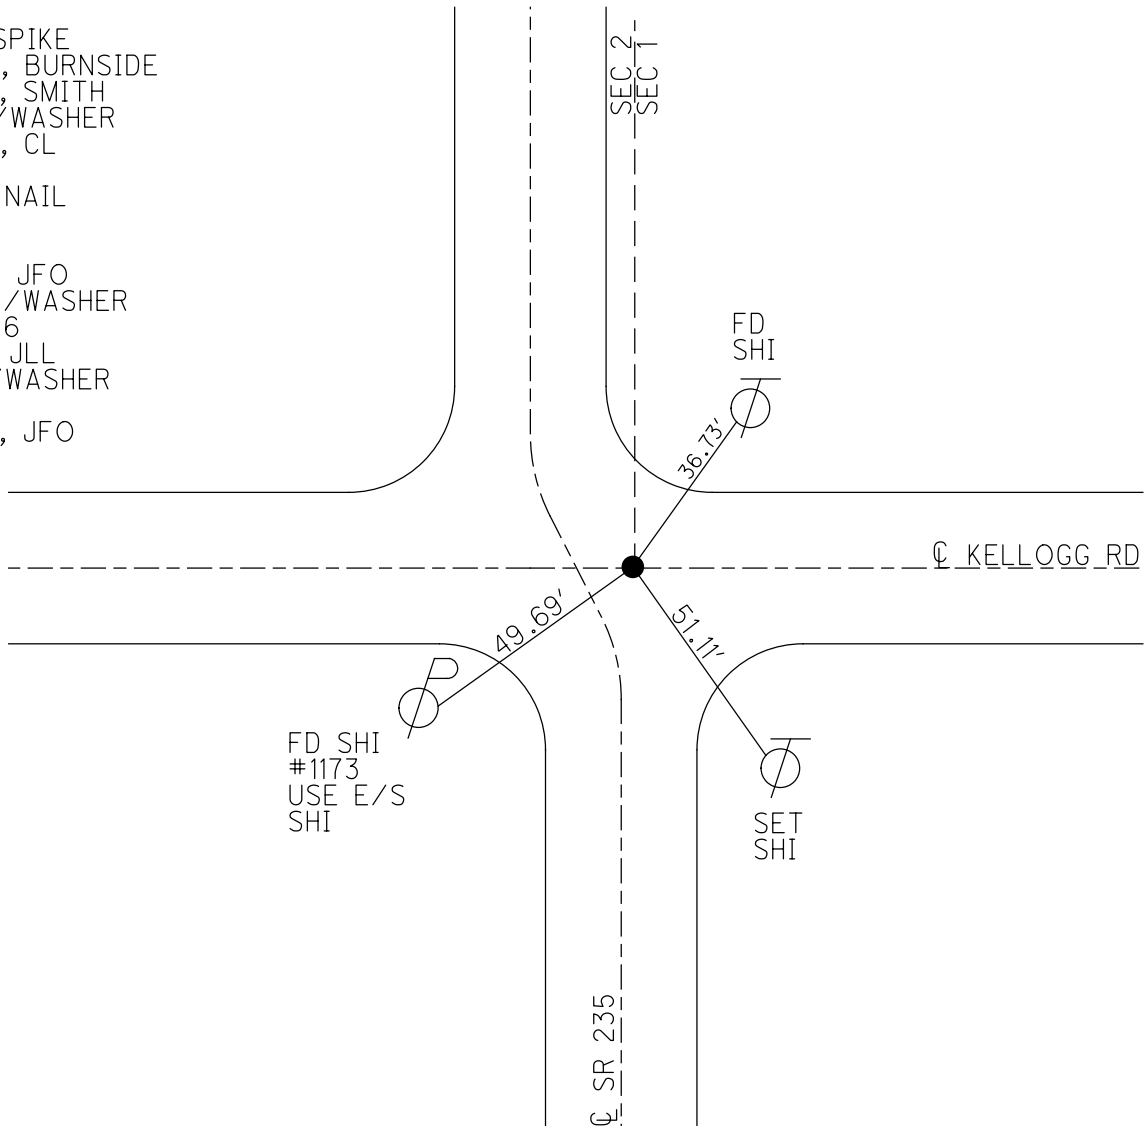

O.D.O.T. DISTRICT 2 SURVEY OFFICE (USE ONLY)

PERSONNEL

REFERENCE NO. 37

SHEET 9 OF 16

NOTES RHOADES

DATE 8-26-15

ROUTE SR 235

H.C. O'DONNELL

WEATHER CLOUDY

COUNTY WOOD

R.C. RHOADES

TEMP. 60°F

TOWNSHIP WASHINGTON

SECTION 2

T 6 N R 9 E

TYPE MONUMENT P.K./WASHER


ON SURFACE - ~~BELOW~~ ON

~~LEFT~~ = CL PAV'T - RIGHT 9.2'


1.0' RT TO RT EDGE PAVEMENT

S.L.M. 929+76.70

Grid: Northing: 642495.082 Easting: 1615723.132

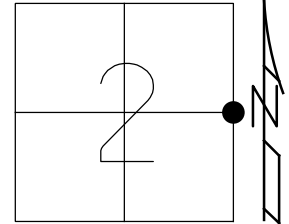

RECORD:
FD R.R.SPIKE
ORIGIN UNKNOWN
5/13/76, BURNSIDE
FD 1" IPIN
SET BY CO.ENGR.
1" DOWN
5/15/79, SMITH
FD P.K./WASHER
8-27-92, CL
4-14-00
FD P.K.NAIL
REF43
10-24-14
FD PK/WASHER
3" BELOW
REF43
8-25-15, JFO
SET MAG/WASHER
NEWREF37
7-18-16, JLL
FD MAG/WASHER
REF37
7/26/18, JFO

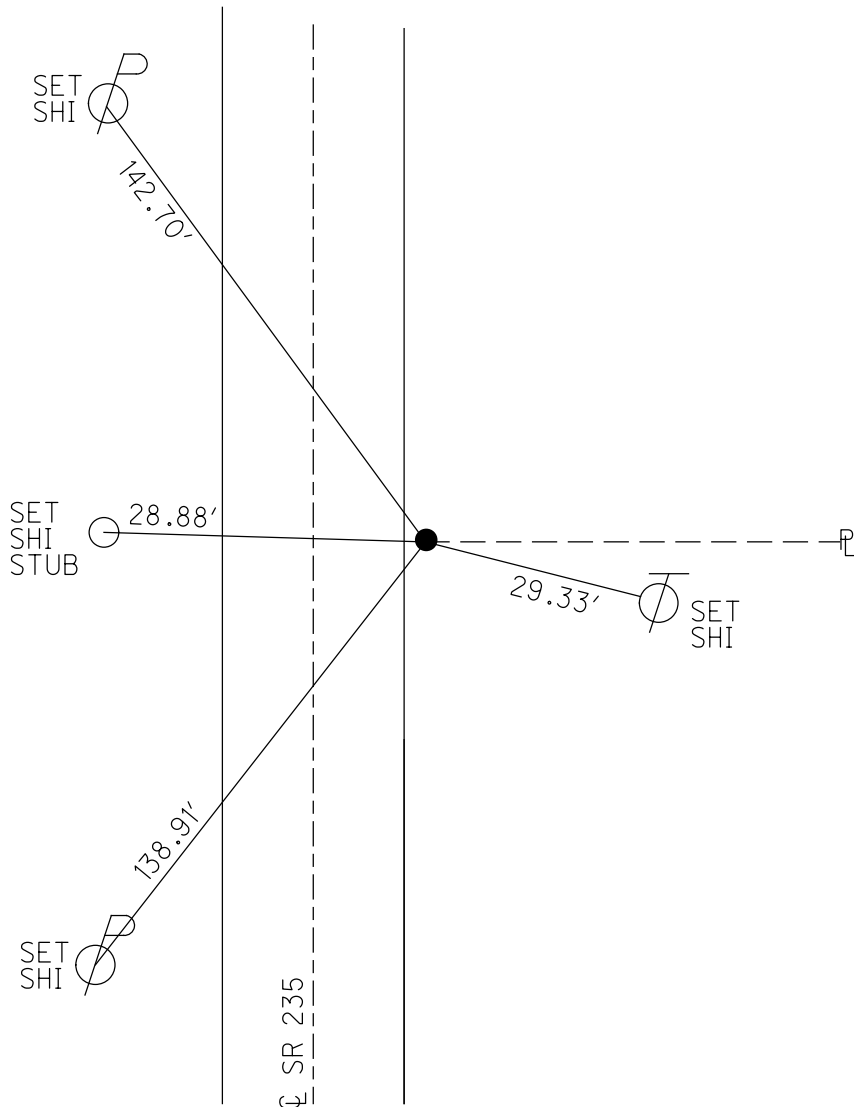

O.D.O.T. DISTRICT 2 SURVEY OFFICE (USE ONLY)

PERSONNEL

REFERENCE NO. 38

SHEET 10 OF 16

NOTES RHOADES

DATE 8-26-15

ROUTE SR 235

H.C. O'DONNELL

WEATHER CLOUDY

COUNTY WOOD

R.C. RHOADES

TEMP. 60°F

TOWNSHIP WASHINGTON

SECTION 35

T 6 N R 9 E

TYPE MONUMENT P.K./WASHER


~~ON SURFACE~~ - BELOW 3"

~~LEFT~~ - Q PAV'T - RIGHT 8.2'

- TO - EDGE PAVEMENT


S.L.M. 956+20.36

Grid: Northing: 645138.550 Easting: 1615750.425

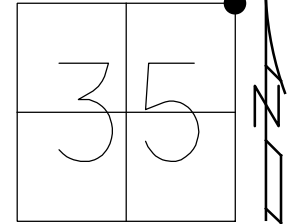

RECORD:
FD STONE
2' DOWN
SET 1" IPIPE
OVER STONE
5/13/76, BURNSIDE
FD 1" IPIPE
OVER STONE
5/15/79, SMITH
FD SM.R.R.SPIKE
3/18/85, CL
FD P.K./WASHER
8-27-92, CL
3/31/93, BVD
4-14-00
FD P.K./WASHER
3" DOWN
REF44
10-24-14
8-25-15, JFO
SET MAG/WASHER
NEWREF38
7-18-16, JLL
FD MAG/WASHER
REF38
7/26/18, JFO

MUD RD

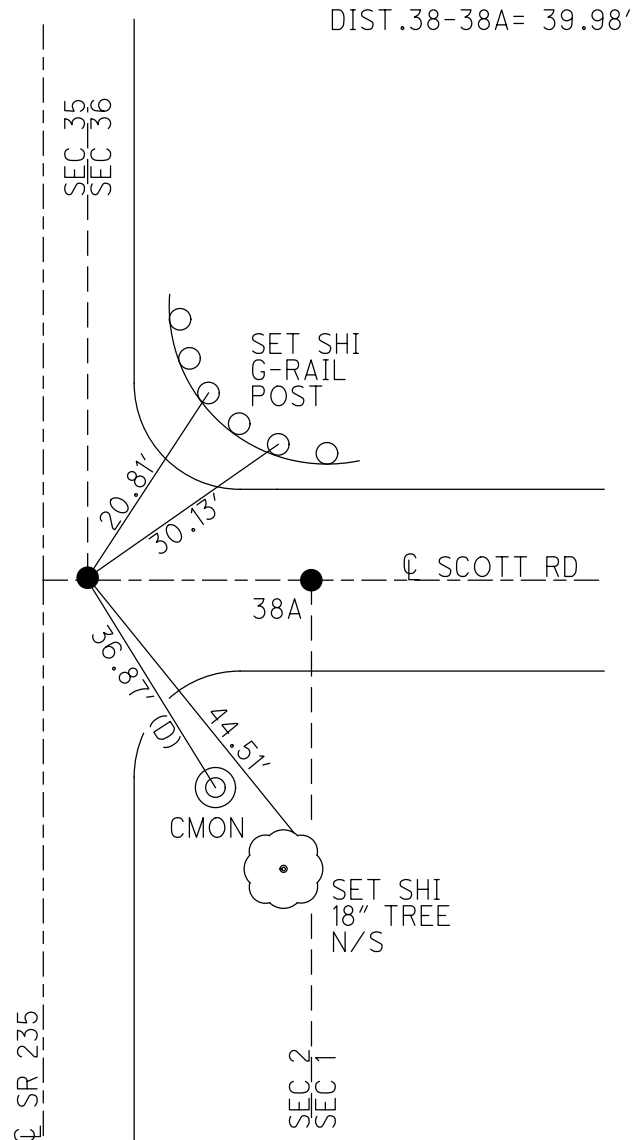

DIST.38-38A= 39.98'

O.D.O.T. DISTRICT 2 SURVEY OFFICE (USE ONLY)

PERSONNEL

REFERENCE NO. 38 A

SHEET 11 OF 16

NOTES RHOADES
H.C. O'DONNELL
R.C. RHOADES

DATE 8-26-15
WEATHER CLOUDY
TEMP. 60°F

ROUTE SR 235
COUNTY WOOD
TOWNSHIP WASHINGTON
SECTION 2
T 6 N R 9 E

TYPE MONUMENT R.R.SPIKE


~~ON SURFACE~~ - BELOW 3/4"

~~LEFT~~ - Q PAV'T - RIGHT 48.18'

- TO - EDGE PAVEMENT


S.L.M. 956+20.36

Grid: Northing: 645138.509 Easting: 1615790.382

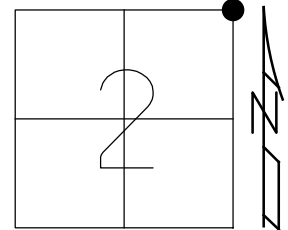

RECORD:
FD R.R.SPIKE
ATOP STONE
5/13/76, BURNSIDE
5/15/79, SMITH
FD LG.R.R.SPIKE
3/18/85, CL
FD P.K./WASHER
8-27-92, CL
FD LG.R.R.SPIKE
3/31/93, BVD
4-14-00
FD LG.R.R.SPIKE
3/4" DOWN
REF45
10-24-14
FD P.K./WASHER
3/4" DOWN
REF45
8-25-15, JFO
7-18-16, JLL
FD R.R.SPIKE
REF45
7/26/18, JFO

MUD RD

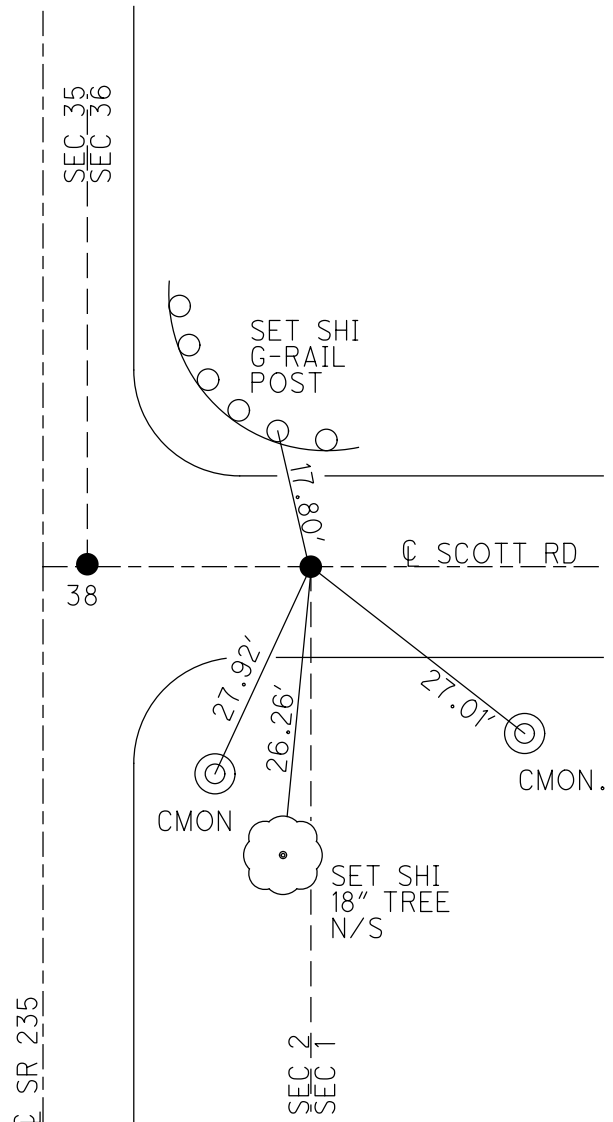

O.D.O.T. DISTRICT 2 SURVEY OFFICE (USE ONLY)

PERSONNEL

REFERENCE NO.

39

SHEET

12

OF

16

NOTES

RHOADES

DATE

8-26-15

ROUTE

SR 235

H.C.

O'DONNELL

WEATHER

CLOUDY

COUNTY

WOOD

R.C.

RHOADES

TEMP.

60°F

TOWNSHIP

WASHINGTON

SECTION

35

T 6 N

R 9 E

TYPE MONUMENT

PK/WASHER

ON SURFACE - ~~BELOW~~

ON


~~LEFT~~ - C PAV'T - RIGHT 1.0'

7.6' TO RT EDGE PAVEMENT

S.L.M. 982+73.40

Grid: Northing: 647791.5559

Easting: 1615768.3864

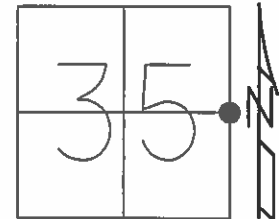

RECORD:

FD PK/WASHER

8-27-92, CL

PREVENTIVE MAINTENANCE

CHIP&SEAL

EXISTING POINT UNCOVERED

DATE 4-14-2000

FD PK/WASHER

2.5" BELOW

GPS, REF46

10-24-14

FD PK/WASHER


GPS, REF46

8-25-15, JFO

SET MAG/WASHER

GPS, NEWREF39

7-18-16, JLL

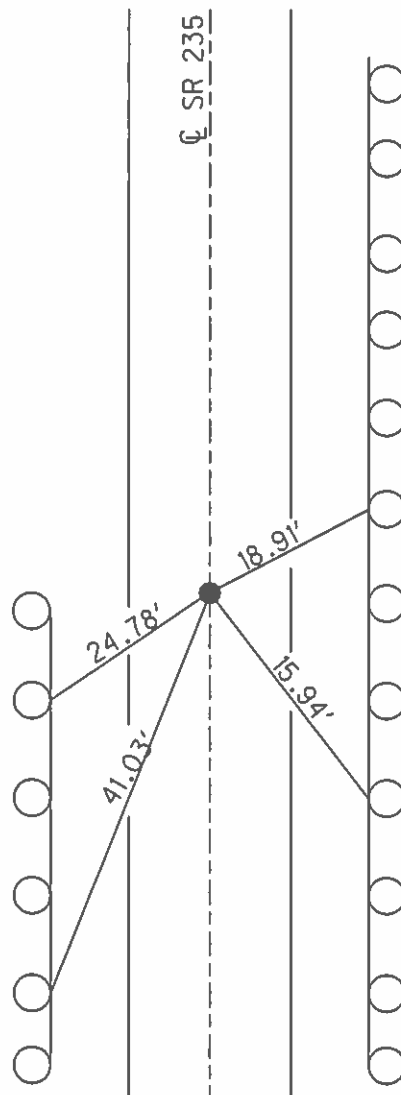

SET SHI'S
G-RAIL
POSTS

O.D.O.T. DISTRICT 2 SURVEY OFFICE (USE ONLY)

PERSONNEL

REFERENCE NO. 39 A SHEET 13 OF 16

NOTES RHOADES DATE 8-26-15 ROUTE SR 235
H.C. O'DONNELL WEATHER CLOUDY COUNTY WOOD
R.C. RHOADES TEMP. 60°F TOWNSHIP WASHINGTON
SECTION 35
T 6 N R 9 E

TYPE MONUMENT PK/WASHER


ON SURFACE - ~~BELOW~~ ON

~~LEFT~~ - Q PAV'T - RIGHT 2.0'

7.3' TO RT EDGE PAVEMENT

S.L.M. 992+66.24

Grid: Northing: 648784.313 Easting: 1615780.534

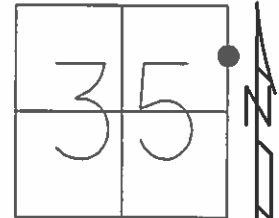

RECORD:
FD PK/WASHER
8-27-92, CL

PREVENTIVE MAINTENANCE
CHIP&SEAL
EXISTING POINT UNCOVERED
DATE 4-14-2000

FD PK/WASHER
GPS, REF47
10-24-14

FD PK/WASHER
GPS, REF47
8-25-15, JFO

SET MAG/WASHER
GPS, NEWREFA39
7-18-16, JLL

FD SHI
STUB POLE
SE/S

CTR. 6TH
BRICK UP

BACK BAY RD.

CTR. 9TH
BRICK UP

FD SHI
NW/S

Q SR 235



40.18'

41.09'

42.35'

31.98'


O.D.O.T. DISTRICT 2 SURVEY OFFICE (USE ONLY)

PERSONNEL _____ REFERENCE NO. 39 B SHEET 14 OF 16

NOTES RHOADES DATE 4-20-15 ROUTE SR 235
H.C. WESTFALL WEATHER WINDY COUNTY WOOD
R.C. O'DONNELL TEMP. 58°F TOWNSHIP WASHINGTON
_____ SECTION 35
_____ T 6 N R 9 E

TYPE MONUMENT PK/WASHER
ON SURFACE - ~~BELOW~~ ON
~~LEFT~~ - Q PAV'T - RIGHT ON
TO EDGE PAVEMENT
S.L.M. 1008+81.21


Grid: Northing: 650399.191 Easting: 1615800.485

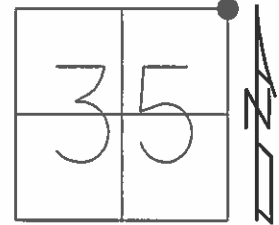

RECORD:
UNKNOWN
ORIGIN
4-17-92

DIST.
39B-39C= 2.15'
39B-40= 24.94'

FD MAG/WASHER
GPS, REF49
10-24-14

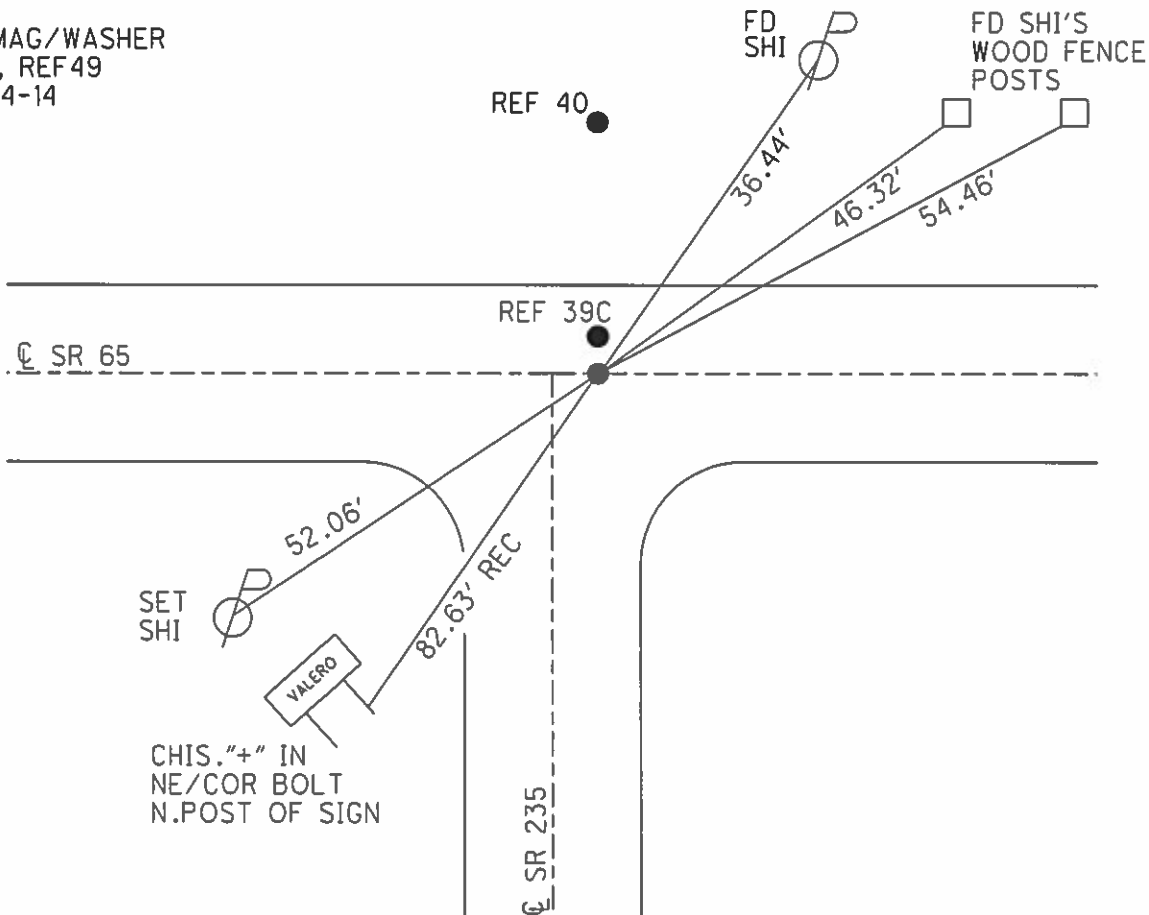

NOTE: REF 12 I ON SR 65

O.D.O.T. DISTRICT 2 SURVEY OFFICE (USE ONLY)

PERSONNEL

REFERENCE NO.

39 C

SHEET

15

OF 16

NOTES RHOADES

DATE

4-20-15

ROUTE SR 235

H.C. WESTFALL

WEATHER

WINDY

COUNTY WOOD

R.C. O'DONNELL

TEMP.

58°F

TOWNSHIP WASHINGTON

SECTION 35

T 6 N R 9 E

TYPE MONUMENT PK SHANK


ON SURFACE - ~~BELOW~~ ON

LEFT - ~~Q~~ PAV'T - ~~RIGHT~~ 2.2'

7.5' TO LT EDGE PAVEMENT

S.L.M. 1008+83.36


Grid: Northing: 650401.372 Easting: 1615800.550

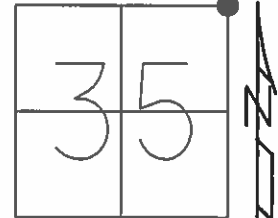

RECORD: P.I.
STA. 210+24.6
CURVE DATA FROM
CONSTR. PLAN 1923-24
 $\Delta = 6^\circ 05' \text{ RT}$
 $D = 4^\circ 0'$
 $R = 1432.69$
 $T = 76.12$
 $E = 2.02 \text{ (FIG)}$
4-17-92

DIST.
39B-39C = 2.15'
39B-40 = 24.94'

FD MAG/WASHER
GPS, REF 48

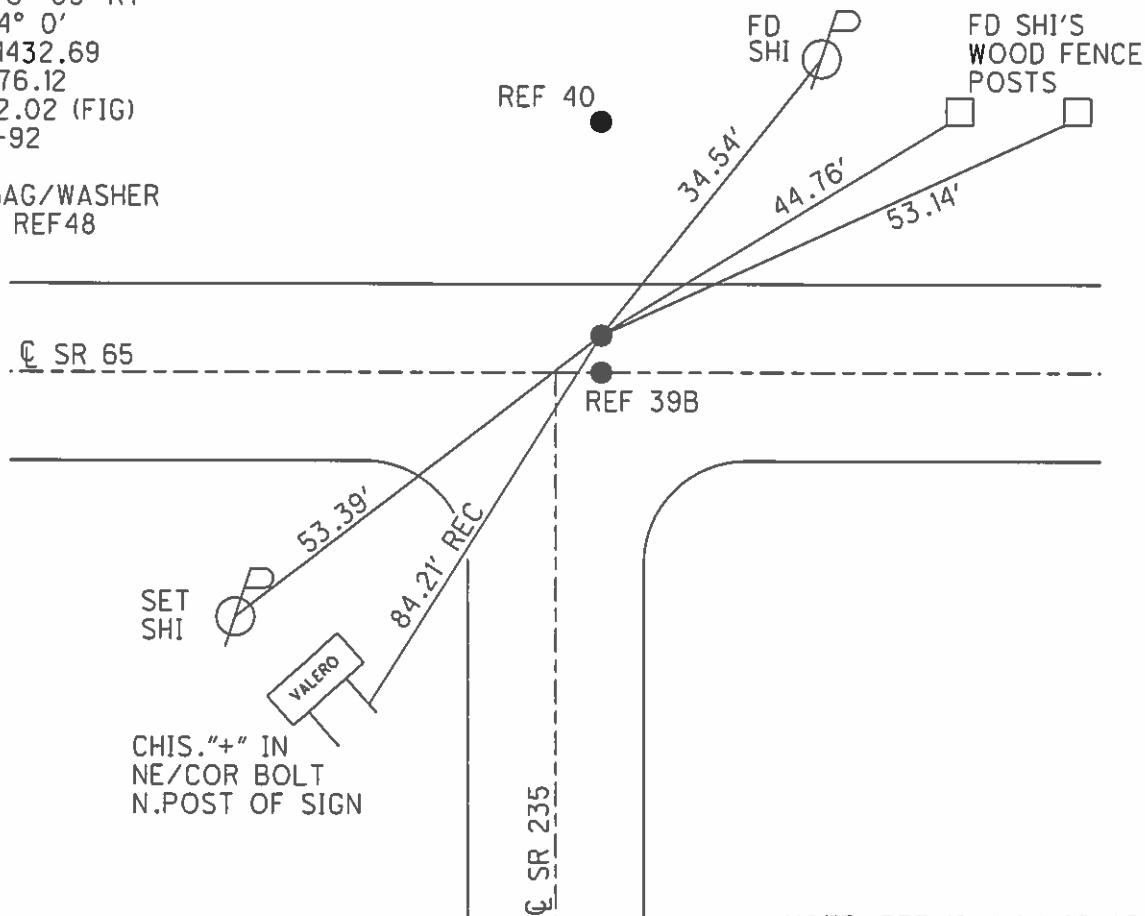


NOTE: REF 12 J ON SR 65

O.D.O.T. DISTRICT 2 SURVEY OFFICE (USE ONLY)

PERSONNEL _____ REFERENCE NO. 40 SHEET 16 OF 16
NOTES RHOADES DATE 4-20-15 ROUTE SR 235
H.C. WESTFALL WEATHER WINDY COUNTY WOOD
R.C. O'DONNELL TEMP. 58°F TOWNSHIP WASHINGTON
SECTION 35
T 6 N R 9 E

TYPE MONUMENT PK.WASHER
ON SURFACE - ~~BELOW~~ ON
LEFT - ℄ PAV'T - RIGHT 30.3'
20.4' LT TO LT EDGE PAVEMENT
S.L.M. 1009+06.15
Grid: Northing: 650424.025 Easting: 1615800.841

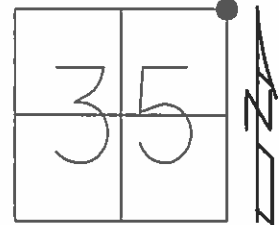


RECORD:
HAS BEEN DESTROYED
BY CONSTRUCTION IN THIS
AREA/ HAS NOT
BEEN RESET AS OF
4-17-92

NE/COR.SEC.35
FD 3/4" IPIPE
6/23/04

8/6/13, SDC

DIST.
39B-39C= 2.15'
39B-40= 24.94'

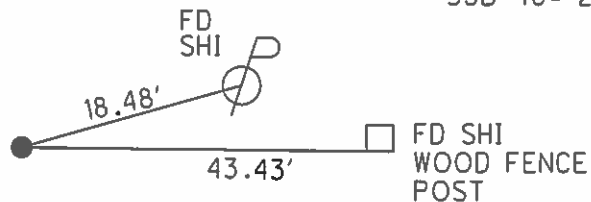

℄ SR 65

REF 39C

REF 39B

℄ SR 235

NOTE: REF 13 ON SR 65