

O.D.O.T. DISTRICT 2 SURVEY OFFICE (USE ONLY)

PERSONNEL

REFERENCE NO. 1

SHEET 1 OF 25

NOTES RHOADES

DATE 4/8/14

ROUTE SR 582

H.C. ROUSOS

WEATHER FAIR

COUNTY WOOD

R.C. RHOADES

TEMP. 44°

TOWNSHIP WASHINGTON

SECTION 20

T 6 N R 10 E

TYPE MONUMENT P.K./WASHER


ON SURFACE - ~~BELOW~~ ON

~~LEFT~~ - Q PAV'T - RIGHT 1.3'

11.7' TO LT EDGE PAVEMENT

S.L.M. 0+00, (452+29 ON SR 65)

Grid: Northing: 626327.529 Easting: 1654939.310

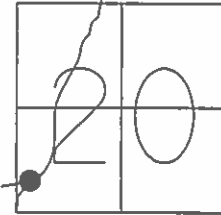


ORIGIN UNKNOWN

RESET P.K./WASHER
9/3/92, MB

FD PK, 3/14/14

GPS, REF1
4/8/14, TMR

NOT COVERED
7/25/12, EBW

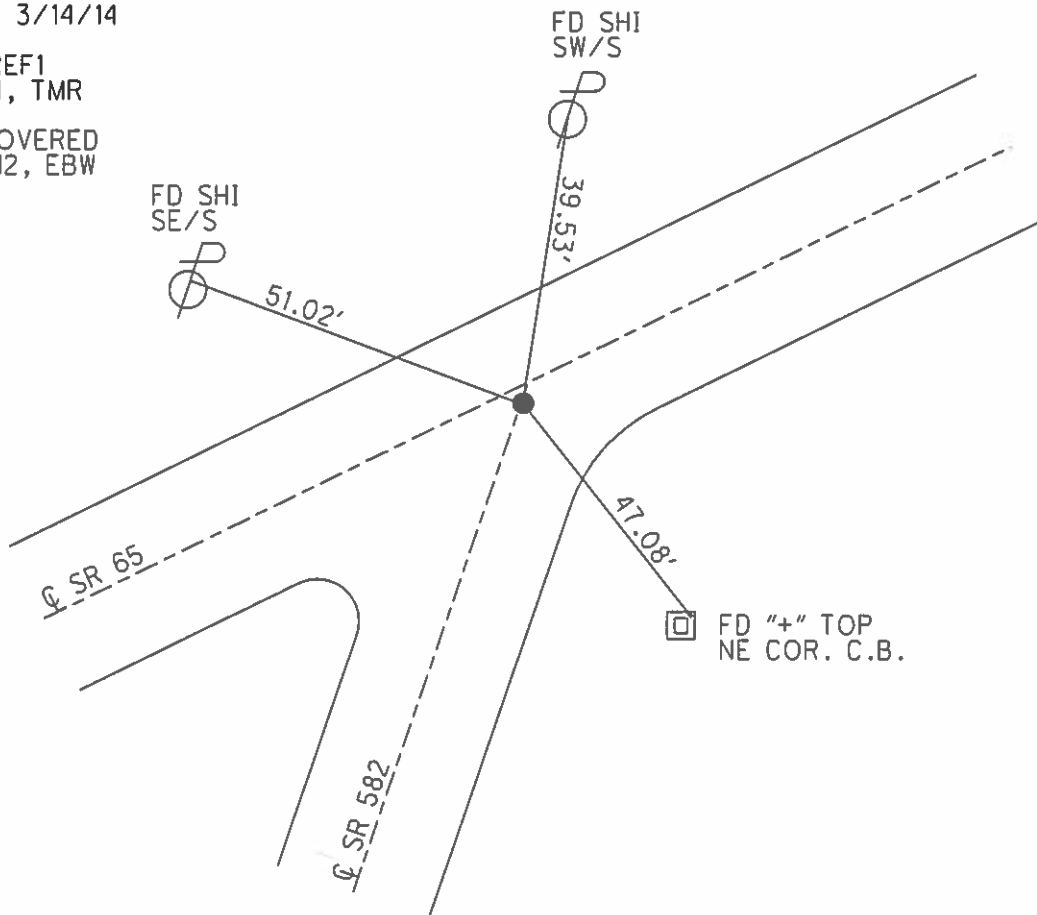

O.D.O.T. DISTRICT 2 SURVEY OFFICE (USE ONLY)

PERSONNEL

REFERENCE NO. 2

SHEET 2 OF 25

NOTES MILLER
H.C. MILLER
R.C. BARRIERE
BLUBAUGH

DATE 8/6/24
WEATHER CLOUDY
TEMP. 75°

ROUTE SR 582
COUNTY WOOD
TOWNSHIP MIDDLETON
SECTION 20
T 6 N R 10 E

DWG BY BARRIERE PID 114849

TYPE MONUMENT 1 3/4" IRON PIPE

ON SURFACE - ~~BELOW~~ 4" BELOW

OFFSET Q PAVEMENT 20' LT : ~~RT~~

13.0' TO LT EDGE PAVEMENT

STATION: 04+34

HORIZ.DATUM: NAD83 (2011)


GEOID: 18

GRID: NORTHING: 656735.960


EASTING: 1626786.944

LDP: NORTHING: 478239.680

EASTING: 137512.548

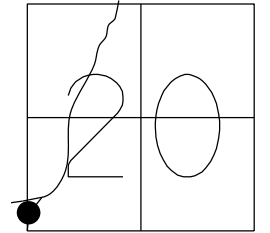

RECORD:
FD STONE WITH 1" IRON PIPE
21' ± EAST OF Q SR 582
433' ± S. OF INTER. OF SR 65
GPS, REF2
4/8/14, TMR
NOT COVERED
7/25/14, EBW
FD 1 3/4" IPIPE 4" DOWN
REF2
12/7/23, JAM
8/6/24, JAM

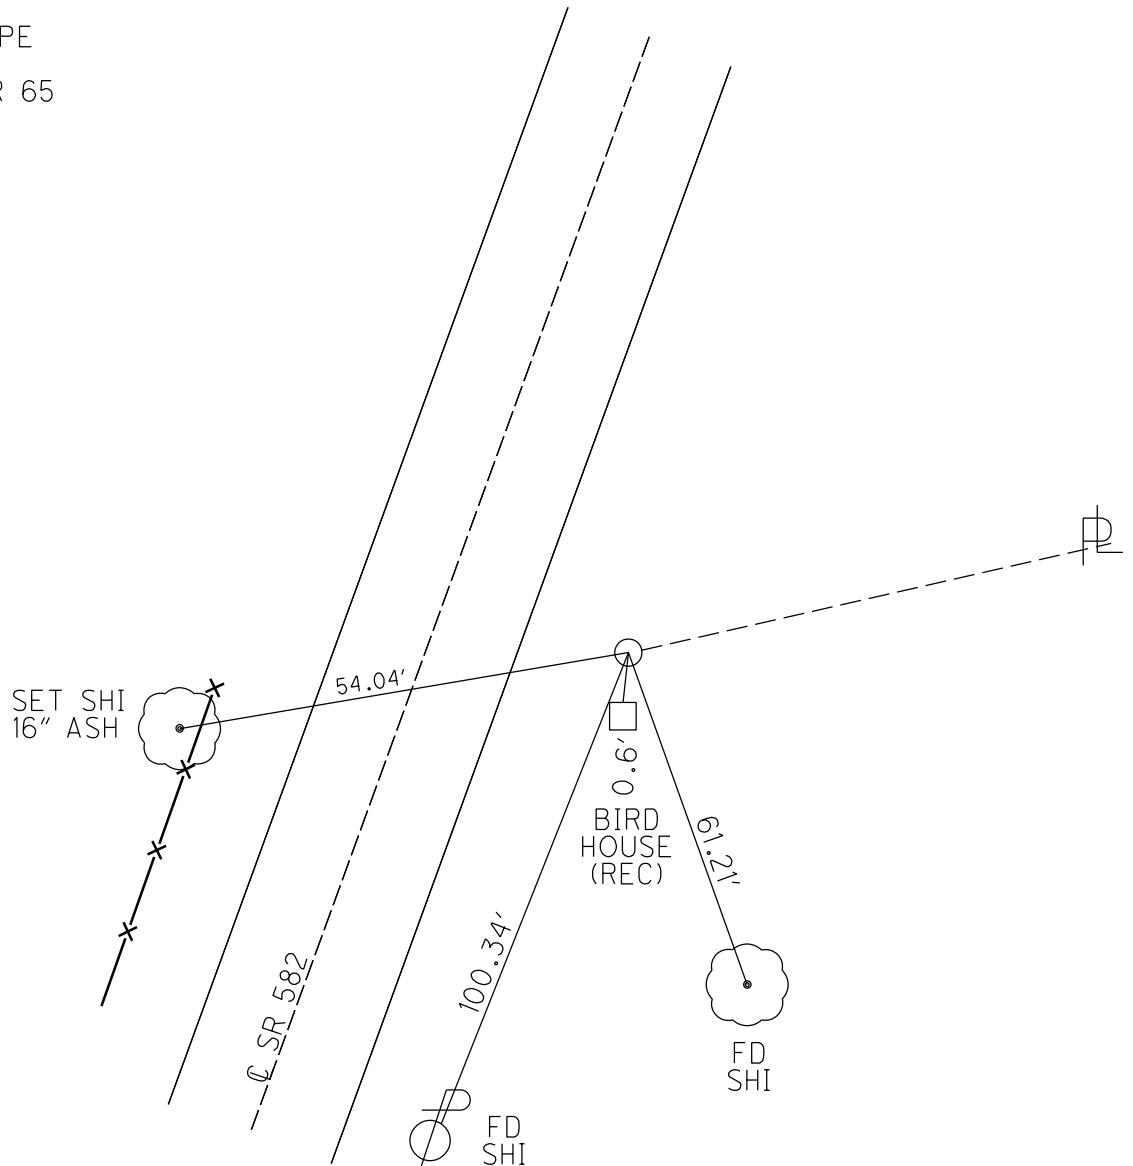

O.D.O.T. DISTRICT 2 SURVEY OFFICE (USE ONLY)

PERSONNEL

REFERENCE NO. 3

SHEET 3 OF 25

NOTES MILLER
H.C. MILLER
R.C. BARRIERE
BLUBAUGH

DATE 8/6/24
WEATHER CLOUDY
TEMP. 75°

ROUTE SR 582
COUNTY WOOD
TOWNSHIP MIDDLETON
SECTION 20

DWG BY BARRIERE PID 114849

T 6 N R 10 E

TYPE MONUMENT MAG WASHER

ON SURFACE - BELOW 0.5" BELOW

OFFSET $\angle$ PAVEMENT 6' LT : RT

TO EDGE PAVEMENT

STATION: 16+42

HORIZ.DATUM: NAD83 (2011)


GEOID: 18

GRID: NORTHING: 655578.232


EASTING: 1626511.217

LDP: NORTHING: 477078.322

EASTING: 137252.118

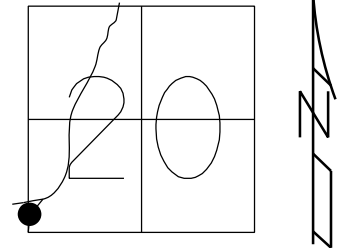

FD SM RR SPK
4/20/04, M.B.
RESET MAG/WASHER
7/30/04, MC
FND, 3/14/14
GPS, REF3
4/8/14, TMR
SET MAG/W
7/25/14, EBW
GPS, NEWREF3
7/29/14, JMR
FD MAG/WASH
REF3
12/7/23, JAM
FD TONE, DID NOT UNCOVER
8/6/24, JAM

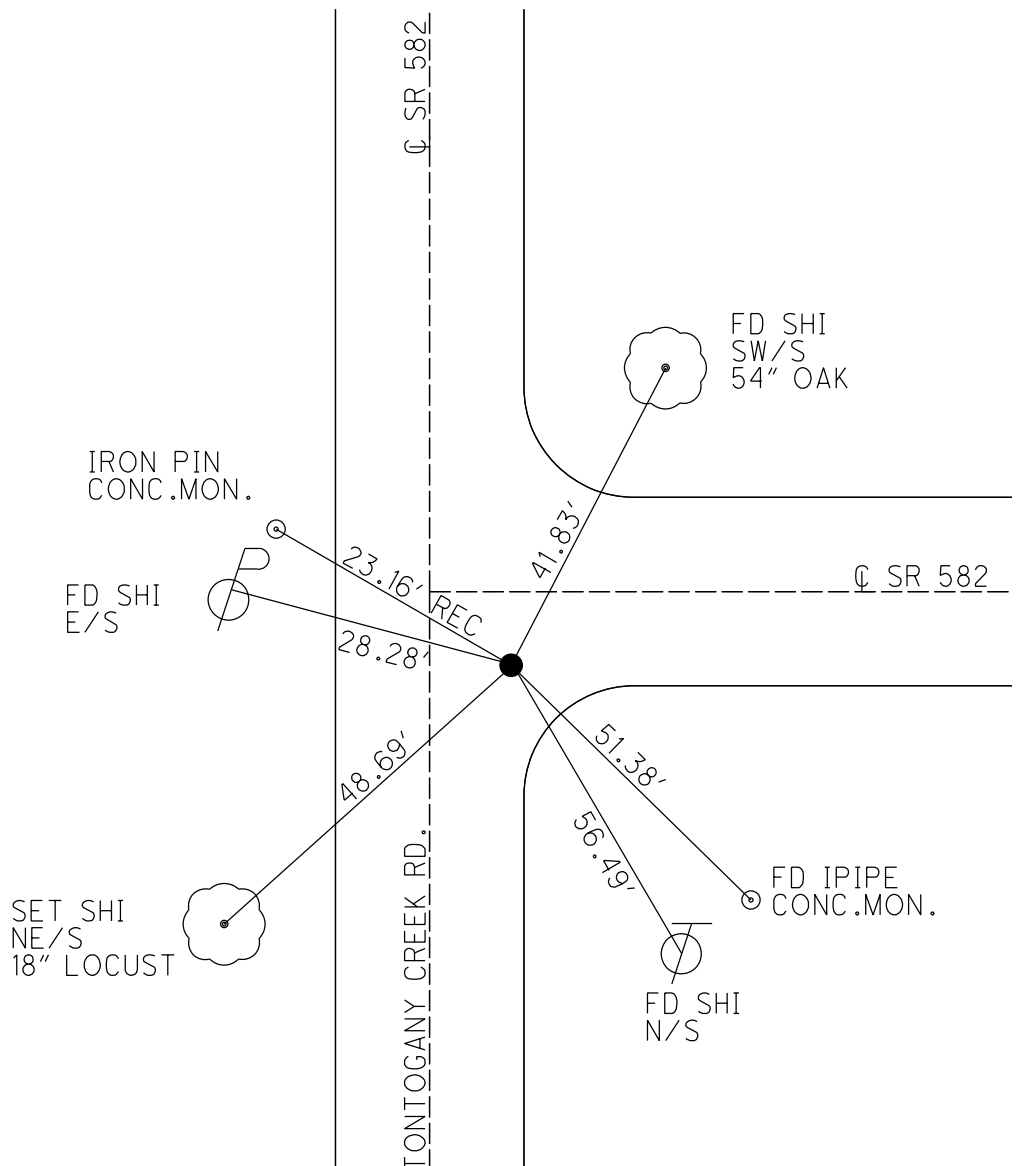

O.D.O.T. DISTRICT 2 SURVEY OFFICE (USE ONLY)

PERSONNEL

REFERENCE NO. 4

SHEET 4 OF 25

NOTES MILLER
H.C. MILLER
R.C. BARRIERE
BLUBAUGH

DATE 8/6/24
WEATHER CLOUDY
TEMP. 75°

ROUTE SR 582
COUNTY WOOD
TOWNSHIP MIDDLETON
SECTION 20
T 6 N R 10 E

DWG BY BARRIERE PID 114849

TYPE MONUMENT MAG WASHER

ON SURFACE - BELOW 0.5" BELOW

OFFSET $\odot$ PAVEMENT 4' ~~LT~~ : RT

TO EDGE PAVEMENT

STATION: 42+86

HORIZ.DATUM: NAD83 (2011)


GEOID: 18

GRID: NORTHING: 655523.362


EASTING: 1629157.607

LDP: NORTHING: 477058.334

EASTING: 139899.094

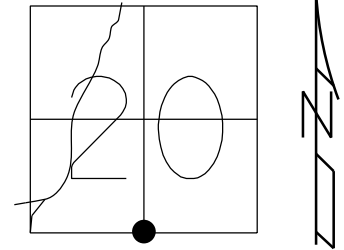

RESET MAG/WASHER
7/31/04, MC
GPS, REF4
4/8/14, TMR
SET MAG/W
7/25/14, EBW
GPS, NEWREF4
7/29/14, JMR
FD MAG/WASH,
REF4
12/7/23, JAM
FD TONE, DID NOT UNCOVER
8/6/24, JAM

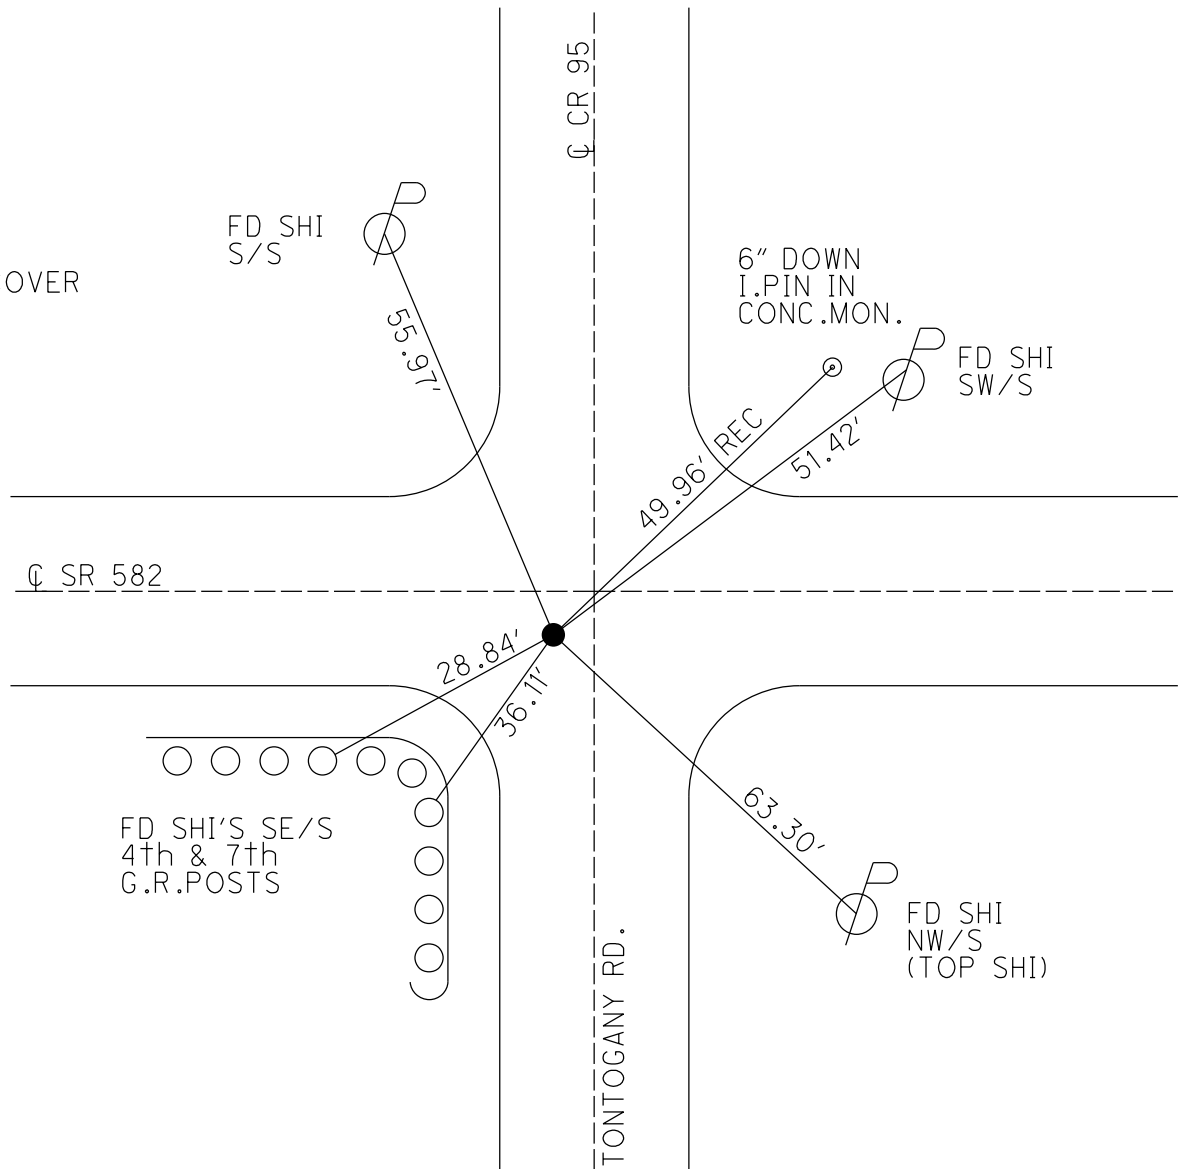

O.D.O.T. DISTRICT 2 SURVEY OFFICE (USE ONLY)

PERSONNEL

REFERENCE NO. 5

SHEET 5 OF 25

NOTES MILLER
H.C. MILLER
R.C. BARRIERE
BLUBAUGH

DATE 8/6/24
WEATHER CLOUDY
TEMP. 75°

ROUTE SR 582
COUNTY WOOD
TOWNSHIP MIDDLETON
SECTION 20

DWG BY BARRIERE PID 114849

T 6 N R 10 E

TYPE MONUMENT MAG WASHER

ON SURFACE - BELOW ON

OFFSET Q PAVEMENT 9.6' LT : RT

2' TO RT EDGE PAVEMENT

STATION: 69+12

HORIZ.DATUM: NAD83 (2011)


GEOID: 18

GRID: NORTHING: 655516.579


EASTING: 1631788.991

LDP: NORTHING: 477086.244

EASTING: 142530.570

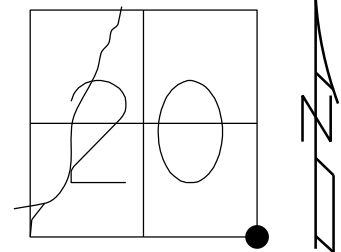

NOTE:
DUG DOWN TO I.PIN. FOUND
LG.R.R.SPIKE 6" DOWN, STILL
APPEARED TO BE SLIDING SOUTH
TOWARDS DITCH. CONTINUED TO
I.PIN FOUND AT 12".
RESET MAG/WASHER
7/31/04, MC
FND, 2/14/14
FD MAG/W
GPS, REF5
4/8/14, TMR
SET MAG/W
GPS, NEWREF5
7/29/14, JMR
FD MAG SHANK
REF5
12/7/23, JAM
SET MAG/WASHER
8/6/24, JAM

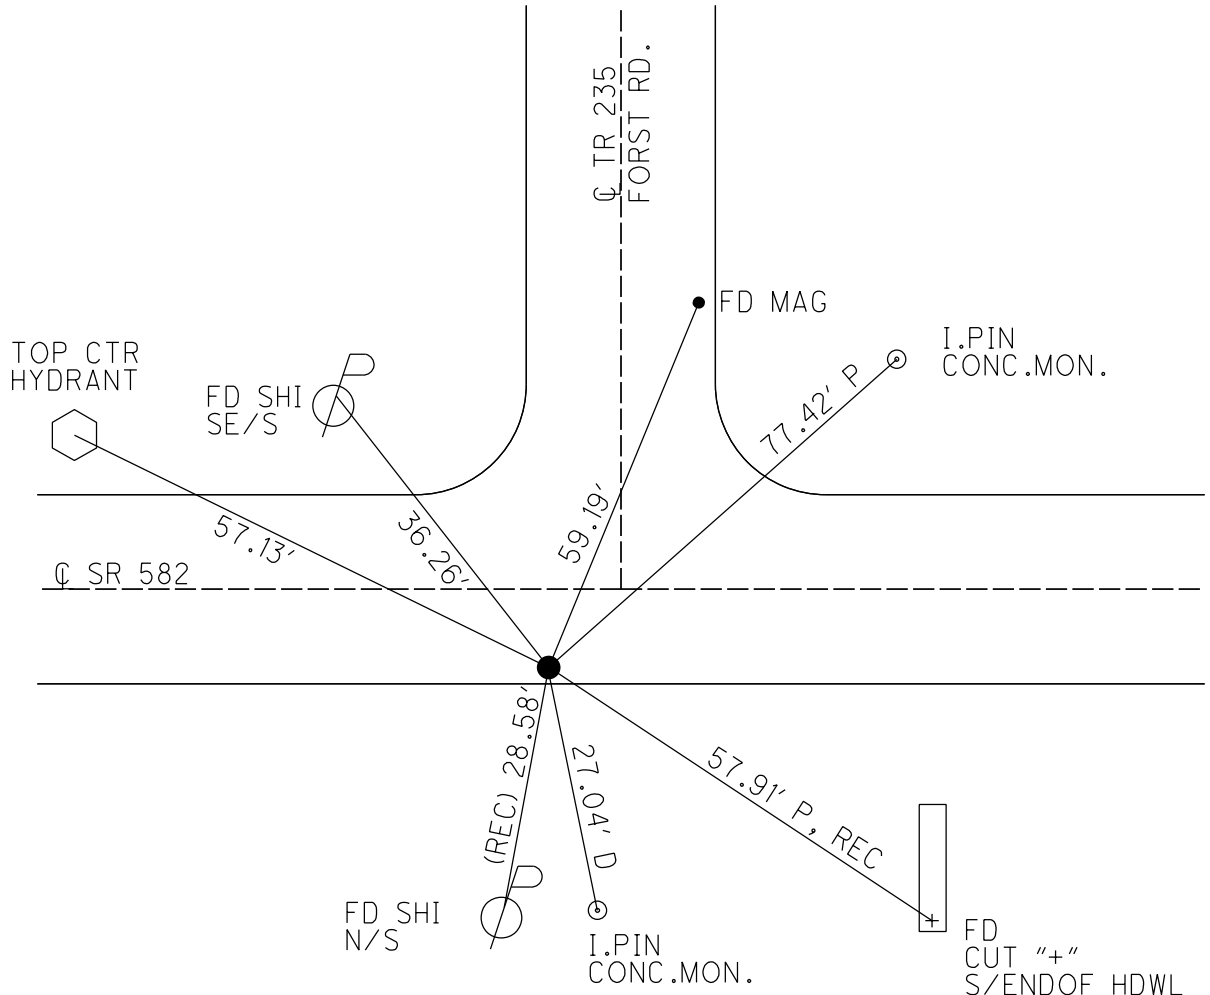

O.D.O.T. DISTRICT 2 SURVEY OFFICE (USE ONLY)

PERSONNEL

REFERENCE NO. 6

SHEET 6 OF 25

NOTES MILLER
H.C. MILLER
R.C. BARRIERE
BLUBAUGH

DATE 8/6/24
WEATHER CLOUDY
TEMP. 75°

ROUTE SR 582
COUNTY WOOD
TOWNSHIP MIDDLETON
SECTION 21
T 6 N R 10 E

DWG BY BARRIERE PID 114849

TYPE MONUMENT MAG WASHER

ON SURFACE - BELOW 0.5" BELOW

OFFSET $\angle$ PAVEMENT 8.6' ~~LT~~ : RT

TO EDGE PAVEMENT

STATION: 82+63

HORIZ.DATUM: NAD83 (2011)


GEOID: 18

GRID: NORTHING: 655498.899


EASTING: 1633128.494

LDP: NORTHING: 477086.170

EASTING: 143870.258

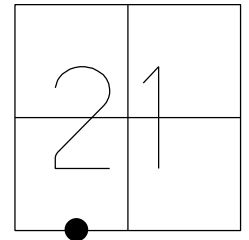

RESET MAG/WASHER
7/30/04, MC
FND, 3/14/14
FD MAG/W
GPS, REF6
4/8/14, TMR
SET MAG/W
GPS, NEWREF6
7/29/14, JMR
FD MAG/WASH
REF6
12/7/23, JAM
FD TONE, DID NOT UNCOVER
8/6/24, JAM

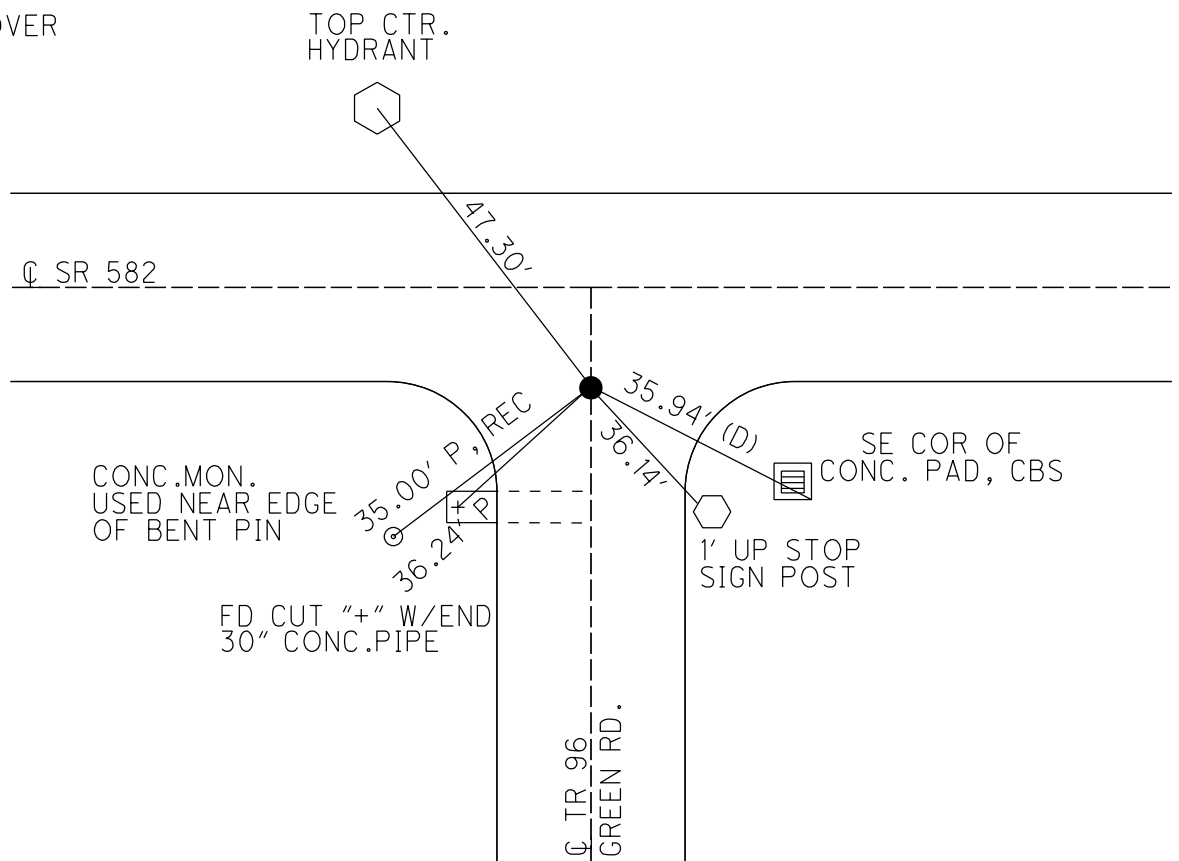

O.D.O.T. DISTRICT 2 SURVEY OFFICE (USE ONLY)

PERSONNEL

REFERENCE NO. 7

SHEET 7 OF 25

NOTES MILLER
H.C. MILLER
R.C. BARRIERE
BLUBAUGH

DATE 8/6/24
WEATHER CLOUDY
TEMP. 75°

ROUTE SR 582
COUNTY WOOD
TOWNSHIP MIDDLETON
SECTION 21

DWG BY BARRIERE PID 114849

T 6 N R 10 E

TYPE MONUMENT MAG WASHER

ON SURFACE - BELOW 0.5" BELOW

OFFSET $\odot$ PAVEMENT 3.1' ~~LT~~ : RT

TO EDGE PAVEMENT

STATION: 96+00

HORIZ.DATUM: NAD83 (2011)


GEOID: 18

GRID: NORTHING: 655481.119


EASTING: 1634468.795

LDP: NORTHING: 477086.080

EASTING: 145210.706

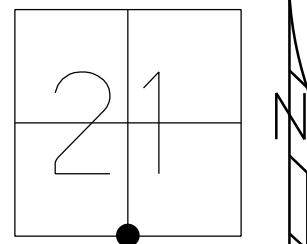

FD SM RR SPIKE
4/20/04, M.B.
RESET MAG/WASHER
8/2/04, MC
FND, 3/14/14
FD MAG/W
GPS, RE7
4/8/14, TMR
SET MAG/W
7/25/14, EBW
GPS, NEWREF7
7/29/14, JMR
FD MAG/WASHER
REF7
12/7/23, JAM
FD TONE, DID NOT UNCOVER
8/6/24, JAM

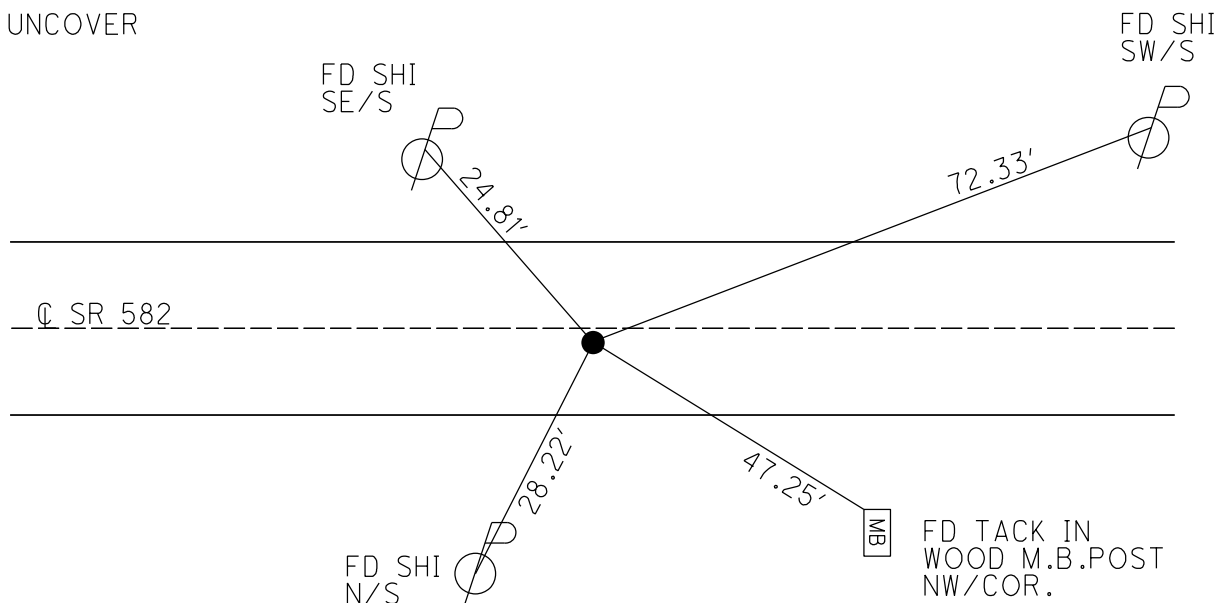

O.D.O.T. DISTRICT 2 SURVEY OFFICE (USE ONLY)

PERSONNEL

REFERENCE NO. 8

SHEET 8 OF 25

NOTES MILLER
H.C. MILLER
R.C. BARRIERE
BLUBAUGH

DATE 8/6/24
WEATHER CLOUDY
TEMP. 75°

ROUTE SR 582
COUNTY WOOD
TOWNSHIP MIDDLETON
SECTION 21
T 6 N R 10 E

DWG BY BARRIERE PID 114849

TYPE MONUMENT MAG WASHER

ON SURFACE - BELOW 0.5" BELOW

OFFSET Q PAVEMENT 4.35' ~~LT~~ : RT
4.7' TO RT EDGE PAVEMENT

STATION: 109+65

HORIZ.DATUM: NAD83 (2011)


GEOID: 18

GRID: NORTHING: 655444.988


EASTING: 1635834.551

LDP: NORTHING: 477067.925

EASTING: 146576.986

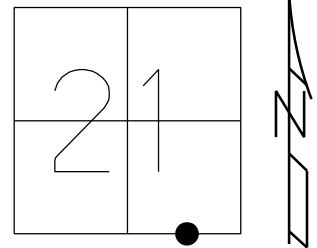

RECORD:
FD 1" IRON PIPE
2" BELOW SURFACE
4.3" N.OF SOUTH E.O.P.
SET MAG/WASHER
7/30/04, MC
FND, 3/14/14
SET MAG/W
GPS, NEWREF8
7/29/14, JMR
FD MAG/WASH
REF8
12/7/23, JAM
FD TONE, DID NOT UNCOVER
8/6/24, JAM

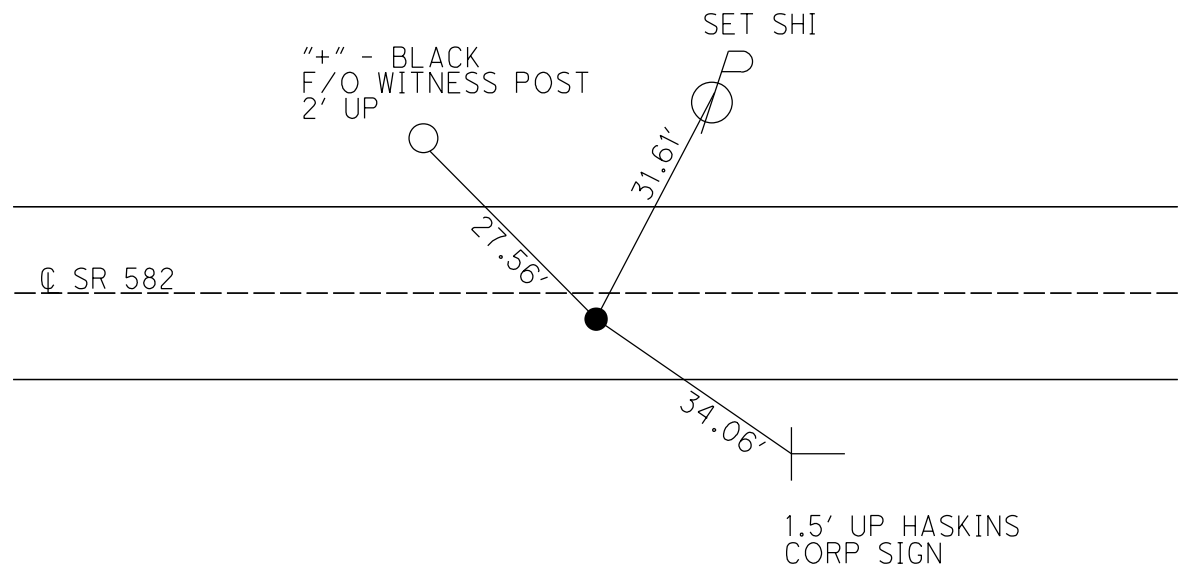

O.D.O.T. DISTRICT 2 SURVEY OFFICE (USE ONLY)

PERSONNEL

REFERENCE NO. 9

SHEET 9 OF 25

NOTES MILLER

DATE 8/6/24

ROUTE SR 582

H.C. MILLER

WEATHER CLOUDY

COUNTY WOOD

R.C. BARRIERE

TEMP. 75°

TOWNSHIP MIDDLETON

BLUBAUGH

SECTION 21

DWG BY BARRIERE

PID 114849

T 6 N R 10 F

TYPE MONUMENT MAG WASHER

ON SURFACE - BELOW ON

OFFSET C PAVEMENT OF 582 EAST LT : RT

_____TO_____EDGE PAVEMENT

STATION: 123+33, 2.6' C TO WEST, 7.4' W. OF C NORTH


HORZ.DATUM: NAD83 (2011)

GEOID: 18

GRID: NORTHING: 655408.881

EASTING: 1637200.454

LDP: NORTHING: 477049.791

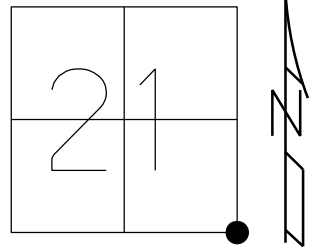EASTING: 147943.328

RECORD:
POINT NOT COVERED

8/2/04, MC
DNF, STAKE OUT
3/14/14

GPS, REF9


4/8/14, TMR
NOT COVERED

7/29/14, JMR
D.N.F. - TIES CROSSED FD SHI
12/17/27 TON

12/7/23, TDN
SET MAG/WASH
REF9

12/8/23, JAM
FD MAG/WASH

8/6/24, JAM

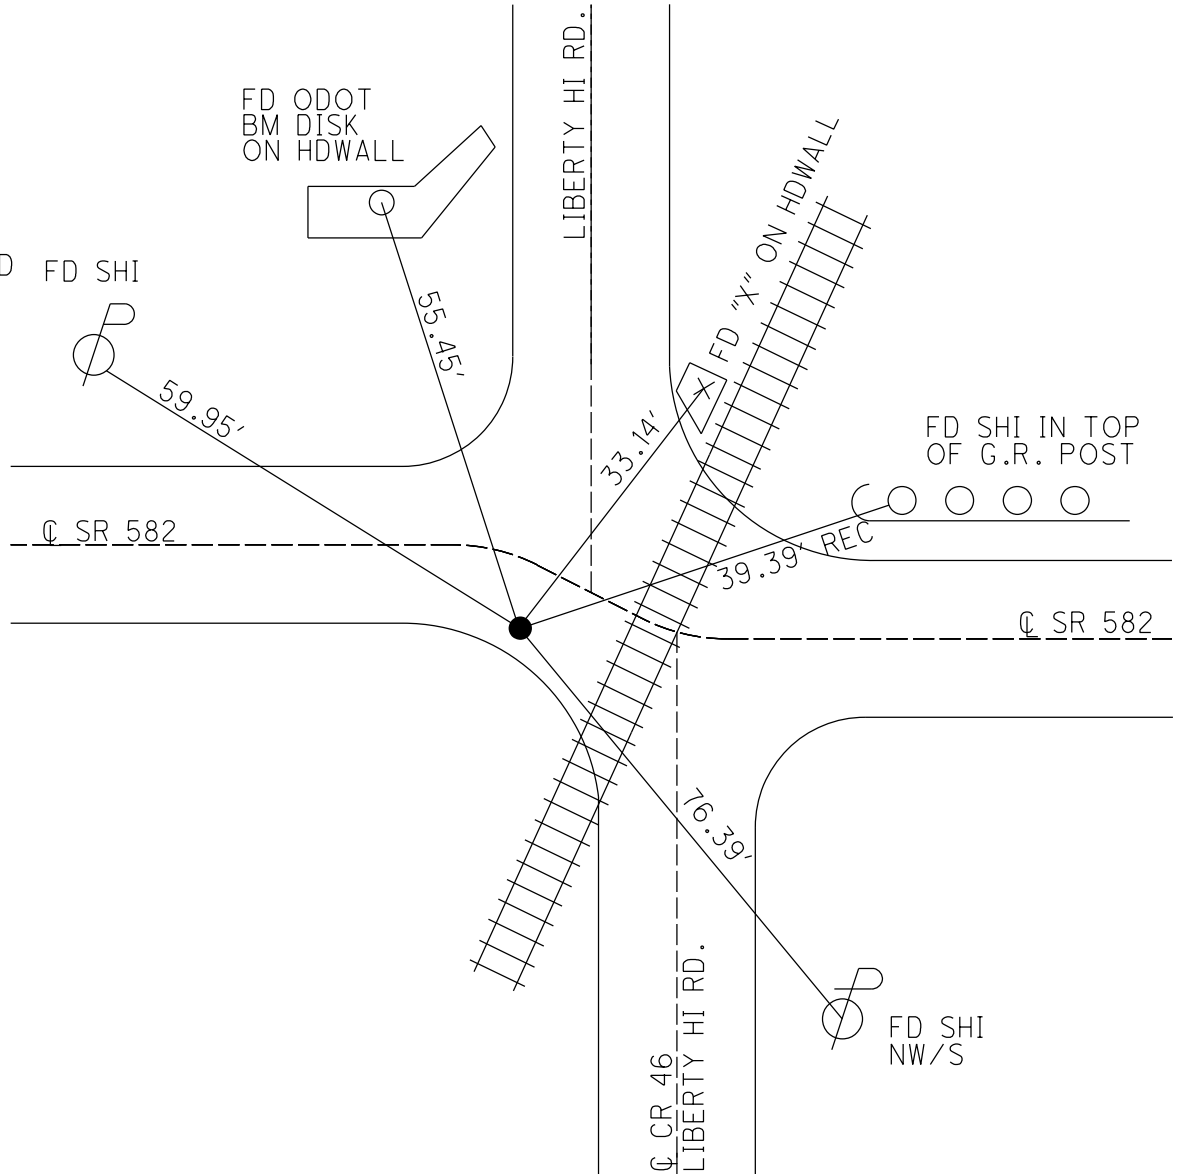

O.D.O.T. DISTRICT 2 SURVEY OFFICE (USE ONLY)

PERSONNEL

REFERENCE NO. 9A

SHEET 10 OF 25

NOTES MILLER

DATE 8/6/24

ROUTE SR 582

H.C. MILLER

WEATHER CLOUDY

COUNTY WOOD

R.C. BARRIERE

TEMP. 75°

TOWNSHIP MIDDLETON

BLUBAUGH

SECTION 22

DWG BY BARRIERE

PID 114849

T 6 N R 10 E

TYPE MONUMENT MAG WASHER

~~ON SURFACE~~ - BELOW 0.5"

OFFSET Q PAVEMENT 7.0' LT : ~~RT~~

1.7' TO LT EDGE PAVEMENT

STATION: 135+00

HORIZ.DATUM: NAD83 (2011)


GEOID: 18

GRID: NORTHING: 655378.107


EASTING: 1638364.582

LDP: NORTHING: 477034.448

EASTING: 149107.805

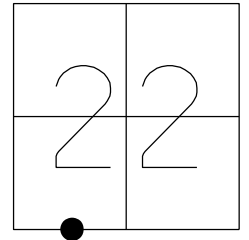


RECORD:
BRIDGE CONTROL
STA. 135+00
SET MAG/WASHER
8/2/04, MC
FND, 3/14/14
FD MAG NAIL
GPS, REFA9
4/8/14, DCH
SET MAG/W FROM TIES
7/29/14, EBW
GPS, NEWREFA9
7/29/14, JMR
FD MAG/WASH
REF9A
12/7/23, JAM
FD TONE, DID NOT UNCOVER
8/6/24, JAM

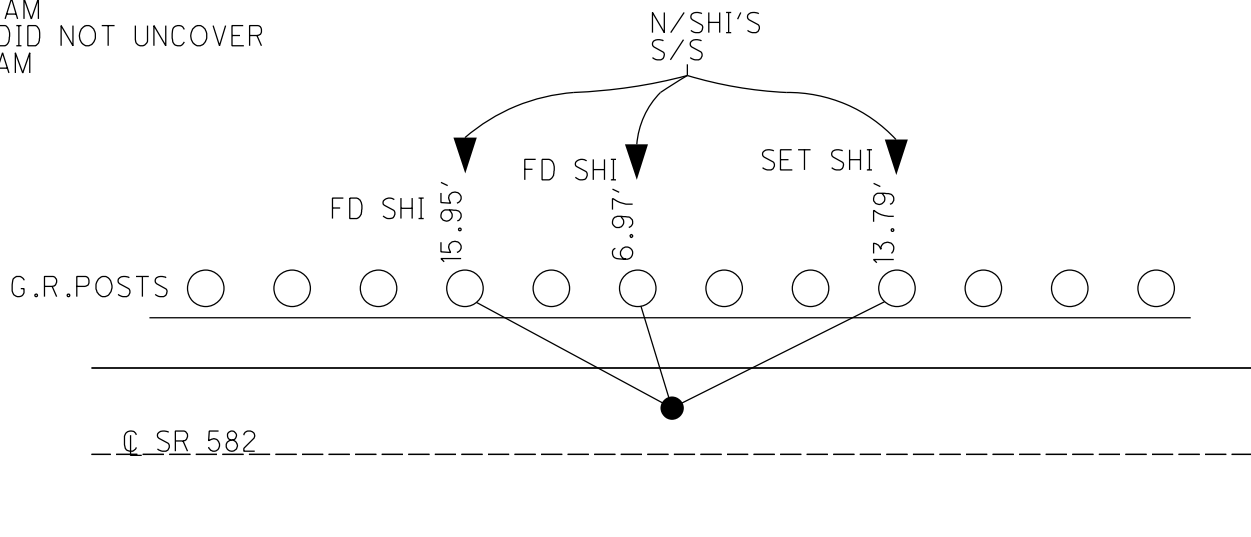

O.D.O.T. DISTRICT 2 SURVEY OFFICE (USE ONLY)

PERSONNEL	REFERENCE NO. <u>9B</u>	SHEET <u>11</u> OF <u>25</u>
NOTES	DATE <u>4/8/14</u>	ROUTE <u>SR 582</u>
H.C. <u>RHOADES</u>	WEATHER <u>FAIR</u>	COUNTY <u>WOOD</u>
R.C. <u>HOMAN</u>	TEMP. <u>53°</u>	TOWNSHIP <u>MIDDLETON</u>
<u>ROUSOS</u>		SECTION <u>27</u>
<u>GABLE</u>		T <u>6</u> N R <u>10</u> E

TYPE MONUMENT MAG/W
 ON SURFACE - ~~BELOW~~ ON
 LEFT - Q PAV'T - RIGHT ON
TO EDGE PAVEMENT
 S.L.M. (476+82) SR 64

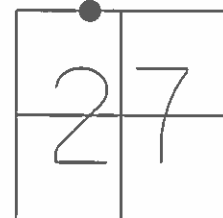


Grid: Northing: 655370.895 Easting: 1638681.973

RECORD:
 SM.R.R.SPIKE
 PI= 110+89.9
 Δ= 0°-07' LT

NOT COVERED
 8/2/04, MC

NOT IN PROJECT
 3/14/14

GPS, REFB9
 4/8/14, TMR

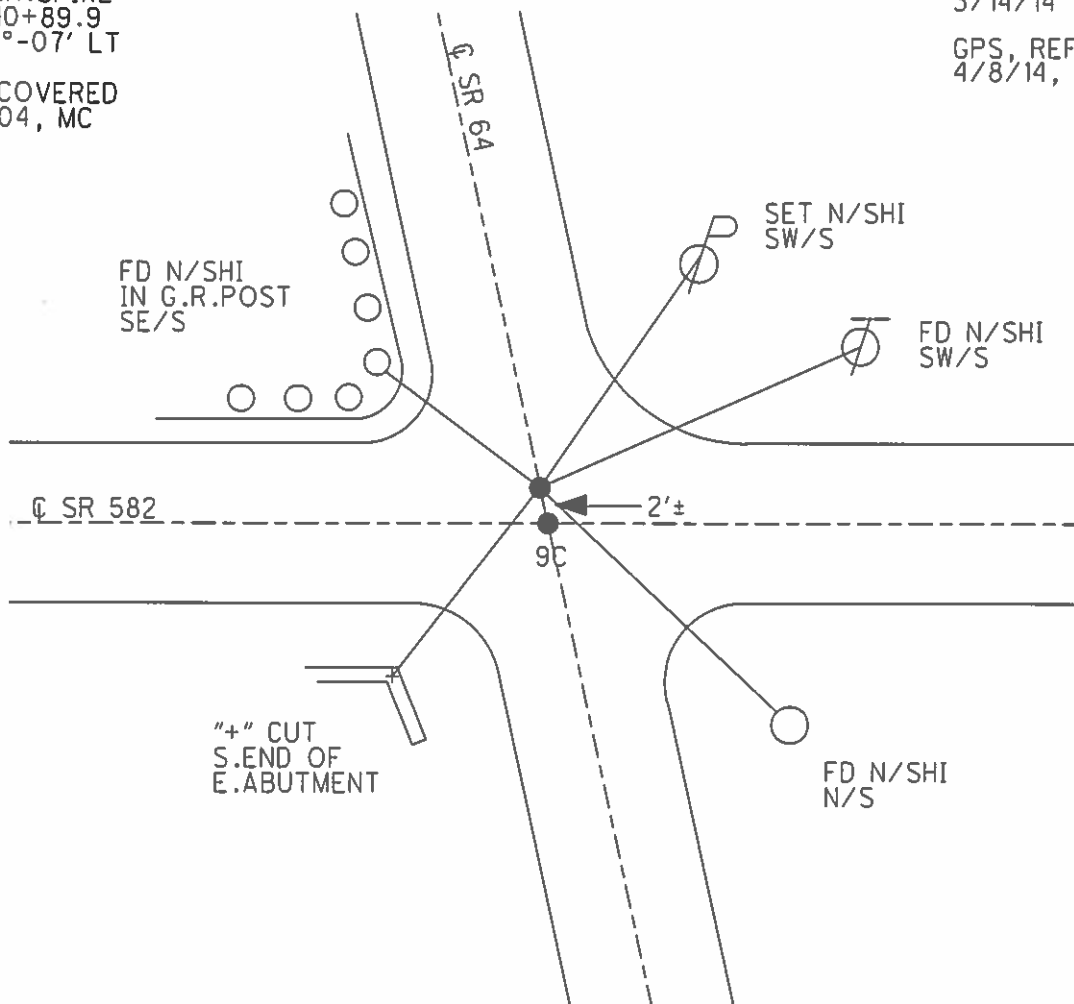

O.D.O.T. DISTRICT 2 SURVEY OFFICE (USE ONLY)

PERSONNEL

REFERENCE NO.

9C

SHEET 12 OF 25

NOTES RHOADESDATE 4/8/14ROUTE SR 582

H.C. HOMAN

WEATHER FAIR

COUNTY WOOD

R.C. ROUSOS

TEMP. 53°

TOWNSHIP MIDDLETONGABLESECTION 27

T_6_N R_10_E

TYPE MONUMENT MAG/WASHER


ON SURFACE - ~~BELOW~~ ON

LEFT - Q PAV'T - RIGHT__ON

____ TO ____ EDGE PAVEMENT

S.L.M. 476+84 (SR 64)

Grid: Northing: 655369.158 Easting: 1638682.243

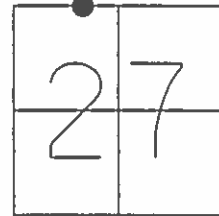


FD P.K.SHANK
ON SECTION LINE
E.-W. ON TANGENT
LINE OF SR 64

NOT COVERED
8/2/04, MC

NOT IN PROJECT
3/14/14

GPS, REFC9
4/8/14, TMR

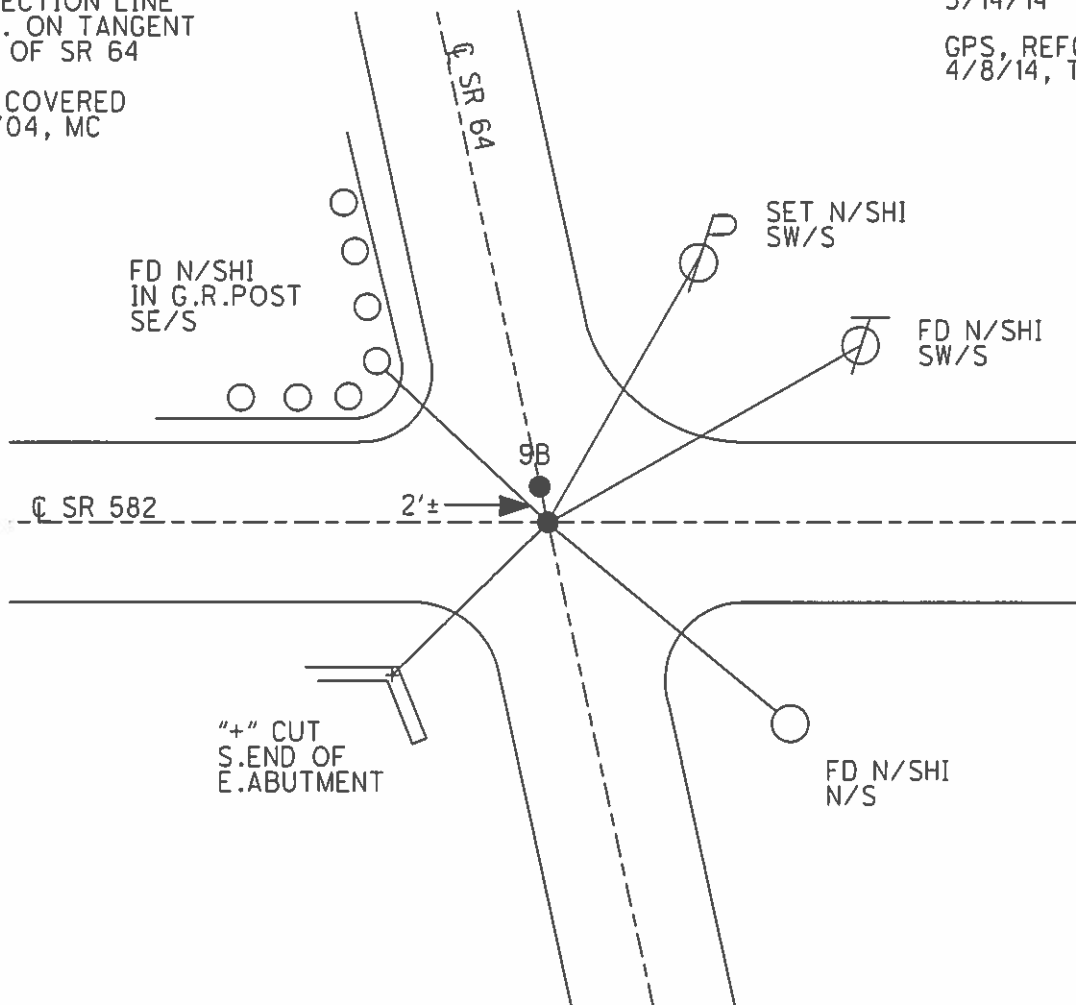

O.D.O.T. DISTRICT 2 SURVEY OFFICE (USE ONLY)

PERSONNEL

REFERENCE NO. 11

SHEET 13 OF 25

NOTES MILLER
H.C. MILLER
R.C. BARRIERE
BLUBAUGH

DATE 8/6/24
WEATHER CLOUDY
TEMP. 75°

ROUTE SR 582
COUNTY WOOD
TOWNSHIP MIDDLETON
SECTION 22

DWG BY BARRIERE PID 114849

T 6 N R 10 E

TYPE MONUMENT MAG WASHER

ON SURFACE - BELOW ON

OFFSET Q PAVEMENT 7' LT : RT

3.2' TO RT EDGE PAVEMENT

STATION: 150+10

HORIZ.DATUM: NAD83 (2011)


GEOID: 18

GRID: NORTHING: 655337.098

EASTING: 1639873.605

LDP: NORTHING: 477013.301

EASTING: 150617.371

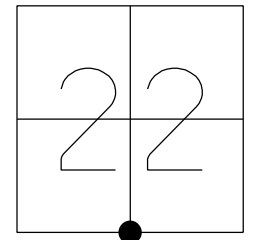

FLAG POLE
1' UP


CUT "+"
OF M.H.
RIM E/S

FD "+" TOP
S. BOLT ON
BONNET F.H.

FD SHI
S/S

SET SHI
16" MAPLE

SET MAG/WASHER
8/2/04, MC
FND MAG/WASHER
GPS, REF11
3/14/14, DCH
SET MAG/WASHER
7/29/14, EBW
GPS, NEWREF11
7/29/14, JMR
FD MAG/WASH
REF11
12/8/23, JAM
FD MAG/WASH
8/6/24, JAM

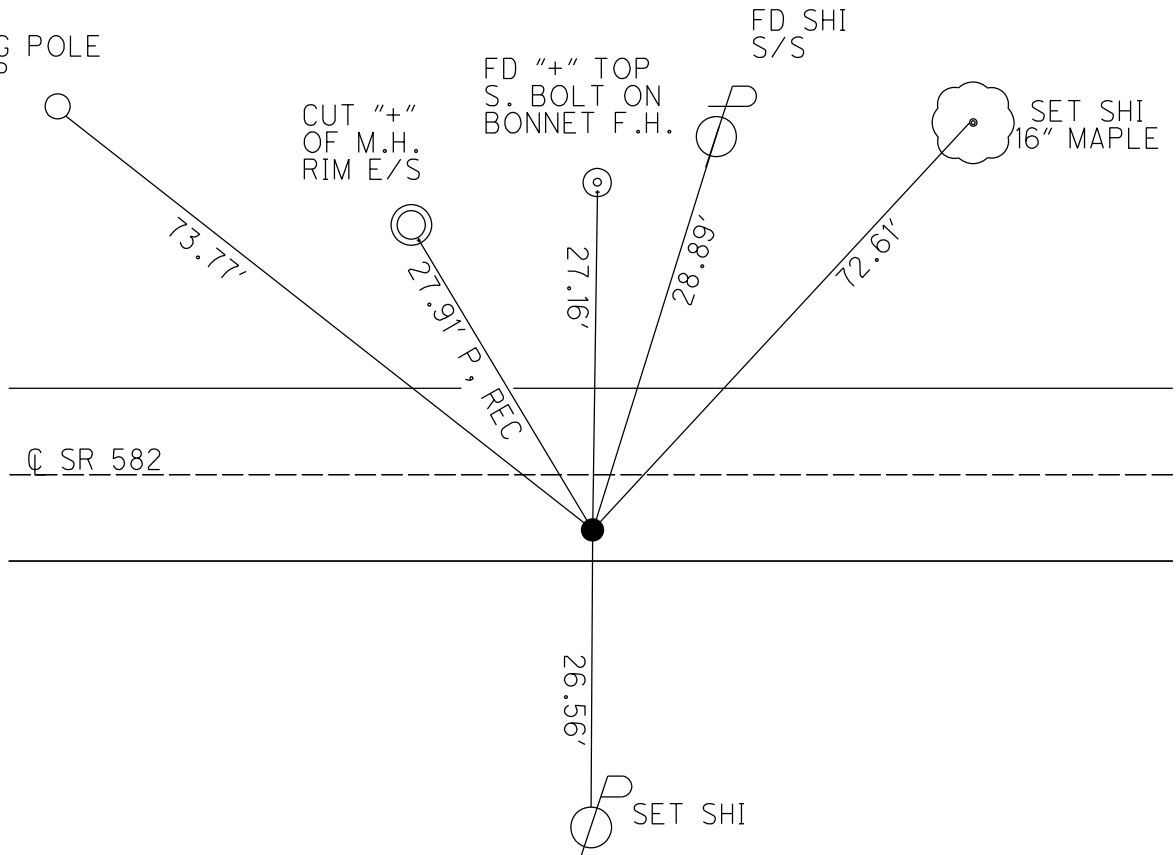

O.D.O.T. DISTRICT 2 SURVEY OFFICE (USE ONLY)

PERSONNEL

REFERENCE NO. 12

SHEET 14 OF 25

NOTES MILLER
H.C. MILLER
R.C. BARRIERE
BLUBAUGH

DATE 8/6/24
WEATHER CLOUDY
TEMP. 75°

ROUTE SR 582
COUNTY WOOD
TOWNSHIP MIDDLETON
SECTION 22
T 6 N R 10 E

DWG BY BARRIERE PID 114849

TYPE MONUMENT MAG WASHER

ON SURFACE - ~~BELOW~~ ON

OFFSET CL PAVEMENT 5.8' ~~LT~~ : RT

3.5' TO RT EDGE PAVEMENT

STATION: 150+10, 7.5' EAST OF CL SOUTH

HORIZ.DATUM: NAD83 (2011)



GEOID: 18

GRID: NORTHING: 655262.814

EASTING: 1642554.999

LDP: NORTHING: 476974.399

EASTING: 153299.676

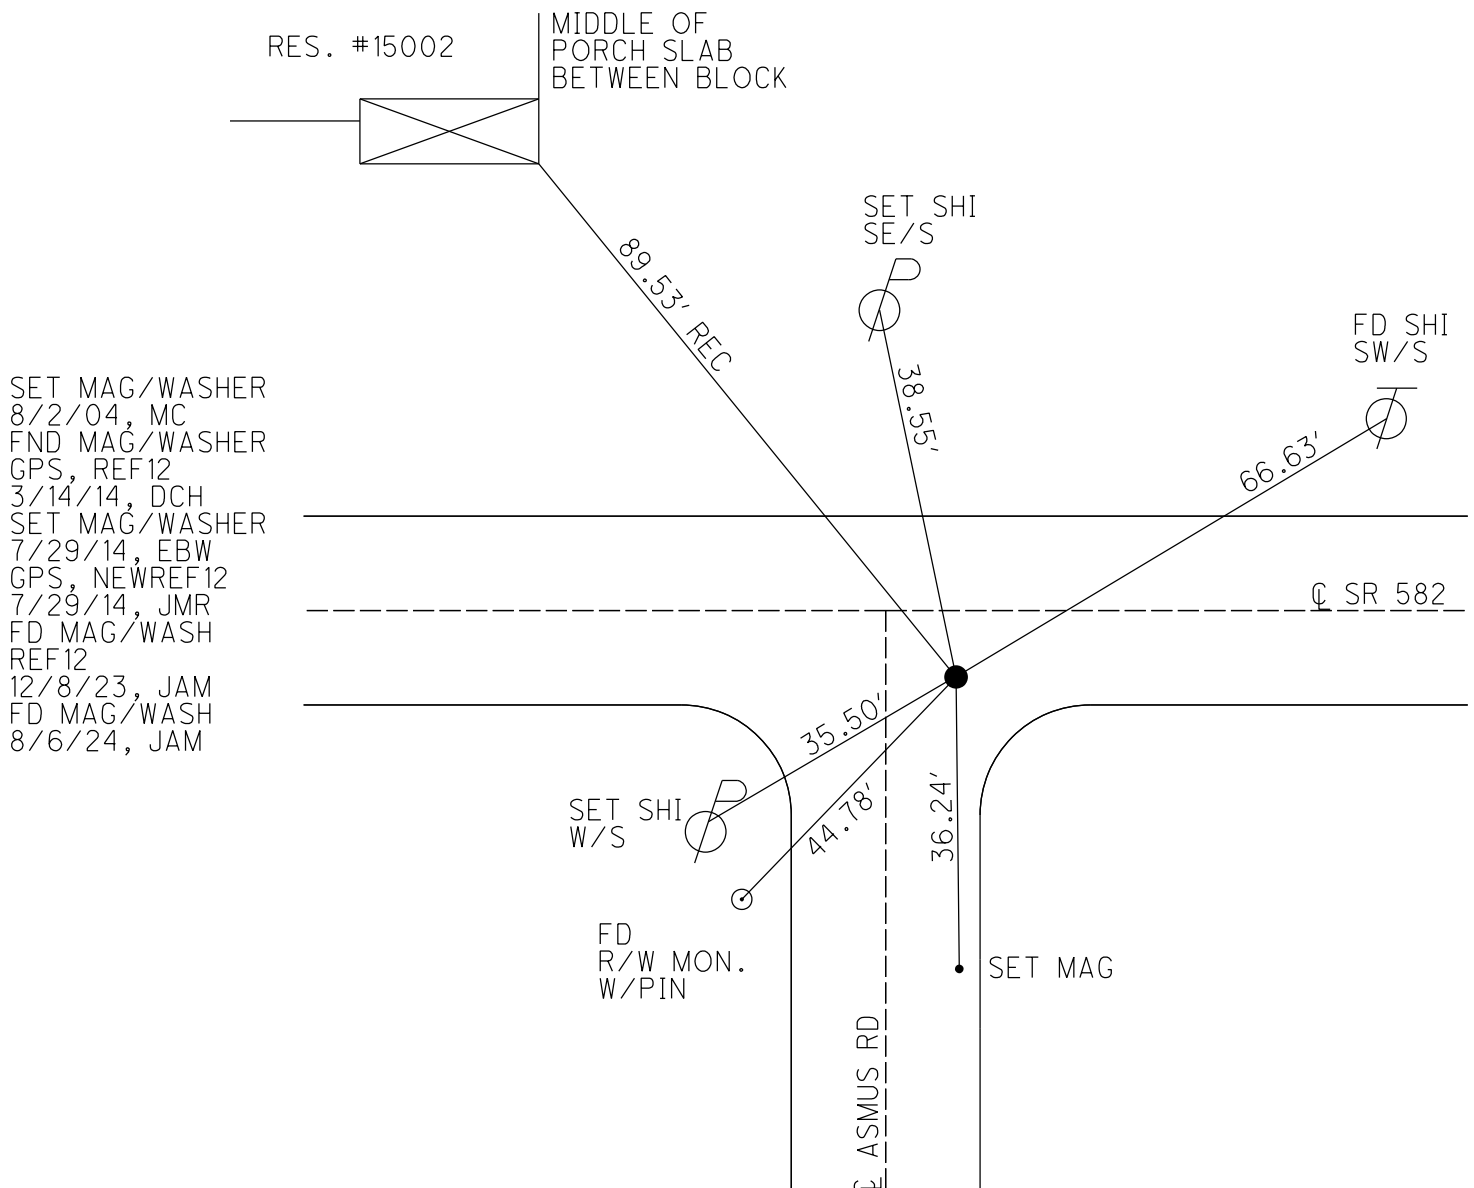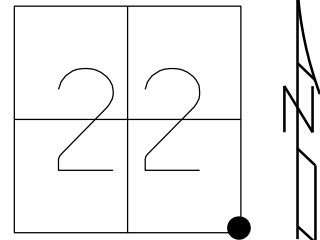

O.D.O.T. DISTRICT 2 SURVEY OFFICE (USE ONLY)

PERSONNEL

REFERENCE NO. 13

SHEET 15 OF 25

NOTES MILLER
H.C. MILLER
R.C. BARRIERE
BLUBAUGH

DATE 8/6/24
WEATHER CLOUDY
TEMP. 75°

ROUTE SR 582
COUNTY WOOD
TOWNSHIP MIDDLETON
SECTION 23

DWG BY BARRIERE PID 114849

T 6 N R 10 E

TYPE MONUMENT MAG WASHER

ON SURFACE - BELOW 0.5" BELOW

OFFSET Q PAVEMENT 3.0 ~~LT~~ : RT

7.7' TO RT EDGE PAVEMENT

STATION: 203+00

HORIZ.DATUM: NAD83 (2011)


GEOID: 18

GRID: NORTHING: 655196.693


EASTING: 1645199.835


LDP: NORTHING: 476943.122

EASTING: 155945.340

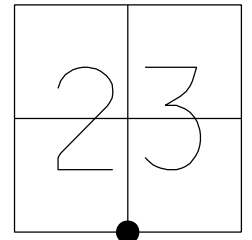

SET MAG/WASHER
8/2/04, MC
FND MAG/WASHER
GPS, REF13
3/14/14, DCH
SET MAG/WASHER
7/29/14, EBW
GPS, NEWREF13
7/29/14, JMR
FD MAG/WASH
REF13
12/8/23, JAM
FD TONE, DID NOT UNCOVER
8/6/24, JAM

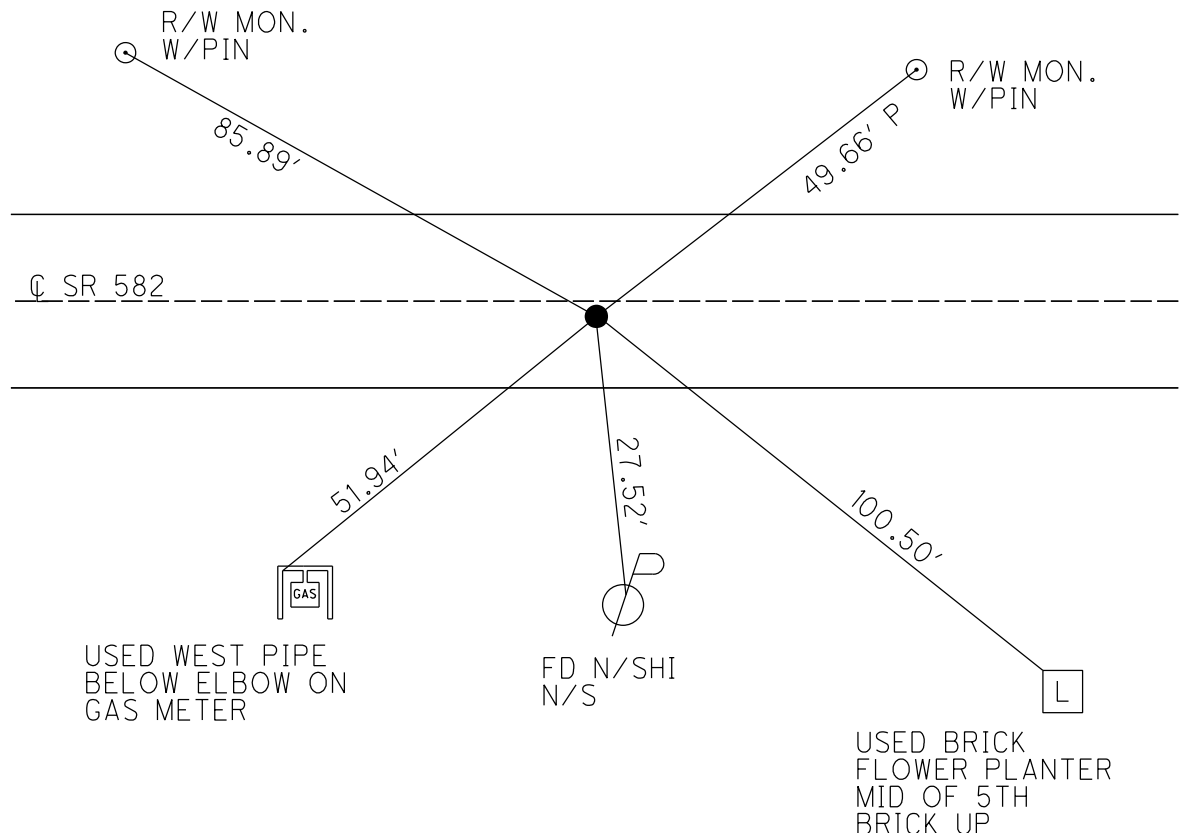

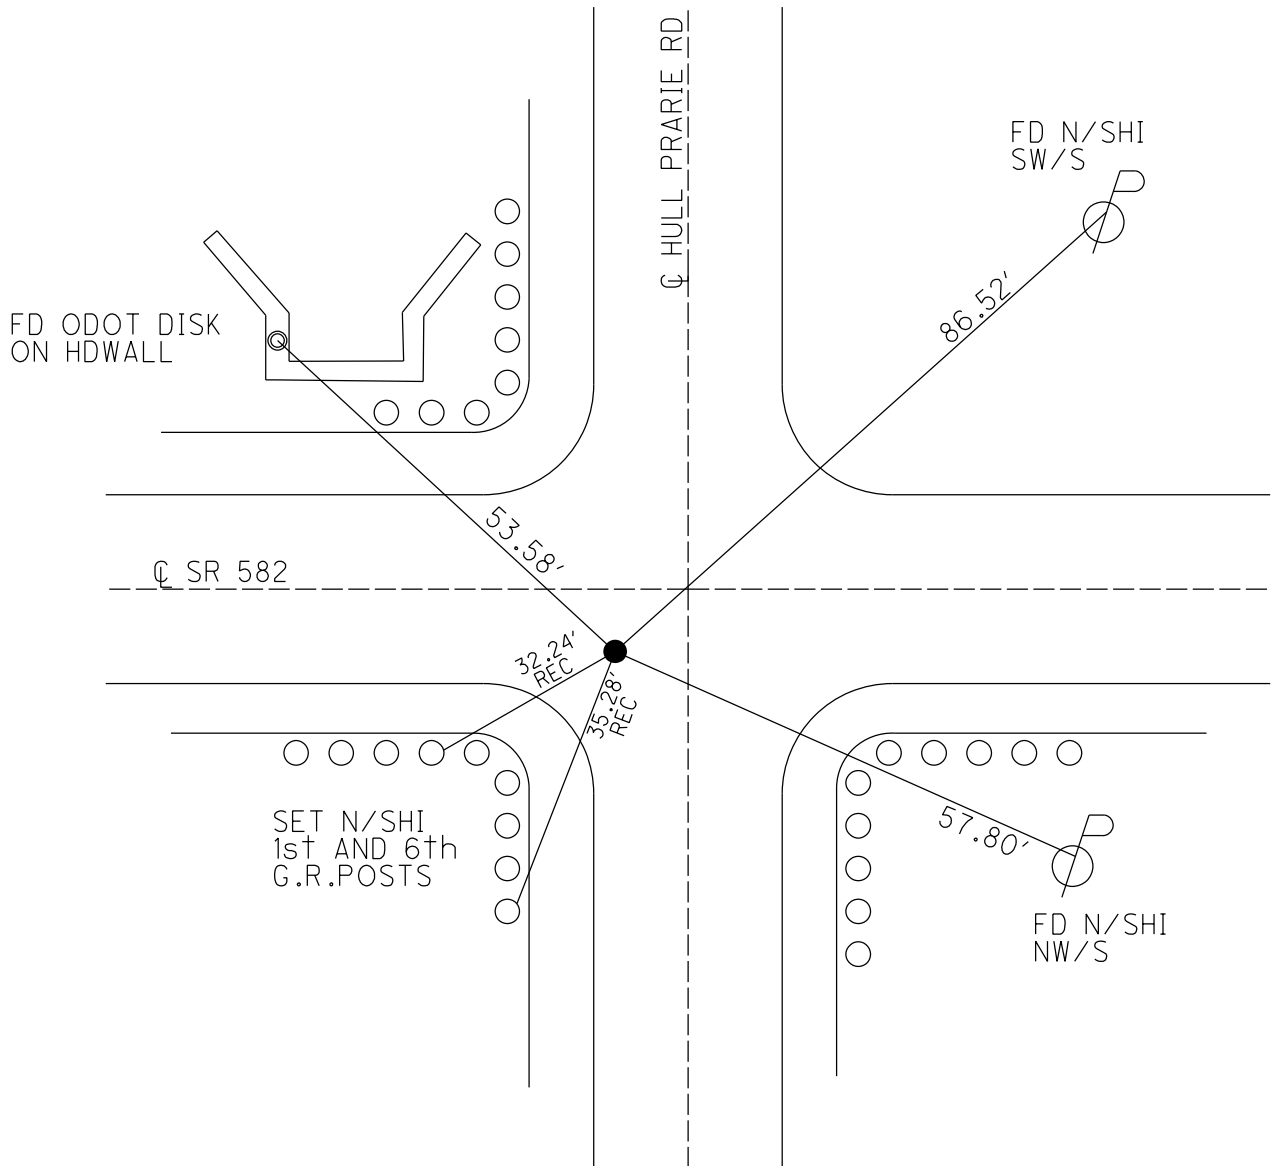

O.D.O.T. DISTRICT 2 SURVEY OFFICE (USE ONLY)

PERSONNEL

REFERENCE NO. 15

SHEET 17 OF 25

NOTES MILLER
H.C. MILLER
R.C. BARRIERE
BLUBAUGH

DATE 8/6/24
WEATHER CLOUDY
TEMP. 75°

ROUTE SR 582
COUNTY WOOD
TOWNSHIP MIDDLETON
SECTION 25

DWG BY BARRIERE PID 114849

T 6 N R 10 E

TYPE MONUMENT MAG/WASHER

~~ON SURFACE~~ - BELOW 0.5"

OFFSET Q PAVEMENT 8.0' ~~LT~~ : RT

2' TO RT EDGE PAVEMENT

STATION: 229+64

HORIZ.DATUM: NAD83 (2011)


GEOID: 18

GRID: NORTHING: 655110.046


EASTING: 1647860.010

LDP: NORTHING: 476891.512

EASTING: 158606.568

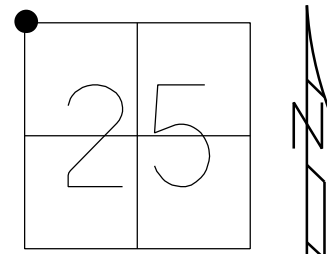

RS.#14028

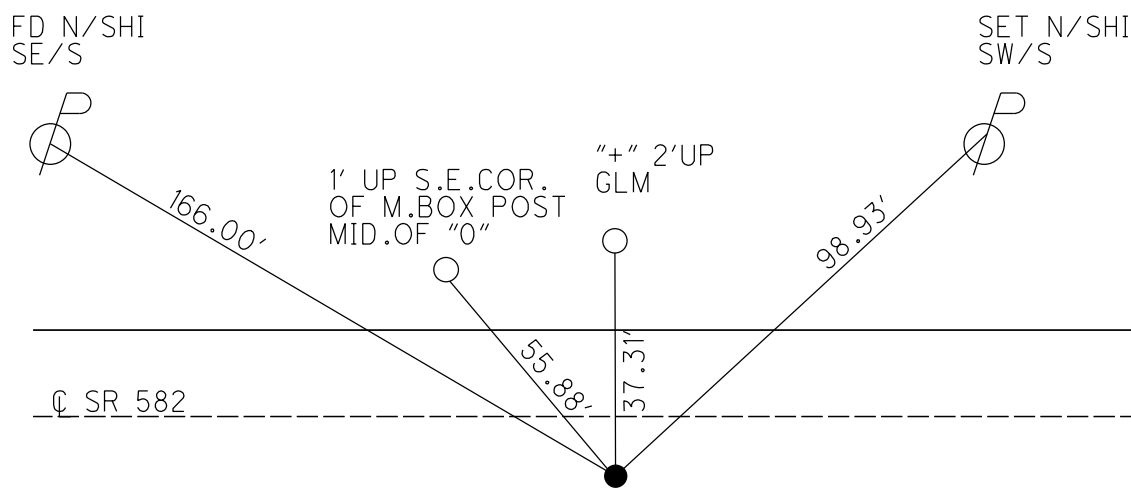

SET MAG/WASHER
7/30/04, MC
FND MAG/WASHER
GPS, REF15
3/14/14, DCH
SET MAG/WASHER
GPS, NEWREF15
7/29/14, EBW
FD MAG/WASH
REF15
12/8/23, JAM
FD TONE, DID NOT UNCOVER
8/6/24, JAM

O.D.O.T. DISTRICT 2 SURVEY OFFICE (USE ONLY)

PERSONNEL

REFERENCE NO. 16

SHEET 18 OF 25

NOTES MILLER
H.C. MILLER
R.C. BARRIERE
BLUBAUGH

DATE 8/6/24
WEATHER CLOUDY
TEMP. 75°

ROUTE SR 582
COUNTY WOOD
TOWNSHIP MIDDLETON
SECTION 24

DWG BY BARRIERE PID 114849

T 6 N R 10 E

TYPE MONUMENT MAG/WASHER

~~ON SURFACE~~ - BELOW 0.5" BELOW

OFFSET 6.0' ~~LT~~ : RT

3.8' TO RT EDGE PAVEMENT

STATION: 255+26.70, 15.5' W PF $\oslash$ PARGILLIS RD

HORZ.DATUM: NAD83 (2011)


GEOID: 18

GRID: NORTHING: 655026.899


EASTING: 1650422.306

LDP: NORTHING: 476842.179

EASTING: 161169.922

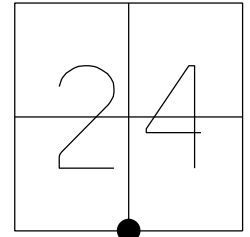

FD SM.R.R.SPIKE
4/26/04, MC
SET MAG/WASHER
7/30/04, MC
FND MAG/WASHER
GPS, REF16
3/14/14, DCH
SET MAG/WASHER
GPS, NEWREF16
7/29/14, EBW
FD MAG/WASH
REF16
12/8/23, JAM
8/6/24, JAM

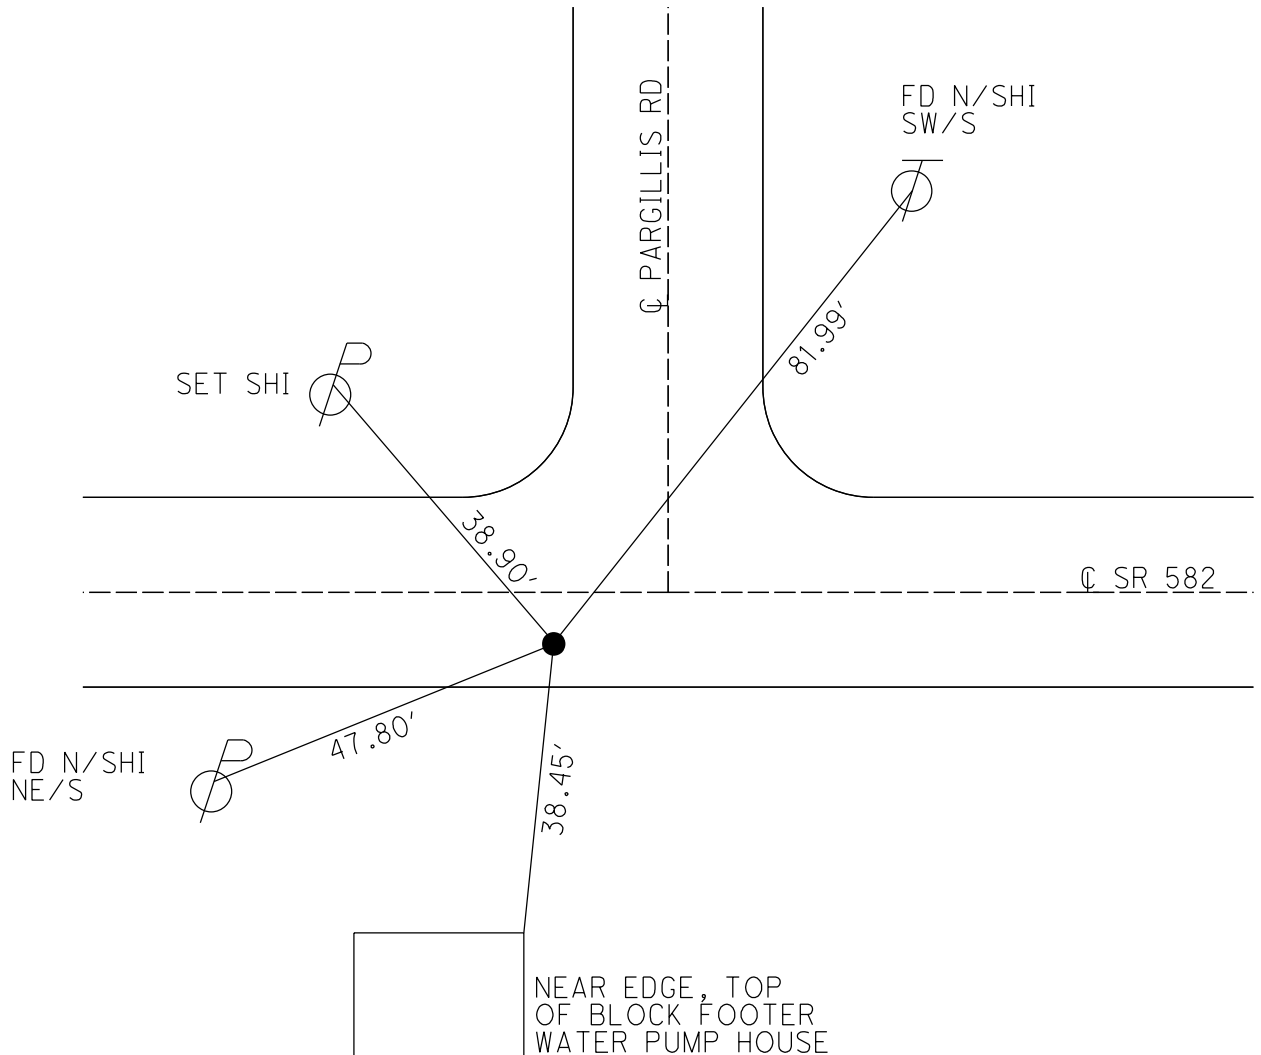

O.D.O.T. DISTRICT 2 SURVEY OFFICE (USE ONLY)

PERSONNEL

REFERENCE NO. 17

SHEET 19 OF 25

NOTES MILLER
H.C. MILLER
R.C. BARRIERE
BLUBAUGH

DATE 8/6/24
WEATHER CLOUDY
TEMP. 75°

ROUTE SR 582
COUNTY WOOD
TOWNSHIP MIDDLETON
SECTION 24

DWG BY BARRIERE PID 114849

T 6 N R 10 E

TYPE MONUMENT MONBOX

ON SURFACE - ~~BELOW~~ ON

OFFSET Q PAVEMENT 3.1' ~~LT~~ : RT

7.5' TO RT EDGE PAVEMENT

STATION: 281+15.59

HORIZ.DATUM: NAD83 (2011)



GEOID: 18

GRID: NORTHING: 655237.678

EASTING: 1642379.623

LDP: NORTHING: 476786.593

EASTING: 163758.186

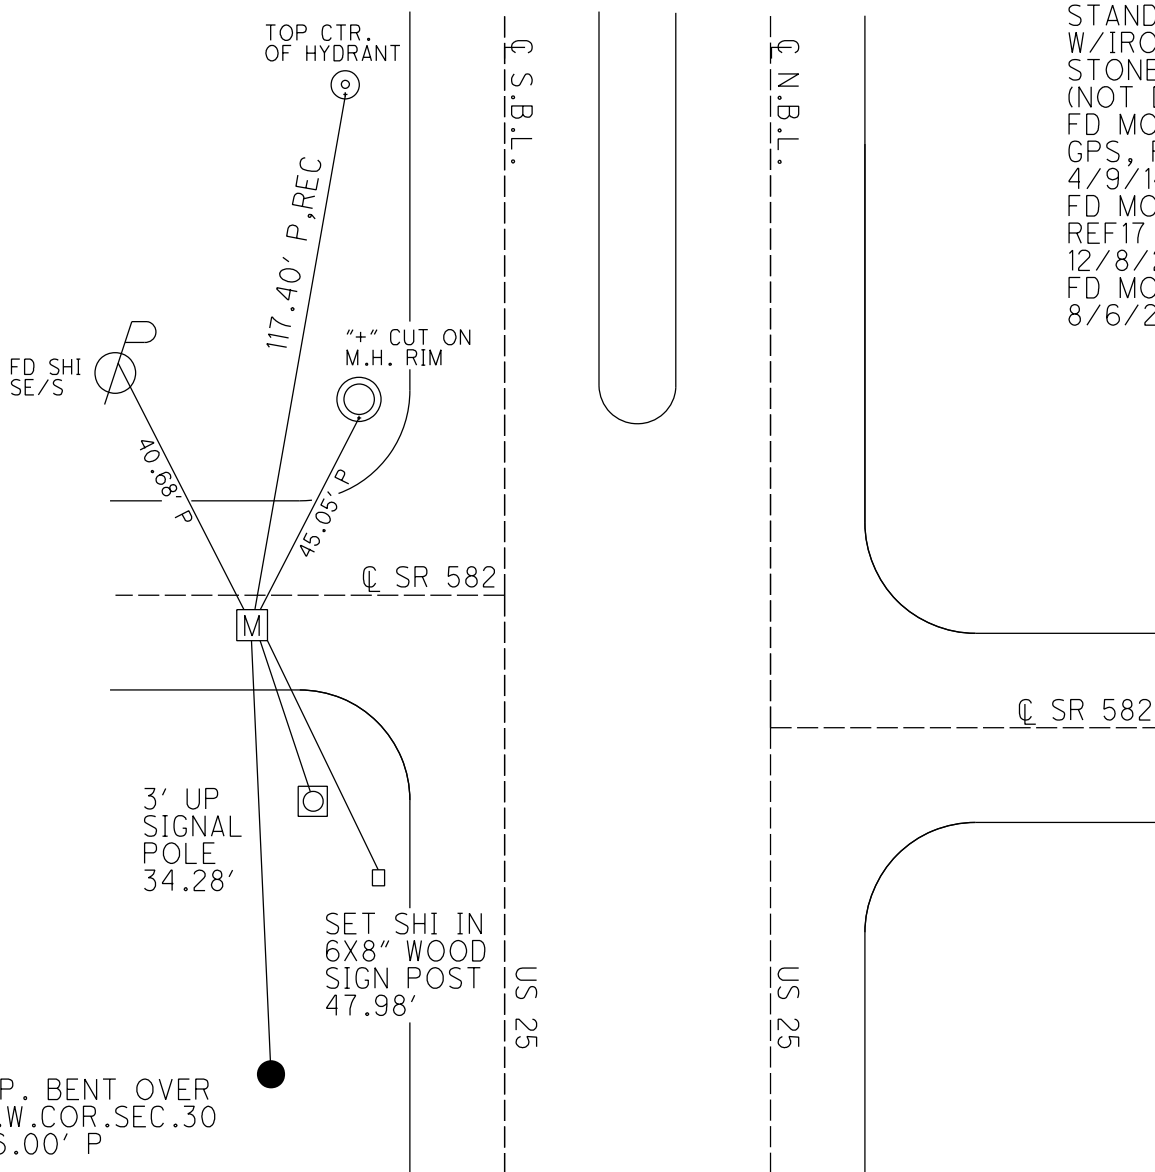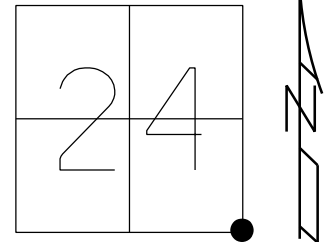

STANDARD MON.BOX
W/IRON PIN SET,
STONE AT 13" BELOW
(NOT DISTURBED)
FD MON.BOX
GPS, REF17
4/9/14, EBW
FD MONBOX
REF17
12/8/23, JAM
FD MONBOX UNDISTURBED
8/6/24, JAM

O.D.O.T. DISTRICT 2 SURVEY OFFICE (USE ONLY)

PERSONNEL

REFERENCE NO. 40

SHEET 17 OF 19

NOTES HOMAN

DATE 5/3/09

ROUTE SR 25

H.C. ROUSOS

WEATHER CLEAR

COUNTY WOOD

R.C. HOMAN

TEMP. 70°

TOWNSHIP MIDDLETON

SECTION 30

DWG BY RHOADES PID 25519

T 6 N R 11 E

TYPE MONUMENT IPIPE

ON SURFACE - ~~BELOW~~ ON

OFFSET Q PAVEMENT 17.7' LT : ~~RT~~

- TO - EDGE PAVEMENT


STATION: 827+80

HORIZ.DATUM: NAD 83

GEOID: NAVD88 2003

GRID: NORTHING: 654861.262

EASTING: 1653099.159

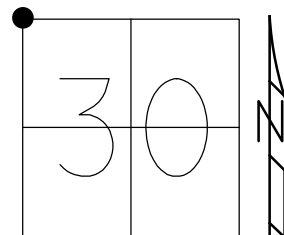

NOTE: NW.COR.SEC.30

Q SR 582

Q SR 582

CUT
CBS



53.11' P

10.92' P

CUT
CBS



Q SB SR 25

Q NB SR 25

RECORD:
SET 1" IPIPE
4/7/03, MB
FD 1" IPIPE
LEANING NORTH
12/4/07
CP2
5/3/09, DCH

O.D.O.T. DISTRICT 2 SURVEY OFFICE (USE ONLY)

PERSONNEL

REFERENCE NO. 40 A

SHEET 21 OF 29

NOTES LEU

DATE 5/28/20

ROUTE SR 25

H.C. O'DONNELL

WEATHER CLOUDY

COUNTY WOOD

R.C. AUBLE

TEMP. 72°

TOWNSHIP MIDDLETON

RHOADES

SECTION 30

DWG BY GARRETT

PID 95722

T 6 S R 11 E

TYPE MONUMENT MAG/WASHER

ON SURFACE - ~~BELOW~~ ON

OFFSET CL PAVEMENT 1.2' LT : ~~RT~~

10.0' TO LT EDGE PAVEMENT


STATION: 827+76

HORIZ.DATUM: NAD83 (2011)


GEOID: 2012A

GRID: NORTHING: 654858.861

EASTING: 1653088.897

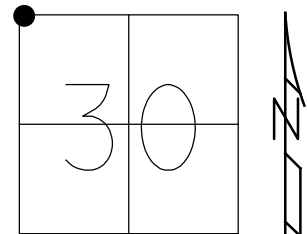

RECORD:
SET P.K./WASHER
9/30/94, MB
SET R.R.SPIKE
11/1/85, SWH
FD SM.R.R.SPIKE
5/9/11, RJL
FD MAG/WASHER
REFA40
2-28-19, JFO

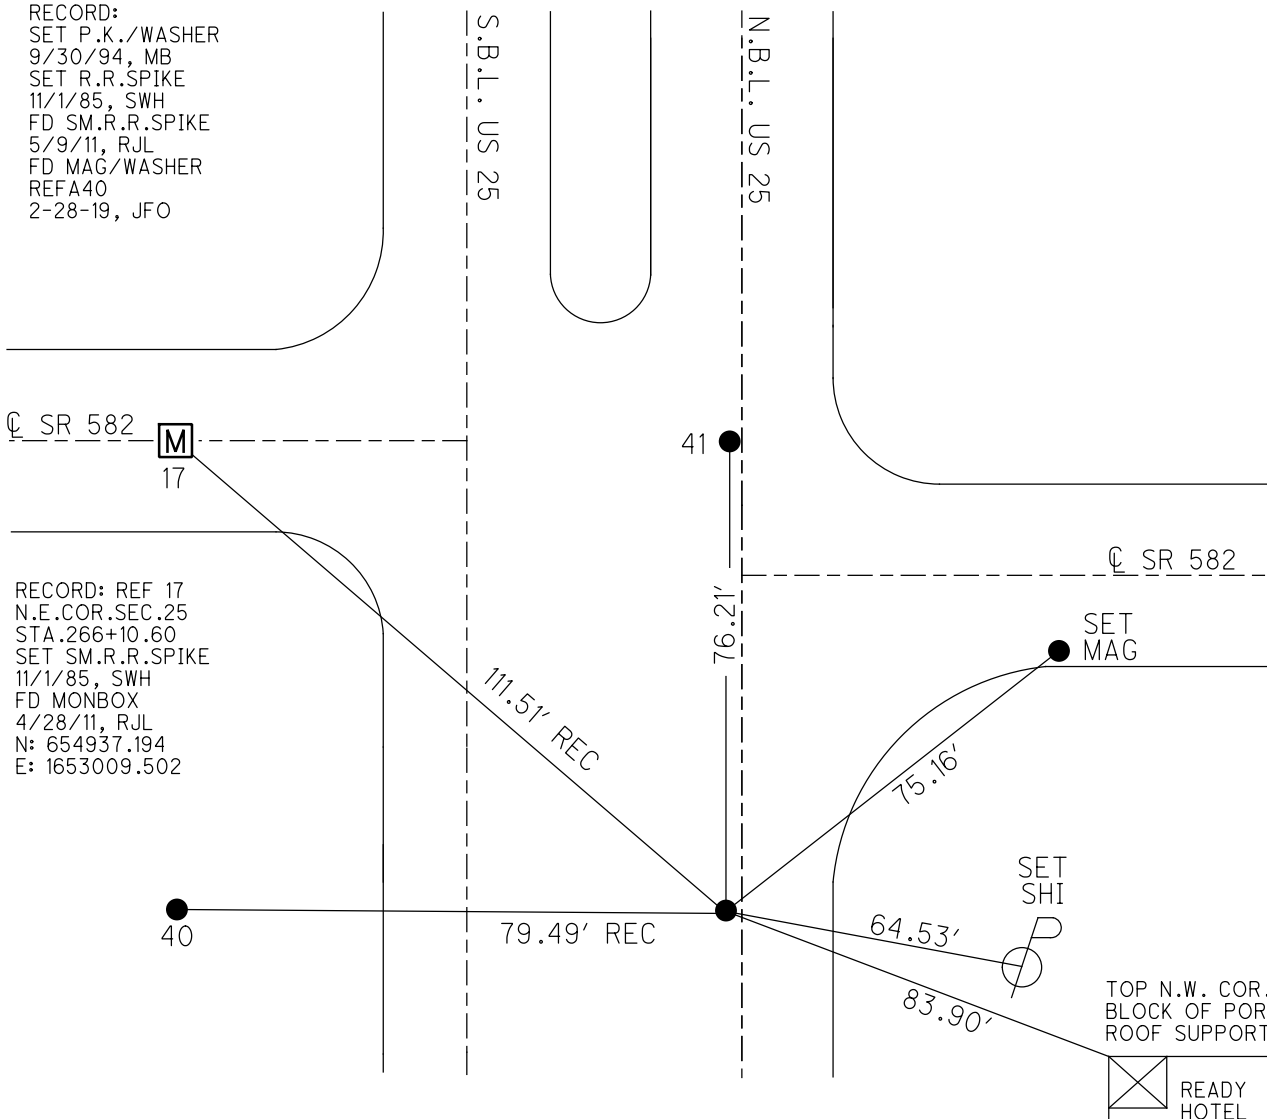

RECORD: REF 17
N.E.COR.SEC.25
STA.266+10.60
SET SM.R.R.SPIKE
11/1/85, SWH
FD MONBOX
4/28/11, RJL
N: 654937.194
E: 1653009.502

O.D.O.T. DISTRICT 2 SURVEY OFFICE (USE ONLY)

PERSONNEL

REFERENCE NO. 17 A

SHEET 22 OF 29

NOTES LEU

DATE 5/28/20

ROUTE SR 582

H.C. O'DONNELL

WEATHER CLOUDY

COUNTY WOOD

R.C. AUBLE

TEMP. 72°

TOWNSHIP MIDDLETON

RHOADES

SECTION 30

DWG BY GARRETT

PID 95722

T 6 S R 11 E

TYPE MONUMENT MAG/WASHER

ON SURFACE - ~~BELOW~~ ON

OFFSET CL PAVEMENT 1.2' LT : ~~RT~~

10.0' TO LT EDGE PAVEMENT


STATION: 282+07.7

HORIZ.DATUM: NAD83 (2011)

GEOID: 2012A


GRID: NORTHING: 654933.983

EASTING: 1653101.598

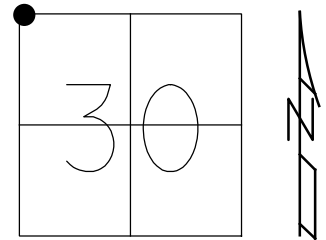

RECORD:
SET P.K./WASHER
9/30/94, MB
FD SM.R.R.SPIKE
5/9/11, RJL
FD MAG/WASHER
REF41
2-28-19, JFO

NOTE: REF 41 US 25

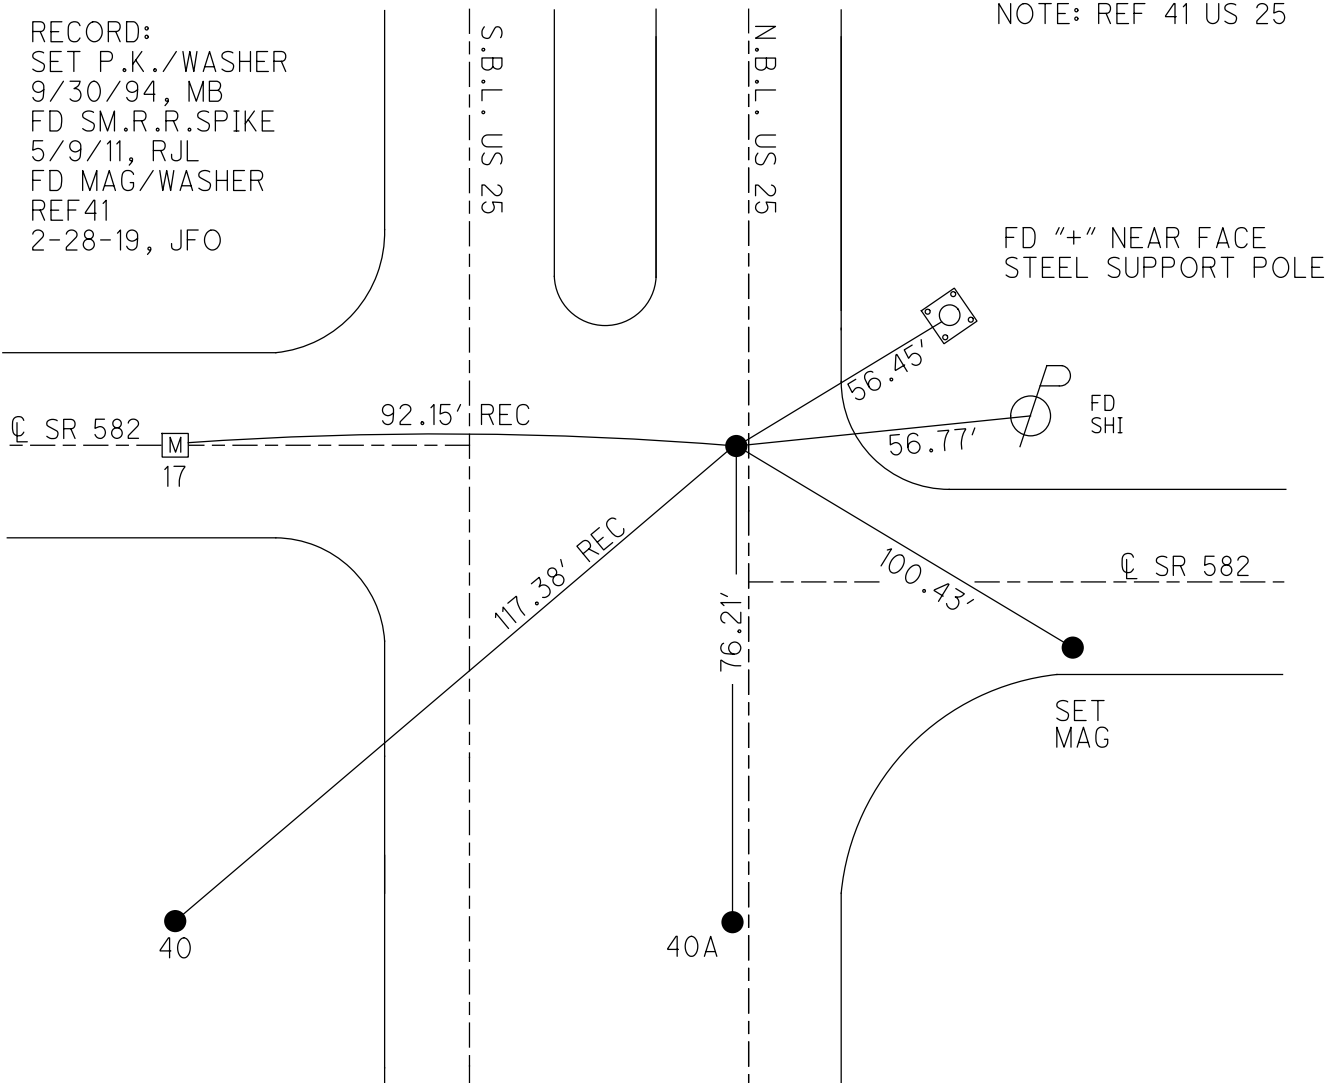

O.D.O.T. DISTRICT 2 SURVEY OFFICE

PERSONNEL

REFERENCE NO. 18

SHEET 20 OF 25

NOTES CANTERBURY

DATE 4/26/04

ROUTE SR 582

H.C. BARNHISEL

WEATHER FAIR

COUNTY WOOD

R.C. CANTERBURY

TEMP. 60°

TOWNSHIP MIDDLETON

SECTION 30

T 6 N R 11 E

TYPE MONUMENT MON. BOX W/IRON PIN



ON SURFACE - ~~BELOW~~ ON

~~LEFT~~ - Q PAV'T - RIGHT 7.5'

4.7' TO RT EDGE PAVEMENT

S.L.M. 315+35

Grid: Northing: _____ Easting: _____

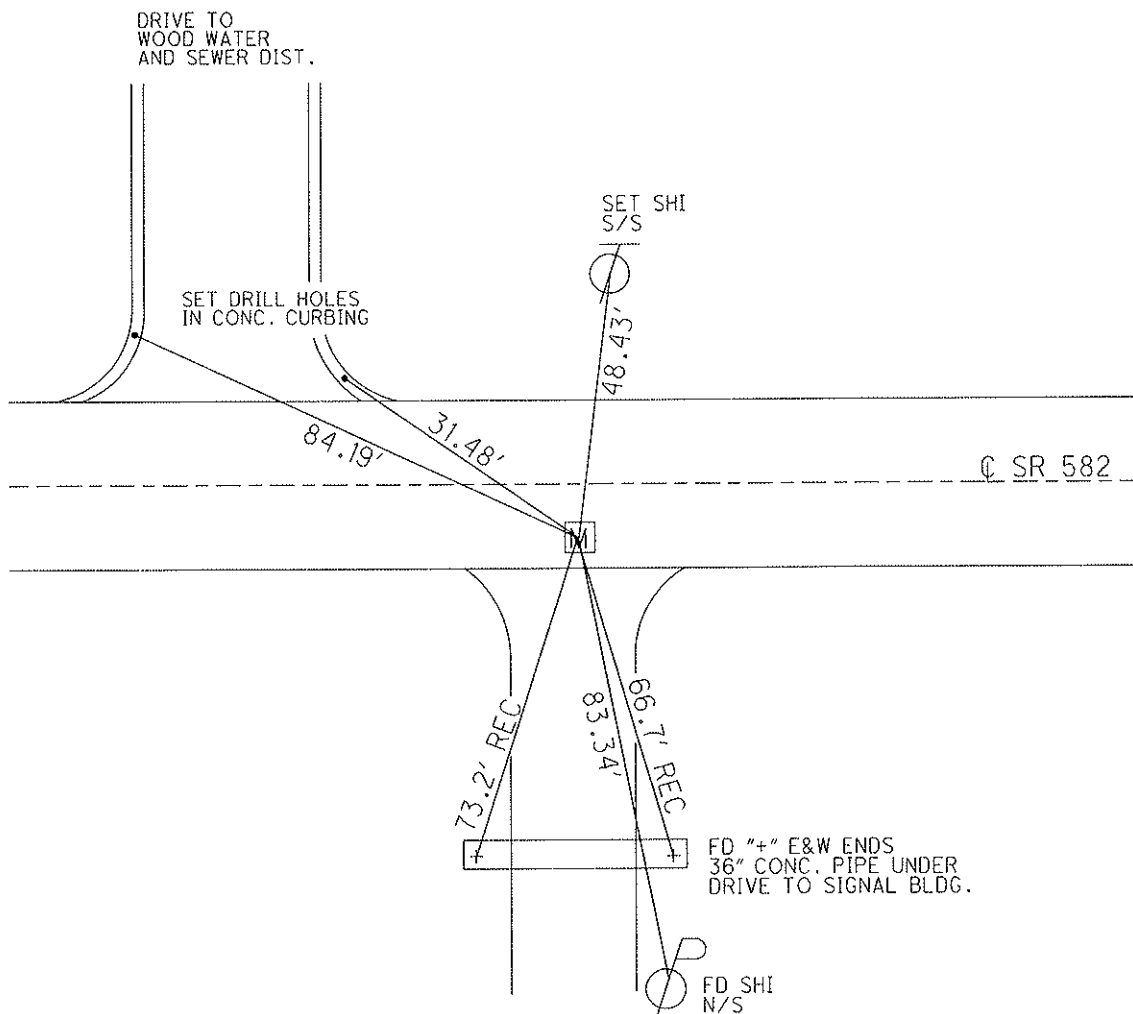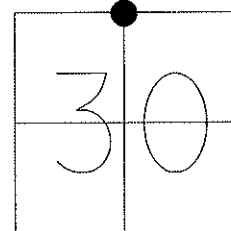

O.D.O.T. DISTRICT 2 SURVEY OFFICE (USE ONLY)

PERSONNEL

REFERENCE NO. 19

SHEET 24 OF 29

NOTES JAMES

DATE 4/23/19

ROUTE SR 582

H.C. LEU

WEATHER WINDY

COUNTY WOOD

R.C. JAMES

TEMP. 67°

TOWNSHIP MIDDLETON

SECTION 30

DWG BY BALBAUGH PID 81000

T 6 N R 11 E

TYPE MONUMENT MONBOX W/ IPIN

ON SURFACE - ~~BELOW~~ ON

OFFSET Q PAVEMENT 8.3' ~~LT~~ : RT

3.5' TO RT EDGE PAVEMENT



STATION: 342+14.40

HORZ.DATUM: NAD83 (2011)

GEOID: 2012A

GRID: NORTHING: 654662.838

EASTING: 1659045.665

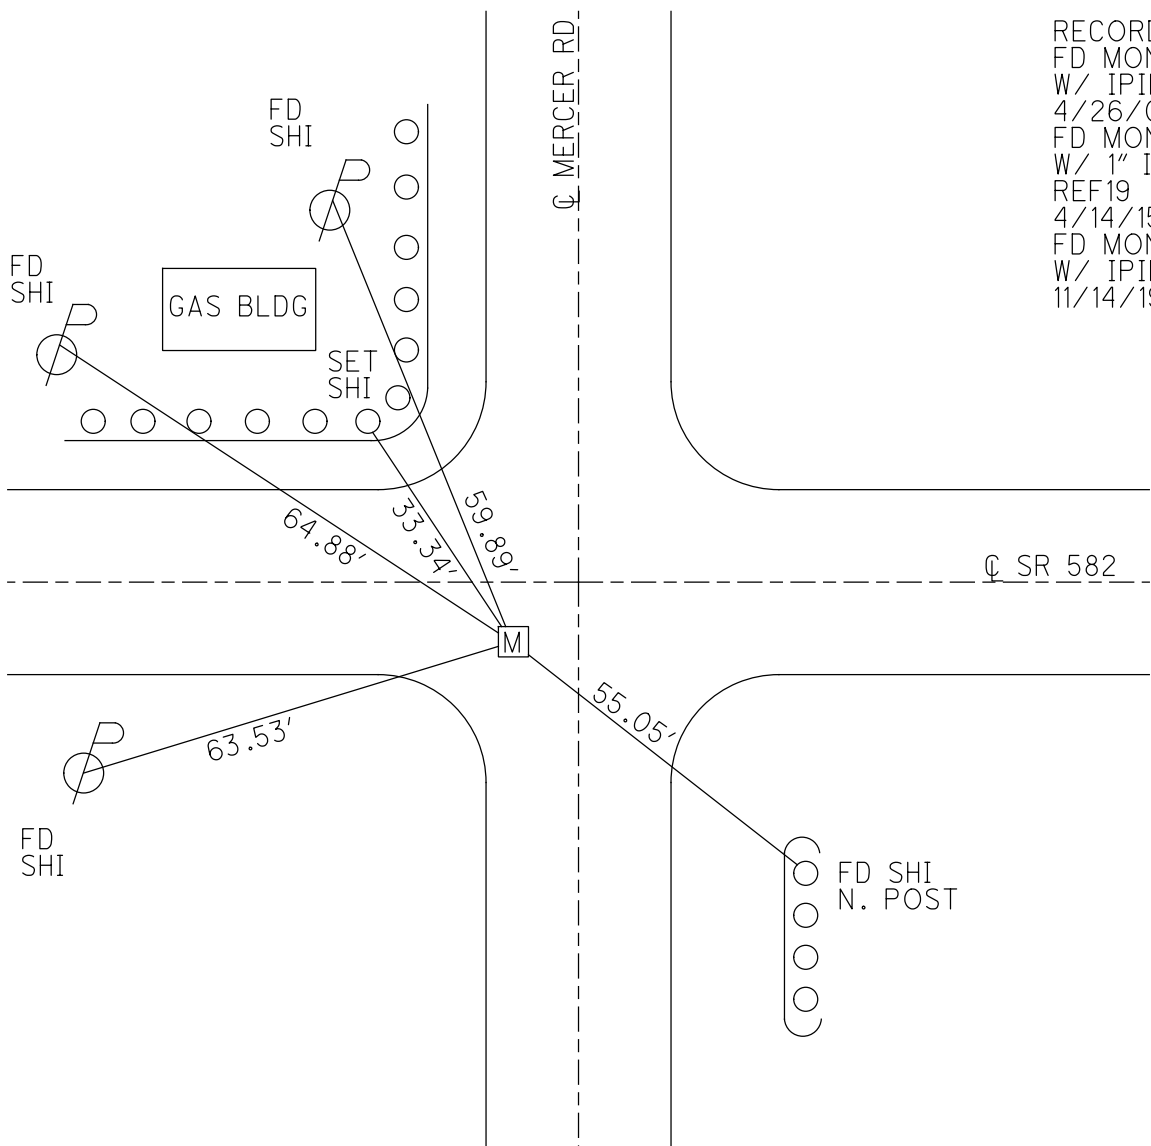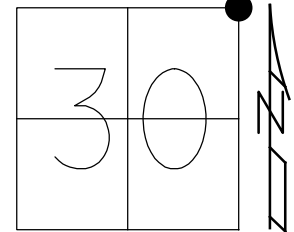

RECORD:
FD MONBOX
W/ IPIN
4/26/04,
FD MONBOX
W/ 1" IPIN
REF19
4/14/15, EBW
FD MONBOX
W/ IPIN
11/14/19, JLL

O.D.O.T. DISTRICT 2 SURVEY OFFICE (USE ONLY)

PERSONNEL

REFERENCE NO. 20

SHEET 25 OF 29

NOTES NIESE

DATE 12/4/19

ROUTE SR 582

H.C. LEU

WEATHER CLOUDY

COUNTY WOOD

R.C. NASON

TEMP. 37°

TOWNSHIP MIDDLETON

REFERENCE NO.

SECTION 29

DWG BY BALBAUGH

PID 81000

T 6 N R 11 E

TYPE MONUMENT MONBOX W/ 1" IPIN

ON SURFACE - ~~BELOW~~ ON

OFFSET 2.5 TO RT EDGE PAVEMENT


STATION: 368+67.95

HORIZ.DATUM: NAD83 (2011)


GEOID: 2012A

GRID: NORTHING: 654574.682

EASTING: 1661697.610

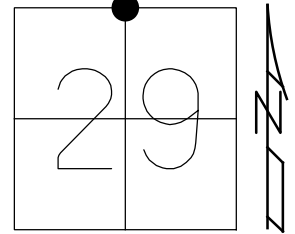

RECORD:
FD P.K./WASHER
4/26/04, MC
SET MAG/WASHER
10/20/04, MC
FD MAG/WASHER
REF20
4/4/15, EBW
FD MAG/WASHER
4/23/19, JLL
FD MONBOX
W/ 1" IPIN
NEWREF20
11/14/19, JLL

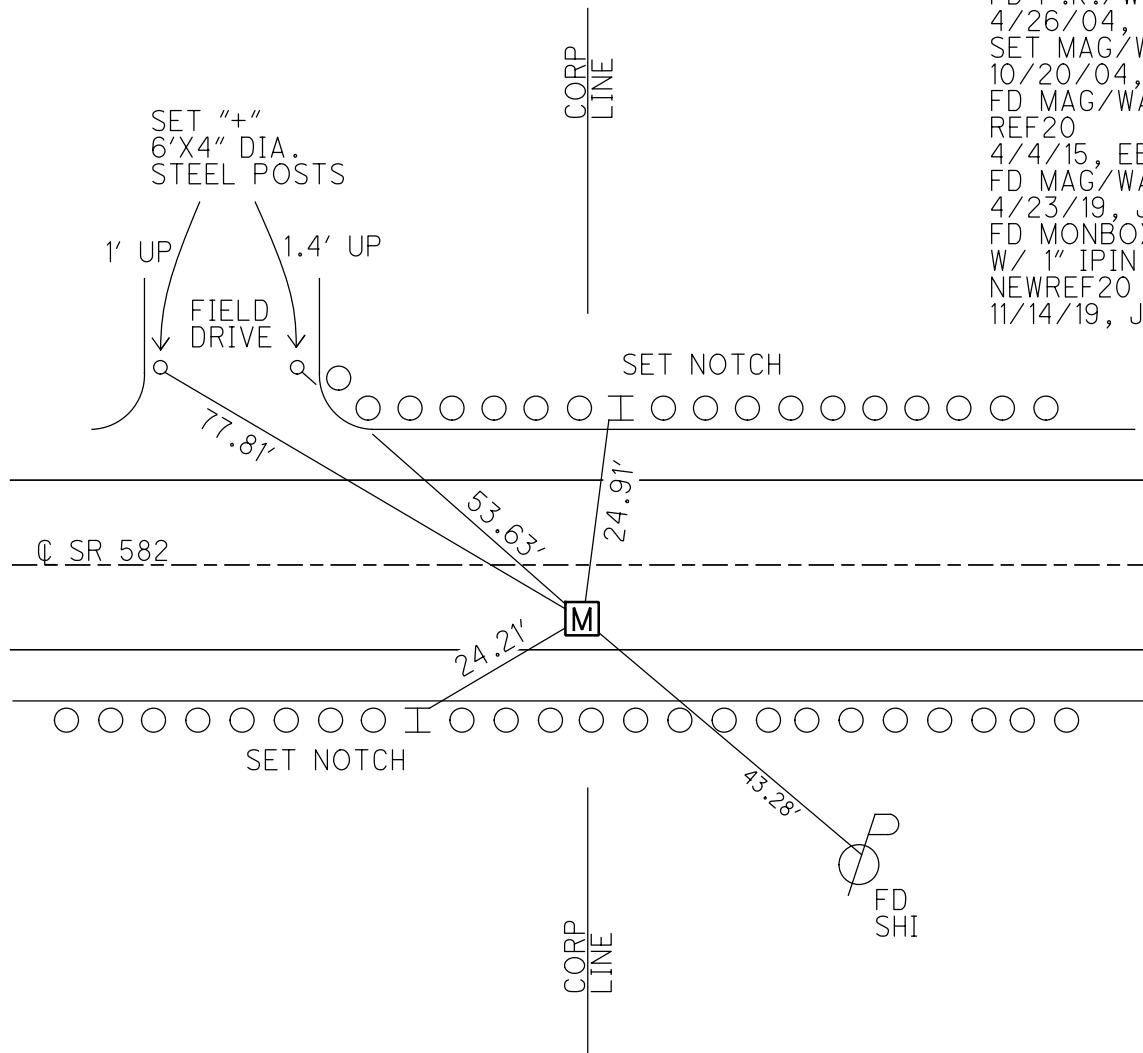

O.D.O.T. DISTRICT 2 SURVEY OFFICE (USE ONLY)

PERSONNEL

21

SHEET 26 OF 29

NOTES NIESE DATE 12/4/19
H.C. LEU WEATHER CLOUDY
R.C. NASON TEMP. 37°

ROUTE SR 582
COUNTY WOOD
TOWNSHIP MIDDLETON
SECTION 29
T 6 N R 11 E

DWG BY BALBAUGH PID 81000

TYPE MONUMENT MAG/WASHER

ON SURFACE - ~~BELOW~~ ON

OFFSET Q PAVEMENT 13.8' ~~LT~~ : RT
2.7' TO RT EDGE PAVEMENT


STATION: 378+26.88

HORIZ.DATUM: NAD83 (2011)



GEOID: 2012A


GRID: NORTHING: 654541.051

EASTING: 1662655.862

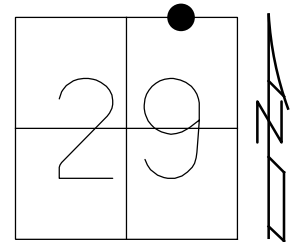

RECORD:
FD P.K./WASHER
4/26/04, MC
SET MAG/WASHER
10/20/04, MC
FD MAG/WASHER
REF21
4/14/15, EBW
FD MAG/WASHER
4/23/19, JLL
SET MAG/WASHER
12/4/19, JLL

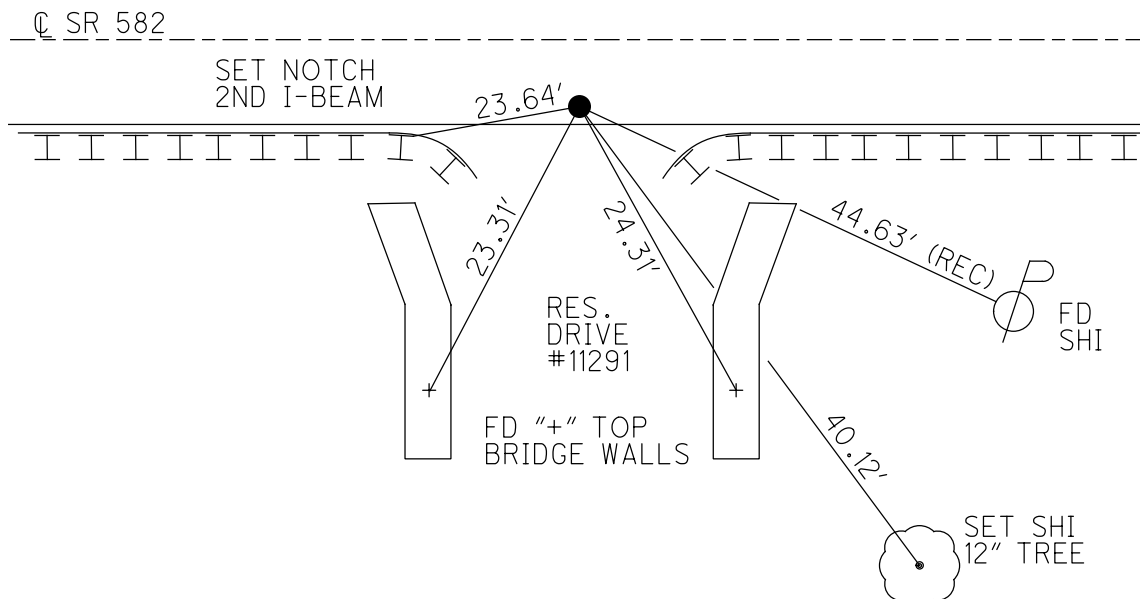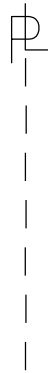

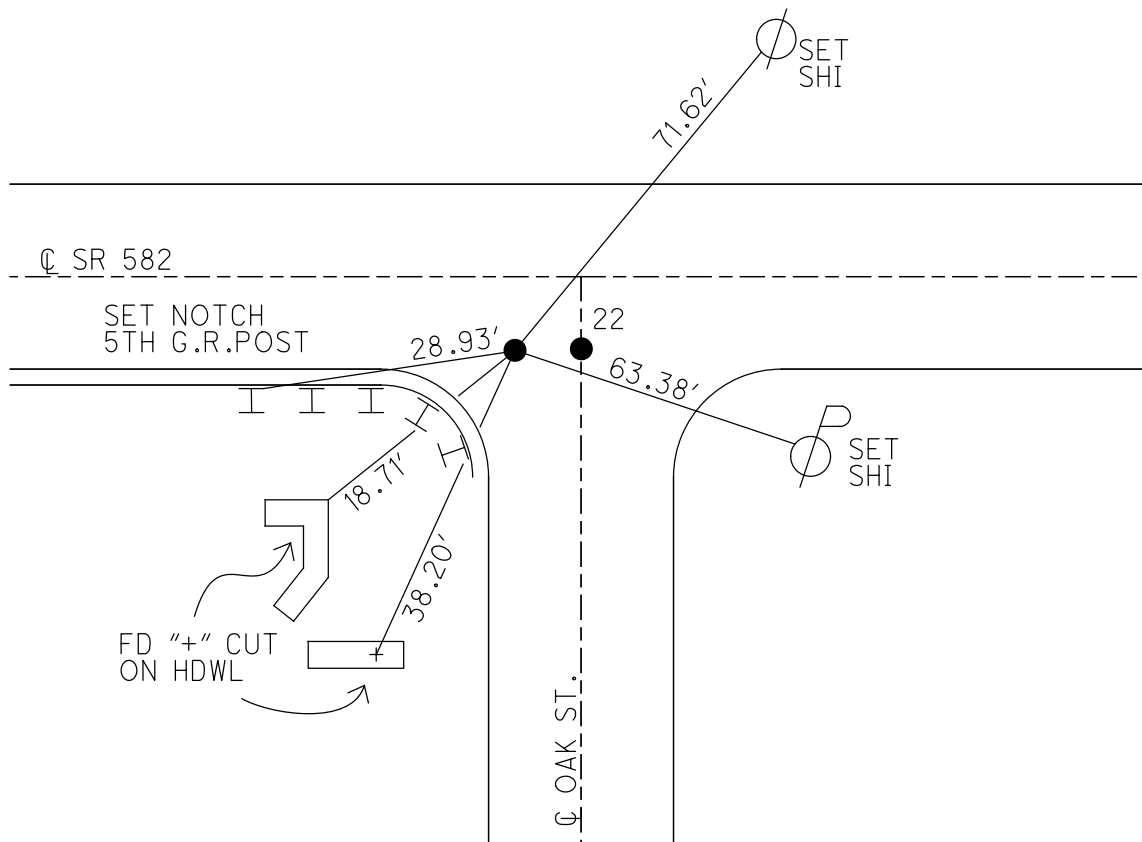

O.D.O.T. DISTRICT 2 SURVEY OFFICE (USE ONLY)

PERSONNEL

REFERENCE NO. 22

SHEET 28 OF 29

NOTES LEU

DATE 4/14/15

ROUTE SR 582

H.C. WESTFALL

WEATHER OVERCAST

COUNTY WOOD

R.C. LEU

TEMP. 53°

TOWNSHIP MIDDLETON

DWG BY BALBAUGH PID 81000

SECTION 29

T 6 N R 11 E

TYPE MONUMENT MAG/WASHER

ON SURFACE - ~~BELOW~~ ON

OFFSET CL PAVEMENT 9.3' ~~LT~~ : RT

0.5' TO RT EDGE PAVEMENT


STATION: 387+74.17

HORIZ.DATUM: NAD83 (2011)

GEOID: 2012A


GRID: NORTHING: 654507.577

EASTING: 1663602.500

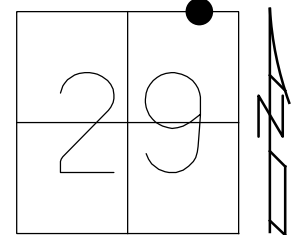

RECORD:

FD P.K./WASHER
4/27/04, MC
SET MAG/WASHER
10/20/04, MC
FD MAG/WASHER
4/14/15, EBW
SET MAG/WASHER
4/23/19, JLL

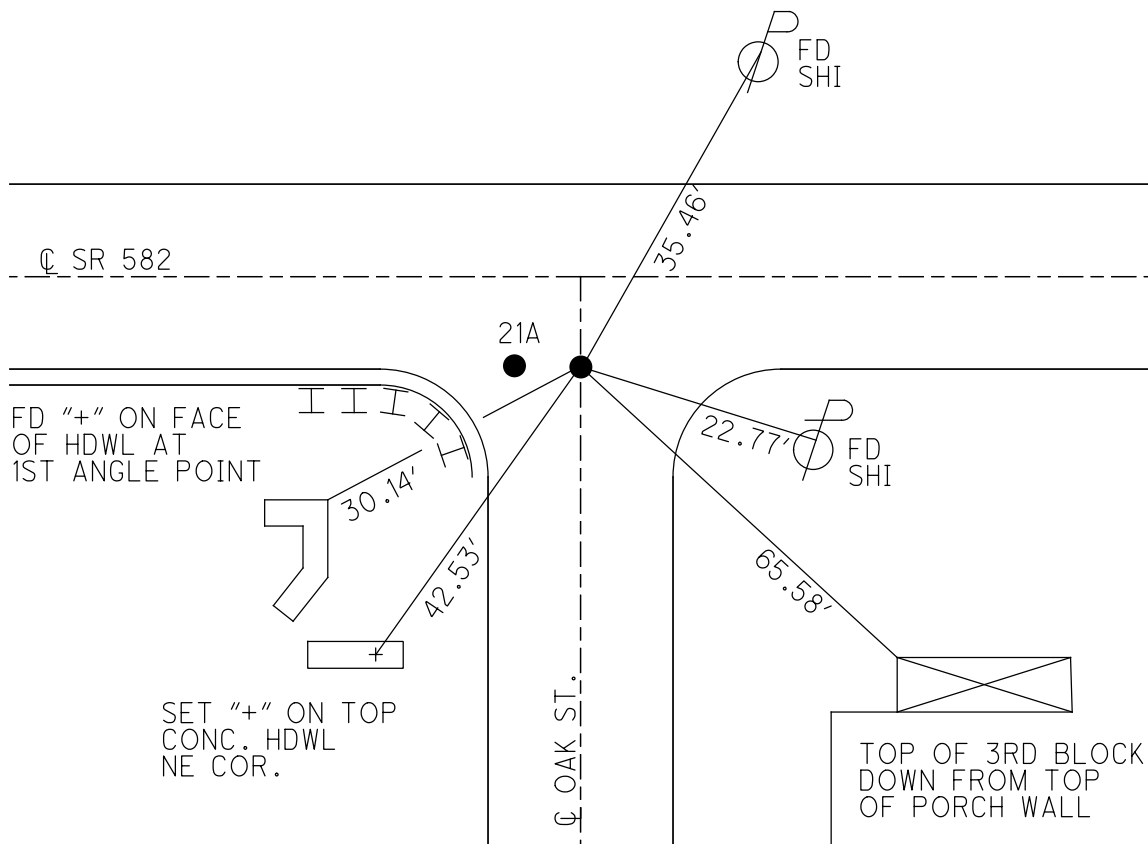

O.D.O.T. DISTRICT 2 SURVEY OFFICE (USE ONLY)

PERSONNEL

REFERENCE NO. 23

SHEET 29 OF 29

NOTES LEU

DATE 4/14/15

ROUTE SR 582

H.C. WESTFALL

WEATHER CLOUDY

COUNTY WOOD

R.C. LEU

TEMP. 45°

TOWNSHIP MIDDLETON

DWG BY BALBAUGH PID 81000

SECTION 28

T 6 N R 11 E

TYPE MONUMENT MAG/WASHER

ON SURFACE - ~~BELOW~~ ON

OFFSET Q PAVEMENT 6.6' ~~LT~~ : RT

— TO — EDGE PAVEMENT


STATION: 394+91.07

HORZ.DATUM: NAD83 (2011)


GEOID: 2012A

GRID: NORTHING: 654482.350

EASTING: 16664318.889

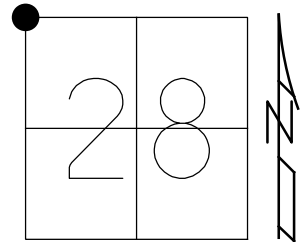

RECORD:
FD IPIN
4/27/04, MC
SET MAG/WASHER
10/20/04, MC
SET MAG/WASHER
4/23/19, JLL
FD MONBOX
W/ 1" IPIN
NEWREF23
11/14/19, JLL

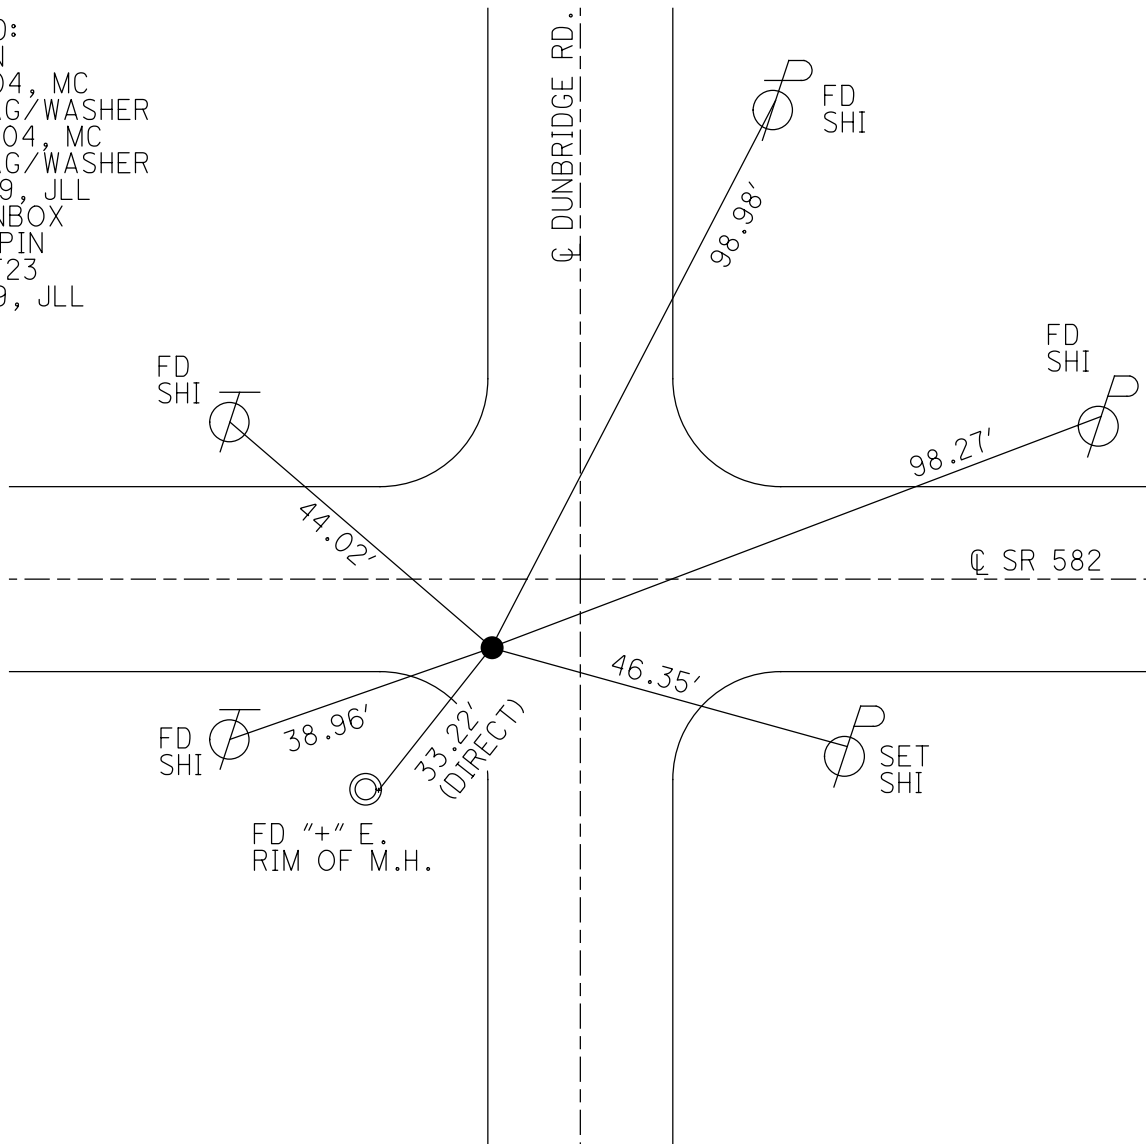

O.D.O.T. DISTRICT 2 SURVEY OFFICE (USE ONLY)

PERSONNEL

REFERENCE NO. 24

SHEET 1 OF 21

NOTES JAMES

DATE 4/23/19

ROUTE SR 582

H.C. LEU

WEATHER WINDY

COUNTY WOOD

R.C. JAMES

TEMP. 67°

TOWNSHIP MIDDLETON

SECTION 28

DWG BY BALBAUGH

PID 81000

T 6 N R 11 E

TYPE MONUMENT MAG NAIL

ON SURFACE - ~~BELOW~~ ON

OFFSET $\mathcal{C}$ PAVEMENT 8.8' ~~LT~~ : RT

0.8' TO RT EDGE PAVEMENT


STATION: 398+30.01

HORZ.DATUM: NAD83 (2011)

GEOID: 2012A

GRID: NORTHING: 654471.348

EASTING: 1664657.649

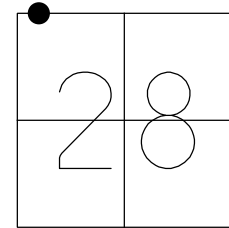

RECORD:

FD P.K./WASHER

4/14/05, MC

SET MAG/WASHER

8/23/05, MDB


FD MAG/WASHER

REF24

4/14/15, JLL

SET MAG/WASHER

4/8/20, JLL

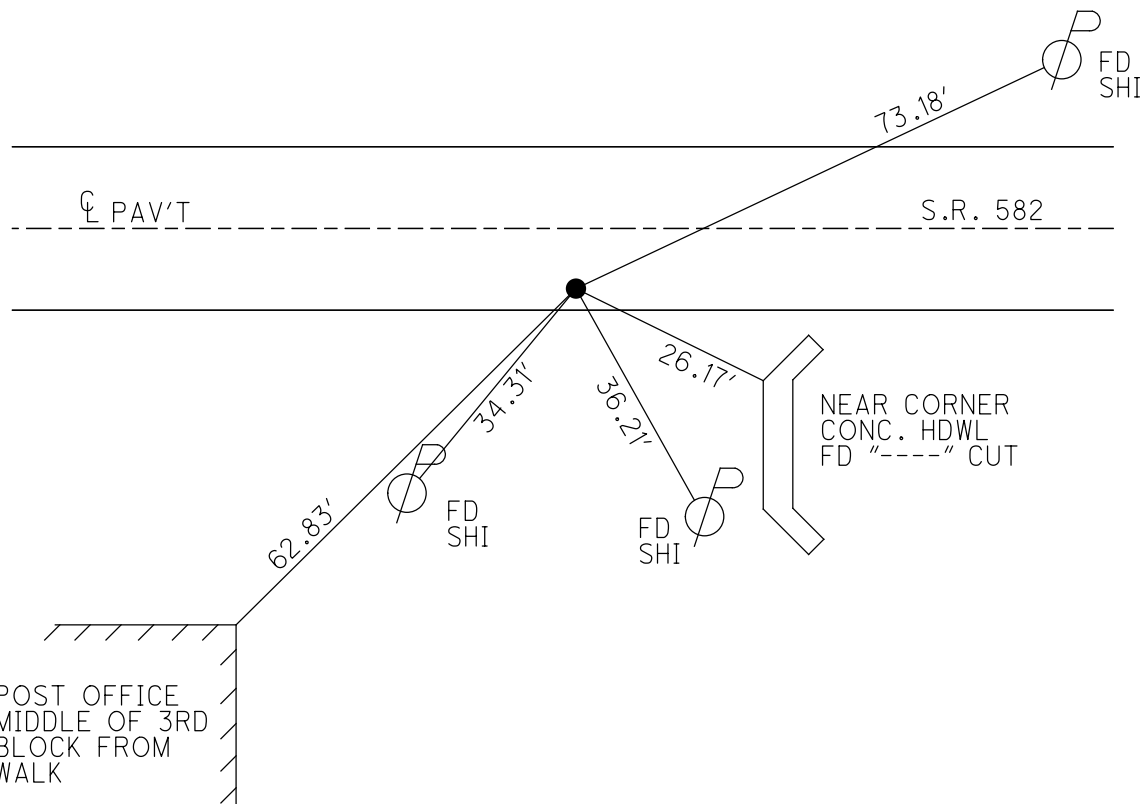

O.D.O.T. DISTRICT 2 SURVEY OFFICE (USE ONLY)

PERSONNEL

REFERENCE NO. 25

SHEET 2 OF 21

NOTES JAMES

DATE 4/23/19

ROUTE SR 582

H.C. LEU

WEATHER WINDY

COUNTY WOOD

R.C. JAMES

TEMP. 67°

TOWNSHIP MIDDLETON

SECTION 28

DWG BY BALBAUGH PID 81000

T 6 N R 11 E

TYPE MONUMENT MAG/WASHER

ON SURFACE - ~~BELOW~~ ON

OFFSET CL PAVEMENT 7.4' ~~LT~~ : RT

1.9' TO RT EDGE PAVEMENT


STATION: 402+27.05

HORIZ.DATUM: NAD83 (2011)

GEOID: 2012A

GRID: NORTHING: 654460.659

EASTING: 1665054.518

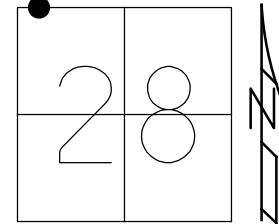


RECORD:
FD P.K./WASHER
4/15/05, MC
SET MAG/WASHER
8/23/05, MBD
FD MAG/WASHER
4/14/15, JLL
SET MAG/WASHER
W/ COORDS.
4/8/20, JLL

STONE FDN
UNDER SIDING

SET SHI
24" TREE

3' UP FROM
CONC. SW
COR. SIDING

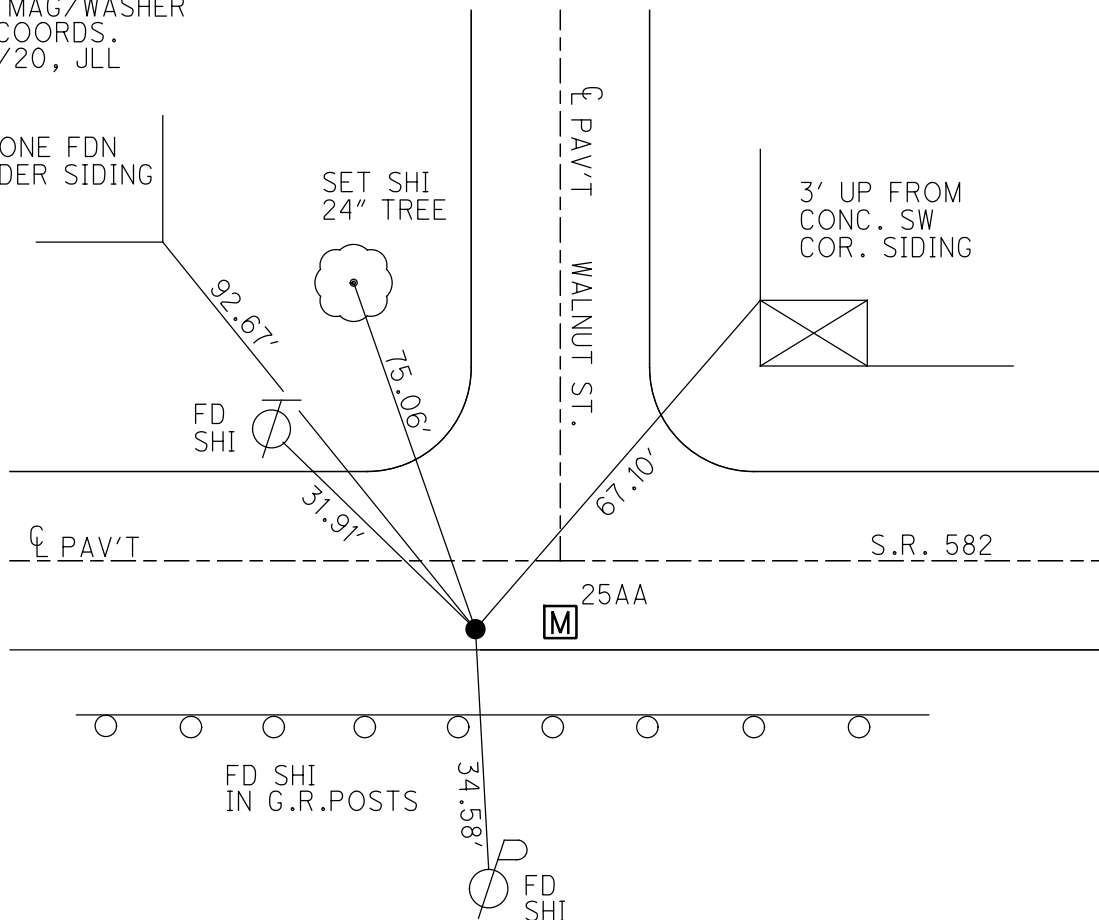

O.D.O.T. DISTRICT 2 SURVEY OFFICE (USE ONLY)

PERSONNEL

REFERENCE NO. 25 AA

SHEET 3 OF 21

NOTES_NIESE

DATE 12/4/19ROUTE SR 582

H.C. LEU

WEATHER CLOUDY

COUNTY WOOD

R.C. NASON

TEMP. _____

TOWNSHIP MIDDLETONSECTION 28DWG BY BALBAUGHPID 81000

T_6_N R_11_E

TYPE MONUMENT MONBOX W/ 1" IPIN

ON SURFACE - ~~BELOW~~ ON

OFFSET C PAVEMENT 6.8 ~~11.7~~ : RT

____TO____EDGE PAVEMENT

STATION: 402+47.43

HORZ.DATUM: NAD83 (2011)

GEOID: 2012A

GRID: NORTHING: 654460.728

EASTING: 1665074.851

RECORD:

STA. 402+47.43

PER WOO-582-6.48


PID #81000

FD MONBOX

W/ 1" IPIN

REF AA25

11/14/19, JLL

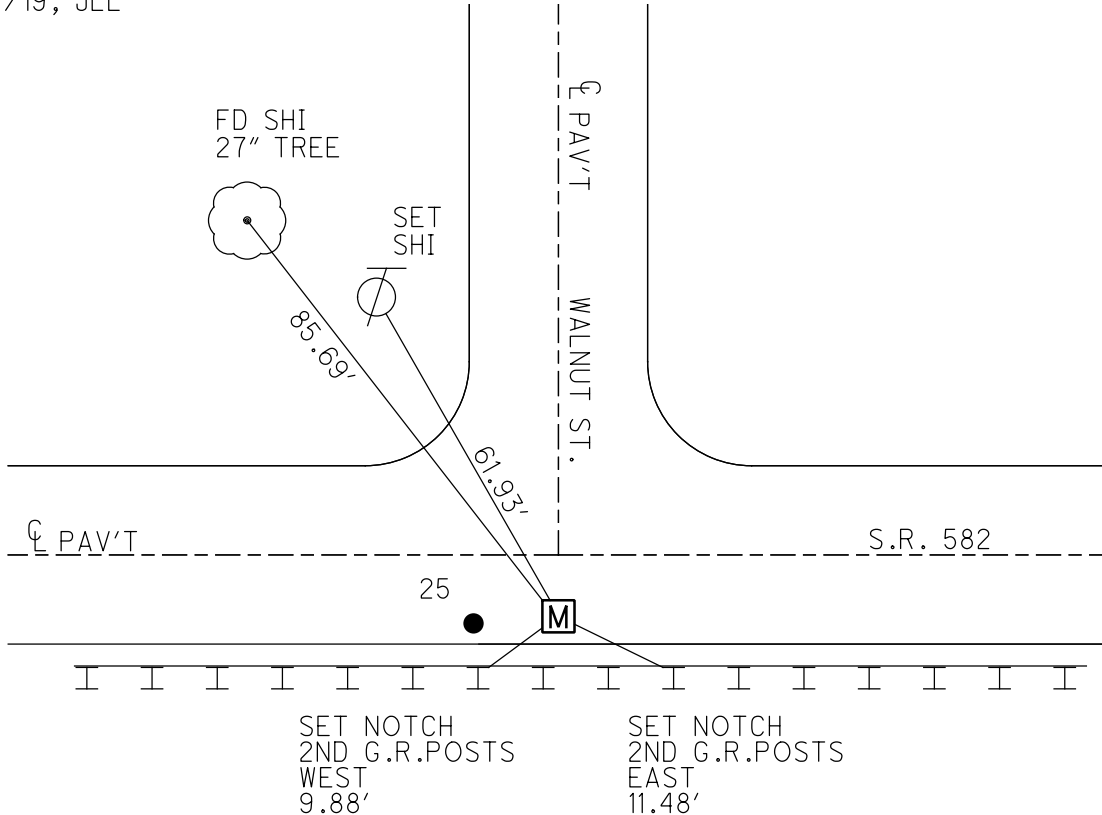

O.D.O.T. DISTRICT 2 SURVEY OFFICE (USE ONLY)

PERSONNEL

REFERENCE NO. 25 A

SHEET 4 OF 21

NOTES LEU

DATE 4/8/20

ROUTE SR 582

H.C.	LEU
------	-----

WEATHER SUNNY

COUNTY WOOD

R.C. BALBAUGH

TEMP. 66°

TOWNSHIP MIDDLETONSECTION 28

DWG BY BALBAUGH PID 81000

T_6_N R_11_E

TYPE MONUMENT MAG/WASHER

ON SURFACE - ~~BELOW~~ ON

OFFSET C PAVEMENT 7.0' ~~LT~~ : RT


2.5' TO RT EDGE PAVEMENT

STATION: 416+02.26

HORZ.DATUM: NAD83 (2011)

GEOID: 2012A

GRID: NORTHING: 654421.675

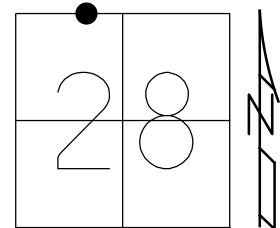EASTING: 1666429.089

RECORD:

FD P.K./WASHER

4/15/05, MC

SET MAG/WASHER

8/23/05, MDB

FD MAG/WASHER

REF A25

4/14/15, JLL

D.N.F.


4/23/19, JLL
GET MAG MAG

SET MAG/WASHER
FROM COORDINAT

FROM COORDINATES
 1.62×10^2 m/s

4/8/20, JLL

RES. #10626

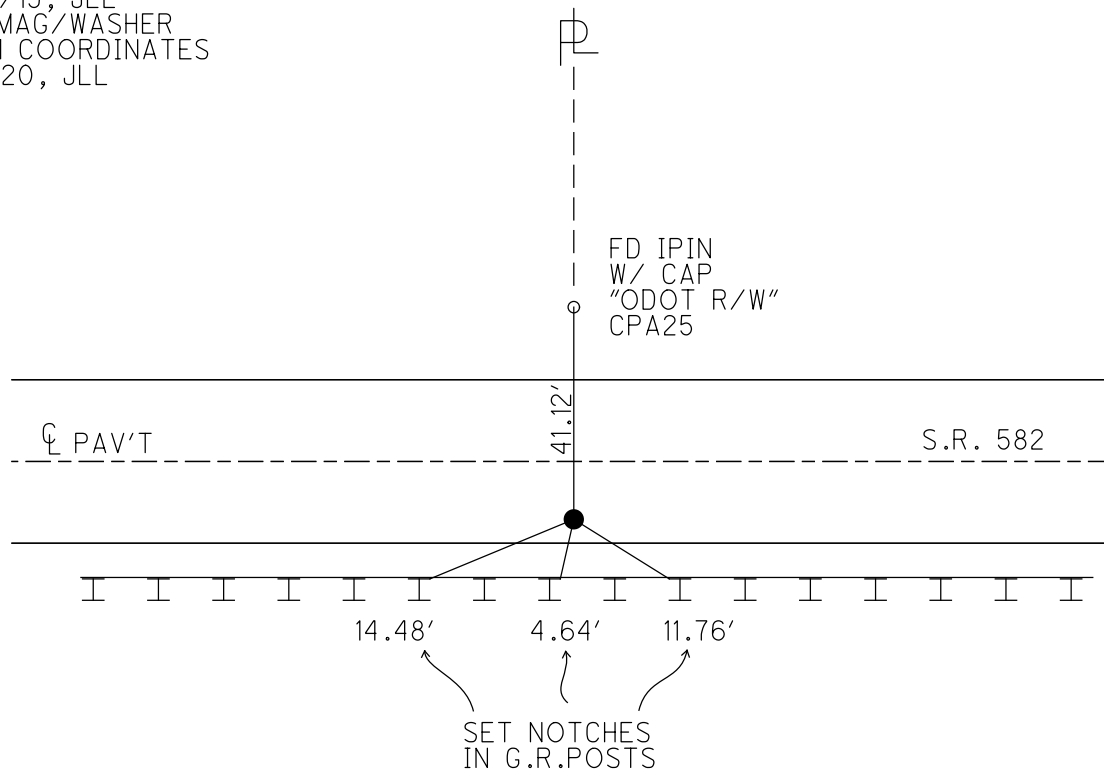

O.D.O.T. DISTRICT 2 SURVEY OFFICE (USE ONLY)

PERSONNEL

REFERENCE NO. 26

SHEET 5 OF 21

NOTES NIESE

DATE 12/4/19

ROUTE SR 582

H.C. LEU

WEATHER CLOUDY

COUNTY WOOD

R.C. NASON

TEMP. 38°

TOWNSHIP MIDDLETON

SECTION 28

DWG BY BALBAUGH PID 81000

T 6 N R 11 E

TYPE MONUMENT MONBOX W/ 1" IPIN

ON SURFACE - ~~BELOW~~ ON

OFFSET CL PAVEMENT 10.8 ~~LT~~ : RT

— TO — EDGE PAVEMENT


STATION: 421+38.81

HORIZ.DATUM: NAD83 (2011)


GEOID: 2012A

GRID: NORTHING: 654406.503

EASTING: 1666965.330

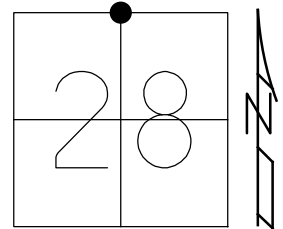

RECORD:
FD STONE
4/15/05, MC
FD STONE
4/14/15, JLL
FD STONE
5/8/19, JLL
FD MONBOX
W/ 1" IPIN
NEWREF26
11/14/19, JLL

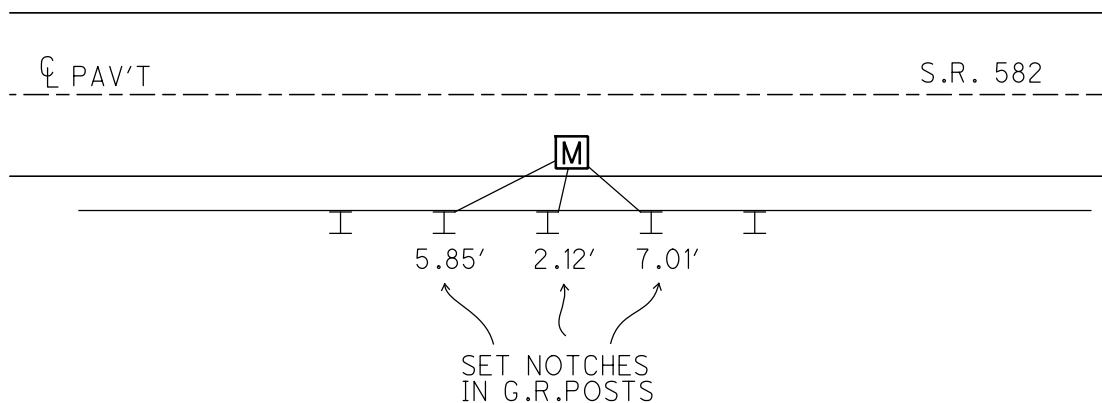

O.D.O.T. DISTRICT 2 SURVEY OFFICE (USE ONLY)

PERSONNEL

REFERENCE NO. 27

SHEET 6 OF 21

NOTES_____NIESE

DATE 12/4/19ROUTE SR 582

H.C. LEU

WEATHER CLOUDY

COUNTY WOOD

R.C. NASON

TEMP. _____

TOWNSHIP MIDDLETONSECTION 28DWG BY BALBAUGH

PID 81000

T_6_N R_11_E

TYPE MONUMENT MAG NAIL OVER BRASS TABLET

ON SURFACE - ~~BELOW~~ ON

OFFSET @ PAVEMENT 11.4' ~~LT~~ : RT

____TO____EDGE PAVEMENT


STATION: 447+79.85

HORZ.DATUM: NAD83 (2011)

GEOID: 2012A

GRID: NORTHING: 654344.834

EASTING: 1669605.536

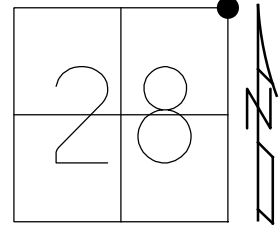

RECORD:

SET BRASS TABLET

8/6/93, BVD

FD DRILLH/BRASS TABLET

4/15/05, MC

FD BRASS TABLET

8/23/05

FD DRILLH/BRASS TABLET


REF27

4/14/15, JLL

FD DRILLH/BRASS TABLET


REF27

5/8/19, JLL

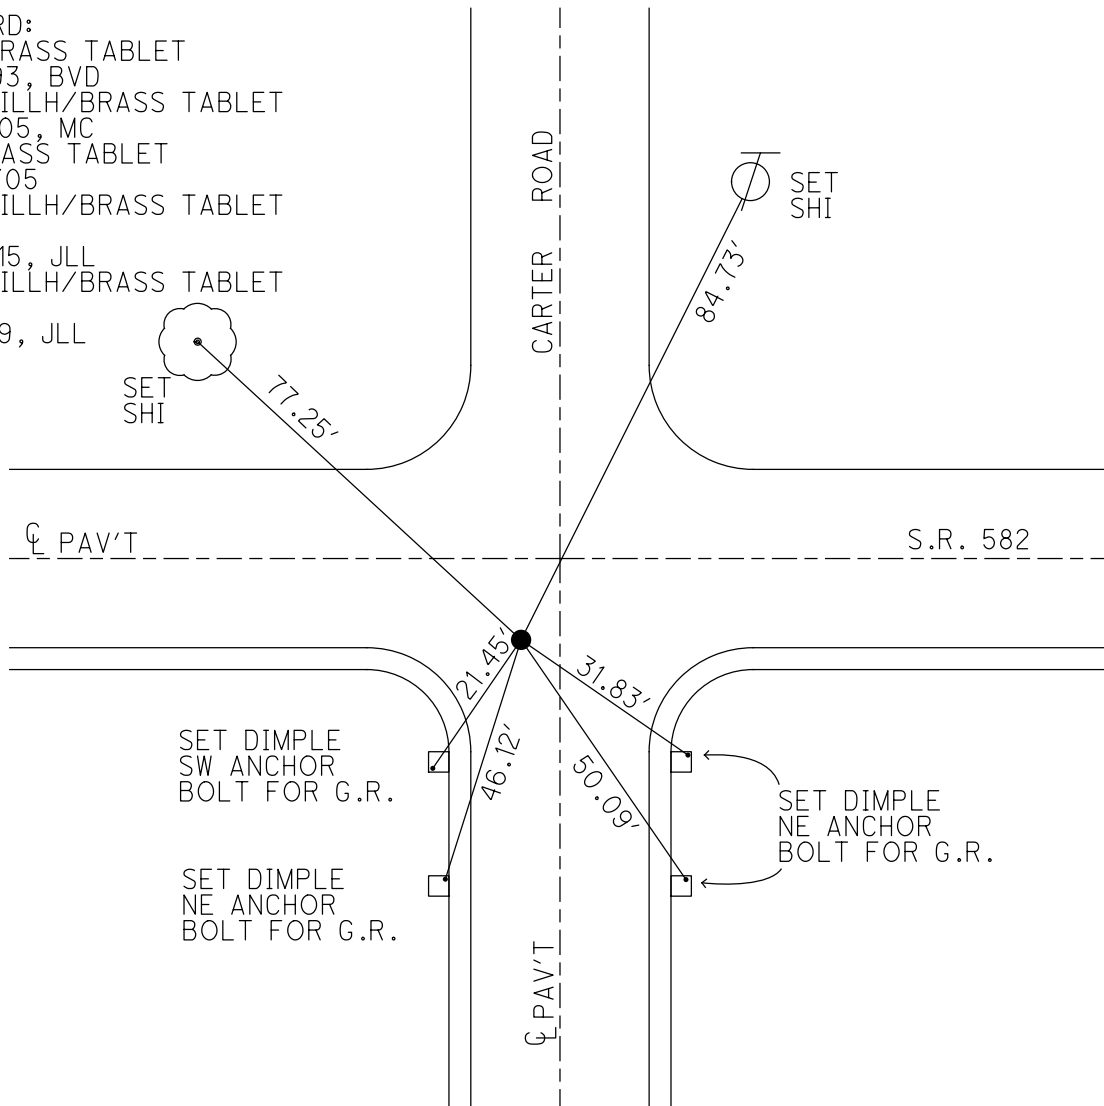


O.D.O.T. DISTRICT 2 SURVEY OFFICE (USE ONLY)

PERSONNEL	REFERENCE NO. <u>28</u>	SHEET <u>7</u> OF <u>21</u>
NOTES <u>LEU</u>	DATE <u>4/24/19</u>	ROUTE <u>SR 582</u>
H.C. <u>LEU</u>	WEATHER <u>SUNNY</u>	COUNTY <u>WOOD</u>
R.C. <u>JAMES</u>	TEMP. <u>46°</u>	TOWNSHIP <u>WEBSTER</u>
		SECTION <u>27</u>
DWG BY <u>BALBAUGH</u>	PID <u>81000</u>	T <u>6</u> N R <u>11</u> E
TYPE MONUMENT <u>3/4" IPIN BENT</u>		
ON SURFACE - BELOW <u>4"</u>		
OFFSET <u>CL</u> PAVEMENT <u>9.7'</u> LT : RT		
<u>1.6'</u> TO RT EDGE PAVEMENT		
STATION: <u>474+29.82</u>		
HORZ.DATUM: <u>NAD83 (2011)</u>		GEOID: <u>2012A</u>
GRID: NORTHING: <u>654275.487</u>		EASTING: <u>1672254.510</u>

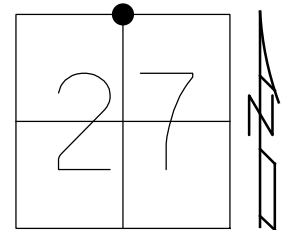

RECORD:
 FD LG.R.R.SPIKE
 4/15/05, MC
 SET 5/8" IPIN
 8/23/05
 FD 3/4" IPIN BENT
 REF28
 SET 3/4" IPIN
 4/14/15, JLL
 FD MONBOX
 W/ 1" IPIN
 NEWREF28
 11/14/19, JLL

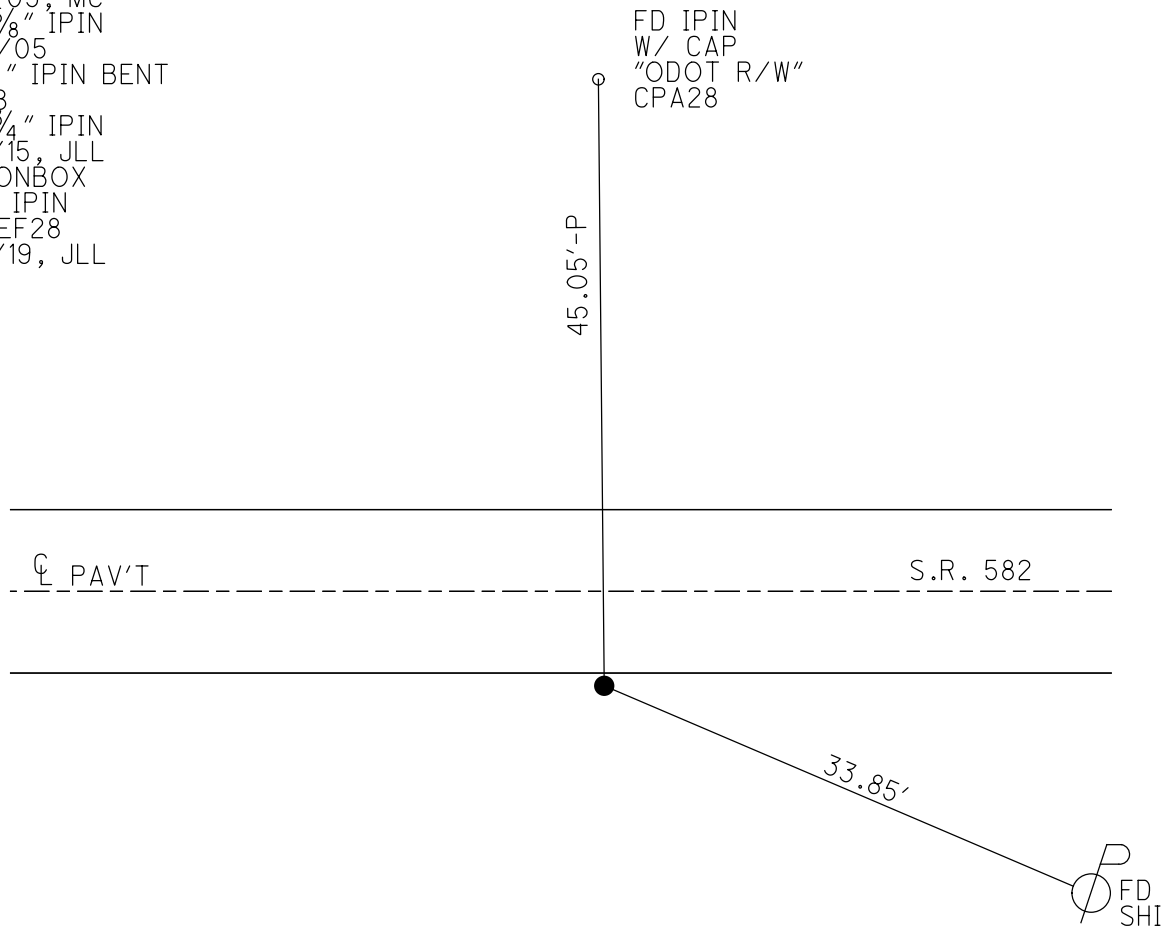

O.D.O.T. DISTRICT 2 SURVEY OFFICE (USE ONLY)

PERSONNEL

REFERENCE NO. 29

SHEET 8 OF 21

NOTES LEU

DATE 4-15-15

ROUTE SR 582

H.C. WESTFALL

WEATHER SUNNY

COUNTY WOOD

R.C. LEU

TEMP. 41°

TOWNSHIP WEBSTER

SECTION 26

DWG BY WHITAKER PID NO PID

T 6 N R 11 E

TYPE MONUMENT MAG/WASHER

ON SURFACE - ~~BELOW~~ ON

OFFSET CL PAVEMENT 8.8' LT : RT

- TO - EDGE PAVEMENT


STATION: 500+78.48

HORIZ.DATUM: NAD83 2011


GEOID: NAVD88 2018

GRID: NORTHING: 654208.206

EASTING: 1674902.066

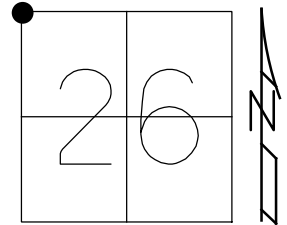

RECORD:
FD P.K.NAIL
4/19/05, MC
SET MAG/WASHER
8/23/05, MDB
FD MAG/WASHER
REF29
4/15/15, JLL
FD MONBOX
W/ 1" IPIN
NEWREF29
11/14/19, JLL
FD MONBOX
W/ 1" IPIN
REF29
8-31-21, JFO

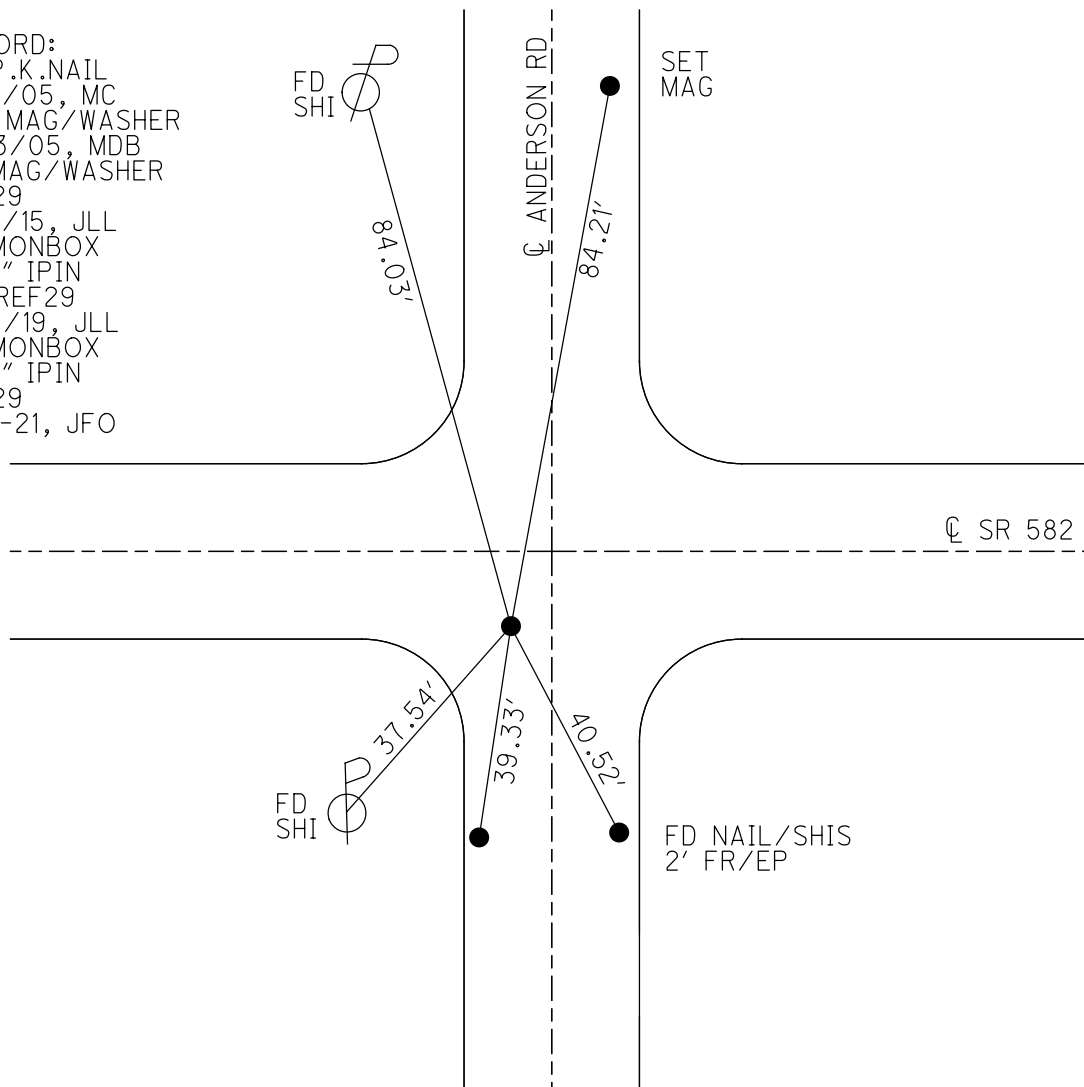

O.D.O.T. DISTRICT 2 SURVEY OFFICE (USE ONLY)

PERSONNEL

REFERENCE NO. 30

SHEET 9 OF 21

NOTES LEU

DATE 4-24-19

ROUTE SR 582

H.C. LEU

WEATHER SUNNY/WINDY

COUNTY WOOD

R.C. JAMES

TEMP. 50°

TOWNSHIP WEBSTER

DWG BY WHITAKER

PID NO PID

SECTION 26

T 6 N R 11 E

TYPE MONUMENT MAG/WASHER

ON SURFACE - ~~BELOW~~ ON

OFFSET Q PAVEMENT 6.6' LT : ~~RT~~

2.9' TO LT EDGE PAVEMENT


STATION: 527+52.16

HORZ.DATUM: NAD83 2011


GEOID: NAVD88 2018

GRID: NORTHING: 654118.766

EASTING: 1677574.048

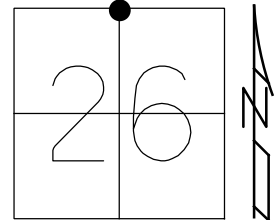

RECORD:
FD P.K./WASHER
4/19/05, MC
FD MAG/WASHER
REF30
4/15/15, JLL
FD MONBOX
W/ 1" IPIN
NEWREF30
11/14/19, JLL
FD MONBOX
W/ 1" IPIN
REF30
8-31-21, JFO

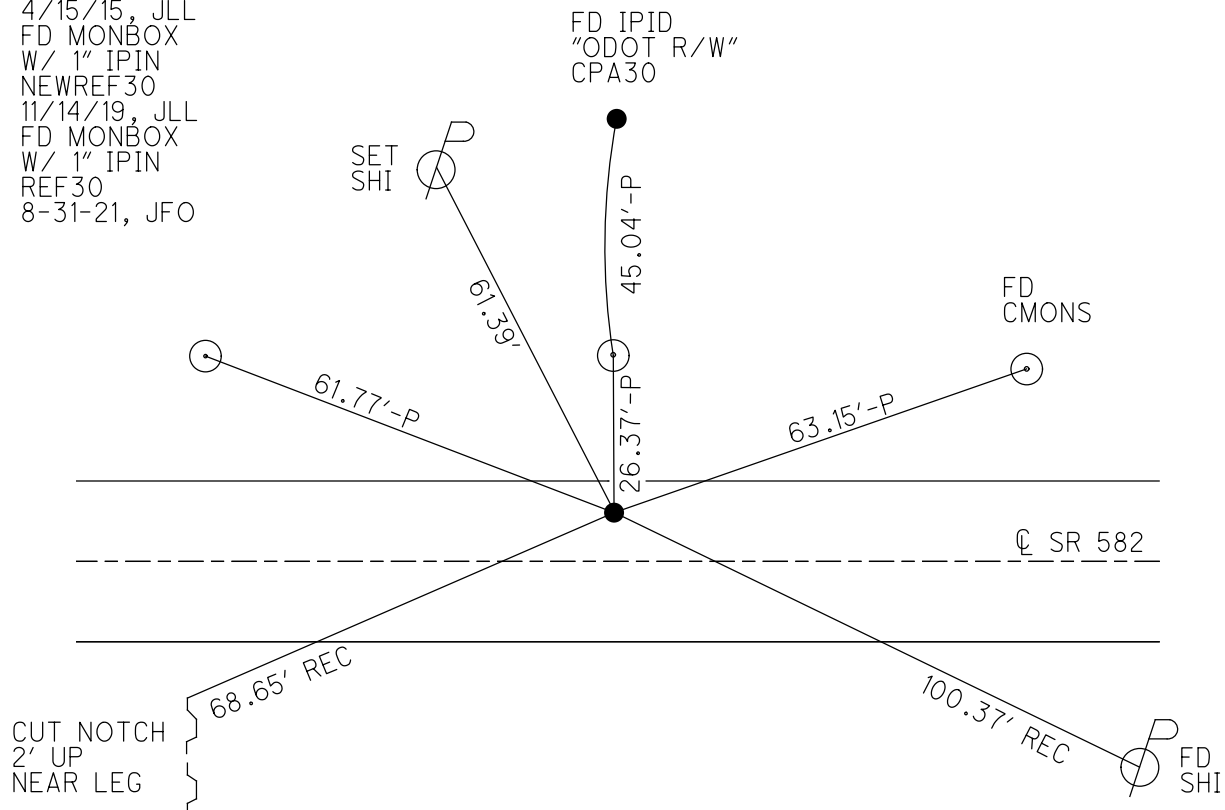

O.D.O.T. DISTRICT 2 SURVEY OFFICE (USE ONLY)

PERSONNEL

REFERENCE NO. 31

SHEET 11 OF 21

NOTES JAMES

DATE 4/24/19

ROUTE SR 582

H.C. JAMES

WEATHER CLOUDY

COUNTY WOOD

R.C. LEU

TEMP. 55°

TOWNSHIP WEBSTER

SECTION 25

DWG BY BALBAUGH PID 81000

T 6 N R 11 E

TYPE MONUMENT MAG/WASHER

ON SURFACE - ~~BELOW~~ ON

OFFSET CL PAVEMENT 9.6' ~~LT~~ : RT

0.2' TO RT EDGE PAVEMENT


STATION: 554+32.24

HORIZ.DATUM: NAD83 (2011)


GEOID: 2012A

GRID: NORTHING: 654006.583

EASTING: 1680251.676

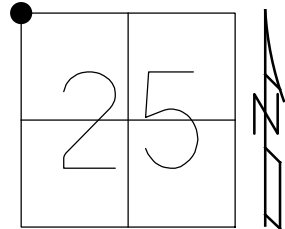

RECORD:
FD P.K./WASHER
4/19/05, MDB
FD 1" IPIN
10" DOWN
PROBED TO STONE
5' DOWN
SET 1" IPIN ATOP STONE
15" DOWN
5/20/05
SET MAG/WASHER
9/2/05, MDB
FD MONBOX
W/ 1" IPIN
NEWREF31
11/14/19, JLL

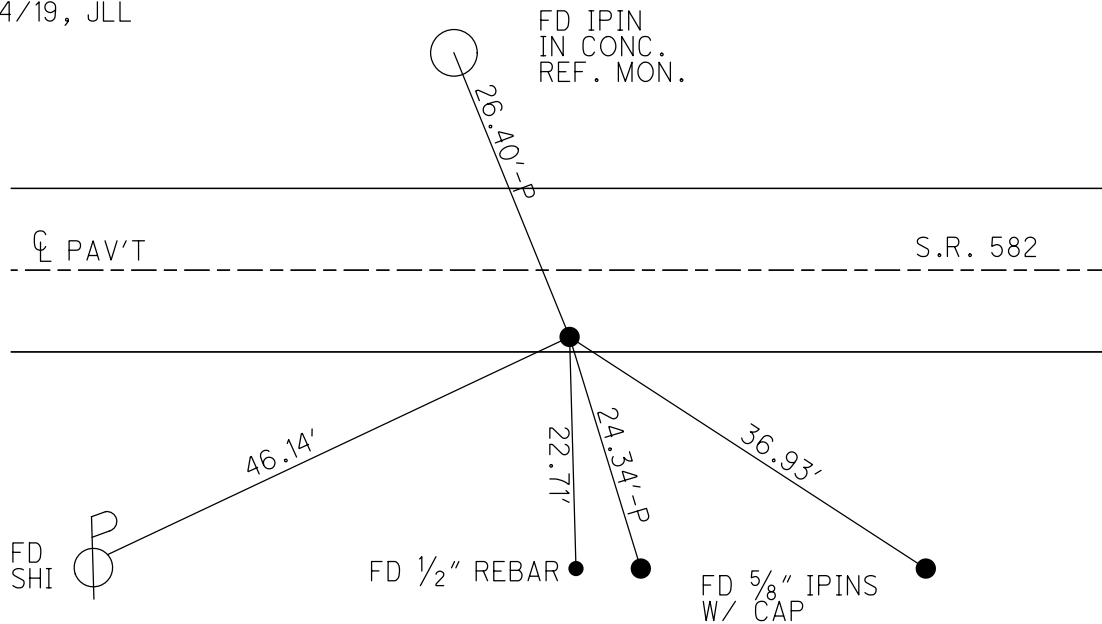

O.D.O.T. DISTRICT 2 SURVEY OFFICE

PERSONNEL

REFERENCE NO. 32


SHEET 11 OF 20

NOTES BARNHISEL
H.C. CANTERBURY
R.C. MIKLOVIC

DATE 04/19/05
WEATHER CLOUDY
TEMP. +60°


ROUTE S.R. 582
COUNTY WOOD
TOWNSHIP WEBSTER
SECTION 25
T 6 N R 11 E

TYPE MONUMENT PK & WASHER
ON SURFACE - BELOW YES
~~LEFT~~ - Q PAV'T - RIGHT 0.7'
9.1' TO RT EDGE PAVEMENT
S.L.M. 581+13

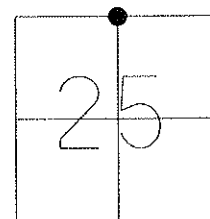

GRID: NORTHING:

EASTING:

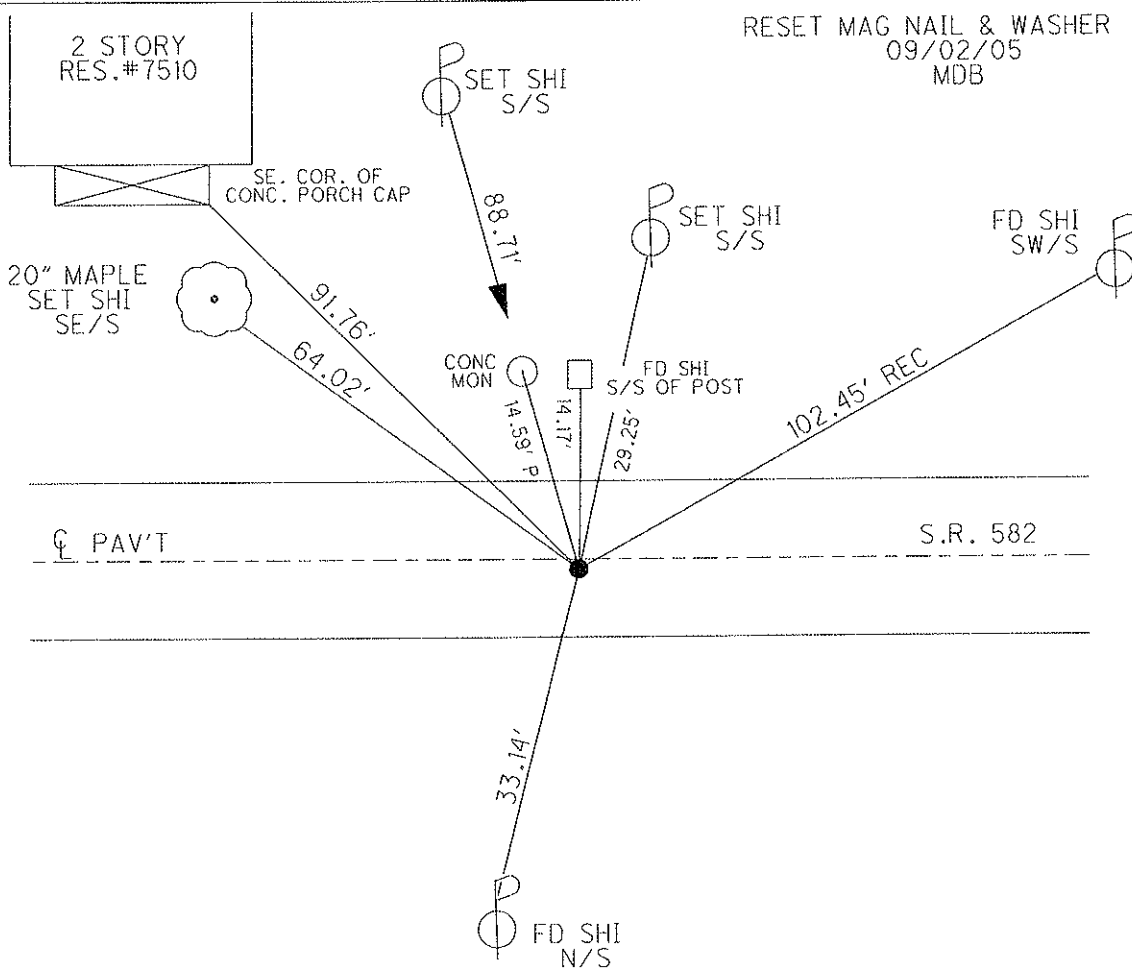

O.D.O.T. DISTRICT 2 SURVEY OFFICE

PERSONNEL

REFERENCE NO. 33

SHEET 12 OF 20

NOTES BARNHISEL

DATE 05/20/05

ROUTE S.R. 582

H.C. CANTERBURY

WEATHER CLOUDY

COUNTY WOOD

R.C. MIKLOVIC

TEMP. +60°

TOWNSHIP WEBSTER

SECTION 30

T 6 N R 11 E


TYPE MONUMENT PK NAIL

ON SURFACE - ~~BELOW~~ ON

~~LEFT~~ - CL PAV'T - RIGHT 1.9'


TO EDGE PAVEMENT

S.L.M. 607+83

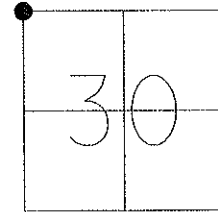

GRID: NORTHING:

EASTING:

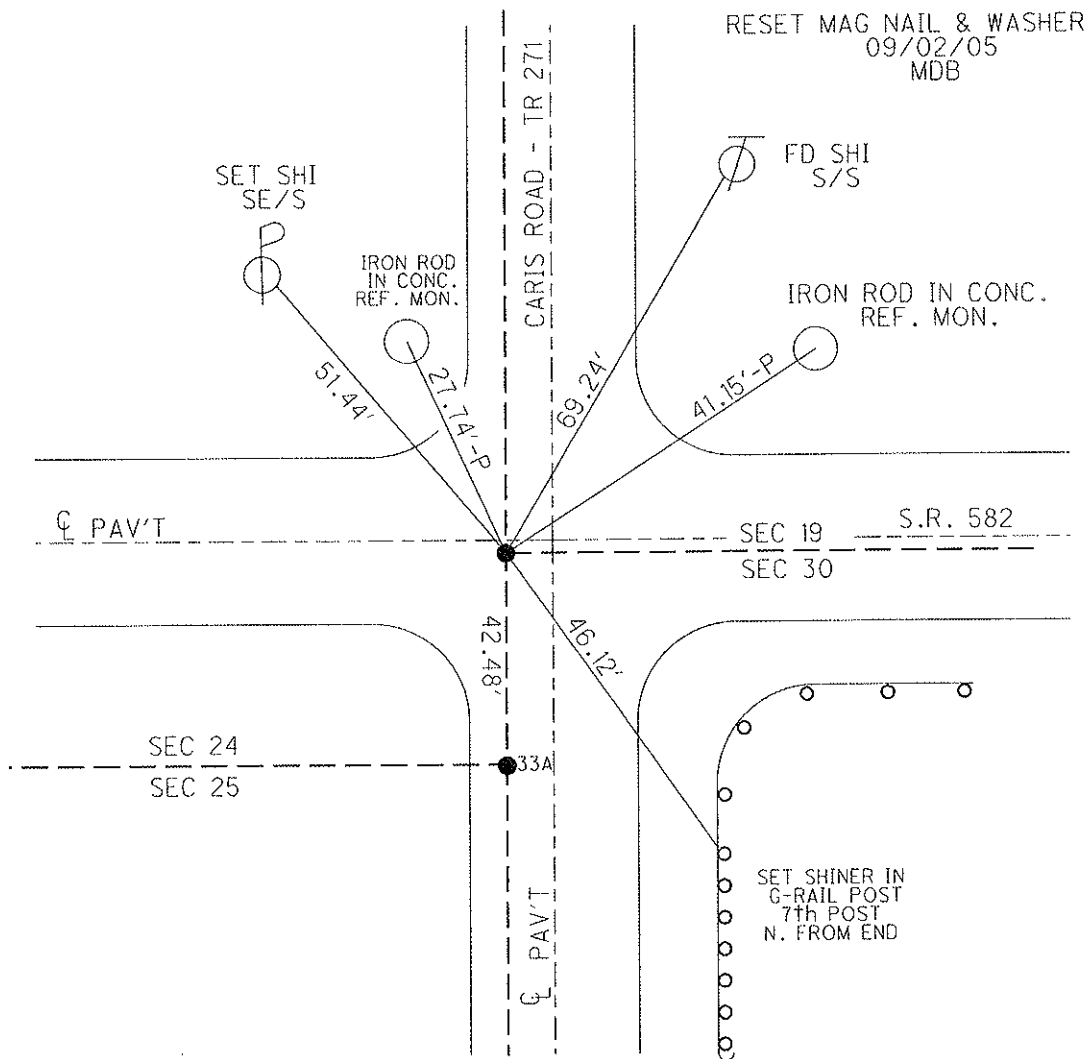

O.D.O.T. DISTRICT 2 SURVEY OFFICE

PERSONNEL

NOTES BARNHISEL
H.C. CANTERBURY
R.C. MIKLOVIC



REFERENCE NO. 33 A

DATE 05/20/05
WEATHER CLOUDY
TEMP. +60°

SHEET 13 OF 20


ROUTE S.R. 582
COUNTY WOOD
TOWNSHIP WEBSTER
SECTION 30
T 6 N R 11 E

TYPE MONUMENT BOAT SPIKE
~~ON SURFACE~~ - BELOW 1"
LEFT - Q PAV'T - ~~RIGHT~~ 2.3' OF Q TR 271
TO EDGE PAVEMENT
S.L.M. 607+83

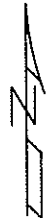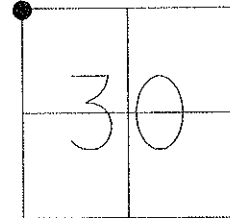

GRID: NORTHING:

EASTING:

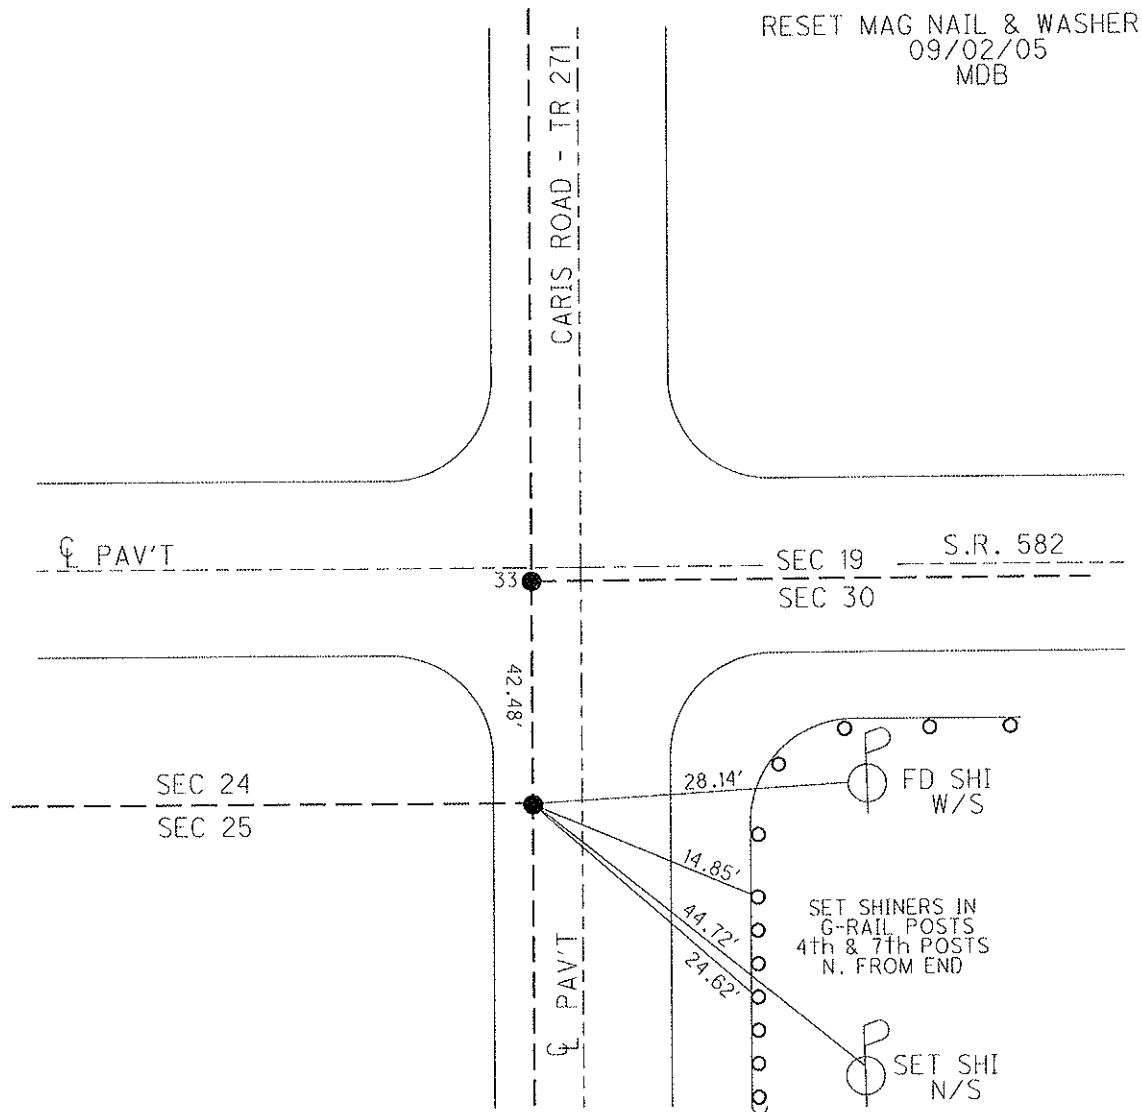

O.D.O.T. DISTRICT 2 SURVEY OFFICE (USE ONLY)

PERSONNEL

REFERENCE NO. 34

SHEET 15 OF 21

NOTES MILLER
H.C. MILLER
R.C. BARRIERE

DATE 10/1/24
WEATHER CLOUDY
TEMP. 71°

ROUTE SR 582
COUNTY WOOD
TOWNSHIP WEBSTER
SECTION 30

DWG BY PRESTON-COLVIN PID PAVING TRAIN

T 6 N R 11 E

TYPE MONUMENT MAG SHANK

ON SURFACE - ~~BELOW~~ ON

OFFSET Q PAVEMENT 0.8' ~~LT~~ : RT

10.3' TO LT EDGE PAVEMENT

STATION: 636+76.8

HORIZ.DATUM: NAD83 (2011)


GEOID: NAVD88 2018

GRID: NORTHING: 653873.549

EASTING: 1690446.417

LDP: NORTHING: 476191.728

EASTING: 199272.026

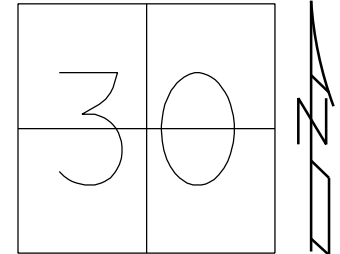


RESET MAG & WASHER
09-02-2005 M.D.B.

FND MAG & WASHER
GPS, REF 34
03-11-14, T.M.R.

FND MAG & WASHER
GPS REF 34
06-16-2015

FD MAG SHANK
REF34
10/1/24, JAM

FD MAG SHANK
10/10/24, TDN

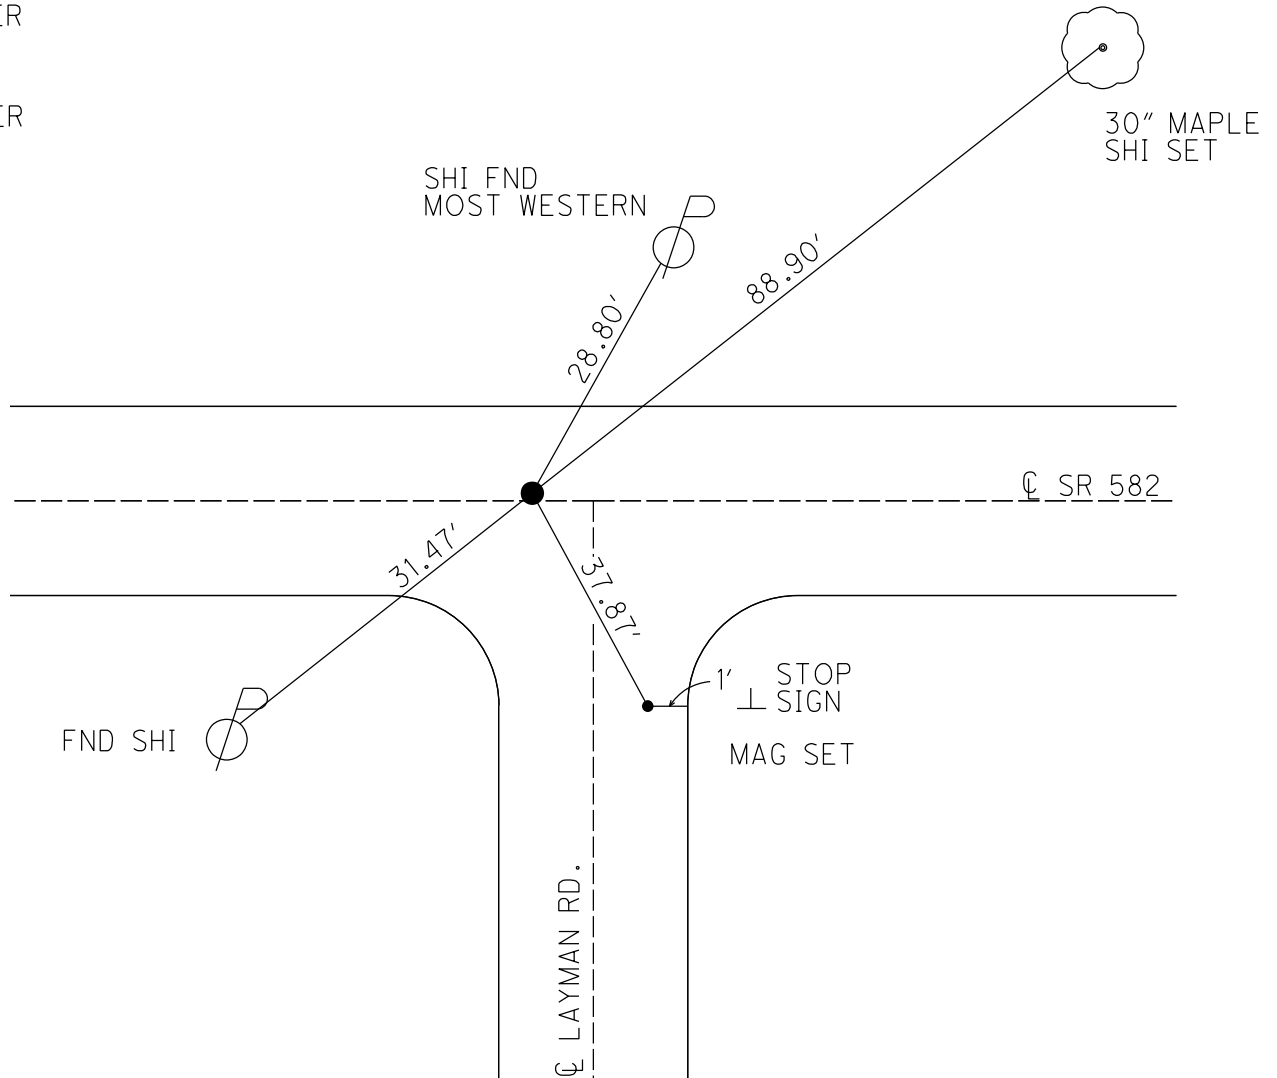

O.D.O.T. DISTRICT 2 SURVEY OFFICE (USE ONLY)

PERSONNEL

REFERENCE NO. 35

SHEET 16 OF 21

NOTES MILLER

DATE 10/1/24

ROUTE SR 582

H.C. MILLER

WEATHER CLOUDY

COUNTY WOOD

R.C. BARRIERE

TEMP. 71°

TOWNSHIP WEBSTER

SECTION 29

DWG BY PRESTON-COLVIN PID PAVING TRAIN

T 6 N R 11 E

TYPE MONUMENT MAG/WASHER

ON SURFACE - ~~BELOW~~ ON

OFFSET $\varnothing$ PAVEMENT 2.5" ~~LT~~ : RT

9' TO LT EDGE PAVEMENT

STATION: 663+35.82

HORIZ.DATUM: NAD83 (2011)


GEOID: NAVD88 2018

GRID: NORTHING: 653854.021

EASTING: 1691169.064

LDP: NORTHING: 476206.86

EASTING: 201931.166

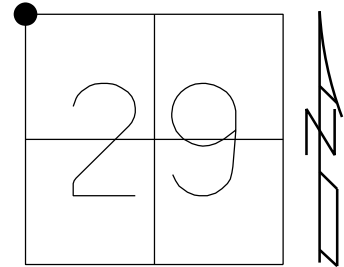


RESET MAG & WASHER
09-02-2005 M.D.B.

FND MAG & WASHER
GPS, REF 35
03-11-14, T.M.R.

FND MAG & WASHER
GPS REF 35
06-16-2015

FD MAG/WASHER
REF 35
10/1/24, JAM

FD MAG/WASHER
10/10/24, TDN

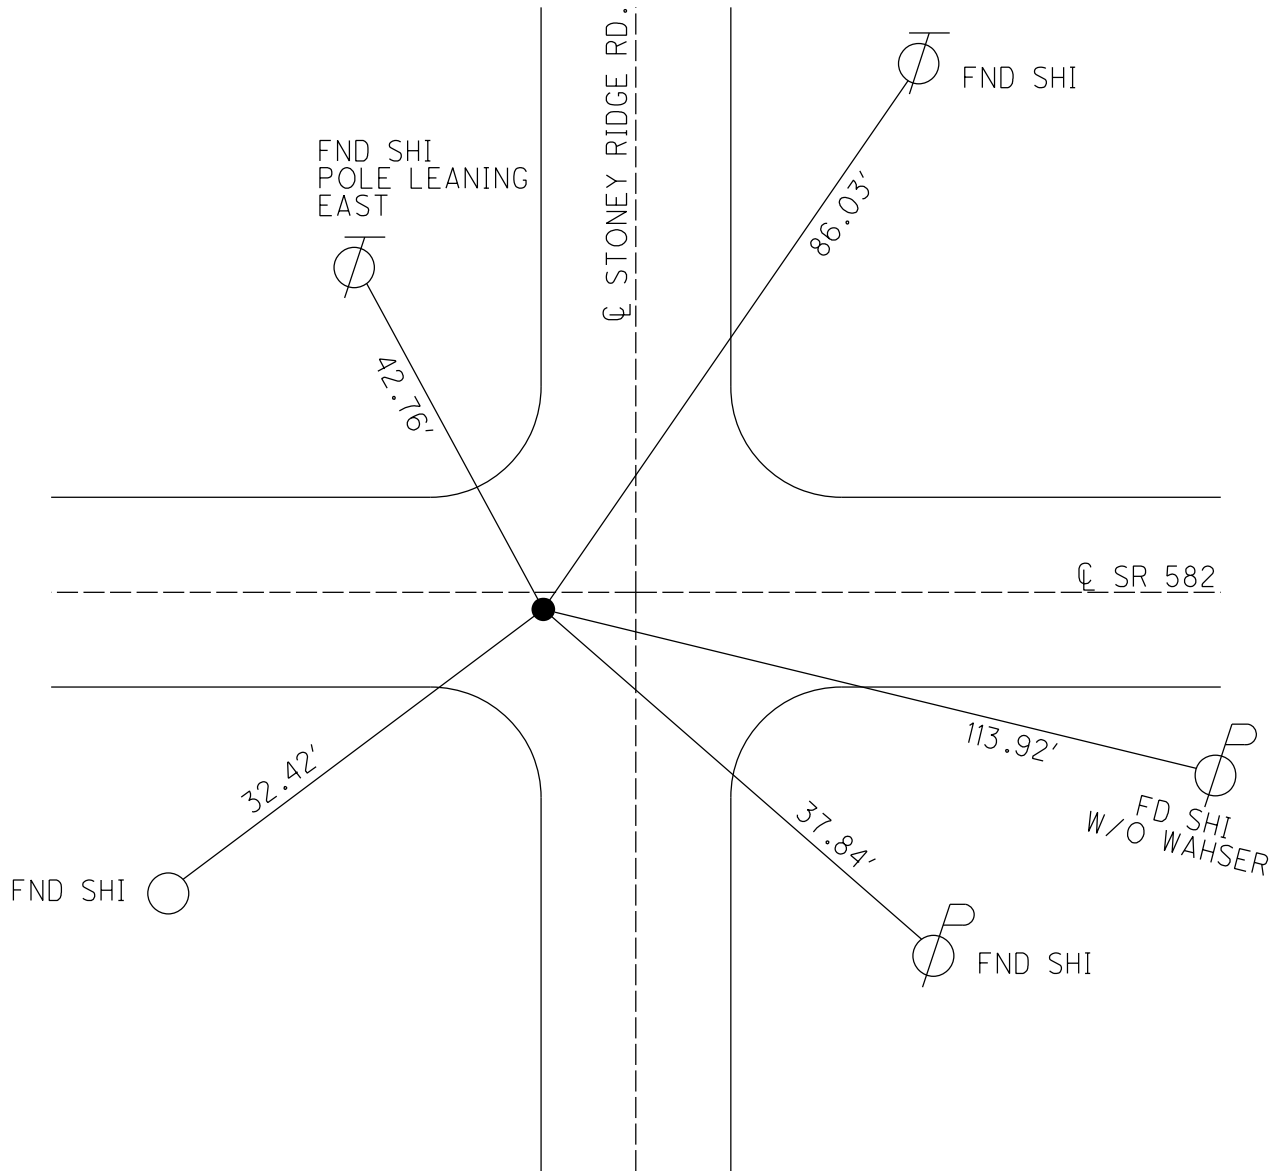

O.D.O.T. DISTRICT 2 SURVEY OFFICE (USE ONLY)

PERSONNEL

REFERENCE NO. 36

SHEET 17 OF 21

NOTES MILLER

DATE 10/1/24

ROUTE SR 582

H.C. MILLER

WEATHER CLOUDY

COUNTY WOOD

R.C. BARRIERE

TEMP. 71°

TOWNSHIP WEBSTER

SECTION 29

DWG BY PRESTON-COLVIN PID PAVING TRAIN

T 6 N R 11 E

TYPE MONUMENT LG RR SPIKE

ON SURFACE - ~~BELOW~~ ON

OFFSET CL PAVEMENT 6.3' ~~LT~~ : RT

9' TO LT EDGE PAVEMENT

STATION: 663+35.82

HORIZ.DATUM: NAD83 (2011)


GEOID: NAVD88 2018

GRID: NORTHING: 653833.779


EASTING: 1693825.223

LDP: NORTHING: 476221.69

EASTING: 204587.511

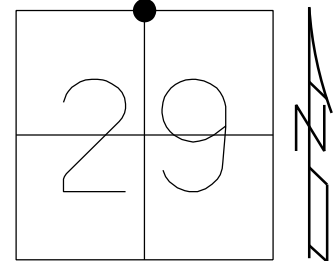

SET MAG/WASHER
9/02/05, MDB
FD MAG SHANK
REF36
10-2-2020, DSA
SET LG.R.R.SPIKE
12-3-2020, DSA
FD LG RR SPIKE
10/1/24, JAM
SET MAG/WASHER
10/10/24, TDN

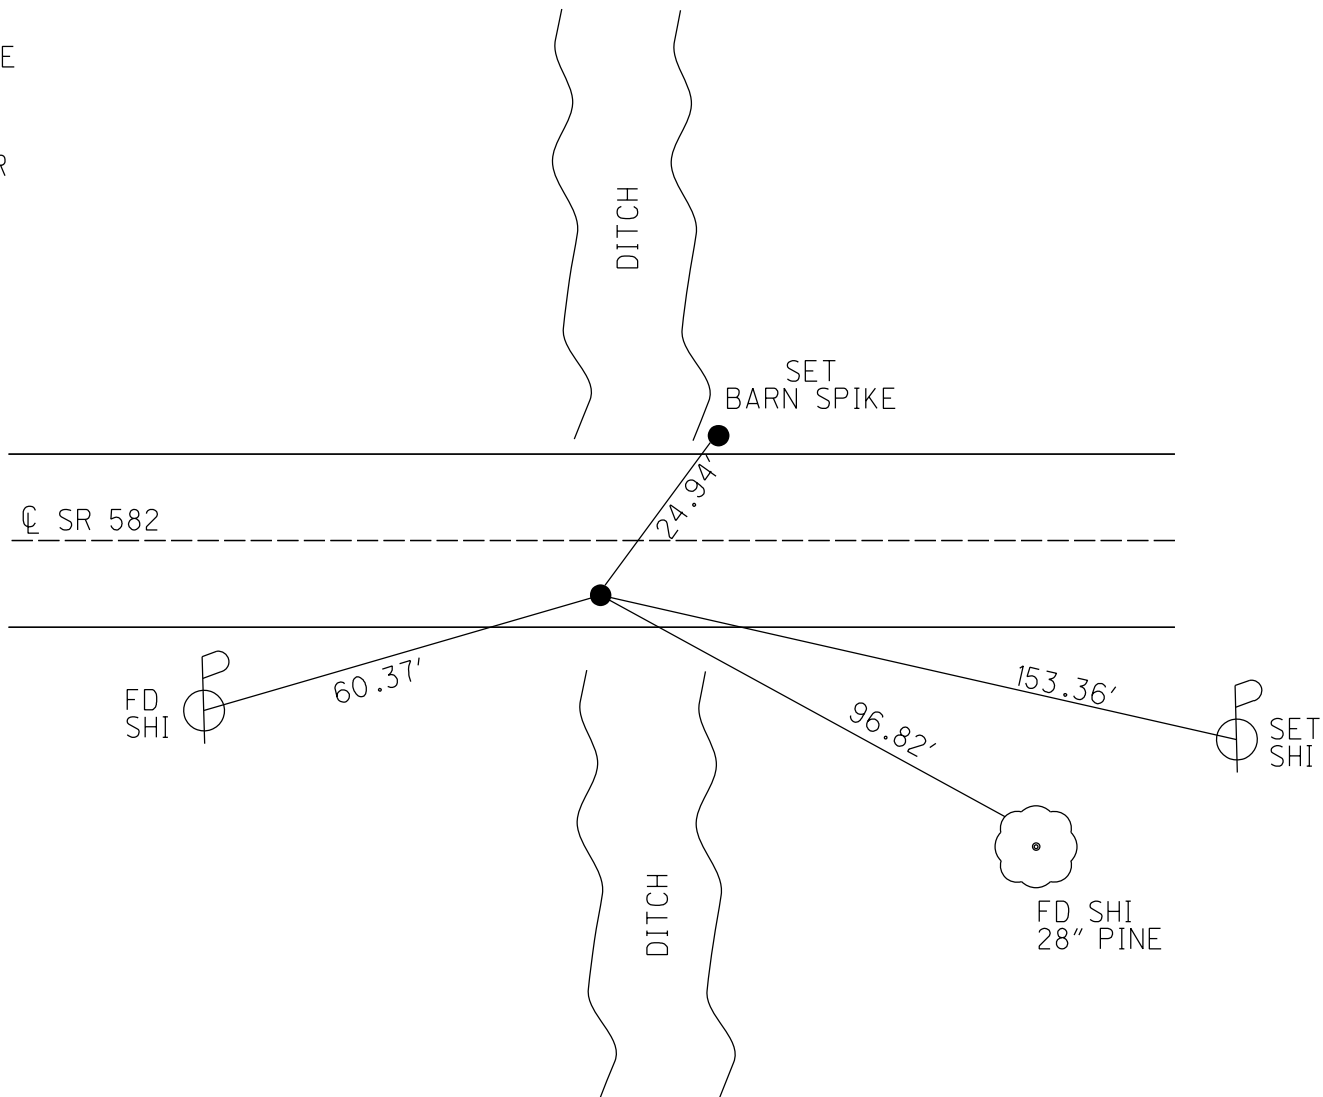

O.D.O.T. DISTRICT 2 SURVEY OFFICE (USE ONLY)

PERSONNEL

REFERENCE NO. 36 A

SHEET 18 OF 21

NOTES MILLER
H.C. MILLER
R.C. BARRIERE

DATE 10/1/24
WEATHER CLOUDY
TEMP. 71°

ROUTE SR 582
COUNTY WOOD
TOWNSHIP WEBSTER
SECTION 29

DWG BY PRESTON-COLVIN PID PAVING TRAIN

T 6 N R 12 E

TYPE MONUMENT MAG SHANK

ON SURFACE - ~~BELOW~~ ON

OFFSET CL PAVEMENT 5.7' ~~LT~~ : RT

3.8' TO RT EDGE PAVEMENT

STATION: 703+67

HORIZ.DATUM: NAD83 (2011)


GEOID: NAVD88 2018

GRID: NORTHING:

EASTING:

LDP: NORTHING: 476229.855


EASTING: 205915.861

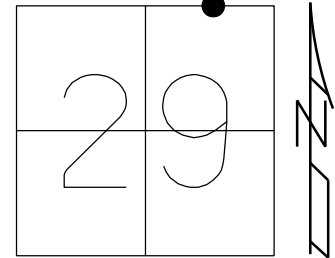

RESET MAG NAIL & WASHER
09/02/05, MDB

FD MAG SHANK
REF36A
10/1/24, JAM

FD MAG SHANK
10/10/24, TDN

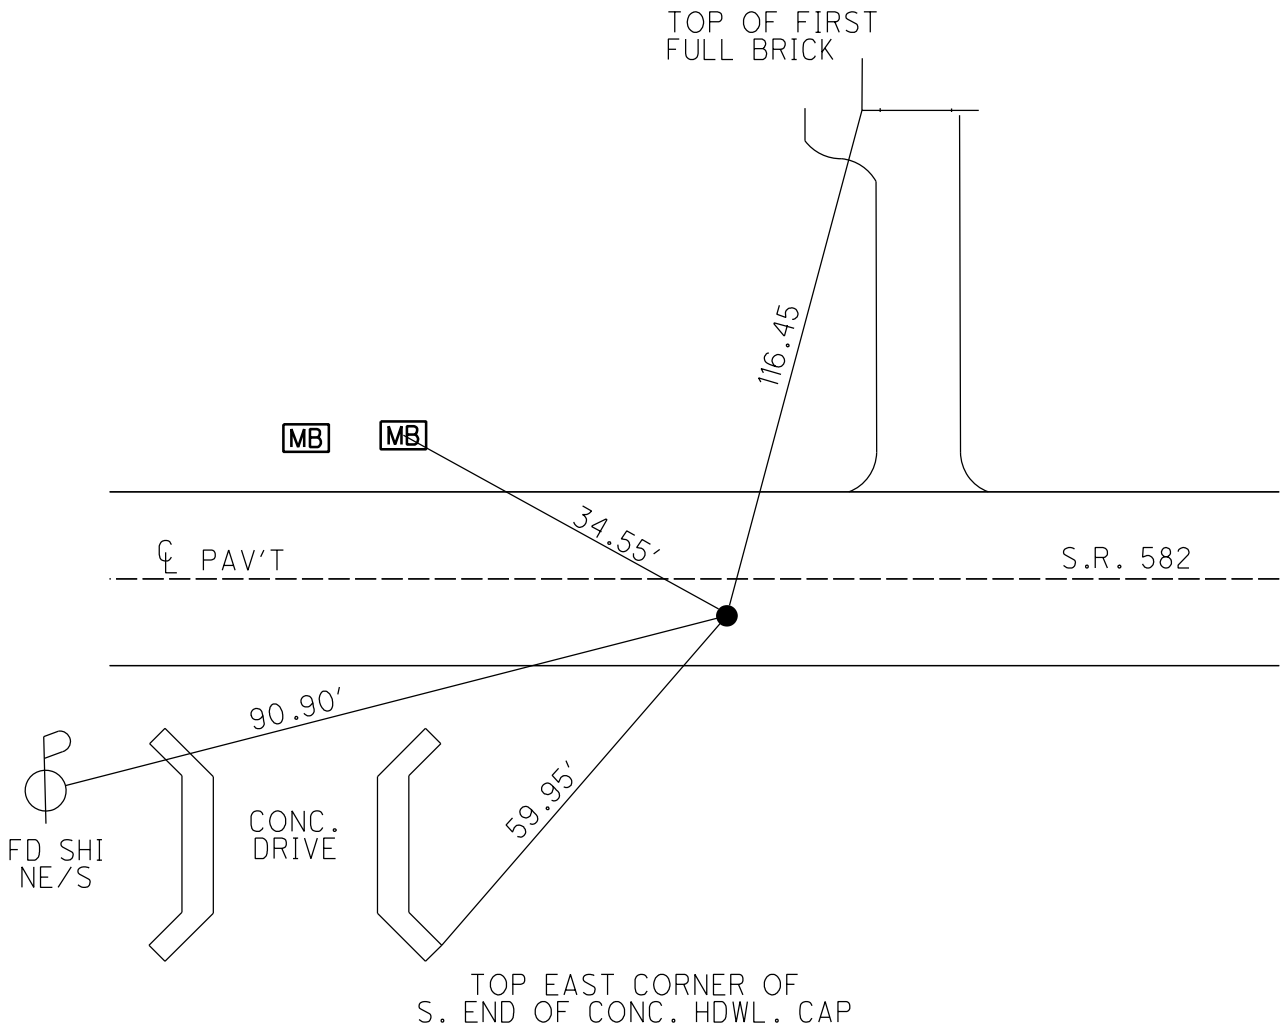

O.D.O.T. DISTRICT 2 SURVEY OFFICE

PERSONNEL

REFERENCE NO. 37



SHEET 18 OF 20

NOTES BARNHISEL
H.C. CANTERBURY
R.C. MIKLOVIC

DATE 05/20/05
WEATHER SUNNY
TEMP. +65°

ROUTE S.R. 582
COUNTY WOOD
TOWNSHIP TROY
SECTION 28
T 6 N R 12 E

TYPE MONUMENT PK & WASHER
ON SURFACE - BELOW YES
LEFT - Q PAV'T - RIGHT 5.9'
TO EDGE PAVEMENT
S.L.M. 716+96, 5.8' S. OF Q PAV'T WEST
GRID: NORTHING: EASTING:

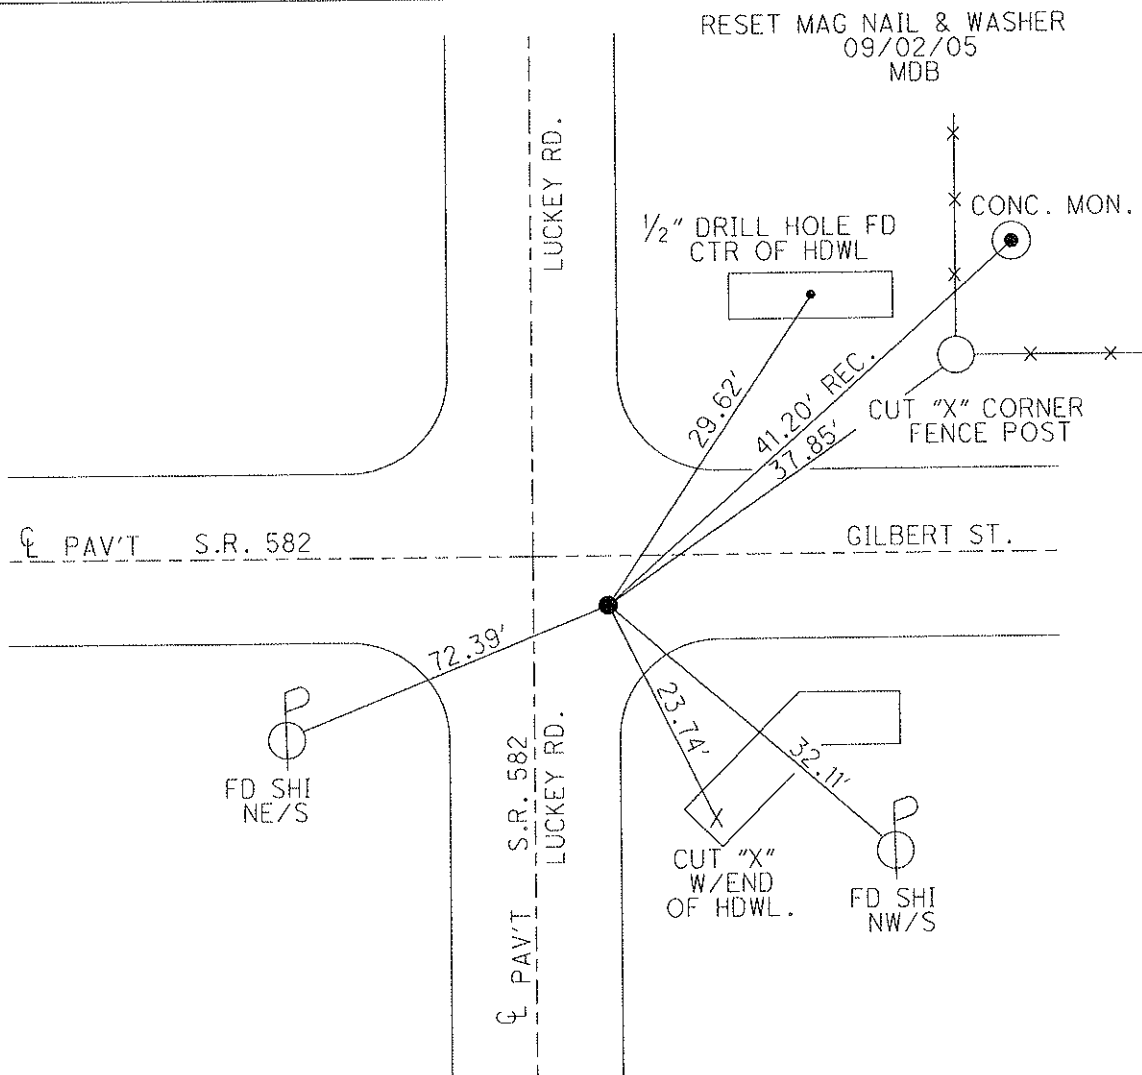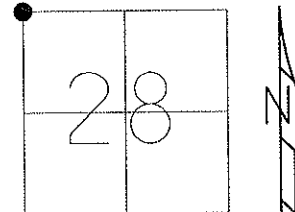

O.D.O.T. DISTRICT 2 SURVEY OFFICE

PERSONNEL

REFERENCE NO. 37 A

SHEET 19 OF 20

NOTES BARNHISEL

DATE 05/20/05

ROUTE S.R. 582

H.C. CANTERBURY

WEATHER SUNNY

COUNTY WOOD

R.C. MIKLOVIC

TEMP. +65°

TOWNSHIP TROY

SECTION 28

T 6 N R 12 E

TYPE MONUMENT PK & WASHER

ON SURFACE - ~~BELOW~~ YES



LEFT - Q PAV'T ~~RIGHT~~ 6.7'

3.2' TO LT EDGE PAVEMENT

S.L.M. 730+37


GRID: NORTHING:

EASTING:

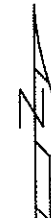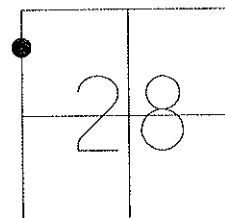

RECORD: $\frac{1}{16}$ COR. OF SEC 28

RESET MAG NAIL & WASHER
09/02/05
MDB

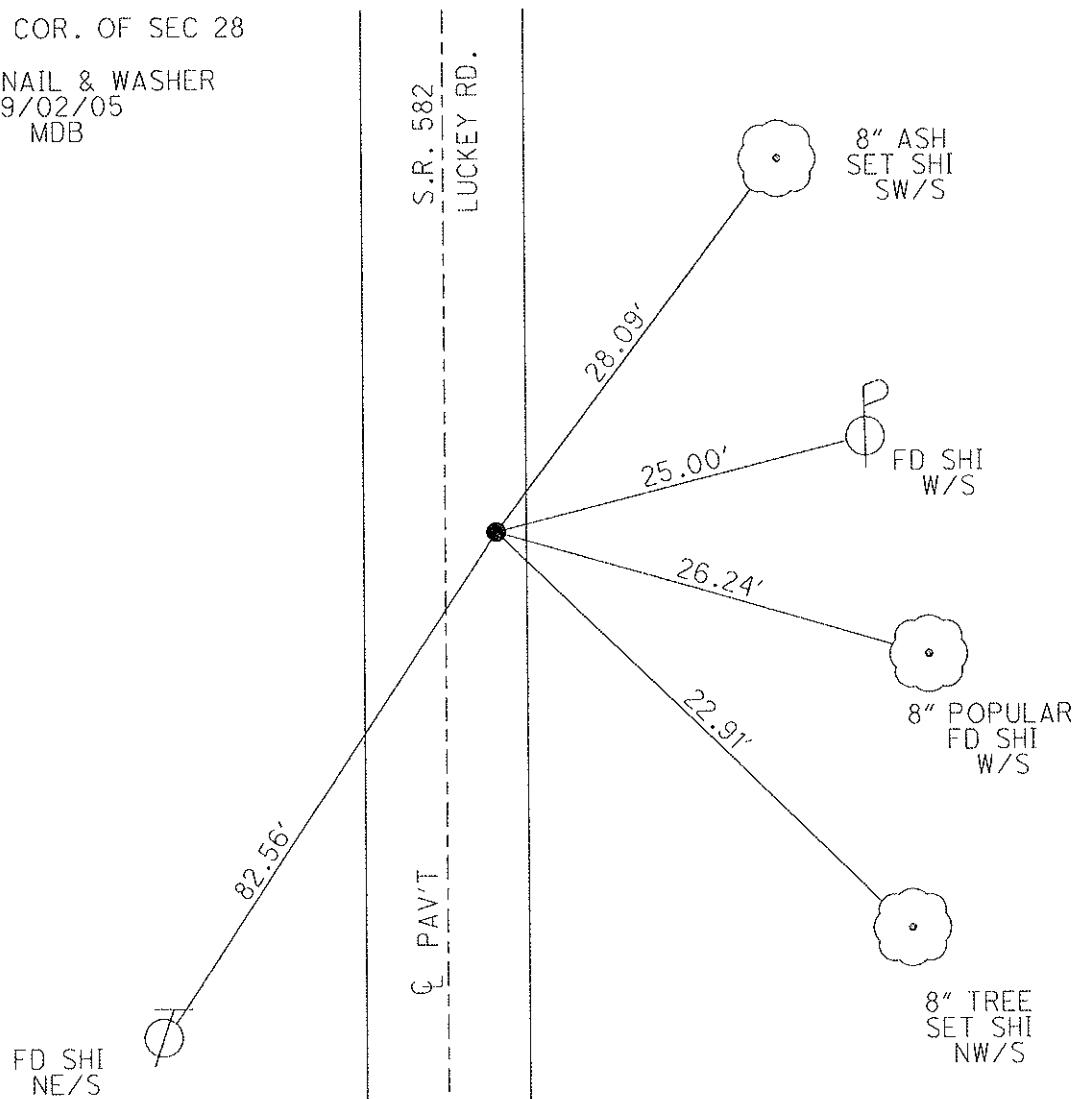

O.D.O.T. DISTRICT 2 SURVEY OFFICE

PERSONNEL

NOTES BARNHISEL
H.C. CANTERBURY
R.C. MIKLOVIC


REFERENCE NO. 37 B

DATE 05/20/05
WEATHER SUNNY
TEMP. +65°

SHEET 20 OF 20

ROUTE S.R. 582
COUNTY WOOD
TOWNSHIP TROY
SECTION 28
T 6 N R 12 E


TYPE MONUMENT PK & WASHER
ON SURFACE - BELOW YES
~~LEFT~~ - Q PAV'T - RIGHT 6.0'
15.5' TO RT EDGE PAVEMENT
S.L.M. 733+93

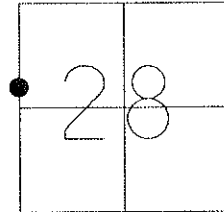

GRID: NORTHING:

EASTING:

RESET MAG NAIL & WASHER
09/02/05
MDB

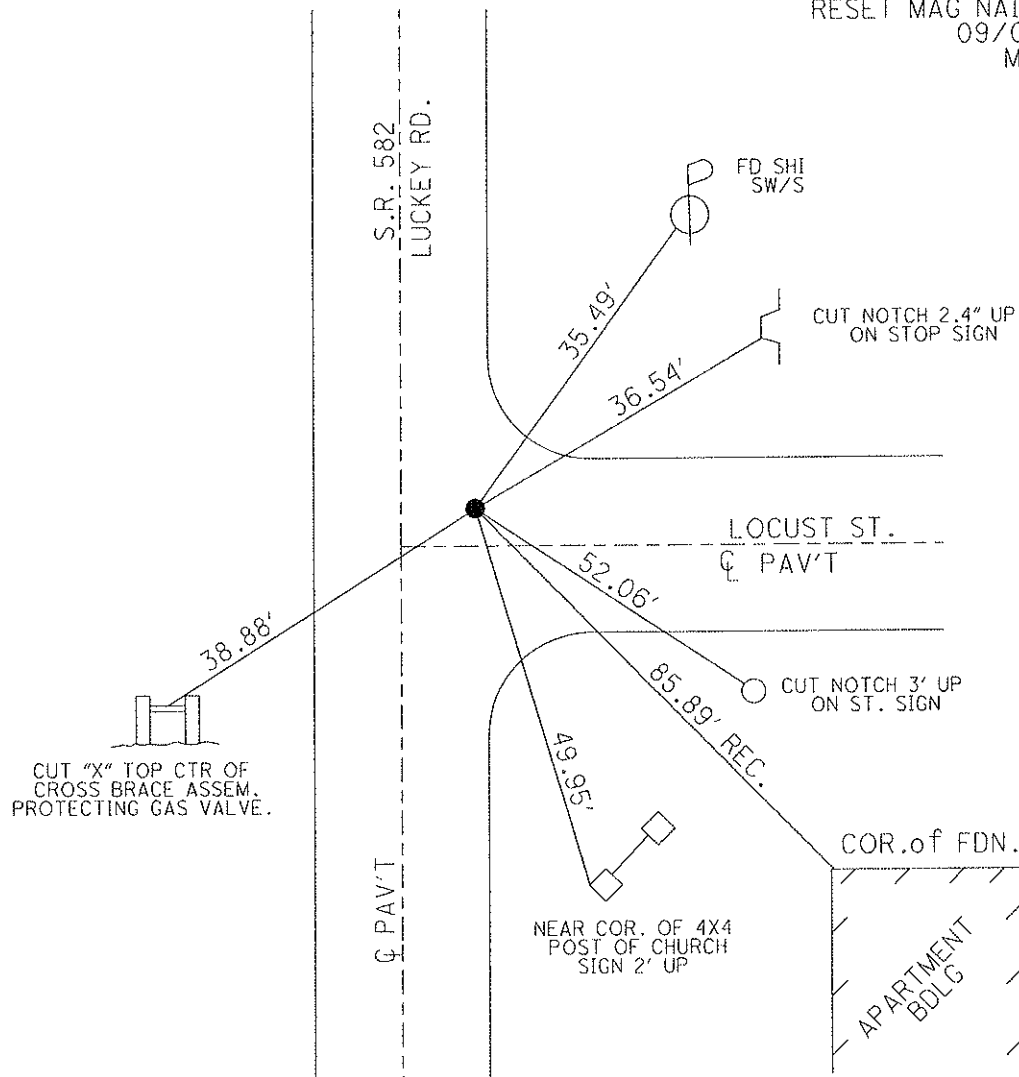

O.D.O.T. DISTRICT 2 SURVEY OFFICE

PERSONNEL

NOTES _____
H.C. _____
R.C. _____

REFERENCE NO. 38



DATE 4/27/10
WEATHER SUNNY
TEMP. 40°

SHEET 1 OF 29

ROUTE S.R. 582
COUNTY WOOD
TOWNSHIP TROY
SECTION 28
T 6 N R 12 E

TYPE MONUMENT MAG & WASHER
ON SURFACE - BELOW YES
LEFT - CL PAV'T - RIGHT 6.6'
15.5' TO RT EDGE PAVEMENT
S.L.M. 740+50 6.4' N. OF CL MAIN ST.

GRID: NORTHING: 651464.0772 EASTING: 1696457.7877

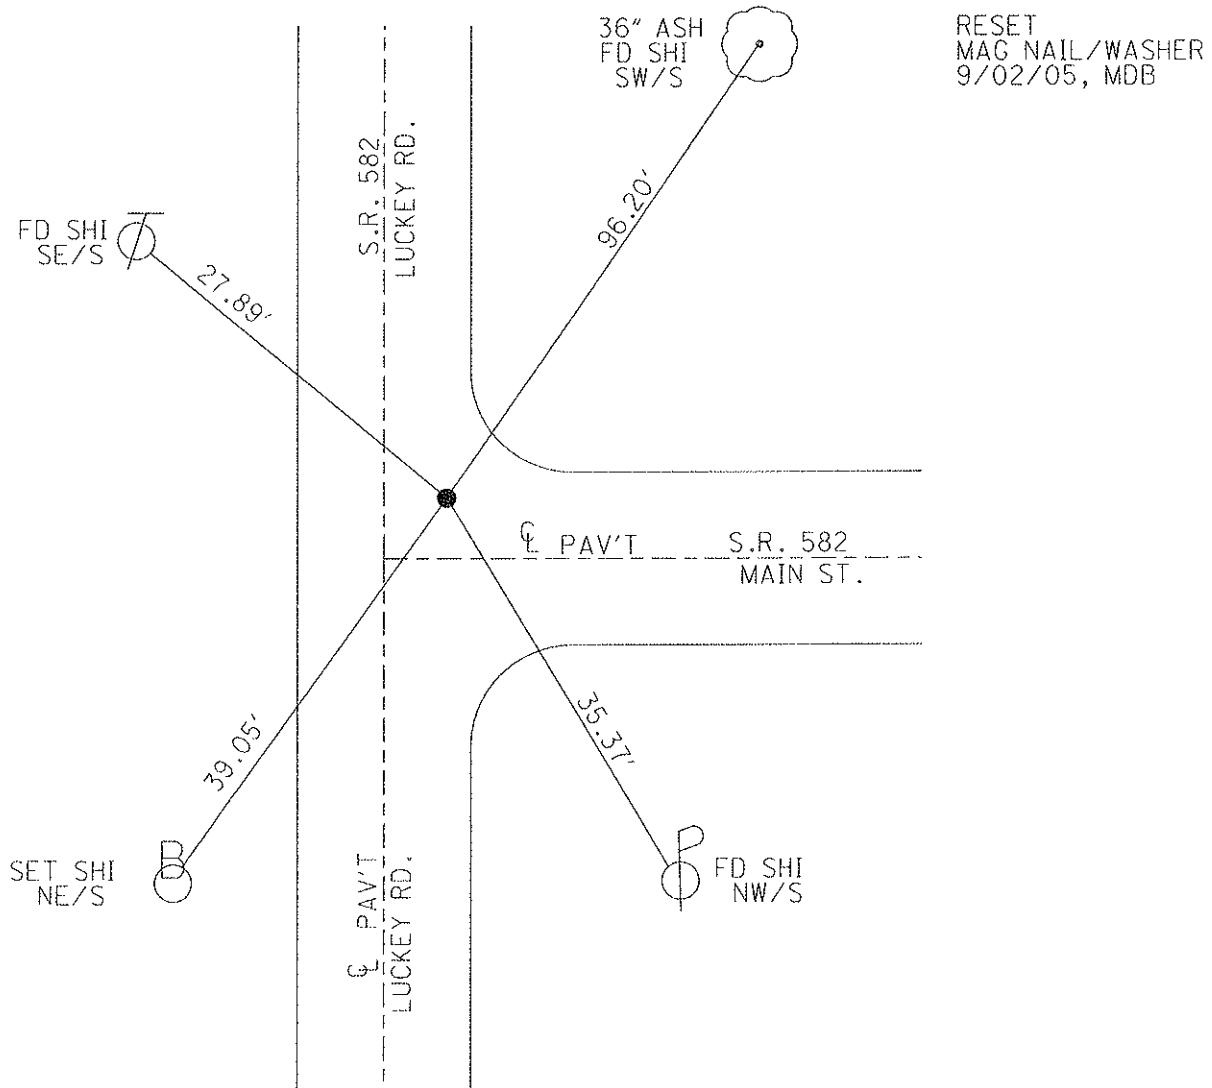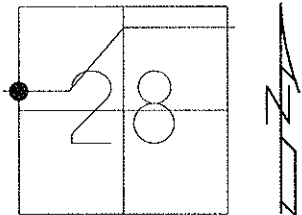

O.D.O.T. DISTRICT 2 SURVEY OFFICE

PERSONNEL

REFERENCE NO. 38 A

SHEET 2 OF 29

NOTES HOMAN

DATE 4/27/10

ROUTE SR 582

H.C. HOMAN

WEATHER SUNNY

COUNTY WOOD

R.C. ROUSOS

TEMP. 40°

TOWNSHIP TROY

SECTION 28

T 6 N R 12 E

TYPE MONUMENT SM. R.R. SPK.


~~ON SURFACE~~ - BELOW 2"

~~LEFT~~ - Q PAV'T - RIGHT 3' RIGHT / 4' EAST OF Q MAPLE

12.4' TO RT EDGE PAVEMENT

S.L.M. 744+81.22 REC


GRID: NORTHING: 651462.247 EASTING: 1696966.224

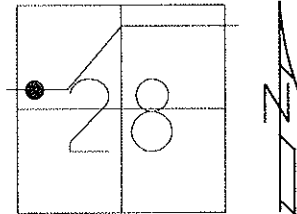

SET PK/WASHER
11-06-90 MB

RESET MAG & WASHER
NEWREFA38 7-8-10 DCH

NOTE: FILE 84803 CTNL

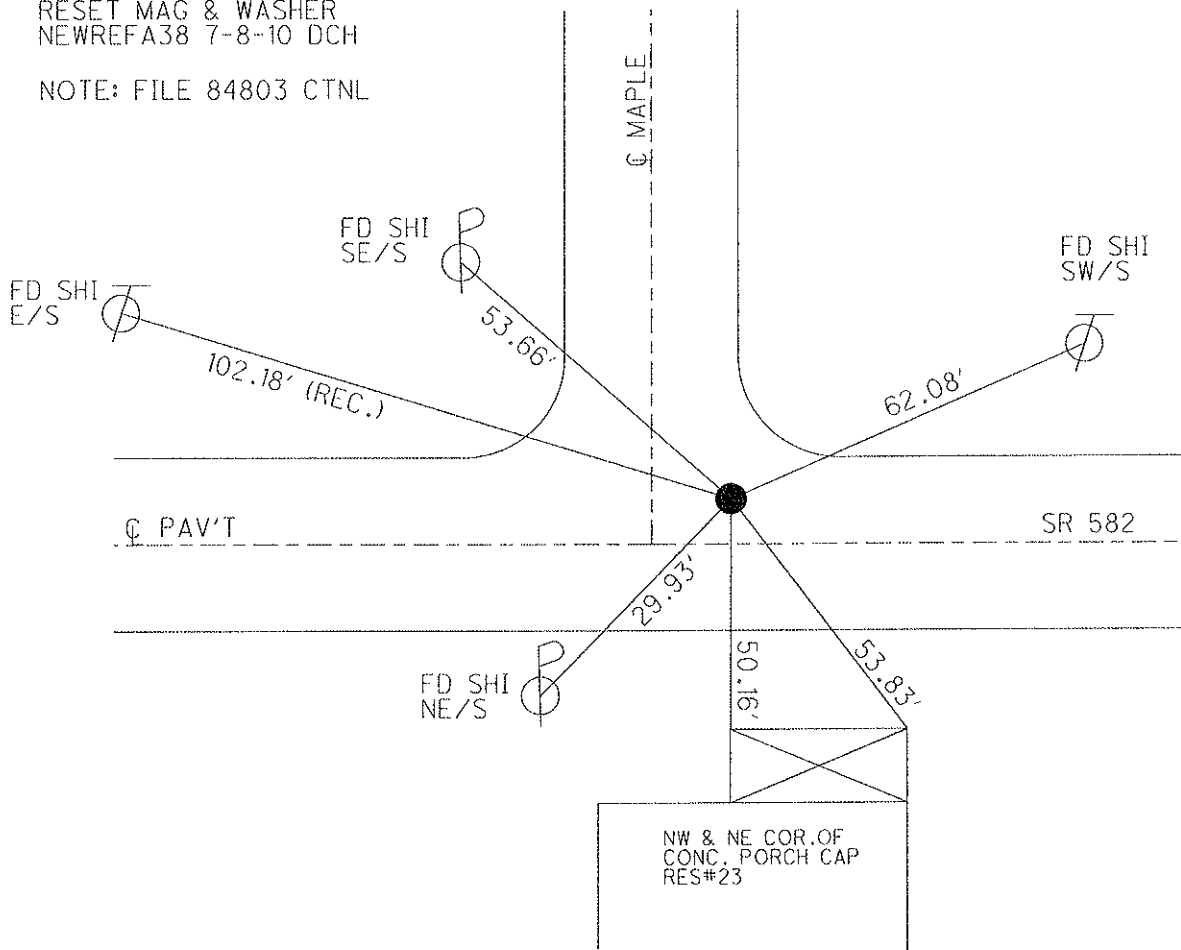

O.D.O.T. DISTRICT 2 SURVEY OFFICE

PERSONNEL

REFERENCE NO. 38 B

SHEET 3 OF 29

NOTES HOMAN

DATE 4-27-10

ROUTE SR 582

H.C. HOMAN

WEATHER SUNNY

COUNTY WOOD

R.C. ROUSOS

TEMP. 40°

TOWNSHIP TROY

SECTION 28

T 6 N R 12 E

TYPE MONUMENT P.K. NAIL


~~ON SURFACE~~ - BELOW 2"

LEFT - Q PAV'T - ~~RIGHT~~ 1.0', (2.5' E OF Q PARK)

9.8' TO LT. EDGE PAVEMENT


S.L.M. 747+59.08

GRID: NORTHING: 651461.262 EASTING: 1697244.118

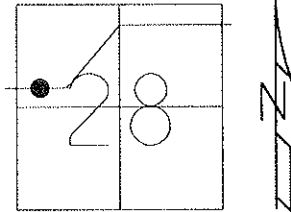

SET PK/WASHER
11-6-90 MB

RESET MAG/WASHER
NEWREFB38 7-08-10 DCH

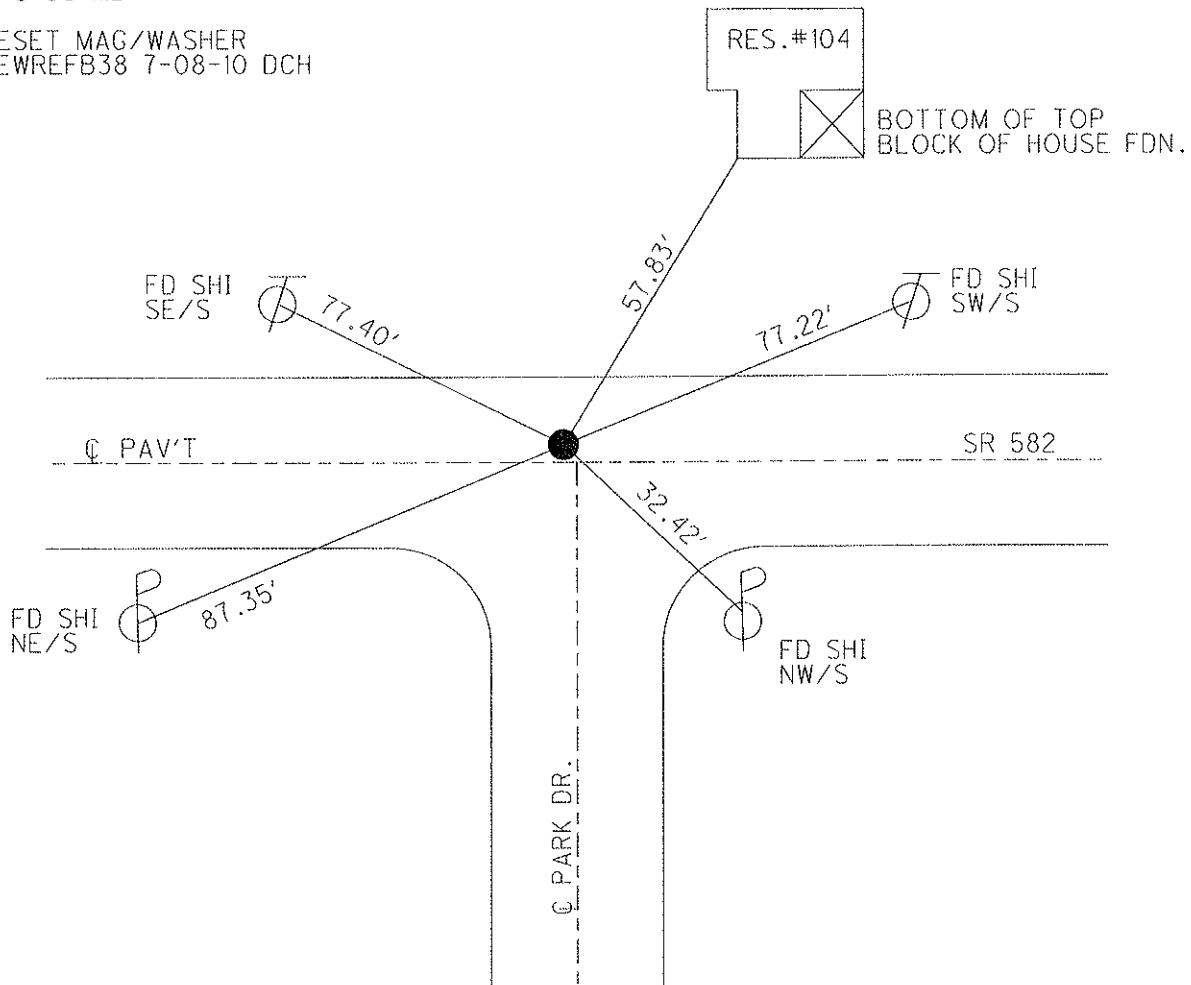

O.D.O.T. DISTRICT 2 SURVEY OFFICE

PERSONNEL

REFERENCE NO. 38 C

SHEET 4 OF 29



NOTES HOMAN
H.C. HOMAN
R.C. ROUSOS

DATE 4-27-10
WEATHER SUNNY
TEMP. 40°

ROUTE SR 582
COUNTY WOOD
TOWNSHIP TROY
SECTION 28
T 6 N R 12 E

TYPE MONUMENT PK
ON SURFACE - ~~BELOW~~ On Surface
LEFT - Q PAV'T - ~~RIGHT~~ 1.1'
9.5' TO LT. EDGE PAVEMENT
S.L.M. 752+50

GRID: NORTHING: 651459.844 EASTING: 1697644.001

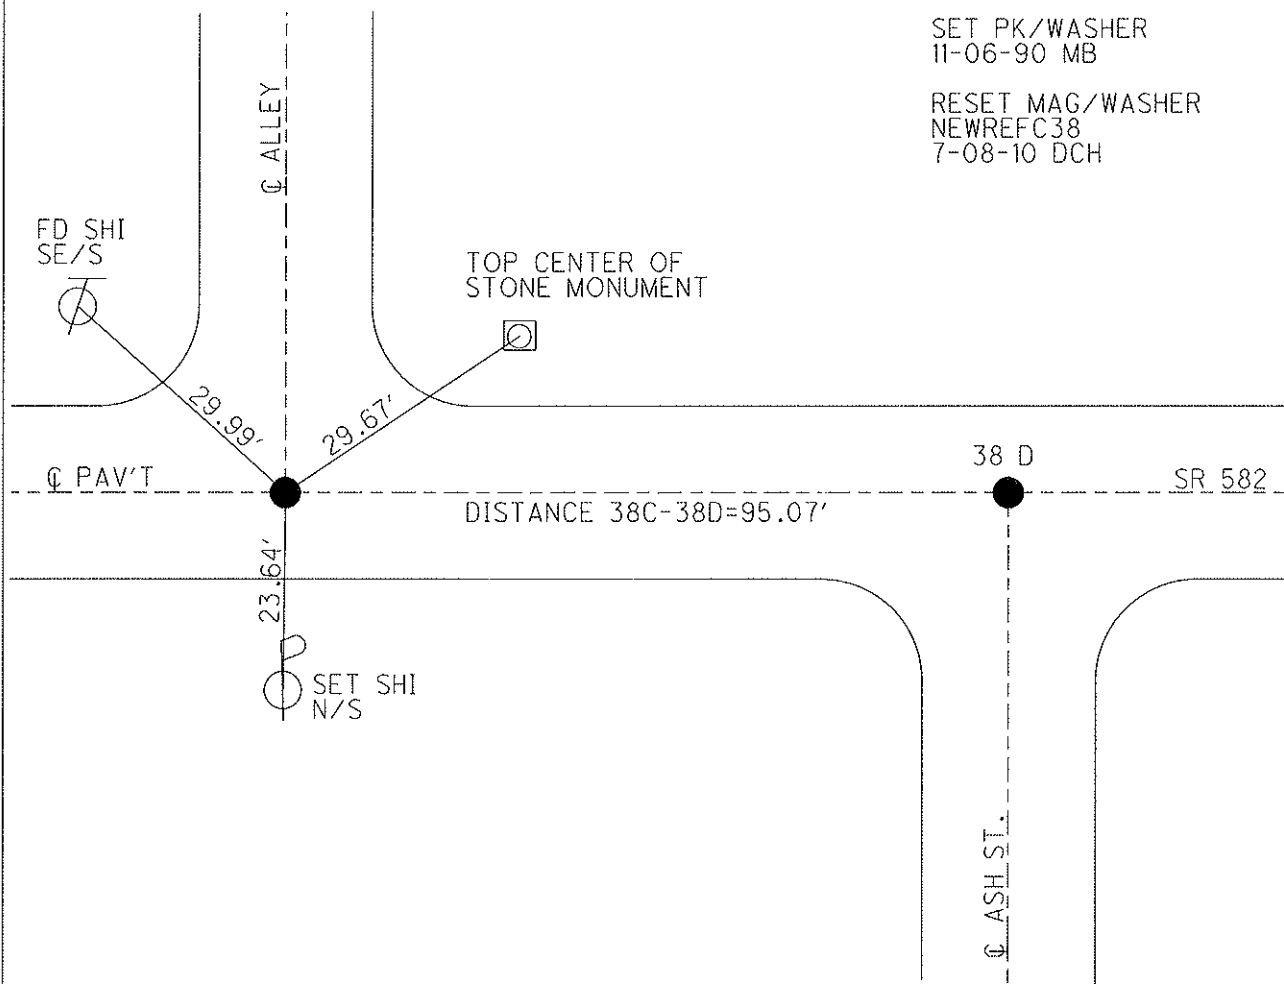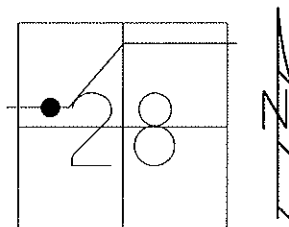

O.D.O.T. DISTRICT 2 SURVEY OFFICE

PERSONNEL

REFERENCE NO. 38 D SHEET 5 OF 29

NOTES _____ HOMAN

DATE 4-27-10

ROUTE SR 582

H.C. HOMAN

WEATHER SUNNY

COUNTY WOOD

R.C. ROUSOS

TEMP. 40°

TOWNSHIP TROY

SECTION 28

T 6 N R 12 E

TYPE MONUMENT _____ PK _____



ON SURFACE - ~~BELOW~~ On Surface

LEFT - C PAV'T - ~~RIGHT~~ 1.1'

9.5' TO LT EDGE PAVEMENT

S.L.M. 753+45

GRID: NORTHING: 651459.421 EASTING: 1697739.049

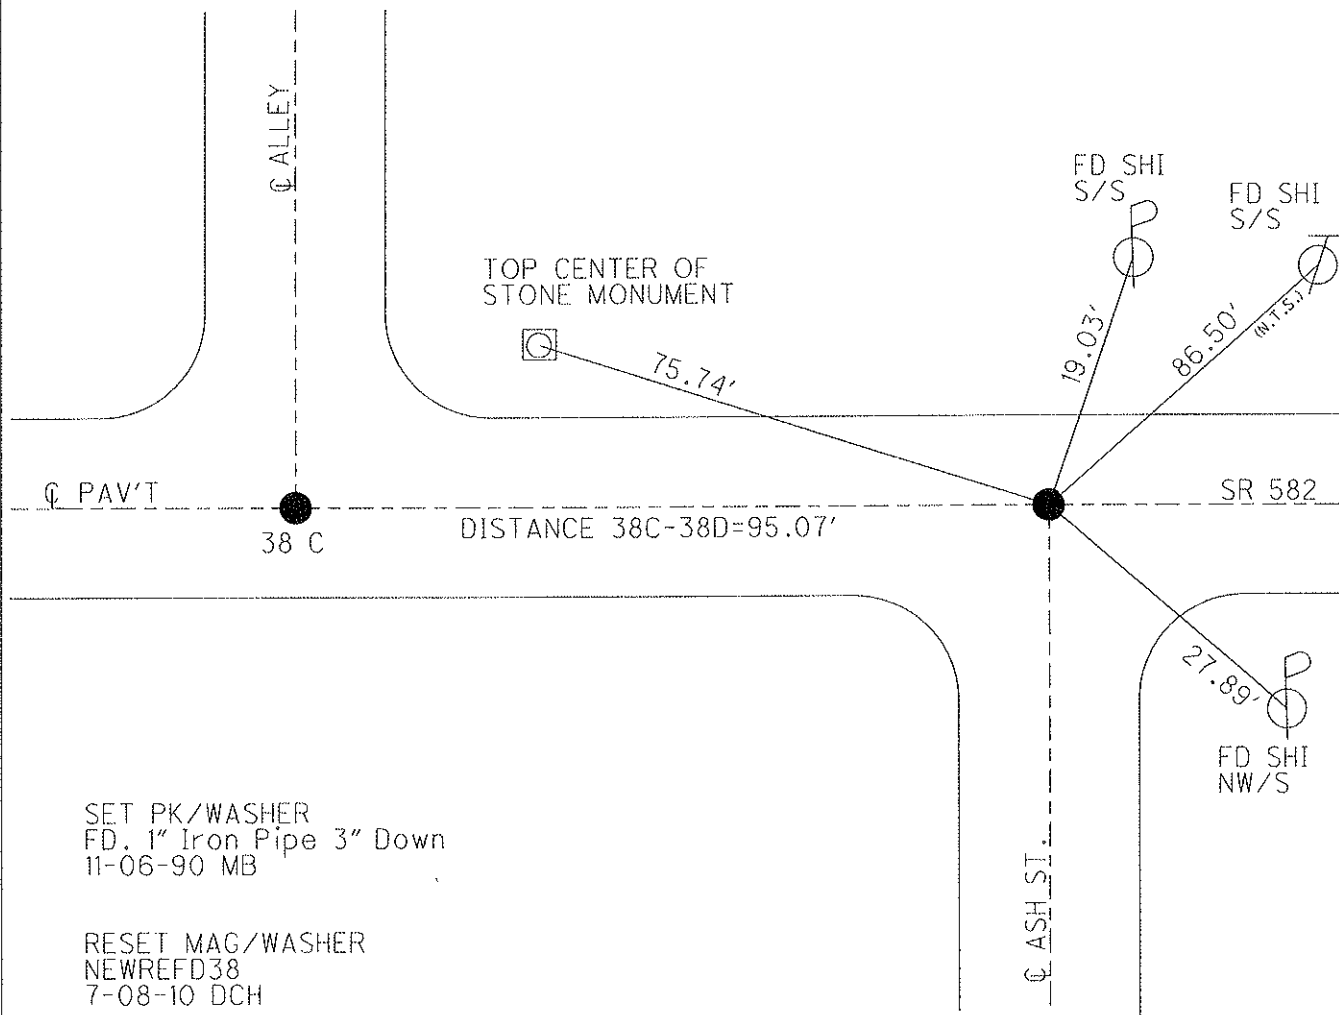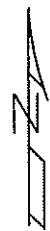

O.D.O.T. DISTRICT 2 SURVEY OFFICE

PERSONNEL

REFERENCE NO. 39

SHEET 6 OF 29

NOTES HOMAN

DATE 4-27-10

ROUTE SR 582

H.C. HOMAN

WEATHER SUNNY

COUNTY WOOD

R.C. ROUSOS

TEMP. 40°

TOWNSHIP TROY

SECTION 28

T 6 N R 12 E

TYPE MONUMENT P.K.NAIL


ON SURFACE - ~~BELOW~~ On Surface

LEFT - Q PAV'T - ~~RIGHT~~ 2.0' Left To Rd. WEST / ON Q PAV'T Rd. NE

17.9' TO RT EDGE PAVEMENT


S.L.M. 753+65.67

GRID: NORTHING: 651459.118 EASTING: 1697850.570

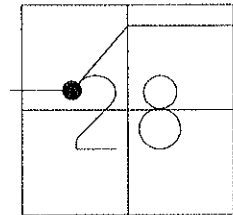

SET PK/WASHER
11-06-90 MB

RESET MAG/WASHER
NEWREF39 7-08-10 DCH

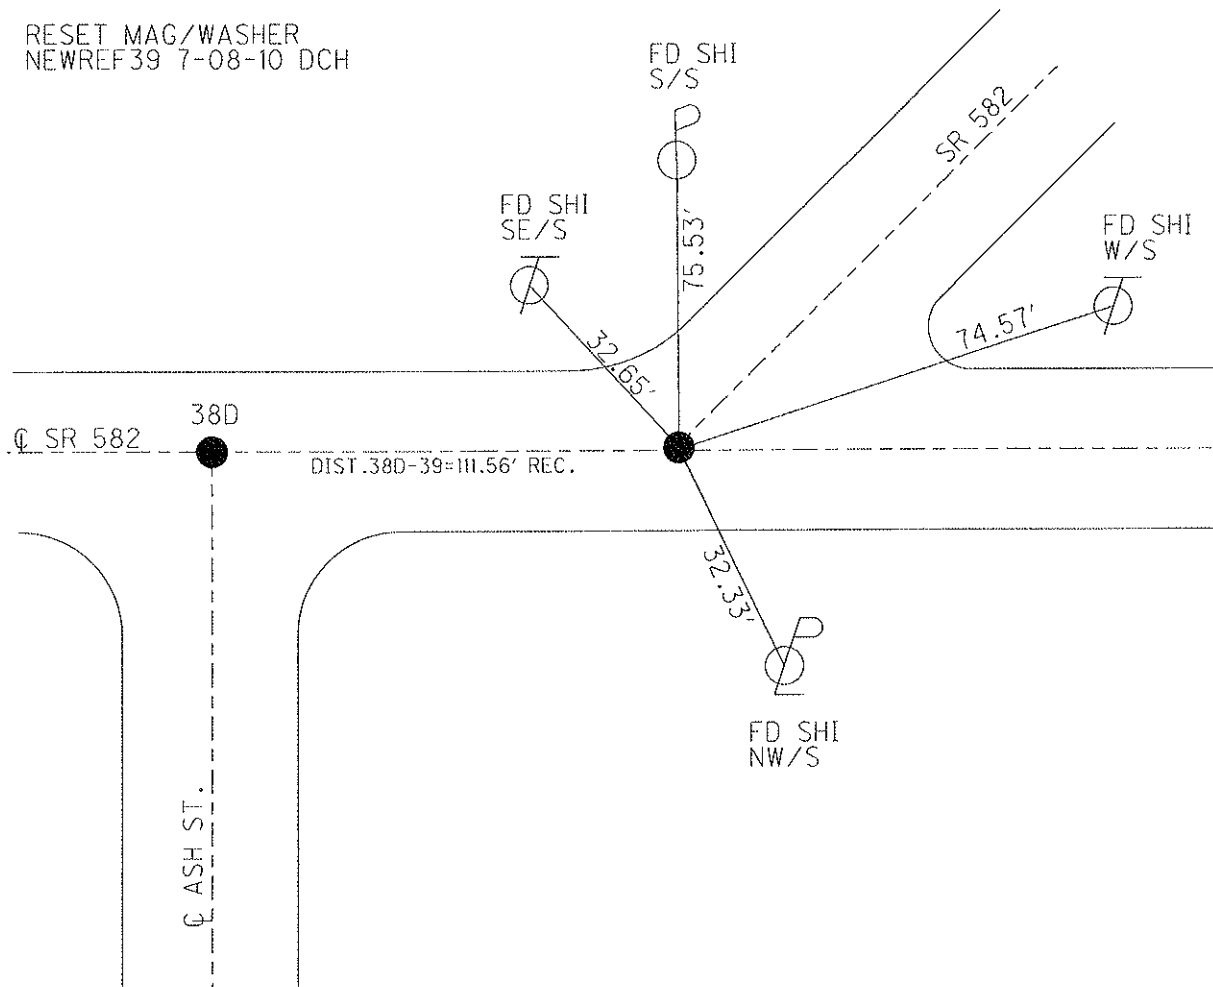

O.D.O.T. DISTRICT 2 SURVEY OFFICE

PERSONNEL

REFERENCE NO. 39 A

SHEET 7 OF 29

NOTES HOMAN

DATE 4-27-10

ROUTE SR 582

H.C. HOMAN

WEATHER SUNNY

COUNTY WOOD

R.C. ROUSOS

TEMP. 40°

TOWNSHIP TROY

SECTION 28

T 6 N R 12 E

TYPE MONUMENT P.K. NAIL


ON SURFACE - ~~BELOW~~ On Surface

~~LEFT~~ - C PAV'T - ~~RIGHT~~ ON

TO EDGE PAVEMENT

S.L.M. 758+05.62


GRID: NORTHING: 651756.179 EASTING: 1698175.129

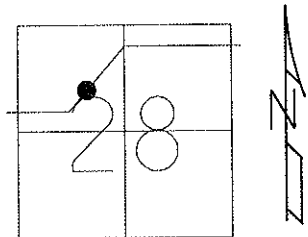

SET PK/WASHER
11-06-90 MB

RESET MAG/WASHER
NEWREFA39
7-08-10 DCH

DISTANCE BETWEEN
39A-39B= 27.62'

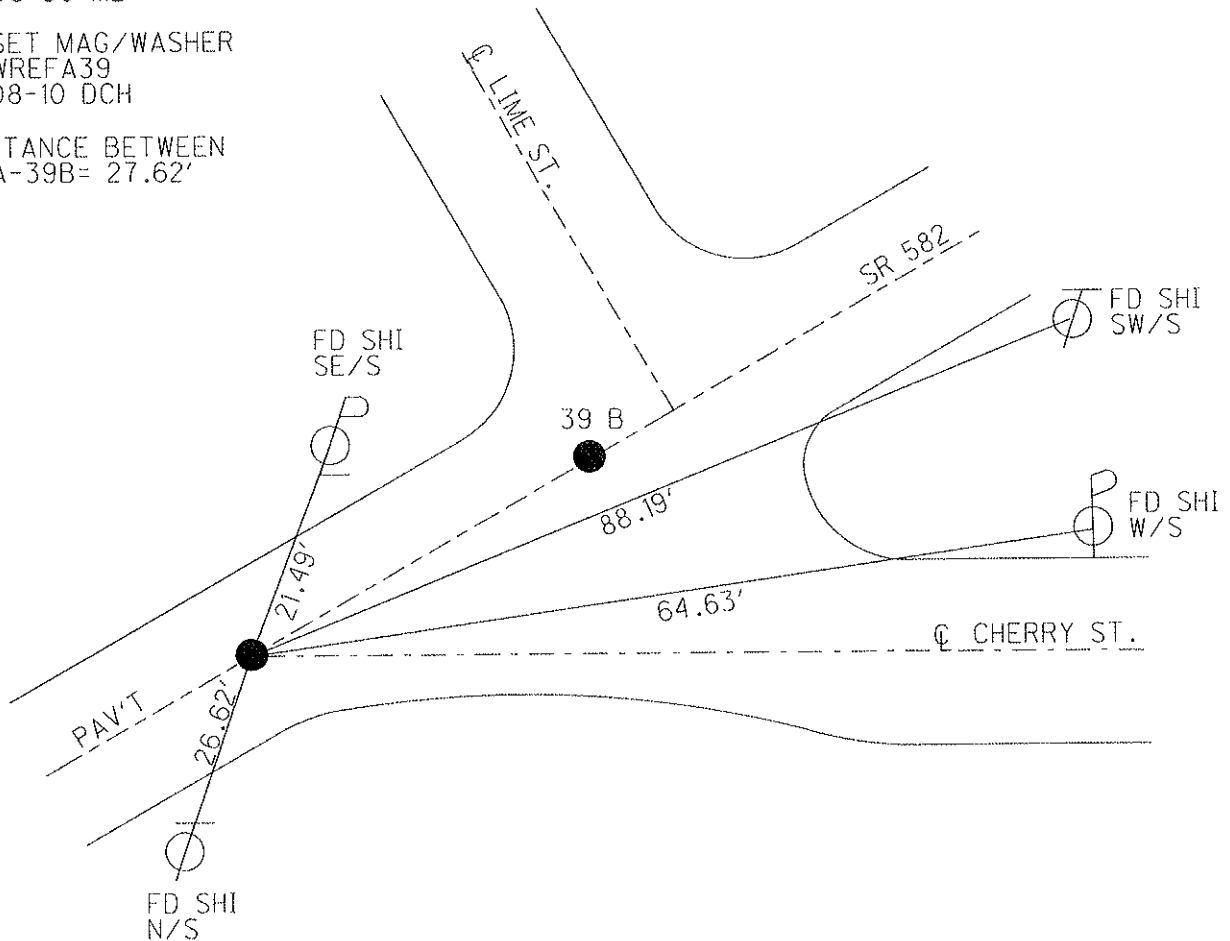

O.D.O.T. DISTRICT 2 SURVEY OFFICE

PERSONNEL

REFERENCE NO. 39 B

SHEET 8 OF 29

NOTES HOMAN

DATE 4-27-10

ROUTE SR 582

H.C. HOMAN

WEATHER SUNNY

COUNTY WOOD

R.C. ROUSOS

TEMP. 40°

TOWNSHIP TROY

SECTION 28

T 6 N R 12 E

TYPE MONUMENT P.K.NAIL

ON SURFACE - ~~BELOW~~ On Surface

~~LEFT - C PAV'T~~ RIGHT On

TO EDGE PAVEMENT


S.L.M. 758+33.23

GRID: NORTHING: 651774.786 EASTING: 1698195.524

SET PK/WASHER
11-06-90 MB

RESET MAG/WASHER
NEWREFB39
7-08-10 DCH

DISTANCE BETWEEN
39A-39B= 27.62'

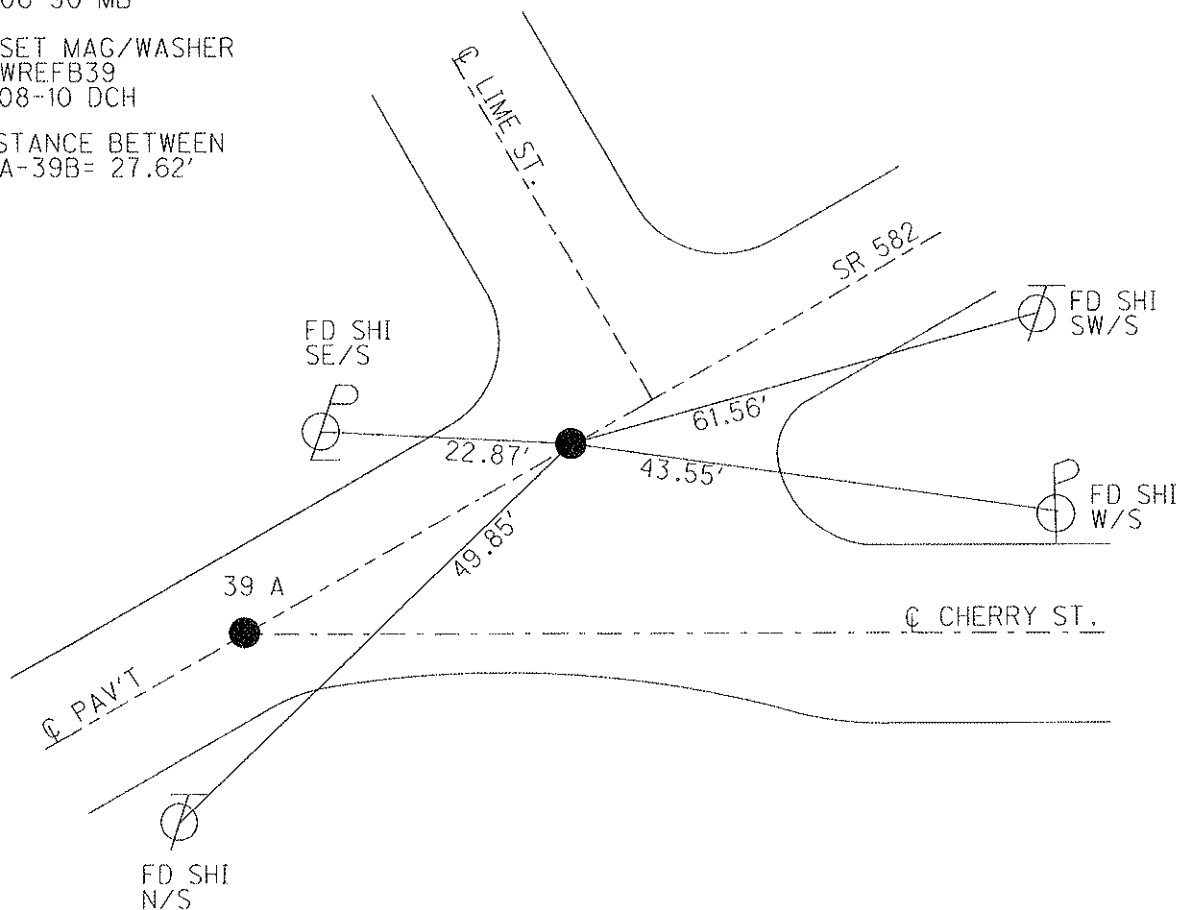

O.D.O.T. DISTRICT 2 SURVEY OFFICE

PERSONNEL

NOTES HOMAN
H.C. HOMAN
R.C. ROUSOS

REFERENCE NO. 39 C

DATE 4-27-10
WEATHER SUNNY
TEMP. 40°

SHEET 9 OF 29

ROUTE SR 582
COUNTY WOOD
TOWNSHIP TROY
SECTION 28
T 6 N R 12 E




TYPE MONUMENT P.K. NAIL

ON SURFACE - ~~BELOW~~ On Surface

~~LEFT - C PAV'T~~ - RIGHT 1.3' Right
10.4' TO LT EDGE PAVEMENT

S.L.M. 761+02.75

GRID: NORTHING: 651957.108 EASTING: 1698394.097

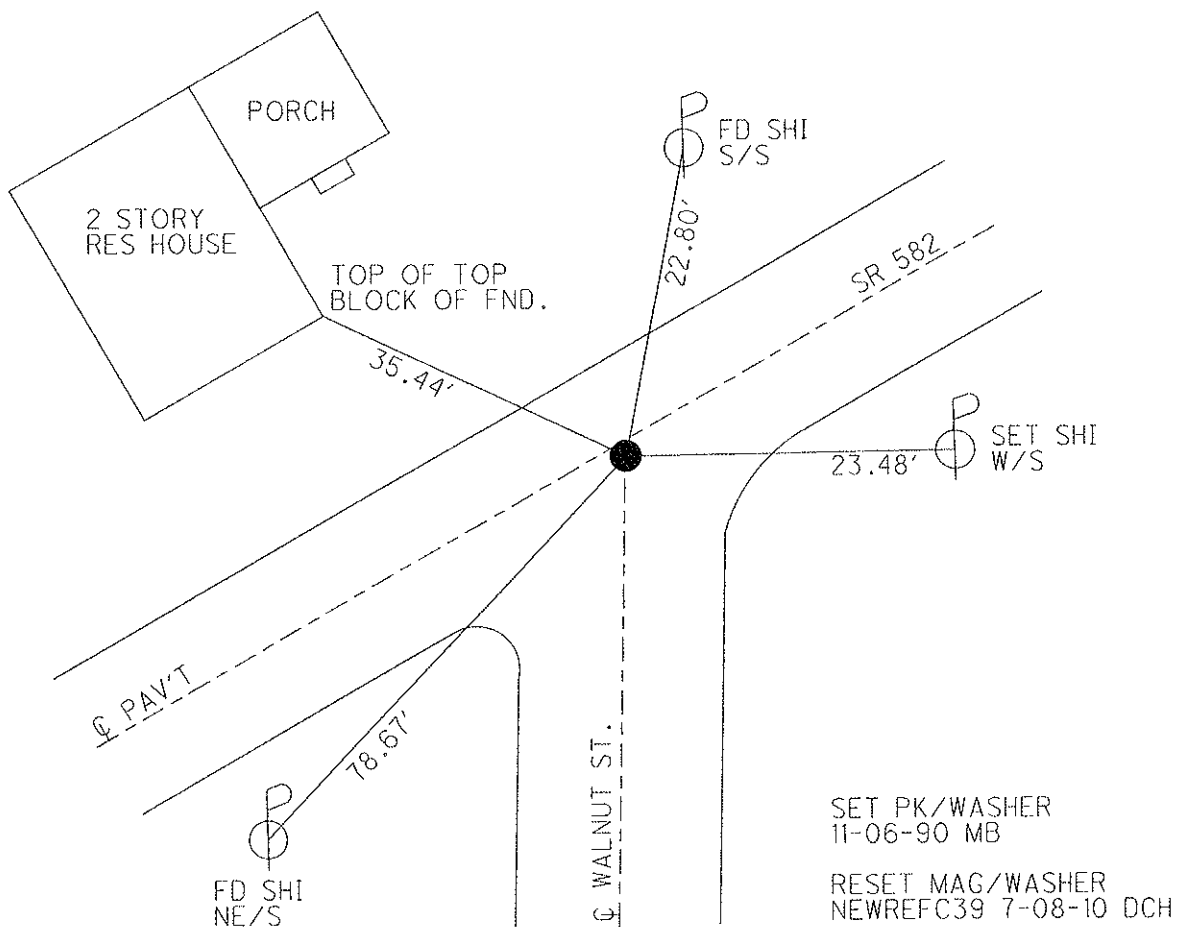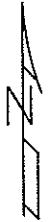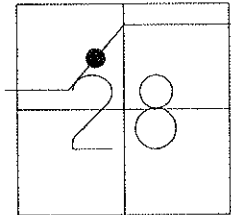

O.D.O.T. DISTRICT 2 SURVEY OFFICE

PERSONNEL

REFERENCE NO. 40

SHEET 10 OF 29

NOTES HOMAN

DATE 4-27-10

ROUTE SR 582

H.C. HOMAN

WEATHER SUNNY

COUNTY WOOD

R.C. ROUSOS

TEMP. 40°

TOWNSHIP TROY

SECTION 28

T 6 N R 12 E

TYPE MONUMENT PK/WASHER


ON SURFACE - ~~BELOW~~ On Surface

LEFT - ~~C PAV'T~~ - ~~RIGHT~~ 7.2'

16.6' TO ^LRT EDGE PAVEMENT

S.L.M. 768+42.40

GRID: NORTHING: 652456.268 EASTING: 1698939.941

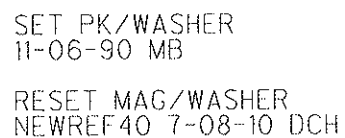

O.D.O.T. DISTRICT 2 SURVEY OFFICE

PERSONNEL

REFERENCE NO. 40 A

SHEET 11 OF 29

NOTES HOMAN

DATE 4-27-10

ROUTE SR 582

H.C. HOMAN

WEATHER SUNNY

COUNTY WOOD

R.C. ROUSOS

TEMP. 40°

TOWNSHIP TROY

SECTION 28

T 6 N R 12 E

TYPE MONUMENT 1" IRON PIN


~~ON SURFACE~~ - BELOW 5"

~~LEFT - C PAV'T~~ - RIGHT 11.5'

1.2' TO RT EDGE PAVEMENT


S.L.M. 770+98 (PT. IS SOUTH OF S.E.P.)

GRID: NORTHING: 6652453.808 EASTING: 1699104.548

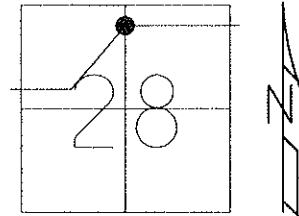

DID NOT COVER
11-06-90 MB

DID NOT COVER
7-08-10 DCH

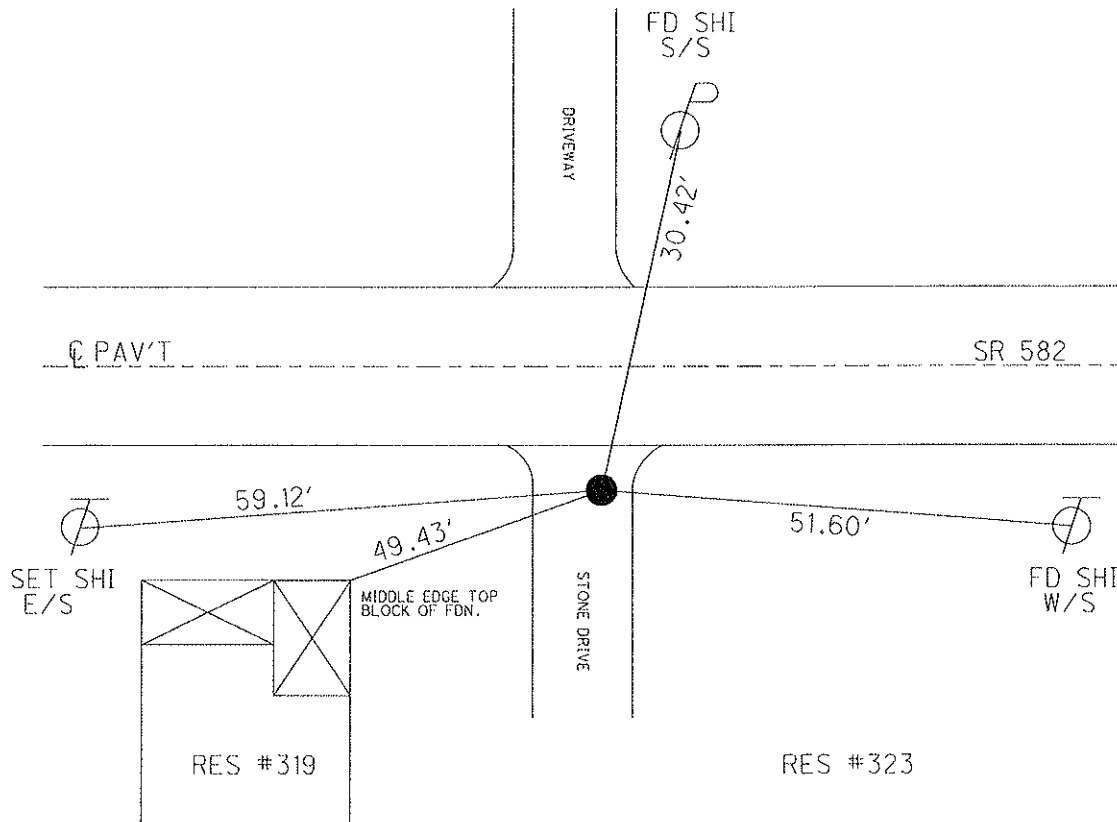

O.D.O.T. DISTRICT 2 SURVEY OFFICE

PERSONNEL

REFERENCE NO. 40 B

SHEET 12 OF 29

NOTES HOMAN

DATE 4-27-10

ROUTE SR 582

H.C. HOMAN

WEATHER SUNNY

COUNTY WOOD

R.C. ROUSOS

TEMP. 40°

TOWNSHIP TROY

SECTION 28

T 6 N R 12 E

TYPE MONUMENT PK Nail


ON SURFACE - ~~BELOW~~ On Surface

~~LEFT - C PAV'T~~ - RIGHT 8.8'

18.0' TO LT EDGE PAVEMENT


S.L.M. 773+20.74

GRID: NORTHING: 652451.962 EASTING: 1699418.314

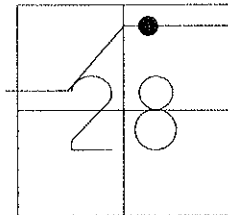

SET PK/WASHER
11-06-90 MB

RESET MAG/WASHER
40-B=NEWREFB40
7-08-10 DCH

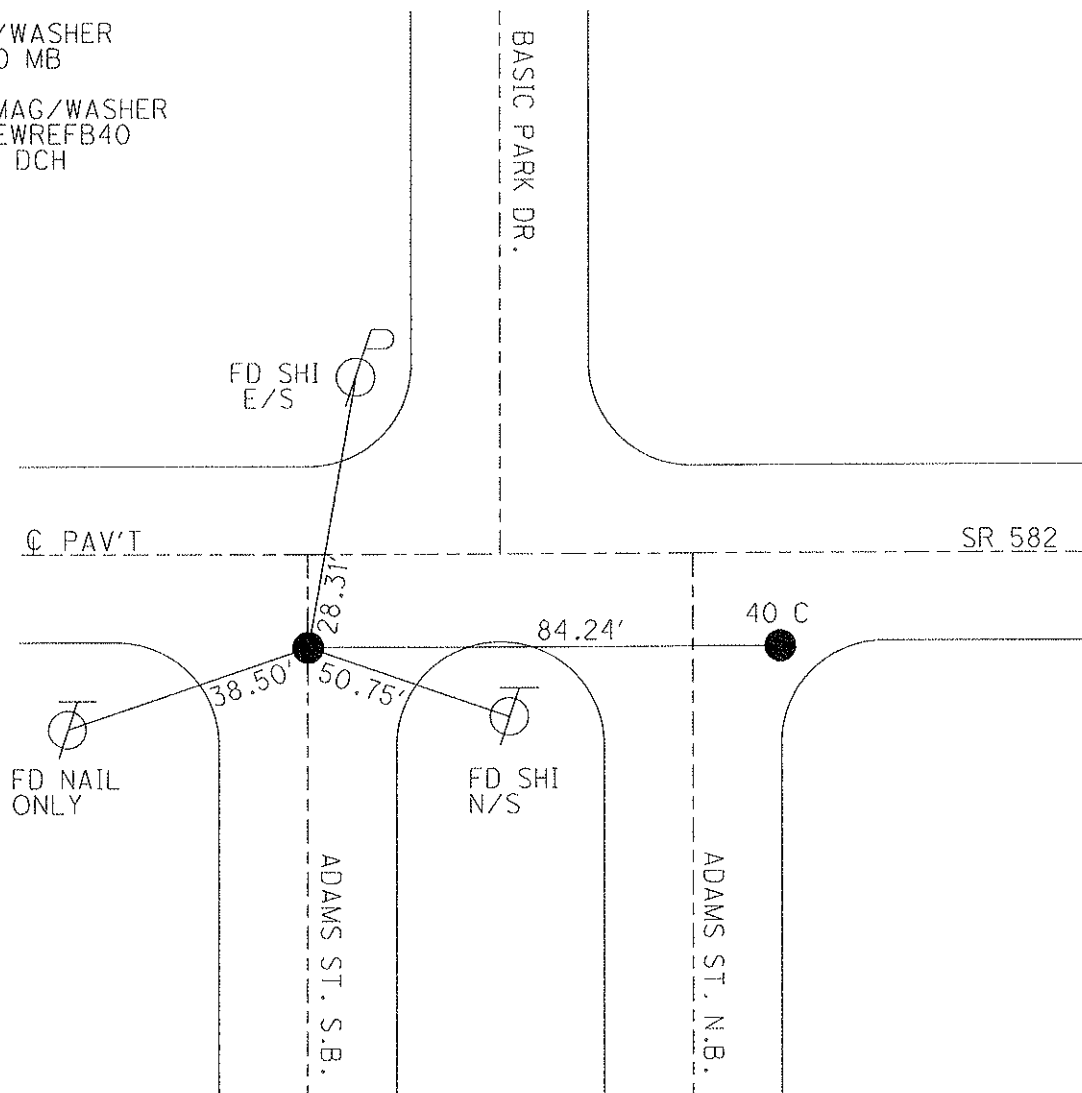

O.D.O.T. DISTRICT 2 SURVEY OFFICE

PERSONNEL

REFERENCE NO. 40 C

SHEET 13 OF 29

NOTES HOMAN

DATE 4-27-10

ROUTE SR 582

H.C. HOMAN

WEATHER SUNNY

COUNTY WOOD

R.C. ROUSOS

TEMP. 40°

TOWNSHIP TROY

SECTION 28

T 6 N R 12 E

TYPE MONUMENT PK Nail


ON SURFACE - ~~BELOW~~ On Surface

~~LEFT - C PAV'T~~ - RIGHT 8.3'

TO EDGE PAVEMENT


S.L.M. 774+04.98, 9.3' East C PAV'T TO SOUTH

GRID: NORTHING: 652451.539 EASTING: 1699502.536

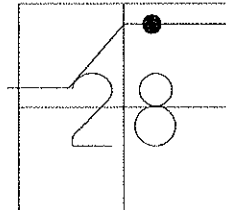

SET PK/WASHER
11-06-90 MB

RESET MAG/WASHER
40-C=NEWREFC40
7-08-10 DCH

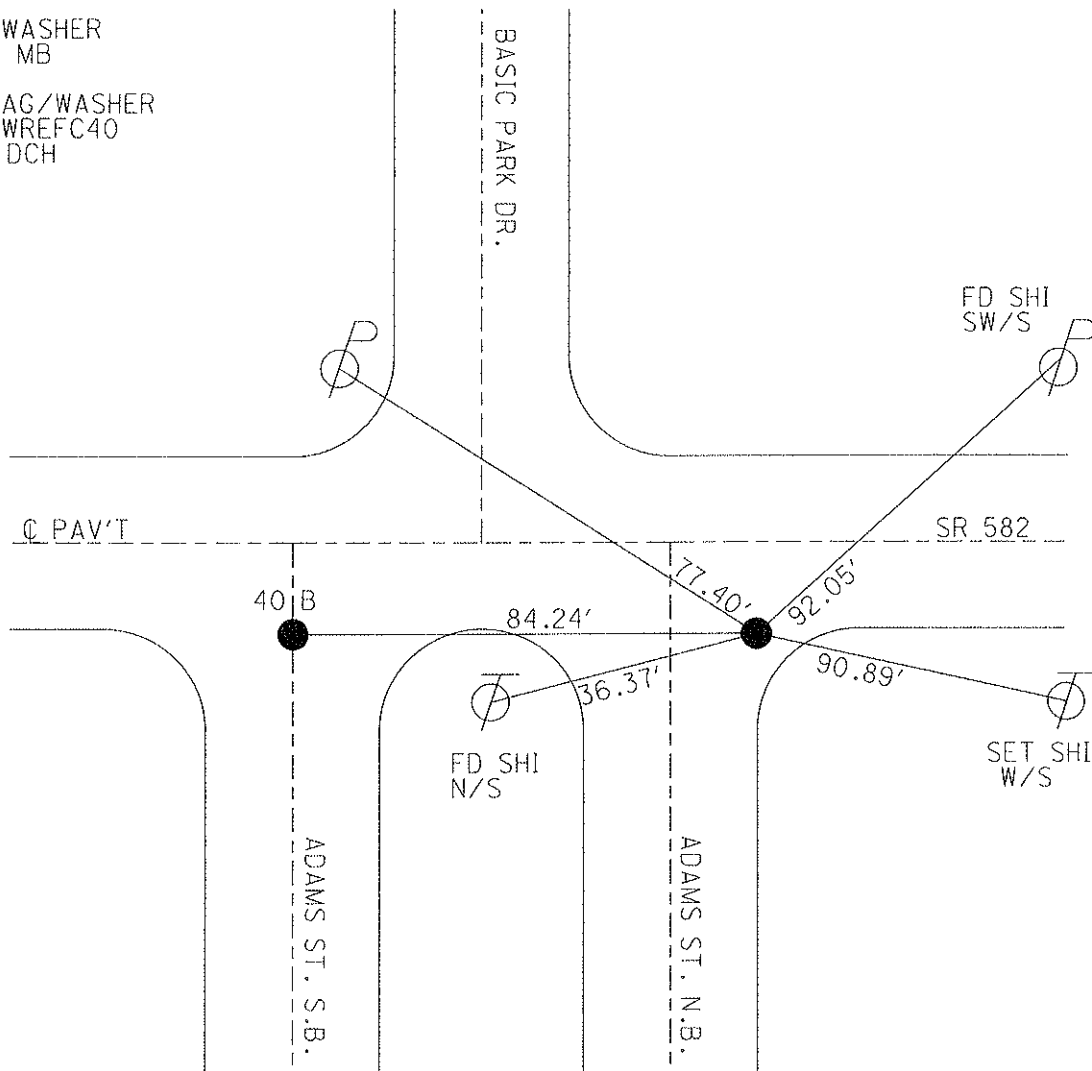

O.D.O.T. DISTRICT 2 SURVEY OFFICE

PERSONNEL

REFERENCE NO. 40 D

SHEET 14 OF 29

NOTES HOMAN

DATE 4-27-10

ROUTE SR 582

H.C. HOMAN

WEATHER SUNNY

COUNTY WOOD

R.C. ROUSOS

TEMP. 40°

TOWNSHIP TROY

SECTION 28

T 6 N R 12 E

TYPE MONUMENT Shank


ON SURFACE - ~~BELOW~~ On Surface

~~LEFT - C PAV'T~~ - RIGHT 6.5'

16.0' TO LT EDGE PAVEMENT

S.L.M. 779+06.46, ON C PAV'T AT RUCH ST.

GRID: NORTHING: 652449.102 EASTING: 1700003.863

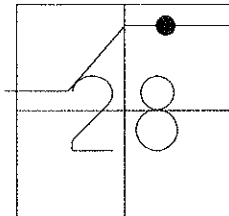

SET PK/WASHER
11-06-90 MB

RESET MAG/WASHER
NEWREFD40 7-08-10 DCH

FD SHI
SE/S



89.95'

C PAV'T

53.01'



FD SHI
SW/S

SR 582

SET SHI
NE/S



23.65'

27.65'

FD. N/SHI
ON C PAV'T

RUCH ST

O.D.O.T. DISTRICT 2 SURVEY OFFICE

PERSONNEL

REFERENCE NO. 40 E

SHEET 15 OF 29

NOTES HOMAN

DATE 4-27-10

ROUTE SR 582

H.C. HOMAN

WEATHER SUNNY

COUNTY WOOD

R.C. ROUSOS

TEMP. 40°

TOWNSHIP TROY

SECTION 28

T 6 N R 12 E

TYPE MONUMENT 3/4" IRON ROD


ON SURFACE - ~~BELOW~~ On Surface

~~LEFT - C PAV'T~~ - RIGHT 6.2'

15.7' TO LT. EDGE PAVEMENT


S.L.M. 781+75.85, 1.0' E. C SCHOOL ST.

GRID: NORTHING: 652447.172 EASTING: 1700273.357

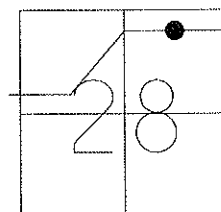

SET PK/WASHER
11-06-90 MB

RESET MAG/WASHER
NEWREFE40 7-08-10 DCH

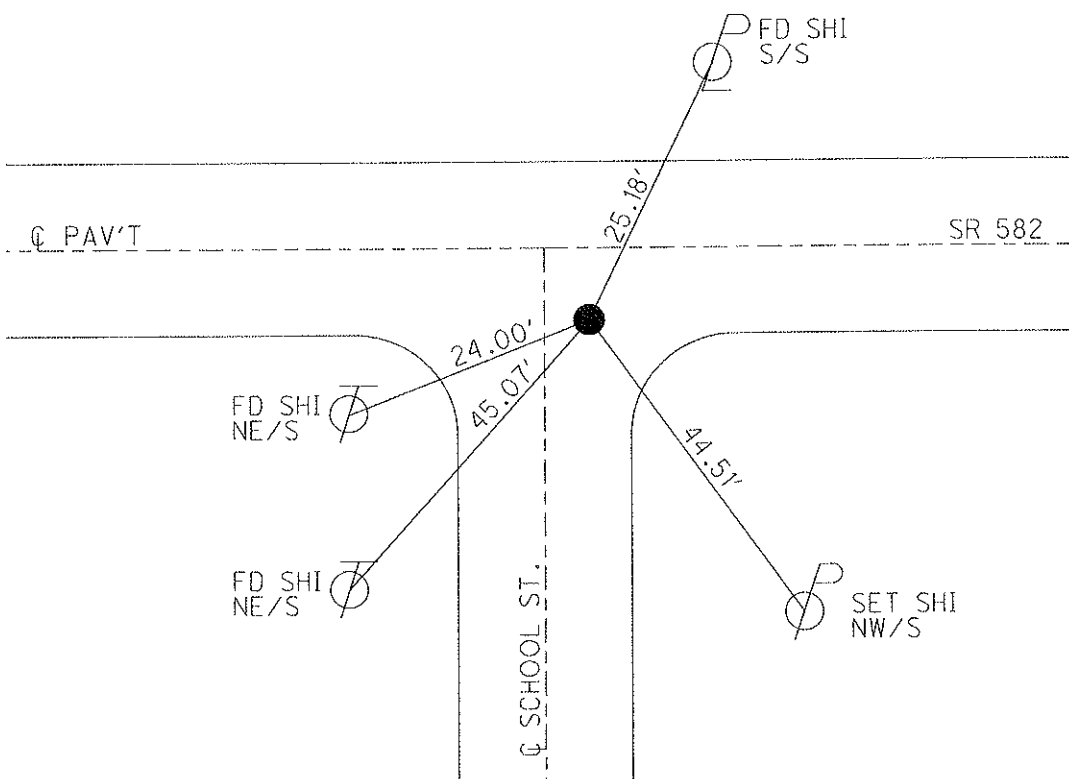

O.D.O.T. DISTRICT 2 SURVEY OFFICE

PERSONNEL

NOTES HOMAN
H.C. HOMAN
R.C. ROUSOS

REFERENCE NO. 40 F

DATE 4-27-10
WEATHER SUNNY
TEMP. 45°

SHEET 16 OF 29

ROUTE SR 582
COUNTY WOOD
TOWNSHIP TROY
SECTION 28
T 6 N R 12 E

TYPE MONUMENT MAG/WASHER


ON SURFACE - ~~BELOW~~ On Surface

~~LEFT - C PAV'T~~ - RIGHT 5.8'

3.5' TO RT EDGE PAVEMENT


S.L.M. 784+22 REC

GRID: NORTHING: 652446.240 EASTING: 1700427.183

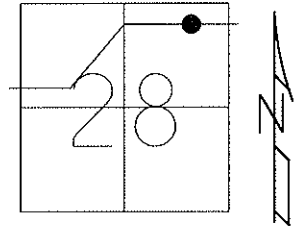

SET PK/WASHER
11-06-90 MB

RESET MAG/WASHER
NEWREFF40
7-08-10 DCH

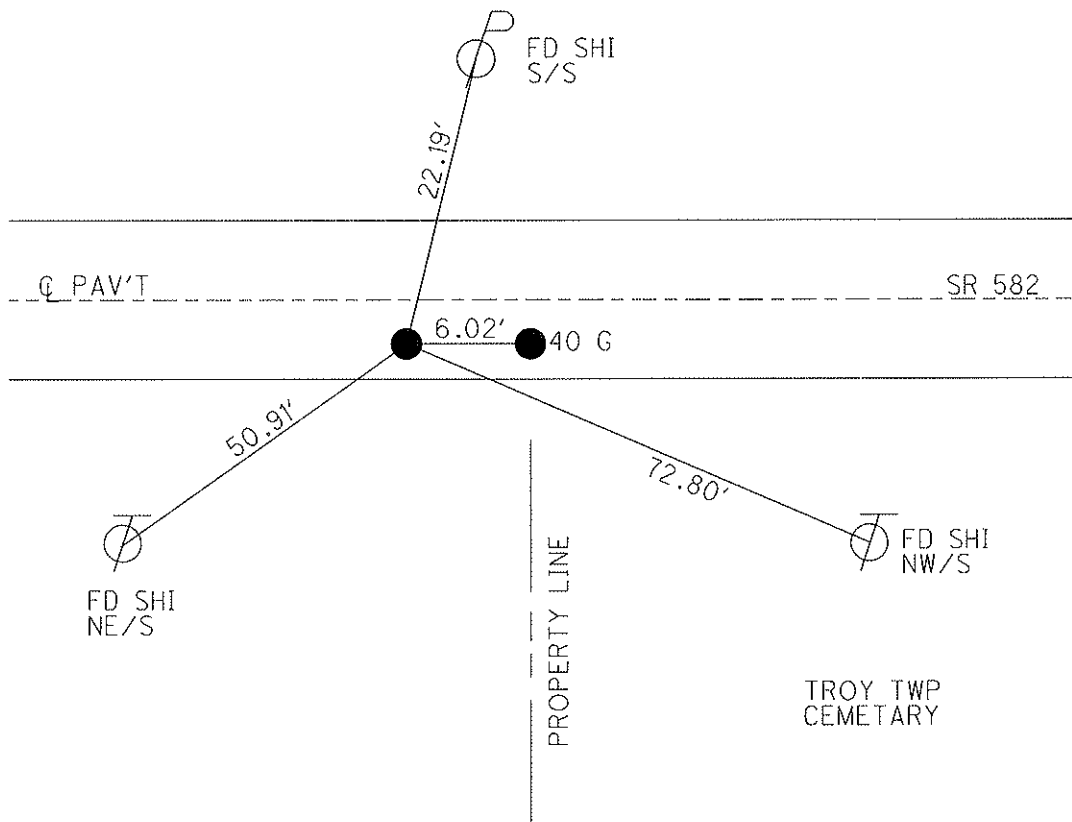

O.D.O.T. DISTRICT 2 SURVEY OFFICE

PERSONNEL

REFERENCE NO. 40 G

SHEET 17 OF 29

NOTES HOMAN

DATE 4-27-10

ROUTE SR 582

H.C. HOMAN

WEATHER SUNNY

COUNTY WOOD

R.C. ROUSOS

TEMP. 45°

TOWNSHIP TROY

SECTION 28

T 6 N R 12 E

TYPE MONUMENT MAG/WASHER



ON SURFACE - ~~BELOW~~ On Surface

LEFT - ~~C~~ PAV'T - RIGHT 5.8'

3.5' TO RT EDGE PAVEMENT


S.L.M. 784+28 REC

GRID: NORTHING: 652446.363 EASTING: 1700433.172

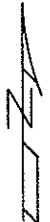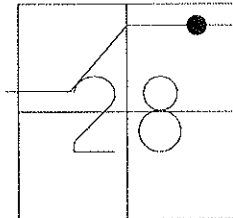

SET PK/WASHER
11-06-90 MB

RESET MAG/WASHER
NEWREFG40
7-08-10 DCH

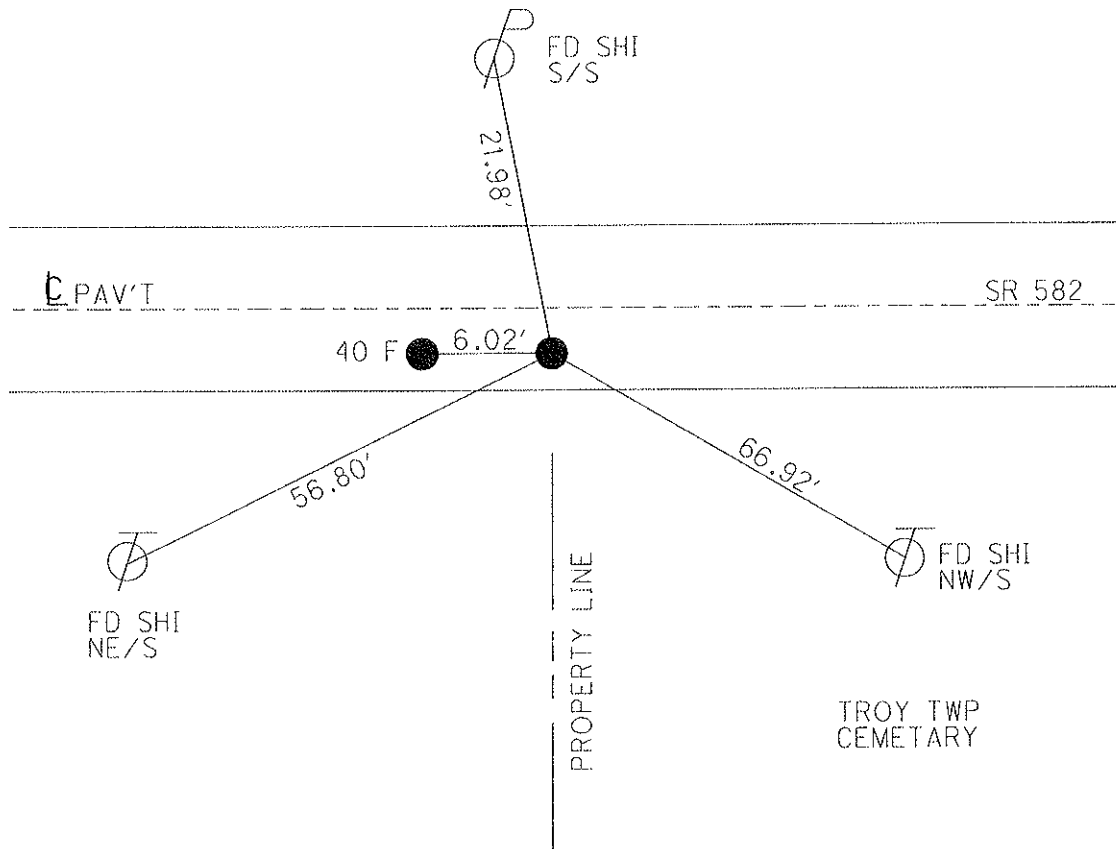

O.D.O.T. DISTRICT 2 SURVEY OFFICE

PERSONNEL

REFERENCE NO. 41

SHEET 18 OF 29

NOTES HOMAN

DATE 4-27-10

ROUTE SR 582

H.C. HOMAN

WEATHER SUNNY

COUNTY WOOD

R.C. ROUSOS

TEMP. 45°

TOWNSHIP TROY

SECTION 28

T 6 N R 12 E

TYPE MONUMENT SM R.R. SPIKE



~~ON SURFACE~~ - BELOW 2"

~~LEFT~~ - Q PAV'T - RIGHT 6.6'

TO EDGE PAVEMENT

S.L.M. 796+36.88, 13.6' W. Q LEMOYNE RD.

GRID: NORTHING: 652438.775 EASTING: 1701734.416

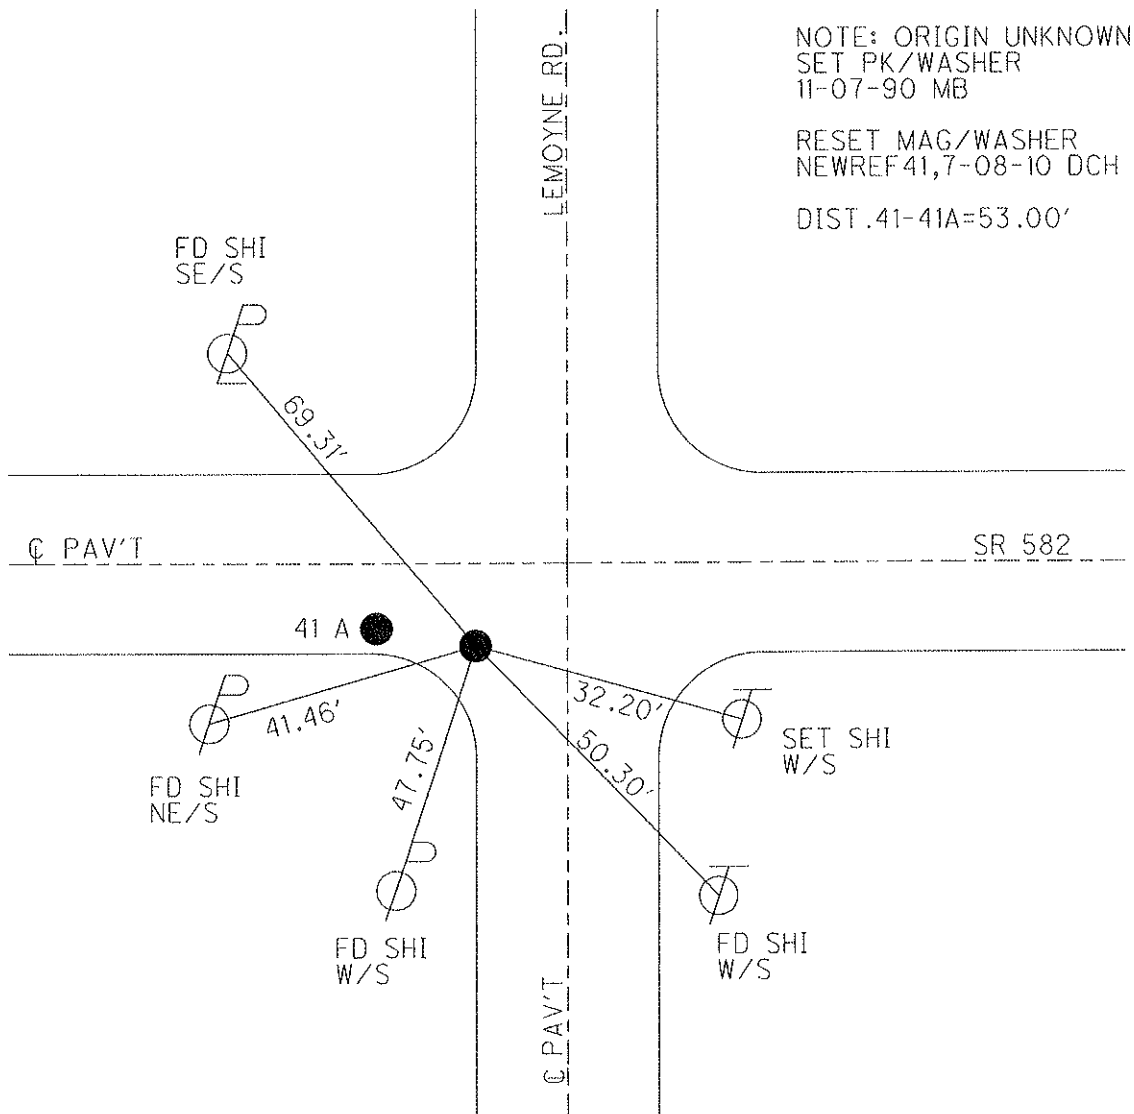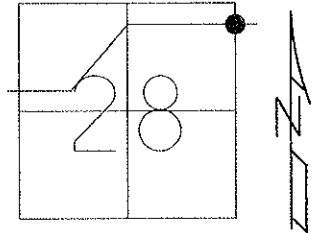

O.D.O.T. DISTRICT 2 SURVEY OFFICE

PERSONNEL

NOTES _____
H.C. _____
R.C. _____

REFERENCE NO. 41 A

DATE 4-27-10
WEATHER SUNNY
TEMP. 45°

SHEET 19 OF 29

ROUTE SR 582
COUNTY WOOD
TOWNSHIP TROY
SECTION 28
T 6 N R 12 E

TYPE MONUMENT SM R.R. SPIKE


~~ON SURFACE~~ - BELOW 2"

~~LEFT~~ - ~~Q PAV'T~~ - RIGHT 6.6'

TO EDGE PAVEMENT

S.L.M. 13.6' W. Q LEMOYNE RD.


GRID: NORTHING: 652439.525 EASTING: 1701730.020

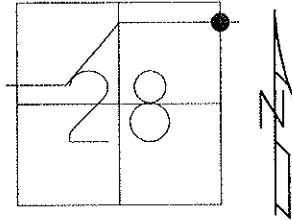

NOTE: ORIGIN UNKNOWN
SET PK/WASHER
11-07-90 MB

RESET MAG/WASHER
NEWREFA41,7-08-10 DCH

DIST.41-41A=53.00'

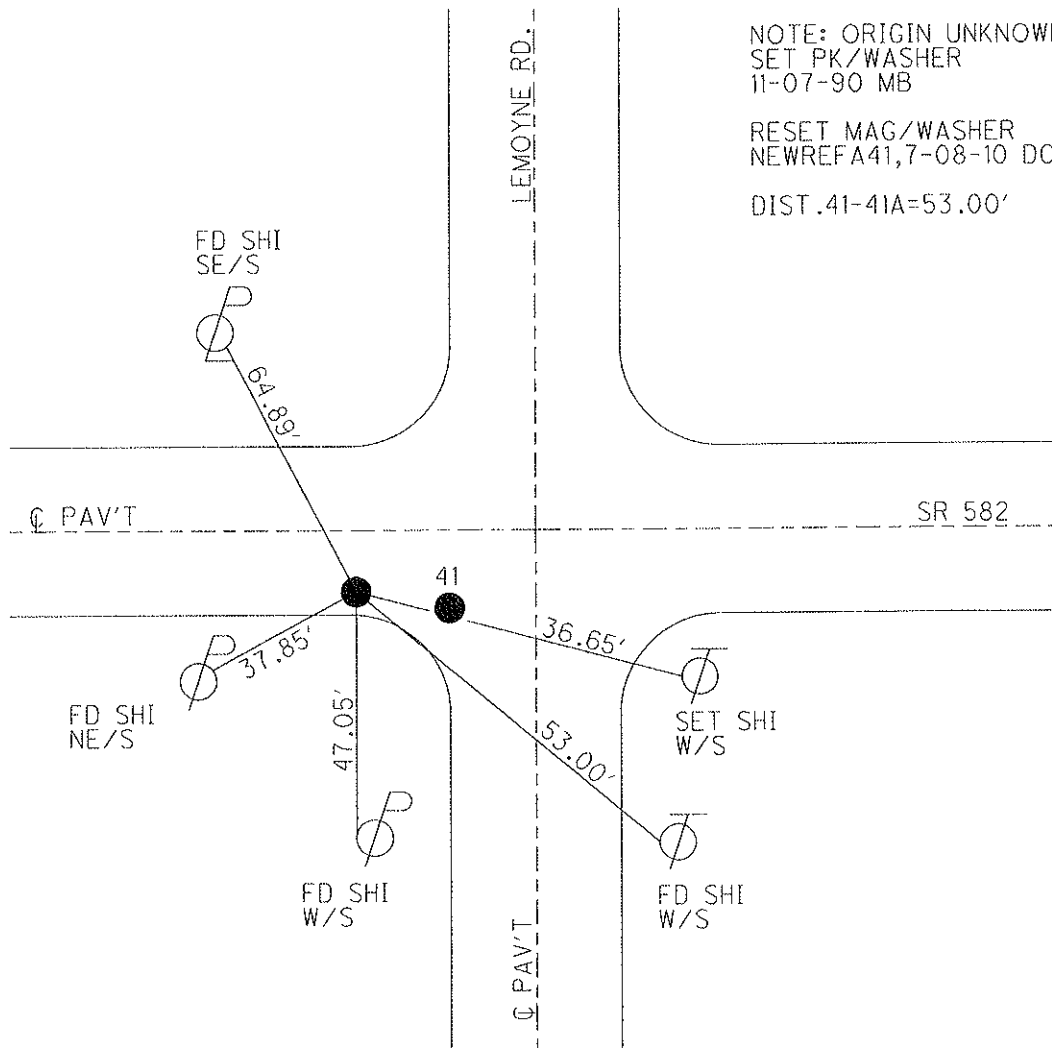

O.D.O.T. DISTRICT 2 SURVEY OFFICE

PERSONNEL

REFERENCE NO. 42

SHEET 20 OF 29

NOTES HOMAN

DATE 4-27-10

ROUTE SR 582

H.C. HOMAN

WEATHER SUNNY

COUNTY WOOD

R.C. ROUSOS

TEMP. 45°

TOWNSHIP TROY

SECTION 27

T 6 N R 12 E

TYPE MONUMENT LARGE R.R. SPIKE


ON SURFACE - ~~BELOW~~ On Surface

~~LEFT - C PAV'T~~ - RIGHT 2.8'

6.6' TO RT EDGE PAVEMENT

S.L.M. 823+87.5 REC


GRID: NORTHING: 652456.236 EASTING: 1705719.050

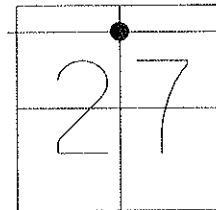

NOTE: PT. 42A ORIGIN UNKNOWN

SET PK/WASHER
11-07-90 MB

NEED TO DIG
4-27-10 DCH

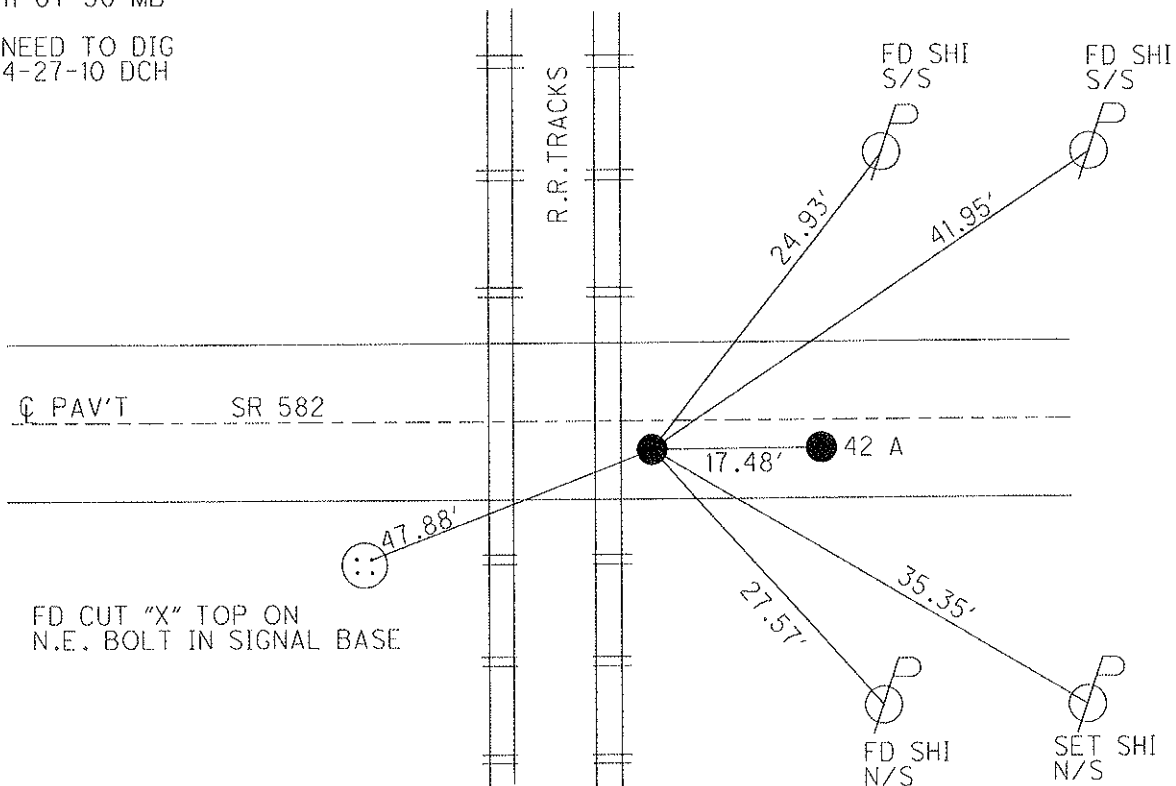

O.D.O.T. DISTRICT 2 SURVEY OFFICE

PERSONNEL _____

REFERENCE NO. 42 A

SHEET 21 OF 29

NOTES HOMAN

DATE 4-27-10

ROUTE SR 582

H.C. HOMAN

WEATHER SUNNY

COUNTY WOOD

R.C. ROUSOS

TEMP. 45°

TOWNSHIP TROY

SECTION 27

T 6 N R 12 E

TYPE MONUMENT SMALL R.R. SPIKE

ON SURFACE - ~~BELOW~~ On Surface


~~LEFT~~ - Q PAV'T - RIGHT 2.9'

6.6' TO RT EDGE PAVEMENT

S.L.M. 824+05 REC

GRID: NORTHING: _____


EASTING: _____

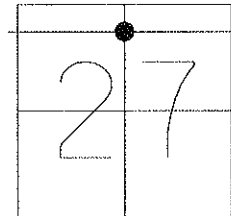

NOTE: ORIGIN UNKNOWN

SET PK/WASHER
11-07-90 MB

NEED TO DIG
4-27-10 DCH

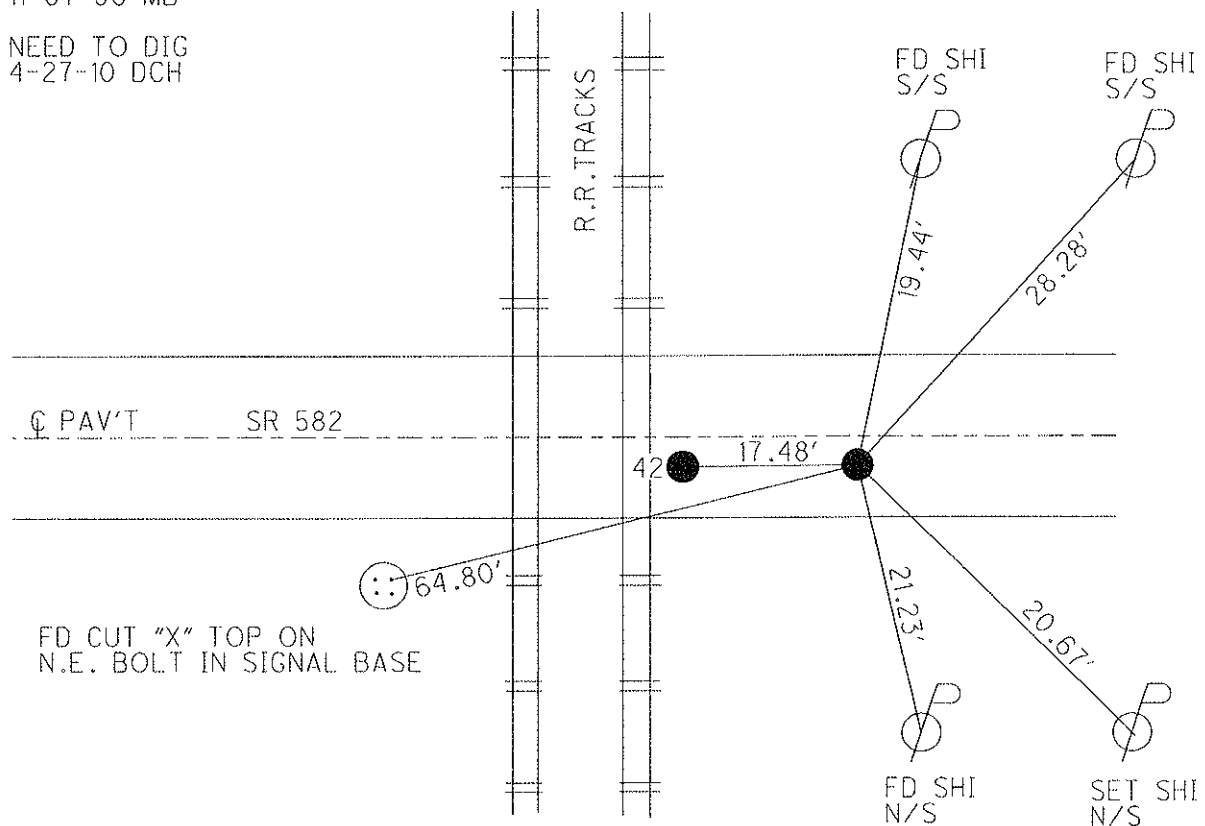

O.D.O.T. DISTRICT 2 SURVEY OFFICE

PERSONNEL

REFERENCE NO. 42 B

SHEET 22 OF 29

NOTES HOMAN

DATE 4-27-10

ROUTE SR 582

H.C. HOMAN

WEATHER SUNNY

COUNTY WOOD

R.C. ROUSOS

TEMP. 45°

TOWNSHIP TROY

SECTION 27

T 6 N R 12 E

TYPE MONUMENT PK Nail


ON SURFACE - ~~BELOW~~ On Surface

~~LEFT - C PAV'T~~ - RIGHT 2.8'

6.7' TO RT EDGE PAVEMENT

S.L.M. 836+21.68

GRID: NORTHING: 652456.250 EASTING: 1705718.920

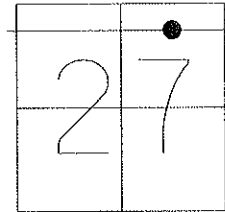


NOTE: EITHER POSSIBLE $\frac{1}{4}$ QUARTER POINT, ORIGIN UNKNOWN

SET PK NAIL
11-07-90 MB

RESET MAG/WASHER
NEWREFB42, 7-9-10 DCH

SET SHI IN STUMP
OF 12" ASH, SE/S

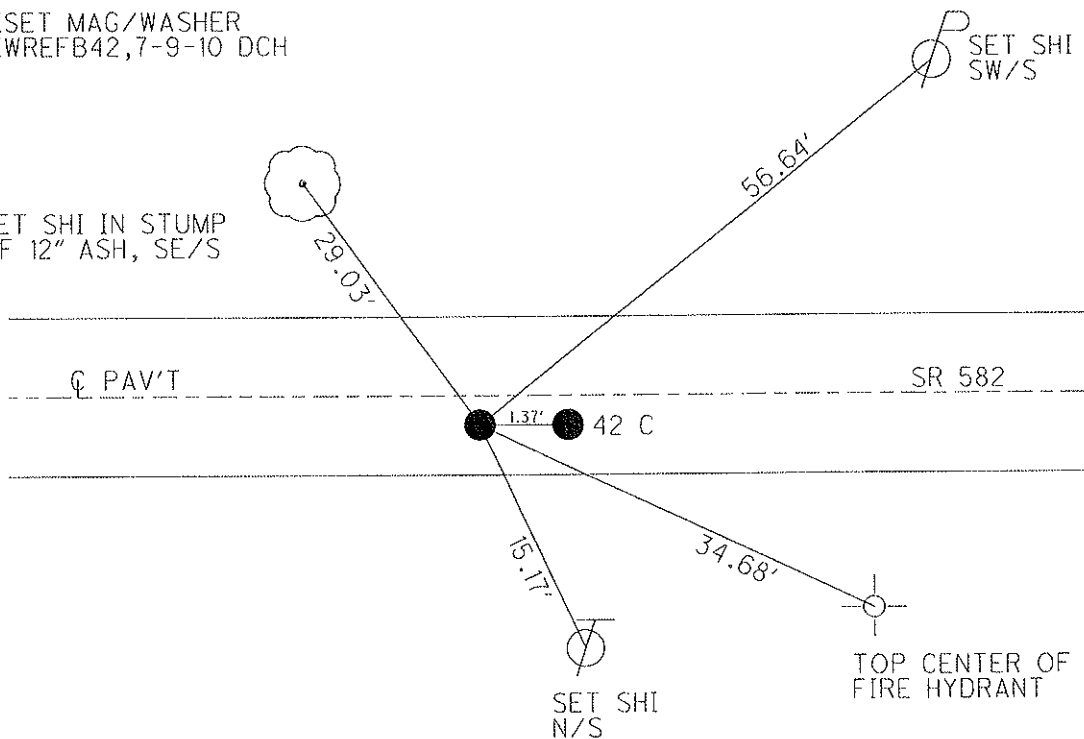

O.D.O.T. DISTRICT 2 SURVEY OFFICE

PERSONNEL

NOTES HOMAN

H.C. HOMAN

R.C. ROUSOS

REFERENCE NO. 42 C

DATE 4-27-10

WEATHER SUNNY

TEMP. 45°

SHEET 23 OF 29

ROUTE SR 582

COUNTY WOOD

TOWNSHIP TROY

SECTION 27

T 6 N R 12 E

TYPE MONUMENT PK Nail


ON SURFACE - ~~BELOW~~ On Surface

~~LEFT - C PAV'T~~ - RIGHT 2.8'

6.7' TO RT. EDGE PAVEMENT

S.L.M. 836+22.96

GRID: NORTHING: 652456.359 EASTING: 1705720.303

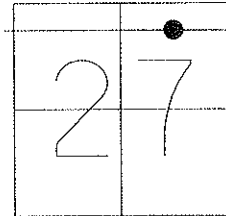


NOTE: EITHER POSSIBLE 1/4
QUARTER POINT, ORIGIN UNKNOWN

SET PK NAIL
11-07-90 MB

RESET MAG/WASHER
NEWREFC42,7-9-10 DCH

SET SHI IN STUMP
OF 12" ASH, SE/S

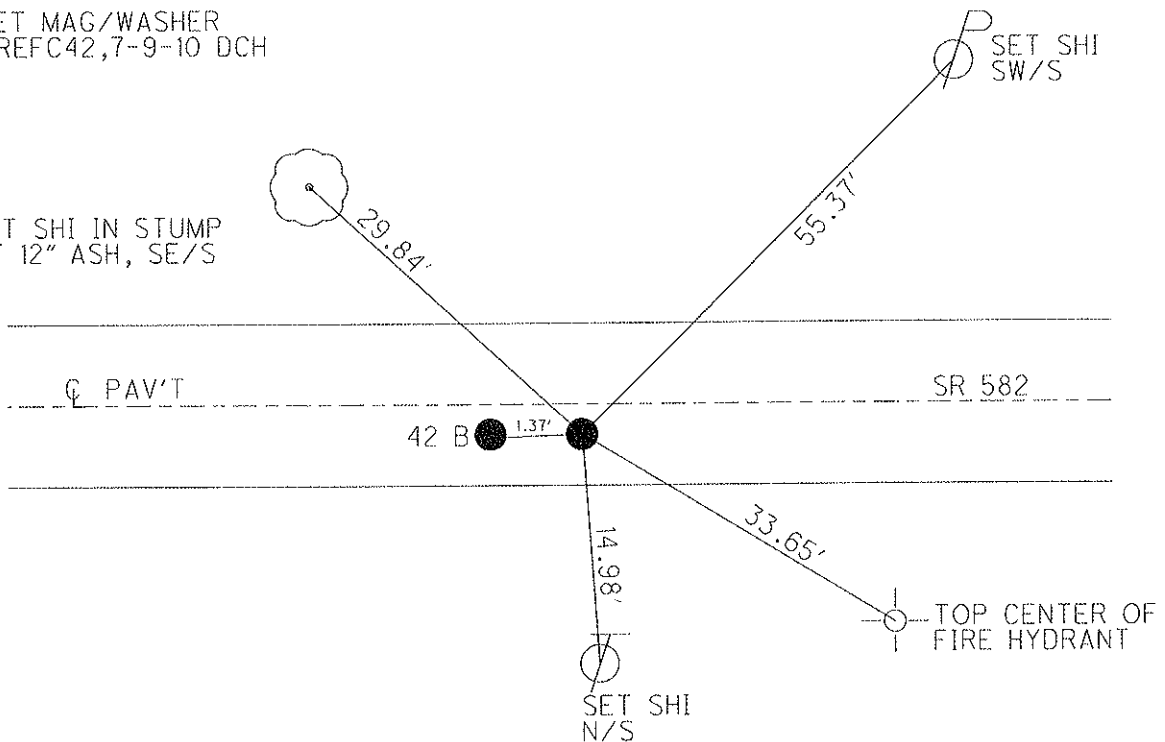

O.D.O.T. DISTRICT 2 SURVEY OFFICE (USE ONLY)

PERSONNEL

REFERENCE NO. 43

SHEET 18 OF 25

NOTES MILLER

DATE 8/6/24

ROUTE SR 582

H.C. MILLER

WEATHER CLOUDY

COUNTY WOOD

R.C. BARRIERE

TEMP. 75°

TOWNSHIP TROY

BLUBAUGH

SECTION 27

DWG BY BARRIERE

PID 107717

T 6 N R 12 E

TYPE MONUMENT MAG/WASHER

ON SURFACE - BELOW ON

OFFSET $\varnothing$ PAVEMENT 1.3' LT

TO EDGE PAVEMENT

STATION: 849+53.17

HORIZ.DATUM: NAD83 (2011)


GEOID: 18

GRID: NORTHING: 652457.852


EASTING: 1707050.669

LDP: NORTHING: 475020.390

EASTING: 217830.837

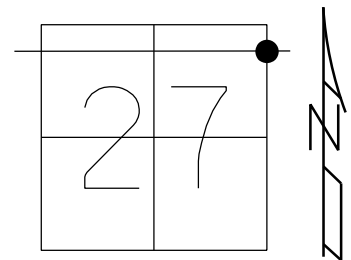

RECORD:
 SET PK/WASHER
 11-07-90 MB
 RESET MAG/WASHER
 NEWREF43 7-9-10 DCH
 FD SHANK HOLE
 RESET SQ NAIL
 REF43
 12/9/22, TDN
 FD SHANK HOLE
 REF43
 7/25/24, TDN

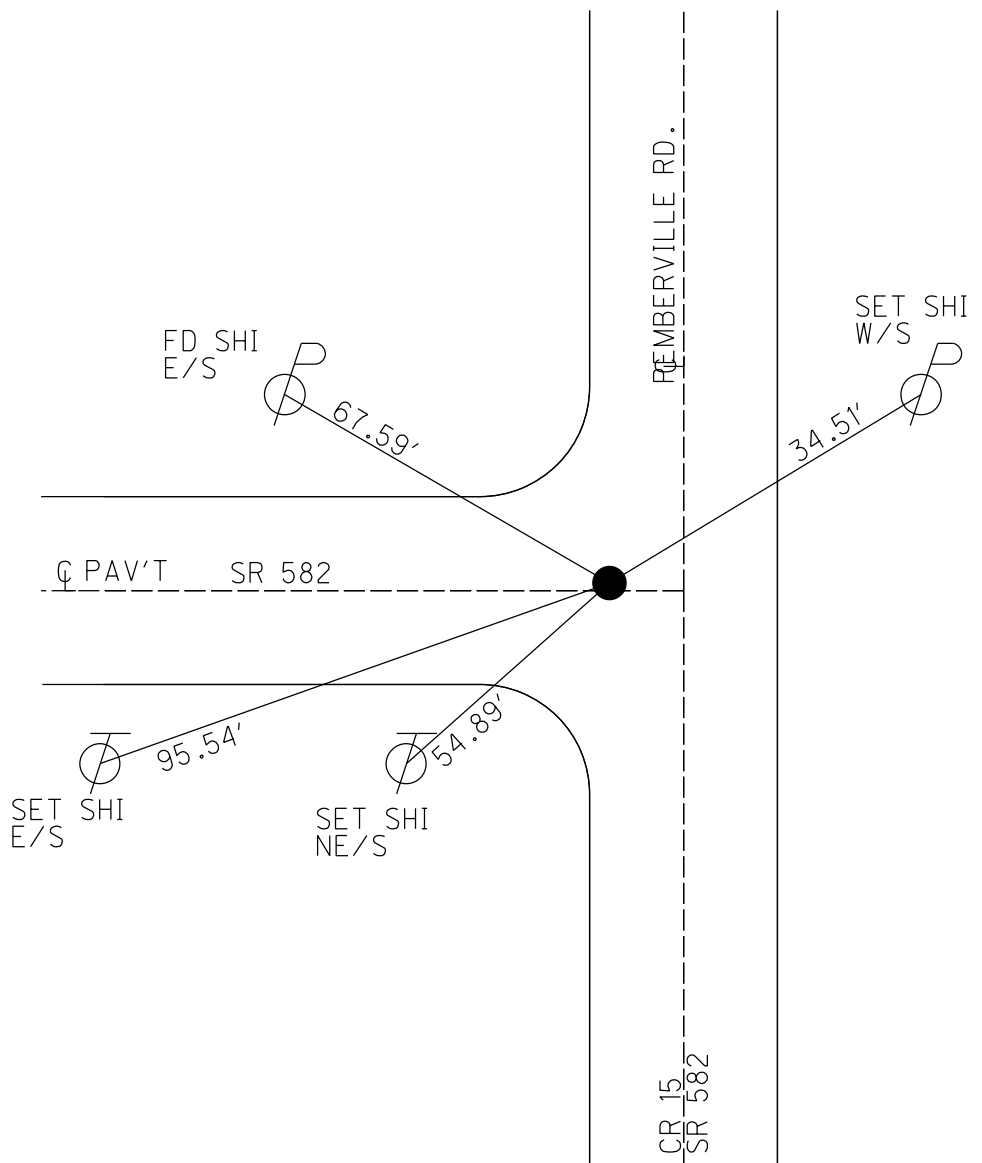

O.D.O.T. DISTRICT 2 SURVEY OFFICE (USE ONLY)

PERSONNEL

REFERENCE NO. 44

SHEET 18 OF 25

NOTES NIESE
H.C. NIESE
R.C. PRESTON-COLVIN

DATE 10/10/24
WEATHER SUNNY
TEMP. 51°

ROUTE SR 582
COUNTY WOOD
TOWNSHIP TROY
SECTION 27

DWG BY BARRIERE PID 107717

T 6 N R 12 E

TYPE MONUMENT MAG/WASHER

ON SURFACE - BELOW ON

OFFSET Q PAVEMENT 9' RT

TO EDGE PAVEMENT

STATION: 862+90.02

HORIZ.DATUM: NAD83 (2011)


GEOID: 18

GRID: NORTHING: 651121.018


EASTING: 1707039.224

LDP: NORTHING: 473683.432

EASTING: 217837.043

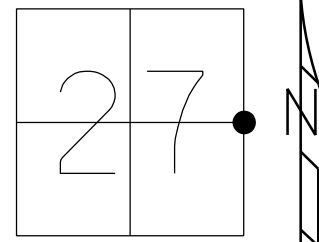

RECORD:
SET P.K./WASHER
11-07-90, MB
SET MAG/WASHER
NEWREF44
7-09-10, DCH
FD MAG/WASHER
REF44
7-31-18, JLL
SET MAG/WASHER
2" DOWN
8-20-19, JFO
FD MAG/WASH
1 1/2" DOWN
REF44
7/24/24, TDN
SET MAG/WASH
10/10/24, TDN

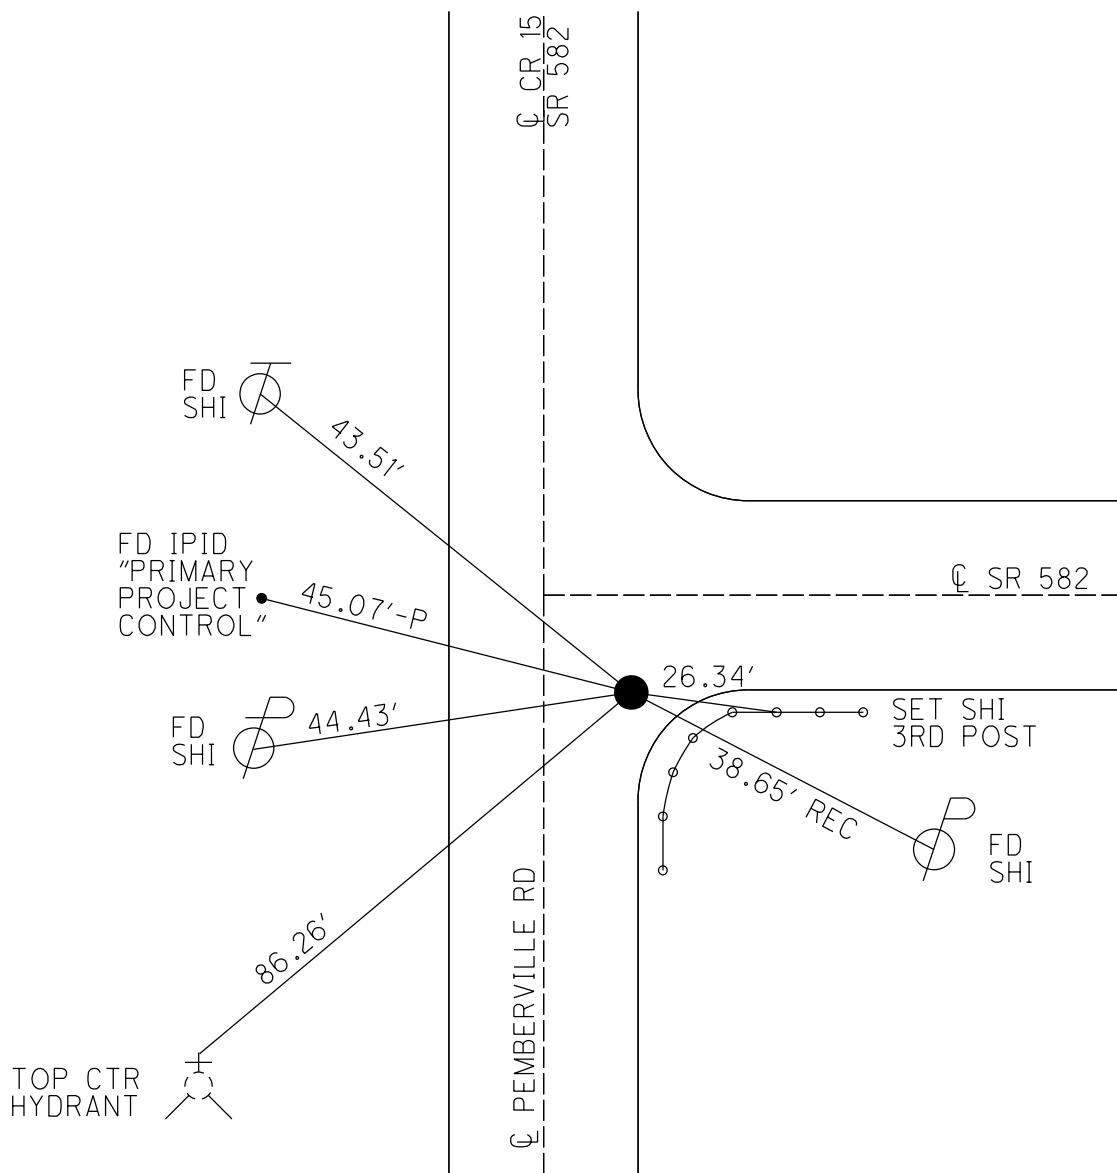

O.D.O.T. DISTRICT 2 SURVEY OFFICE (USE ONLY)

PERSONNEL

REFERENCE NO. 45

SHEET 18 OF 25

NOTES TRENKA
H.C. LEU
R.C. TRENKA

DATE 7/31/18
WEATHER RAIN
TEMP. 73°

ROUTE SR 582
COUNTY WOOD
TOWNSHIP TROY
SECTION 26
T 6 N R 12 E

DWG BY BARRIERE PID 107717

TYPE MONUMENT MAG/WASHER

ON SURFACE - BELOW ON

OFFSET $\varnothing$ PAVEMENT 1.6' LT

TO EDGE PAVEMENT

STATION: 889+25.97

HORIZ.DATUM: NAD83 (2011)


GEOID: 18

GRID: NORTHING: 651100.557


EASTING: 1709675.026

LDP: NORTHING: 473697.774

EASTING: 220473.062

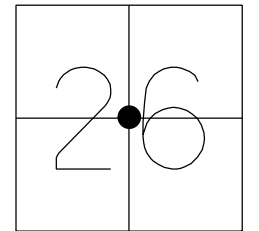

RECORD:
SET P.K./WASHER
6-17-82, SWH
SET MAG/WASHER
NEWREF45
7-09-10, DCH
FD MAG/WASHER
REF45
7-31-18, JLL
8-20-19, JFOFD MAG/WASH
REF45
12/9/22, TDN
FD MAG/WASH
REF45
7/25/24, TDN

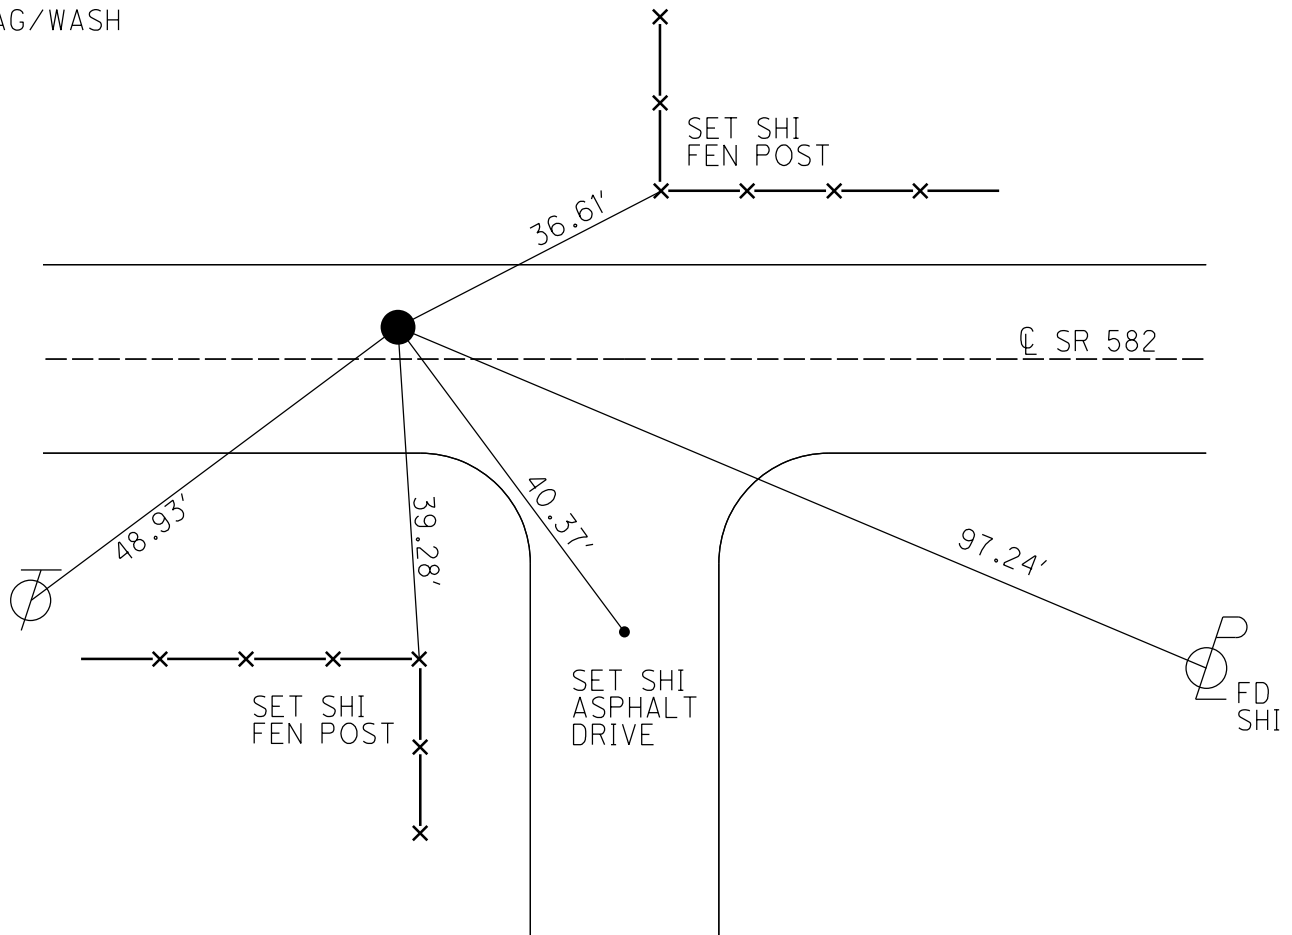

O.D.O.T. DISTRICT 2 SURVEY OFFICE (USE ONLY)

PERSONNEL

REFERENCE NO. 46

SHEET 27 OF 29

NOTES TRENKA

DATE 7-31-18

ROUTE SR 582

H.C. LEU

WEATHER RAIN

COUNTY WOOD

R.C. TRENKA

TEMP. 73°

TOWNSHIP TROY

SECTION 26

DWG BY NIESE PID NO PID

T 6 N R 12 E

TYPE MONUMENT MAG/WASHER

ON SURFACE - ~~BELOW~~ ON

OFFSET CL PAVEMENT 1' ~~LT~~ : RT

- TO - EDGE PAVEMENT 3.0' W OF CL S


STATION: 915+58.29

HORIZ.DATUM: NAD83(2011)

GEOID: 2012A


GRID: NORTHING: 651081.802

EASTING: 1712307.406

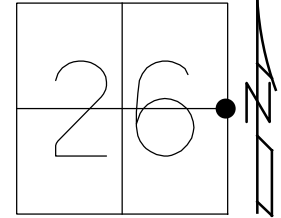

RECORD:
SET P.K./WASHER
6-17-82, SWH
SET MAG/WASHER
NEWREF46
7-09-10, DCH
FD MAG/WASHER
REF46
7-31-18, JLL
8-20-19, JFO

U.S.G.S. B.M.
BROKEN-TIPPED
(APPEARS TO BE
DESTROYED)

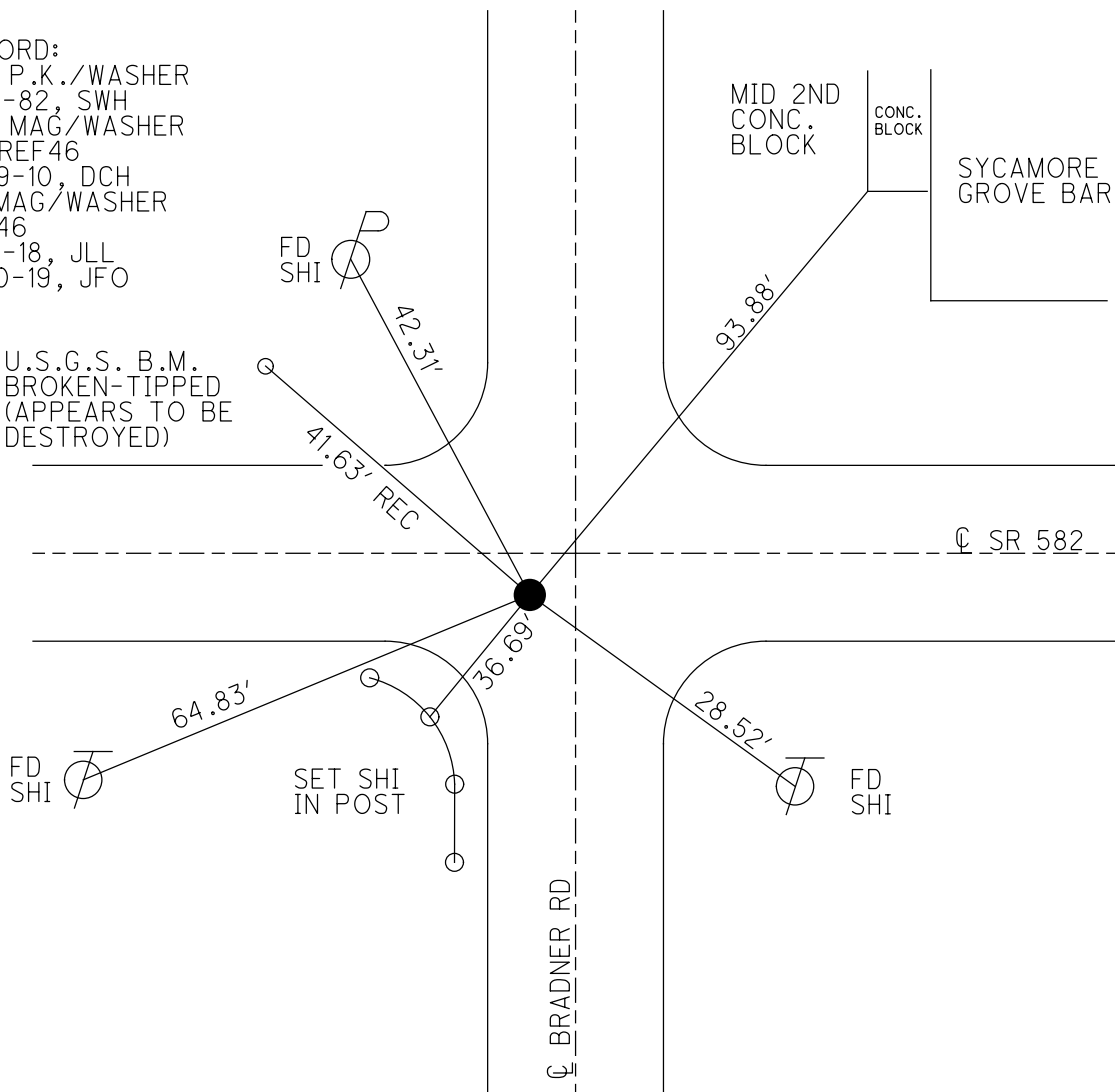

O.D.O.T. DISTRICT 2 SURVEY OFFICE

PERSONNEL

REFERENCE NO. 47

SHEET 28 OF 29

NOTES HOMAN

DATE 4-28-10

ROUTE SR 582

H.C. HOMAN

WEATHER SUNNY

COUNTY WOOD

R.C. ROUSOS

TEMP. 35°

TOWNSHIP TROY

SECTION 25

T 6 N R 12 E

TYPE MONUMENT PK Nail



ON SURFACE - ~~BELOW~~ On Surface

LEFT - ~~C PAV'T~~ RIGHT 0.7'

TO EDGE PAVEMENT

S.L.M. 942+10.07, 8.3' TO N. EP, 9.6' TO S. EP


GRID: NORTHING: 651026.810 EASTING: 1714958.460

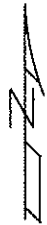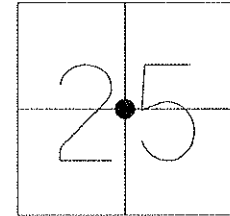

NOTE: FD 1/2" IRON PIN
2" BELOW SURFACE

SET PK/WASHER
6-17-82 SWH

SET MAG/WASHER
NEWREF47 7-09-10 DCH

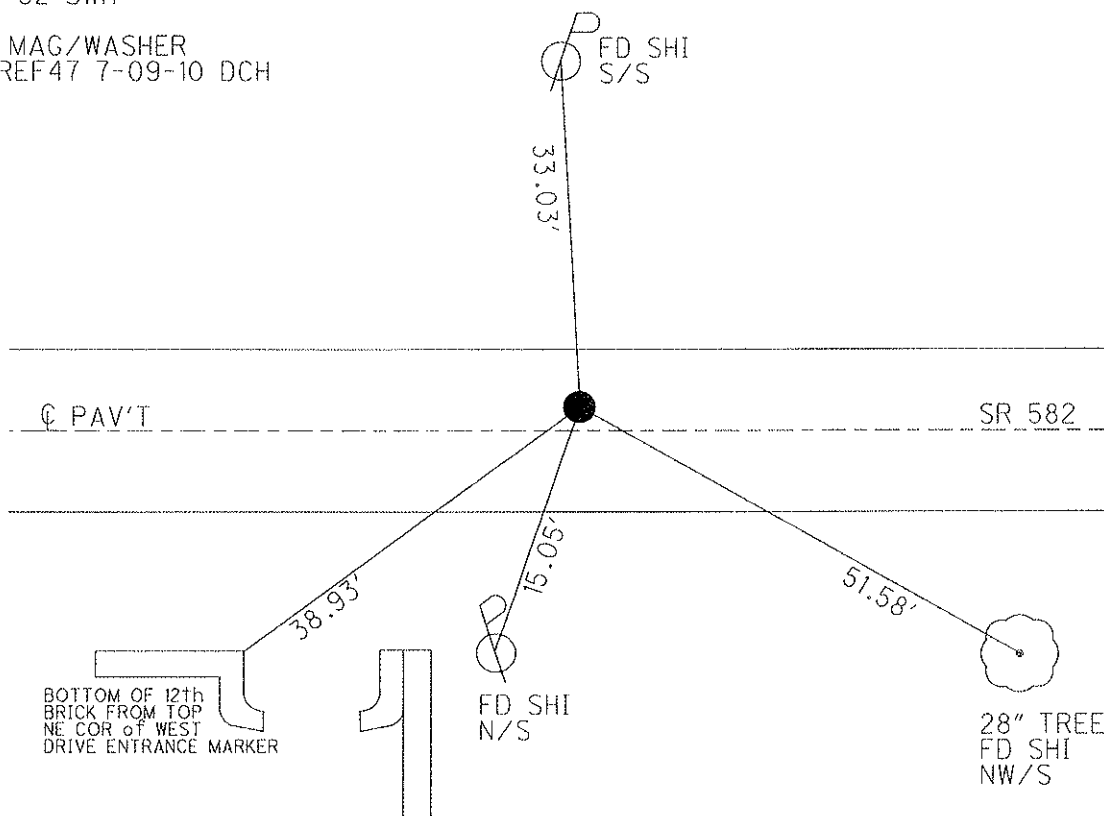

O.D.O.T. DISTRICT 2 SURVEY OFFICE

PERSONNEL

REFERENCE NO. 48

SHEET 29 OF 29

NOTES BURNSIDE

DATE 9-1-77

ROUTE SR 582

H.C. SMITH

WEATHER CLEAR

COUNTY WOOD

R.C. BOWERS

TEMP. 85°

TOWNSHIP TROY

KNAPE

SECTION 25

MEAD

T 6 N R 12 E

TYPE MONUMENT BRASS MONUMENT

~~ON SURFACE~~ - BELOW 1 1/2"


LEFT - Q PAV'T - RIGHT

 TO EDGE PAVEMENT

S.L.M. 1031+74.99

GRID: NORTHING:

EASTING:

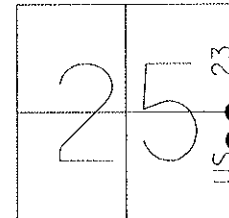

NOTE:
P.I. STA.= 1031+74.99
 $\Delta = 0^{\circ} 01' RT$
FD ADJ. BRASS MON.
1/2" DEEP

