

GUE #0<sup>1655</sup><sub>1657</sub> Puernsey 240 IR-70 Subway

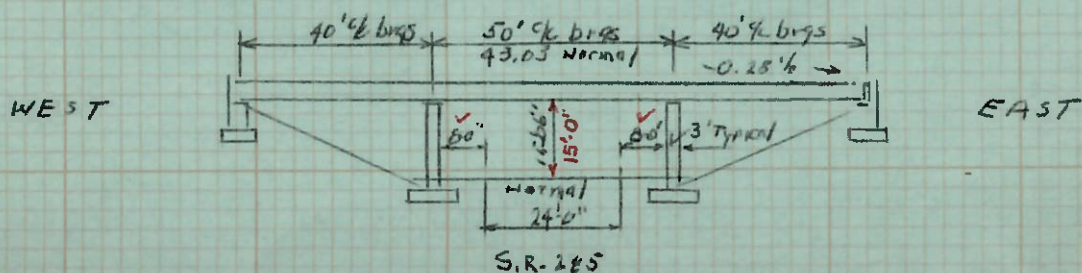
## IR-70 Subway

= GUE-70-1656 L & R

SHOW BY SKETCH - NO. OF JACKS, R.R. AND HIGHWAY ALIGNMENT, SUBWAY CLEARANCES, HORIZONTAL AND VERTICAL.



Red = Field Measure, June '67

 $1'' = 40'$