



I:\ProjectData\LIC\92958\Design\Roadway\Sheets\92958\_GN002.dgn 11-APR-2017 3:06PM jutzl

PAVEMENT MARKING

STOP LINES, CROSSWALK LINES, CHANNELIZING LINES, ETC., SHOWN IN THE PLANS ARE TAKEN FROM EXISTING MARKINGS. THE CONTRACTOR SHALL DOCUMENT ALL OF THE EXISTING AUXILIARY PAVEMENT MARKING LOCATIONS THAT WILL BE REMOVED/OBLITERATED DURING THIS PROJECT. THE CONTRACTOR SHALL PLACE NEW PAVEMENT MARKINGS AT THE LOCATION OF THE EXISTING MARKINGS UNLESS OTHERWISE DIRECTED BY THE ENGINEER. DOCUMENTATION OF PAVEMENT MARKING SHALL BE SUPPLIED TO THE ENGINEER BEFORE COMMENCEMENT OF ANY OPERATION WHICH WILL REMOVE/OBLITERATE MARKINGS. THE METHOD OF DOCUMENTATION SHALL BE APPROVED BY THE ENGINEER IN ORDER TO PROVIDE AN ACCEPTABLE TOLERANCE BETWEEN THE EXISTING AND PROPOSED PAVMENT MARKINGS. **LONG LINE PAVEMENT MARKINGS SHALL BE PLACED PER SECTION 301-4 OF ODOT'S TRAFFIC ENGINEERING MANUAL AND DETAIL ON SHEET 16.**

RESIDENTIAL AND COMMERCIAL DRIVES

AN ESTIMATED QUANTITY OF ITEM 441 ASPHALT CONCRETE, HAS BEEN INCLUDED IN THE PLAN TO BE USED AS DIRECTED BY THE ENGINEER TO PAVE APPROACH AREAS TO EXISTING DRIVEWAYS. PAVING SHALL EXTEND AN AVERAGE OF 4' INTO THE DRIVEWAY (MEASURED FROM THE EDGE OF PAVEMENT OR PAVED SHOULDER IF PRESENT). THE ENGINEER MAY EXTEND PAVING DISTANCE FOR ASPHALT DRIVEWAYS IN ORDER TO PROVIDE A SMOOTH TRANSITION AND/OR ELIMINATE SHORT DISTANCES OF UNDESIRABLE PROFILE. ABRUPT CHANGES IN DRIVEWAY PROFILE ARE NOT PERMITTED, THEREFORE, A QUANTITY OF ITEM 304 AGGREGATE BASE HAS BEEN PROVIDED TO BE USED AS DIRECTED BY THE ENGINEER TO PROVIDE A SMOOTH TRANSITION FOR AGGREGATE DRIVES.

FIELD DRIVES AND OIL WELL DRIVES SHALL NOT BE PAVED. GRAVEL DRIVES SHALL BE PAVED BACK AN AVERAGE OF 4' WITHOUT CREATING A BUTT JOINT, UNLESS OTHERWISE DIRECTED BY THE ENGINEER. CREATE A BUTT JOINT FOR EXISTING ASPHALT/CONCRETE DRIVES/APRONS. GRAVEL DRIVES WITH ASPHALT APRONS SHALL NOT HAVE BUTT JOINTS, BUT ONLY IF THE EXISTING ASPHALT APRON IS IN AN ACCEPTABLE CONDITION TO BE PAVED OVER. IF THE ASPHALT APRON CANNOT BE PAVED OVER (FOR EXAMPLE, BROKEN INTO SMALL PIECES) AS DETERMINED BY THE ENGINEER, IT SHALL BE REMOVED BEFORE BEING PAVED BACK 4' INTO THE DRIVEWAY. ALL GRADING, PRIME OR TACK COAT, MATERIALS, LABOR, EQUIPMENT TOOLS AND INCIDENTALS NECESSARY TO COMPLETE THE DRIVES SHALL BE INCLUDED IN THE UNIT PRICE BID FOR THE ITEMS LISTED BELOW.

BUTT JOINT AT THE END OF ALL DRIVEWAYS SHALL BE 1.5" IN DEPTH TO ACCOMMODATE 1.5" SURFACE COURSE. NO WORK SHALL BE PERFORMED ON DRIVEWAYS LOCATED IN CURB SECTIONS UNLESS OTHERWISE DIRECTED BY THE ENGINEER.

THE FOLLOWING QUANTITIES HAVE BEEN CARRIED TO THE SUB-SUMMARIES FOR THE ABOVE DESCRIBED PURPOSE.

**ITEM 202, WEARING COURSE REMOVED**  
**LOCATION 1A - 230 SQ.YD.**  
**LOCATION 1B – 1110 SQ.YD.**  
**LOCATION 1C – 290 SQ.YD.**  
**LOCATION 1D – 110 SQ.YD.**

**ITEM 304, AGGREGATE BASE**  
**LOCATION 1A - 1 CU.YD.**  
**LOCATION 1B – 4 CU.YD.**  
**LOCATION 1C – 1 CU.YD.**  
**LOCATION 1D – 1 CU.YD.**

**ITEM 441, ASPHALT CONCRETE SURFACE COURSE, TYPE 1, (448), PG 70-22M**  
**LOCATION 1A - 10 CU.YD.**  
**LOCATION 1B – 46 CU.YD.**  
**LOCATION 1C – 12 CU.YD.**  
**LOCATION 1D – 5 CU.YD.**

MAILBOX TURN OUTS

A QUANTITY OF ASPHALT CONCRETE HAS BEEN PROVIDED IN THE PLAN TO COVER MAILBOX TURN-OUTS. TURN-OUTS SHALL BE PAVED AS SHOWN IN THE DETAIL IN DRAWING BP-4.1. ANY EXTRA GRADING OF THE SHOULDERS, PRIME OR TACK COAT, MATERIALS, LABOR, EQUIPMENT, TOOLS AND INCIDENTALS NECESSARY TO COMPLETE MAILBOX TURN OUTS SHALL BE INCLUDED IN THE UNIT PRICE BID FOR THE ITEMS LISTED BELOW.

THE FOLLOWING QUANTITIES HAVE BEEN CARRIED TO THE SUB-SUMMARIES FOR THE ABOVE PURPOSES.

**ITEM 202, WEARING COURSE REMOVED**  
**LOCATION 1A - 100 SQ.YD.**  
**LOCATION 1B – 610 SQ.YD.**  
**LOCATION 1C – 110 SQ.YD.**  
**LOCATION 1D – 60 SQ.YD.**

**ITEM 441 ASPHALT CONCRETE SURFACE COURSE, TYPE 1, (448), PG 70-22M**  
**LOCATION 1A - 5 CU.YD.**  
**LOCATION 1B - 26 CU.YD.**  
**LOCATION 1C – 5 CU.YD.**  
**LOCATION 1D – 3 CU.YD.**

**ITEM 611, CATCH BASIN ADJUSTED TO GRADE**  
**ITEM 611, MANHOLE ADJUSTED TO GRADE**  
**ITEM 638, VALVE BOX ADJUSTED TO GRADE**

THESE ITEMS SHALL BE USED TO ADJUST TO GRADE CATCH BASINS, MANHOLES, AND WATER VALVE BOXES LOCATED THROUGH OUT THE PROJECT LIMITS AS DIRECTED BY THE ENGINEER.

ALL MATERIALS, LABOR, EQUIPMENT, TOOLS, AND INCIDENTALS NECESSARY TO COMPLETE THE WORK DESCRIBED SHALL BE INCLUDED FOR PAYMENT WITH THE ITEMS LISTED BELOW.

ANY GAS VALVE BOXES AND TELEPHONE COMPANY MANHOLES ON THIS PROJECT SHALL BE ADJUSTED TO GRADE BY THE RESPECTIVE OWNERS.

~~ITEM 611, CATCH BASIN ADJUSTED TO GRADE~~  
~~LOCATION 1E - 3 EACH~~  
~~ODOT D05 COMPLEX – 24 EACH~~

~~ITEM 611, MANHOLE ADJUSTED TO GRADE~~  
~~LOCATION 1D – 1 EACH~~  
~~LOCATION 1E – 12 EACH~~  
~~ODOT D05 COMPLEX – 4 EACH~~

**ITEM 638, VALVE BOX ADJUSTED TO GRADE**  
**LOCATION 1E - 5 EACH**

ITEM 606, ANCHOR ASSEMBLY, MGS TYPE B

THIS ITEM SHALL CONSIST OF FURNISHING AND INSTALLING ANY OF THE GUARDRAIL END TERMINALS FOR TYPE MGS GUARDRAIL AS LISTED ON ROADWAY ENGINEERING'S WEB PAGE UNDER ROADSIDE SAFETY DEVICES FOR APPROVED GUARDRAIL END TREATMENTS. INSTALLATION SHALL BE AT THE LOCATIONS SPECIFIED IN THE PLANS, IN ACCORDANCE WITH THE MANUFACTURER'S SPECIFICATIONS.

REFER TO THE MANUFACTURER'S INSTRUCTIONS REGARDING THE INSTALLATION OF, AND THE GRADING AROUND, THE FOUNDATION TUBES AND GROUND STRUT. THE TOP OF ANY FOUNDATION TUBE SHOULD BE LESS THAN 4 INCHES ABOVE THE GROUND. THE PLACEMENT OF THE FOUNDATION TUBES SHOULD BE AN APPROPRIATE DEPTH BELOW THE LEVEL LINE IN ORDER TO MAINTAIN THE FINISHED GUARDRAIL HEIGHT OF 31 INCHES FROM THE EDGE OF THE SHOULDER.

ON-SITE GRADING IS REQUIRED IF THE TOP OF THE FOUNDATION TUBES OR TOP OF THE GROUND STRUT DOES PROJECT MORE THAN 4 INCHES ABOVE THE GROUND LINE.

THE FACE OF THE TYPE B IMPACT HEAD SHALL BE COVERED WITH TYPE G REFLECTIVE SHEETING, PER CMS 730.19.

PAYMENT FOR THE ABOVE WORK SHALL BE MADE AT THE UNIT PRICE BID FOR ITEM 606, ANCHOR ASSEMBLY, MGS TYPE B, EACH, AND SHALL INCLUDE ALL LABOR, TOOLS, EQUIPMENT AND MATERIALS NECESSARY TO CONSTRUCT A COMPLETE AND FUNCTIONAL ANCHOR ASSEMBLY SYSTEM, INCLUDING REFLECTIVE SHEETING AND ALL RELATED HARDWARE, GRADING, EMBANKMENT AND EXCAVATION NOT SEPARATELY SPECIFIED, AS REQUIRED BY THE MANUFACTURER.

ITEM 606, ANCHOR ASSEMBLY, MGS TYPE E

THIS ITEM SHALL CONSIST OF FURNISHING AND INSTALLING ANY OF THE GUARDRAIL END TERMINALS FOR TYPE MGS GUARDRAIL AS LISTED ON ROADWAY ENGINEERING'S WEB PAGE UNDER ROADSIDE SAFETY DEVICES FOR APPROVED GUARDRAIL END TREATMENTS. INSTALLATION SHALL BE AT THE LOCATIONS SPECIFIED IN THE PLANS, IN ACCORDANCE WITH THE MANUFACTURER'S SPECIFICATIONS.

THE FACE OF THE TYPE E IMPACT HEAD SHALL BE COVERED WITH A SHEET OF TYPE G REFLECTIVE SHEETING, PER CMS 730.19.

REFER TO THE MANUFACTURER'S INSTRUCTIONS REGARDING THE INSTALLATION OF, AND THE GRADING AROUND THE FOUNDATION TUBES AND GROUND STRUT. THE TOP OF ANY FOUNDATION TUBE SHOULD BE LESS THAN 4 INCHES ABOVE THE GROUND. THE PLACEMENT OF THE FOUNDATION TUBES SHOULD BE AN APPROPRIATE DEPTH BELOW THE LEVEL LINE IN ORDER TO MAINTAIN THE FINISHED GUARDRAIL HEIGHT OF 31 INCHES FROM THE EDGE OF THE SHOULDER.

ON-SITE GRADING IS REQUIRED IF THE TOP OF THE FOUNDATION TUBES OR TOP OF THE GROUND STRUT DOES PROJECT MORE THAN 4 INCHES ABOVE THE GROUND LINE.

PAYMENT FOR THE ABOVE WORK SHALL BE MADE AT THE UNIT PRICE BID FOR ITEM 606, ANCHOR ASSEMBLY, MGS TYPE E, EACH, AND SHALL INCLUDE ALL LABOR, TOOLS, EQUIPMENT AND MATERIALS NECESSARY TO CONSTRUCT A COMPLETE AND FUNCTIONAL ANCHOR ASSEMBLY SYSTEM, INCLUDING ALL RELATED TRANSITIONS, REFLECTIVE SHEETING, HARDWARE, GRADING, EMBANKMENT AND EXCAVATION NOT SEPARATELY SPECIFIED, AS REQUIRED BY THE MANUFACTURER.

CALCULATED  
LIME  
CHECKED  
JSL

GENERAL NOTES

LIC-13-0.00

3  
90



I:\ProjectData\LIC\92958\Design\Roadway\Sheets\92958\_GN003.dgn 03-MAR-2017 10:54 AM jutz1

ITEM 632, DETECTOR LOOP, AS PER PLAN

ALL STOP LINE INDUCTANCE DETECTOR LOOPS SHALL BE THE POWER HEAD CONFIGURATION SHOWN ON TC-82.10. THE WIDTH SHALL BE AS SPECIFIED ON TC-82.10 AND THE LENGTH SHALL BE 20' OR AS DIRECTED. THE STOP LINE DETECTOR LOOPS SHALL NOT BE WIRED TO ANY OTHER LOOPS AND SHALL HAVE ITS OWN DETECTOR CHANNEL. ALL STOP LINE DETECTION SHALL BE TESTED FOR A BICYCLE TARGET AND ALL DILEMMA DETECTION ZONES SHALL BE TESTED FOR A MOTORCYCLE TARGET.

ALL DILEMMA ZONE INDUCTANCE DETECTOR LOOPS CALLED FOR IN THE PLANS SHALL BE THE ANGULAR DESIGN DETECTION (ADD) LOOP AS SHOWN ON TC-82.10. DIMENSIONS SHALL BE AS SPECIFIED ON TC-82.10.

ALL DETECTOR LOOPS SHALL BE CUT INTO THE PLANED SURFACE OR THE PROPOSED INTERMEDIATE COURSE AT A DEPTH OF 4" FROM THE PROPOSED SURFACE ELEVATION. THE CONTRACTOR SHALL TEST ALL LEAD-IN CABLES PRIOR TO MAKING THE FINAL SPLICE. PLACEMENT SHALL BE AS PER SPECIFICATION 632.10.

FINAL LOCATIONS, SIZE AND ORIENTATION SHALL BE PROVIDED TO THE CONTRACTOR AT THE PRE-CONSTRUCTION MEETING.

ALL MATERIALS, LABOR, TOOLS, EQUIPMENT, TRAFFIC CONTROL AND INCIDENTALS NECESSARY TO PERFORM THE WORK DESCRIBED ABOVE SHALL BE INCLUDED IN THE UNIT PRICE BID FOR ITEM 632, DETECTOR LOOP, AS PER PLAN.

THE FOLLOWING CONTIGENCY QUANTITIES HAVE BEEN CARRIED TO THE SUB-SUMMARIES FOR THE ABOVE PURPOSES.

ITEM 632, DETECTOR LOOP, AS PER PLAN

LOCATION 1B – 12 EACH

ON S.R. 13 N.B. BEFORE U.S. 40 – 1 DILEMMA  
ON U.S. 40 W.B. AT S.R. 13 – 1 POWERHEAD  
ON S.R. 13 S.B. BEFORE U.S. 40 – 1 DILEMMA

ON S.R. 13 N.B. AT DORSEY MILL RD. – 1 POWERHEAD, 4 DILEMMA  
DORSEY MILL RD. (LEFT) – 2 POWERHEAD  
DORSEY MILL RD. (RIGHT) – 2 POWERHEAD

LOCATION 1C – 5 EACH

ON S.R. 13 S.B. AT DORSEY MILL RD. – 1 POWERHEAD, 4 DILEMMA

LOCATION 1D – 3 EACH

ON S.R. 13 N.B. AT HOPEWELL DR. – 1 POWERHEAD  
ON S.R. 13 S.B. AT HOPEWELL DR. – 1 POWERHEAD  
ON HOPEWELL DR. (RIGHT) – 1 POWERHEAD

LOCATION 1E – 3 EACH

ON S.R. 13 N.B. AT WILWOOD AVE. – 1 POWERHEAD, 1 DILEMMA  
ON S.R. 13 S.B. AT WILWOOD AVE. – 1 DILEMMA

SAFETY EDGE

IN ADDITION TO THE REQUIREMENTS OF 401.12, ATTACH A DEVICE TO THE SCREED OF THE PAVER THAT CONFINES THE MATERIAL AT THE END GATE AND EXTRUDES THE ASPHALT MATERIAL IN SUCH A WAY THAT RESULTS IN A COMPACTED WEDGE SHAPE PAVEMENT EDGE OF APPROXIMATELY 30 DEGREES (NOT STEEPER THAN 40 DEGREES). ENSURE THE DEVICE MAINTAINS CONTACT WITH THE EXISTING SURFACE, AND ALLOW FOR AUTOMATIC TRANSITION TO CROSS ROADS, DRIVEWAYS AND OBSTRUCTIONS. DO NOT USE CONVENTIONAL SINGLE PLATE STRIKE OFF.

CONSTRUCTION OF SAFETY EDGE CAN BE OMITTED AT LOCATIONS WHERE EXISTING WIDTH OF GRADED SHOULDER OR BERM IS LESS THAN 12". PROJECTS WITH VARYING CONDITIONS SHOULD USE SAFETY EDGE WHERE POSSIBLE. PLAN PREPARATION HAS MADE EVERY REASONABLE ATTEMPT TO IDENTIFY POSSIBLE SAFETY EDGE LOCATIONS.

USE THE TRANS TECH SHOULDER WEDGE MAKER, THE CARLSON SAFETY EDGE END GATE, THE ADVANT-EDGER, THE TROXLER SAFETSLOPE OR A SIMILAR APPROVED-EQUAL DEVICE THAT PRODUCES THE SAME WEDGE CONSOLIDATION RESULTS. CONTACT INFORMATION FOR THESE WEDGE SHAPE COMPACTION DEVICES IS THE FOLLOWING:

TransTech Systems, Inc.  
1594 State Street  
Schenectady, NY 12304  
1-800-724-6306  
[www.transtechsys.com](http://www.transtechsys.com)

Carlson Safety Edge End Gate  
18425 50<sup>th</sup> Avenue East  
Tacoma, WA 98446  
253-875-8000

Advant-Edge Paving Equipment, LLC.  
P.O. Box 9163  
Niskayuna, NY 12309-0163  
518-280-6090  
[www.advantaedgepaving.com](http://www.advantaedgepaving.com)

Troxler Electronics Laboratories, Inc.  
3008 E. Cornwallis Rd.  
Research Triangle Park, NC 27709  
1-877-TROXLER  
[www.troxlerlabs.com](http://www.troxlerlabs.com)

IF ELECTING TO USE A SIMILAR DEVICE, PROVIDE PROOF THAT THE DEVICE HAS BEEN USED ON PREVIOUS PROJECTS WITH ACCEPTABLE RESULTS OR CONSTRUCT A TEST SECTION PRIOR TO THE BEGINNING OF WORK AND DEMONSTRATE WEDGE COMPACTION TO THE SATISFACTION OF THE ENGINEER. SHORT SECTIONS OF HANDWORK WILL BE ALLOWED WHEN NECESSARY FOR TRANSITIONS AND TUENOUTS OR OTHERWISE AUTHORIZED BY THE ENGINEER.

IN ADDITION TO THE REQUIREMENTS OF 401.16, MAKE THE FIRST ROLLER PASS 8 TO 12 INCHES (200 TO 300 mm) AWAY FROM TAPERED EDGE. DO NOT ROLL THE TAPER.

THE FOLLOWING QUANTITIES HAVE BEEN CARRIED TO THE SUB-SUMMARIES TO PROVIDE EXTRA ASPHALT FOR CONSTRUCTION OF THE SAFETY EDGE:

ITEM 448 ASPHALT CONCRETE SURFACE COURSE, TYPE 1, PG 70-22M

LOCATION 1A - 8 CU.YD.  
LOCATION 1B - 83 CU.YD.  
LOCATION 1C - 18 CU.YD.  
LOCATION 1D – 9 CU.YD.

CURB REPAIR (ODOT D-5 COMPLEX)

THE FOLLOWING QUANTITIES HAVE BEEN CARRIED TO THE GENERAL SUMMARY AND SHALL BE USED TO REPLACE BROKEN/DEFICIENT CURB WITHIN THE ODOT D-5 COMPLEX **AS DIRECTED BY THE ENGINEER.**

**ODOT D-5 COMPLEX:**  
**ITEM 202, CURB REMOVED – 100 FT**  
**ITEM 609, CURB, TYPE 6 – 100 FT**

SIDEWALK REPAIR (VILLAGE OF JACKSONTOWN)

THE FOLLOWING QUANTITIES HAVE BEEN CARRIED TO THE LOCATION 1B SUB-SUMMARY AND SHALL BE USED TO REPAIR DETERIORATED CONCRETE WALK WITHIN THE VILLAGE OF JACKSONTOWN **AS DIRECTED BY THE ENGINEER.**

**LOCATION 1B (JACKSONTOWN):**  
**ITEM 202, WALK REMOVED – 400 SF**  
**ITEM 608, 4" CONCRETE WALK – 400 SF**

PAVED GUTTER REPAIR (S.R. 13 HILL)

THE FOLLOWING QUANTITY HAS BEEN CARRIED TO THE LOCATION 1B SUB-SUMMARY AND SHALL BE USED TO REPAIR THE PAVED CONCRETE GUTTER PRIOR TO RESURFACING **AS DIRECTED BY THE ENGINEER.**

**LOCATION 1B (GUTTER):**  
**ITEM 613, LOW STRENGTH MORTAR BACKFILL, TYPE 2, AS PER PLAN - 10 CU. YD.**

THE GUTTER SHALL BE CLEANED OF ALL DIRT, LOOSE CONCRETE, AND ALL OTHER DEBRIS PRIOR TO APPLYING LOW STRENGTH MORTAR. THE ADDITIONAL WORK SHALL BE INCLUDED IN PAYMENT FOR LOW STRENGTH MORTAR BACKFILL, TYPE 2, AS PER PLAN.

ITEM SPECIAL - REINFORCED MESH FOR TRANSVERSE AND/OR LONGITUDINAL JOINTS AND CRACKS



THIS ITEM SHALL BE USED TO REINFORCE LONGITUDINAL WIDENING JOINT FOR TURN LANE CONSTRUCTION AT DAWES ARBORETUM ON S.R. 13. PLACE REINFORCING MESH ON PLANED SURFACE, 5.0' WIDE CENTERED OVER LONGITUDINAL JOINT. REINFORCING MATERIAL SHALL BE GLASGRID CG100 OR EQUIVALENT AND SHALL BE PLACED ACCORDING TO MANUFACTURER'S SPECIFICATIONS AND THIS NOTE.

THIS PROJECT IS EVALUATING THE EFFECTIVENESS OF REINFORCED MESH OVER LONGITUDINAL JOINTS. THEREFORE, **ONLY PLACE THE REINFORCED MESH FROM STA. 215+60 TO STA. 224+60.**

ALL MATERIALS, LABOR, EQUIPMENT, TOOLS, TRAFFIC CONTROL AND INCIDENTALS NEEDED TO COMPLETE THE WORK DESCRIBED ABOVE SHALL BE INCLUDED FOR PAYMENT IN THE UNIT PRICE BID FOR ITEM 690 SPECIAL - REINFORCED MESH FOR TRANSVERSE AND/OR LONGITUDINAL JOINTS AND CRACKS.

**LOCATION 1B:**  
**ITEM 690 SPECIAL - REINFORCED MESH FOR TRANSVERSE AND/OR LONGITUDINAL JOINTS AND CRACKS - 500 SQ.YD.**



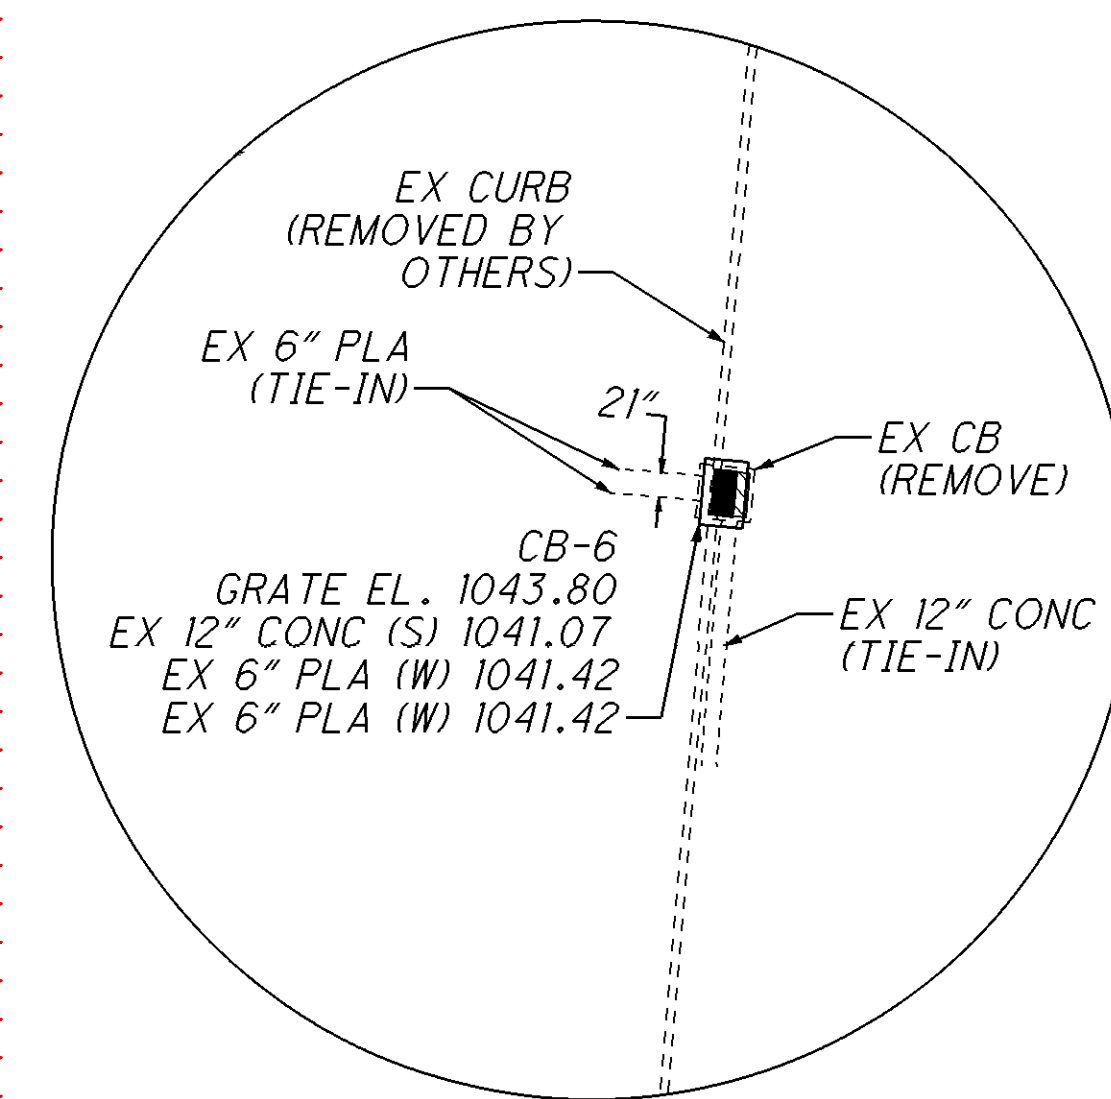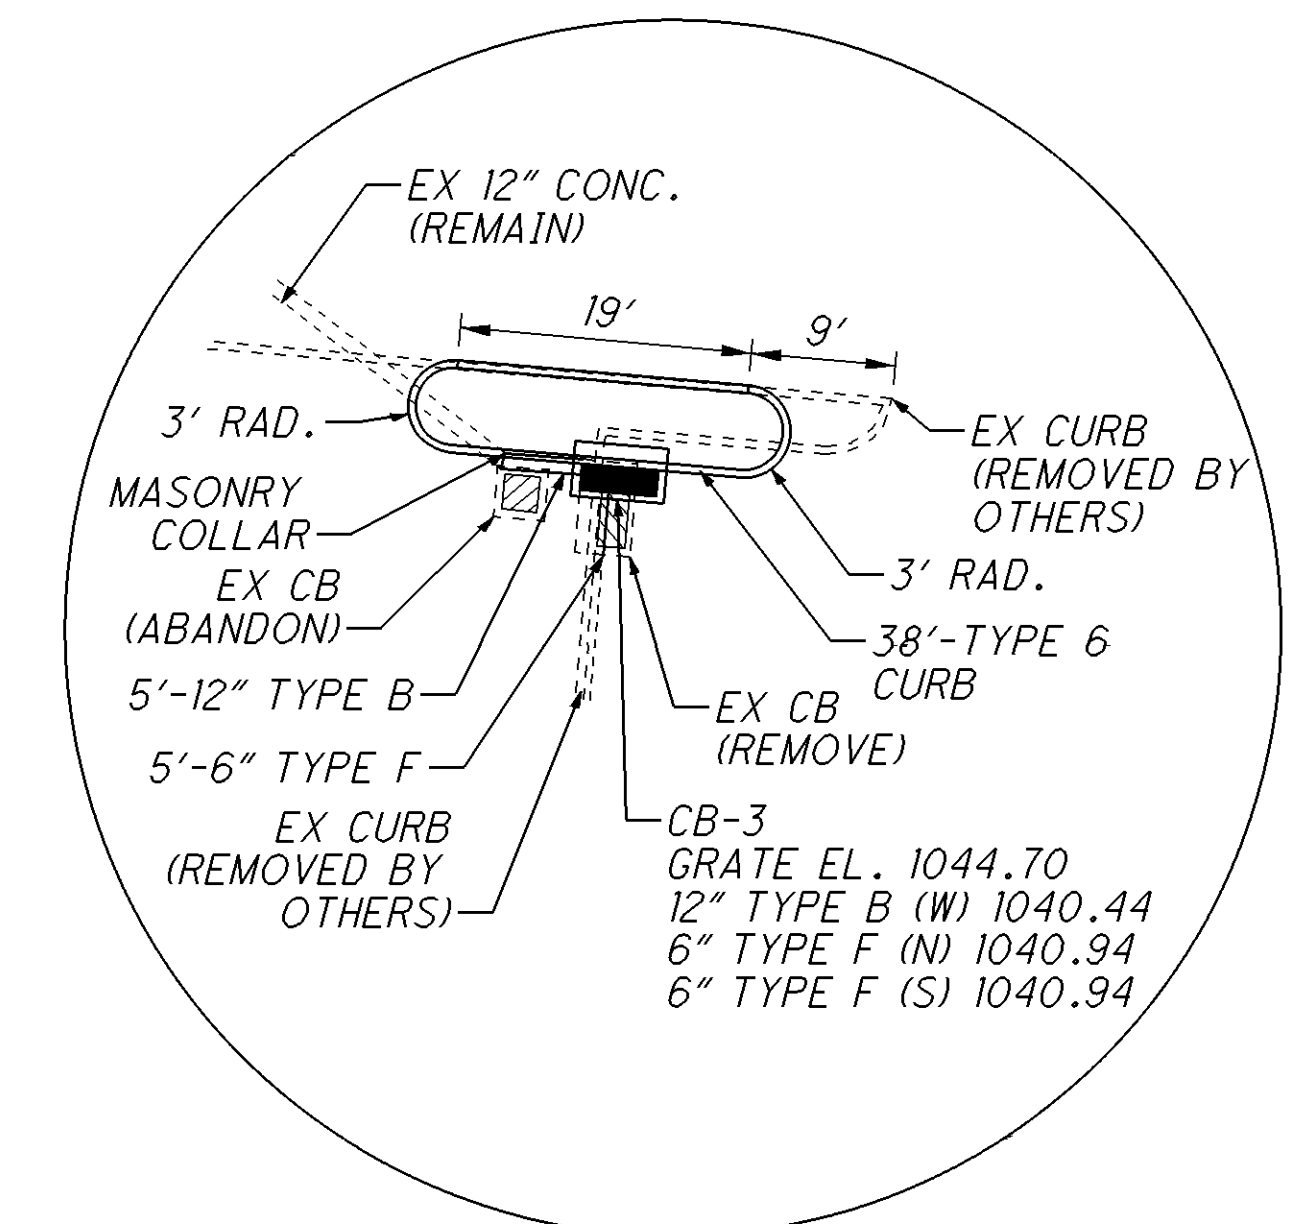

LOT A: 1,361 SQ.YD.  
LOT B: 6,480 SQ.YD.  
LOT C: 1,230 SQ.YD.  
LOT D: 4,667 SQ.YD.  
DRIVES: 7,109 SQ.YD.

LOT A: 1,361 SQ.YD.  
LOT B: 6,480 SQ.YD.  
LOT C: 1,230 SQ.YD.  
LOT D: 4,667 SQ.YD.  
DRIVES: 7,109 SQ.YD.

SEE SHEET 4 FOR CURB REPAIR QUANTITIES  
SEE SHEET 14 FOR RESURFACING QUANTITIES  
SEE SHEETS 22,24,40 AND 41 FOR STRIPING QUANTITIES/DETAILS

ADDITIONAL QUANTITIES NOT CARRIED TO THE GENERAL SUMMARY

ITEM 202, CATCH BASIN REMOVED - 2 EACH

ITEM 202, CATCH BASIN ABANDONED - 1 EACH


ITEM 609, CURB, TYPE 6 - 57 FT

ITEM 611, 12" CONDUIT, TYPE B - 5 FT

ITEM 611, 6" TYPE F - 5 FT

ITEM 611, CATCH BASIN, NO. 3 - 1 EACH

ITEM 611, CATCH BASIN, NO. 6 - 1 EACH

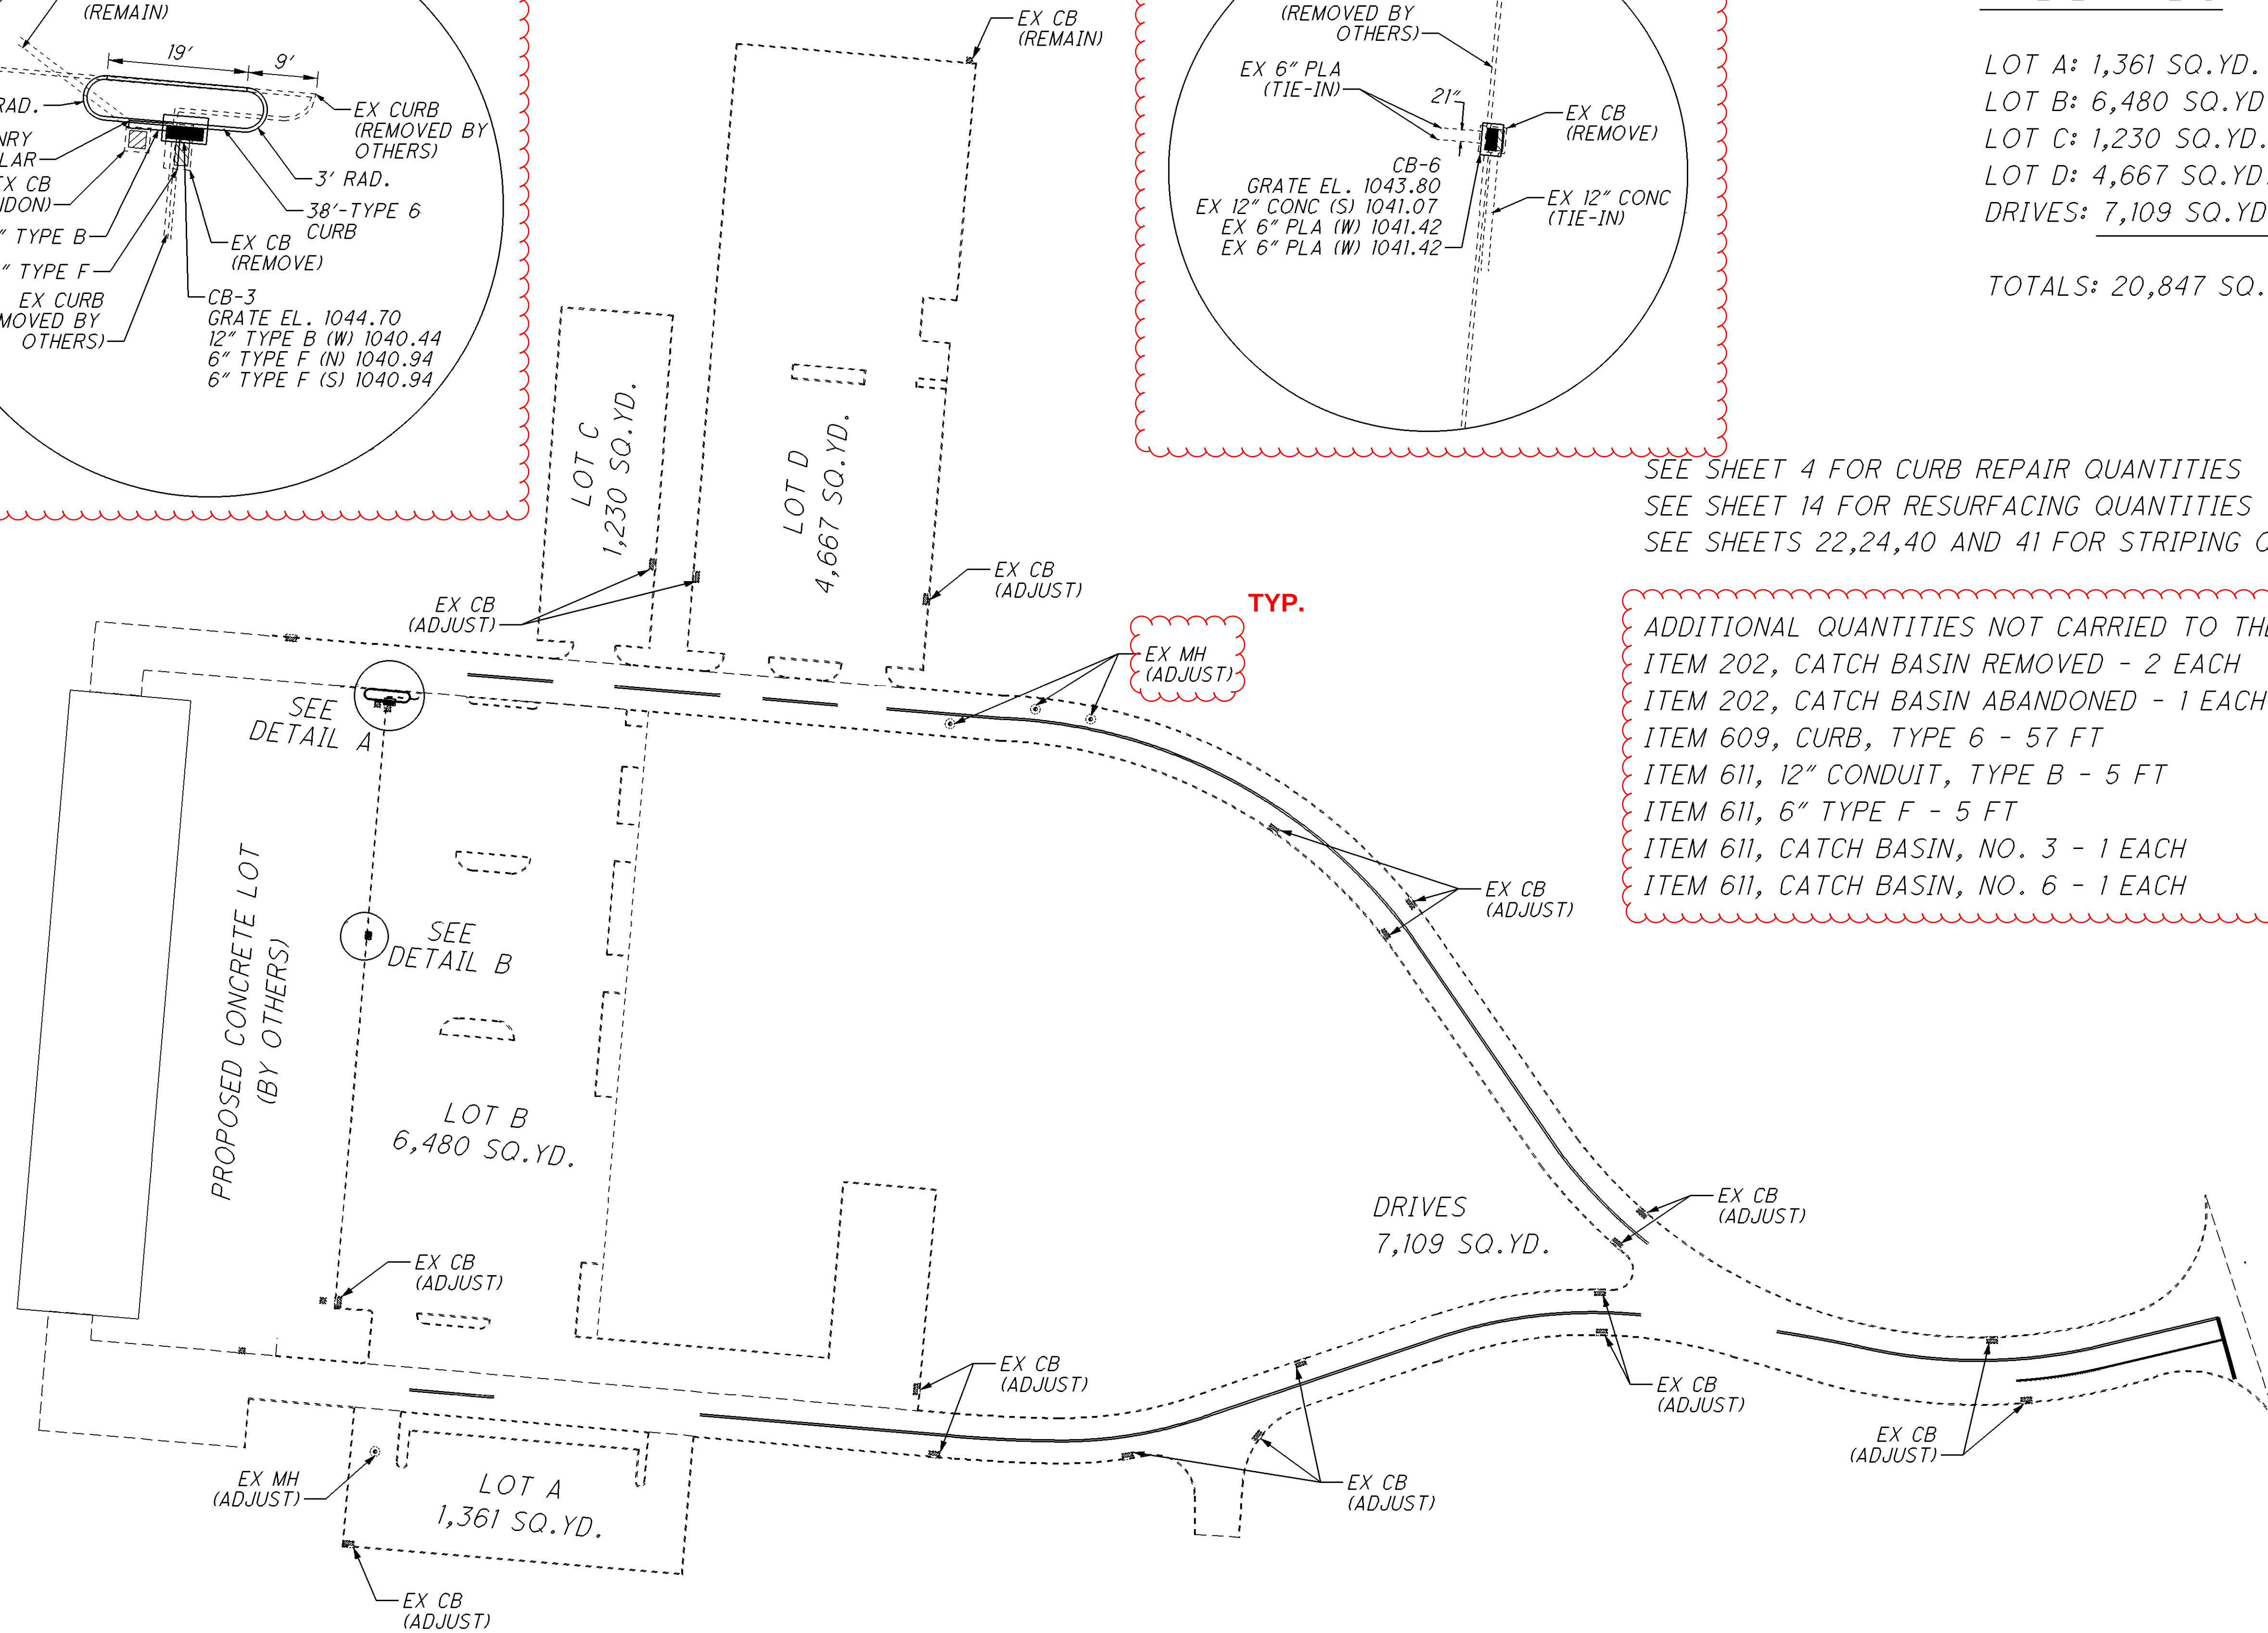



I:\ProjectData\LIC\92958\Design\Roadway\Sheets\92958\_GE001.dgn

08-SEP-2017 6:07PM

julz1

| S.R. 13 CURVE AT DAWES ARBORETUM |                     |                     |                               |                       |                     |                     |                                           |                        |                      |                      |                        |                    |                          |                      |                      |                        |                     |
|----------------------------------|---------------------|---------------------|-------------------------------|-----------------------|---------------------|---------------------|-------------------------------------------|------------------------|----------------------|----------------------|------------------------|--------------------|--------------------------|----------------------|----------------------|------------------------|---------------------|
| LEFT EDGE OF SHOULDER            | LEFT SHOULDER WIDTH | LEFT SHOULDER SLOPE | LEFT EDGE CORRECTION (INCHES) | LEFT EDGE OF PAVEMENT | LEFT PAVEMENT WIDTH | LEFT PAVEMENT SLOPE | PROPOSED CENTERLINE SURVEY & CONSTRUCTION | PROPOSED PROFILE GRADE | RIGHT PAVEMENT SLOPE | RIGHT PAVEMENT WIDTH | RIGHT EDGE OF PAVEMENT | SAW CUT LINE WIDTH | SAW CUT EDGE OF PAVEMENT | RIGHT SHOULDER SLOPE | RIGHT SHOULDER WIDTH | RIGHT EDGE OF SHOULDER | COMMENTS            |
| 1014.72                          | 2.0                 | -0.040              | 0.00                          | 1014.80               | 11.77               | 0.006               | 206+40.38                                 | 1014.74                | -0.043               | 11.77                | 1014.23                | 11.48              | 1014.24                  | -0.043               | 2.0                  | 1014.14                | MATCH EXISTING      |
| 1014.57                          | 2.0                 | -0.040              | 0.28                          | 1014.65               | 11.80               | 0.008               | 206+50.00                                 | 1014.56                | -0.044               | 11.89                | 1014.03                | 11.44              | 1014.05                  | -0.044               | 2.0                  | 1013.94                |                     |
| 1014.20                          | 2.0                 | -0.040              | 1.23                          | 1014.28               | 11.90               | 0.016               | 206+75.00                                 | 1014.10                | -0.048               | 12.22                | 1013.51                | 11.29              | 1013.55                  | -0.048               | 2.0                  | 1013.41                |                     |
| 1013.86                          | 2.0                 | -0.040              | 2.93                          | 1013.94               | 12.00               | 0.023               | 207+00.00                                 | 1013.67                | -0.056               | 12.54                | 1012.96                | 11.01              | 1013.05                  | -0.056               | 2.0                  | 1012.85                |                     |
| 1013.55                          | 2.2                 | -0.039              | 3.40                          | 1013.63               | 12.00               | 0.031               | 207+25.00                                 | 1013.27                | -0.059               | 12.86                | 1012.51                | 11.12              | 1012.61                  | -0.059               | 2.0                  | 1012.39                |                     |
| 1013.20                          | 2.3                 | -0.032              | 2.77                          | 1013.27               | 12.00               | 0.038               | 207+50.00                                 | 1012.82                | -0.060               | 13.19                | 1012.03                | 10.99              | 1012.16                  | -0.060               | 2.0                  | 1011.91                |                     |
| 1012.95                          | 2.4                 | -0.027              | 2.22                          | 1013.02               | 12.00               | 0.043               | 207+65.38                                 | 1012.51                | -0.063               | 13.39                | 1011.66                | 10.98              | 1011.81                  | -0.063               | 2.0                  | 1011.53                | PC                  |
| 1012.79                          | 2.5                 | -0.024              | 1.79                          | 1012.85               | 12.00               | 0.046               | 207+75.00                                 | 1012.31                | -0.065               | 13.51                | 1011.43                | 10.86              | 1011.60                  | -0.065               | 2.0                  | 1011.30                |                     |
| 1012.32                          | 2.9                 | -0.017              | 0.67                          | 1012.37               | 12.00               | 0.053               | 208+00.00                                 | 1011.74                | -0.071               | 13.83                | 1010.76                | 10.12              | 1011.02                  | -0.071               | 2.0                  | 1010.62                |                     |
| 1012.14                          | 3.6                 | 0.061               | 0.35                          | 1011.92               | 12.00               | 0.061               | 208+25.00                                 | 1011.20                | -0.076               | 14.16                | 1010.12                | 9.82               | 1010.45                  | -0.076               | 2.0                  | 1009.97                |                     |
| 1011.62                          | 4.5                 | 4' ROUNDING         | 0.35                          | 1011.51               | 12.00               | 0.068               | 208+50.00                                 | 1010.70                | -0.080               | 14.48                | 1009.54                | 10.23              | 1009.88                  | -0.080               | 2.0                  | 1009.38                |                     |
| 1011.25                          | 5.0                 | 4' ROUNDING         | -0.02                         | 1011.13               | 12.00               | 0.075               | 208+75.00                                 | 1010.23                | -0.083               | 14.80                | 1009.00                | 10.05              | 1009.39                  | -0.083               | 2.0                  | 1008.83                |                     |
| 1011.05                          | 5.1                 | 4' ROUNDING         | 0.23                          | 1010.93               | 12.00               | 0.080               | 208+90.38                                 | 1009.97                | -0.081               | 15.00                | 1008.75                | 9.97               | 1009.16                  | -0.081               | 2.0                  | 1008.59                | BEGIN FULL SUPER LT |
| 1010.90                          | 5.2                 | 4' ROUNDING         | -0.07                         | 1010.78               | 12.00               | 0.080               | 209+00.00                                 | 1009.82                | -0.082               | 15.16                | 1008.58                | 9.86               | 1009.01                  | -0.082               | 2.0                  | 1008.41                |                     |
| 1010.53                          | 5.2                 | 4' ROUNDING         | -0.51                         | 1010.41               | 12.00               | 0.080               | 209+25.00                                 | 1009.45                | -0.079               | 15.59                | 1008.21                | 9.65               | 1008.68                  | -0.079               | 2.0                  | 1008.05                |                     |
| 1010.30                          | 4.8                 | 4' ROUNDING         | 0.07                          | 1010.17               | 12.00               | 0.080               | 209+50.00                                 | 1009.21                | -0.077               | 16.02                | 1007.98                | 9.71               | 1008.46                  | -0.077               | 2.0                  | 1007.82                |                     |
| 1010.26                          | 4.6                 | 4' ROUNDING         | 0.43                          | 1010.13               | 12.00               | 0.080               | 209+56.95                                 | 1009.17                | -0.077               | 16.14                | 1007.93                | 9.99               | 1008.40                  | -0.077               | 2.0                  | 1007.78                | END FULL SUPER LT   |
| 1010.07                          | 4.3                 | 4' ROUNDING         | 1.47                          | 1009.95               | 12.00               | 0.075               | 209+75.00                                 | 1009.05                | -0.074               | 16.45                | 1007.83                | 10.53              | 1008.27                  | -0.074               | 2.0                  | 1007.69                |                     |
| 1009.97                          | 3.6                 | 0.068               | 1.76                          | 1009.73               | 12.00               | 0.068               | 210+00.00                                 | 1008.91                | -0.068               | 16.88                | 1007.75                | 11.17              | 1008.14                  | -0.068               | 2.0                  | 1007.61                |                     |
| 1009.64                          | 3.0                 | 0.062               | 3.32                          | 1009.46               | 12.00               | 0.062               | 210+25.00                                 | 1008.72                | -0.056               | 17.31                | 1007.75                | 10.29              | 1008.14                  | -0.056               | 2.0                  | 1007.64                |                     |
| 1009.11                          | 2.5                 | -0.015              | 4.33                          | 1009.14               | 12.00               | 0.055               | 210+50.00                                 | 1008.49                | -0.046               | 17.74                | 1007.67                | 10.79              | 1007.99                  | -0.046               | 2.0                  | 1007.58                |                     |
| 1008.78                          | 2.5                 | -0.022              | 5.82                          | 1008.83               | 12.00               | 0.048               | 210+75.00                                 | 1008.26                | -0.037               | 18.17                | 1007.58                | 11.20              | 1007.84                  | -0.040               | 2.0                  | 1007.50                |                     |
| 1008.68                          | 2.5                 | -0.024              | 5.79                          | 1008.74               | 12.00               | 0.046               | 210+81.95                                 | 1008.19                | -0.036               | 18.28                | 1007.53                | 11.26              | 1007.78                  | -0.040               | 2.0                  | 1007.45                | PT                  |
| 1008.44                          | 2.5                 | -0.028              | 5.92                          | 1008.51               | 12.00               | 0.042               | 211+00.00                                 | 1008.02                | -0.032               | 18.59                | 1007.42                | 11.35              | 1007.65                  | -0.040               | 2.0                  | 1007.34                |                     |
| 1008.06                          | 2.6                 | -0.035              | 6.01                          | 1008.15               | 12.00               | 0.035               | 211+25.00                                 | 1007.74                | -0.023               | 19.02                | 1007.30                | 11.14              | 1007.48                  | -0.040               | 2.0                  | 1007.22                |                     |
| 1007.73                          | 2.4                 | -0.040              | 6.51                          | 1007.82               | 12.00               | 0.028               | 211+50.00                                 | 1007.49                | -0.020               | 19.45                | 1007.10                | 11.31              | 1007.26                  | -0.040               | 2.0                  | 1007.02                |                     |
| 1007.41                          | 2.3                 | -0.040              | 6.71                          | 1007.50               | 12.00               | 0.021               | 211+75.00                                 | 1007.25                | -0.024               | 19.88                | 1006.76                | 11.35              | 1006.97                  | -0.040               | 2.0                  | 1006.68                |                     |
| 1007.12                          | 2.0                 | -0.040              | 6.67                          | 1007.20               | 12.00               | 0.015               | 212+00.00                                 | 1007.03                | -0.026               | 20.31                | 1006.50                | 11.70              | 1006.72                  | -0.040               | 2.0                  | 1006.42                |                     |
| 1006.80                          | 2.0                 | -0.040              | 5.36                          | 1006.88               | 12.00               | 0.008               | 212+25.00                                 | 1006.79                | -0.025               | 20.74                | 1006.26                | 11.67              | 1006.49                  | -0.040               | 2.0                  | 1006.18                |                     |
| 1006.48                          | 2.0                 | -0.040              | 4.54                          | 1006.56               | 12.00               | 0.001               | 212+50.00                                 | 1006.55                | -0.024               | 21.17                | 1006.05                | 11.68              | 1006.27                  | -0.040               | 2.0                  | 1005.97                |                     |
| 1006.13                          | 2.0                 | -0.040              | 3.86                          | 1006.21               | 12.00               | -0.006              | 212+75.00                                 | 1006.28                | -0.022               | 21.59                | 1005.81                | 11.73              | 1006.02                  | -0.040               | 2.0                  | 1005.73                |                     |
| 1005.79                          | 2.0                 | -0.040              | 2.55                          | 1005.87               | 12.00               | -0.012              | 213+00.00                                 | 1006.02                | -0.019               | 22.02                | 1005.80                | 11.61              | 1005.80                  | -0.040               | 2.0                  | 1005.72                |                     |
| 1005.44                          | 2.0                 | -0.040              | 0.33                          | 1005.52               | 12.00               | -0.019              | 213+25.00                                 | 1005.75                | -0.014               | 22.45                | 1005.43                | 11.69              | 1005.58                  | -0.040               | 2.0                  | 1005.35                |                     |
| 1005.15                          | 2.0                 | -0.040              | 0.00                          | 1005.23               | 12.00               | -0.026              | 213+50.00                                 | 1005.54                | -0.016               | 22.88                | 1005.17                | 11.52              | 1005.35                  | -0.040               | 2.0                  | 1005.09                | MATCH EXISTING      |

NOTES:

THE SUPERELEVATION CORRECTION FOR THE S.R. 13 CURVE AT DAWES ARBORETUM SHALL BE DONE BY PAVEMENT PLANING AND VARIABLE DEPTH ASPHALT PAVEMENT. THE CONTRACTOR SHALL COME AS CLOSE AS POSSIBLE TO MEETING THE ELEVATIONS IN THE TABLE ABOVE.

THE RIGHT SIDE OF TABLE WAS CALCULATED FROM THE PART 3 DAWES ARBORETUM TURN LANE WIDENING.

THE STATIONING IN THE TABLE ABOVE REFLECTS APPROXIMATE SLM 3.87-4.04.

THE PROPOSED PROFILE GRADE IS APPROXIMATELY 1.5" BELOW THE EXISTING PROFILE GRADE

CALCULATED  
JSL

CHECKED  
JSL

SUPERELEVATION DATA - S.R. 13 CURVE AT DAWES

LIC-13-0.00

12  
90




| PAVEMENT DATA                               |        |         |---------------------------------------------|--------|---------|---------------------|-------------------|---------|----------|-----------------------|---------|---------------|---------------------------|-------------------------------------------|-------------------------------------------|------------------------------------------|-----------------------------------------|---------------|-----------------------------------------------------|---------------|-----------------------------------------------------------|---------------------------------|---------------------------------------------|---------|
| LOCATION                                    | COUNTY | ROUTE   | BEGIN LOG POINT SLM | END LOG POINT SLM | LENGTH  |          | PAVEMENT WIDTH (FEET) | TYPICAL | PAVEMENT AREA | 254                       |                                           |                                           |                                          | 407                                     |               | 441                                                 |               |                                                           |                                 | 614                                         |         |
|                                             |        |         |                     |                   |         |          |                       |         |               | DEPTH OF PAVEMENT PLANING | PAVEMENT PLANING, ASPHALT CONCRETE, 1.50" | PAVEMENT PLANING, ASPHALT CONCRETE, 3.25" | NON-TRACKING TACK COAT @ 0.075 GAL./S.Y. | NON-TRACKING TACK COAT @ 0.05 GAL./S.Y. | S U R F A C E | ASPHALT CONCRETE INTERMEDIATE COURSE, TYPE 2, (448) | S U R F A C E | ASPHALT CONCRETE SURFACE COURSE, TYPE 1, (448), PG 70-22M | WORK ZONE CENTER LINE, CLASS II | WORK ZONE CENTER LINE, CLASS III, 642 PAINT |         |
|                                             |        |         |                     |                   | SQ. YD. | INCHES   |                       |         |               |                           |                                           |                                           |                                          |                                         |               |                                                     |               |                                                           |                                 |                                             | SQ. YD. |
|                                             |        | LOCATION 1A TOTALS (CARRIED TO SUB-SUMMARY) |        |         |                     |                   |         |          |                       |         |               |                           | 8,729.6                                   |                                           | 654.7                                    |                                         |               |                                                     |               | 363.7                                                     |                                 | 0.54                                        |         |
|                                             |        | 1B                                          | LIC    | S.R. 13 | 0.54                | 1.15              | 0.61    | 3,220.8  | 24.0                  | 1       | 8,588.8       | 1.50                      | 8,588.8                                   |                                           | 644.2                                    |                                         |               |                                                     | 1.50          | 357.9                                                     |                                 | 0.61                                        |         |
| 1B                                          | LIC    | S.R. 13 | 1.15                | 1.23              | 0.08    | 422.4    | 30.0 AVG              | 2       | 1,408.0       | 1.50                      | 1,408.0                                   |                                           | 105.6                                    |                                         |               |                                                     | 1.50          | 58.7                                                      |                                 | 0.08                                        |         |
| 1B                                          | LIC    | S.R. 13 | 1.23                | 1.28              | 0.05    | 264.0    | 36.0                  | 2       | 1,056.0       | 1.50                      | 1,056.0                                   |                                           | 79.2                                     |                                         |               |                                                     | 1.50          | 44.0                                                      |                                 | 0.05                                        |         |
| 1B                                          | LIC    | S.R. 13 | 1.28                | 1.39              | 0.11    | 580.8    | 36.0                  | 3       | 2,323.2       | 1.50                      | 2,323.2                                   |                                           | 174.2                                    |                                         |               |                                                     | 1.50          | 96.8                                                      |                                 | 0.11                                        |         |
| 1B                                          | LIC    | S.R. 13 | 1.39                | 1.41              | 0.02    | 105.6    | 36.0                  | 1       | 422.4         | 1.50                      | 422.4                                     |                                           | 31.7                                     |                                         |               |                                                     | 1.50          | 17.6                                                      |                                 | 0.02                                        |         |
| 1B                                          | LIC    | S.R. 13 | 1.41                | 1.46              | 0.05    | 264.0    | 48.0 AVG              | 1       | 1,408.0       | 1.50                      | 1,408.0                                   |                                           | 105.6                                    |                                         |               |                                                     | 1.50          | 58.7                                                      |                                 | 0.05                                        |         |
| 1B                                          | LIC    | S.R. 13 | 1.46                | 1.75              | 0.29    | 1,531.2  | 60.0                  | 1       | 10,208.0      | 1.50                      | 10,208.0                                  |                                           | 765.6                                    |                                         |               |                                                     | 1.50          | 425.3                                                     |                                 | 0.29                                        |         |
| 1B                                          | LIC    | S.R. 13 | 1.75                | 1.87              | 0.12    | 633.6    | 48.0 AVG              | 1       | 3,379.2       | 1.50                      | 3,379.2                                   |                                           | 253.4                                    |                                         |               |                                                     | 1.50          | 140.8                                                     |                                 | 0.12                                        |         |
| 1B                                          | LIC    | S.R. 13 | 1.87                | 2.12              | 0.25    | 1,320.0  | 36.0                  | 1       | 5,280.0       | 1.50                      | 5,280.0                                   |                                           | 396.0                                    |                                         |               |                                                     | 1.50          | 220.0                                                     |                                 | 0.25                                        |         |
| 1B                                          | LIC    | S.R. 13 | 2.12                | 2.18              | 0.06    | 316.8    | 48.0                  | 1       | 1,689.6       | 1.50                      | 1,689.6                                   |                                           | 126.7                                    |                                         |               |                                                     | 1.50          | 70.4                                                      |                                 | 0.06                                        |         |
| 1B                                          | LIC    | S.R. 13 | 2.18                | 2.31              | 0.13    | 686.4    | 30.0 AVG              | 1       | 2,288.0       | 1.50                      | 2,288.0                                   |                                           | 171.6                                    |                                         |               |                                                     | 1.50          | 95.3                                                      |                                 | 0.13                                        |         |
| 1B                                          | LIC    | S.R. 13 | 2.31                | 2.64              | 0.33    | 1,742.4  | 24.0                  | 1       | 4,646.4       | 1.50                      | 4,646.4                                   |                                           | 348.5                                    |                                         |               |                                                     | 1.50          | 193.6                                                     |                                 | 0.33                                        |         |
| 1B                                          | LIC    | S.R. 13 | 2.64                | 2.81              | 0.17    | 897.6    | 24.0                  | 2       | 2,393.6       | 3.25                      |                                           | 2,393.6                                   | 179.5                                    | 119.7                                   | 1.75          | 116.4                                               | 1.50          | 99.7                                                      | 0.17                            | 0.17                                        |         |
| 1B                                          | LIC    | S.R. 13 | 2.81                | 3.87              | 1.06    | 5,596.8  | 24.0                  | 1       | 14,924.8      | 1.50                      | 14,924.8                                  |                                           | 1,119.4                                  |                                         |               |                                                     | 1.50          | 621.9                                                     |                                 | 1.06                                        |         |
| 1B                                          | LIC    | S.R. 13 | 3.87                | 4.04              | 0.17    | 897.6    | 30.0 AVG              | 1       | 2,992.0       | VAR                       |                                           | 2,992.0                                   | 224.4                                    | 149.6                                   | 4.25 AVG      | 353.3                                               | 1.50          | 124.7                                                     | 0.17                            | 0.17                                        |         |
| 1B                                          | LIC    | S.R. 13 | 4.04                | 4.10              | 0.06    | 316.8    | 36.0                  | 1       | 1,267.2       | 3.25                      |                                           | 1,267.2                                   | 95.0                                     | 63.4                                    | 1.75          | 61.6                                                | 1.50          | 52.8                                                      | 0.06                            | 0.06                                        |         |
| 1B                                          | LIC    | S.R. 13 | 4.10                | 4.24              | 0.14    | 739.2    | 30.0 AVG              | 1       | 2,464.0       | 3.25                      |                                           | 2,464.0                                   | 184.8                                    | 123.2                                   | 1.75          | 119.8                                               | 1.50          | 102.7                                                     | 0.14                            | 0.14                                        |         |
| 1B                                          | LIC    | S.R. 13 | 4.24                | 6.30              | 2.06    | 10,876.8 | 24.0                  | 1       | 29,004.8      | 1.50                      | 29,004.8                                  |                                           | 2,175.4                                  |                                         |               |                                                     | 1.50          | 1,208.5                                                   |                                 | 2.06                                        |         |
| 1B                                          | LIC    | S.R. 13 | 6.30                | 6.36              | 0.06    | 316.8    | 30.0 AVG              | 1       | 1,056.0       | 1.50                      | 1,056.0                                   |                                           | 79.2                                     |                                         |               |                                                     | 1.50          | 44.0                                                      |                                 | 0.06                                        |         |
| 1B                                          | LIC    | S.R. 13 | 6.36                | 6.48              | 0.12    | 633.6    | 36.0                  | 1       | 2,534.4       | 1.50                      | 2,534.4                                   |                                           | 190.1                                    |                                         |               |                                                     | 1.50          | 105.6                                                     |                                 | 0.12                                        |         |
|                                             |        | BRIDGE DEDUCTIONS                           |        |         |                     |                   |         |          |                       |         | (352.0)       |                           | (352.0)                                   |                                           | (26.4)                                   |                                         |               |                                                     | 1.50          | (14.7)                                                    |                                 | (0.03)                                      |         |
|                                             |        | SUB-TOTALS                                  |        |         |                     |                   |         |          |                       |         |               |                           |                                           |                                           | 7,423.7                                  | 455.9                                   |               |                                                     |               |                                                           |                                 |                                             |         |
| LOCATION 1B TOTALS (CARRIED TO SUB-SUMMARY) |        |         |                     |                   |         |          |                       |         |               |                           | 89,865.6                                  | 9,116.8                                   | 7,879.6                                  |                                         |               | 651.1                                               |               | 4,124.3                                                   | 0.54                            | 5.91                                        |         |
|                                             |        | 1C                                          | LIC    | S.R. 13 | 6.48                | 6.56              | 0.08    | 422.4    | 36.0                  | 1       | 1,689.6       | 1.50                      | 1,689.6                                   |                                           | 126.7                                    |                                         |               |                                                     | 1.50          | 70.4                                                      |                                 | 0.08                                        |         |
| 1C                                          | LIC    | S.R. 13 | 6.56                | 6.64              | 0.08    | 422.4    | 30.0 AVG              | 1       | 1,408.0       | 1.50                      | 1,408.0                                   |                                           | 105.6                                    |                                         |               |                                                     | 1.50          | 58.7                                                      |                                 | 0.08                                        |         |
| 1C                                          | LIC    | S.R. 13 | 6.64                | 7.76              | 1.12    | 5,913.6  | 24.0                  | 1       | 15,769.6      | 1.50                      | 15,769.6                                  |                                           | 1,182.7                                  |                                         |               |                                                     | 1.50          | 657.1                                                     |                                 | 1.12                                        |         |
|                                             |        | LOCATION 1C TOTALS (CARRIED TO SUB-SUMMARY) |        |         |                     |                   |         |          |                       |         |               |                           | 18,867.2                                  |                                           | 1,415.0                                  |                                         |               |                                                     |               | 786.2                                                     |                                 | 1.28                                        |         |
|                                             |        | 1D                                          | LIC    | S.R. 13 | 7.76                | 8.15              | 0.39    | 2,059.2  | 24.0                  | 1       | 5,491.2       | 1.50                      | 5,491.2                                   |                                           | 411.8                                    |                                         |               |                                                     | 1.50          | 228.8                                                     |                                 | 0.39                                        |         |
| 1D                                          | LIC    | S.R. 13 | 8.15                | 8.20              | 0.05    | 264.0    | 30.0 AVG              | 1       | 880.0         | 3.25                      |                                           | 880.0                                     | 66.0                                     | 44.0                                    | 1.75          | 42.8                                                | 1.50          | 36.7                                                      | 0.05                            | 0.05                                        |         |
| 1D                                          | LIC    | S.R. 13 | 8.20                | 8.26              | 0.06    | 316.8    | 36.0                  | 1       | 1,267.2       | 3.25                      |                                           | 1,267.2                                   | 95.0                                     | 63.4                                    | 1.75          | 61.6                                                | 1.50          | 52.8                                                      | 0.06                            | 0.06                                        |         |
| 1D                                          | LIC    | S.R. 13 | 8.26                | 8.30              | 0.04    | 211.2    | 30.0 AVG              | 1       | 704.0         | 3.25                      |                                           | 704.0                                     | 52.8                                     | 35.2                                    | 1.75          | 34.3                                                | 1.50          | 29.3                                                      | 0.04                            | 0.04                                        |         |
| 1D                                          | LIC    | S.R. 13 | 8.30                | 8.37              | 0.07    | 369.6    | 24.0                  | 1       | 985.6         | 1.50                      | 985.6                                     |                                           | 73.9                                     |                                         |               |                                                     | 1.50          | 41.1                                                      |                                 | 0.07                                        |         |
|                                             |        | SUB-TOTALS                                  |        |         |                     |                   |         |          |                       |         |               |                           |                                           |                                           | 699.5                                    | 142.6                                   |               |                                                     |               |                                                           |                                 |                                             |         |
| LOCATION 1D TOTALS (CARRIED TO SUB-SUMMARY) |        |         |                     |                   |         |          |                       |         |               |                           | 6,476.8                                   | 2,851.2                                   | 842.1                                    |                                         |               | 138.7                                               |               | 388.7                                                     | 0.15                            | 0.61                                        |         |







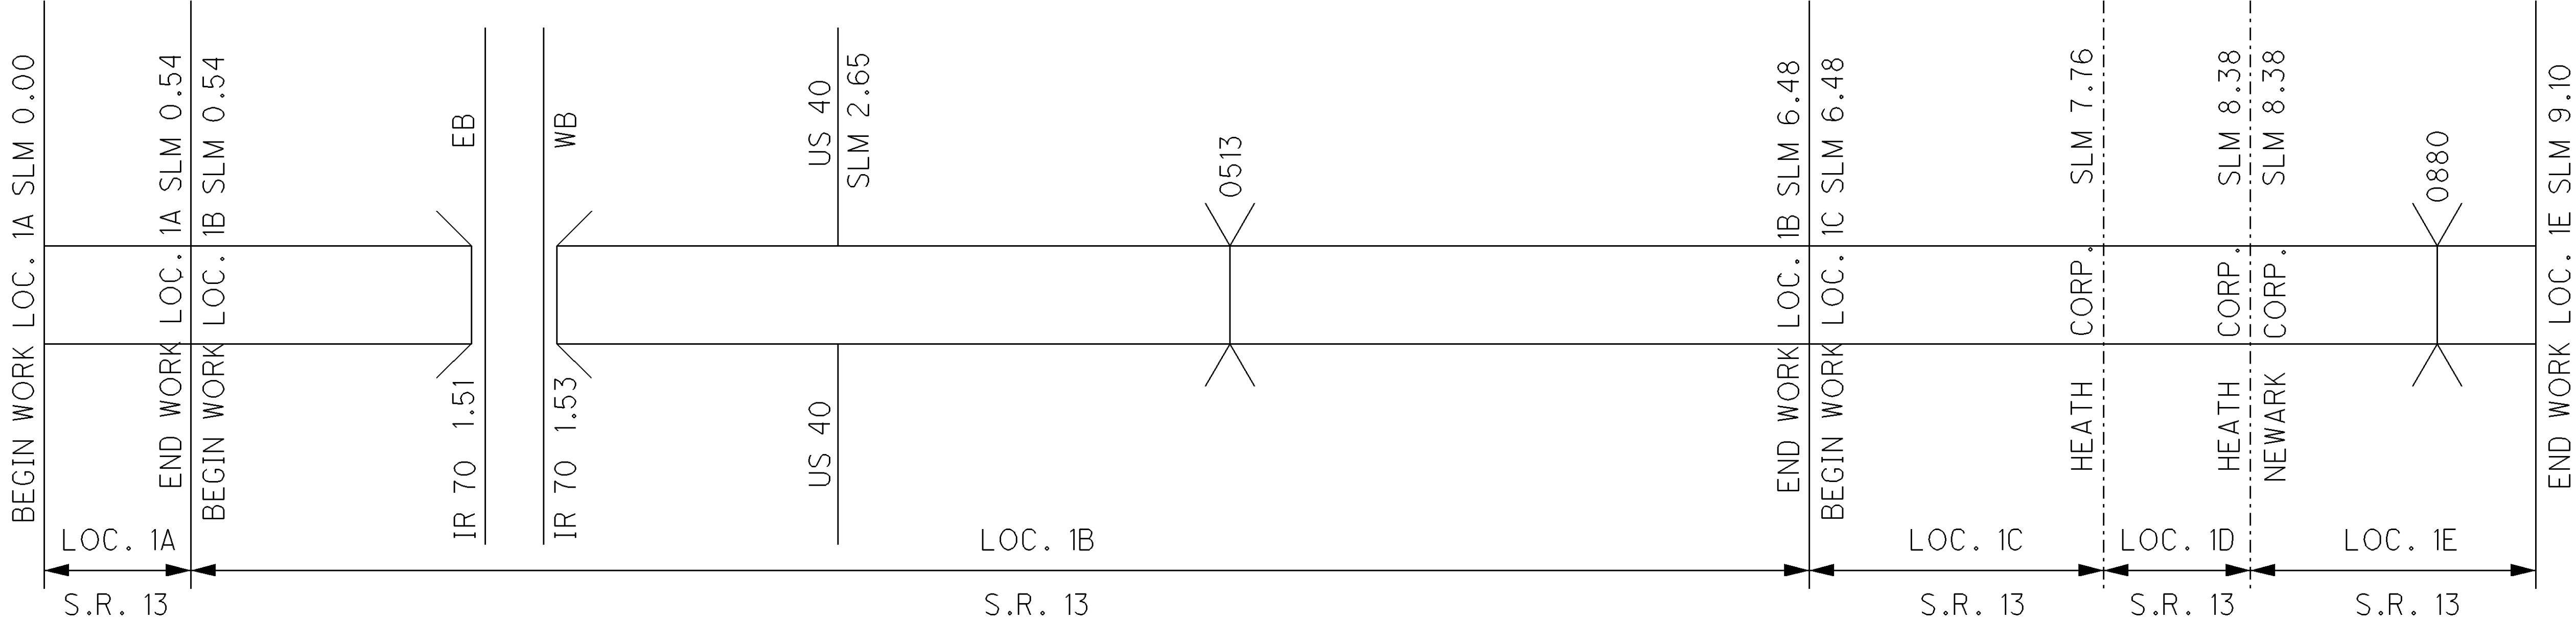


STRAIGHT LINE DIAGRAMS




PW = PAVEMENT WIDTH  
PS = PAVED SHOULDER  
AS = AGGREGATE SHOULDER


TYPICAL 1

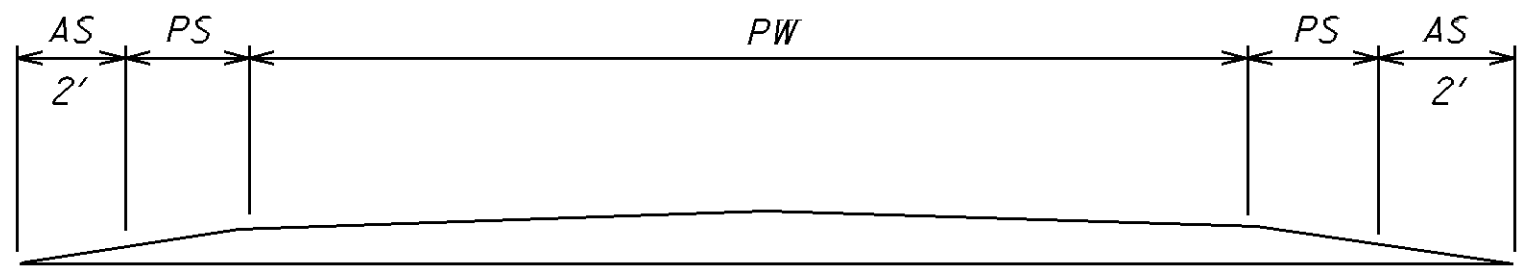

TYPICAL 2

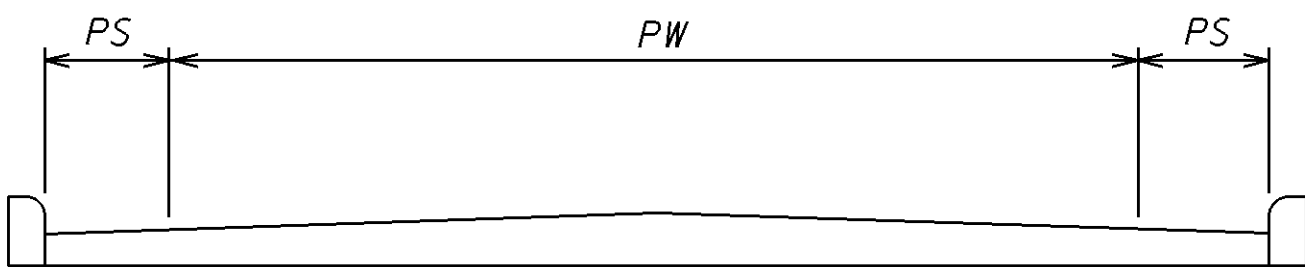

TYPICAL 3

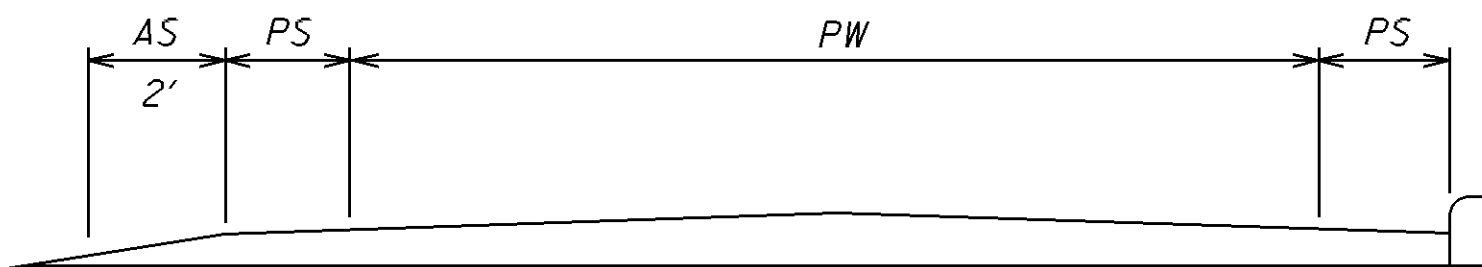

| SHOULDER DATA                               |                   |         |---------------------------------------------|-------------------|---------|---------------------|-------------------|--------|----------|---------|-----------------------------------------------------------------------|----|---------------|-----------------------------------------------------|---------------------------|------------------------------------------|-------------------------------------------|------------------------------------------|-----------------------------------------|-------------------------|-----------|-----------------------------------------------------|-----------|-----------------------------------------------------------|-----------|---------------------------------------------|----------------------|---------|
| LOCATION                                    | COUNTY            | ROUTE   | BEGIN LOG POINT SLM | END LOG POINT SLM | LENGTH |          | TYPICAL | PROPOSED SHOULDER WMDTH (FT.) (WIDTHS ARE AVERAGE THROUGHOUT SECTION) |    | SHOULDER AREA | 209                                                 | 254                       |                                          |                                           |                                          | 407                                     |                         | 408       | 441                                                 |           |                                                           |           | 617                                         |                      |         |
|                                             |                   |         |                     |                   |        |          |         |                                                                       |    |               | PREPARING SUBGRADE FOR SHOULDER PAVING, AS PER PLAN | DEPTH OF PAVEMENT PLANING | PAVEMENT PLANING, ASPHALT CONCRETE, 1.5" | PAVEMENT PLANING, ASPHALT CONCRETE, 3.25" | NON-TRACKING TACK COAT @ 0.075 GAL./S.Y. | NON-TRACKING TACK COAT @ 0.05 GAL./S.Y. | PRIME COAT, AS PER PLAN | THICKNESS | ASPHALT CONCRETE INTERMEDIATE COURSE, TYPE 2, (448) | THICKNESS | ASPHALT CONCRETE SURFACE COURSE, TYPE 1, (448), PG 70-22M | THICKNESS | COMPACTED AGGREGATE, AS PER PLAN (2' WIDTH) | SHOULDER PREPARATION |         |
|                                             |                   |         |                     |                   | MILES  | LIN. FT. |         | A                                                                     | B  |               | SQ. YD.                                             | MILE                      | INCHES                                   | SQ. YD.                                   | SQ. YD.                                  | GAL.                                    | GAL.                    | GAL.      | INCHES                                              | CU. YD.   | INCHES                                                    | CU. YD.   | INCHES                                      | CU. YD.              | SQ. YD. |
|                                             |                   | 1A                                          | LIC               | S.R. 13 | 0.00                | 0.54              | 0.54   | 2851.2   | 1       | 3                                                                     | 3  | 1,900.8       | 1.08                                                | 1.50                      | 1900.8                                   |                                           | 142.6                                    |                                         | 506.9                   |           |                                                     | 1.50      | 79.2                                                      | 2.00      | 70.4                                        | 1,267.2              |         |
|                                             |                   | LOCATION 1A TOTALS (CARRIED TO SUB-SUMMARY) |                   |         |                     |                   |        |          |         |                                                                       |    |               | 1.08                                                |                           | 1900.8                                   |                                           | 142.6                                    |                                         | 506.9                   |           |                                                     | 79.2      |                                                           | 70.4      | 1267.2                                      |                      |         |
|                                             |                   | 1B                                          | LIC               | S.R. 13 | 0.54                | 1.15              | 0.61   | 3220.8   | 1       | 3                                                                     | 3  | 2,147.2       | 1.22                                                | 1.50                      | 2147.2                                   |                                           | 161.0                                    |                                         | 572.6                   |           |                                                     | 1.50      | 89.5                                                      | 2.00      | 79.5                                        | 1,431.5              |         |
| 1B                                          | LIC               | S.R. 13 | 1.15                | 1.28              | 0.13   | 686.4    | 2       | 4                                                                     | 4  | 610.1         | 0.26                                                | 1.50                      | 610.1                                    |                                           | 45.8                                     |                                         | 122.0                   |           |                                                     | 1.50      | 25.4                                                      | 2.00      | 16.9                                        | 305.1                |         |
| 1B                                          | LIC               | S.R. 13 | 1.28                | 1.39              | 0.11   | 580.8    | 3       | 4                                                                     | 4  | 516.3         | 0.22                                                | 1.50                      | 516.3                                    |                                           | 38.7                                     |                                         | 103.2                   |           |                                                     | 1.50      | 21.5                                                      | 2.00      | 14.3                                        | 258.1                |         |
| 1B                                          | LIC               | S.R. 13 | 1.39                | 1.46              | 0.07   | 369.6    | 1       | 4                                                                     | 4  | 328.5         | 0.14                                                | 1.50                      | 328.5                                    |                                           | 24.6                                     |                                         | 65.7                    |           |                                                     | 1.50      | 13.7                                                      | 2.00      | 9.1                                         | 164.3                |         |
| 1B                                          | LIC               | S.R. 13 | 1.46                | 2.28              | 0.82   | 4329.6   | 1       | 6                                                                     | 6  | 5,772.8       | 1.64                                                | 1.50                      | 5772.8                                   |                                           | 433.0                                    |                                         | 769.7                   |           |                                                     | 1.50      | 240.5                                                     | 2.00      | 106.9                                       | 1,924.3              |         |
| 1B                                          | LIC               | S.R. 13 | 2.28                | 2.64              | 0.36   | 1900.8   | 1       | 3                                                                     | 3  | 1,267.2       | 0.72                                                | 1.50                      | 1267.2                                   |                                           | 95.0                                     |                                         | 337.9                   |           |                                                     | 1.50      | 52.8                                                      | 2.00      | 46.9                                        | 844.8                |         |
| 1B                                          | LIC               | S.R. 13 | 2.64                | 2.81              | 0.17   | 897.6    | 2       | 3                                                                     | 3  | 598.4         | 0.34                                                | 3.25                      |                                          | 598.4                                     | 44.9                                     | 29.9                                    | 159.6                   | 1.75      | 29.1                                                | 1.50      | 24.9                                                      | 2.00      | 22.2                                        | 398.9                |         |
| 1B                                          | LIC               | S.R. 13 | 2.81                | 3.26              | 0.45   | 2376.0   | 1       | 3                                                                     | 3  | 1,584.0       | 0.90                                                | 1.50                      | 1584.0                                   |                                           | 118.8                                    |                                         | 422.4                   |           |                                                     | 1.50      | 66.0                                                      | 2.00      | 58.7                                        | 1,056.0              |         |
| 1B                                          | LIC               | S.R. 13 | 3.26                | 3.87              | 0.61   | 3220.8   | 1       | 2                                                                     | 2  | 1,431.5       | 1.22                                                | 1.50                      | 1431.5                                   |                                           | 107.4                                    |                                         | 572.6                   |           |                                                     | 1.50      | 59.6                                                      | 2.00      | 79.5                                        | 1,431.5              |         |
| 1B                                          | LIC               | S.R. 13 | 3.87                | 4.04              | 0.17   | 897.6    | 1       | 2                                                                     | 2  | 398.9         | 0.34                                                | VAR                       |                                          | 398.9                                     | 29.9                                     | 19.9                                    | 159.6                   | 1.75 AVG  | 19.4                                                | 1.50      | 16.6                                                      | 2.00      | 22.2                                        | 398.9                |         |
| 1B                                          | LIC               | S.R. 13 | 4.04                | 4.24              | 0.20   | 1056.0   | 1       | 2                                                                     | 2  | 469.3         | 0.40                                                | 3.25                      |                                          | 469.3                                     | 35.2                                     | 23.5                                    | 187.7                   | 1.75      | 22.8                                                | 1.50      | 19.6                                                      | 2.00      | 26.1                                        | 469.3                |         |
| 1B                                          | LIC               | S.R. 13 | 4.24                | 5.07              | 0.83   | 4382.4   | 1       | 2                                                                     | 2  | 1,947.7       | 1.66                                                | 1.50                      | 1947.7                                   |                                           | 146.1                                    |                                         | 779.1                   |           |                                                     | 1.50      | 81.2                                                      | 2.00      | 108.2                                       | 1,947.7              |         |
| 1B                                          | LIC               | S.R. 13 | 5.07                | 5.18              | 0.11   | 580.8    | 1       | 8                                                                     | 8  | 1,032.5       | 0.22                                                | 1.50                      | 1032.5                                   |                                           | 77.4                                     |                                         | 103.2                   |           |                                                     | 1.50      | 43.0                                                      | 2.00      | 14.3                                        | 258.1                |         |
| 1B                                          | LIC               | S.R. 13 | 5.18                | 6.23              | 1.05   | 5544.0   | 1       | 2                                                                     | 2  | 2,464.0       | 2.10                                                | 1.50                      | 2464.0                                   |                                           | 184.8                                    |                                         | 985.6                   |           |                                                     | 1.50      | 102.7                                                     | 2.00      | 136.9                                       | 2,464.0              |         |
| 1B                                          | LIC               | S.R. 13 | 6.23                | 6.48              | 0.25   | 1320.0   | 1       | 10                                                                    | 10 | 2,933.3       | 0.50                                                | 1.50                      | 2933.3                                   |                                           | 220.0                                    |                                         | 234.7                   |           |                                                     | 1.50      | 122.2                                                     | 2.00      | 32.6                                        | 586.7                |         |
|                                             |                   |                                             | BRIDGE DEDUCTIONS |         |                     |                   |        |          |         |                                                                       |    | (234.7)       | (0.10)                                              |                           | (234.7)                                  |                                           | (17.6)                                   |                                         | (93.9)                  |           |                                                     | 1.50      | (9.78)                                                    | 2.00      | (13.0)                                      | (234.7)              |         |
|                                             |                   | SUB-TOTALS                                  |                   |         |                     |                   |        |          |         |                                                                       |    |               |                                                     |                           |                                          |                                           |                                          | 1745.0                                  | 73.3                    |           |                                                     |           |                                                           |           |                                             |                      |         |
| LOCATION 1B TOTALS (CARRIED TO SUB-SUMMARY) |                   |         |                     |                   |        |          |         |                                                                       |    |               | 11.78                                               |                           | 21800.4                                  | 1466.6                                    | 1818.3                                   |                                         | 5481.7                  |           | 71.3                                                |           | 969.4                                                     |           | 761.3                                       | 13704.5              |         |
|                                             |                   | 1C                                          | LIC               | S.R. 13 | 6.48                | 6.68              | 0.20   | 1056.0   | 1       | 10                                                                    | 10 | 2,346.7       | 0.40                                                | 1.50                      | 2346.7                                   |                                           | 176.0                                    |                                         | 187.7                   |           |                                                     | 1.50      | 97.8                                                      | 2.00      | 26.1                                        | 469.3                |         |
| 1C                                          | LIC               | S.R. 13 | 6.68                | 7.76              | 1.08   | 5702.4   | 1       | 2                                                                     | 2  | 2,534.4       | 2.16                                                | 1.50                      | 2534.4                                   |                                           | 190.1                                    |                                         | 1,013.8                 |           |                                                     | 1.50      | 105.6                                                     | 2.00      | 140.8                                       | 2,534.4              |         |
|                                             |                   | LOCATION 1C TOTALS (CARRIED TO SUB-SUMMARY) |                   |         |                     |                   |        |          |         |                                                                       |    |               | 2.56                                                |                           | 4881.1                                   |                                           | 366.1                                    |                                         | 1201.5                  |           |                                                     |           | 203.4                                                     |           | 166.9                                       | 3003.7               |         |
|                                             |                   | 1D                                          | LIC               | S.R. 13 | 7.76                | 8.15              | 0.39   | 2059.2   | 1       | 2                                                                     | 2  | 915.2         | 0.78                                                | 1.50                      | 915.2                                    |                                           | 68.6                                     |                                         | 366.1                   |           |                                                     | 1.50      | 38.1                                                      | 2.00      | 50.8                                        | 915.2                |         |
| 1D                                          | LIC               | S.R. 13 | 8.15                | 8.30              | 0.15   | 792.0    | 1       | 2                                                                     | 2  | 352.0         | 0.30                                                | 3.25                      |                                          | 352.0                                     | 26.4                                     | 17.6                                    | 140.8                   | 1.75      | 17.1                                                | 1.50      | 14.7                                                      | 2.00      | 19.6                                        | 352.0                |         |
| 1D                                          | LIC               | S.R. 13 | 8.30                | 8.37              | 0.07   | 369.6    | 1       | 2                                                                     | 2  | 164.3         | 0.14                                                | 1.50                      | 164.3                                    |                                           | 12.3                                     |                                         | 65.7                    |           |                                                     | 1.50      | 6.8                                                       | 2.00      | 9.1                                         | 164.3                |         |
|                                             |                   | SUB-TOTALS                                  |                   |         |                     |                   |        |          |         |                                                                       |    |               |                                                     |                           |                                          |                                           |                                          | 107.3                                   | 17.6                    |           |                                                     |           |                                                           |           |                                             |                      |         |
| LOCATION 1D TOTALS (CARRIED TO SUB-SUMMARY) |                   |         |                     |                   |        |          |         |                                                                       |    |               | 1.22                                                |                           | 1079.5                                   | 352.0                                     | 124.9                                    |                                         | 572.6                   |           | 17.1                                                |           | 59.6                                                      |           | 79.5                                        | 1,431.5              |         |

CALCULATED  
LME  
CHECKED  
JSL

SHOULDER DATA


LIC-13-0.00




| EXTRA AREAS                                 |        |         |      |                            |                           |                                                |                                               |         |           |                                                           |           |                                                                |         |        |         |
|---------------------------------------------|--------|---------|------|----------------------------|---------------------------|------------------------------------------------|-----------------------------------------------|---------|-----------|-----------------------------------------------------------|-----------|----------------------------------------------------------------|---------|--------|---------|
| LOCATION                                    | COUNTY | ROUTE   | SIDE | DESCRIPTION                | INTERSECTIONS DIMENSIONS  |                                                |                                               | AREA    | 202       | 407                                                       |           | 441                                                            |         |        |         |
|                                             |        |         |      |                            | WEARING COURSE<br>REMOVED | NON-TRACKING<br>TACK COAT @ 0.075<br>GAL./S.Y. | NON-TRACKING<br>TACK COAT<br>@ 0.05 GAL./S.Y. |         | THICKNESS | ASPHALT CONCRETE<br>INTERMEDIATE COURSE,<br>TYPE 2, (448) | THICKNESS | ASPHALT CONCRETE<br>SURFACE COURSE,<br>TYPE 1, (448), PG 64-22 |         |        |         |
|                                             |        |         |      |                            |                           |                                                |                                               |         |           |                                                           |           |                                                                | A       | B      | C       |
|                                             |        |         |      |                            | FT.                       | FT.                                            | FT.                                           | SQ. YD. | SQ. YD.   | GAL.                                                      | GAL.      | INCHES                                                         | CU. YD. | INCHES | CU. YD. |
|                                             |        |         |      |                            |                           |                                                |                                               |         |           |                                                           |           |                                                                |         |        |         |
| 1A                                          | LIC    | S.R. 13 | RT   | BOUNDARIES RD (CR 9)       | 50                        | 35                                             | 113                                           | 411.2   | 411.2     | 30.9                                                      |           |                                                                |         | 1.50   | 17.2    |
| 1A                                          | LIC    | S.R. 13 | LT   | LAKE SHORE BLVD (TWP 196)  | 23                        | 21                                             | 58                                            | 101.0   | 101.0     | 7.6                                                       |           |                                                                |         | 1.50   | 4.3     |
| 1A                                          | LIC    | S.R. 13 | LT   | PARK DRIVE (TWP 197)       | 25                        | 16                                             | 61                                            | 107.0   | 107.0     | 8.1                                                       |           |                                                                |         | 1.50   | 4.5     |
| 1A                                          | LIC    | S.R. 13 | LT   | MAPLE AVE (TWP 433)        | 19                        | 19                                             | 55                                            | 78.2    | 78.2      | 5.9                                                       |           |                                                                |         | 1.50   | 3.3     |
| 1A                                          | LIC    | S.R. 13 | LT   | MILLER AVE                 | 20                        | 11                                             | 39                                            | 55.6    | 55.6      | 4.2                                                       |           |                                                                |         | 1.50   | 2.4     |
| 1A                                          | LIC    | S.R. 13 | LT   | EDGEWATER (TWP 196)        | 22                        | 20                                             | 58                                            | 95.4    | 95.4      | 7.2                                                       |           |                                                                |         | 1.50   | 4.0     |
| 1A                                          | LIC    | S.R. 13 | LT   | CRISTLAND HILL RD (CR 596) | 41                        | 25                                             | 79                                            | 236.9   | 236.9     | 17.8                                                      |           |                                                                |         | 1.50   | 9.9     |
|                                             |        |         |      |                            |                           |                                                |                                               |         |           |                                                           |           |                                                                |         |        |         |
| LOCATION 1A TOTALS (CARRIED TO SUB-SUMMARY) |        |         |      |                            |                           |                                                |                                               |         | 1,085.3   | 81.7                                                      |           |                                                                |         |        | 45.6    |
|                                             |        |         |      |                            |                           |                                                |                                               |         |           |                                                           |           |                                                                |         |        |         |
| 1B                                          | LIC    | S.R. 13 | RT   | KINDLE RD (TWP 325)        | 15                        | 21                                             | 46                                            | 55.9    | 55.9      | 4.2                                                       |           |                                                                |         | 1.50   | 2.4     |
| 1B                                          | LIC    | S.R. 13 | LT   | SOUTH ST                   | 15                        | 21                                             | 46                                            | 55.9    | 55.9      | 4.2                                                       |           |                                                                |         | 1.50   | 2.4     |
| 1B                                          | LIC    | S.R. 13 | LT   | SECOND ST                  | 21                        | 17                                             | 42                                            | 68.9    | 68.9      | 5.2                                                       |           |                                                                |         | 1.50   | 2.9     |
| 1B                                          | LIC    | S.R. 13 | LT   | US 40 (WEST SIDE)          | 32                        | 28                                             | 84                                            | 199.2   | 199.2     | 15.0                                                      | 10.0      | 1.75                                                           | 9.7     | 1.50   | 8.3     |
| 1B                                          | LIC    | S.R. 13 | RT   | US 40 (EAST SIDE)          | 50                        | 38                                             | 100                                           | 383.4   | 383.4     | 28.8                                                      | 19.2      | 1.75                                                           | 18.7    | 1.50   | 16.0    |
| 1B                                          | LIC    | S.R. 13 | LT   | STADDEN ALLEY              | 10                        | 12                                             | 20                                            | 17.8    | 17.8      | 1.4                                                       |           |                                                                |         | 1.50   | 0.8     |
| 1B                                          | LIC    | S.R. 13 | LT   | LARASON AVE                | 24                        | 12                                             | 42                                            | 72.0    | 72.0      | 5.4                                                       |           |                                                                |         | 1.50   | 3.0     |
| 1B                                          | LIC    | S.R. 13 | LT   | NORTH AVE                  | 31                        | 15                                             | 52                                            | 115.4   | 115.4     | 8.7                                                       |           |                                                                |         | 1.50   | 4.9     |
| 1B                                          | LIC    | S.R. 13 | LT   | COOPER RD                  | 32                        | 18                                             | 49                                            | 119.2   | 119.2     | 9.0                                                       |           |                                                                |         | 1.50   | 5.0     |
| 1B                                          | LIC    | S.R. 13 | LT   | RIDGELY TRACT RD (TWP 308) | 24                        | 11                                             | 30                                            | 54.7    | 54.7      | 4.2                                                       |           |                                                                |         | 1.50   | 2.3     |
| 1B                                          | LIC    | S.R. 13 | RT   | ONE MILE RD                | 22                        | 20                                             | 42                                            | 75.8    | 75.8      | 5.7                                                       |           |                                                                |         | 1.50   | 3.2     |
| 1B                                          | LIC    | S.R. 13 | RT   | WOODLAND DRIVE             | 19                        | 34                                             | 43                                            | 81.3    | 81.3      | 6.1                                                       |           |                                                                |         | 1.50   | 3.4     |
| 1B                                          | LIC    | S.R. 13 | RT   | HUPP RD (TWP 309)          | 35                        | 17                                             | 71                                            | 171.2   | 171.2     | 12.9                                                      |           |                                                                |         | 1.50   | 7.2     |
| 1B                                          | LIC    | S.R. 13 | LT   | DAVIS DRIVE (TWP 309)      | 27                        | 20                                             | 49                                            | 103.5   | 103.5     | 7.8                                                       |           |                                                                |         | 1.50   | 4.4     |
| 1B                                          | LIC    | S.R. 13 | RT   | HIRST RD (CR 310)          | 35                        | 20                                             | 50                                            | 136.2   | 136.2     | 10.3                                                      |           |                                                                |         | 1.50   | 5.7     |
| 1B                                          | LIC    | S.R. 13 | LT   | WHITE CHAPEL RD (TWP 306)  | 32                        | 21                                             | 53                                            | 131.6   | 131.6     | 9.9                                                       |           |                                                                |         | 1.50   | 5.5     |
| 1B                                          | LIC    | S.R. 13 | RT   | WHITE CHAPEL RD (TWP 306)  | 23                        | 16                                             | 46                                            | 79.3    | 79.3      | 6.0                                                       |           |                                                                |         | 1.50   | 3.4     |
| 1B                                          | LIC    | S.R. 13 | LT   | SANDY LANE                 | 25                        | 19                                             | 47                                            | 91.7    | 91.7      | 6.9                                                       |           |                                                                |         | 1.50   | 3.9     |
| 1B                                          | LIC    | S.R. 13 | LT   | KIRBY RD                   | 21                        | 20                                             | 44                                            | 74.7    | 74.7      | 5.7                                                       |           |                                                                |         | 1.50   | 3.2     |
| 1B                                          | LIC    | S.R. 13 | RT   | AT TRAILER PARK            | 19                        | 31                                             | 65                                            | 101.4   | 101.4     | 7.7                                                       |           |                                                                |         | 1.50   | 4.3     |
| 1B                                          | LIC    | S.R. 13 | LT   | DORSEY MILL RD (CR 343)    | 75                        | 40                                             | 190                                           | 958.4   | 958.4     | 71.9                                                      |           |                                                                |         | 1.50   | 40.0    |
| 1B                                          | LIC    | S.R. 13 | RT   | DORSEY MILL RD (CR 343)    | 75                        | 40                                             | 190                                           | 958.4   | 958.4     | 71.9                                                      |           |                                                                |         | 1.50   | 40.0    |
|                                             |        |         |      |                            |                           |                                                |                                               |         |           |                                                           |           |                                                                |         |        |         |
| SUB-TOTALS                                  |        |         |      |                            |                           |                                                |                                               |         |           | 308.9                                                     | 29.2      |                                                                |         |        |         |
| LOCATION 1B TOTALS (CARRIED TO SUB-SUMMARY) |        |         |      |                            |                           |                                                |                                               |         | 4,105.9   | 338.1                                                     |           |                                                                | 28.4    |        | 172.2   |
|                                             |        |         |      |                            |                           |                                                |                                               |         |           |                                                           |           |                                                                |         |        |         |
| 1D                                          | LIC    | S.R. 13 | RT   | HOPEWELL DR.               | 50                        | 24                                             | 98                                            | 338.9   | 338.9     | 25.5                                                      |           |                                                                |         | 1.50   | 14.2    |
|                                             |        |         |      |                            |                           |                                                |                                               |         |           |                                                           |           |                                                                |         |        |         |
| LOCATION 1D TOTALS (CARRIED TO SUB-SUMMARY) |        |         |      |                            |                           |                                                |                                               |         | 338.9     | 25.5                                                      |           |                                                                |         |        | 14.2    |
|                                             |        |         |      |                            |                           |                                                |                                               |         |           |                                                           |           |                                                                |         |        |         |




I:\ProjectData\LIC\92958\Design\Roadway\Sheets\92958\_GQ005.dgn 11-APR-2017 2:25PM jutz1

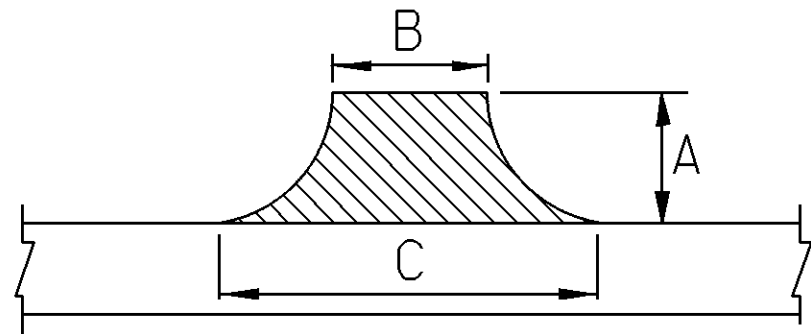

$$AREA = \left[ A \frac{(B + C)}{2} \right] / 9$$

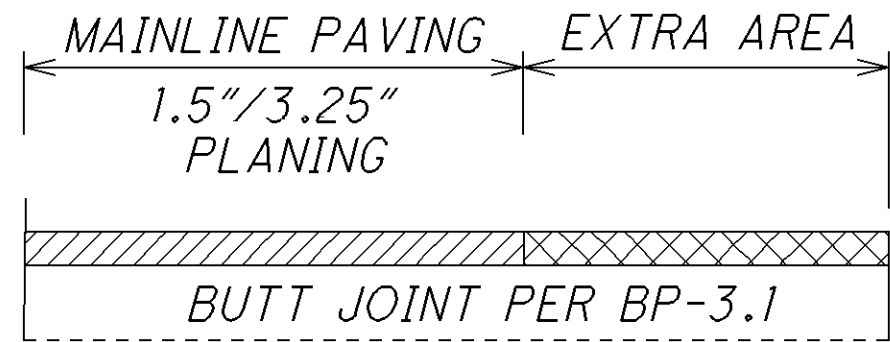

NOTES:  
1. AREAS SHOWN IN THE TABLE  
WITH INTERMEDIATE COURSE  
SHALL HAVE 3.25" DEPTH BUTT  
JOINT AND 2 COURSES OF  
ASPHALT SHALL BE PLACED.

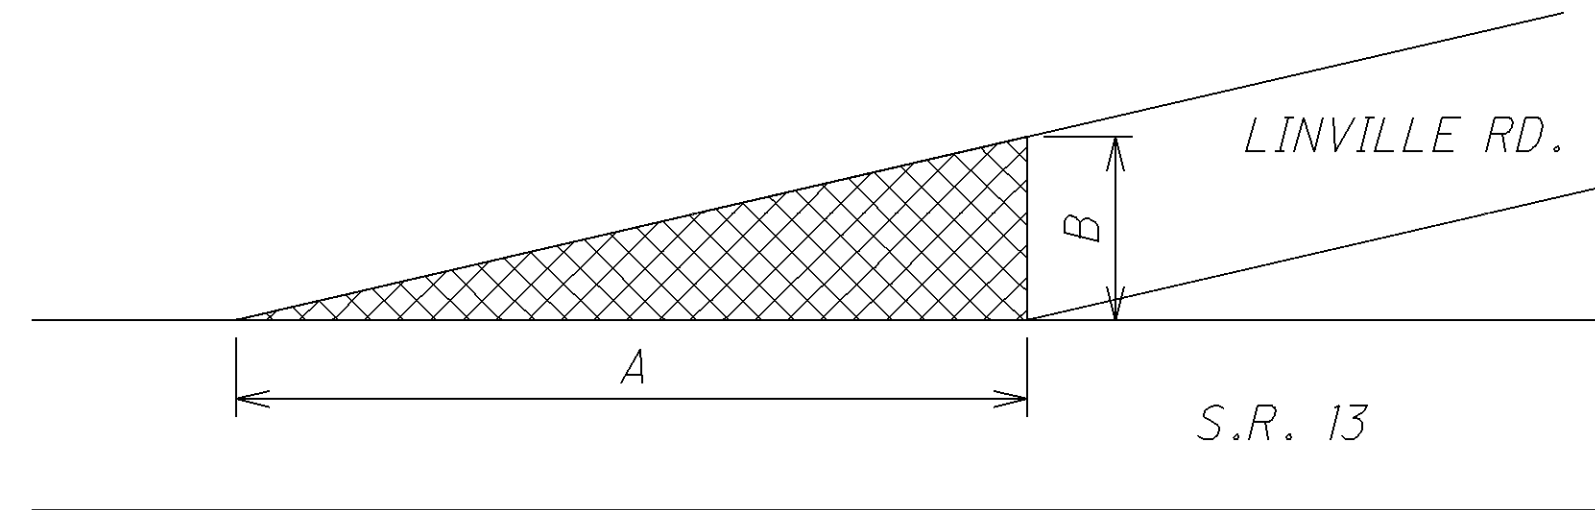

| EXTRA AREAS                                 |                            |                       |                  |                                                     |                                                                                                                 |      |        |                  |                                                                                                      |                                                                                                                                                 |                                                                                                                                                |                                           |                                                                                                                                                                                                               |                                           |                                                                                                                                                                                               |
|---------------------------------------------|----------------------------|-----------------------|------------------|-----------------------------------------------------|-----------------------------------------------------------------------------------------------------------------|------|--------|------------------|------------------------------------------------------------------------------------------------------|-------------------------------------------------------------------------------------------------------------------------------------------------|------------------------------------------------------------------------------------------------------------------------------------------------|-------------------------------------------|---------------------------------------------------------------------------------------------------------------------------------------------------------------------------------------------------------------|-------------------------------------------|-----------------------------------------------------------------------------------------------------------------------------------------------------------------------------------------------|
| L<br>O<br>C<br>A<br>T<br>I<br>O<br>N        | C<br>O<br>U<br>N<br>T<br>Y | R<br>O<br>U<br>T<br>E | S<br>I<br>D<br>E | D<br>E<br>S<br>C<br>R<br>I<br>P<br>T<br>I<br>O<br>N | I<br>N<br>T<br>E<br>R<br>S<br>E<br>C<br>T<br>I<br>O<br>N<br>S<br>D<br>I<br>M<br>E<br>N<br>S<br>I<br>O<br>N<br>S |      |        | A<br>R<br>E<br>A | 202                                                                                                  | 407                                                                                                                                             |                                                                                                                                                | 441                                       |                                                                                                                                                                                                               |                                           |                                                                                                                                                                                               |
|                                             |                            |                       |                  |                                                     |                                                                                                                 |      |        |                  | W<br>E<br>A<br>R<br>I<br>N<br>G<br>C<br>O<br>U<br>R<br>S<br>E<br><br>R<br>E<br>M<br>O<br>V<br>E<br>D | N<br>O<br>N<br>-<br>T<br>R<br>A<br>C<br>K<br>I<br>N<br>G<br><br>T<br>A<br>C<br>K<br>C<br>O<br>A<br>T<br><br>@<br>0.075<br>G<br>A<br>L.<br>/S.Y. | N<br>O<br>N<br>-<br>T<br>R<br>A<br>C<br>K<br>I<br>N<br>G<br><br>T<br>A<br>C<br>K<br>C<br>O<br>A<br>T<br><br>@<br>0.05<br>G<br>A<br>L.<br>/S.Y. | T<br>H<br>I<br>C<br>K<br>N<br>E<br>S<br>S | A<br>S<br>P<br>H<br>A<br>L<br>T<br>C<br>O<br>N<br>C<br>R<br>E<br>T<br>E<br><br>I<br>N<br>T<br>E<br>R<br>M<br>E<br>D<br>I<br>A<br>T<br>E<br>C<br>O<br>U<br>R<br>S<br>E,<br><br>T<br>Y<br>P<br>E<br>1,<br>(448) | T<br>H<br>I<br>C<br>K<br>N<br>E<br>S<br>S | A<br>S<br>P<br>H<br>A<br>L<br>T<br>C<br>O<br>N<br>C<br>R<br>E<br>T<br>E<br><br>S<br>U<br>R<br>F<br>A<br>C<br>E<br>C<br>O<br>U<br>R<br>S<br>E,<br><br>T<br>Y<br>P<br>E<br>1,<br>(448),PG 64-22 |
|                                             |                            |                       |                  |                                                     | A                                                                                                               | B    | C      |                  | SQ. YD.                                                                                              | SQ. YD.                                                                                                                                         | GAL.                                                                                                                                           | GAL.                                      | INCHES                                                                                                                                                                                                        | CU. YD.                                   | INCHES                                                                                                                                                                                        |
| FT.                                         | FT.                        | FT.                   | SQ. YD.          | SQ. YD.                                             | GAL.                                                                                                            | GAL. | INCHES | CU. YD.          | INCHES                                                                                               | CU. YD.                                                                                                                                         |                                                                                                                                                |                                           |                                                                                                                                                                                                               |                                           |                                                                                                                                                                                               |
| 1E                                          | LIC                        | S.R. 13               | RT               | LINVILLE RD.                                        | 82                                                                                                              | 53   |        | 241.5            | 241.5                                                                                                | 18.2                                                                                                                                            |                                                                                                                                                |                                           | 1.50                                                                                                                                                                                                          | 10.1                                      |                                                                                                                                                                                               |
| 1E                                          | LIC                        | S.R. 13               | LT               | ORCHARD ST.                                         | 15                                                                                                              | 24   | 45     | 57.5             | 57.5                                                                                                 | 4.4                                                                                                                                             |                                                                                                                                                |                                           | 1.50                                                                                                                                                                                                          | 2.4                                       |                                                                                                                                                                                               |
| 1E                                          | LIC                        | S.R. 13               | RT               | BONER ST.                                           | 20                                                                                                              | 24   | 45     | 76.7             | 76.7                                                                                                 | 5.8                                                                                                                                             |                                                                                                                                                |                                           | 1.50                                                                                                                                                                                                          | 3.2                                       |                                                                                                                                                                                               |
| 1E                                          | LIC                        | S.R. 13               | LT               | GAINOR AVE.                                         | 12                                                                                                              | 23   | 40     | 42.0             | 42.0                                                                                                 | 3.2                                                                                                                                             |                                                                                                                                                |                                           | 1.50                                                                                                                                                                                                          | 1.8                                       |                                                                                                                                                                                               |
| 1E                                          | LIC                        | S.R. 13               | RT               | ISABELL RD.                                         | 20                                                                                                              | 40   | 50     | 100.0            | 100.0                                                                                                | 7.5                                                                                                                                             |                                                                                                                                                |                                           | 1.50                                                                                                                                                                                                          | 4.2                                       |                                                                                                                                                                                               |
| 1E                                          | LIC                        | S.R. 13               | LT               | PROSPECT ST.                                        | 16                                                                                                              | 24   | 36     | 53.4             | 53.4                                                                                                 | 4.1                                                                                                                                             |                                                                                                                                                |                                           | 1.50                                                                                                                                                                                                          | 2.3                                       |                                                                                                                                                                                               |
| 1E                                          | LIC                        | S.R. 13               | LT               | WILWOOD AVE.                                        | 40                                                                                                              | 24   | 60     | 186.7            | 186.7                                                                                                | 14.1                                                                                                                                            |                                                                                                                                                |                                           | 1.50                                                                                                                                                                                                          | 7.8                                       |                                                                                                                                                                                               |
| 1E                                          | LIC                        | S.R. 13               | LT               | S. 5TH ST.                                          | 36                                                                                                              | 38   | 70     | 216.0            | 216.0                                                                                                | 16.2                                                                                                                                            |                                                                                                                                                |                                           | 1.50                                                                                                                                                                                                          | 9.0                                       |                                                                                                                                                                                               |
| 1E                                          | LIC                        | S.R. 13               | RT               | W. NATIONAL DR.                                     | 30                                                                                                              | 34   | 64     | 163.4            | 163.4                                                                                                | 12.3                                                                                                                                            |                                                                                                                                                |                                           | 1.50                                                                                                                                                                                                          | 6.9                                       |                                                                                                                                                                                               |
|                                             |                            |                       |                  |                                                     |                                                                                                                 |      |        |                  |                                                                                                      |                                                                                                                                                 |                                                                                                                                                |                                           |                                                                                                                                                                                                               |                                           |                                                                                                                                                                                               |
| LOCATION 1E TOTALS (CARRIED TO SUB-SUMMARY) |                            |                       |                  |                                                     |                                                                                                                 |      |        |                  | 1,137.2                                                                                              | 85.8                                                                                                                                            |                                                                                                                                                |                                           |                                                                                                                                                                                                               | 47.7                                      |                                                                                                                                                                                               |
|                                             |                            |                       |                  |                                                     |                                                                                                                 |      |        |                  |                                                                                                      |                                                                                                                                                 |                                                                                                                                                |                                           |                                                                                                                                                                                                               |                                           |                                                                                                                                                                                               |


EXTRA AREA DATA

LIC-13-0.00




I:\ProjectData\LIC\92958\Design\Roadway\Sheets\92958\_GQ006.dgn 28-JUN-2017 1:12PM jutz1

DETAIL 1

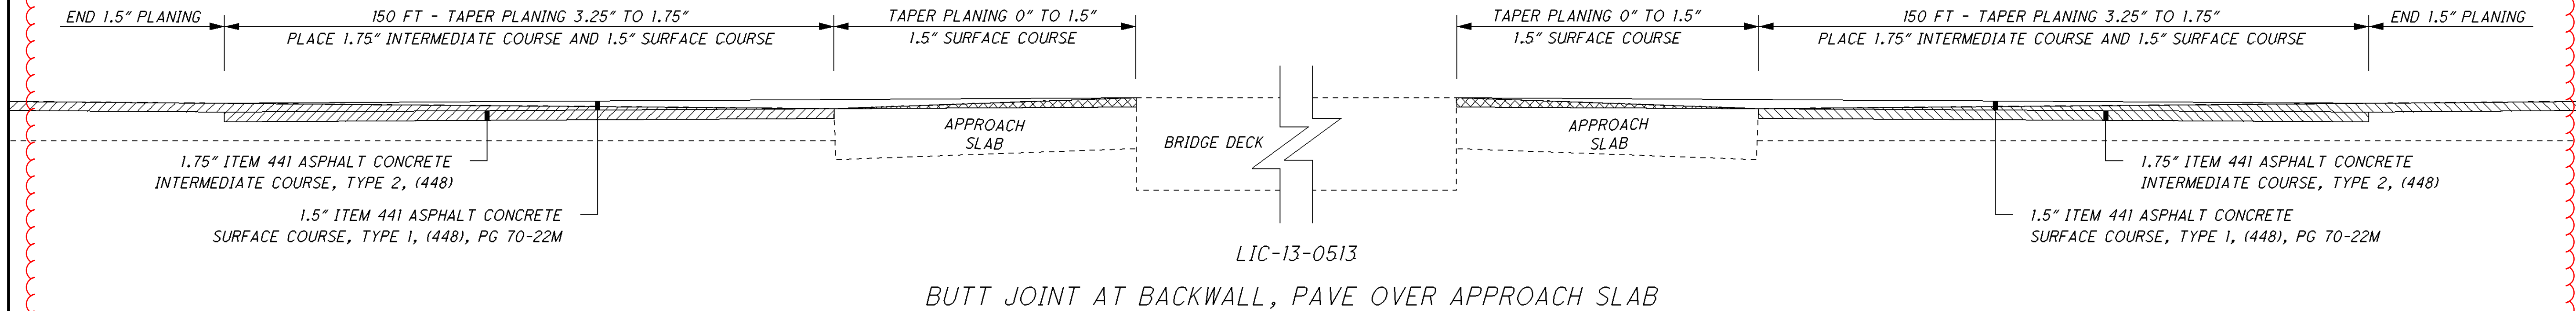

DETAIL 2

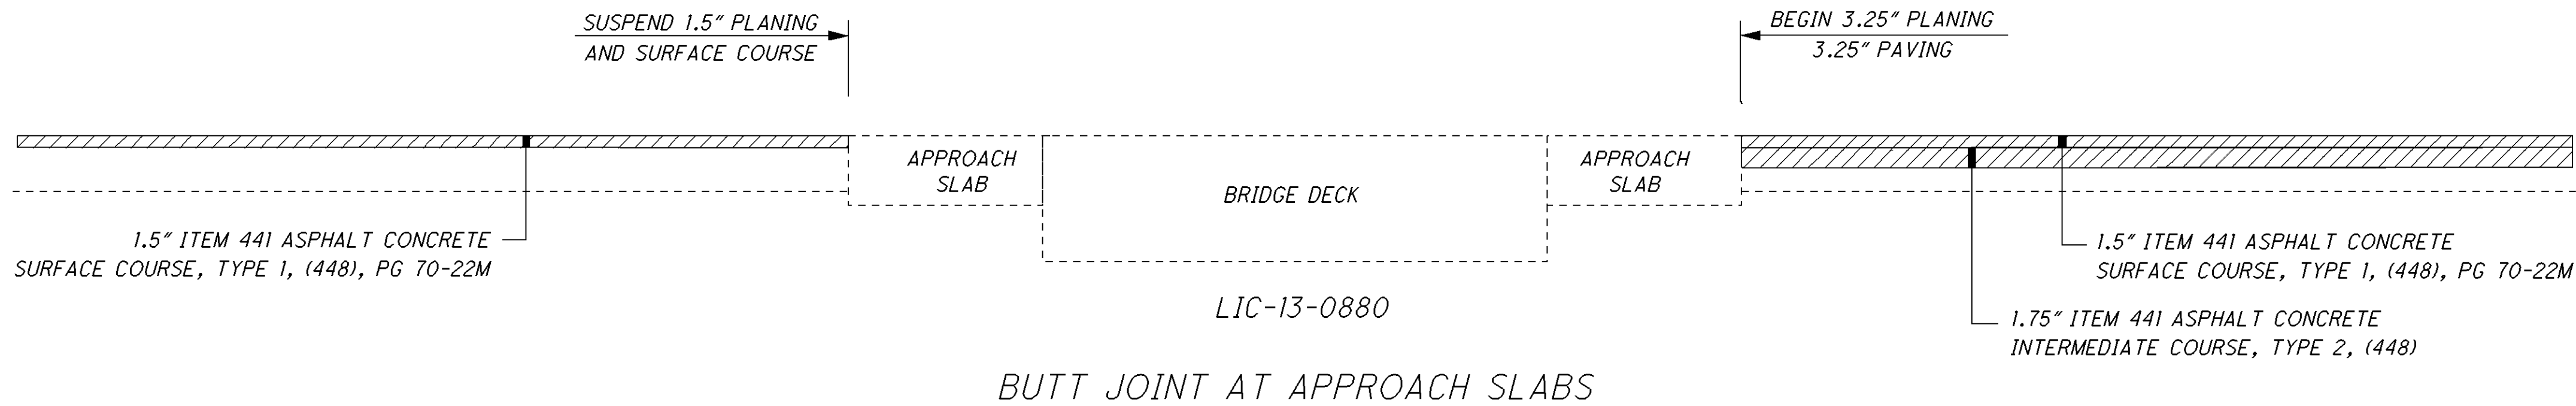


| BRIDGE TREATMENT DATA |                                             |                                  |-----------------------|---------------------------------------------|----------------------------------|----------|---------|-------------------------|------------------------|---------------------------------------------------------|----------------------------------------|--------------------------------------------------|----------------------------------------------|------------------------------------|---------------------------|--------------------------------|-------------------------------|-----------|-----------------------------------------------------------|-----------|-----------------------------------------------------------------|----------------------|--------------------------------------|
| NOTES                 | COUNTY, ROUTE, BRIDGE NO.                   | LENGTH<br>(BRIDGE LIMITS)        | WIDTH    | AREA    | APPROACH SLAB<br>LENGTH | APPROACH SLAB<br>WIDTH | APPROACH SLAB<br>AREA (INCLUDES BOTH<br>APPROACH SLABS) | BRIDGE DECK DETAIL<br>(SEE THIS SHEET) | MAINLINE DEDUCTIONS<br>(CARRIED TO SHEETS 13,14) | SHOULDER DEDUCTIONS<br>(CARRIED TO SHEET 16) | 202                                |                           | 407                            |                               | 441       |                                                           |           |                                                                 | 512                  | 516                                  |
|                       |                                             | LIN. FT.                         | LIN. FT. | SQ. YD. | LIN. FT.                | LIN. FT.               | SQ. YD.                                                 |                                        | SQ. YD.                                          | SQ. YD.                                      | DEPTH OF WEARING<br>COURSE REMOVED | WEARING COURSE<br>REMOVED | TACK COAT<br>@ 0.075 GAL./S.Y. | TACK COAT<br>@ 0.05 GAL./S.Y. | THICKNESS | ASPHALT CONCRETE<br>INTERMEDIATE COURSE,<br>TYPE 1, (448) | THICKNESS | ASPHALT CONCRETE<br>SURFACE COURSE,<br>TYPE 1, (448), PG 70-22M | TYPE 3 WATERPROOFING | 2" DEEP JOINT SEALER,<br>AS PER PLAN |
|                       |                                             | 1B                    | LIC-13-0151                                 | OVERHEAD - MILL AND FILL ROADWAY |          |         |                         |                        |                                                         |                                        |                                                  |                                              |                                    |                           |                                |                               |           |                                                           |           |                                                                 |                      |                                      |
| 1B                    | LIC-13-0513                                 | 92.0                             | 43.3     | 442.7   | 20.0                    | 43.0                   | 191.1                                                   | 1                                      | 352.0                                            | 234.7                                        |                                    |                           | 14.3                           |                               |           | 1.50                                                      | 8.0       |                                                                 |                      | 86                                   |
|                       |                                             |                       | BRIDGE DEDUCTIONS                           |                                  |          |         |                         |                        |                                                         |                                        | 352.0                                            | 234.7                                        |                                    |                           |                                |                               |           |                                                           |           |                                                                 |                      |                                      |
|                       | LOCATION 1B TOTALS (CARRIED TO SUB-SUMMARY) |                                  |          |         |                         |                        |                                                         |                                        |                                                  |                                              |                                    |                           | 14.3                           |                               |           |                                                           | 8.0       |                                                                 |                      | 86                                   |
|                       |                                             | 1E                    | LIC-13-0880                                 | 202.0                            | 35.8     | 803.6   | 20.0                    | 28.0                   | 124.4                                                   | 2                                      | 537.8                                            |                                              |                                    |                           |                                |                               |           |                                                           |           |                                                                 |                      | 56                                   |
|                       |                                             |                       | BRIDGE DEDUCTIONS                           |                                  |          |         |                         |                        |                                                         |                                        | 537.8                                            |                                              |                                    |                           |                                |                               |           |                                                           |           |                                                                 |                      |                                      |
|                       | LOCATION 1E TOTALS (CARRIED TO SUB-SUMMARY) |                                  |          |         |                         |                        |                                                         |                                        |                                                  |                                              |                                    |                           |                                |                               |           |                                                           |           |                                                                 |                      | 56                                   |



I:\ProjectData\LIC\92958\Design\Roadway\Sheets\92958\_TQ001.dgn 11-APR-2017 2:29PM jlut1

| ITEM 648 EDGE LINE, 6"                      |                            |                       |                  |        |                                                                                |                                                                                                                 |                                                          |                                           |                                                                       |                                                                                                                                                                                |                                 |
|---------------------------------------------|----------------------------|-----------------------|------------------|--------|--------------------------------------------------------------------------------|-----------------------------------------------------------------------------------------------------------------|----------------------------------------------------------|-------------------------------------------|-----------------------------------------------------------------------|--------------------------------------------------------------------------------------------------------------------------------------------------------------------------------|---------------------------------|
| L<br>O<br>C<br>A<br>T<br>I<br>O<br>N        | C<br>O<br>U<br>N<br>T<br>Y | R<br>O<br>U<br>T<br>E | S.L.M.           |        | T<br>O<br>T<br>A<br>L<br>L<br>E<br>N<br>G<br>T<br>H<br>(M<br>I<br>L<br>E<br>S) | I<br>N<br>F<br>O<br>R<br>M<br>A<br>T<br>I<br>O<br>N<br>O<br>N<br>L<br>Y                                         |                                                          |                                           | 648                                                                   | 618                                                                                                                                                                            | R<br>E<br>M<br>A<br>R<br>K<br>S |
|                                             |                            |                       |                  |        |                                                                                | W<br>H<br>I<br>T<br>E<br>E<br>D<br>G<br>E<br>L<br>I<br>N<br>E<br>Q<br>U<br>A<br>N<br>T<br>I<br>T<br>I<br>E<br>S |                                                          |                                           | T<br>O<br>T<br>A<br>L<br>E<br>D<br>G<br>E<br>L<br>I<br>N<br>E<br>(6") | E<br>D<br>G<br>E<br>L<br>I<br>N<br>E,<br>R<br>U<br>M<br>B<br>L<br>E<br>S<br>T<br>R<br>I<br>P<br>E<br>(A<br>S<br>P<br>H<br>A<br>L<br>T<br>C<br>O<br>N<br>C<br>R<br>E<br>T<br>E) |                                 |
|                                             |                            |                       | F<br>R<br>O<br>M | T<br>O |                                                                                | T<br>O<br>T<br>A<br>L<br>M<br>I<br>L<br>E<br>S                                                                  | H<br>I<br>G<br>H<br>W<br>A<br>Y<br>M<br>I<br>L<br>E<br>S | R<br>A<br>M<br>P<br>M<br>I<br>L<br>E<br>S | M<br>I<br>L<br>E                                                      | M<br>I<br>L<br>E                                                                                                                                                               |                                 |
| 1A                                          | LIC                        | S.R. 13               | 0.00             | 0.54   | 0.54                                                                           | 1.08                                                                                                            | 1.08                                                     |                                           | 1.08                                                                  | 1.08                                                                                                                                                                           | PERRY COUNTY TO SLM             |
|                                             |                            |                       |                  |        |                                                                                |                                                                                                                 |                                                          |                                           |                                                                       |                                                                                                                                                                                |                                 |
| LOCATION 1A TOTALS (CARRIED TO SUB-SUMMARY) |                            |                       |                  |        |                                                                                |                                                                                                                 |                                                          |                                           | 1.08                                                                  | 1.08                                                                                                                                                                           |                                 |
| 1B                                          | LIC                        | S.R. 13               | 0.54             | 6.48   | 5.94                                                                           | 11.88                                                                                                           | 11.88                                                    |                                           | 11.88                                                                 | 11.88                                                                                                                                                                          | SLM TO DORSEY MILL RD.          |
|                                             |                            |                       |                  |        |                                                                                |                                                                                                                 |                                                          |                                           |                                                                       |                                                                                                                                                                                |                                 |
| LOCATION 1B TOTALS (CARRIED TO SUB-SUMMARY) |                            |                       |                  |        |                                                                                |                                                                                                                 |                                                          |                                           | 11.88                                                                 | 11.88                                                                                                                                                                          |                                 |
| 1C                                          | LIC                        | S.R. 13               | 6.48             | 7.76   | 1.28                                                                           | 2.56                                                                                                            | 2.56                                                     |                                           | 2.56                                                                  | 2.56                                                                                                                                                                           | DORSEY MILL RD. TO HEATH CORP.  |
|                                             |                            |                       |                  |        |                                                                                |                                                                                                                 |                                                          |                                           |                                                                       |                                                                                                                                                                                |                                 |
| LOCATION 1C TOTALS (CARRIED TO SUB-SUMMARY) |                            |                       |                  |        |                                                                                |                                                                                                                 |                                                          |                                           | 2.56                                                                  | 2.56                                                                                                                                                                           |                                 |
| 1D                                          | LIC                        | S.R. 13               | 7.76             | 8.37   | 0.61                                                                           | 1.22                                                                                                            | 1.22                                                     |                                           | 1.22                                                                  |                                                                                                                                                                                | HEATH CORP. TO NEWARK CORP.     |
|                                             |                            |                       |                  |        |                                                                                |                                                                                                                 |                                                          |                                           |                                                                       |                                                                                                                                                                                |                                 |
| LOCATION 1D TOTALS (CARRIED TO SUB-SUMMARY) |                            |                       |                  |        |                                                                                |                                                                                                                 |                                                          |                                           | 1.22                                                                  |                                                                                                                                                                                |                                 |
|                                             |                            |                       |                  |        |                                                                                |                                                                                                                 |                                                          |                                           |                                                                       |                                                                                                                                                                                |                                 |

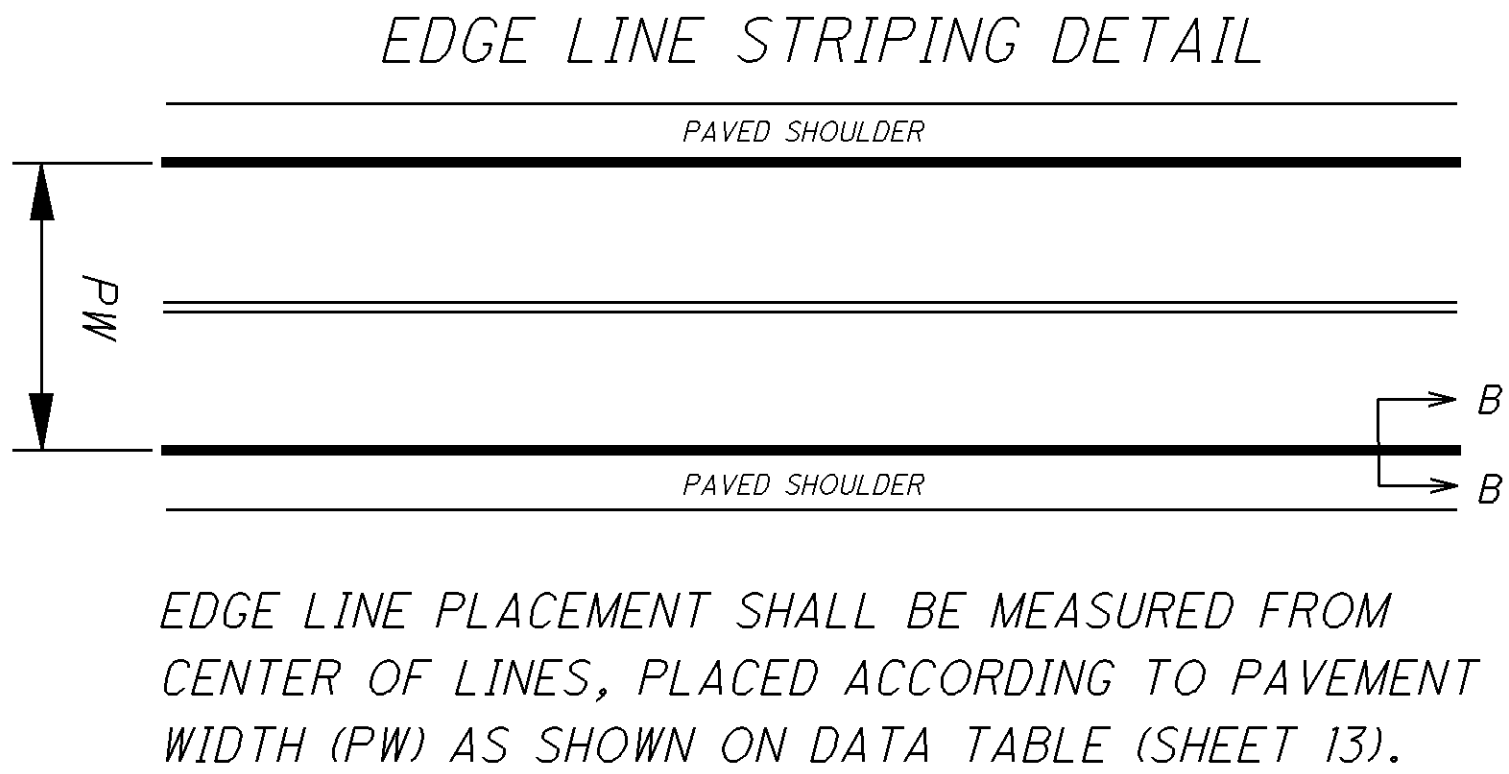




| ITEM 644/648 CENTER/LANE LINE               |                            |                       |                |                          |                            |                           |        |                         |                         |                               |                               |                                              |
|---------------------------------------------|----------------------------|-----------------------|----------------|--------------------------|----------------------------|---------------------------|--------|-------------------------|-------------------------|-------------------------------|-------------------------------|----------------------------------------------|
| L<br>O<br>C<br>A<br>T<br>I<br>O<br>N        | C<br>O<br>U<br>N<br>T<br>Y | R<br>O<br>U<br>T<br>E | S.L.M.         |                          | TOTAL<br>LENGTH<br>(MILES) | INFORMATION ONLY          |        | 644                     | 648                     | 644                           | 648                           | REMARKS                                      |
|                                             |                            |                       |                |                          |                            | CENTER LINE<br>QUANTITIES |        | TOTAL<br>CENTER<br>LINE | TOTAL<br>CENTER<br>LINE | TOTAL<br>LANE<br>LINE<br>(4") | TOTAL<br>LANE<br>LINE<br>(6") |                                              |
|                                             |                            |                       | TOTAL<br>MILES | EQUIVALENT<br>SOLID LINE |                            |                           |        |                         |                         |                               |                               |                                              |
|                                             |                            |                       | FROM           | TO                       |                            | MILES                     | MILES  | MILES                   | MILES                   |                               |                               |                                              |
| 1A                                          | LIC                        | S.R. 13               | 0.00           | 0.54                     | 0.54                       | 0.54                      | 1.300  |                         | 0.54                    |                               |                               | PERRY COUNTY TO SLM                          |
| LOCATION 1A TOTALS (CARRIED TO SUB-SUMMARY) |                            |                       |                |                          |                            |                           |        |                         | 0.54                    |                               |                               |                                              |
| 1B                                          | LIC                        | S.R. 13               | 0.54           | 6.48                     | 5.94                       | 5.94                      | 10.856 |                         | 6.29                    |                               |                               | SLM TO DORSEY MILL RD.(EXTRA FOR TURN LANES) |
| 1B                                          | LIC                        | S.R. 13 N.B.          | 1.42           | 1.49                     | 0.07                       |                           |        |                         |                         |                               | 0.07                          |                                              |
| 1B                                          | LIC                        | S.R. 13               | 1.49           | 1.74                     | 0.25                       |                           |        |                         |                         |                               | 0.50                          | NORTHBOUND AND SOUTHBOUND                    |
| 1B                                          | LIC                        | S.R. 13 N.B.          | 1.74           | 1.88                     | 0.14                       |                           |        |                         |                         |                               | 0.14                          | SOUTHBOUND                                   |
| LOCATION 1B TOTALS (CARRIED TO SUB-SUMMARY) |                            |                       |                |                          |                            |                           |        |                         | 6.29                    |                               | 0.71                          |                                              |
| 1C                                          | LIC                        | S.R. 13               | 6.48           | 7.76                     | 1.28                       | 1.28                      | 2.425  |                         | 1.37                    |                               |                               | DORSEY MILL RD. TO HEATH CORP.               |
| LOCATION 1C TOTALS (CARRIED TO SUB-SUMMARY) |                            |                       |                |                          |                            |                           |        |                         | 1.37                    |                               |                               |                                              |
| 1D                                          | LIC                        | S.R. 13               | 7.76           | 8.37                     | 0.61                       | 0.61                      | 1.281  |                         | 0.74                    |                               |                               | HEATH CORP. TO NEWARK CORP.                  |
| LOCATION 1D TOTALS (CARRIED TO SUB-SUMMARY) |                            |                       |                |                          |                            |                           |        |                         | 0.74                    |                               |                               |                                              |
| 1E                                          | LIC                        | S.R. 13               | 8.37           | 9.10                     | 0.73                       | 0.73                      | 2.012  |                         | 0.73                    |                               |                               | NEWARK CORP. TO 4TH ST.                      |
| LOCATION 1E TOTALS (CARRIED TO SUB-SUMMARY) |                            |                       |                |                          |                            |                           |        |                         | 0.73                    |                               |                               |                                              |
| O.D.O.T. D05 COMPLEX                        |                            |                       |                |                          | 0.30                       | 0.30                      | 0.600  | 0.30                    |                         |                               |                               |                                              |
| TOTALS (CARRIED TO GENERAL SUMMARY)         |                            |                       |                |                          |                            |                           |        | 0.30                    |                         |                               |                               |                                              |






I:\ProjectData\LIC\92958\Design\Roadway\Sheets\92958\_TQ004.dgn 11-APR-2017 2:40PM jutz1

| ITEM 644 AUXILIARY MARKING                  |                            |                       |                  |                                                     |             |                                                                                                                     |                                           |                                                   |                                                                   |                                                                    |                  |                                                |         |         |                                                                                 |                                                                                                       |                                                                                   |                                                                                             |                                 |
|---------------------------------------------|----------------------------|-----------------------|------------------|-----------------------------------------------------|-------------|---------------------------------------------------------------------------------------------------------------------|-------------------------------------------|---------------------------------------------------|-------------------------------------------------------------------|--------------------------------------------------------------------|------------------|------------------------------------------------|---------|---------|---------------------------------------------------------------------------------|-------------------------------------------------------------------------------------------------------|-----------------------------------------------------------------------------------|---------------------------------------------------------------------------------------------|---------------------------------|
| L<br>O<br>C<br>A<br>T<br>I<br>O<br>N        | C<br>O<br>U<br>N<br>T<br>Y | R<br>O<br>U<br>T<br>E | S<br>I<br>D<br>E | D<br>E<br>S<br>C<br>R<br>I<br>P<br>T<br>I<br>O<br>N | S<br>L<br>M | T<br>R<br>A<br>N<br>S<br>E<br>R<br>S<br>E/<br>D<br>I<br>A<br>G<br>O<br>N<br>A<br>L<br>L<br>I<br>N<br>E<br><br>(24") |                                           | S<br>T<br>O<br>P<br>L<br>I<br>N<br>E<br><br>(24") | 12" C<br>R<br>O<br>S<br>S<br>W<br>A<br>L<br>K<br>L<br>I<br>N<br>E | W<br>O<br>R<br>D<br>O<br>N<br>P<br>A<br>V<br>E<br>M<br>E<br>N<br>T |                  | L<br>A<br>N<br>E<br>A<br>R<br>R<br>O<br>W<br>S |         |         | 8" C<br>H<br>A<br>N<br>N<br>E<br>L<br>I<br>Z<br>I<br>N<br>G<br>L<br>I<br>N<br>E | H<br>A<br>N<br>D<br>I<br>C<br>A<br>P<br>S<br>Y<br>M<br>B<br>O<br>L<br>M<br>A<br>R<br>K<br>I<br>N<br>G | S<br>H<br>A<br>R<br>E<br>D<br>L<br>A<br>N<br>E<br>M<br>A<br>R<br>K<br>I<br>N<br>G | P<br>A<br>R<br>K<br>I<br>N<br>G<br>S<br>T<br>A<br>L<br>L<br>M<br>A<br>R<br>K<br>I<br>N<br>G | R<br>E<br>M<br>A<br>R<br>K<br>S |
|                                             |                            |                       |                  |                                                     |             | W<br>H<br>I<br>T<br>E<br><br>F<br>T.                                                                                | Y<br>E<br>L<br>L<br>O<br>W<br><br>F<br>T. |                                                   |                                                                   | O<br>N<br>L<br>Y                                                   |                  | T<br>U<br>R<br>N                               |         |         |                                                                                 |                                                                                                       |                                                                                   |                                                                                             |                                 |
|                                             |                            |                       |                  |                                                     |             |                                                                                                                     |                                           |                                                   |                                                                   | 72"                                                                | 96"              | L<br>T<br>/<br>T<br>H<br>R<br>U                | L<br>T. | R<br>T. |                                                                                 |                                                                                                       |                                                                                   |                                                                                             |                                 |
|                                             |                            |                       |                  |                                                     |             |                                                                                                                     |                                           | E<br>A<br>C<br>H                                  | E<br>A<br>C<br>H                                                  | E<br>A<br>C<br>H                                                   | E<br>A<br>C<br>H | E<br>A<br>C<br>H                               |         |         |                                                                                 |                                                                                                       |                                                                                   |                                                                                             |                                 |
| 1C                                          | LIC                        | S.R. 13               | RT               | DORSEY MILL RD.                                     |             |                                                                                                                     |                                           | 24                                                |                                                                   |                                                                    |                  |                                                |         |         |                                                                                 |                                                                                                       |                                                                                   | SEE SHEET 33                                                                                |                                 |
| 1C                                          | LIC                        | S.R. 13               |                  | ON S.R. 13 AFTER DORSEY MILL RD.                    |             |                                                                                                                     | 169                                       | 28                                                |                                                                   |                                                                    | 1                |                                                | 3       |         | 290                                                                             |                                                                                                       |                                                                                   | SEE SHEET 34                                                                                |                                 |
| LOCATION 1C TOTALS (CARRIED TO SUB-SUMMARY) |                            |                       |                  |                                                     |             |                                                                                                                     | 169                                       | 52                                                |                                                                   |                                                                    | 1                |                                                | 3       |         | 290                                                                             |                                                                                                       |                                                                                   |                                                                                             |                                 |
| 1D                                          | LIC                        | S.R. 13               |                  | ON S.R. 13 BEFORE HOPEWELL DR.                      |             |                                                                                                                     | 117                                       | 24                                                |                                                                   |                                                                    |                  |                                                | 2       |         | 70                                                                              |                                                                                                       |                                                                                   | SEE SHEET 35                                                                                |                                 |
|                                             |                            |                       | RT               | HOPEWELL DR.                                        |             |                                                                                                                     |                                           | 13                                                |                                                                   |                                                                    |                  |                                                |         |         |                                                                                 |                                                                                                       |                                                                                   | SEE SHEET 35                                                                                |                                 |
|                                             |                            |                       |                  | ON S.R. 13 AFTER HOPEWELL DR.                       |             |                                                                                                                     | 112                                       |                                                   |                                                                   |                                                                    |                  |                                                | 2       |         | 70                                                                              |                                                                                                       |                                                                                   | SEE SHEET 35                                                                                |                                 |
| LOCATION 1D TOTALS (CARRIED TO SUB-SUMMARY) |                            |                       |                  |                                                     |             |                                                                                                                     | 229                                       | 37                                                |                                                                   |                                                                    |                  |                                                | 4       |         | 140                                                                             |                                                                                                       |                                                                                   |                                                                                             |                                 |
| 1E                                          | LIC                        | S.R. 13               | RT               | LINVILLE RD                                         |             |                                                                                                                     |                                           | 28                                                |                                                                   |                                                                    |                  |                                                |         |         |                                                                                 |                                                                                                       |                                                                                   | PLACE 19' FROM CL SR 586                                                                    |                                 |
| 1E                                          | LIC                        | S.R. 13               | LT               | ORCHARD ST                                          |             |                                                                                                                     |                                           |                                                   | 64                                                                |                                                                    |                  |                                                |         |         |                                                                                 |                                                                                                       |                                                                                   | PLACE 21' FROM CL SR 586                                                                    |                                 |
| 1E                                          | LIC                        | S.R. 13               | RT               | BONNER ST                                           |             |                                                                                                                     |                                           |                                                   | 50                                                                |                                                                    |                  |                                                |         |         |                                                                                 |                                                                                                       |                                                                                   | PLACE 18' FROM CL SR 586                                                                    |                                 |
| 1E                                          | LIC                        | S.R. 13               | LT               | GANIOR AVE                                          |             |                                                                                                                     |                                           |                                                   | 50                                                                |                                                                    |                  |                                                |         |         |                                                                                 |                                                                                                       |                                                                                   | PLACE 20' FROM CL SR 586                                                                    |                                 |
| 1E                                          | LIC                        | S.R. 13               | RT               | ISABELLE RD                                         |             |                                                                                                                     |                                           |                                                   | 80                                                                |                                                                    |                  |                                                |         |         |                                                                                 |                                                                                                       |                                                                                   | PLACE 19' FROM CL SR 586                                                                    |                                 |
| 1E                                          | LIC                        | S.R. 13               |                  | SR 13 AT ISABELLE RD                                |             |                                                                                                                     |                                           | 35                                                | 72                                                                |                                                                    |                  |                                                | 2       |         | 75                                                                              |                                                                                                       |                                                                                   | SEE SHEET 36                                                                                |                                 |
| 1E                                          | LIC                        | S.R. 13               | LT               | PROSPECT ST                                         |             |                                                                                                                     |                                           |                                                   | 54                                                                |                                                                    |                  |                                                |         |         |                                                                                 |                                                                                                       |                                                                                   | PLACE 20' FROM CL SR 586                                                                    |                                 |
| 1E                                          | LIC                        | S.R. 13               |                  | SR 13 AT WILWOOD AVE.                               |             |                                                                                                                     |                                           | 41                                                | 72                                                                |                                                                    |                  | 1                                              |         | 2       | 63                                                                              |                                                                                                       |                                                                                   | SEE SHEET 36                                                                                |                                 |
| 1E                                          | LIC                        | S.R. 13               | LT               | S. 5TH ST.                                          |             |                                                                                                                     |                                           | 20                                                | 95                                                                |                                                                    |                  |                                                |         |         |                                                                                 |                                                                                                       |                                                                                   | SEE SHEET 36                                                                                |                                 |
| <div></div>                                 |                            |                       |                  |                                                     |             |                                                                                                                     |                                           |                                                   |                                                                   |                                                                    |                  |                                                |         |         |                                                                                 |                                                                                                       |                                                                                   |                                                                                             |                                 |
| SUB-TOTALS                                  |                            |                       |                  |                                                     |             |                                                                                                                     |                                           |                                                   |                                                                   |                                                                    |                  | 1                                              | 2       | 2       |                                                                                 |                                                                                                       |                                                                                   |                                                                                             |                                 |
| LOCATION 1E TOTALS (CARRIED TO SUB-SUMMARY) |                            |                       |                  |                                                     |             |                                                                                                                     |                                           | 124                                               | 537                                                               |                                                                    |                  | 5                                              |         |         | 138                                                                             |                                                                                                       |                                                                                   |                                                                                             |                                 |
|                                             |                            |                       |                  | O.D.O.T. D05 COMPLEX                                |             |                                                                                                                     |                                           | 70                                                | 48                                                                |                                                                    |                  |                                                | 2       |         | 115                                                                             | 5                                                                                                     | 5,995                                                                             | SEE SHEETS 40-41                                                                            |                                 |
| TOTALS (CARRIED TO GENERAL SUMMARY)         |                            |                       |                  |                                                     |             |                                                                                                                     | 122                                       | 70                                                | 48                                                                |                                                                    |                  |                                                | 2       |         | 115                                                                             | 5                                                                                                     | 5,995                                                                             |                                                                                             |                                 |

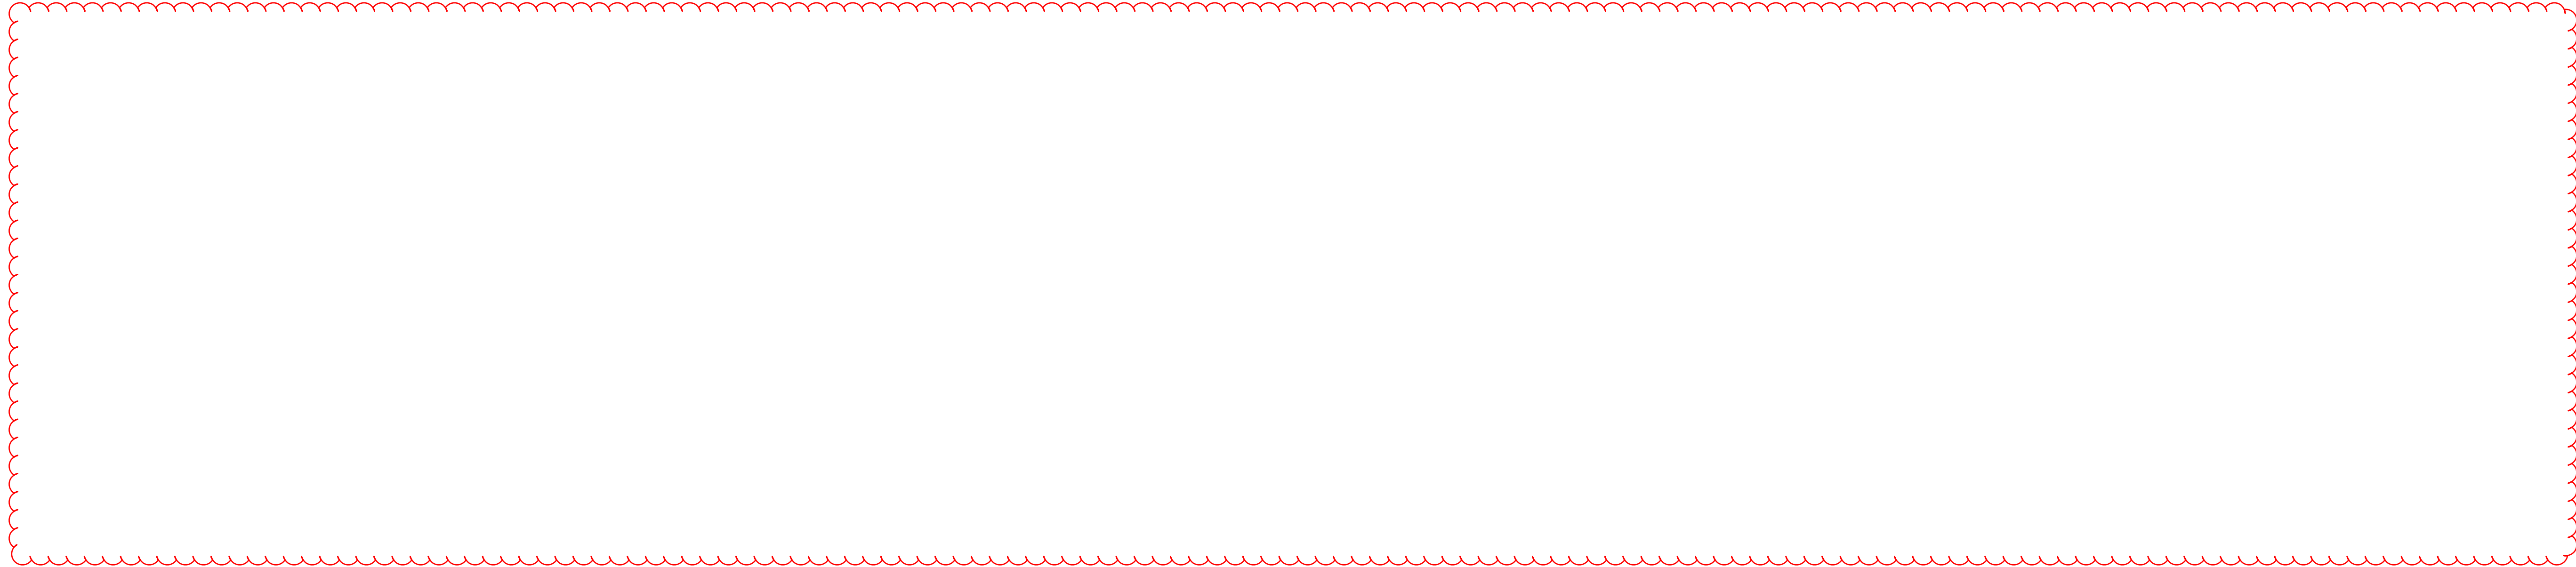





CHL = CHANNELIZING LINE  
DYC = DOUBLE YELLOW CENTER LINE  
STL = STOP LINE  
WEL = WHITE EDGE LINE  
YTL = YELLOW TRANSVERSE/DIAGONAL LINE

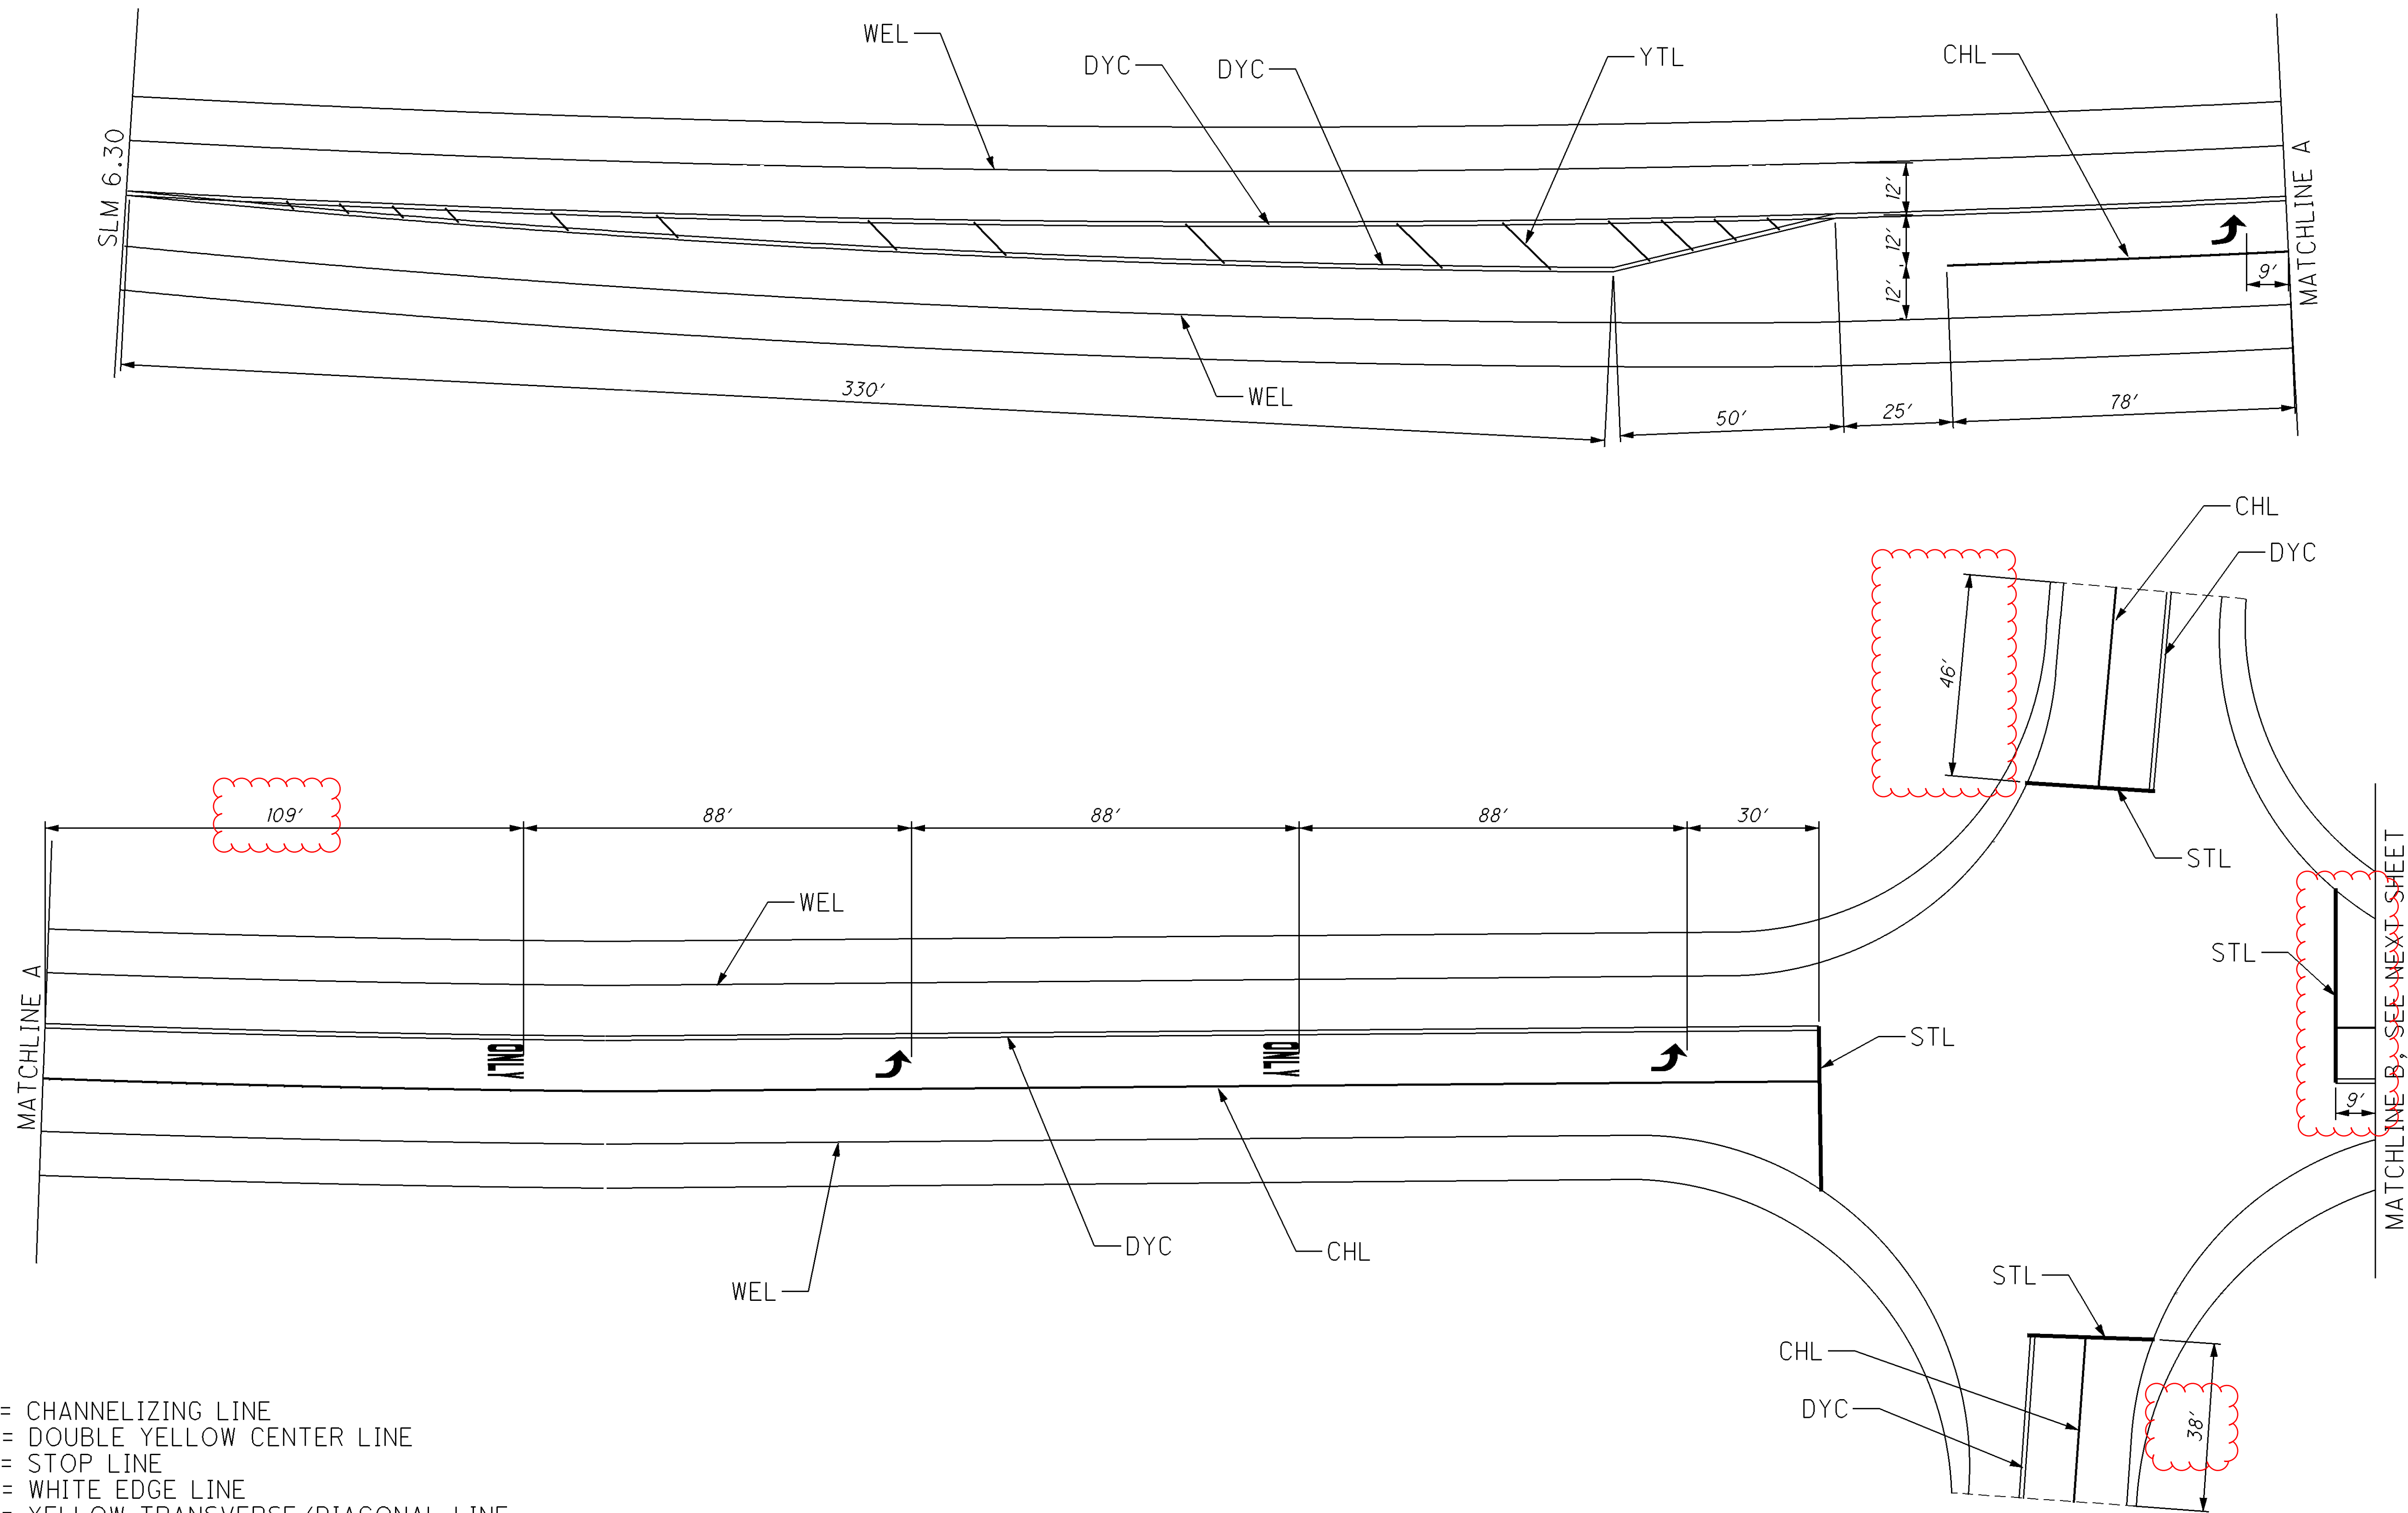

SEE SHEET 21-24 FOR PAVEMENT MARKING QUANTITIES



CHL = CHANNELIZING LINE  
DYC = DOUBLE YELLOW CENTER LINE  
STL = STOP LINE  
WEL = WHITE EDGE LINE  
YTL = YELLOW TRANSVERSE/DIAGONAL LINE

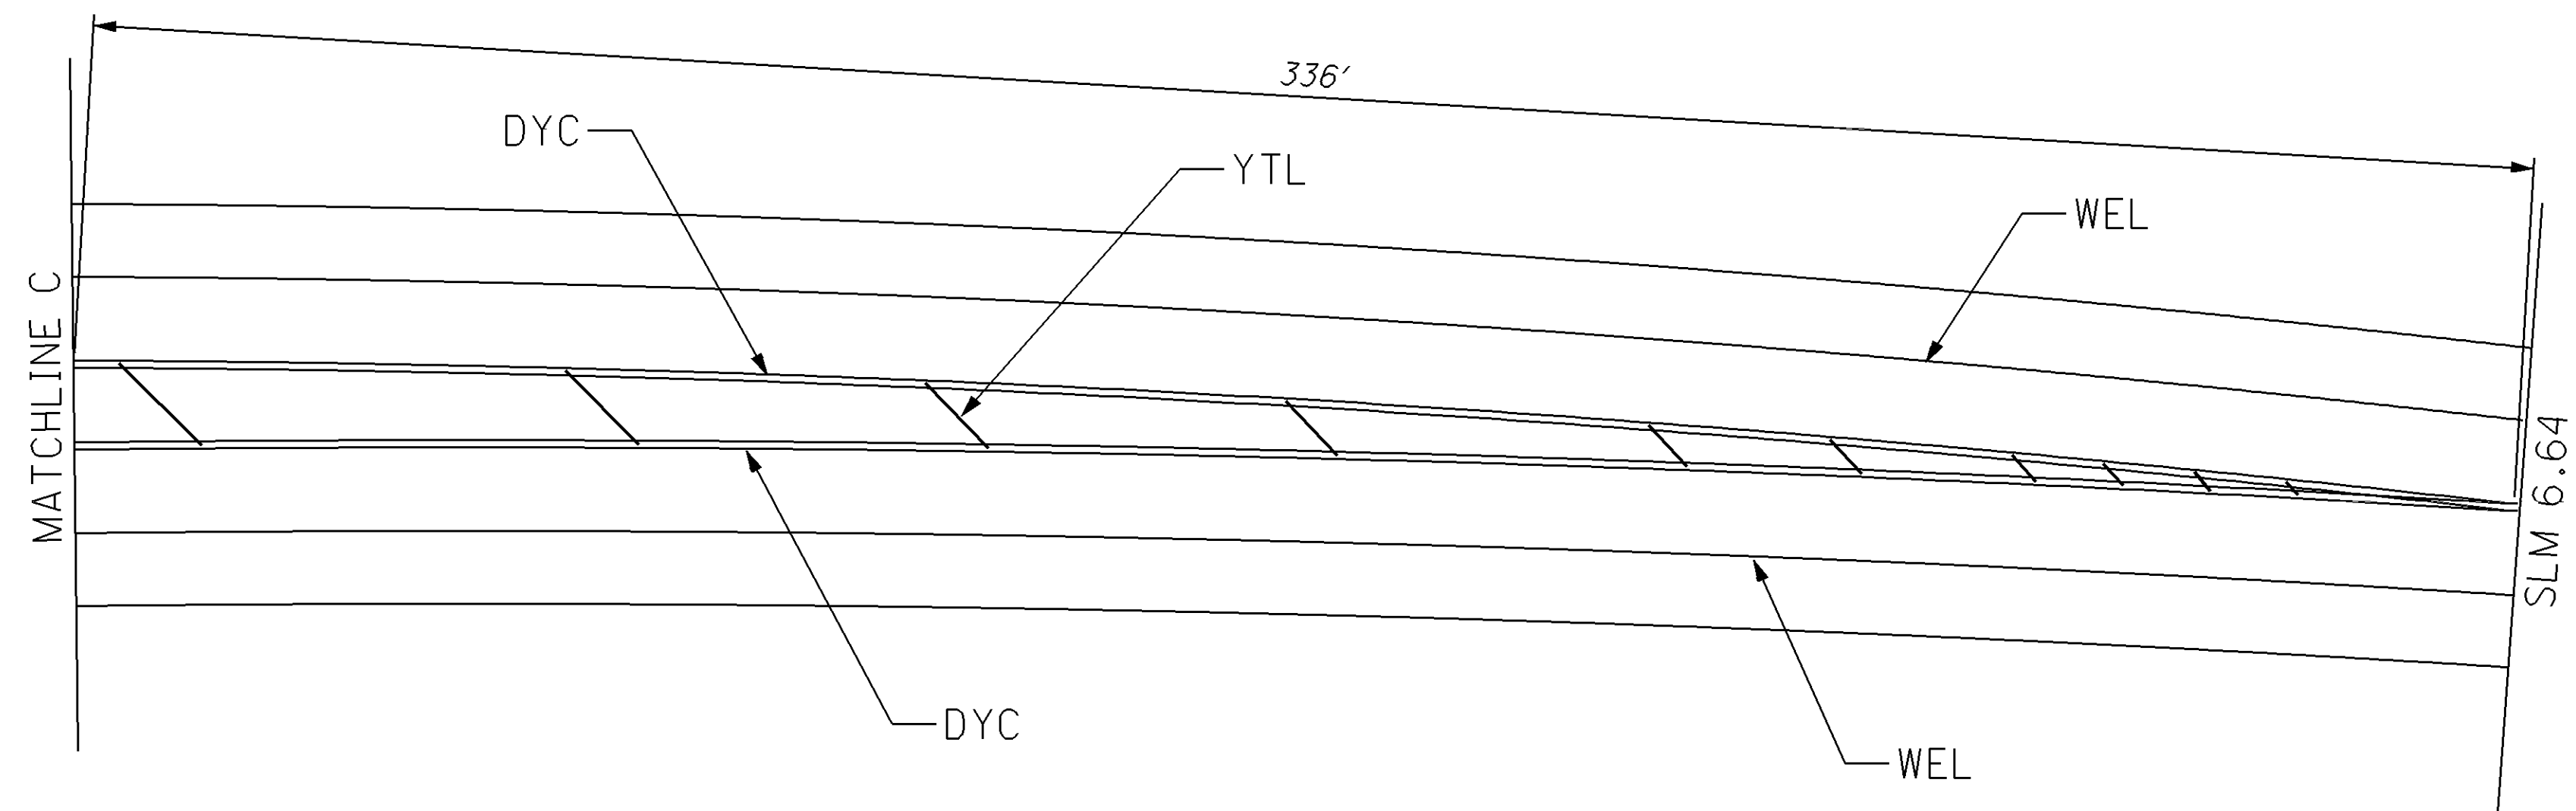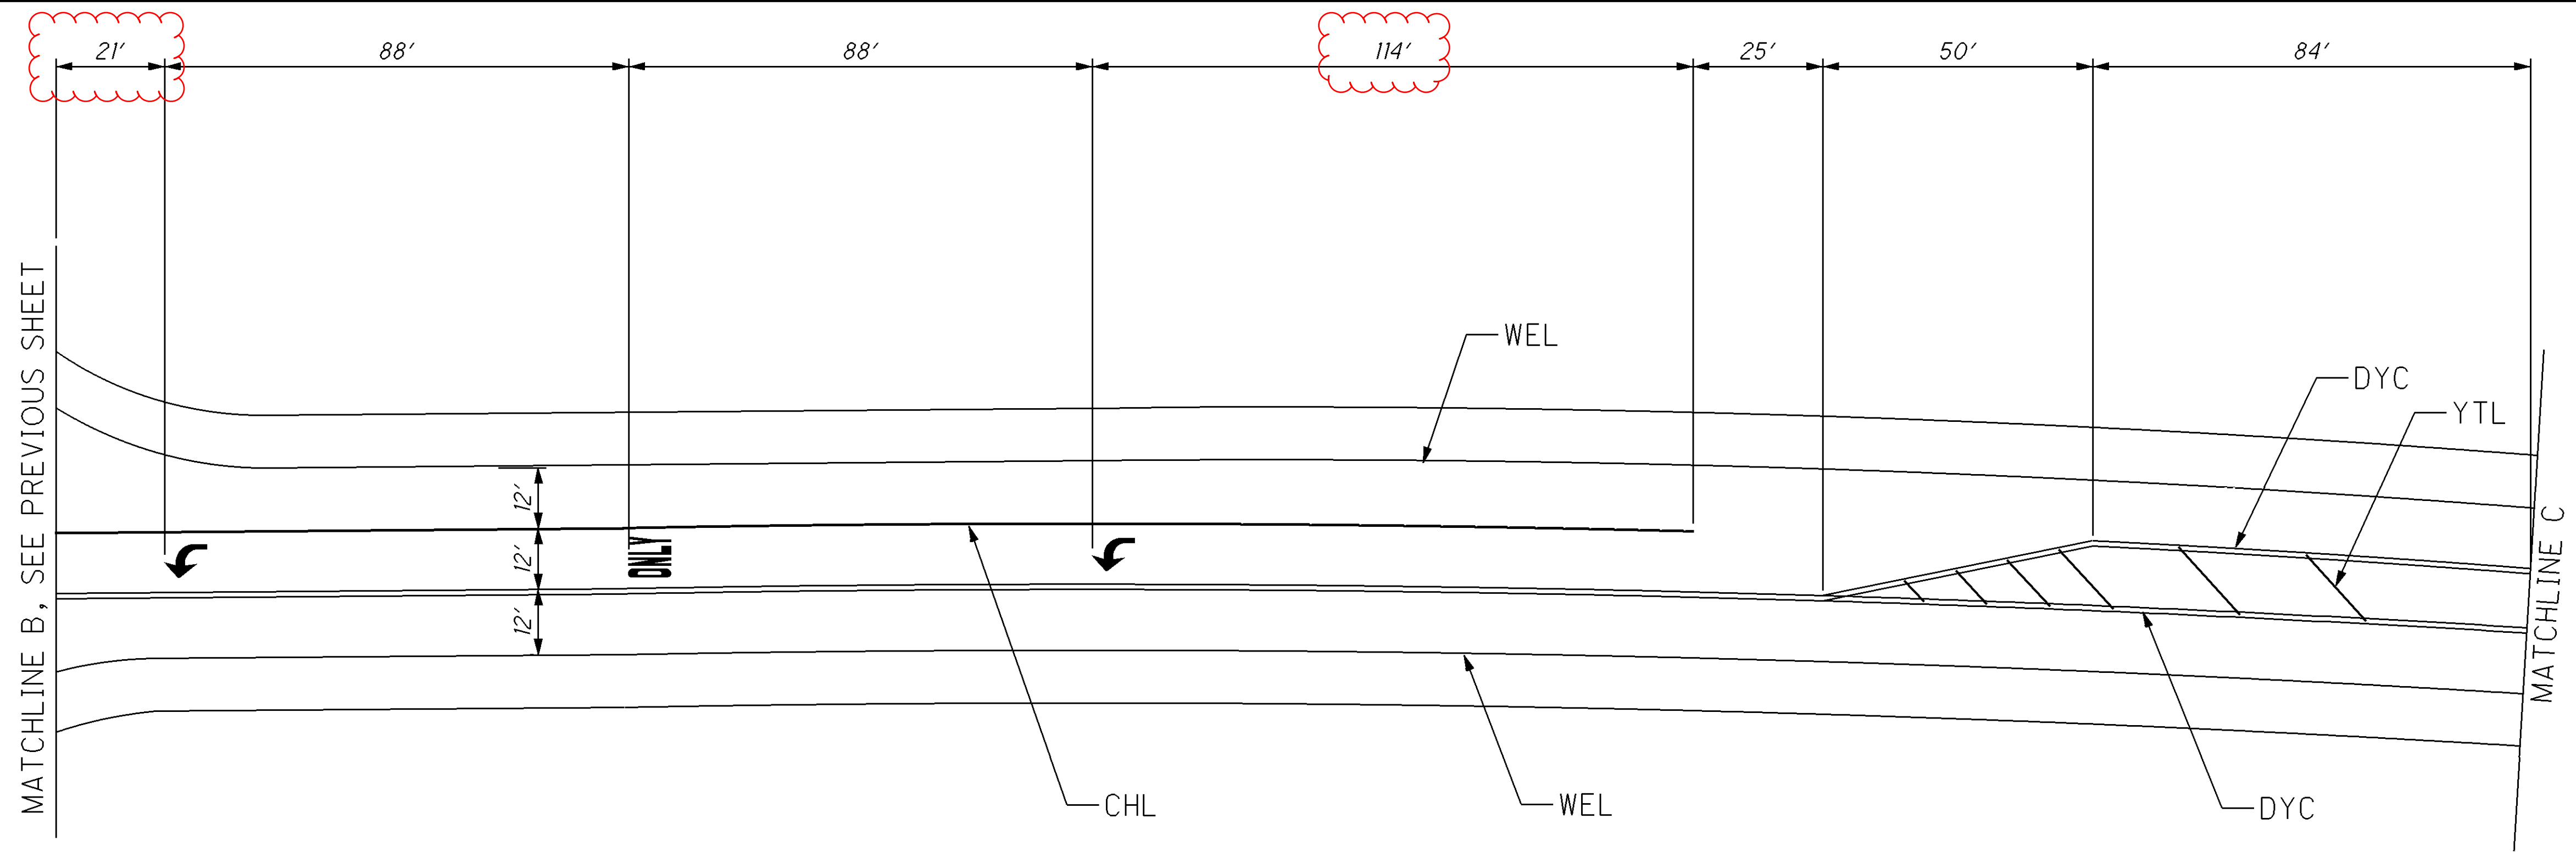


SEE SHEET 21-24 FOR PAVEMENT MARKING QUANTITIES



SHEET  
NOT  
USED



SHEET  
NOT  
USED

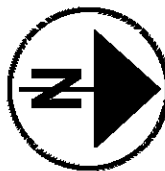




SHEET  
NOT  
USED




I:\ProjectData\LIC\92958\Design\Roadway\Sheets\92958\_GY001.dgn 02-MAR-2017 2:45PM jlut1

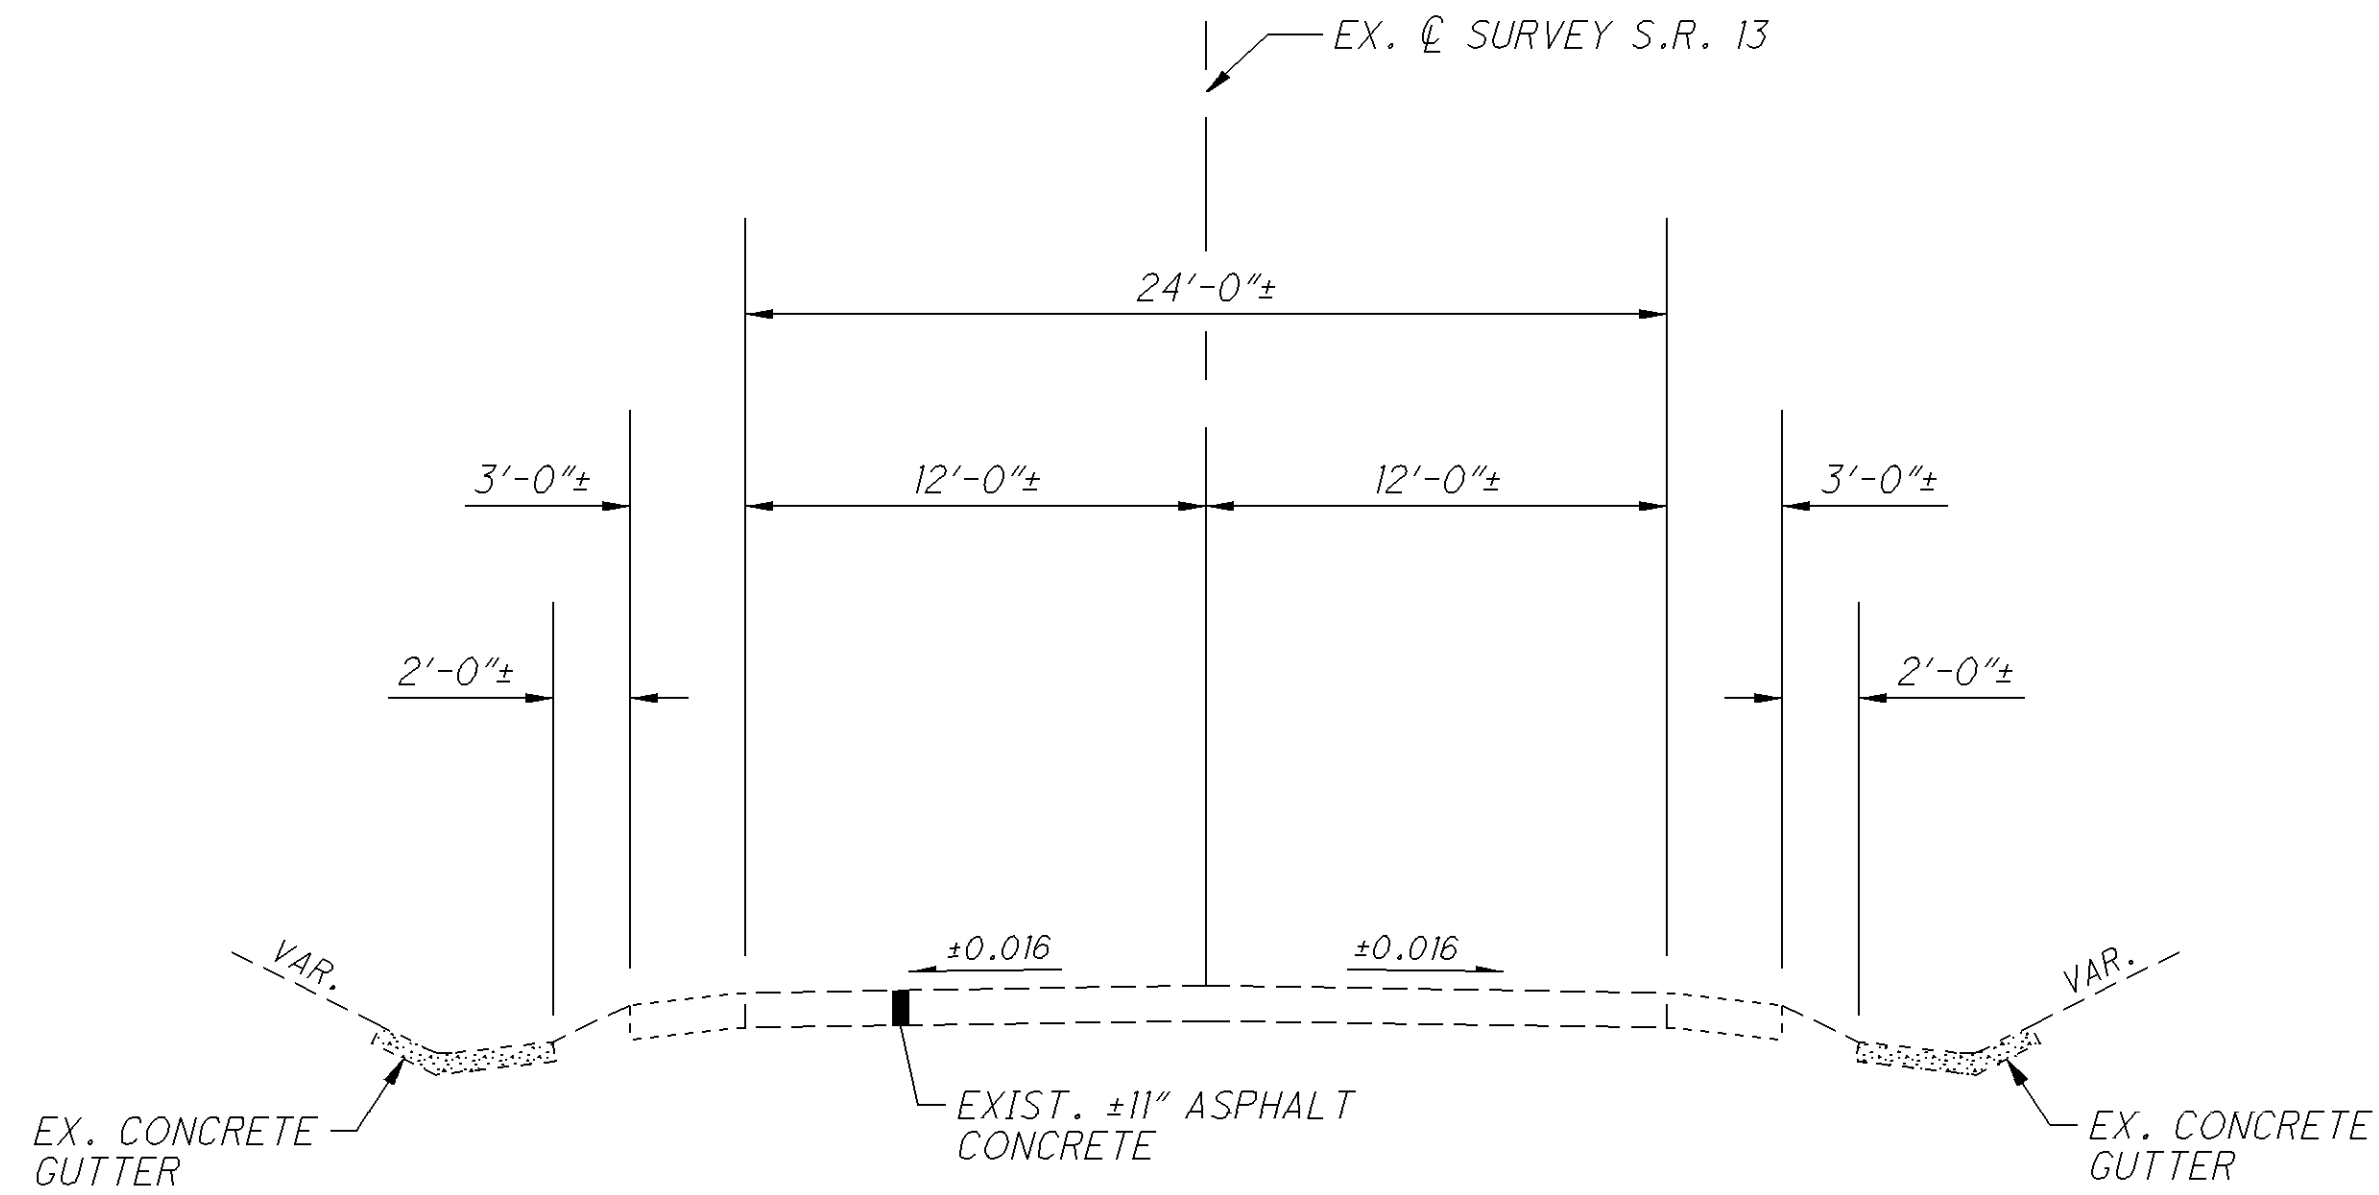

S.R. 13 (EXISTING)  
NORMAL SECTION APPLIES:  
STA. 202+47.06 TO STA. 211+99.98 = 952.92 FT.  
TOTAL 952.92 FT.

LEGEND


- ① ITEM 441, 1 1/2" ASPHALT CONCRETE SURFACE COURSE, TYPE 1, (448), PG64-22
- ② ITEM 441, 1 3/4" ASPHALT CONCRETE INTERMEDIATE COURSE, TYPE 2, (448)
- ③ ITEM 407, NON-TRACKING TACK COAT (@ 0.05 GAL/SY)
- ④ ITEM 407, NON-TRACKING TACK COAT (@ 0.075 GAL/SY)

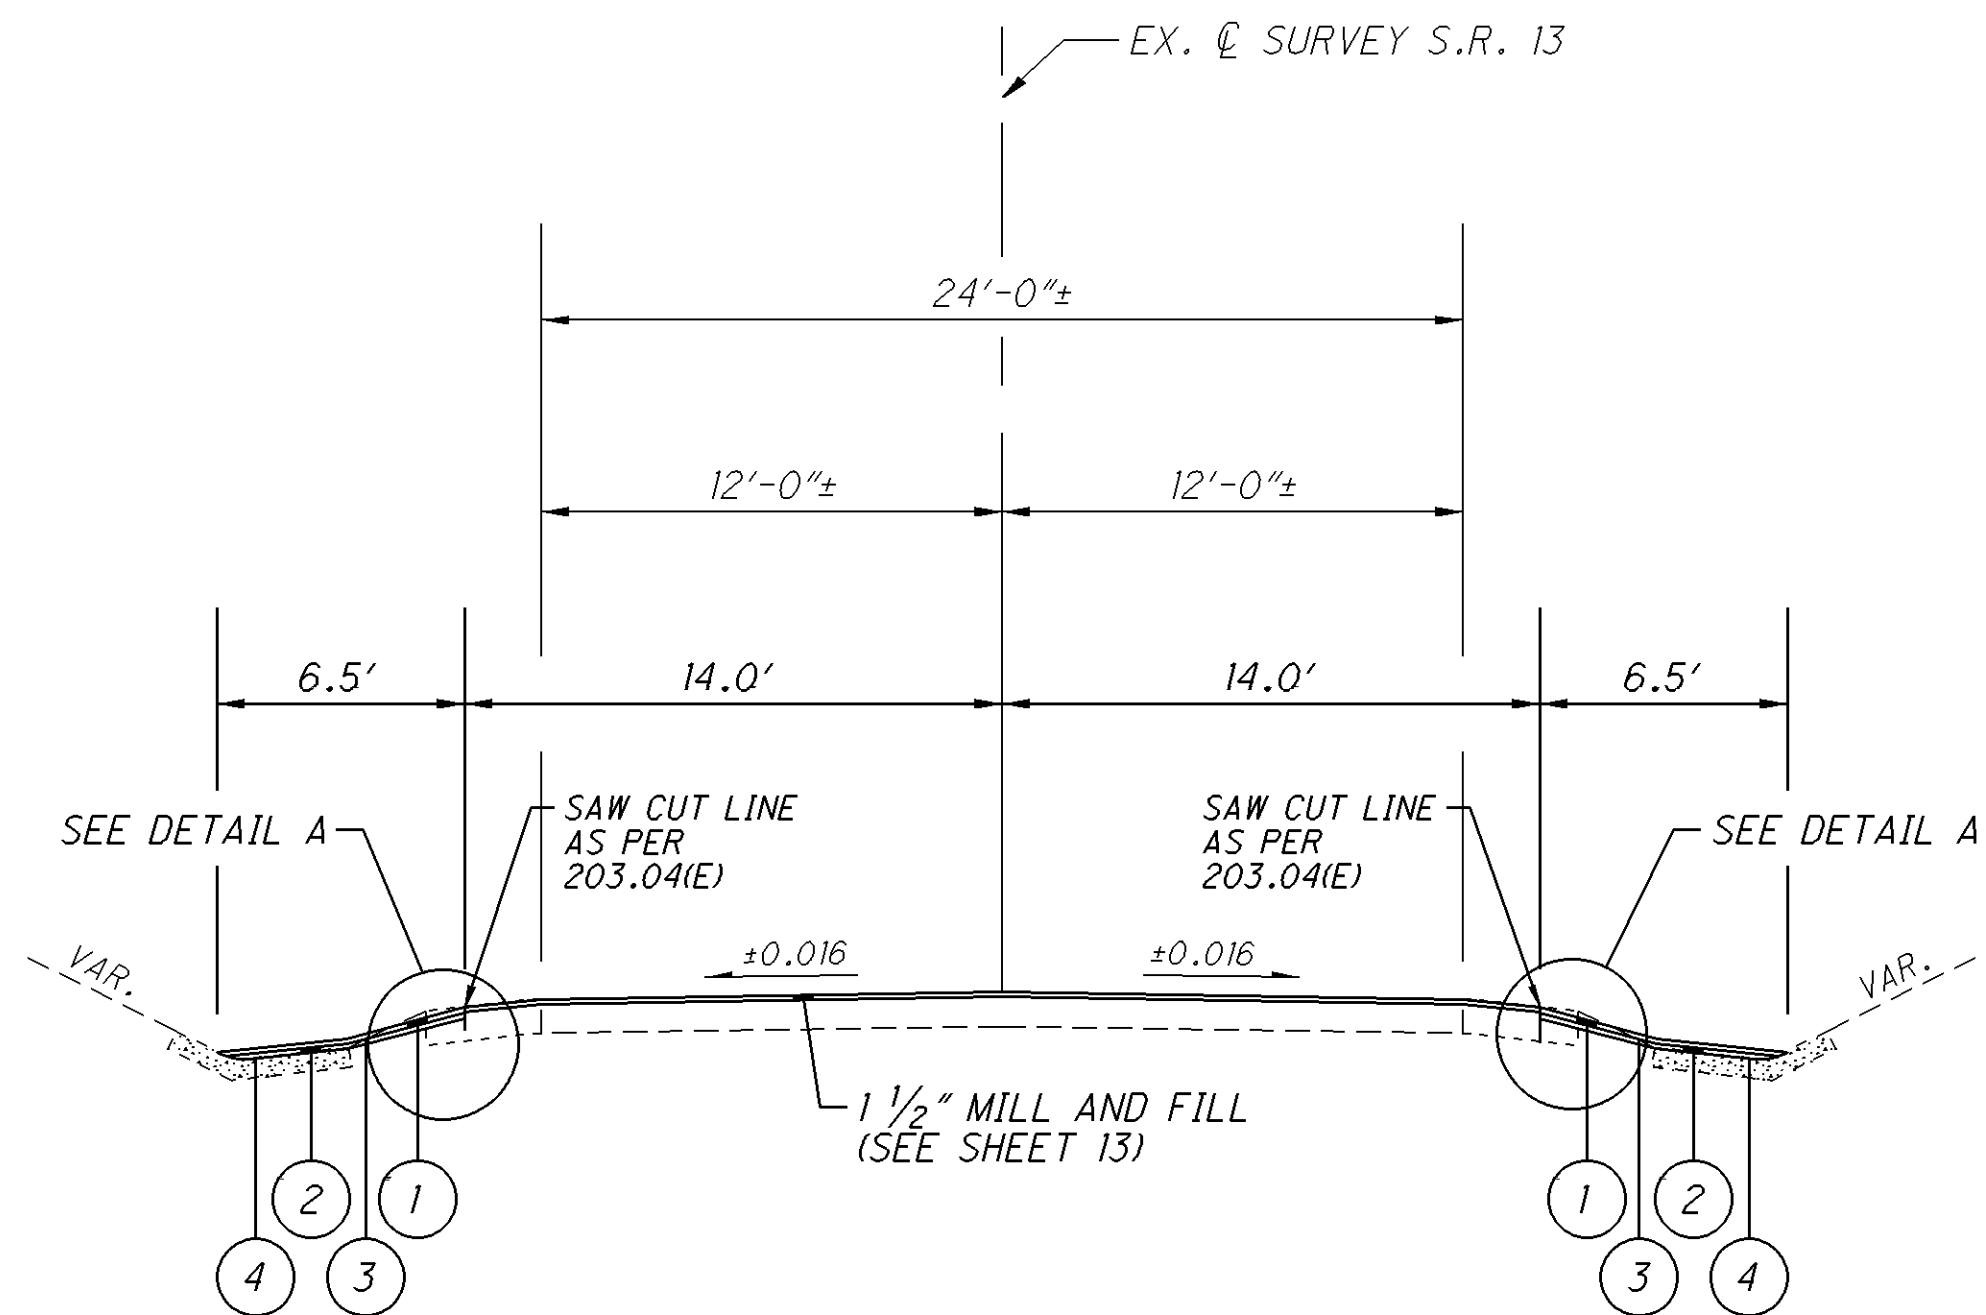

S.R. 13 (PROPOSED)  
GUTTER LIMITS (LT.):

STA. 202+47.06 TO STA. 211+99.22 = 952.16 FT.  
TOTAL 952.16 FT.

**DETAIL A**

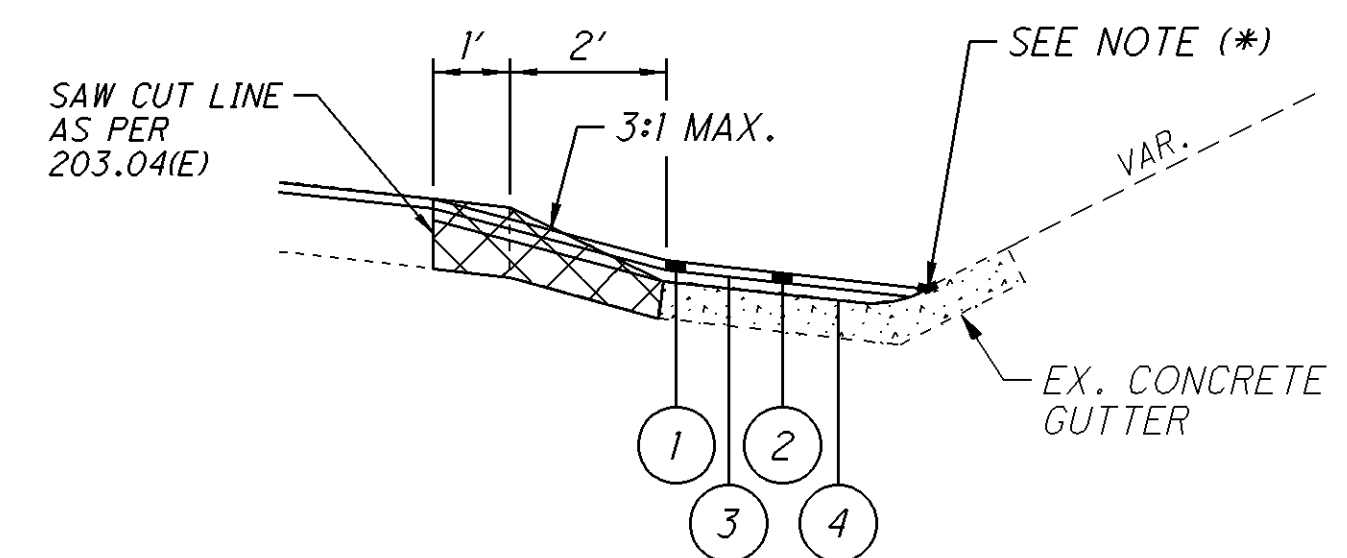

ITEM 203, EXCAVATION (6" AVG.)  
ITEM 203, EMBANKMENT (4.5" AVG.)

(\*) - SEAL THE JOINT BETWEEN THE PROP. ASPHALT CONCRETE AND EXIST. CONCRETE GUTTER WITH 4" BAND OF ITEM 407, NON-TRACKING TACK COAT (@ 0.075 GAL/SY).

S.R. 13 (PROPOSED)  
GUTTER LIMITS (RT.):

STA. 203+43.29 TO STA. 211+99.98 = 856.69 FT.  
TOTAL 856.69 FT.



| Reference No.                               | Sheet No. | Location                         | Side    | Length   | Width | Area    | 202                 |                                | 203          |              | 407                                         |                                              | 441                                                           |                                                              | 602              | 611                    |
|---------------------------------------------|-----------|----------------------------------|---------|----------|-------|---------|---------------------|--------------------------------|--------------|--------------|---------------------------------------------|----------------------------------------------|---------------------------------------------------------------|--------------------------------------------------------------|------------------|------------------------|
|                                             |           |                                  |         |          |       |         | HEADWALL<br>REMOVED | PIPE REMOVED,<br>24" AND UNDER | 6.00" (Avg.) | 4.50" (Avg.) | NON-TRACKING<br>TACK COAT<br>(@0.05 Gal/SY) | NON-TRACKING<br>TACK COAT<br>(@0.075 Gal/SY) | 1.50"                                                         | 1.75"                                                        |                  |                        |
|                                             |           |                                  | Lt./Rt. | Lin. Ft. | Ft.   | Sq. Yd. |                     |                                | EXCAVATION   | EMBANKMENT   |                                             |                                              | ASPHALT CONCRETE<br>SURFACE COURSE,<br>TYPE 1, (448), PG64-22 | ASPHALT CONCRETE<br>INTERMEDIATE<br>COURSE,<br>TYPE 2, (448) | CONCRETE MASONRY | 15" CONDUIT,<br>TYPE B |
|                                             |           | S.R. 13                          |         |          |       |         |                     |                                |              |              |                                             |                                              |                                                               |                                                              |                  |                        |
| P-1                                         | 45        | Sta. 202+47.06 to Sta. 206+74.94 | Lt.     | 427.88   | 6.5   | 309.1   |                     |                                |              |              | 15.5                                        | 23.2                                         | 12.9                                                          | 15.0                                                         |                  |                        |
| P-2                                         | 45-46     | Sta. 203+43.29 to Sta. 211+99.98 | Rt.     | 856.69   | 6.5   | 618.8   |                     |                                |              |              | 30.9                                        | 46.4                                         | 25.8                                                          | 30.1                                                         |                  |                        |
| P-3                                         | 45-46     | Sta. 207+28.35 to Sta. 211+99.22 | Lt.     | 470.87   | 6.5   | 340.1   |                     |                                |              |              | 17.0                                        | 25.5                                         | 14.2                                                          | 16.5                                                         |                  |                        |
|                                             |           |                                  |         |          |       |         |                     |                                |              |              |                                             |                                              |                                                               |                                                              |                  |                        |
| EW-1                                        | 45        | Sta. 202+47.06 to Sta. 206+74.94 | Lt.     | 427.88   | 3.0   | 142.7   |                     |                                | 23.8         | 17.8         |                                             | 0.9(*)                                       |                                                               |                                                              |                  |                        |
| EW-2                                        | 45-46     | Sta. 203+43.29 to Sta. 211+99.98 | Rt.     | 856.69   | 3.0   | 285.6   |                     |                                | 47.6         | 35.7         |                                             | 1.8(*)                                       |                                                               |                                                              |                  |                        |
| EW-3                                        | 45-46     | Sta. 207+28.35 to Sta. 211+99.22 | Lt.     | 470.87   | 3.0   | 157.0   |                     |                                | 26.2         | 19.6         |                                             | 1.0(*)                                       |                                                               |                                                              |                  |                        |
|                                             |           |                                  |         |          |       |         |                     |                                |              |              |                                             |                                              |                                                               |                                                              |                  |                        |
| D-1                                         | 45, 47    | Sta. 206+74.94 to Sta. 207+28.35 | Lt.     |          |       |         | 1                   | 40                             |              |              |                                             |                                              |                                                               |                                                              | 0.54             | 54                     |
|                                             |           |                                  |         |          |       |         |                     |                                |              |              |                                             |                                              |                                                               |                                                              |                  |                        |
|                                             |           |                                  |         |          |       |         |                     |                                |              |              |                                             |                                              |                                                               |                                                              |                  |                        |
| Totals (Carried to Location 1b Sub-Summary) |           |                                  |         |          |       |         | 1                   | 40                             | 98           | 74           | 64                                          | 99                                           | 53                                                            | 62                                                           | 0.54             | 54                     |


(\*) - Additonal for sealing Proposed Pavement and Existing Gutter

| Reference No.                               | Sheet No. | Location      | Side    | Description | Exist. Surface | Apron Area<br>(Calculated By Computer) | Treated Area<br>(Calculated By Computer) | Total Area<br>(Apron Area + Treated Area) | 202                          | 203        | 204                    | 301                                             | 304            | 407                                                | 441                                                              |
|---------------------------------------------|-----------|---------------|---------|-------------|----------------|----------------------------------------|------------------------------------------|-------------------------------------------|------------------------------|------------|------------------------|-------------------------------------------------|----------------|----------------------------------------------------|------------------------------------------------------------------|
|                                             |           |               |         |             |                |                                        |                                          |                                           | PAVEMENT REMOVED,<br>ASPHALT | EMBANKMENT | SUBGRADE<br>COMPACTION | 4.75"                                           | 8.00"          | NON-TRACKING<br>TACK COAT,<br>@ 0.040 GAL./SQ. YD. | ASPHALT CONCRETE<br>SURFACE COURSE,<br>TYPE 1, (448), (DRNEWAYS) |
|                                             |           |               | Lt./Rt. |             |                |                                        |                                          |                                           |                              |            |                        | ASPHALT CONCRETE<br>BASE,<br>PG64-22 (DRNEWAYS) | AGGREGATE BASE |                                                    |                                                                  |
|                                             |           | S.R. 13       |         |             |                |                                        |                                          |                                           |                              |            |                        |                                                 |                |                                                    |                                                                  |
| DR-1                                        | 45, 47    | Sta. 207+03.9 | Lt.     | Residential | Aggregate      | 11.2                                   | 12.8                                     | 24.0                                      | 16.1                         | 10(*)      | 11.2                   | 1.5                                             | 1.7            | 0.5                                                | 0.4                                                              |
|                                             |           |               |         |             |                |                                        |                                          |                                           |                              |            |                        |                                                 |                |                                                    |                                                                  |
|                                             |           |               |         |             |                |                                        |                                          |                                           |                              |            |                        |                                                 |                |                                                    |                                                                  |
| Totals (Carried to Location 1b Sub-Summary) |           |               |         |             |                |                                        |                                          |                                           | 17                           | 10         | 12                     | 2                                               | 2              | 1                                                  | 1                                                                |


(\*) - Quantity to be used for the grading of the adjacent drive areas



I:\ProjectData\LIC\92958\Design\Roadway\Sheets\92958\_TDO01.dgn 10-JUL-2017 2:21PM jltz1

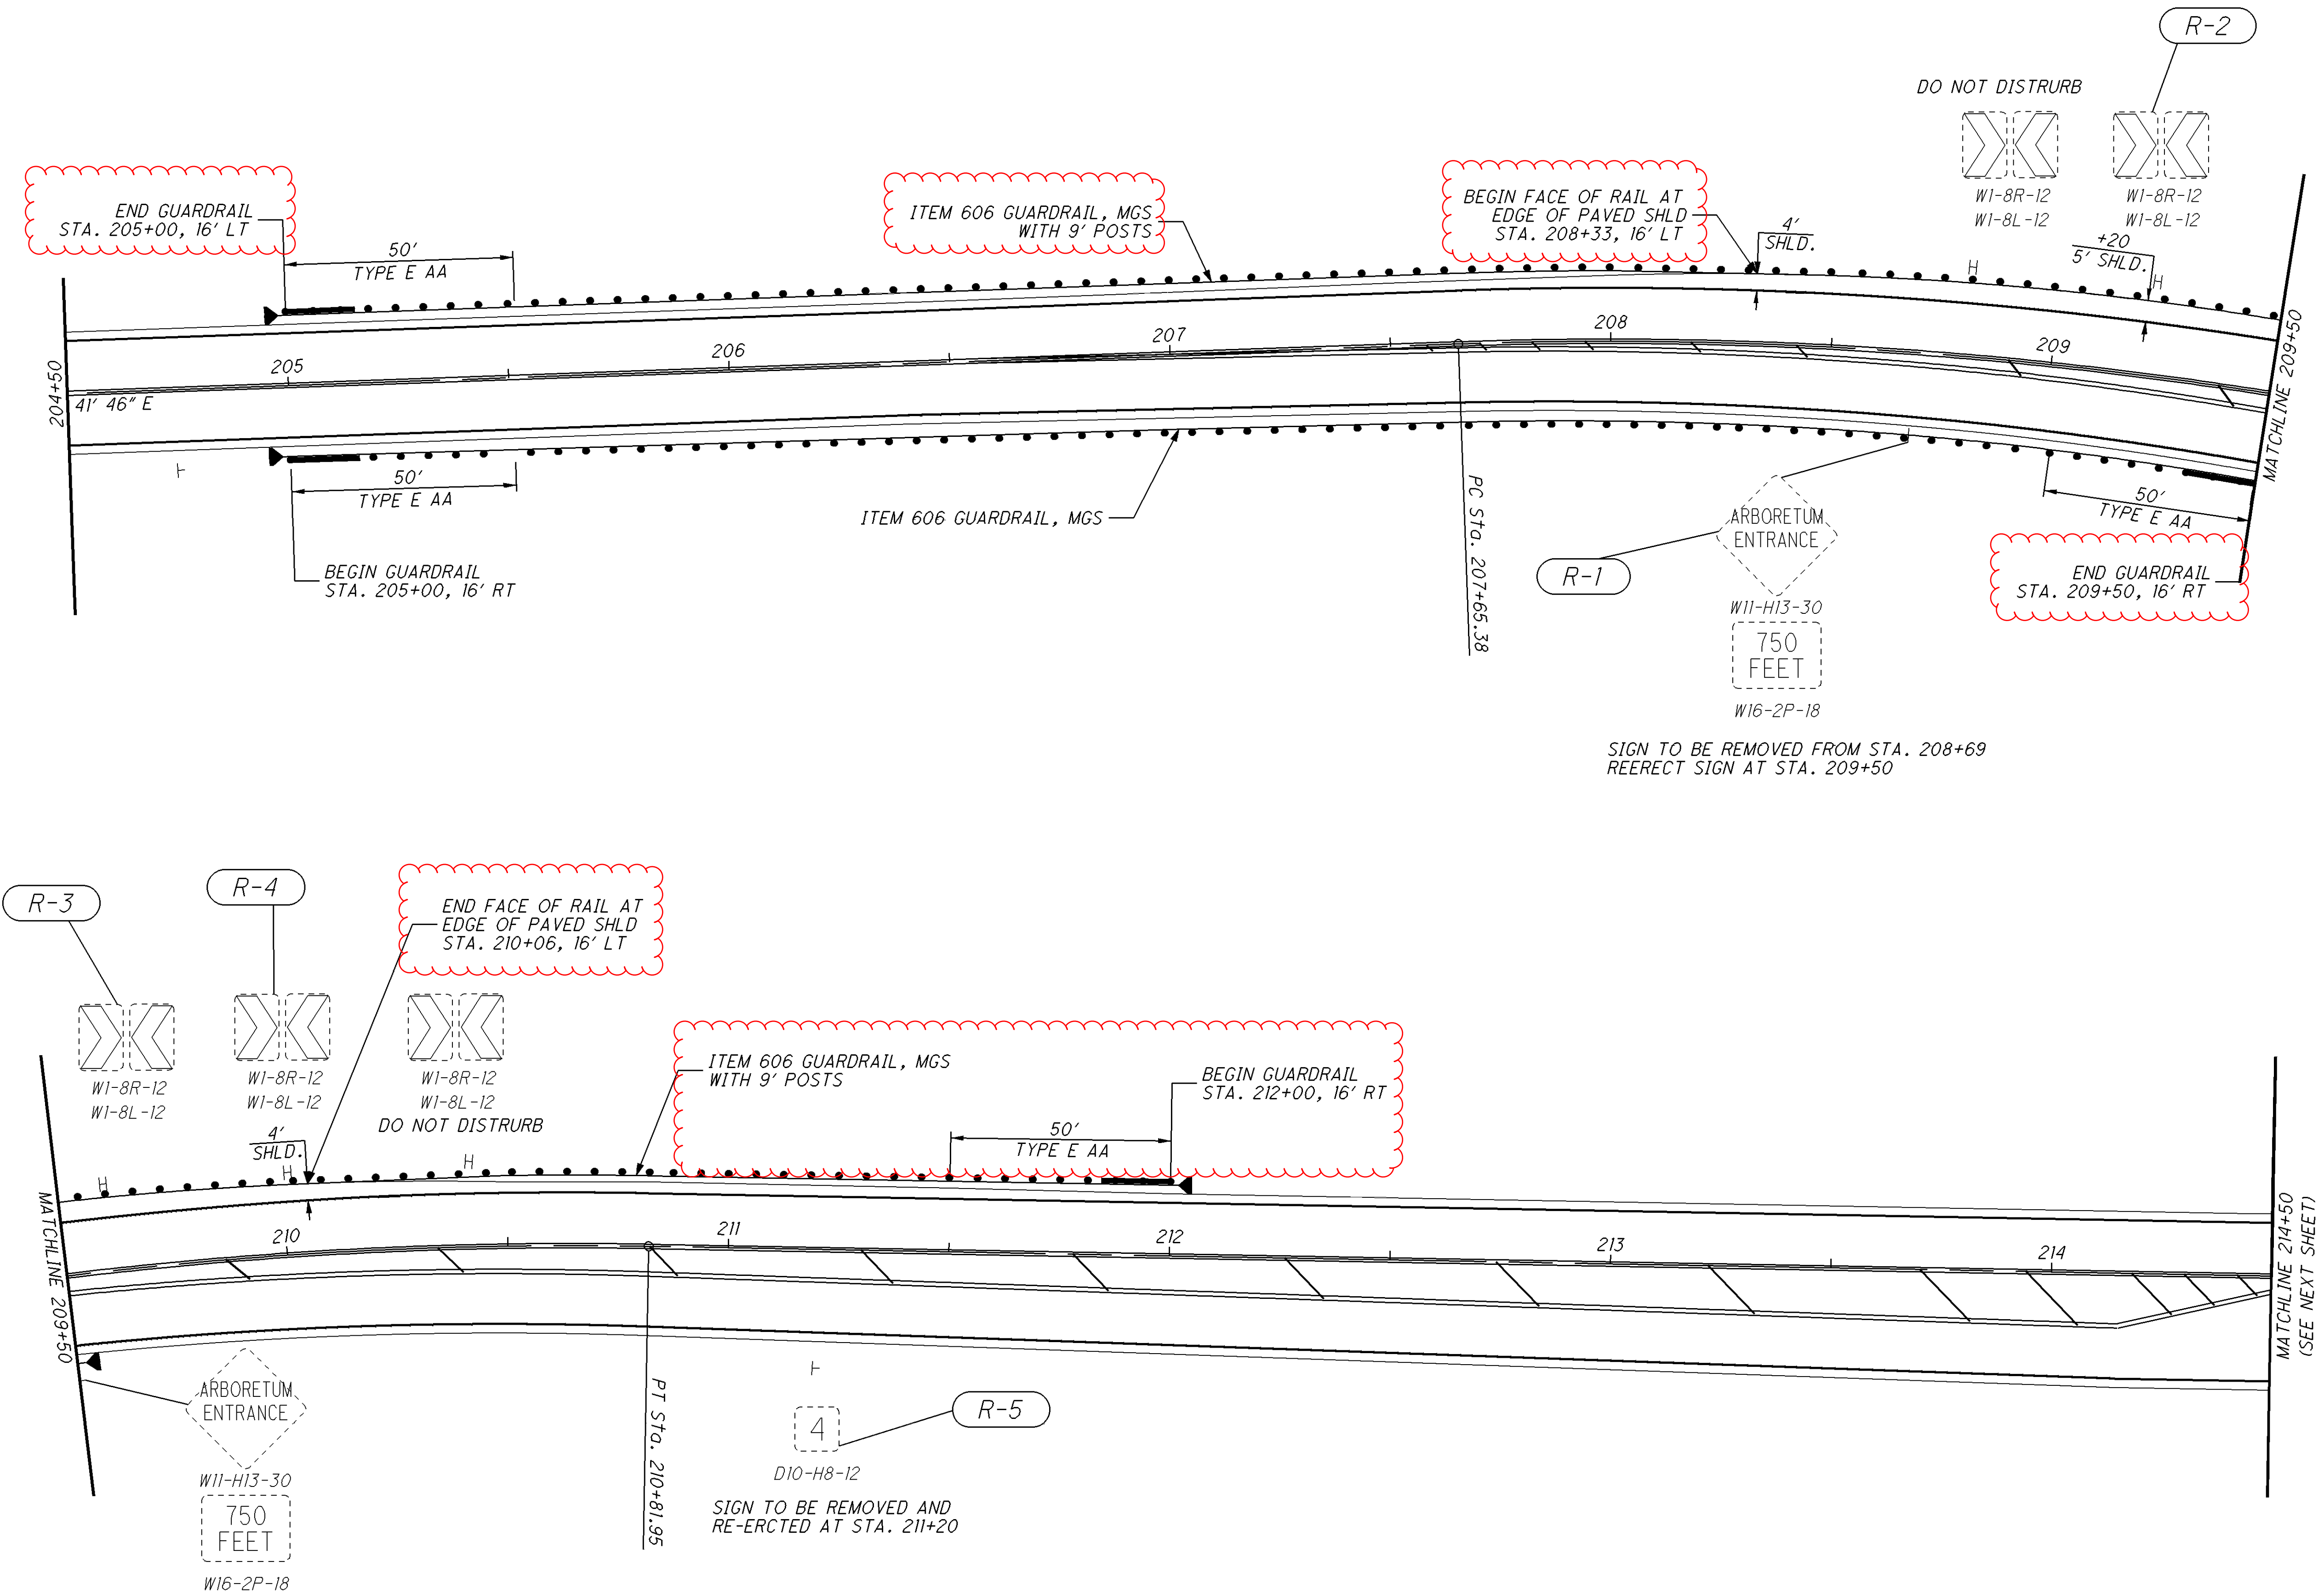

SEE NEXT SHEET FOR SIGN QUANTITIES  
SEE NEXT SHEET FOR GUARDRAIL QUANTITIES

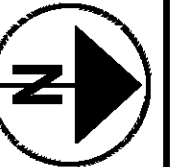

CALCULATED  
LME  
CHECKED  
JSL


TRAFFIC CONTROL PLAN SHEET  
GUARDRAIL/SIGNS DAWES ARBORETUM

LIC-13-0.00




| Reference No.                               | Sheet No. | Location                                | Side | Sign Code | Sign Size<br>(Inches) | 202               | 606                 | 606                                         | 606                            | 626                          | 630                                   | 630              | 630                                               | 630                                                 | 630                                                          |
|---------------------------------------------|-----------|-----------------------------------------|------|-----------|-----------------------|-------------------|---------------------|---------------------------------------------|--------------------------------|------------------------------|---------------------------------------|------------------|---------------------------------------------------|-----------------------------------------------------|--------------------------------------------------------------|
|                                             |           |                                         |      |           |                       | GUARDRAIL REMOVED | GUARDRAIL, TYPE MGS | GUARDRAIL, TYPE MGS<br>WITH LONG POSTS (9') | ANCHOR ASSEMBLY,<br>MGS TYPE E | BARRIER REFLECTOR,<br>TYPE 2 | GROUND MOUNTED<br>SUPPORT, NO. 3 POST | SIGN, FLAT SHEET | REMOVAL OF GROUND<br>MOUNTED SIGN AND<br>DISPOSAL | REMOVAL OF GROUND<br>MOUNTED SIGN AND<br>REERECTION | REMOVAL OF GROUND<br>MOUNTED POST<br>SUPPORT AND<br>DISPOSAL |
|                                             |           |                                         |      |           |                       | FEET              | FEET                | FEET                                        | EACH                           | EACH                         | FEET                                  | SF               | EACH                                              | EACH                                                | EACH                                                         |
|                                             |           | S.R. 13 AT DAWES ARBORETUM              |      |           |                       |                   |                     |                                             |                                |                              |                                       |                  |                                                   |                                                     |                                                              |
|                                             | 49        | STA. 206+49 TO STA. 207+99              | LT.  |           |                       | 150               |                     |                                             |                                |                              |                                       |                  |                                                   |                                                     |                                                              |
|                                             | 49        | STA. 206+06 TO STA. 207+56              | RT.  |           |                       | 150               |                     |                                             |                                |                              |                                       |                  |                                                   |                                                     |                                                              |
|                                             |           |                                         |      |           |                       |                   |                     |                                             |                                |                              |                                       |                  |                                                   |                                                     |                                                              |
|                                             | 49        | STA. 205+00 TO STA. 212+00              | LT.  |           |                       |                   |                     | 600.0                                       | 2                              | 10                           |                                       |                  |                                                   |                                                     |                                                              |
|                                             | 49        | STA. 205+00 TO STA. 209+50              | RT.  |           |                       |                   | 350.0               |                                             | 2                              | 6                            |                                       |                  |                                                   |                                                     |                                                              |
|                                             |           |                                         |      |           |                       |                   |                     |                                             |                                |                              |                                       |                  |                                                   |                                                     |                                                              |
| R-1                                         | 49        | REMOVE STA. 208+69, REERECT STA. 209+50 | RT.  | W11-H13   |                       |                   |                     |                                             |                                |                              | 14.0                                  |                  |                                                   | 1                                                   | 1                                                            |
|                                             |           |                                         |      | W16-2P    |                       |                   |                     |                                             |                                |                              |                                       |                  |                                                   | 1                                                   |                                                              |
| R-2                                         | 49        |                                         | LT.  | W1-8R     |                       |                   |                     |                                             |                                |                              |                                       |                  | 1                                                 |                                                     | 1                                                            |
|                                             |           |                                         |      | W1-8L     |                       |                   |                     |                                             |                                |                              |                                       |                  | 1                                                 |                                                     |                                                              |
| R-3                                         | 49        |                                         | LT.  | W1-8R     |                       |                   |                     |                                             |                                |                              |                                       |                  | 1                                                 |                                                     | 1                                                            |
|                                             |           |                                         |      | W1-8L     |                       |                   |                     |                                             |                                |                              |                                       |                  | 1                                                 |                                                     |                                                              |
| R-4                                         | 49        |                                         | LT.  | W1-8R     |                       |                   |                     |                                             |                                |                              |                                       |                  | 1                                                 |                                                     | 1                                                            |
|                                             |           |                                         |      | W1-8L     |                       |                   |                     |                                             |                                |                              |                                       |                  | 1                                                 |                                                     |                                                              |
| R-5                                         | 49        | STA. 211+20                             | RT.  | D10-H8    |                       |                   |                     |                                             |                                |                              | 8.5                                   |                  |                                                   | 1                                                   | 1                                                            |
|                                             |           |                                         |      |           |                       |                   |                     |                                             |                                |                              |                                       |                  |                                                   |                                                     |                                                              |
| S-1                                         | 50        | STA. 214+65                             | RT.  | R3-H8ba   | 30 x 30               |                   |                     |                                             |                                |                              | 12.0                                  | 6.25             |                                                   |                                                     |                                                              |
|                                             |           |                                         |      |           |                       |                   |                     |                                             |                                |                              |                                       |                  |                                                   |                                                     |                                                              |
| TOTALS (CARRIED TO LOCATION 1B SUB-SUMMARY) |           |                                         |      |           |                       | 300               | 350.0               | 600.0                                       | 4                              | 16                           | 34.5                                  | 6.25             | 6                                                 | 3                                                   | 5                                                            |

MATCHLINE 214+50  
(SEE PREVIOUS SHEET)

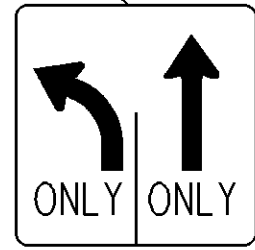



R3-H8BA-30  
STA. 214+65 RIGHT

S-1

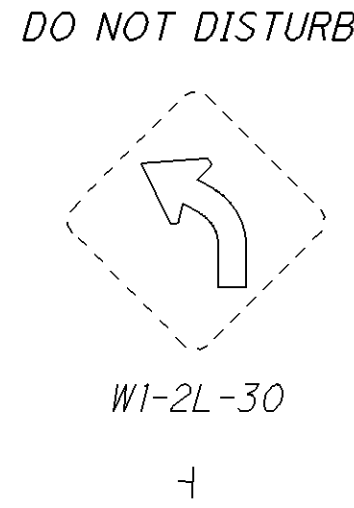

DO NOT DISTURB

W1-2L-30

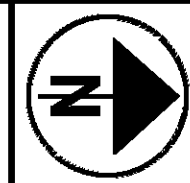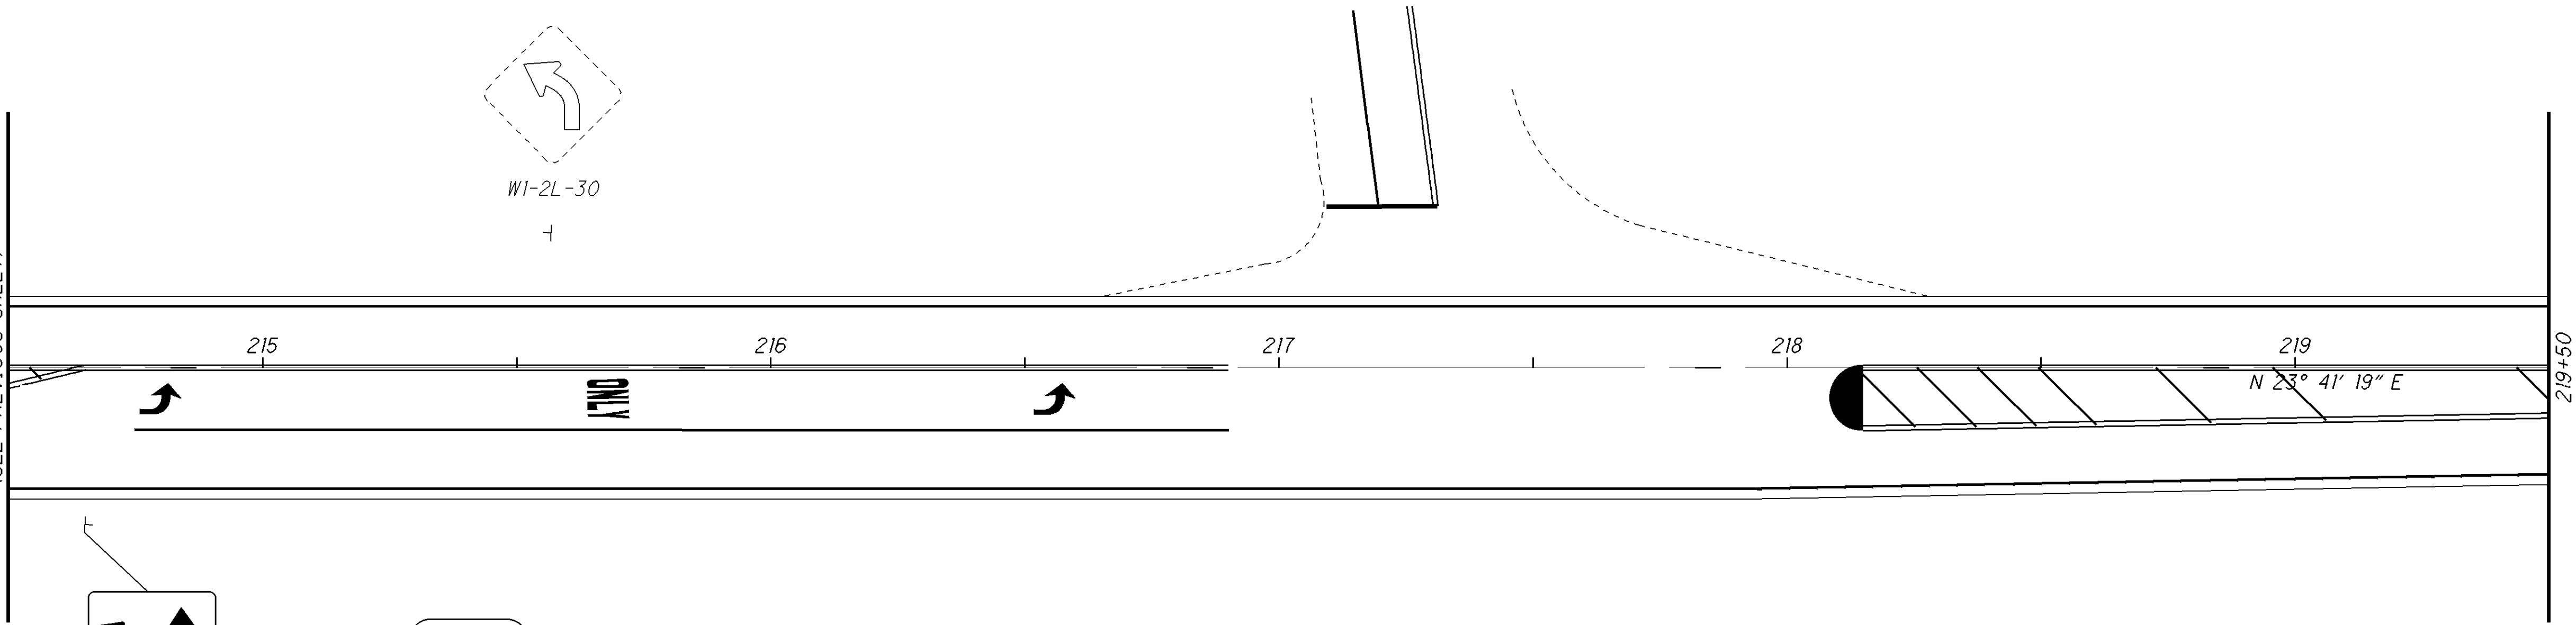

CALCULATED  
LME  
CHECKED  
JSL

TRAFFIC CONTROL PLAN/QUANTITIES SHEET  
SIGNAGE AT DAWES ARBORETUM

LIC-13-0.00

50  
90



I:\ProjectData\LIC\92958\Design\Roadway\Sheets\92958\_GS001.dgn 02-MAR-2017 2:05PM jlutzi

| LOCATION 1A SHEET TOTALS |     |   |   |    |       |       |       |      |      |     |    | ITEM | ITEM EXT. | GRAND TOTALS | UNIT | DESCRIPTION                                              |
|--------------------------|-----|---|---|----|-------|-------|-------|------|------|-----|----|------|-----------|--------------|------|----------------------------------------------------------|
| 2                        | 3   | 4 | 5 | 6  | 13    | 16    | 17    | 21   | 22   | 23  | 42 |      |           |              |      |                                                          |
|                          |     |   |   |    |       |       |       |      |      |     |    |      |           |              |      | ROADWAY                                                  |
|                          | 330 |   |   |    |       |       | 1,086 |      |      |     |    | 202  | 23500     | 1,416        | SY   | WEARING COURSE REMOVED                                   |
|                          |     |   |   |    |       | 1.08  |       |      |      |     |    | 209  | 72501     | 1.08         | MILE | PREPARING SUBGRADE FOR SHOULDER PAVING, AS PER PLAN      |
|                          |     |   |   |    |       |       |       |      |      |     |    |      |           |              |      | PAVEMENT                                                 |
| 100                      |     |   |   |    |       |       |       |      |      |     |    | 253  | 02000     | 100          | CY   | PAVEMENT REPAIR                                          |
|                          |     |   |   |    | 8,730 | 1,901 |       |      |      |     |    | 254  | 01000     | 10,631       | SY   | PAVEMENT PLANING, ASPHALT CONCRETE , 1.50"               |
|                          | 1   |   |   |    |       |       |       |      |      |     |    | 304  | 20000     | 1            | CY   | AGGREGATE BASE                                           |
|                          |     |   |   |    | 655   | 143   | 82    |      |      |     |    | 407  | 20000     | 880          | GAL  | NON-TRACKING TACK COAT                                   |
|                          |     |   |   |    |       | 507   |       |      |      |     |    | 408  | 10001     | 507          | GAL  | PRIME COAT, AS PER PLAN                                  |
|                          |     |   |   |    |       |       | 46    |      |      |     |    | 441  | 50000     | 46           | CY   | ASPHALT CONCRETE SURFACE COURSE, TYPE 1, (448), PG64-22  |
|                          | 15  | 8 |   |    | 364   | 80    |       |      |      |     |    | 441  | 50100     | 467          | CY   | ASPHALT CONCRETE SURFACE COURSE, TYPE 1, (448), PG70-22M |
|                          |     |   |   |    |       |       |       |      |      |     |    | 441  | 50300     |              | CY   | ASPHALT CONCRETE INTERMEDIATE COURSE, TYPE 2, (448)      |
|                          |     |   |   |    |       | 71    |       |      |      |     |    | 617  | 10101     | 71           | CY   | COMPACTED AGGREGATE, AS PER PLAN                         |
|                          |     |   |   |    |       | 1,268 |       |      |      |     |    | 617  | 20000     | 1,268        | SY   | SHOULDER PREPARATION                                     |
|                          |     |   |   |    |       |       |       | 1.08 |      |     |    | 618  | 41000     | 1.08         | MILE | EDGE LINE, RUMBLE STRIPE (ASPHALT CONCRETE)              |
|                          |     |   |   |    |       |       |       |      |      |     |    |      |           |              |      | TRAFFIC CONTROL                                          |
|                          |     |   |   |    |       |       |       |      |      |     | 64 | 621  | 00100     | 64           | EACH | RPM                                                      |
|                          |     |   |   |    |       |       |       |      |      |     | 64 | 621  | 54000     | 64           | EACH | RAISED PAVEMENT MARKER REMOVED                           |
|                          |     |   |   |    |       |       |       |      |      | 323 |    | 644  | 00400     | 323          | FT   | CHANNELIZING LINE, 8"                                    |
|                          |     |   |   |    |       |       |       |      |      | 124 |    | 644  | 00500     | 124          | FT   | STOP LINE                                                |
|                          |     |   |   |    |       |       |       |      |      | 200 |    | 644  | 00700     | 200          | FT   | TRANSVERSE/DIAGONAL LINE                                 |
|                          |     |   |   |    |       |       |       |      |      | 3   |    | 644  | 01300     | 3            | EACH | LANE ARROW                                               |
|                          |     |   |   |    |       |       |       |      |      | 2   |    | 644  | 01410     | 2            | EACH | WORD ON PAVEMENT, 96"                                    |
|                          |     |   |   |    |       |       |       | 1.08 |      |     |    | 648  | 00104     | 1.08         | MILE | EDGE LINE, 6"                                            |
|                          |     |   |   |    |       |       |       |      | 0.54 |     |    | 648  | 00300     | 0.54         | MILE | CENTER LINE                                              |
|                          |     |   |   |    |       |       |       |      |      |     |    |      |           |              |      | MAINTENANCE OF TRAFFIC                                   |
|                          |     |   | 7 |    |       |       |       |      |      |     |    | 614  | 12460     | 7            | EACH | WORK ZONE MARKING SIGN                                   |
|                          |     |   | 2 |    |       |       |       |      |      |     |    | 614  | 13000     | 2            | CY   | ASPHALT CONCRETE FOR MANTANING TRAFFIC                   |
|                          |     |   |   | 60 |       |       |       |      |      |     |    | 614  | 18401     | 60           | DAY  | PORTABLE CHANGEABLE MESSAGE SIGN, AS PER PLAN            |
|                          |     |   |   |    | 0.54  |       |       |      |      |     |    | 614  | 21550     | 0.54         | MILE | WORK ZONE CENTER LINE, CLASS III, 642 PAINT              |



I:\ProjectData\LIC\92958\Design\Roadway\Sheets\92958\_GS002.dgn 16-AUG-2017 10:44 AM jutz1

| LOCATION 1B SHEET TOTALS |       |     |    |    |        |        |       |       |       |      |    |     |       | ITEM | ITEM EXT. | GRAND TOTALS | UNIT | DESCRIPTION                                                                    |
|--------------------------|-------|-----|----|----|--------|--------|-------|-------|-------|------|----|-----|-------|------|-----------|--------------|------|--------------------------------------------------------------------------------|
| 2                        | 3     | 4   | 5  | 6  | 13     | 16     | 17    | 19    | 21    | 22   | 23 | 42  | 50    |      |           |              |      |                                                                                |
|                          | 1,720 |     |    |    |        |        | 4,106 | 1,333 |       |      |    |     |       | 202  | 23500     | 7,159        | SY   | ROADWAY                                                                        |
|                          |       |     |    |    |        |        |       |       |       |      |    |     | 300   | 202  | 38000     | 300          | FT   | WEARING COURSE REMOVED                                                         |
|                          |       |     |    |    |        |        |       |       |       |      |    |     |       |      |           |              |      | GUARDRAIL REMOVED                                                              |
|                          |       |     |    |    |        | 11.78  |       |       |       |      |    |     |       | 209  | 72501     | 11.78        | MILE | PREPARING SUBGRADE FOR SHOULDER PAVING, AS PER PLAN                            |
|                          |       |     |    |    |        |        |       |       |       |      |    |     | 350.0 | 606  | 15050     | 350.0        | FT   | GUARDRAIL, TYPE MGS                                                            |
|                          |       |     |    |    |        |        |       |       |       |      |    |     | 600.0 | 606  | 15100     | 600.0        | FT   | GUARDRAIL, TYPE MGS WITH LONG POSTS                                            |
|                          |       |     |    |    |        |        |       |       |       |      |    |     | 4     | 606  | 26150     | 4            | EACH | ANCHOR ASSEMBLY, MGS TYPE E                                                    |
| 700                      |       |     |    |    |        |        |       |       |       |      |    |     |       | 253  | 02000     | 700          | CY   | PAVEMENT                                                                       |
|                          |       |     |    |    | 89,866 | 21,801 |       |       |       |      |    |     |       | 254  | 01000     | 111,667      | SY   | PAVEMENT PLANING, ASPHALT CONCRETE ,1.50"                                      |
|                          |       |     |    |    | 9,117  | 1,467  |       |       |       |      |    |     |       | 254  | 01000     | 10,584       | SY   | PAVEMENT PLANING, ASPHALT CONCRETE , 3.25"                                     |
|                          | 4     |     |    |    |        |        |       |       |       |      |    |     |       | 304  | 20000     | 4            | CY   | AGGREGATE BASE                                                                 |
|                          |       |     |    |    | 7,880  | 1,819  | 339   | 15    |       |      |    |     |       | 407  | 20000     | 10,053       | GAL  | NON-TRACKING TACK COAT                                                         |
|                          |       |     |    |    |        | 5,482  |       |       |       |      |    |     |       | 408  | 10001     | 5,482        | GAL  | PRIME COAT, AS PER PLAN                                                        |
|                          | 72    | 83  |    |    | 4,125  | 970    | 173   | 8     |       |      |    |     |       | 441  | 50000     | 173          | CY   | ASPHALT CONCRETE SURFACE COURSE, TYPE 1, (448), PG64-22                        |
|                          |       |     |    |    | 652    | 72     | 28    | 65    |       |      |    |     |       | 441  | 50100     | 5,258        | CY   | ASPHALT CONCRETE SURFACE COURSE, TYPE 1, (448), PG70-22M                       |
|                          |       |     |    |    |        |        |       |       |       |      |    |     |       | 441  | 50300     | 817          | CY   | ASPHALT CONCRETE INTERMEDIATE COURSE, TYPE 2, (448)                            |
|                          |       |     |    |    |        |        |       | 86    |       |      |    |     |       | 516  | 31011     | 86           | FT   | 2" DEEP JOINT SEALER, AS PER PLAN                                              |
|                          |       |     |    |    |        | 762    |       |       |       |      |    |     |       | 617  | 10101     | 762          | CY   | COMPACTED AGGREGATE, AS PER PLAN                                               |
|                          |       |     |    |    |        | 13,705 |       |       |       |      |    |     |       | 617  | 20000     | 13,705       | SY   | SHOULDER PREPARATION                                                           |
|                          |       |     |    |    |        |        |       |       | 11.88 |      |    |     |       | 618  | 41000     | 11.88        | MILE | EDGE LINE, RUMBLE STRIPE (ASPHALT CONCRETE)                                    |
|                          |       | 500 |    |    |        |        |       |       |       |      |    |     |       | 690  | 12050     | 500          | SY   | SPECIAL - REINFORCED MESH FOR TRANSVERSE AND/OR LONGITUDINAL JOINTS AND CRACKS |
|                          |       |     |    |    |        |        |       |       |       |      |    |     |       |      |           |              |      | TRAFFIC CONTROL                                                                |
|                          |       |     |    |    |        |        |       |       |       |      |    | 741 |       | 621  | 00100     | 741          | EACH | RPM                                                                            |
|                          |       |     |    |    |        |        |       |       |       |      |    | 741 |       | 621  | 54000     | 741          | EACH | RAISED PAVEMENT MARKER REMOVED                                                 |
|                          |       |     |    |    |        |        |       |       |       |      |    |     | 16    | 626  | 00110     | 16           | EACH | BARRIER REFLECTOR, TYPE 2                                                      |
|                          |       |     |    |    |        |        |       |       |       |      |    |     | 34.5  | 630  | 03100     | 34.5         | EACH | GROUND MOUNTED SUPPORT, NO. 3 POST                                             |
|                          |       |     |    |    |        |        |       |       |       |      |    |     | 6.25  | 630  | 80100     | 6.25         | SF   | SIGN, FLAT SHEET                                                               |
|                          |       |     |    |    |        |        |       |       |       |      |    |     | 6     | 630  | 84900     | 6            | EACH | REMOVAL OF GROUND MOUNTED SIGN AND DISPOSAL                                    |
|                          |       |     |    |    |        |        |       |       |       |      |    |     | 3     | 630  | 85100     | 3            | EACH | REMOVAL OF GROUND MOUNTED SIGN AND REERECTION                                  |
|                          |       |     |    |    |        |        |       |       |       |      |    |     | 5     | 630  | 86002     | 5            | EACH | REMOVAL OF GROUND MOUNTED POST SUPPORT AND DISPOSAL                            |
|                          |       | 12  |    |    |        |        |       |       |       |      |    |     |       | 632  | 26501     | 12           | EACH | DETECTOR LOOP, AS PER PLAN                                                     |
|                          |       |     |    |    |        |        |       |       |       |      |    |     |       | 644  | 00400     | 1,845        | FT   | CHANNELIZING LINE, 8"                                                          |
|                          |       |     |    |    |        |        |       |       |       |      |    |     |       | 644  | 00500     | 473          | FT   | STOP LINE                                                                      |
|                          |       |     |    |    |        |        |       |       |       |      |    |     |       | 644  | 00700     | 2,026        | FT   | TRANSVERSE/DIAGONAL LINE                                                       |
|                          |       |     |    |    |        |        |       |       |       |      |    |     |       | 644  | 00900     | 285          | SF   | ISLAND MARKING                                                                 |
|                          |       |     |    |    |        |        |       |       |       |      |    |     |       | 644  | 01300     | 19           | EACH | LANE ARROW                                                                     |
|                          |       |     |    |    |        |        |       |       |       |      |    |     |       | 644  | 01350     | 1            | EACH | LANE REDUCTION ARROW                                                           |
|                          |       |     |    |    |        |        |       |       |       |      |    |     |       | 644  | 01410     | 9            | EACH | WORD ON PAVEMENT, 96"                                                          |
|                          |       |     |    |    |        |        |       |       | 11.88 |      |    |     |       | 648  | 00104     | 11.88        | MILE | EDGE LINE, 6"                                                                  |
|                          |       |     |    |    |        |        |       |       |       | 0.71 |    |     |       | 648  | 00204     | 0.71         | MILE | LANE LINE, 6"                                                                  |
|                          |       |     |    |    |        |        |       |       |       | 6.29 |    |     |       | 648  | 00300     | 6.29         | MILE | CENTER LINE                                                                    |
|                          |       |     |    |    |        |        |       |       |       |      |    |     |       |      |           |              |      | MAINTENANCE OF TRAFFIC                                                         |
|                          |       |     | 80 |    |        |        |       |       |       |      |    |     |       | 614  | 11110     | 80           | hour | LAW ENFORCEMENT OFFICER WITH PATROL CAR FOR ASSISTANCE                         |
|                          |       |     | 81 |    |        |        |       |       |       |      |    |     |       | 614  | 12460     | 81           | EACH | WORK ZONE MARKING SIGN                                                         |
|                          |       |     | 3  |    |        |        |       |       |       |      |    |     |       | 614  | 13000     | 3            | CY   | ASPHALT CONCRETE FOR MAINTAINING TRAFFIC                                       |
|                          |       |     |    | 60 |        |        |       |       |       |      |    |     |       | 614  | 18401     | 60           | CY   | MAINTAINING TRAFFIC, MISC.:                                                    |
|                          |       |     |    |    | 0.54   |        |       |       |       |      |    |     |       | 614  | 21400     | 0.54         | MILE | WORK ZONE CENTER LINE, CLASS II                                                |
|                          |       |     |    |    | 5.91   |        |       |       |       |      |    |     |       | 614  | 21550     | 5.91         | MILE | WORK ZONE CENTER LINE, CLASS III, 642 PAINT                                    |



I:\ProjectData\LIC\92958\Design\Roadway\Sheets\92958\_GS002B.dgn 02-MAR-2017 2:31PM jutz1

| Location 1b Sheet Totals |      |      |       |       |       |     |  |  |  |  | ITEM | ITEM EXT. | GRAND TOTALS | UNIT | DESCRIPTION                                                 |
|--------------------------|------|------|-------|-------|-------|-----|--|--|--|--|------|-----------|--------------|------|-------------------------------------------------------------|
| 4                        | 48   | 63   | 64    | 65    | 83    | 84  |  |  |  |  |      |           |              |      |                                                             |
|                          |      |      |       |       |       |     |  |  |  |  |      |           |              |      | ROADWAY                                                     |
|                          | 1    |      |       |       |       |     |  |  |  |  | 202  | 20010     | 1            | EACH | HEADWALL REMOVED                                            |
|                          | 17   |      | 433   |       |       | 117 |  |  |  |  | 202  | 23010     | 567          | SY   | PAVEMENT REMOVED, ASPHALT                                   |
| 400                      |      |      |       |       |       | 513 |  |  |  |  | 202  | 30000     | 913          | SF   | WALK REMOVED                                                |
|                          | 40   |      |       | 1,514 |       |     |  |  |  |  | 202  | 35100     | 1,554        | FT   | PIPE REMOVED, 24" AND UNDER                                 |
|                          |      |      |       | 10    |       |     |  |  |  |  | 202  | 58100     | 10           | EACH | CATCH BASIN REMOVED                                         |
|                          |      |      |       | 1     |       |     |  |  |  |  | 202  | 58500     | 1            | EACH | CATCH BASIN ABANDONED                                       |
|                          |      |      |       | 165   |       |     |  |  |  |  | 202  | 70000     | 165          | FT   | SPECIAL - FILL AND PLUG EXISTING CONDUIT                    |
|                          | 98   |      |       |       | 190   |     |  |  |  |  | 203  | 10000     | 288          | CY   | EXCAVATION                                                  |
|                          | 84   |      | 36    |       | 42    | 9   |  |  |  |  | 203  | 20000     | 171          | CY   | EMBANKMENT                                                  |
|                          | 12   |      |       |       |       | 160 |  |  |  |  | 204  | 10000     | 172          | SY   | SUBGRADE COMPACTION                                         |
| 400                      |      |      |       |       |       | 539 |  |  |  |  | 608  | 10000     | 400          | SF   | 4" CONCRETE WALK                                            |
|                          |      |      |       |       |       |     |  |  |  |  | 608  | 13000     | 539          | SF   | 6" CONCRETE WALK                                            |
|                          |      |      |       |       |       |     |  |  |  |  |      |           |              |      | EROSION CONTROL                                             |
|                          |      |      |       | 6     |       |     |  |  |  |  | 601  | 32100     | 6            | CY   | ROCK CHANNEL PROTECTION, TYPE B WITH FILTER                 |
|                          |      |      |       |       | 171   |     |  |  |  |  | 653  | 10000     | 171          | CY   | TOPSOIL FURNISHED AND PLACED                                |
|                          |      |      |       |       | 2,994 |     |  |  |  |  | 659  | 00500     | 2,994        | SY   | SEEDING AND MULCHING, CLASS 1                               |
|                          |      | 150  |       |       |       |     |  |  |  |  | 659  | 14000     | 150          | SY   | REPAIR SEEDING AND MULCHING                                 |
|                          |      | 150  |       |       |       |     |  |  |  |  | 659  | 15000     | 150          | SY   | INTER-SEEDING                                               |
|                          |      | 0.42 |       |       |       |     |  |  |  |  | 659  | 20000     | 0.42         | TON  | COMMERCIAL FERTILIZER                                       |
|                          |      | 0.62 |       |       |       |     |  |  |  |  | 659  | 31000     | 0.62         | ACRE | LIME                                                        |
|                          |      | 17   |       |       |       |     |  |  |  |  | 659  | 35000     | 17           | MGAL | WATER                                                       |
|                          |      |      |       |       |       |     |  |  |  |  |      |           |              |      | DRAINAGE                                                    |
|                          | 0.54 |      |       | 0.81  |       |     |  |  |  |  | 602  | 20000     | 1.35         | CY   | CONCRETE MASONRY                                            |
|                          |      |      |       | 45    |       |     |  |  |  |  | 611  | 02000     | 45           | FT   | 8" CONDUIT, TYPE C                                          |
|                          |      |      |       | 5     |       |     |  |  |  |  | 611  | 04400     | 5            | FT   | 12" CONDUIT, TYPE B                                         |
| 54                       |      |      |       | 2,423 |       |     |  |  |  |  | 611  | 05900     | 2,477        | FT   | 15" CONDUIT, TYPE B                                         |
|                          |      |      |       | 11    |       |     |  |  |  |  | 611  | 98180     | 11           | EACH | CATCH BASIN, NO. 3A                                         |
|                          |      |      |       | 2     |       |     |  |  |  |  | 611  | 98370     | 2            | EACH | CATCH BASIN, NO. 6                                          |
|                          |      |      |       | 7     |       |     |  |  |  |  | 611  | 98470     | 7            | EACH | CATCH BASIN, NO. 2-2B                                       |
|                          |      |      |       | 1     |       |     |  |  |  |  | 611  | 99574     | 1            | EACH | MANHOLE, NO. 3                                              |
|                          |      |      |       | 1     |       |     |  |  |  |  | 611  | 99710     | 1            | EACH | PRECAST REINFORCED CONCRETE OUTLET                          |
|                          |      |      |       |       |       |     |  |  |  |  |      |           |              |      | PAVEMENT                                                    |
|                          | 2    |      | 19    |       |       | 22  |  |  |  |  | 301  | 46000     | 19           | CY   | ASPHALT CONCRETE BASE, PG64-22                              |
|                          |      |      |       |       |       |     |  |  |  |  | 301  | 48000     | 24           | CY   | ASPHALT CONCRETE BASE, PG64-22 (DRIVEWAYS)                  |
|                          | 2    | 15   |       |       |       | 13  |  |  |  |  | 304  | 20000     | 30           | CY   | AGGREGATE BASE                                              |
|                          | 164  |      |       |       |       | 7   |  |  |  |  | 407  | 20000     | 171          | GAL  | NON-TRACKING TACK COAT                                      |
|                          | 53   |      |       |       |       |     |  |  |  |  | 441  | 50000     | 53           | CY   | ASPHALT CONCRETE SURFACE COURSE, TYPE 1, (448), PG64-22     |
|                          | 62   |      |       |       |       |     |  |  |  |  | 441  | 50300     | 62           | CY   | ASPHALT CONCRETE INTERMEDIATE COURSE, TYPE 2, (448)         |
|                          | 1    |      |       |       |       | 7   |  |  |  |  | 441  | 50400     | 8            | CY   | ASPHALT CONCRETE SURFACE COURSE, TYPE 1, (448), (DRIVEWAYS) |
|                          |      |      | 1,376 |       |       |     |  |  |  |  | 609  | 26000     | 1,376        | FT   | CURB, TYPE 6                                                |
|                          |      | 25   | 93    |       |       |     |  |  |  |  | 613  | 41300     | 118          | CY   | LOW STRENGTH MORTAR BACKFILL (TYPE 2)                       |
| 10                       |      |      |       |       |       |     |  |  |  |  | 613  | 41301     | 10           | CY   | LOW STRENGTH MORTAR BACKFILL (TYPE 2), AS PER PLAN          |



I:\ProjectData\LIC\92958\Design\Roadway\Sheets\92958\_GS003.dgn 02-MAR-2017 2:33PM jlut1

| LOCATION 1C SHEET TOTALS |     |    |   |        |       |      |      |     |     | ITEM | ITEM EXT. | GRAND TOTALS | UNIT | DESCRIPTION                                              |
|--------------------------|-----|----|---|--------|-------|------|------|-----|-----|------|-----------|--------------|------|----------------------------------------------------------|
| 2                        | 3   | 4  | 5 | 13     | 16    | 21   | 22   | 24  | 43  |      |           |              |      |                                                          |
|                          | 400 |    |   |        |       |      |      |     |     | 202  | 23500     | 400          | SY   | ROADWAY<br>WEARING COURSE REMOVED                        |
|                          |     |    |   |        | 2.56  |      |      |     |     | 209  | 72501     | 2.56         | MILE | PREPARING SUBGRADE FOR SHOULDER PAVING, AS PER PLAN      |
|                          |     |    |   |        |       |      |      |     |     |      |           |              |      | PAVEMENT                                                 |
| 120                      |     |    |   |        |       |      |      |     |     | 253  | 02000     | 120          | CY   | PAVEMENT REPAIR                                          |
|                          |     |    |   | 18,868 | 4,882 |      |      |     |     | 254  | 01000     | 23,750       | SY   | PAVEMENT PLANING, ASPHALT CONCRETE ,1.50"                |
|                          | 1   |    |   |        |       |      |      |     |     | 304  | 20000     | 1            | CY   | AGGREGATE BASE                                           |
|                          |     |    |   | 1,415  | 367   |      |      |     |     | 407  | 20000     | 1,782        | GAL  | NON-TRACKING TACK COAT                                   |
|                          |     |    |   |        | 1,202 |      |      |     |     | 408  | 10001     | 1,202        | GAL  | PRIME COAT, AS PER PLAN                                  |
|                          | 17  | 18 |   | 787    | 204   |      |      |     |     | 441  | 50000     |              | CY   | ASPHALT CONCRETE SURFACE COURSE, TYPE 1, (448), PG64-22  |
|                          |     |    |   |        |       |      |      |     |     | 441  | 50100     | 1,026        | CY   | ASPHALT CONCRETE SURFACE COURSE, TYPE 1, (448), PG70-22M |
|                          |     |    |   |        |       |      |      |     |     | 441  | 50300     |              | CY   | ASPHALT CONCRETE INTERMEDIATE COURSE, TYPE 2, (448)      |
|                          |     |    |   |        | 167   |      |      |     |     | 617  | 10101     | 167          | CY   | COMPACTED AGGREGATE, AS PER PLAN                         |
|                          |     |    |   |        | 3,004 |      |      |     |     | 617  | 20000     | 3,004        | SY   | SHOULDER PREPARATION                                     |
|                          |     |    |   |        |       | 2.56 |      |     |     | 618  | 41000     | 2.56         | MILE | EDGE LINE, RUMBLE STRIPE (ASPHALT CONCRETE)              |
|                          |     |    |   |        |       |      |      |     |     |      |           |              |      | TRAFFIC CONTROL                                          |
|                          |     |    |   |        |       |      |      |     | 176 | 621  | 00100     | 176          | EACH | RPM                                                      |
|                          |     |    |   |        |       |      |      |     | 176 | 621  | 54000     | 176          | EACH | RAISED PAVEMENT MARKER REMOVED                           |
|                          |     | 5  |   |        |       |      |      |     |     | 632  | 26501     | 5            | EACH | DETECTOR LOOP, AS PER PLAN                               |
|                          |     |    |   |        |       |      |      | 290 |     | 644  | 00400     | 290          | FT   | CHANNELIZING LINE, 8"                                    |
|                          |     |    |   |        |       |      |      | 52  |     | 644  | 00500     | 52           | FT   | STOP LINE                                                |
|                          |     |    |   |        |       |      |      | 169 |     | 644  | 00700     | 169          | FT   | TRANSVERSE/DIAGONAL LINE                                 |
|                          |     |    |   |        |       |      |      | 3   |     | 644  | 01300     | 3            | EACH | LANE ARROW                                               |
|                          |     |    |   |        |       |      |      | 1   |     | 644  | 01410     | 1            | EACH | WORD ON PAVEMENT, 96"                                    |
|                          |     |    |   |        |       | 2.56 |      |     |     | 648  | 00104     | 2.56         | MILE | EDGE LINE, 6"                                            |
|                          |     |    |   |        |       |      | 1.37 |     |     | 648  | 00300     | 1.37         | MILE | CENTER LINE                                              |
|                          |     |    |   |        |       |      |      |     |     |      |           |              |      | MAINTENANCE OF TRAFFIC                                   |
|                          |     |    | 9 |        |       |      |      |     |     | 614  | 12460     | 9            | EACH | WORK ZONE MARKING SIGN                                   |
|                          |     |    |   | 1.28   |       |      |      |     |     | 614  | 21550     | 1.28         | MILE | WORK ZONE CENTER LINE, CLASS III, 642 PAINT              |
|                          |     |    |   |        |       |      |      |     |     |      |           |              |      |                                                          |



I:\ProjectData\LIC\92958\Design\Roadway\Sheets\92958\_GS004.dgn 02-MAR-2017 2:34PM jutz1

| LOCATION 1D SHEET TOTALS |     |   |    |       |       |     |      |      |    |     | ITEM | ITEM EXT. | GRAND TOTALS | UNIT | DESCRIPTION                                              |
|--------------------------|-----|---|----|-------|-------|-----|------|------|----|-----|------|-----------|--------------|------|----------------------------------------------------------|
| 2                        | 3   | 4 | 5  | 13    | 16    | 17  | 21   | 22   | 24 | 43  |      |           |              |      |                                                          |
|                          |     |   |    |       |       |     |      |      |    |     |      |           |              |      | ROADWAY                                                  |
|                          | 170 |   |    |       |       | 339 |      |      |    |     | 202  | 23500     | 509          | SY   | WEARING COURSE REMOVED                                   |
|                          |     |   |    |       | 1.22  |     |      |      |    |     | 209  | 72501     | 1.22         | MILE | PREPARING SUBGRADE FOR SHOULDER PAVING, AS PER PLAN      |
|                          |     |   |    |       |       |     |      |      |    |     |      |           |              |      | DRAINAGE                                                 |
|                          | 1   |   |    |       |       |     |      |      |    |     | 611  | 99654     | 1            | EACH | MANHOLE ADJUSTED TO GRADE                                |
|                          |     |   |    |       |       |     |      |      |    |     |      |           |              |      | PAVEMENT                                                 |
| 60                       |     |   |    |       |       |     |      |      |    |     | 253  | 02000     | 60           | CY   | PAVEMENT REPAIR                                          |
|                          |     |   |    | 6,477 | 1,080 |     |      |      |    |     | 254  | 01000     | 7,557        | SY   | PAVEMENT PLANING, ASPHALT CONCRETE , 1.50"               |
|                          |     |   |    | 2,852 | 352   |     |      |      |    |     | 254  | 01000     | 3,204        | SY   | PAVEMENT PLANING, ASPHALT CONCRETE , 3.25"               |
|                          | 1   |   |    |       |       |     |      |      |    |     | 304  | 20000     | 1            | CY   | AGGREGATE BASE                                           |
|                          |     |   |    | 843   | 125   | 26  |      |      |    |     | 407  | 20000     | 994          | GAL  | NON-TRACKING TACK COAT                                   |
|                          |     |   |    |       | 573   |     |      |      |    |     | 408  | 10001     | 573          | GAL  | PRIME COAT, AS PER PLAN                                  |
|                          |     |   |    |       |       | 12  |      |      |    |     | 441  | 50000     | 12           | CY   | ASPHALT CONCRETE SURFACE COURSE, TYPE 1, (448), PG64-22  |
|                          | 7   | 9 |    | 389   | 60    |     |      |      |    |     | 441  | 50100     | 465          | CY   | ASPHALT CONCRETE SURFACE COURSE, TYPE 1, (448), PG70-22M |
|                          |     |   |    | 139   | 18    |     |      |      |    |     | 441  | 50300     | 157          | CY   | ASPHALT CONCRETE INTERMEDIATE COURSE, TYPE 2, (448)      |
|                          |     |   |    |       | 80    |     |      |      |    |     | 617  | 10101     | 80           | CY   | COMPACTED AGGREGATE, AS PER PLAN                         |
|                          |     |   |    |       | 1,432 |     |      |      |    |     | 617  | 20000     | 1,432        | SY   | SHOULDER PREPARATION                                     |
|                          |     |   |    |       |       |     |      |      |    |     |      |           |              |      | TRAFFIC CONTROL                                          |
|                          |     |   |    |       |       |     |      |      |    | 125 | 621  | 00100     | 125          | EACH | RPM                                                      |
|                          |     |   |    |       |       |     |      |      |    | 125 | 621  | 54000     | 125          | EACH | RAISED PAVEMENT MARKER REMOVED                           |
|                          |     | 3 |    |       |       |     |      |      |    |     | 632  | 26501     | 3            | EACH | DETECTOR LOOP, AS PER PLAN                               |
|                          |     |   |    |       |       |     |      |      |    | 140 | 644  | 00400     | 140          | FT   | CHANNELIZING LINE, 8"                                    |
|                          |     |   |    |       |       |     |      |      |    | 37  | 644  | 00500     | 37           | FT   | STOP LINE                                                |
|                          |     |   |    |       |       |     |      |      |    | 229 | 644  | 00700     | 229          | FT   | TRANSVERSE/DIAGONAL LINE                                 |
|                          |     |   |    |       |       |     |      |      |    | 4   | 644  | 01300     | 4            | EACH | LANE ARROW                                               |
|                          |     |   |    |       |       |     | 1.22 |      |    |     | 648  | 00104     | 1.22         | MILE | EDGE LINE, 6"                                            |
|                          |     |   |    |       |       |     |      | 0.74 |    |     | 648  | 00300     | 0.74         | MILE | CENTER LINE                                              |
|                          |     |   |    |       |       |     |      |      |    |     |      |           |              |      | MAINTENANCE OF TRAFFIC                                   |
|                          |     |   | 16 |       |       |     |      |      |    |     | 614  | 11110     | 16           | HOUR | LAW ENFORCEMENT OFFICER WITH PATROL CAR FOR ASSISTANCE   |
|                          |     |   | 5  |       |       |     |      |      |    |     | 614  | 12460     | 5            | EACH | WORK ZONE MARKING SIGN                                   |
|                          |     |   |    | 0.15  |       |     |      |      |    |     | 614  | 21400     | 0.15         | MILE | WORK ZONE CENTER LINE, CLASS II                          |
|                          |     |   |    | 0.61  |       |     |      |      |    |     | 614  | 21550     | 0.61         | MILE | WORK ZONE CENTER LINE, CLASS III, 642 PAINT              |



I:\ProjectData\LIC\92958\Design\Roadway\Sheets\92958\_GS005.dgn 11-APR-2017 3:14PM jltz1

| LOCATION 1E SHEET TOTALS |    |   |   |    |        |   |       |    |     |    |      | ITEM | ITEM EXT. | GRAND TOTALS | UNIT | DESCRIPTION                                              |
|--------------------------|----|---|---|----|--------|---|-------|----|-----|----|------|------|-----------|--------------|------|----------------------------------------------------------|
| 2                        | 3  | 4 | 5 | 6  | 14     | 7 | 17    | 19 | 20  | 22 | 24   |      |           |              |      |                                                          |
|                          |    |   |   |    |        |   | 1,138 |    |     |    |      | 202  | 23500     | 1,138        | SY   | ROADWAY                                                  |
|                          |    |   |   |    |        |   |       |    | 336 |    |      | 202  | 30000     | 336          | SF   | WEARING COURSE REMOVED                                   |
|                          |    |   |   |    |        |   |       |    | 37  |    |      | 202  | 32000     | 37           | FT   | WALK REMOVED                                             |
|                          |    |   |   |    |        |   |       |    | 348 |    |      | 608  | 10000     | 348          | SF   | CURB REMOVED                                             |
|                          |    |   |   |    |        |   |       |    |     |    |      |      |           |              |      | 4" CONCRETE WALK                                         |
|                          |    |   |   |    |        |   |       |    | 2   |    |      | 690  | 98000     | 2            | EACH |                                                          |
|                          |    |   |   |    |        |   |       |    | 1   |    |      | 690  | 98000     | 1            | EACH | SPECIAL - CURB RAMP, TYPE A1                             |
|                          |    |   |   |    |        |   |       |    | 8   |    |      | 690  | 98200     | 8            | SF   | SPECIAL - CURB RAMP, TYPE A2                             |
|                          |    |   |   |    |        |   |       |    |     |    |      |      |           |              |      | SPECIAL - DETECTABLE WARNING                             |
|                          |    |   |   |    |        |   |       |    |     |    |      |      |           |              |      |                                                          |
|                          | 3  |   |   |    |        |   |       |    |     |    |      | 611  | 98630     | 3            | EACH | DRAINAGE                                                 |
|                          | 12 |   |   |    |        |   |       |    |     |    |      | 611  | 99654     | 12           | EACH | CATCH BASIN ADJUSTED TO GRADE                            |
|                          | 5  |   |   |    |        |   |       |    |     |    |      | 638  | 10800     | 5            | EACH | MANHOLE ADJUSTED TO GRADE                                |
|                          |    |   |   |    |        |   |       |    |     |    |      |      |           |              |      | VALVE BOX ADJUSTED TO GRADE                              |
|                          |    |   |   |    |        |   |       |    |     |    |      |      |           |              |      |                                                          |
| 220                      |    |   |   |    |        |   |       |    |     |    |      | 253  | 02000     | 220          | CY   | PAVEMENT                                                 |
|                          |    |   |   |    |        |   |       |    |     |    |      |      |           |              |      | PAVEMENT REPAIR                                          |
|                          |    |   |   |    | 12,686 |   |       |    |     |    |      | 254  | 01000     | 12,686       | SY   |                                                          |
|                          |    |   |   |    | 1,232  |   |       |    |     |    |      | 254  | 01000     | 1,232        | SY   | PAVEMENT PLANING, ASPHALT CONCRETE , 1.50"               |
|                          |    |   |   |    |        |   |       |    |     |    |      |      |           |              |      | PAVEMENT PLANING, ASPHALT CONCRETE , 3.25"               |
|                          |    |   |   |    | 1,106  |   | 86    |    |     |    |      | 407  | 20000     | 1,192        | GAL  | NON-TRACKING TACK COAT                                   |
|                          |    |   |   |    |        |   | 48    |    |     |    |      | 441  | 50000     | 48           | CY   |                                                          |
|                          |    |   |   |    | 580    |   |       |    |     |    |      | 441  | 50100     | 580          | CY   | ASPHALT CONCRETE SURFACE COURSE, TYPE 1, (448), PG64-22  |
|                          |    |   |   |    | 60     |   |       |    |     |    |      | 441  | 50300     | 60           | CY   | ASPHALT CONCRETE SURFACE COURSE, TYPE 1, (448), PG70-22M |
|                          |    |   |   |    |        |   |       |    |     |    |      |      |           |              |      | ASPHALT CONCRETE INTERMEDIATE COURSE, TYPE 2, (448)      |
|                          |    |   |   |    |        |   |       | 56 |     |    |      | 516  | 31011     | 56           | FT   |                                                          |
|                          |    |   |   |    |        |   |       |    |     |    |      |      |           |              |      | 2" DEEP JOINT SEALER, AS PER PLAN                        |
|                          |    |   |   |    |        |   |       |    | 37  |    |      | 609  | 26000     | 37           | FT   |                                                          |
|                          |    |   |   |    |        |   |       |    |     |    |      |      |           |              |      | CURB, TYPE 6                                             |
|                          |    |   |   |    |        |   |       |    |     |    |      |      |           |              |      |                                                          |
|                          |    |   | 3 |    |        |   |       |    |     |    |      | 632  | 26501     | 3            | EACH | TRAFFIC CONTROL                                          |
|                          |    |   |   |    |        |   |       |    |     |    |      |      |           |              |      | DETECTOR LOOP, AS PER PLAN                               |
|                          |    |   |   |    |        |   |       |    |     |    |      |      |           |              |      |                                                          |
|                          |    |   |   |    |        |   |       |    |     |    | 138  | 644  | 00400     | 138          | FT   |                                                          |
|                          |    |   |   |    |        |   |       |    |     |    | 124  | 644  | 00500     | 124          | FT   | CHANNELIZING LINE, 8"                                    |
|                          |    |   |   |    |        |   |       |    |     |    | 537  | 644  | 00600     | 537          | FT   | STOP LINE                                                |
|                          |    |   |   |    |        |   |       |    |     |    |      |      |           |              |      | CROSSWALK LINE                                           |
|                          |    |   |   |    |        |   |       |    |     |    |      |      |           |              |      |                                                          |
|                          |    |   |   |    |        |   |       |    |     |    | 5    | 644  | 01300     | 5            | EACH |                                                          |
|                          |    |   |   |    |        |   |       |    |     |    |      |      |           |              |      | LANE ARROW                                               |
|                          |    |   |   |    |        |   |       |    |     |    | 0.73 | 648  | 00300     | 0.73         | MILE |                                                          |
|                          |    |   |   |    |        |   |       |    |     |    |      |      |           |              |      | CENTER LINE                                              |
|                          |    |   |   |    |        |   |       |    |     |    |      |      |           |              |      |                                                          |
|                          |    |   |   |    |        |   |       |    |     |    |      |      |           |              |      |                                                          |
|                          |    |   |   | 40 |        |   |       |    |     |    |      | 614  | 11110     | 40           | hour | MAINTENANCE OF TRAFFIC                                   |
|                          |    |   | 4 |    |        |   |       |    |     |    |      | 614  | 12460     | 4            | EACH | LAW ENFORCEMENT OFFICER WITH PATROL CAR FOR ASSISTANCE   |
|                          |    |   | 6 |    |        |   |       |    |     |    |      | 614  | 13000     | 6            | CY   | WORK ZONE MARKING SIGN                                   |
|                          |    |   |   | 60 |        |   |       |    |     |    |      | 614  | 18401     | 60           | DAY  | ASPHALT CONCRETE FOR MAINTAINING TRAFFIC                 |
|                          |    |   |   |    | 0.06   |   |       |    |     |    |      | 614  | 21400     | 0.06         | MILE | PORTABLE CHANGEABLE MESSAGE SIGN, AS PER PLAN            |
|                          |    |   |   |    | 0.69   |   |       |    |     |    |      | 614  | 21550     | 0.69         | MILE | WORK ZONE CENTER LINE, CLASS II                          |
|                          |    |   |   |    |        |   |       |    |     |    |      |      |           |              |      | WORK ZONE CENTER LINE, CLASS III, 642 PAINT              |



SHEET  
NOT  
USED



I:\ProjectData\LIC\92958\Design\Roadway\Sheets\92958\_GG001.dgn 11-APR-2017 3:59PM jlut1

| LOCATION TOTALS |       |       |      |      |       |  |  |             | FUNDING SPLITS |           |                |                |                |           | ITEM | ITEM EXT. | GRAND TOTALS | UNIT | DESCRIPTION                                         | SEE SHEET |
|-----------------|-------|-------|------|------|-------|--|--|-------------|----------------|-----------|----------------|----------------|----------------|-----------|------|-----------|--------------|------|-----------------------------------------------------|-----------|
| 1A              | 1B    | 1B GJ | 1C   | 1D   | 1E    |  |  | D05 COMPLEX | 01/S<2/PV      | 02/STR/PV | 03/NHS/PV/HEAT | 04/NHS/PV/NEWA | 05/NHS/OT/NEWA | 06/STR/PV |      |           |              |      |                                                     |           |
|                 |       |       |      |      |       |  |  |             |                |           |                |                |                |           |      |           |              |      | ROADWAY                                             |           |
|                 |       | 1     |      |      |       |  |  |             |                | 1         |                |                |                |           | 202  | 20010     | 1            | EACH | HEADWALL REMOVED                                    |           |
|                 |       | 567   |      |      |       |  |  |             |                | 567       |                |                |                |           | 202  | 23010     | 567          | SY   | PAVEMENT REMOVED, ASPHALT                           |           |
| 1,416           | 5,826 |       | 400  | 509  | 1,138 |  |  |             | 1,816          | 5,826     | 509            | 1,138          |                |           | 202  | 23500     | 9,289        | SY   | WEARING COURSE REMOVED                              |           |
|                 |       | 913   |      |      | 336   |  |  |             |                | 913       |                |                | 336            |           | 202  | 30000     | 1,249        | SF   | WALK REMOVED                                        |           |
|                 |       |       |      |      | 37    |  |  | 100         |                |           |                |                | 37             | 100       | 202  | 32000     | 137          | FT   | CURB REMOVED                                        |           |
|                 |       | 1,554 |      |      |       |  |  |             |                | 1,554     |                |                |                |           | 202  | 35100     | 1,554        | FT   | PIPE REMOVED, 24" AND UNDER                         |           |
|                 | 300   |       |      |      |       |  |  |             |                | 300       |                |                |                |           | 202  | 38000     | 300          | FT   | GUARDRAIL REMOVED                                   |           |
|                 |       | 10    |      |      |       |  |  |             |                | 10        |                |                |                |           | 202  | 58100     | 10           | EACH | CATCH BASIN REMOVED                                 |           |
|                 |       | 1     |      |      |       |  |  |             |                | 1         |                |                |                |           | 202  | 58500     | 1            | EACH | CATCH BASIN ABANDONED                               |           |
|                 |       | 165   |      |      |       |  |  |             |                | 165       |                |                |                |           | 202  | 70000     | 165          | FT   | SPECIAL - FILL AND PLUG EXISTING CONDUIT            | 63        |
|                 |       |                 |       | 288   |      |      |       |  |  |             |                | 288       |                |                |                |           | 203  | 10000     | 288          | CY   | EXCAVATION                                          |           |
|                 |       | 175   |      |      |       |  |  |             |                | 175       |                |                |                |           | 203  | 20000     | 175          | CY   | EMBANKMENT                                          |           |
|                 |       |                 |       | 172   |      |      |       |  |  |             |                | 172       |                |                |                |           | 204  | 10000     | 172          | SY   | SUBGRADE COMPACTION                                 |           |
| 1.08            | 11.78 |       | 2.56 | 1.22 |       |  |  |             | 3.64           | 11.78     | 1.22           |                |                |           | 209  | 72051     | 16.64        | MILE | PREPARING SUBGRADE FOR SHOULDER PAVING, AS PER PLAN | 2         |
|                 |       |                 | 350.0 |       |      |      |       |  |  |             |                | 350.0     |                |                |                |           | 606  | 15050     | 350.0        | FT   | GUARDRAIL, TYPE MGS                                 |           |
|                 | 600.0 |       |      |      |       |  |  |             |                | 600.0     |                |                |                |           | 606  | 15100     | 600.0        | FT   | GUARDRAIL, TYPE MGS WITH LONG POSTS                 |           |
|                 | 4     |       |      |      |       |  |  |             |                | 4         |                |                |                |           | 606  | 26150     | 4            | EACH | ANCHOR ASSEMBLY, MGS TYPE E                         |           |
|                 |       | 400   |      |      | 348   |  |  |             |                | 400       |                |                | 348            |           | 608  | 10000     | 748          | SF   | 4" CONCRETE WALK                                    |           |
|                 |       | 539   |      |      |       |  |  |             |                | 539       |                |                |                |           | 608  | 13000     | 539          | SF   | 6" CONCRETE WALK                                    |           |
|                 |       |       |      |      | 2     |  |  |             |                |           |                |                | 2              |           | 690  | 98000     | 2            | EACH | SPECIAL - CURB RAMP, TYPE A1                        | 8,9,10    |
|                 |       |       |      |      | 1     |  |  |             |                |           |                |                | 1              |           | 690  | 98000     | 1            | EACH | SPECIAL - CURB RAMP, TYPE A2                        | 8,9,10    |
|                 |       |       |      |      | 8     |  |  |             |                |           |                |                | 8              |           | 690  | 98200     | 8            | SF   | SPECIAL - DETECTABLE WARNING                        | 8,9,10    |
|                 |       EROSION CONTROL                                     |           |
|                 |       | 6     |      |      |       |  |  |             |                | 6         |                |                |                |           | 601  | 32100     | 6            | CY   | ROCK CHANNEL PROTECTION, TYPE B WITH FILTER         |           |
|                 |       |                 |       | 171   |      |      |       |  |  |             |                | 171       |                |                |                |           | 653  | 10000     | 171          | CY   | TOPSOIL FURNISHED AND PLACED                        |           |
|                 |       |                 |       | 2,994 |      |      |       |  |  |             |                | 2,994     |                |                |                |           | 659  | 00500     | 2,994        | SY   | SEEDING AND MULCHING, CLASS 1                       |           |
|                 |       | 150   |      |      |       |  |  |             |                | 150       |                |                |                |           | 659  | 14000     | 150          | SY   | REPAIR SEEDING AND MULCHING                         |           |
|                 |       | 150   |      |      |       |  |  |             |                | 150       |                |                |                |           | 659  | 15000     | 150          | SY   | INTER-SEEDING                                       |           |
|                 |       | 0.42  |      |      |       |  |  |             |                | 0.42      |                |                |                |           | 659  | 20000     | 0.42         | TON  | COMMERCIAL FERTILIZER                               |           |
|                 |       | 0.62  |      |      |       |  |  |             |                | 0.62      |                |                |                |           | 659  | 31000     | 0.62         | ACRE | LIME                                                |           |
|                 |       | 17    |      |      |       |  |  |             |                | 17        |                |                |                |           | 659  | 35000     | 17           | MGAL | WATER                                               |           |



I:\ProjectData\LIC\92958\Design\Roadway\Sheets\92958\_GG002.dgn 11-APR-2017 4:04PM jutz1

| LOCATION TOTALS |         |       |        |       |        |  |             | FUNDING SPLITS |           |                |                |                |           | ITEM | ITEM EXT. | GRAND TOTALS | UNIT | DESCRIPTION                                                                   | SEE SHEET |
|-----------------|---------|-------|--------|-------|--------|--|-------------|----------------|-----------|----------------|----------------|----------------|-----------|------|-----------|--------------|------|-------------------------------------------------------------------------------|-----------|
| 1A              | 1B      | 1B GJ | 1C     | 1D    | 1E     |  | D05 COMPLEX | 01/S<2/PV      | 02/STR/PV | 03/NHS/PV/HEAT | 04/NHS/PV/NEWA | 05/NHS/OT/NEWA | 06/STR/PV |      |           |              |      |                                                                               |           |
|                 |         | 1.35  |        |       |        |  |             |                | 1.35      |                |                |                |           | 602  | 20000     | 1.35         | CY   | DRAINAGE                                                                      |           |
|                 |         | 45    |        |       |        |  |             |                | 45        |                |                |                |           | 611  | 02000     | 45           | FT   | CONCRETE MASONRY                                                              |           |
|                 |         | 5     |        |       |        |  |             |                | 5         |                |                |                |           | 611  | 04400     | 5            | FT   | 8" CONDUIT, TYPE C                                                            |           |
|                 |         | 2,475 |        |       |        |  |             |                | 2,475     |                |                |                |           | 611  | 05900     | 2,475        | FT   | 12" CONDUIT, TYPE B                                                           |           |
|                 |         | 11    |        |       |        |  |             |                | 11        |                |                |                |           | 611  | 98180     | 11           | FT   | 15" CONDUIT, TYPE B                                                           |           |
|                 |         | 2     |        |       |        |  |             |                | 2         |                |                |                |           | 611  | 98370     | 2            | EACH | CATCH BASN, NO. 3A                                                            |           |
|                 |         | 7     |        |       |        |  |             |                | 7         |                |                |                |           | 611  | 98470     | 7            | EACH | CATCH BASN, NO. 6                                                             |           |
|                 |         |       |        |       | 3      |  | 24          |                |           |                | 3              |                | 24        | 611  | 98630     | 27           | EACH | CATCH BASN, NO. 2-2B                                                          |           |
|                 |         | 1     |        |       |        |  |             |                | 1         |                |                |                |           | 611  | 99574     | 1            | EACH | CATCH BASIN ADJUSTED TO GRADE                                                 |           |
|                 |         |       | 1      |       | 12     |  | 4           |                |           | 1              | 12             |                | 4         | 611  | 99654     | 17           | EACH | MANHOLE, NO. 3                                                                |           |
|                 |         | 1     |        |       |        |  |             |                | 1         |                |                |                |           | 611  | 99710     | 1            | EACH | MANHOLE ADJUSTED TO GRADE                                                     |           |
|                 |         |       |        |       | 5      |  |             |                |           |                | 5              |                |           | 638  | 10800     | 5            | EACH | PRECAST REINFORCED CONCRETE OUTLET                                            |           |
|                 |         |       |        |       |        |  |             |                |           |                |                |                |           |      |           |              |      | VALVE BOX ADJUSTED TO GRADE                                                   |           |
|                 |         | 100             | 700     |       | 120    | 60    | 220    |  |             | 220            | 700       | 60             | 220            |                |           | 253  | 02000     | 1,200        | CY   | PAVEMENT                                                                      |           |
|                 |         |       |        |       |        |  |             |                |           |                |                |                |           |      |           |              |      | PAVEMENT REPAIR                                                               |           |
| 10,631          | 111,667 |       | 23,750 | 7,557 | 12,686 |  | 20,847      | 34,381         | 111,667   | 7,557          | 12,686         |                | 20,847    | 254  | 01000     | 187,138      | SY   | PAVEMENT PLANING, ASPHALT CONCRETE , 1.50"                                    |           |
|                 | 10,584  |       |        | 3,204 | 1,232  |  |             |                | 10,584    | 3,204          | 1,232          |                |           | 254  | 01000     | 15,020       | SY   | PAVEMENT PLANING, ASPHALT CONCRETE , 3.25"                                    |           |
|                 |         | 19    |        |       |        |  |             |                | 19        |                |                |                |           | 301  | 46000     | 19           | CY   | ASPHALT CONCRETE BASE, PG64-22                                                |           |
|                 |         | 24    |        |       |        |  |             |                | 24        |                |                |                |           | 301  | 48000     | 24           | CY   | ASPHALT CONCRETE BASE, PG64-22 (DRIVEWAYS)                                    |           |
| 1               | 4       | 30    | 1      | 1     |        |  |             | 2              | 34        | 1              |                |                |           | 304  | 20000     | 37           | CY   | AGGREGATE BASE                                                                |           |
| 880             | 10,053  | 171   | 1,782  | 994   | 1,192  |  | 1,564       | 2,662          | 10,209    | 994            | 1,192          |                | 1,564     | 407  | 20000     | 16,651       | GAL  | NON-TRACKING TACK COAT                                                        |           |
| 507             | 5,482   |       | 1,202  | 573   |        |  |             | 1,709          | 5,482     | 573            |                |                |           | 408  | 10001     | 7,764        | GAL  | PRIME COAT, AS PER PLAN                                                       | 2         |
| 46              | 173     | 53    |        | 12    | 48     |  |             | 46             | 226       | 12             | 48             |                |           | 441  | 50000     | 332          | CY   | ASPHALT CONCRETE SURFACE COURSE, TYPE 1, (448), PG64-22                       |           |
| 467             | 5,258   |       | 1,026  | 465   | 580    |  | 869         | 1,493          | 5,250     | 465            | 580            |                | 869       | 441  | 50100     | 8,673        | CY   | ASPHALT CONCRETE SURFACE COURSE, TYPE 1, (448), PG70-22M                      |           |
|                 | 752     | 62    |        | 157   | 60     |  |             |                | 814       | 157            | 60             |                |           | 441  | 50300     | 1,031        | CY   | ASPHALT CONCRETE INTERMEDIATE COURSE, TYPE 2, (448)                           |           |
|                 |         | 8     |        |       |        |  |             |                | 8         |                |                |                |           | 441  | 50400     | 8            | CY   | ASPHALT CONCRETE SURFACE COURSE, TYPE 1, (448), (DRMEWAYS)                    |           |
|                 | 86      |       |        |       | 56     |  |             |                | 86        |                | 56             |                |           | 516  | 31011     | 142          | FT   | 2" DEEP JOINT SEALER, AS PER PLAN                                             | 2         |
|                 |         | 1,376 |        |       | 37     |  | 100         |                | 1,376     |                |                | 37             | 100       | 609  | 26000     | 1,513        | FT   | CURB, TYPE 6                                                                  |           |
|                 |         | 118   |        |       |        |  |             |                | 118       |                |                |                |           | 613  | 41300     | 118          | CY   | LOW STRENGTH MORTAR BACKFILL (TYPE 2)                                         |           |
|                 |         | 10    |        |       |        |  |             |                | 10        |                |                |                |           | 613  | 41301     | 10           | CY   | LOW STRENGTH MORTAR BACKFILL (TYPE 2), AS PER PLAN                            | 4         |
| 71              | 762     |       | 167    | 80    |        |  |             | 238            | 762       | 80             |                |                |           | 617  | 10101     | 1,080        | CY   | COMPACTED AGGREGATE, AS PER PLAN                                              | 2         |
| 1,268           | 13,705  |       | 3,004  | 1,432 |        |  |             | 4,272          | 13,705    | 1,432          |                |                |           | 617  | 20000     | 19,409       | SY   | SHOULDER PREPARATION                                                          |           |
| 1.08            | 11.88   |       | 2.56   |       |        |  |             | 3.64           | 11.88     |                |                |                |           | 618  | 41000     | 15.52        | MILE | EDGE LINE, RUMBLE STRIPE (ASPHALT CONCRETE)                                   |           |
|                 | 500     |       |        |       |        |  |             |                | 500       |                |                |                |           | 690  | 12050     | 500          | SY   | SPECIAL - REINFORCED MESH FOR TRANSVERSE AND/OR LONGITUDNAL JOINTS AND CRACKS | 5         |

GENERAL SUMMARY

CALCULATED  
LME  
CHECKED  
JSL


LIC-13-0.00



RoO




I:\ProjectData\LIC\92958\Design\Roadway\Sheets\92958\_GY003.dgn 02-MAR-2017 3:29PM jltz1

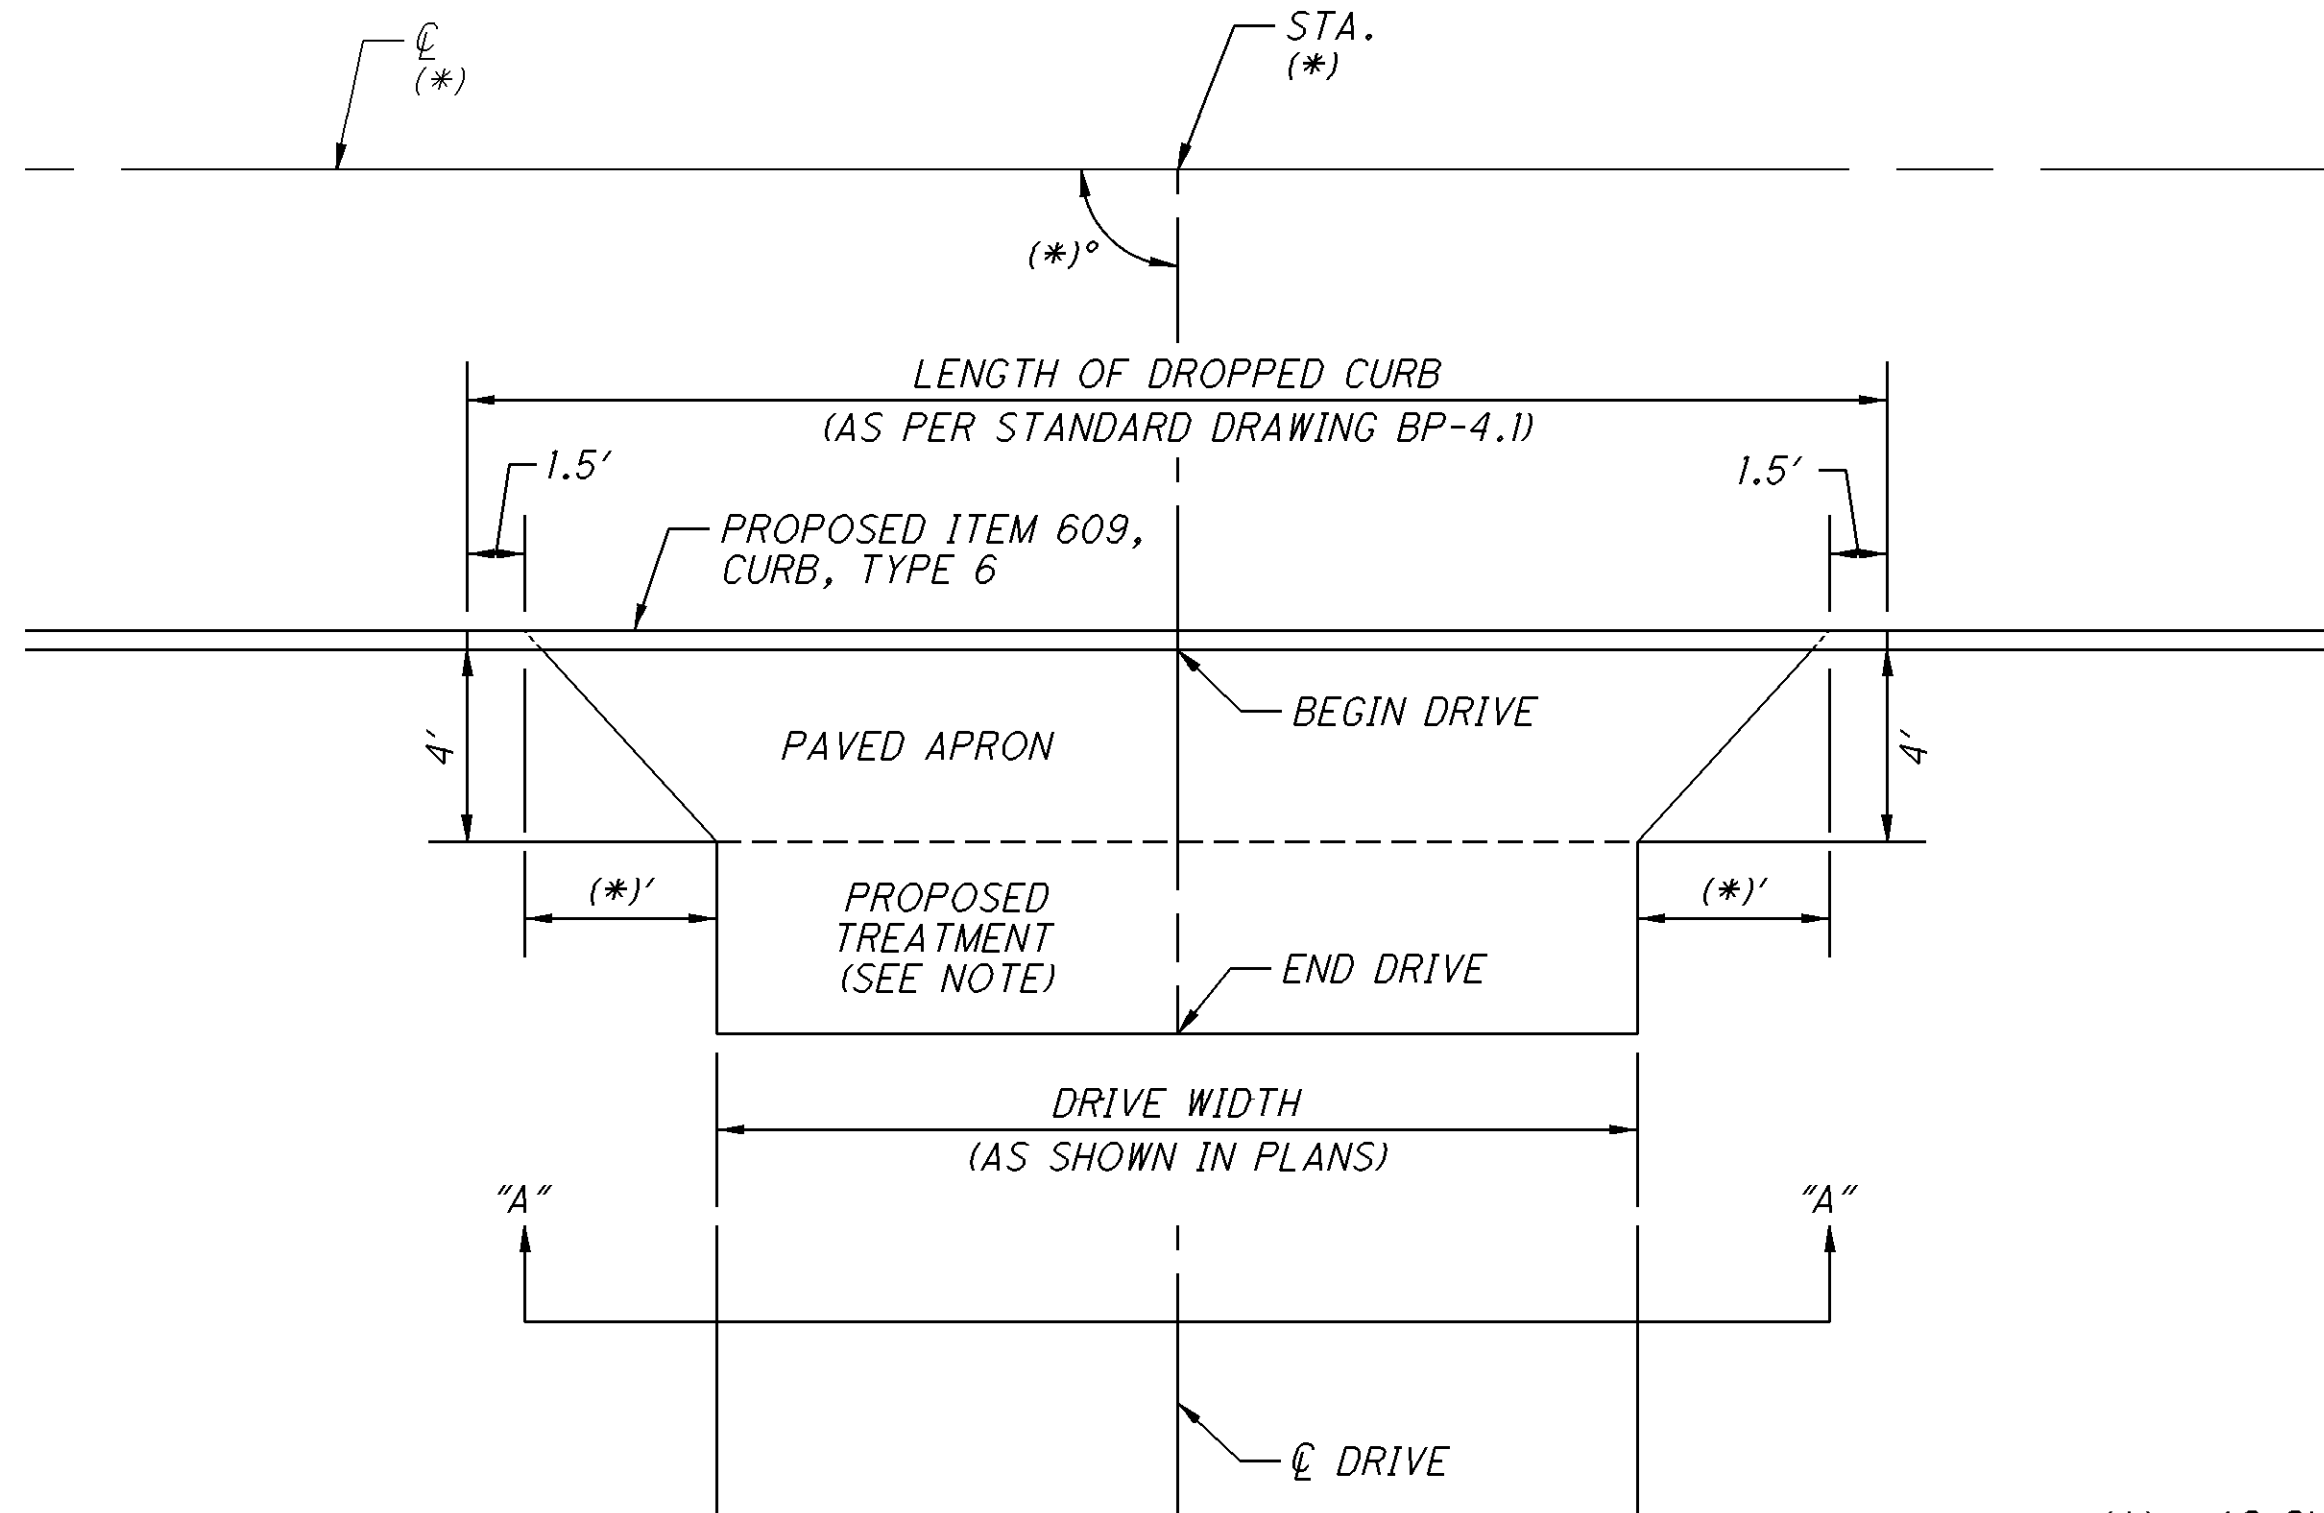

(\*) - AS SHOWN IN PLANS

NOTE:  
PROPOSED DRIVE SURFACE BEYOND PAVED APRON  
SHALL MATCH EXISTING DRIVE SURFACE (i.e. REPLACE  
EXISTING AGGREGATE WITH PROPOSED AGGREGATE, etc.).

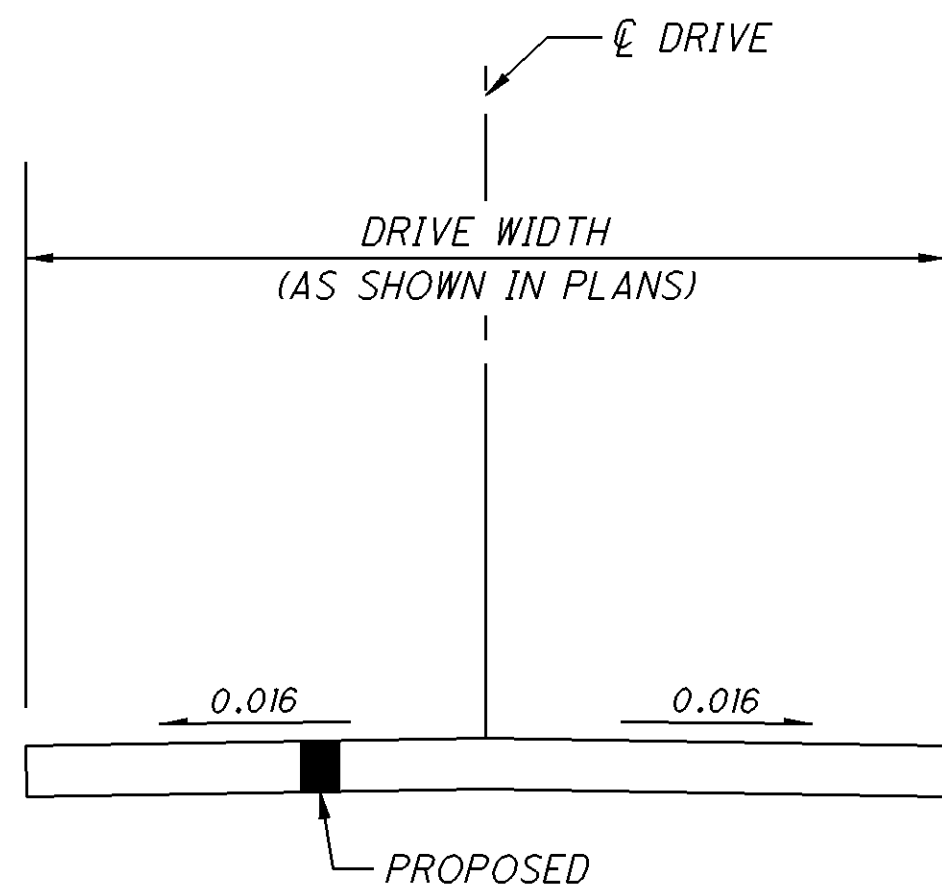



SECTION A-A

RESIDENTIAL DRIVE

- 1 1/4" OF ITEM 441, ASPHALT CONCRETE SURFACE COURSE, TYPE 1, (448) PG64-22 (DRIVEWAYS)
- ITEM 407 NON-TRACKING TACK COAT, SURFACE COURSE @ (0.040 GAL./SQ. YD.)
- 4 1/4" OF ITEM 301, ASPHALT CONCRETE BASE, PG64-22 (DRIVEWAYS)

AND/OR

- 8" ITEM 304, AGGREGATE BASE

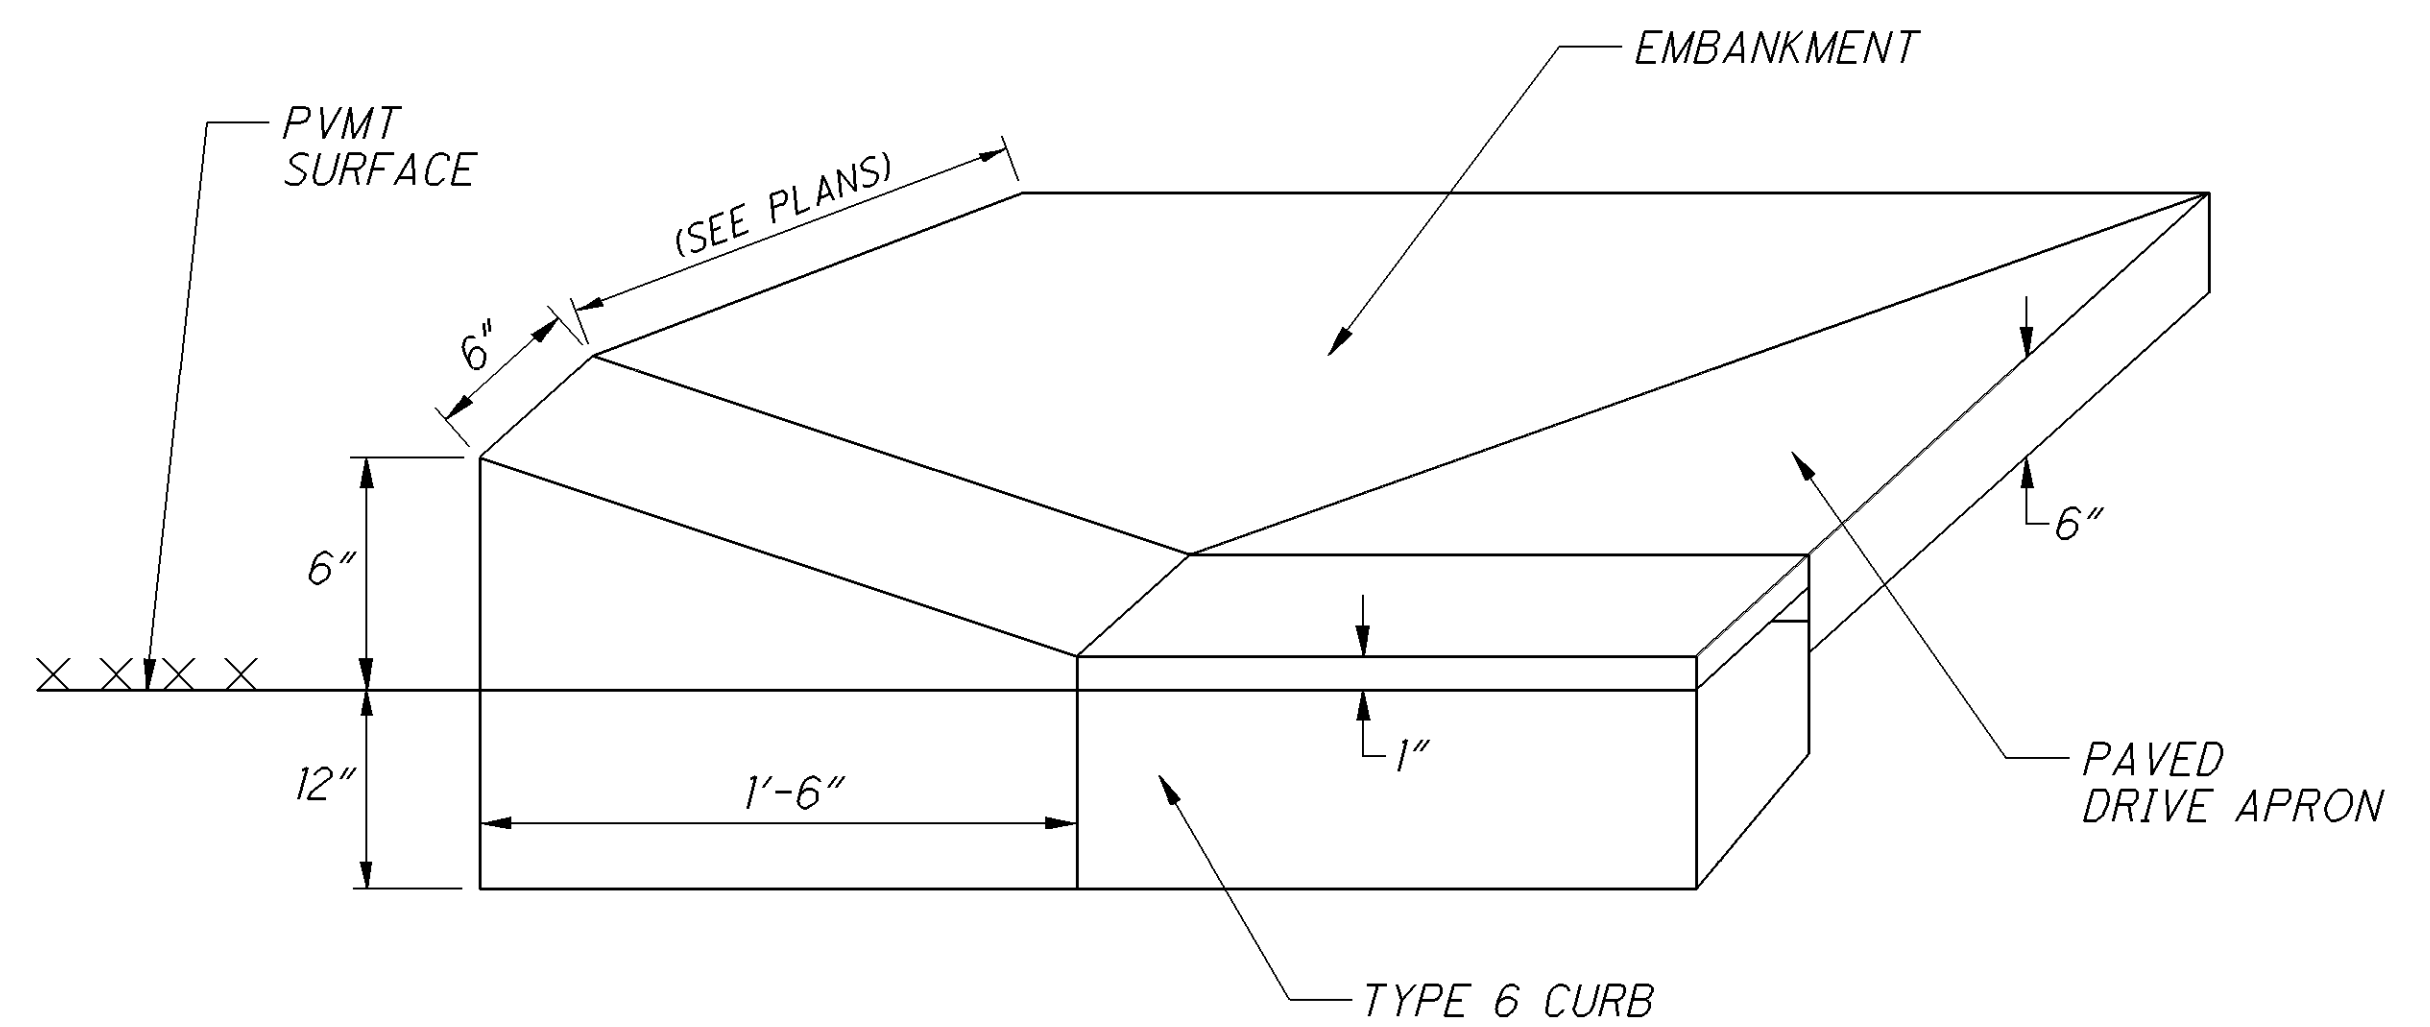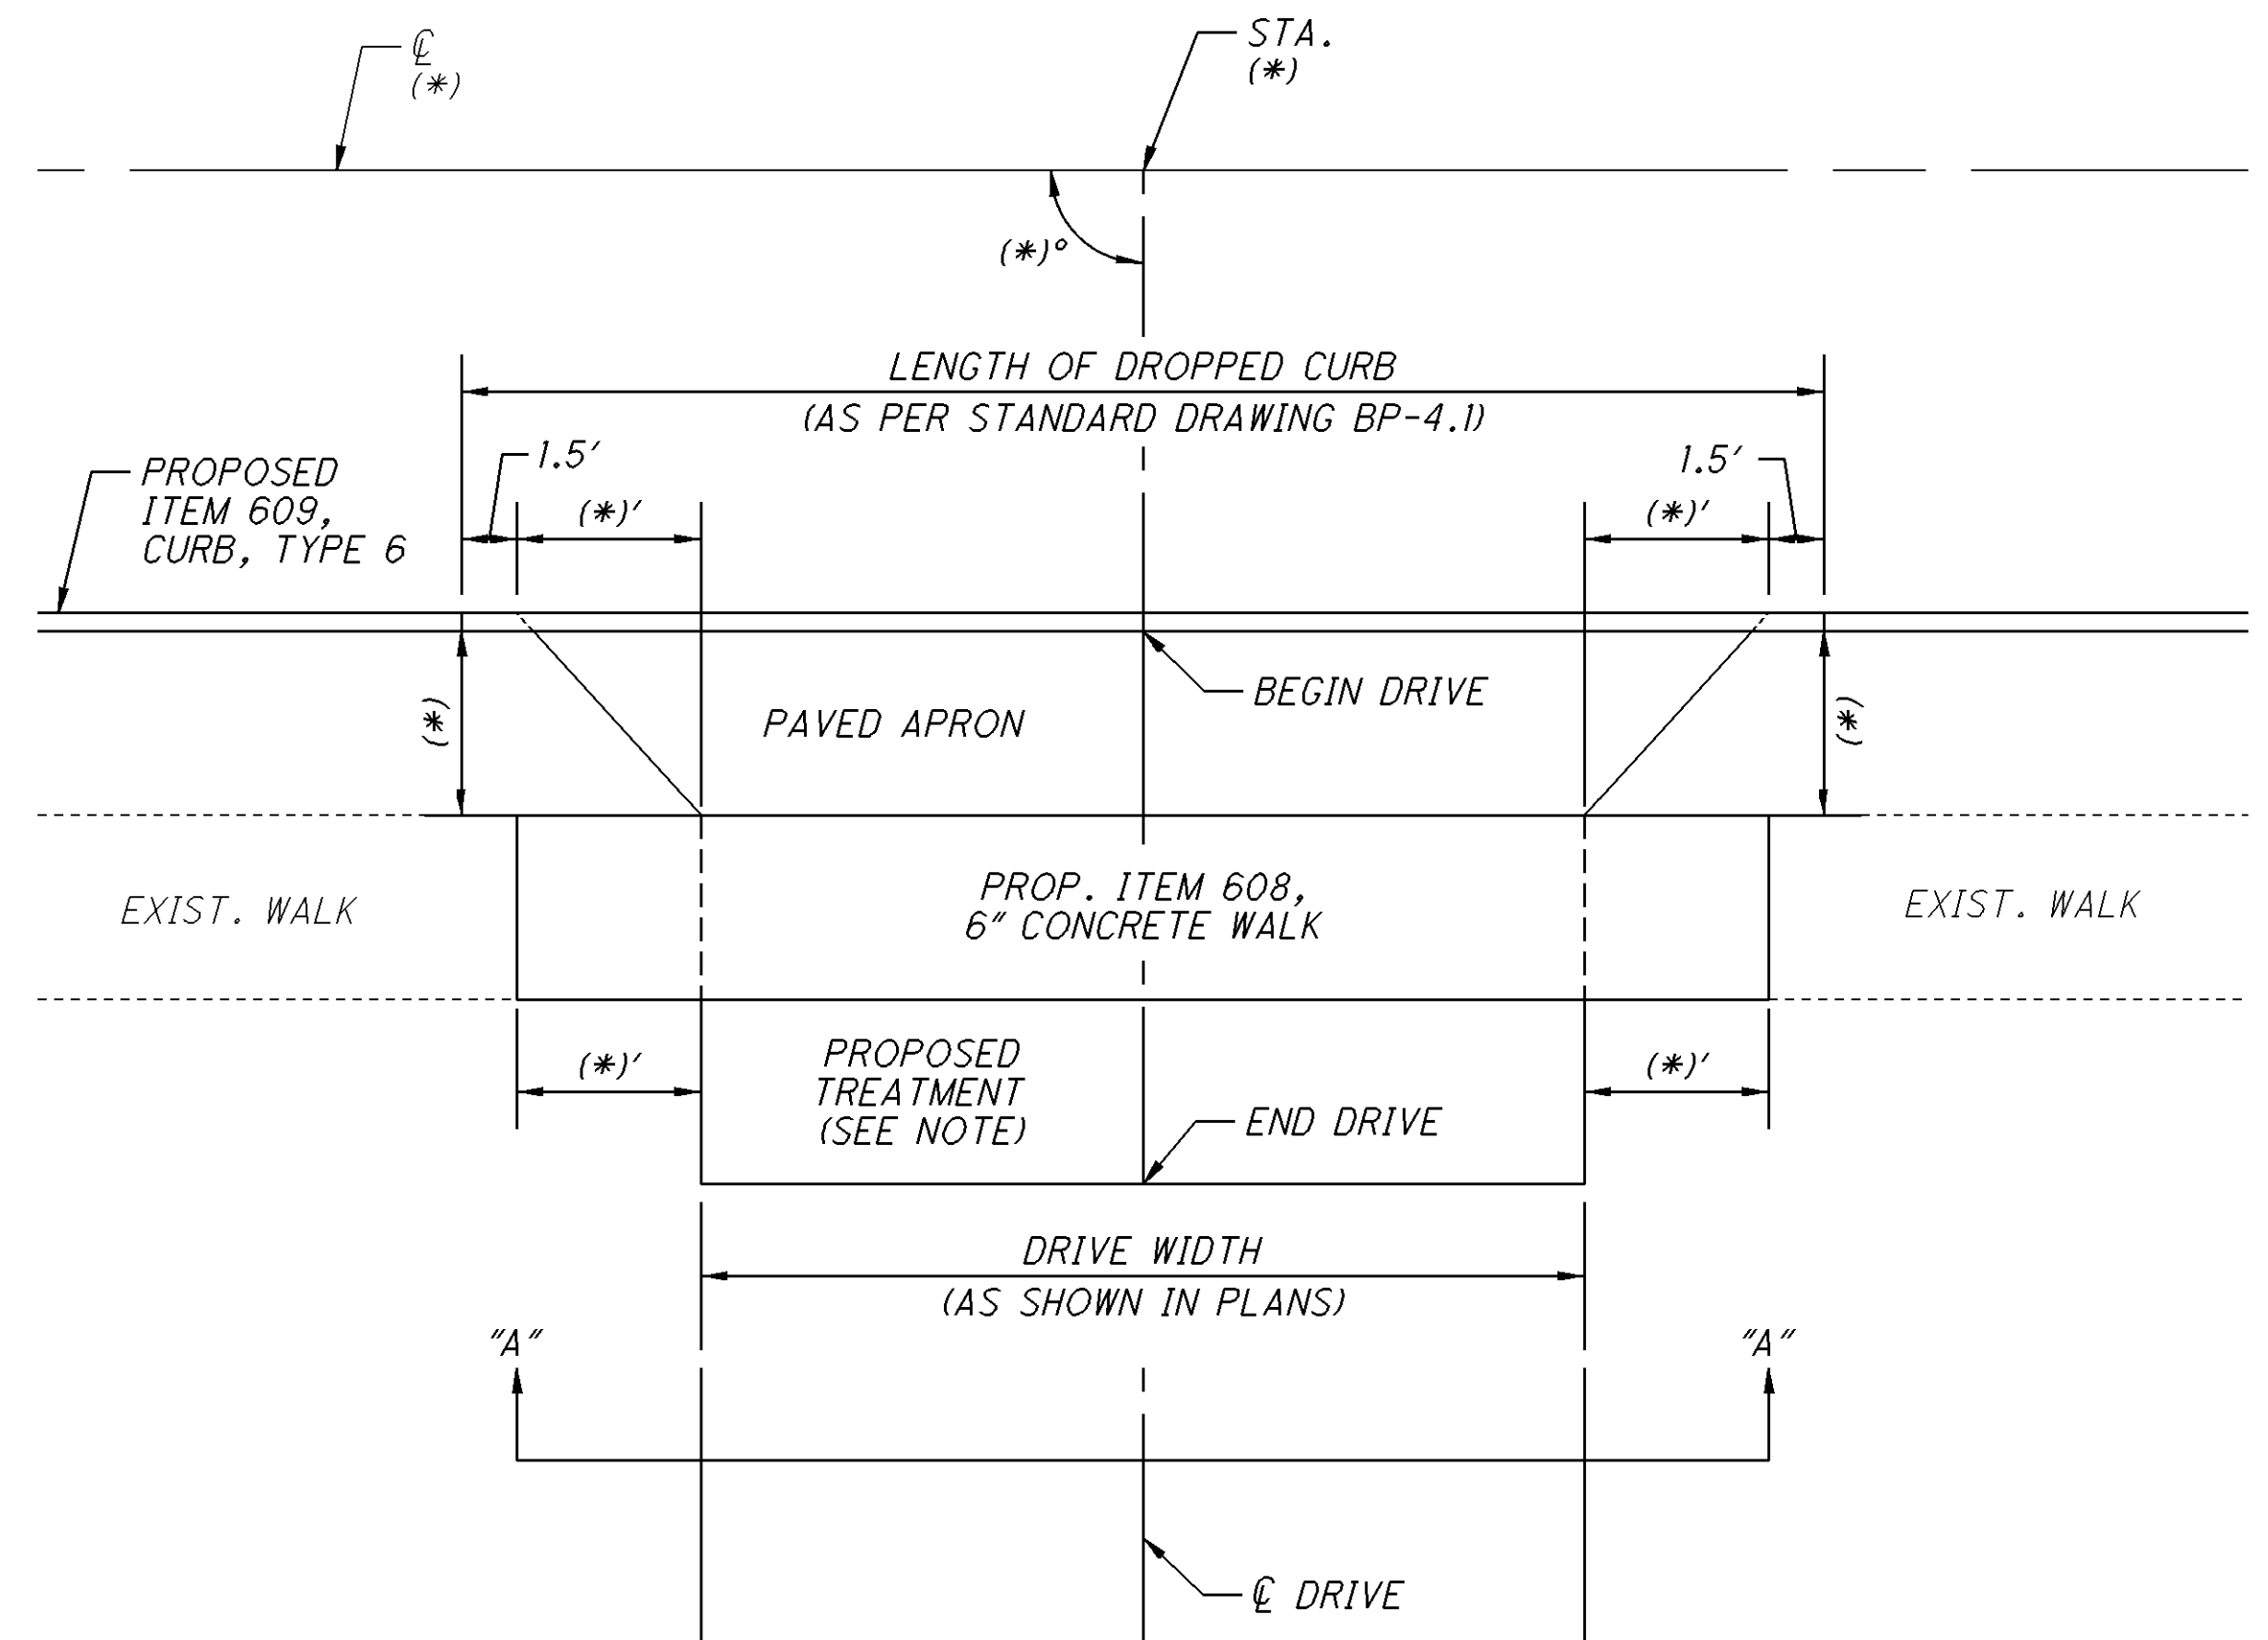




DEPRESSED CURB AT DRIVE



| Reference No.                               | Sheet No. | Location                           | Side  | 202                                | 203                             | 301                                                         | 609                | 613                                                           |
|---------------------------------------------|-----------|------------------------------------|-------|------------------------------------|---------------------------------|-------------------------------------------------------------|--------------------|---------------------------------------------------------------|
|                                             |           |                                    | Lt/Rt | PAVEMENT REMOVED,<br>ASPHALT<br>SY | EMBANKMENT<br>(10" Depth)<br>CY | ASPHALT CONCRETE<br>BASE, PG64-22<br>(10" Avg. Depth)<br>CY | CURB, TYPE 6<br>FT | LOW STRENGTH MORTAR<br>BACKFILL (TYPE 2)<br>(12" Depth)<br>CY |
|                                             |           | U.S. 40                            |       |                                    |                                 |                                                             |                    |                                                               |
| P-1                                         | 66        | S.R. 13/U.S. 40 Southwest Quadrant |       | 12.7                               |                                 | 8.6                                                         |                    |                                                               |
| P-2                                         | 66        | S.R. 13/U.S. 40 Northwest Quadrant |       | 16.1                               |                                 | 9.6                                                         |                    |                                                               |
|                                             |           |                                    |       |                                    |                                 |                                                             |                    |                                                               |
|                                             |           |                                    |       |                                    |                                 |                                                             |                    |                                                               |
|                                             |           | S.R. 13                            |       |                                    |                                 |                                                             |                    |                                                               |
| C-1                                         | 70, 72    | Sta. 11+91.0 to Sta. 18+95.0       | Rt.   | 186.7                              |                                 |                                                             | 704                | 62.3                                                          |
| C-2                                         | 70, 72    | Sta. 11+98.0 to Sta. 18+70.0       | Lt.   | 90.9                               |                                 |                                                             | 672                | 30.3                                                          |
|                                             |           |                                    |       |                                    |                                 |                                                             |                    |                                                               |
| R-1                                         | 70        | Sta. 11+91.89 to Sta. 12+55.68     | Lt.   | 37.0                               | 10.3                            |                                                             |                    |                                                               |
| R-2                                         | 70        | Sta. 12+67.28 to Sta. 13+24.84     | Lt.   | 47.5                               | 13.2                            |                                                             |                    |                                                               |
| R-3                                         | 70        | Sta. 13+42.87 to Sta. 13+90.73     | Lt.   | 41.6                               | 11.6                            |                                                             |                    |                                                               |
|                                             |           |                                    |       |                                    |                                 |                                                             |                    |                                                               |
|                                             |           |                                    |       |                                    |                                 |                                                             |                    |                                                               |
| Totals (Carried to Location 1b Sub-Summary) |           |                                    |       | 433                                | 36                              | 19                                                          | 1,376              | 93                                                            |



I:\ProjectData\LIC\92958\Design\Drainage\Sheets\92958\_DP002.dgn 17-OCT-2016 1:43PM jutz1

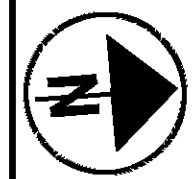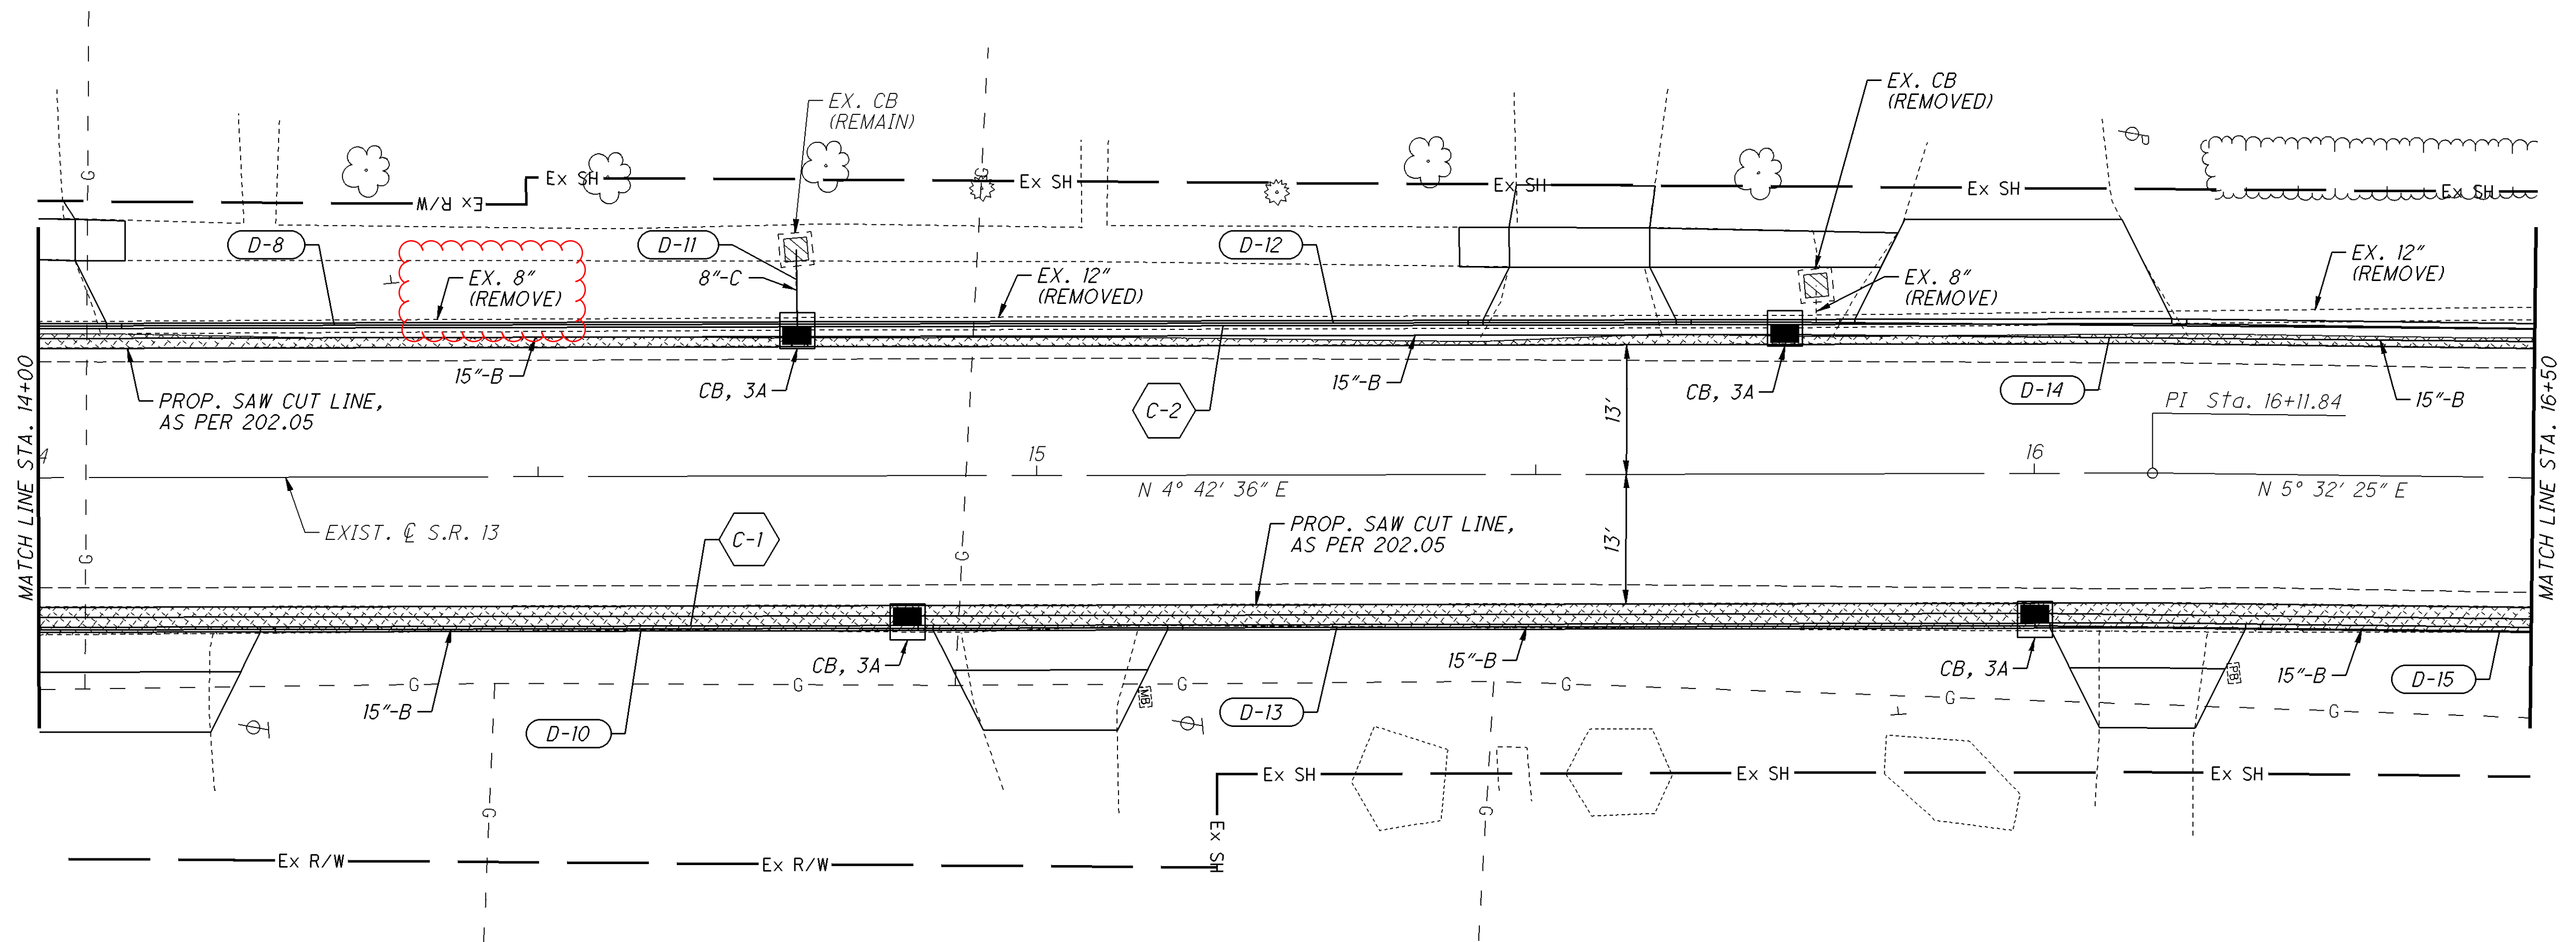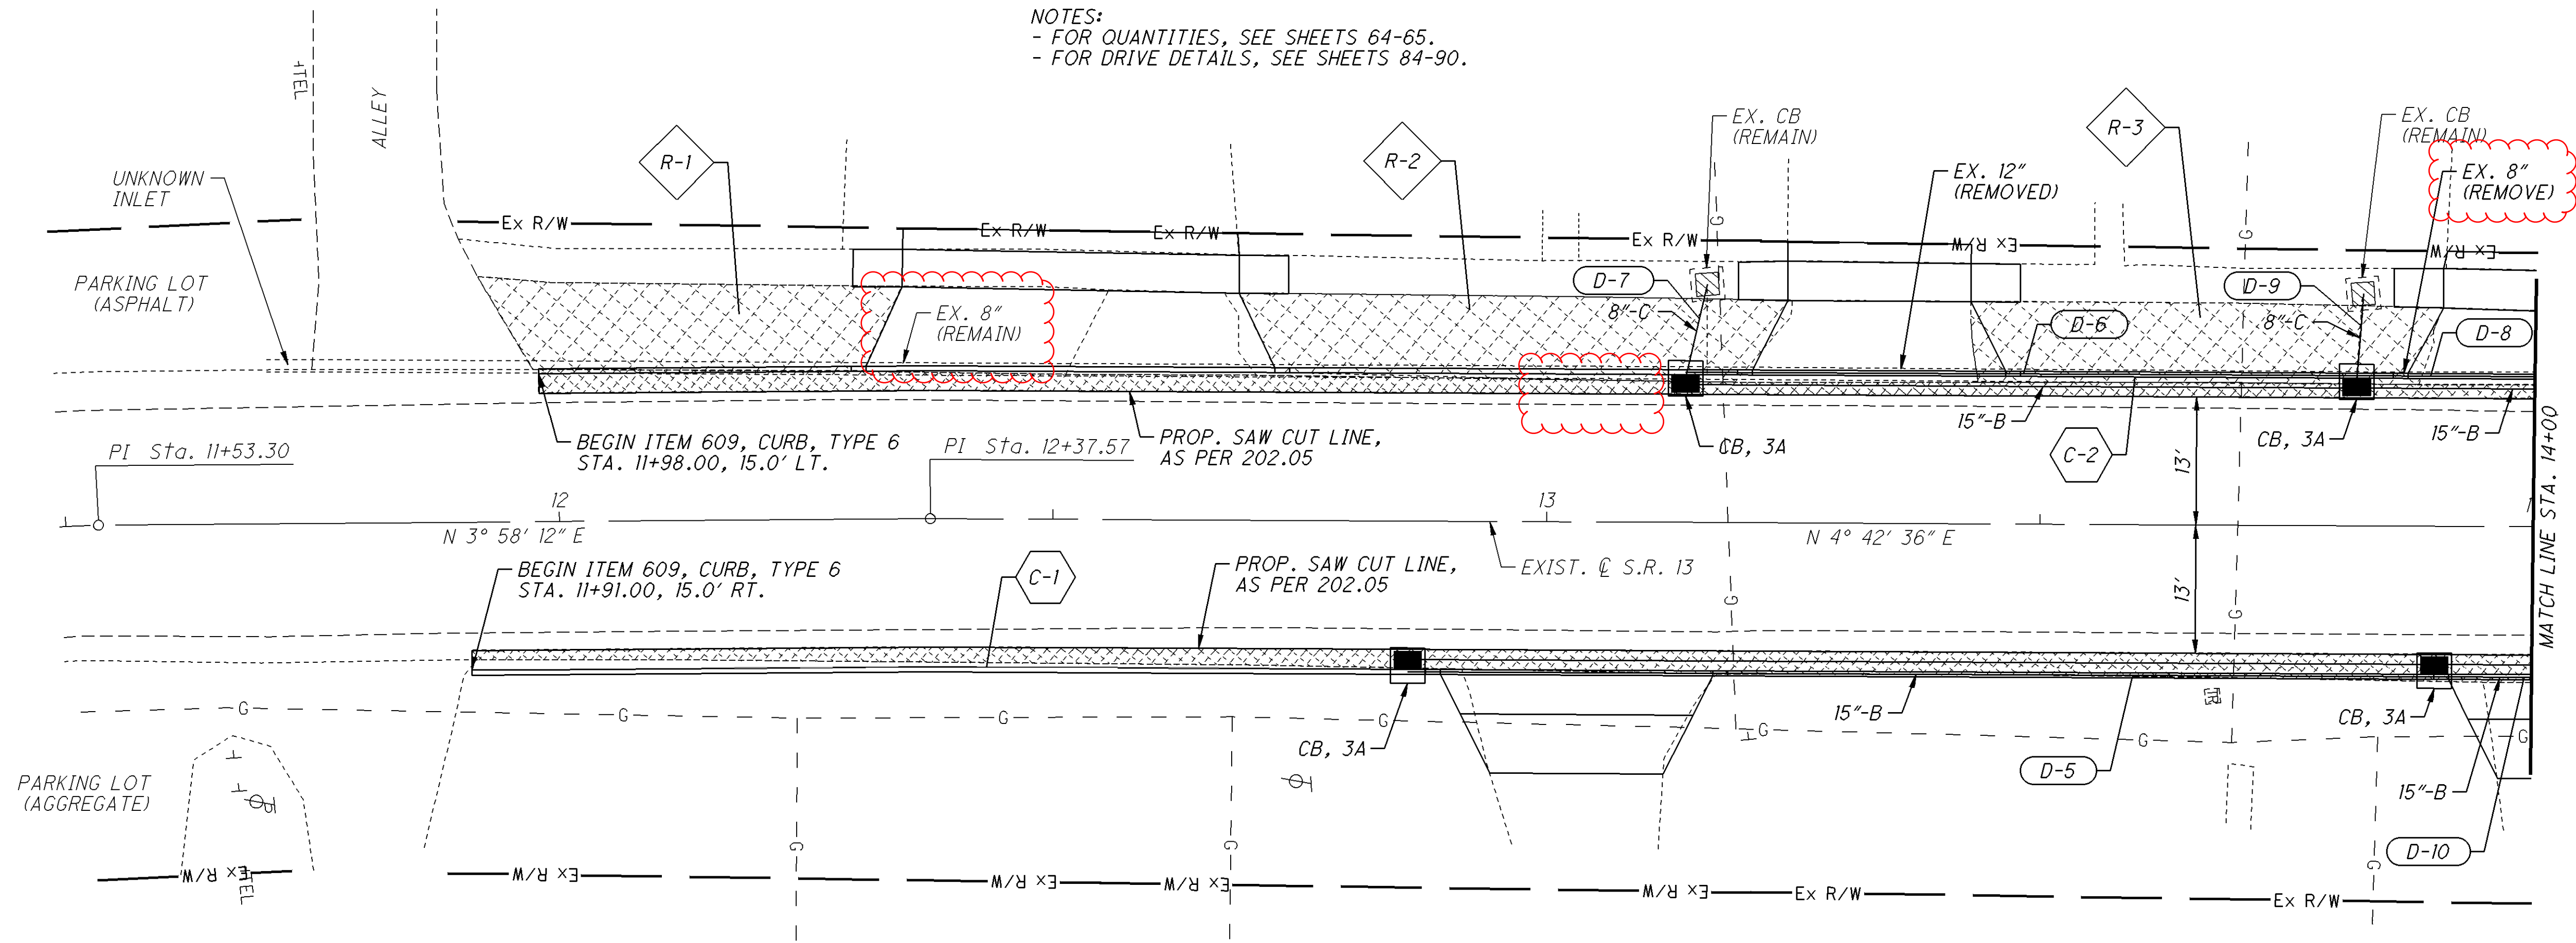

PLAN SHEET (S.R. 13)  
STA. 11+50 TO STA. 16+50


LIC-13-0.00

70  
90




I:\ProjectData\LIC\92958\Design\Drainage\Sheets\92958\_DF002.dgn 17-OCT-2016 1:56PM jutz1

LEFT SIDE PROFILE

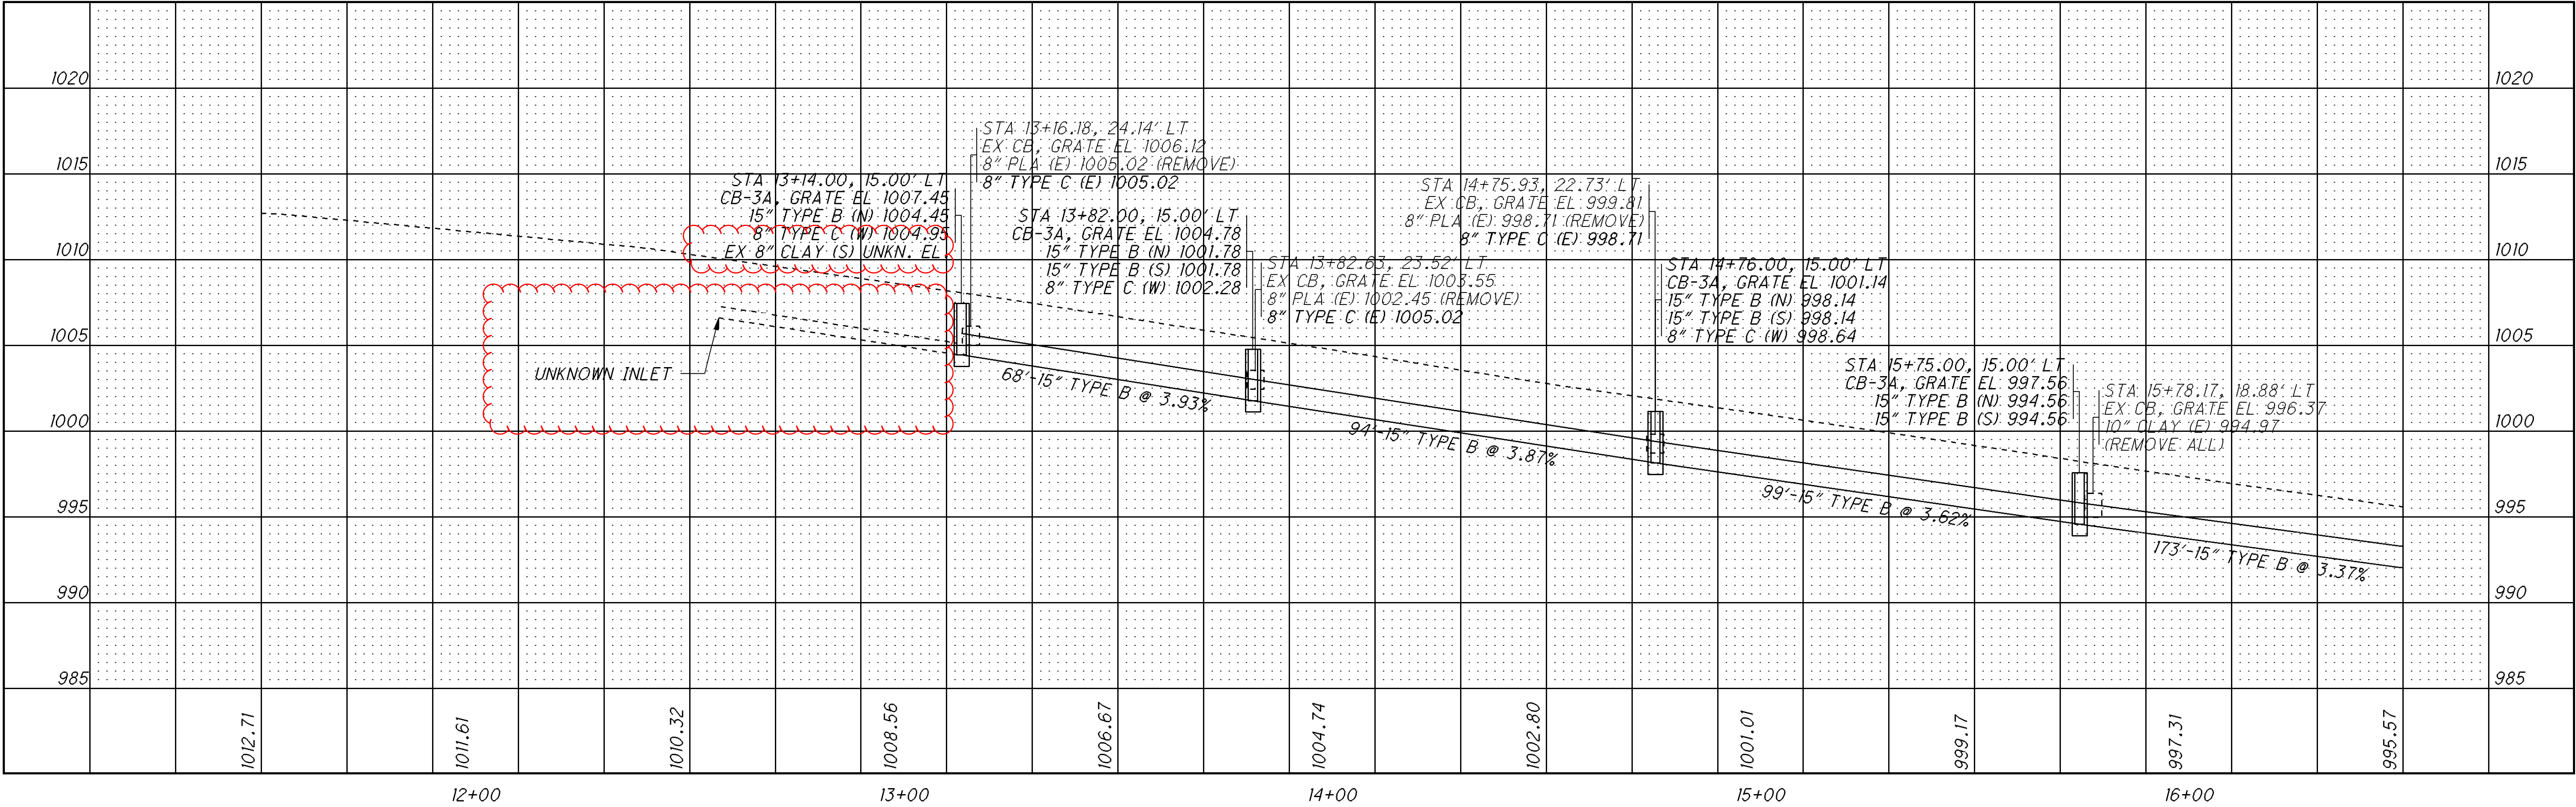


RIGHT SIDE PROFILE

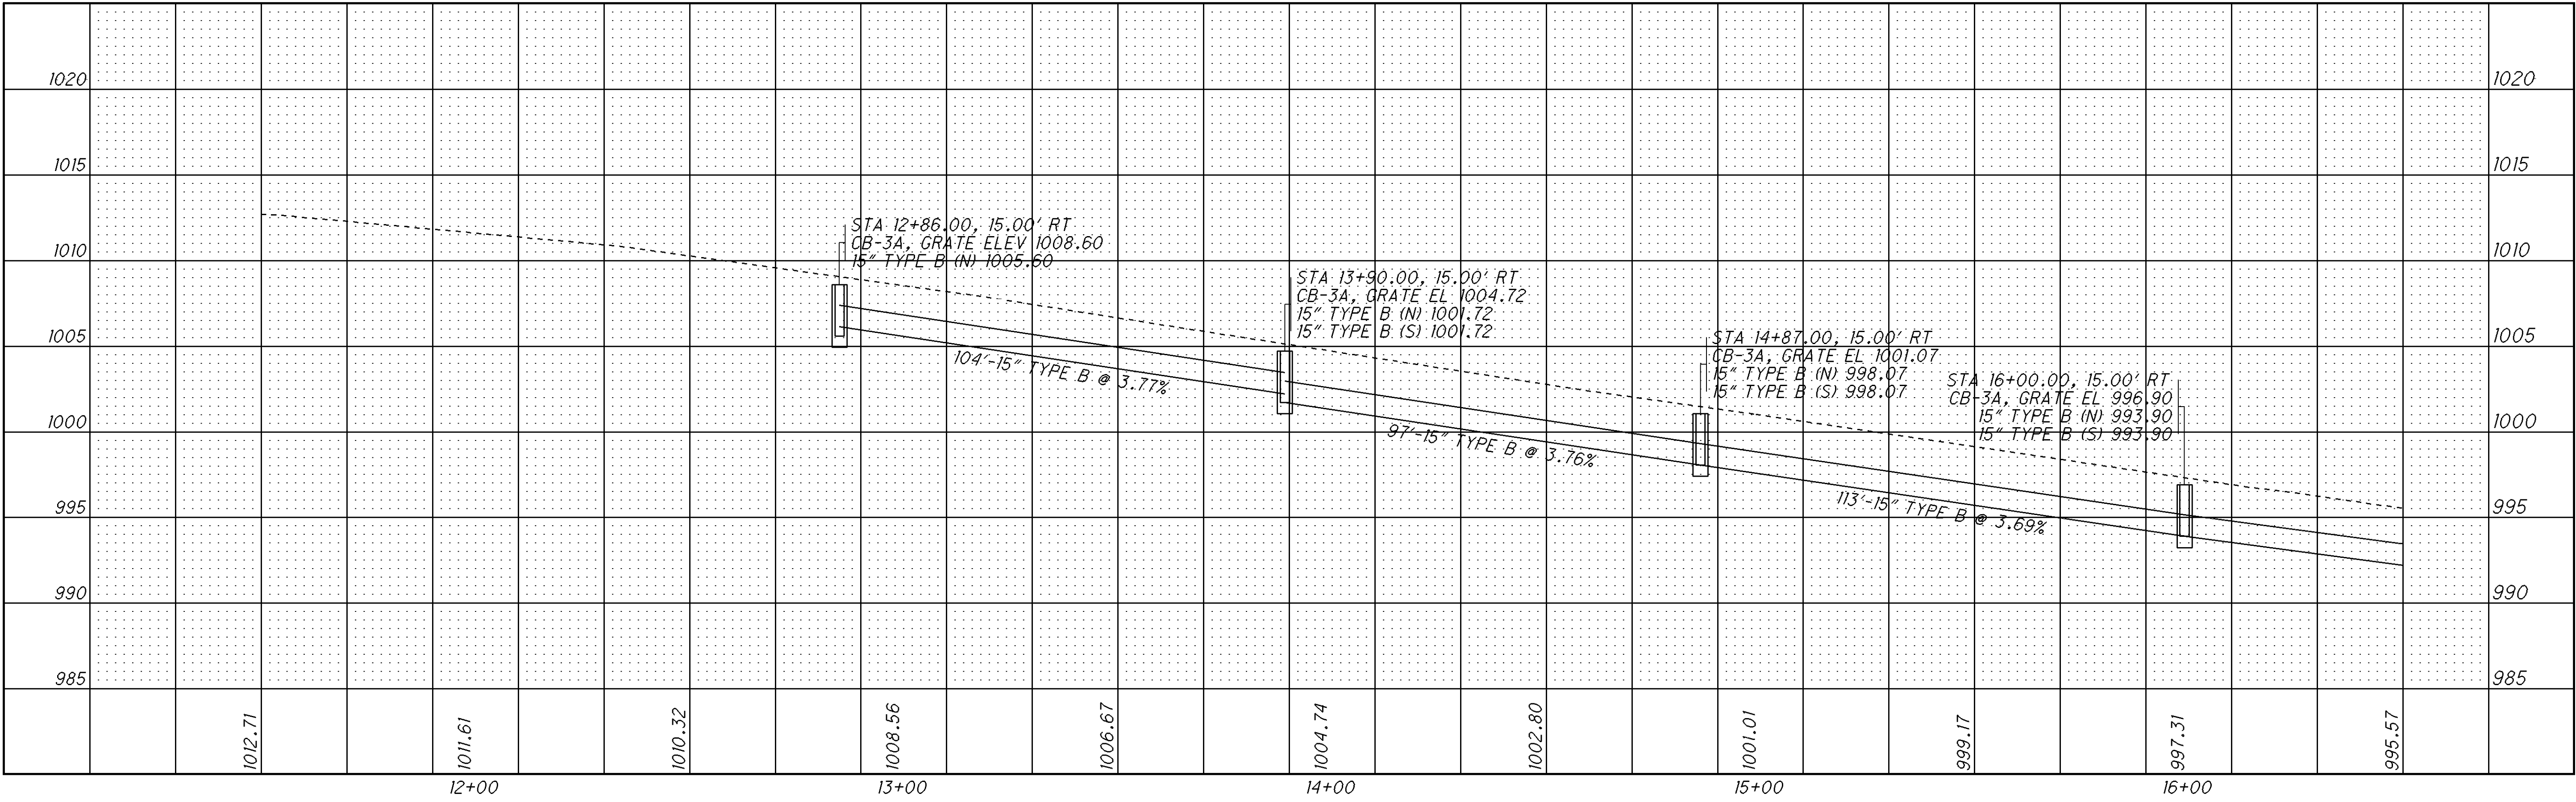



I:\ProjectData\LIC\92958\Design\Drainage\Sheets\92958\_XS002.dgn 17-OCT-2016 2:18PM jutz1

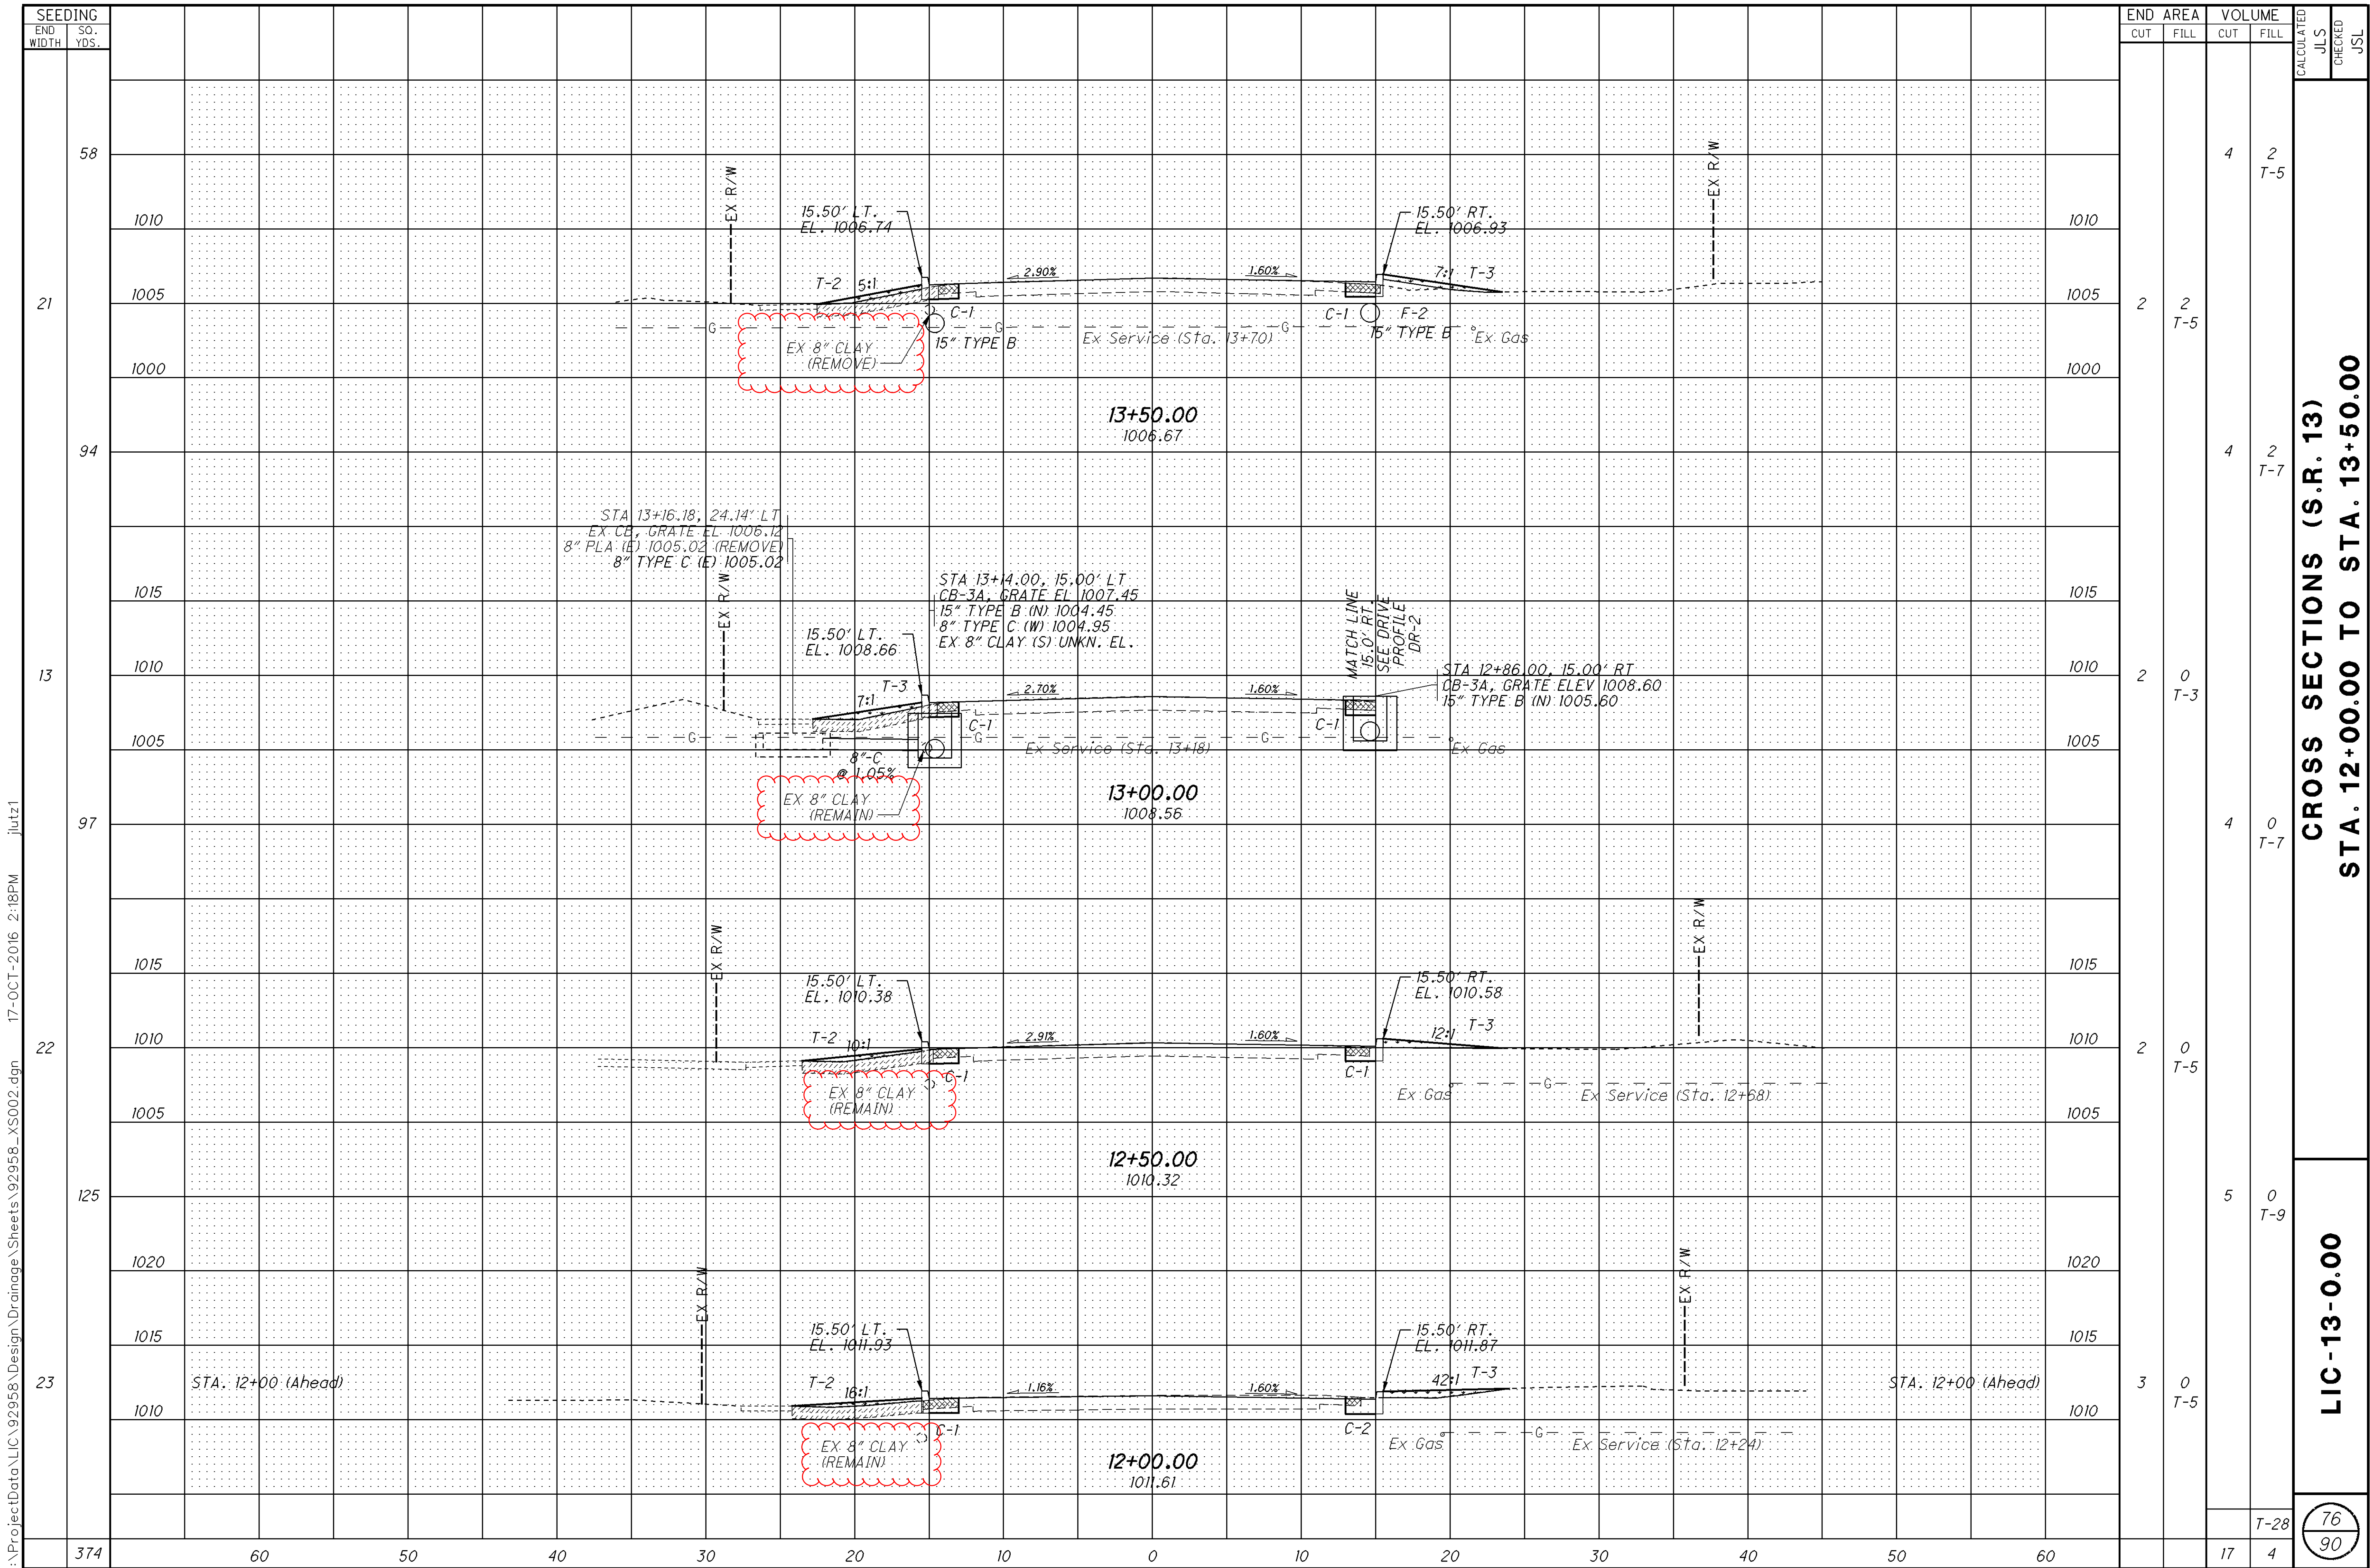


CROSS SECTIONS (S.R. 13)  
STA. 12+00.00 TO STA. 13+50.00

LIC-13-0.00

76  
90



I:\ProjectData\LIC\92958\Design\Drainage\Sheets\92958\_XS002.dgn 17-OCT-2016 2:18PM jutz1

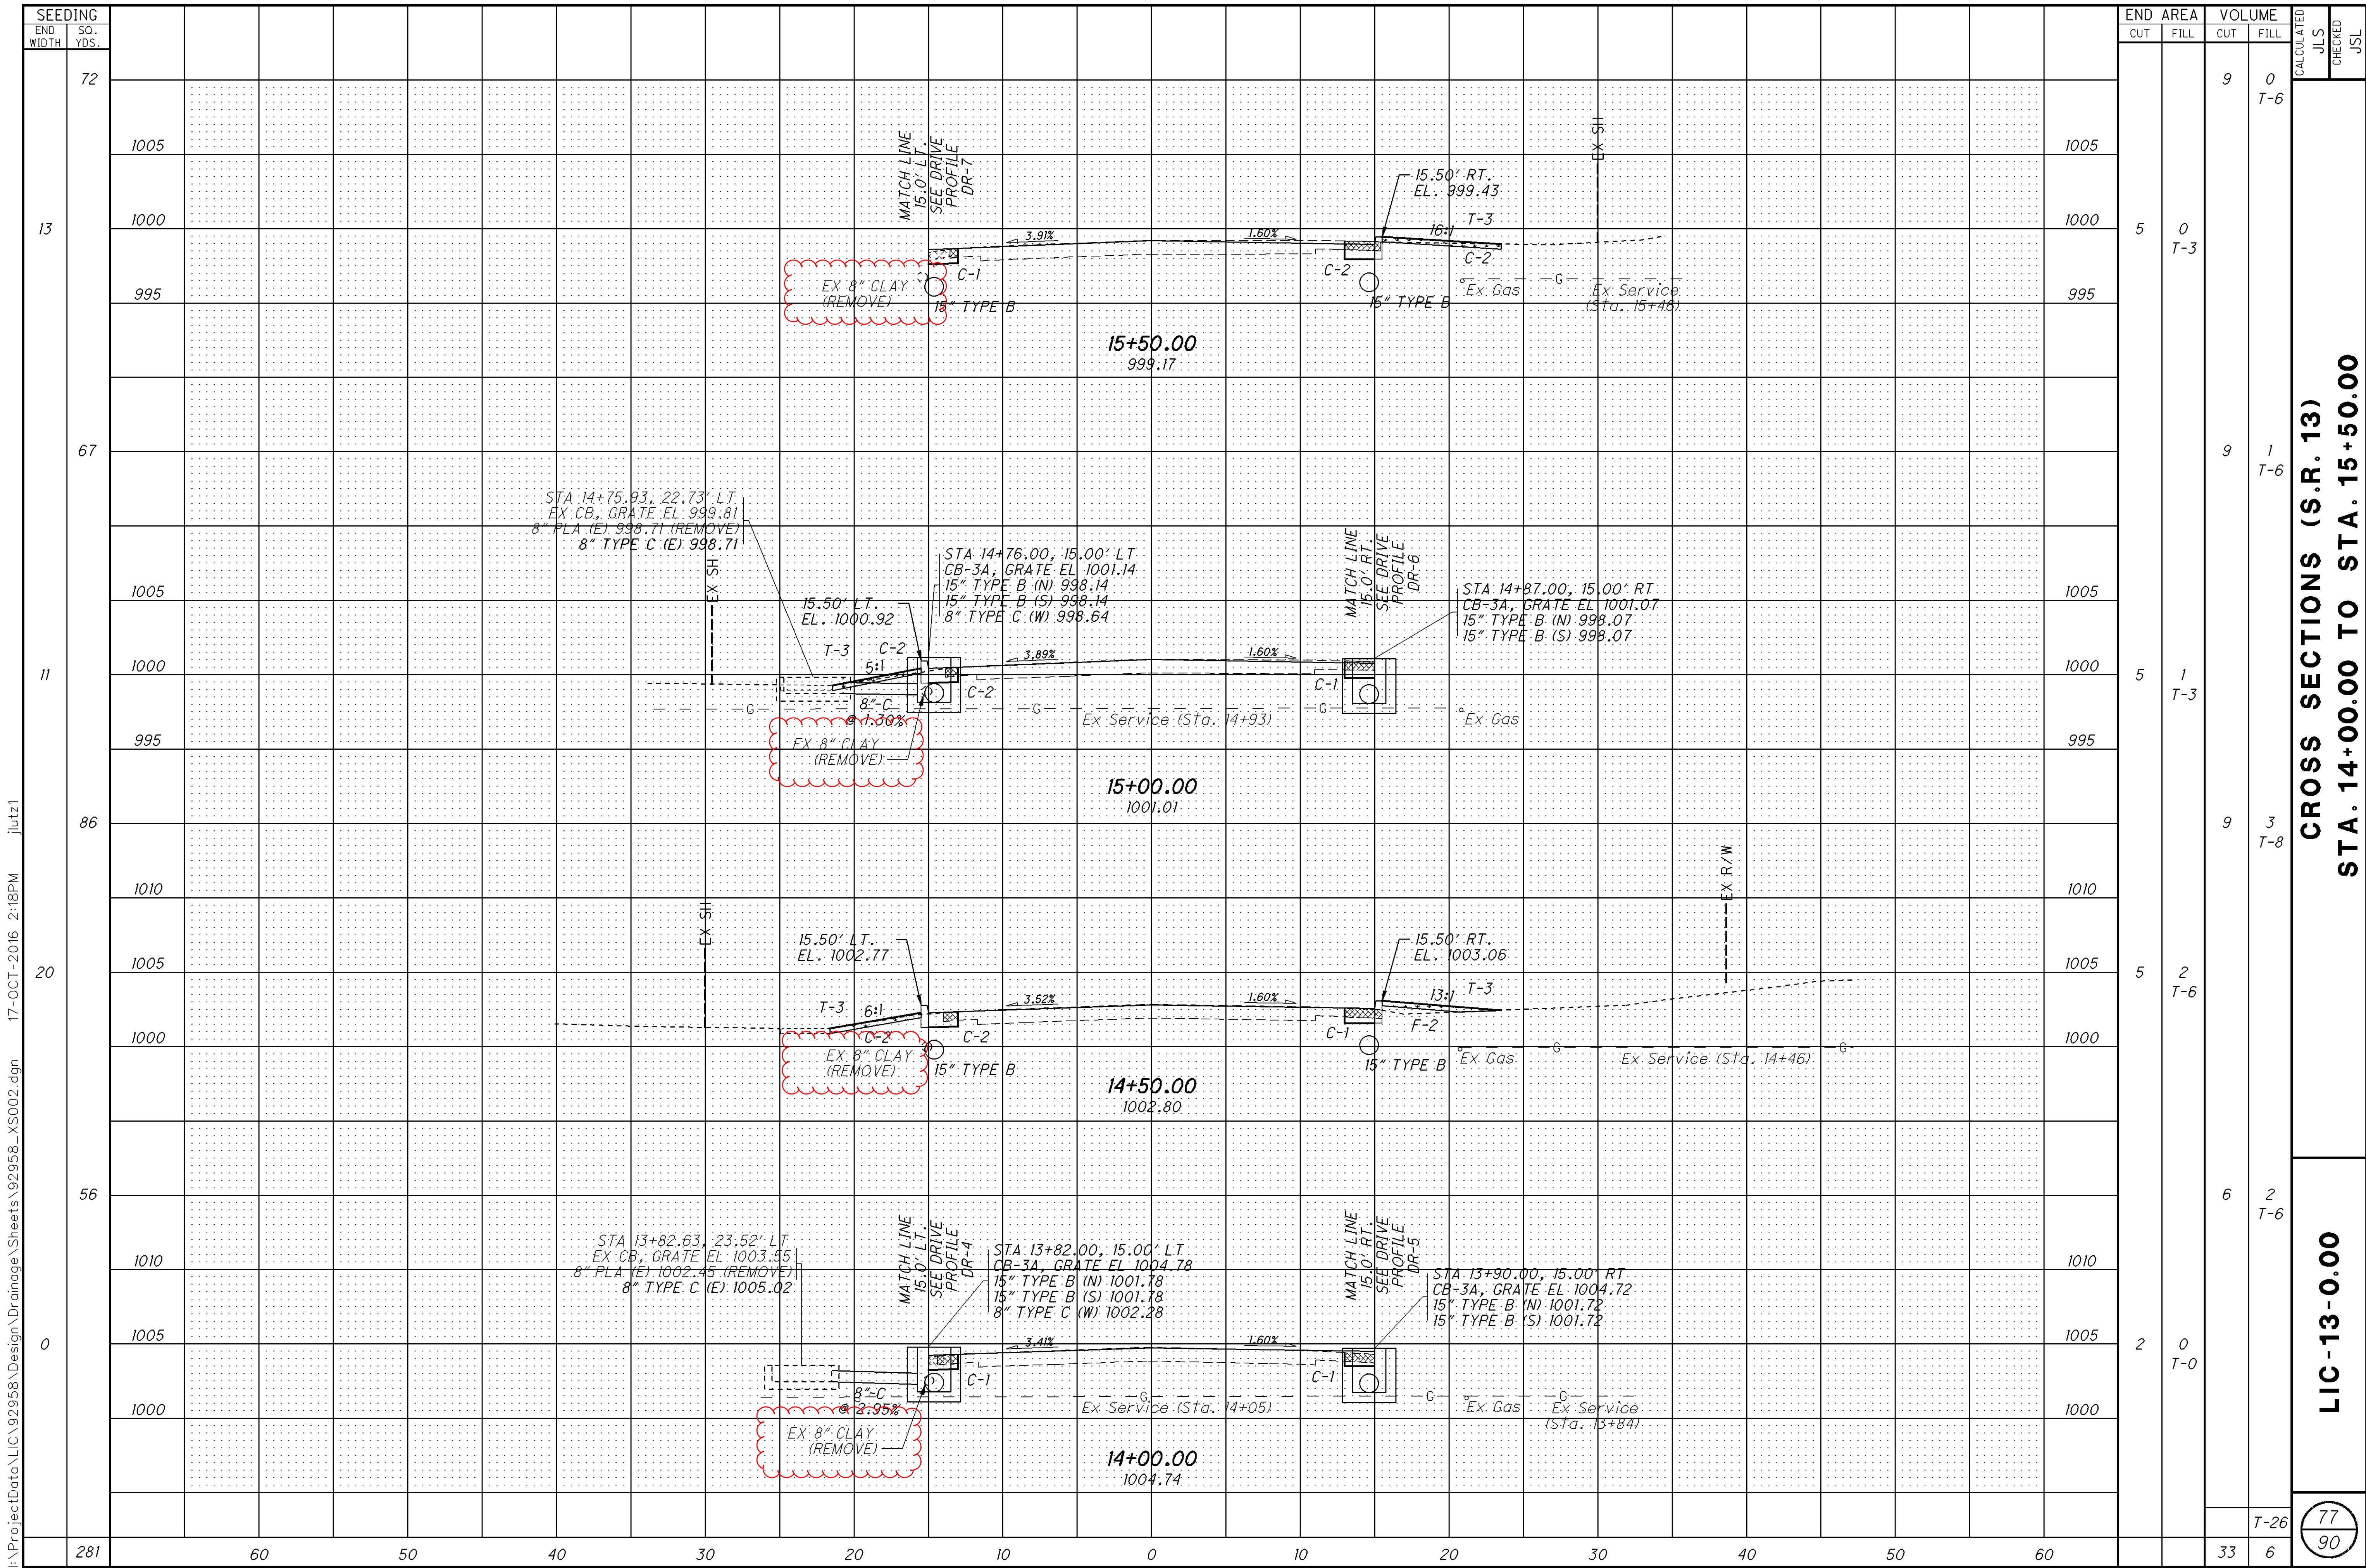


CROSS SECTIONS (S.R. 13)  
STA. 14+00.00 TO STA. 15+50.00


LIC-13-0.00

77  
90



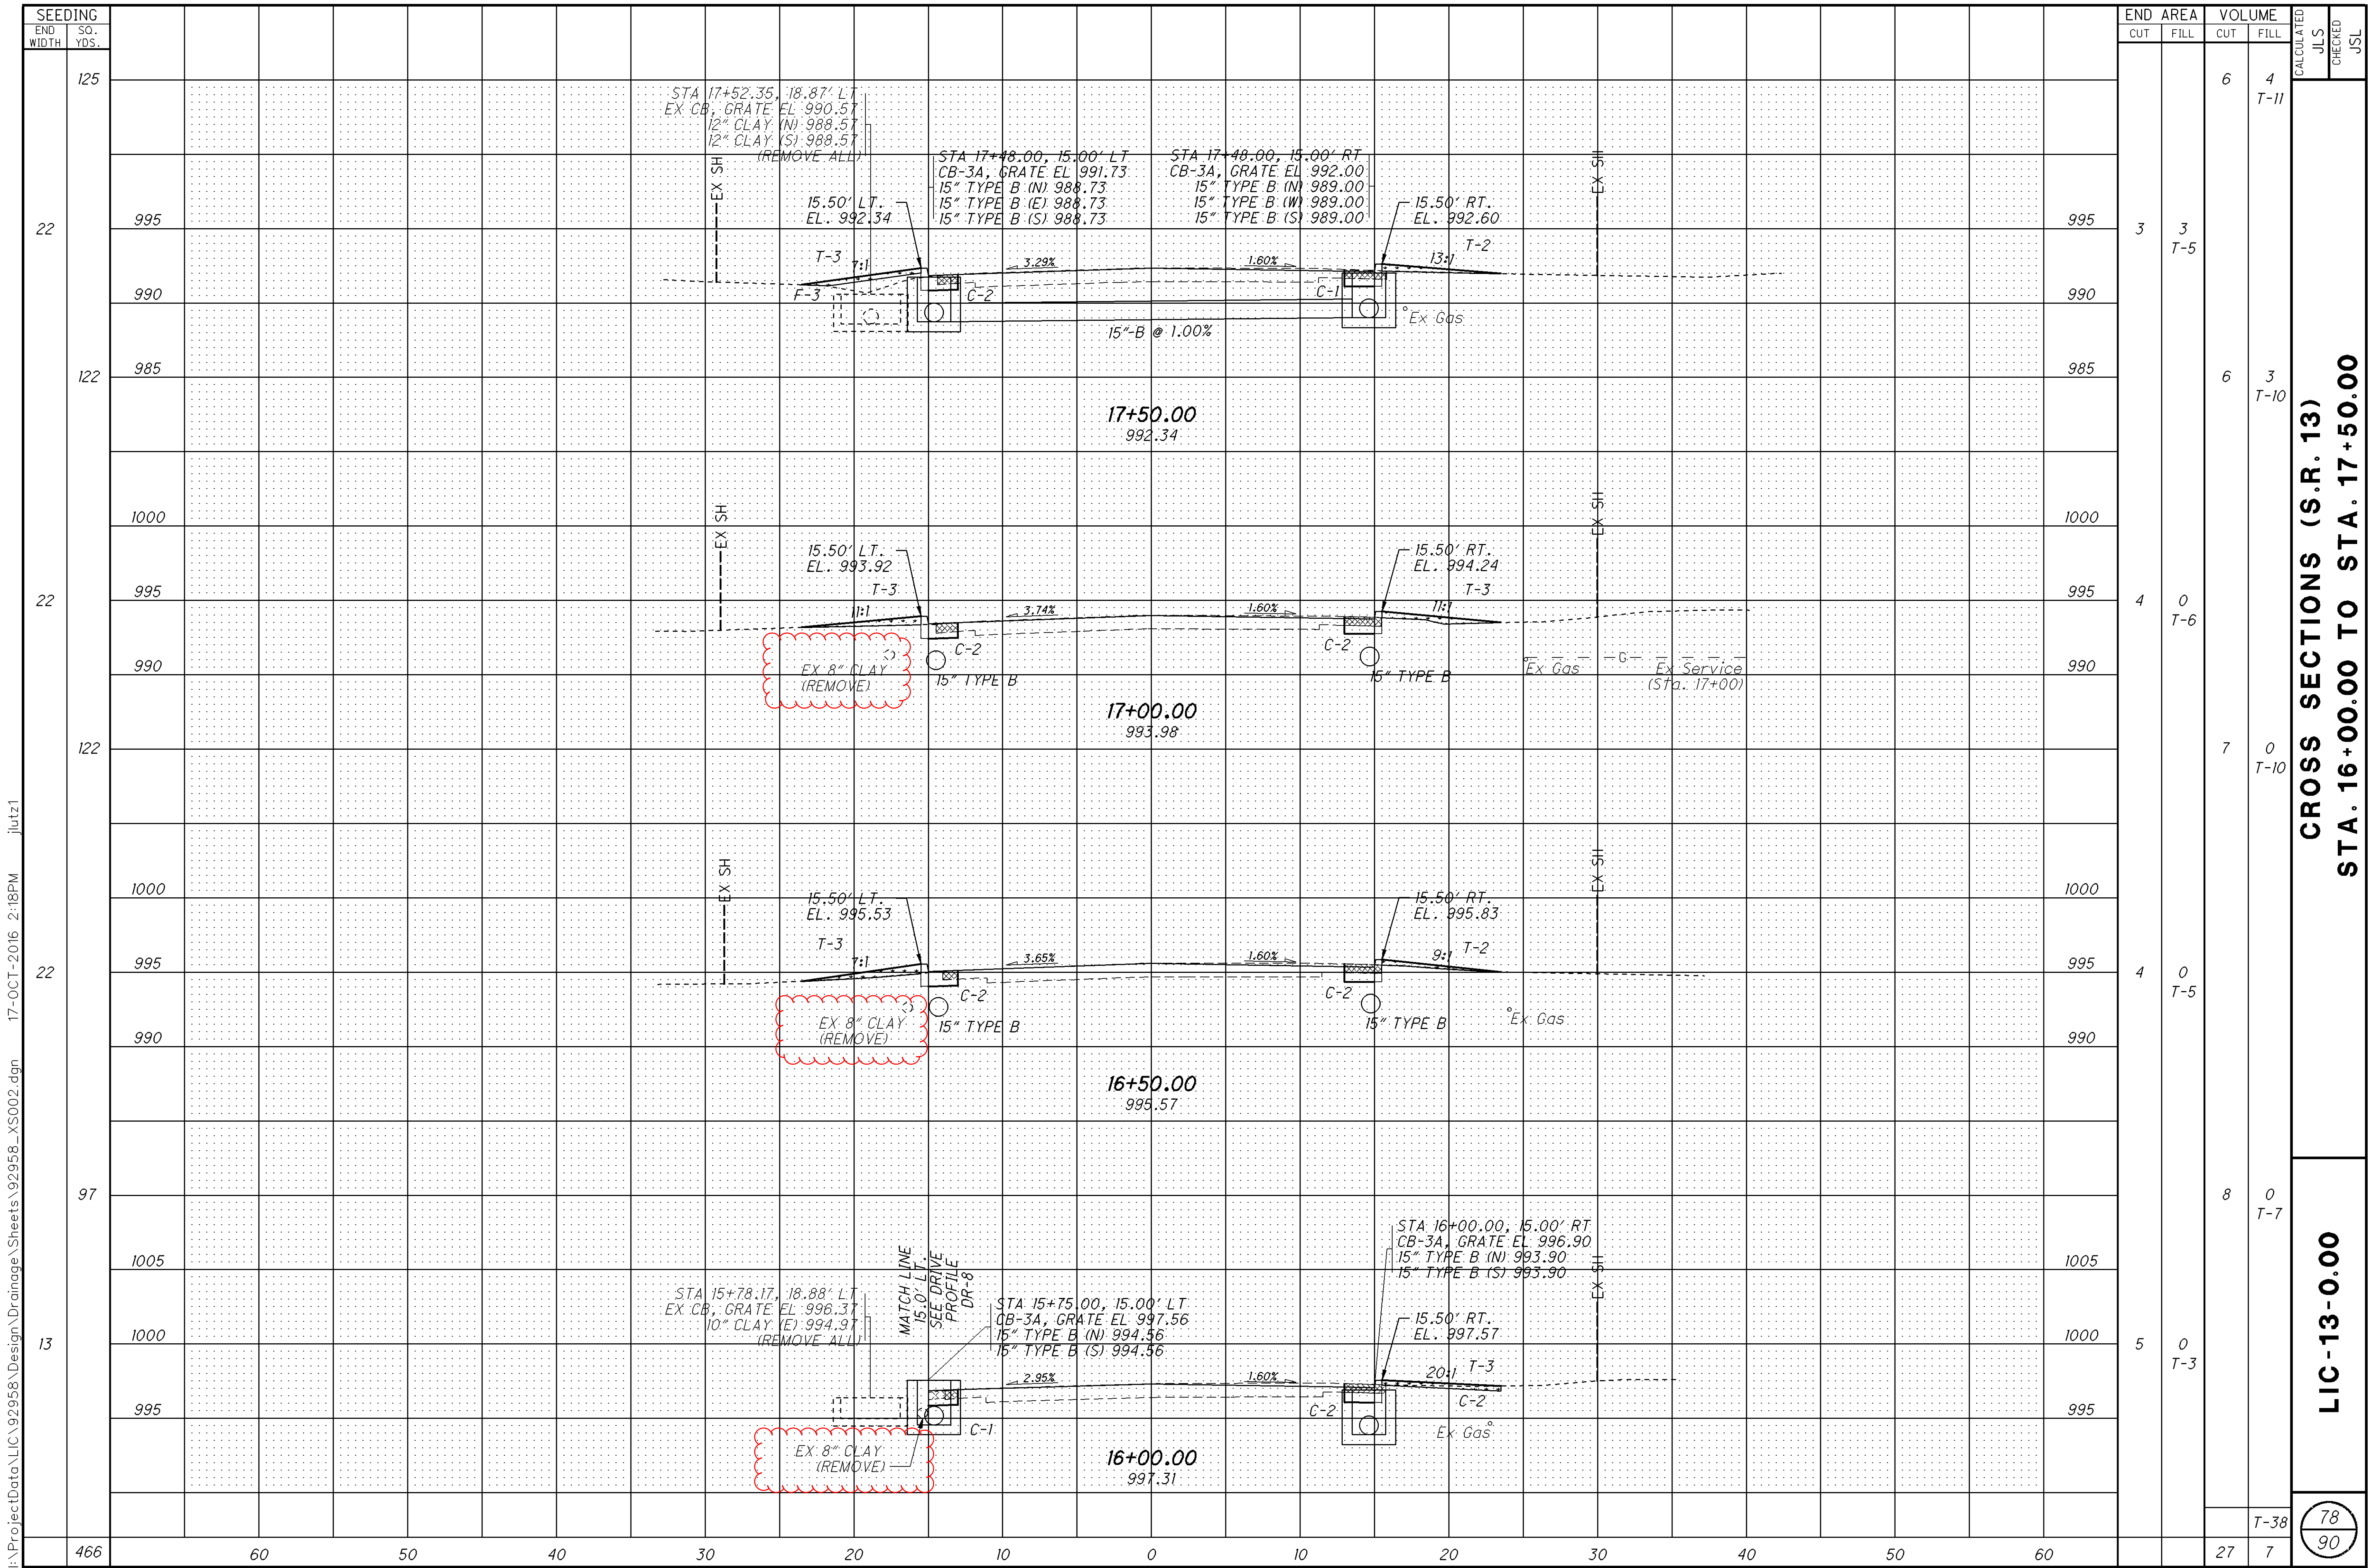




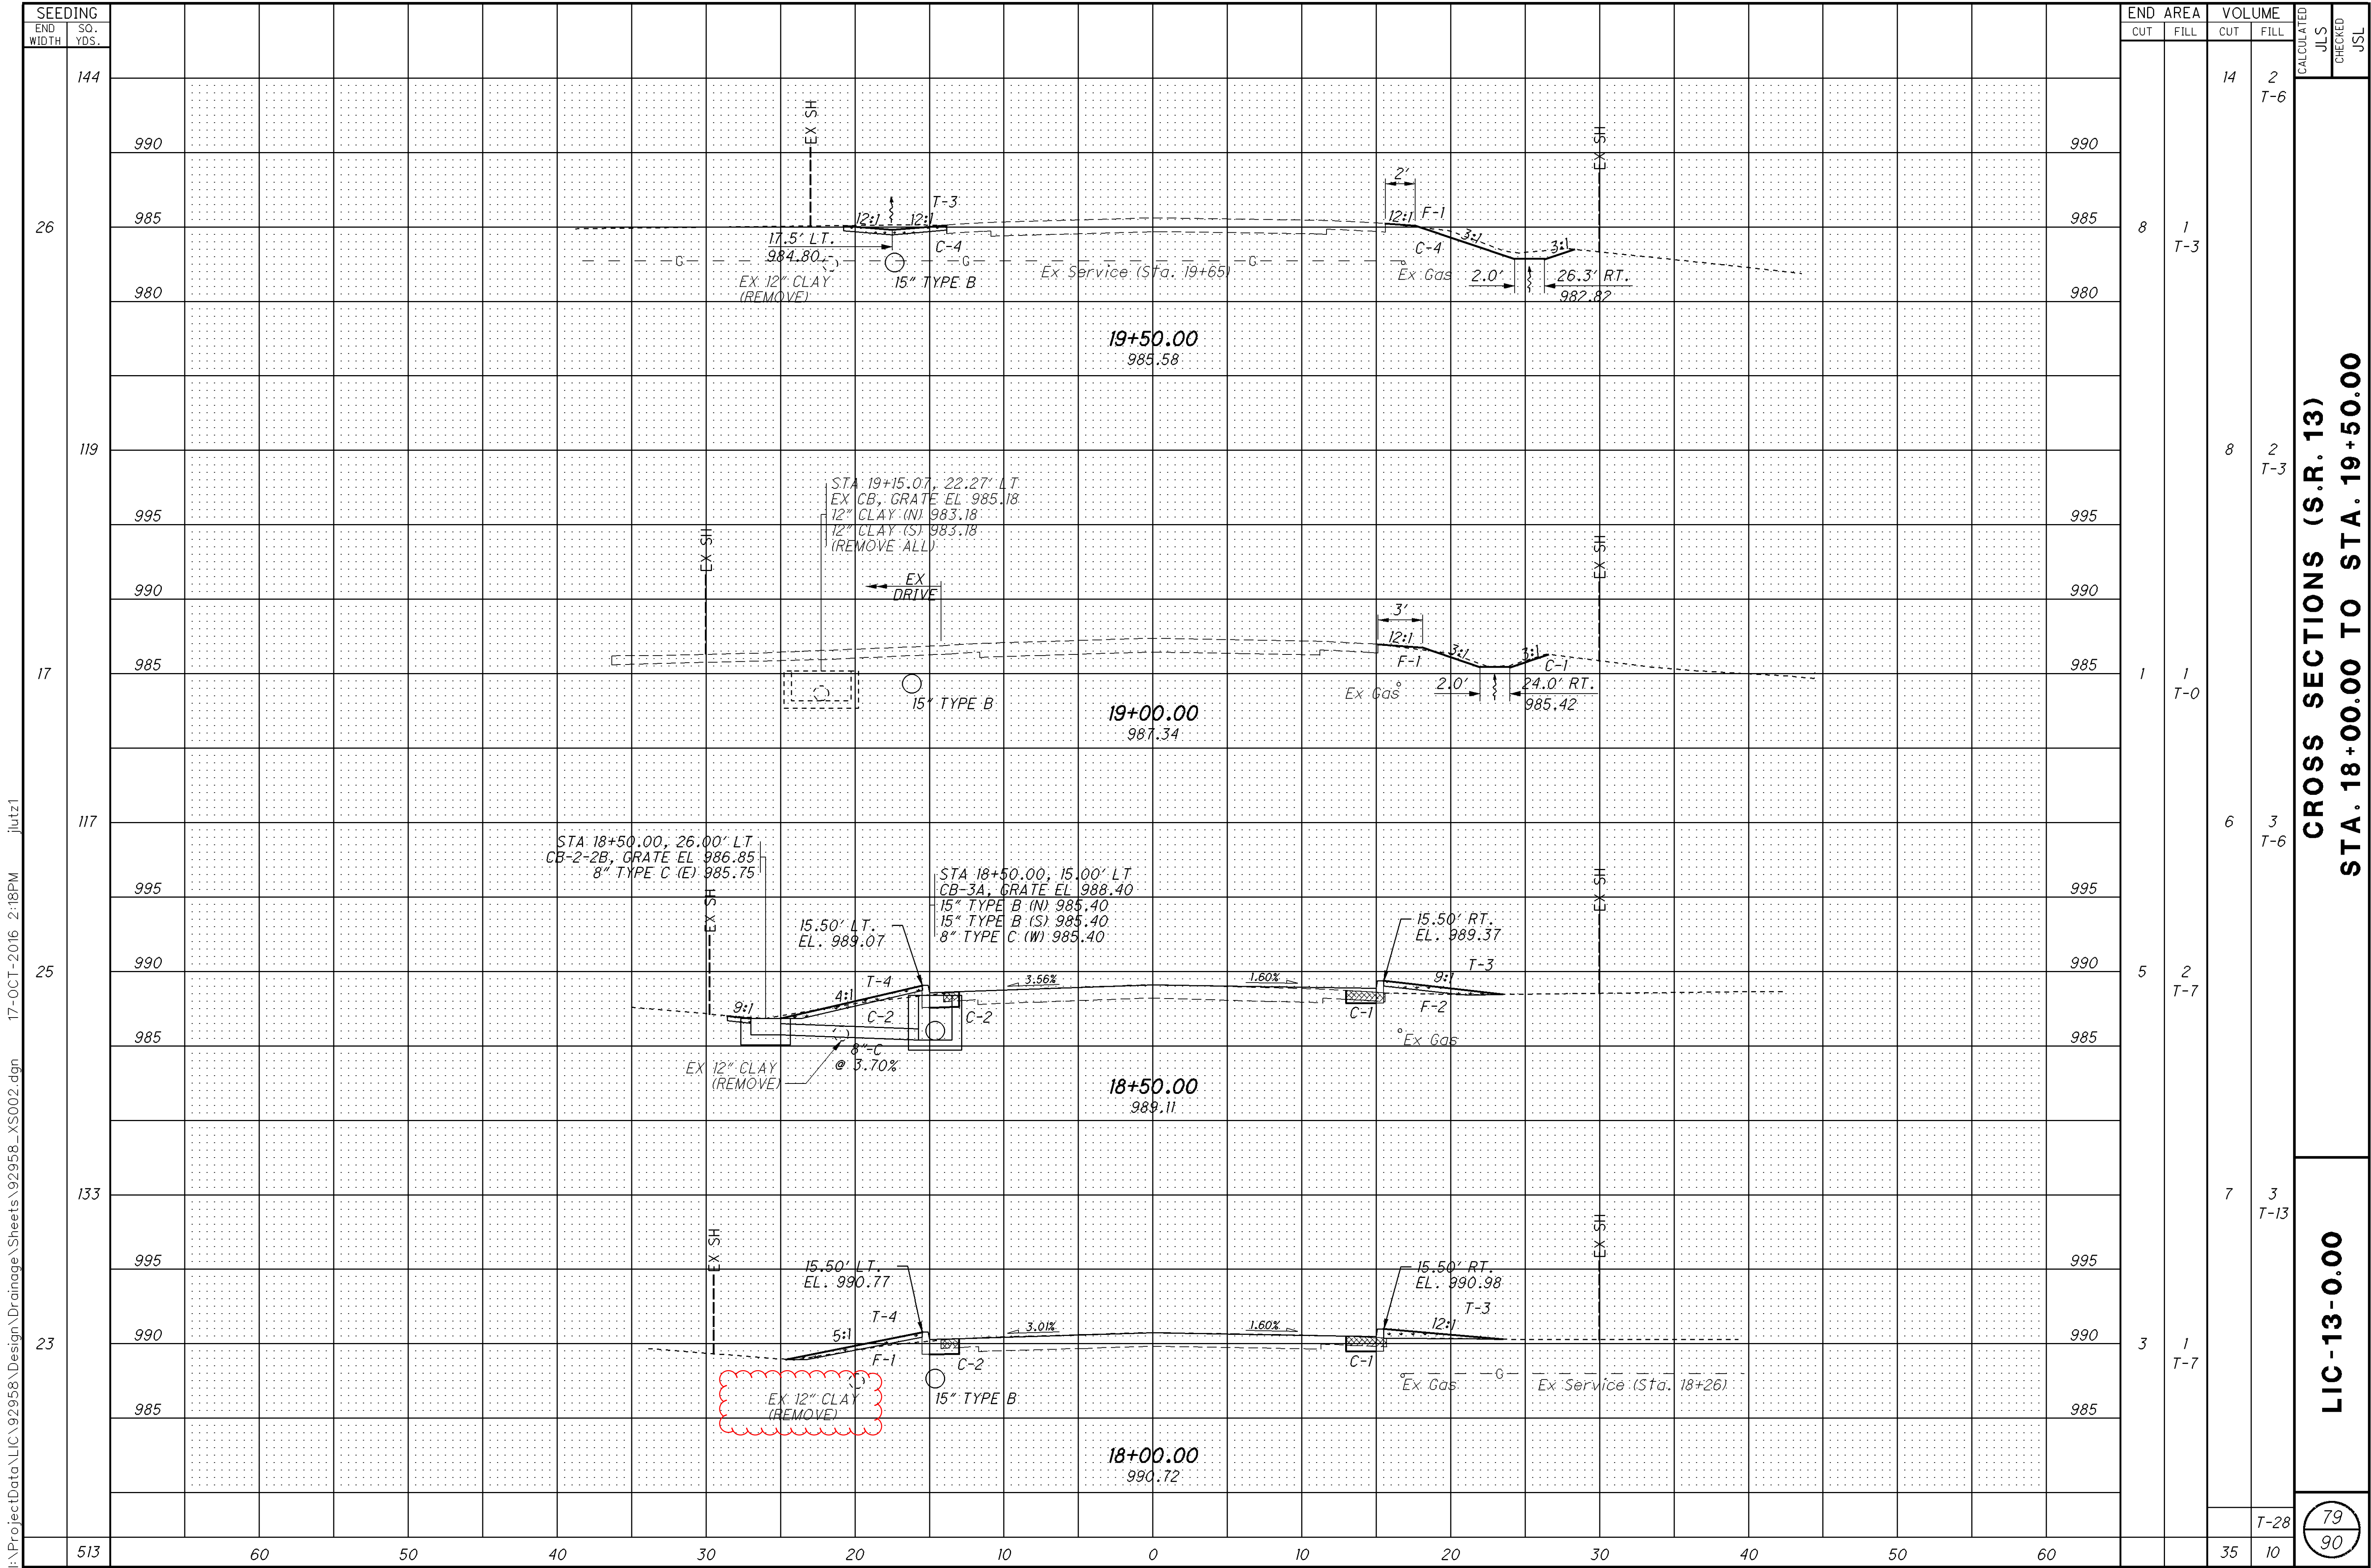



| Reference No.                                | Sheet No. | Location     | Side    | Description | Exist Surface | Apron Area<br>(Calculated By Computer) | Treated Area<br>(Calculated By Computer) | Total Area<br>(Apron Area + Treated Area) | 202                          |              | 203   | 204                    | 301   | 304   | 407                                               | 441                                                               | 608              |
|----------------------------------------------|-----------|--------------|---------|-------------|---------------|----------------------------------------|------------------------------------------|-------------------------------------------|------------------------------|--------------|-------|------------------------|-------|-------|---------------------------------------------------|-------------------------------------------------------------------|------------------|
|                                              |           |              |         |             |               |                                        |                                          |                                           | PAVEMENT REMOVED,<br>ASPHALT | WALK REMOVED | 4.00" | SUBGRADE<br>COMPACTION | 4.75" | 8.00" | NON-TRACKING<br>TACK COAT,<br>@ 0.040 GAL/SQ. YD. | ASPHALT CONCRETE<br>SURFACE COURSE,<br>TYPE 1, (448), (DRIVEWAYS) | 6" CONCRETE WALK |
|                                              |           |              | Lt./Rt. |             |               |                                        |                                          |                                           |                              |              | CY    | SY                     | CY    | CY    | GAL                                               | CY                                                                | SF               |
|                                              |           | S.R. 13      |         |             |               |                                        |                                          |                                           |                              |              |       |                        |       |       |                                                   |                                                                   |                  |
| DR-1                                         | 85        | Sta. 12+51.7 | Lt.     | Residential | Asph./Agg.    | 32.6                                   | 8.3                                      | 40.9                                      | 35.5                         | 168.6        | 4.0   | 32.6                   | 4.4   | 1.1   | 1.4                                               | 1.2                                                               | 168.6            |
| DR-2                                         | 85        | Sta. 13+03.1 | Rt.     | Residential | Aggregate     | 11.4                                   | 13.8                                     | 25.2                                      |                              |              |       | 11.4                   | 1.6   | 1.9   | 0.5                                               | 0.4                                                               |                  |
| DR-3                                         | 85        | Sta. 13+33.9 | Lt.     | Residential | Asph./Agg.    | 17.3                                   | 4.1                                      | 21.4                                      | 18.9                         | 112.2        | 2.1   | 17.3                   | 2.3   | 0.6   | 0.7                                               | 0.7                                                               | 112.2            |
| DR-4                                         | 85        | Sta. 13+97.2 | Lt.     | Residential | Asph./Agg.    | 11.7                                   | 2.5                                      | 14.2                                      | 13.1                         | 93.3         | 1.5   | 11.7                   | 1.6   | 0.4   | 0.5                                               | 0.5                                                               | 93.3             |
| DR-5                                         | 85        | Sta. 14+06.8 | Rt.     | Residential | Aggregate     | 12.8                                   | 15.9                                     | 28.7                                      |                              |              |       | 12.8                   | 1.7   | 2.1   | 0.6                                               | 0.5                                                               |                  |
| DR-6                                         | 85        | Sta. 15+01.3 | Rt.     | Residential | Aggregate     | 9.6                                    | 11.1                                     | 20.7                                      |                              |              |       | 9.6                    | 1.3   | 1.5   | 0.4                                               | 0.4                                                               |                  |
| DR-7                                         | 86        | Sta. 15+54.2 | Lt.     | Residential | Asph./Agg.    | 9.9                                    | 6.7                                      | 16.6                                      | 12.4                         | 138.4        | 1.4   | 9.9                    | 1.4   | 0.9   | 0.4                                               | 0.4                                                               | 164.7            |
| DR-8                                         | 86        | Sta. 15+97.9 | Lt.     | Commercial  | Asphalt       | 29.8                                   | 0.0                                      | 29.8                                      | 36.9                         |              |       | 29.8                   | 4.0   |       | 1.2                                               | 1.1                                                               |                  |
| DR-9                                         | 86        | Sta. 16+11.2 | Rt.     | Residential | Aggregate     | 7.9                                    | 8.5                                      | 16.4                                      |                              |              |       | 7.9                    | 1.1   | 1.2   | 0.4                                               | 0.3                                                               |                  |
| DR-10                                        | 86        | Sta. 17+59.9 | Rt.     | Residential | Aggregate     | 8.7                                    | 11.4                                     | 20.1                                      |                              |              |       | 8.7                    | 1.2   | 1.6   | 0.4                                               | 0.4                                                               |                  |
| DR-11                                        | 86        | Sta. 17+76.3 | Rt.     | Residential | Aggregate     | 7.5                                    | 9.5                                      | 17.0                                      |                              |              |       | 7.5                    | 1.0   | 1.3   | 0.3                                               | 0.3                                                               |                  |
|                                              |           |              |         |             |               |                                        |                                          |                                           |                              |              |       |                        |       |       |                                                   |                                                                   |                  |
| Totals (Carried to Location 1b Sub- Summary) |           |              |         |             |               |                                        |                                          |                                           | 117                          | 513          | 9     | 160                    | 22    | 13    | 7                                                 | 7                                                                 | 539              |






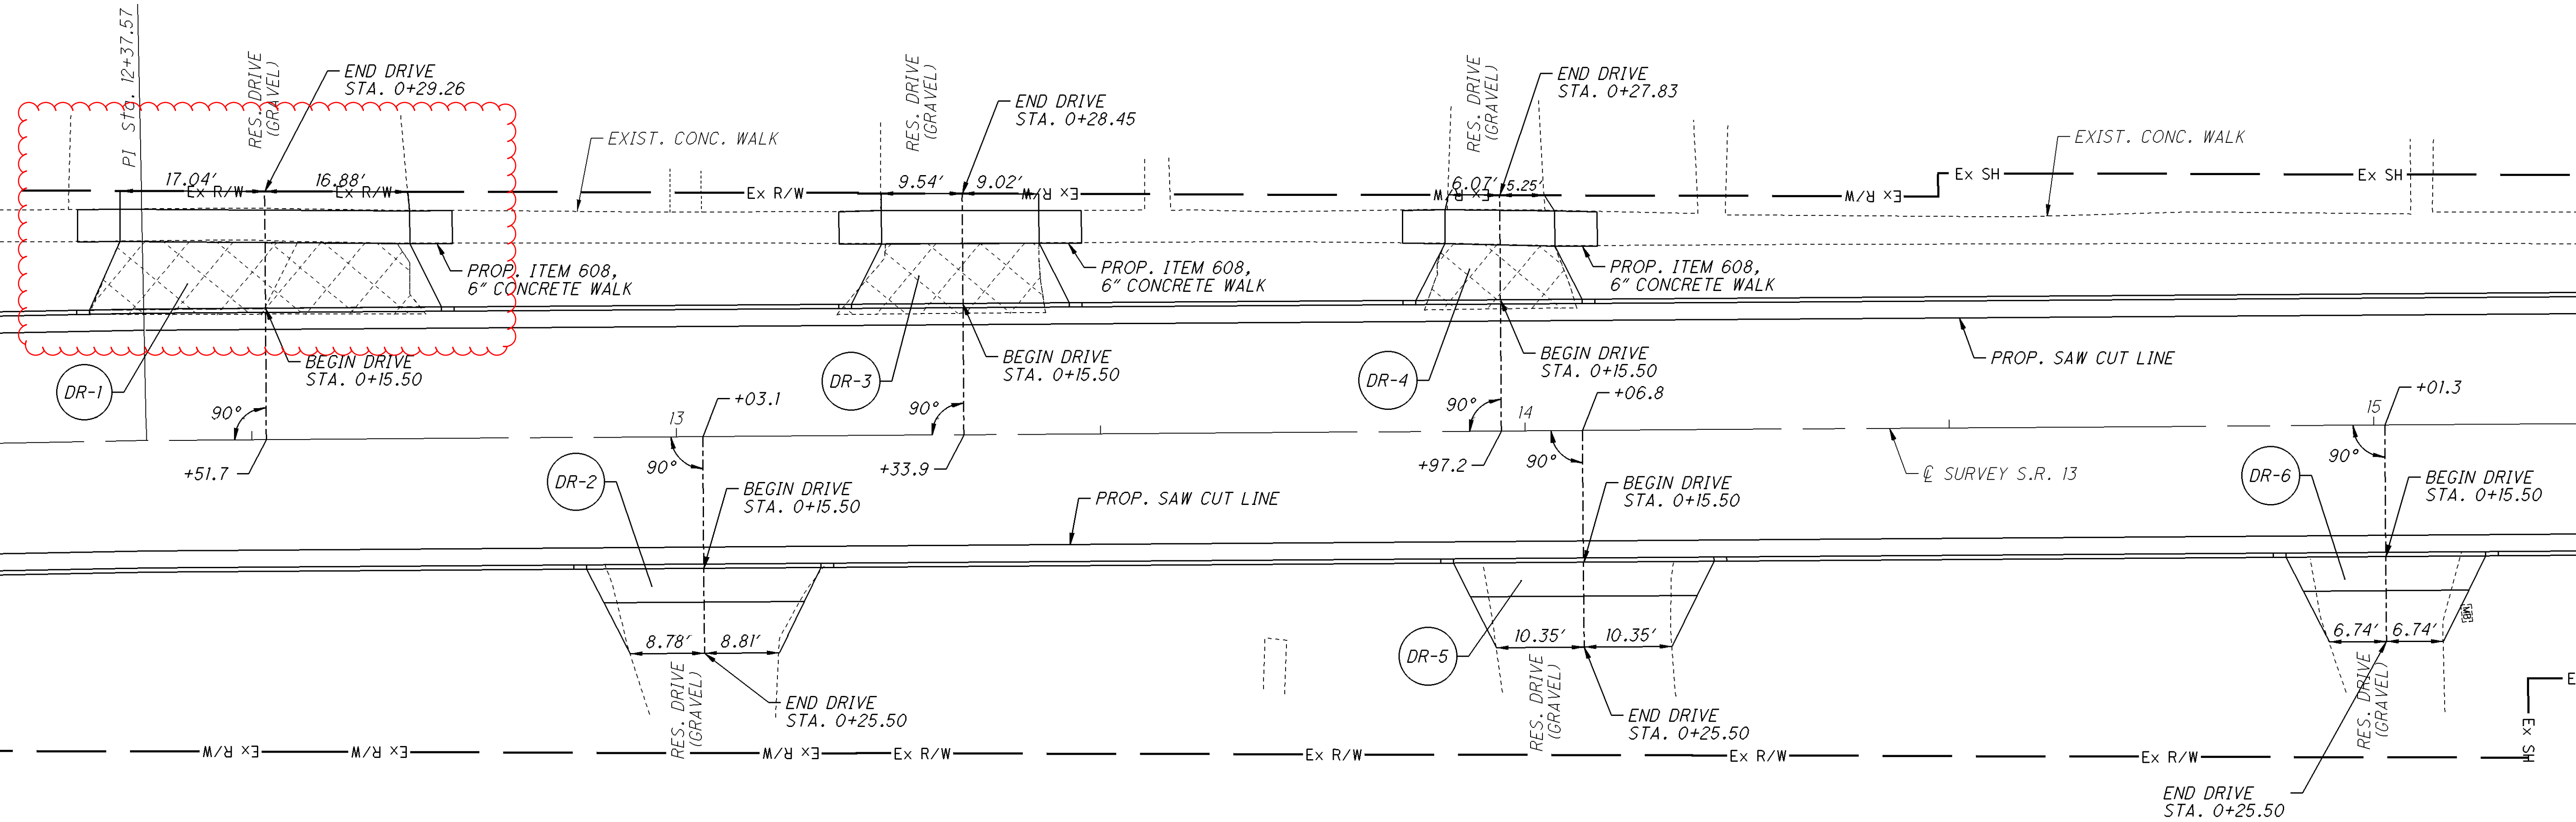


FOR DRIVE QUANTITIES, SEE SHEET 84.  
FOR ITEM 608, 6" CONCRETE WALK DETAILS, SEE SHEET 87.



I:\ProjectData\LIC\92958\Design\Roadway\Sheets\92958\_GA001.dgn 17-OCT-2016 11:15AM jutz1

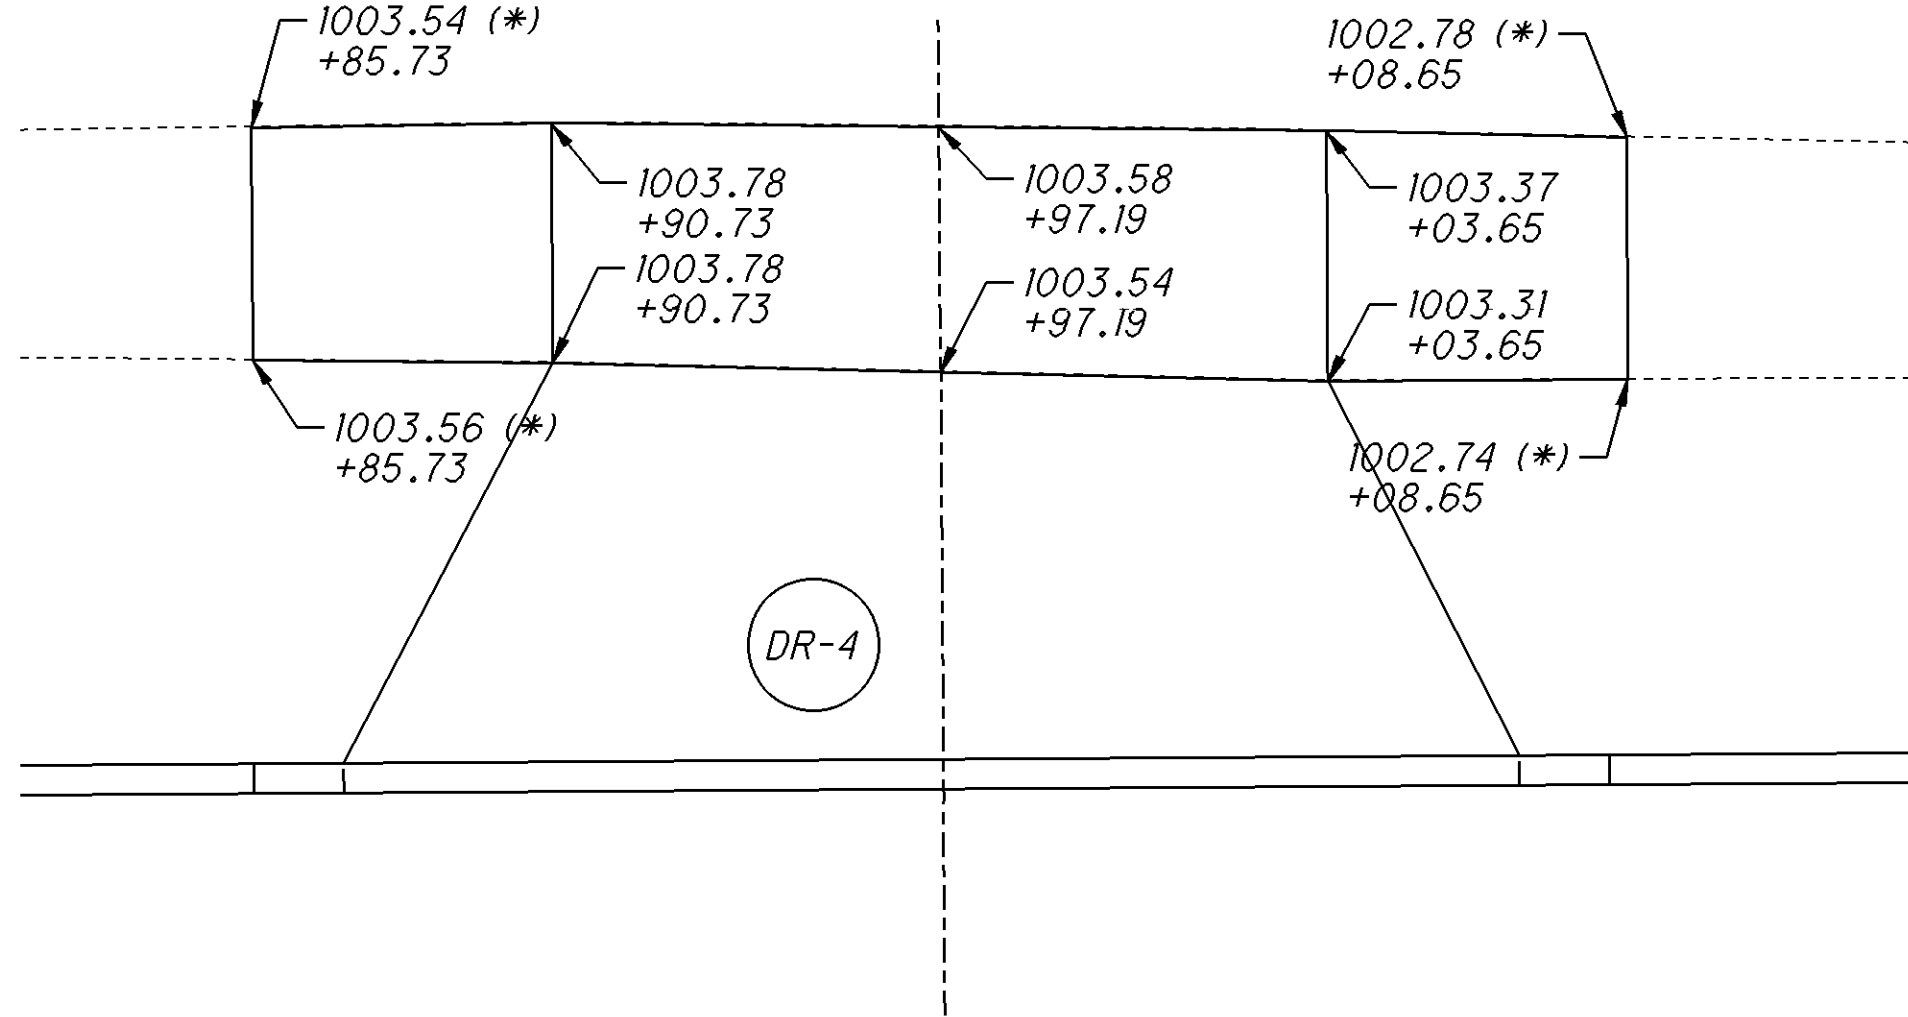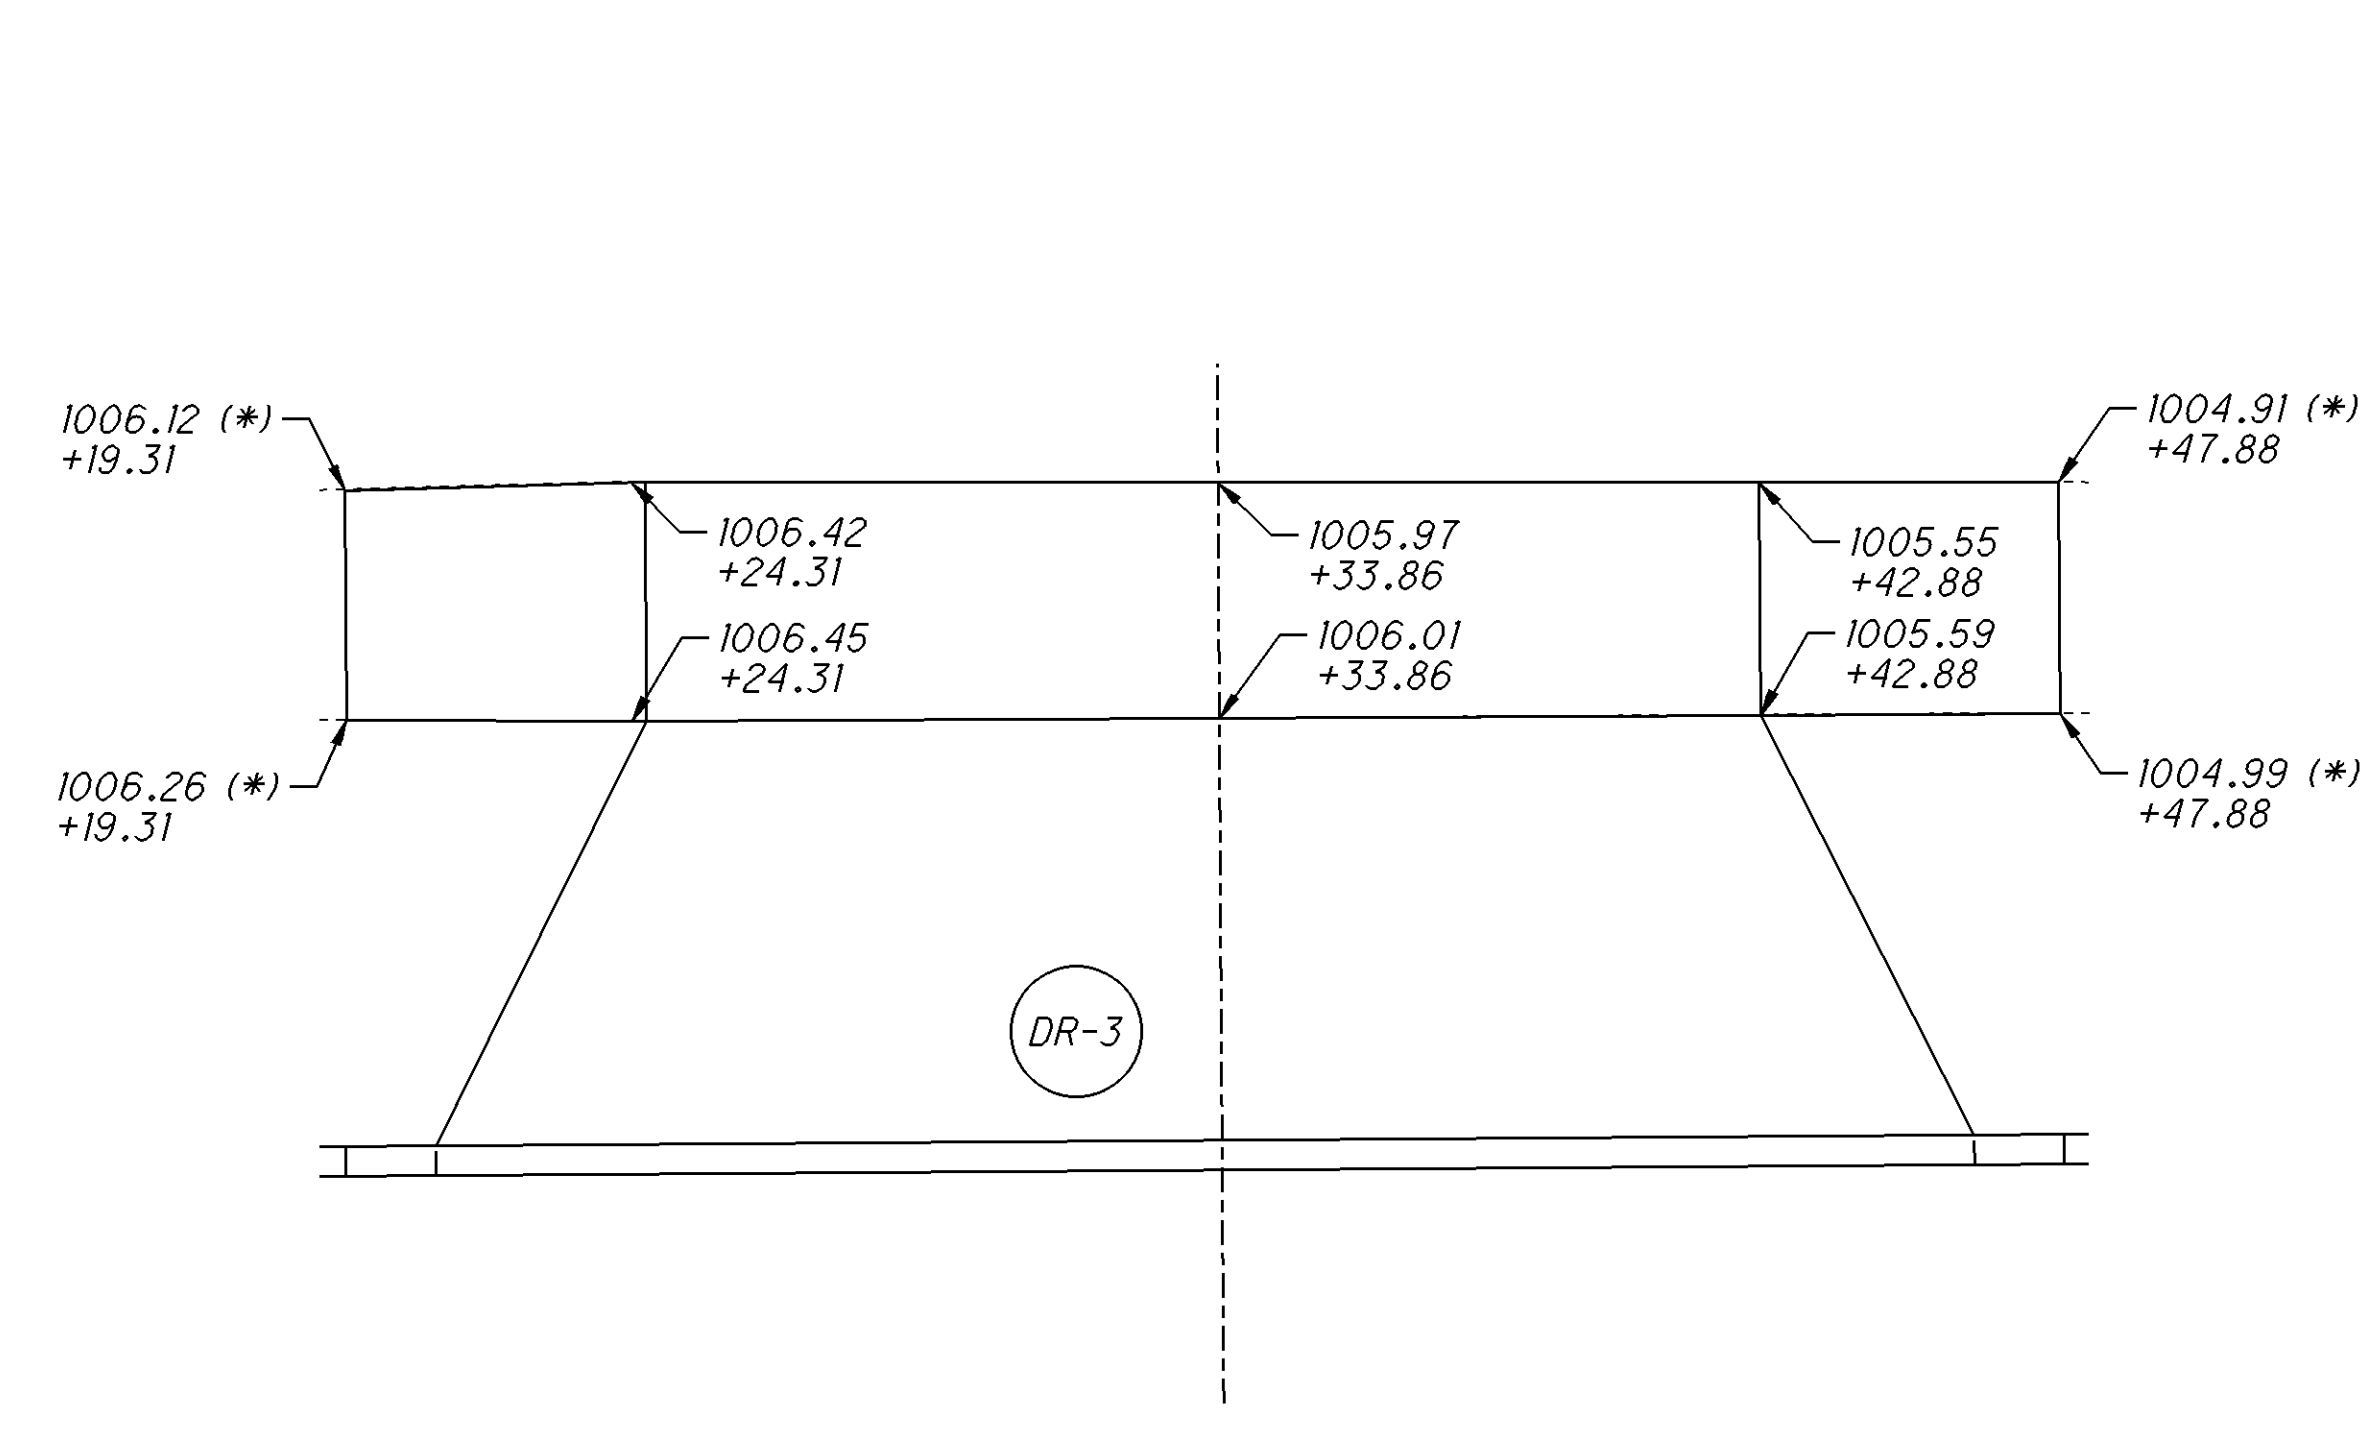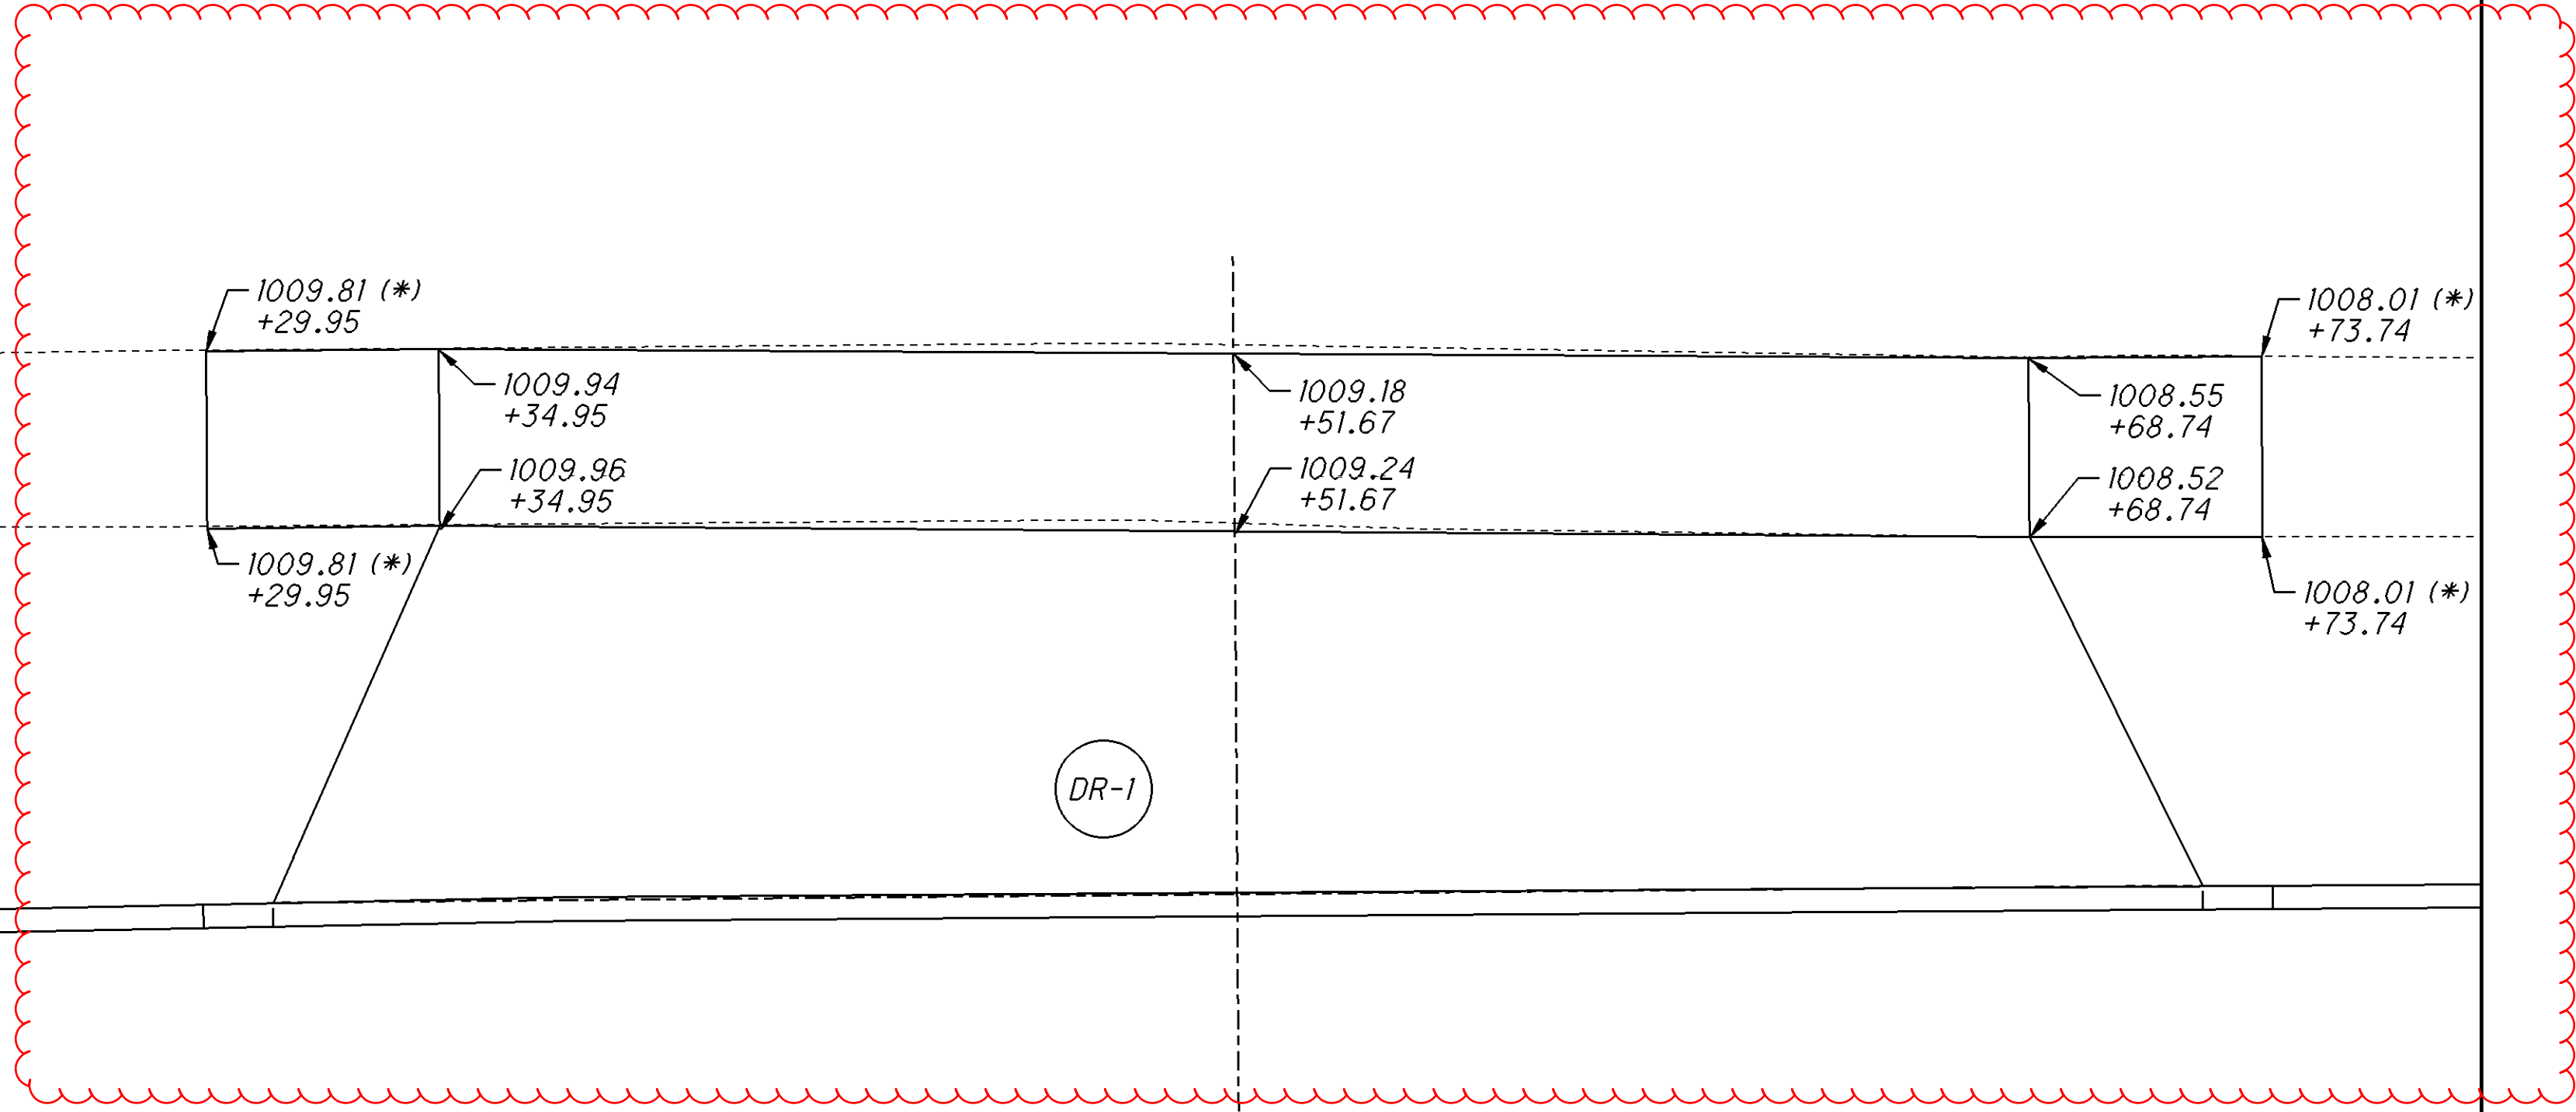

(\*) MEET EXISTING WALK ELEVATION.  
FOR ITEM 608, 6" CONCRETE WALK QUANTITIES, SEE SHEET 84.

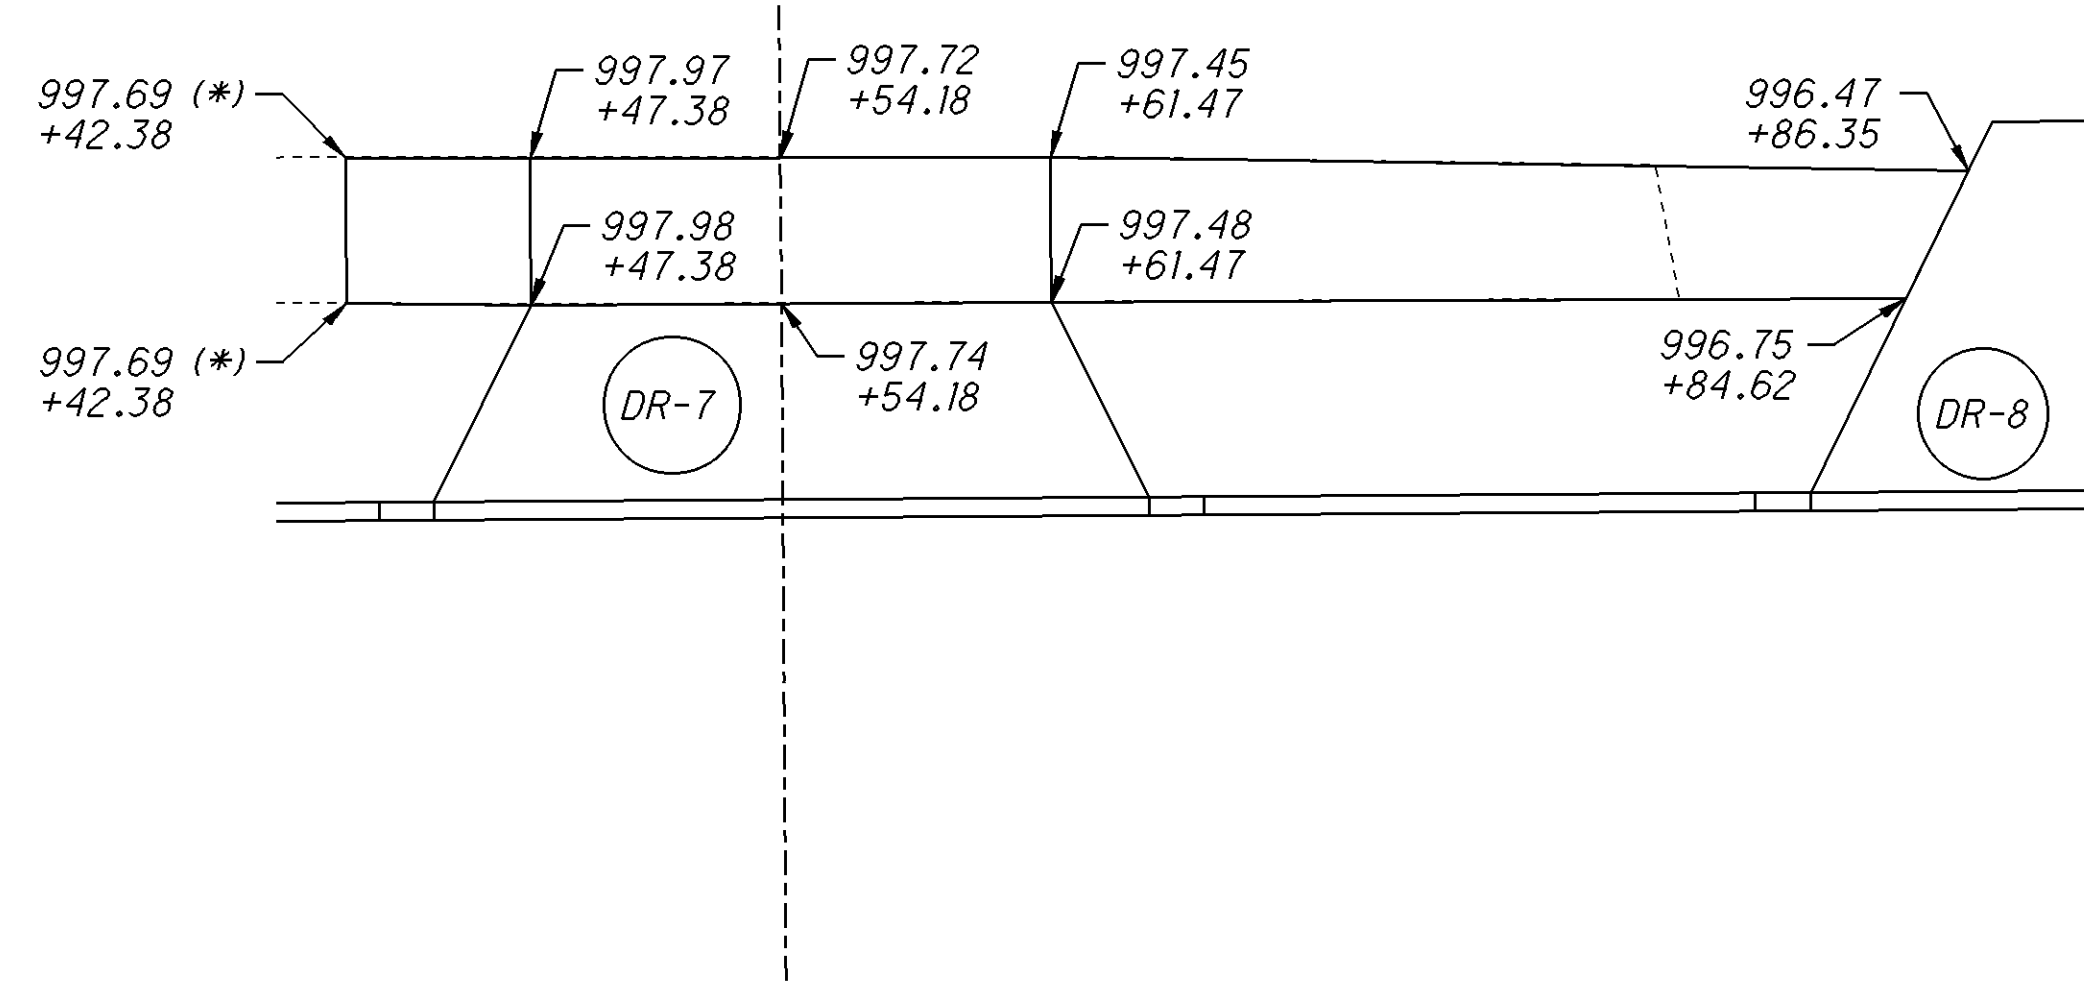


PROPOSED SIDEWALK DETAIL SHEET  
AT PROPOSED DRIVES

LIC-13-0.00

CALCULATED  
JLS  
CHECKED  
JSL



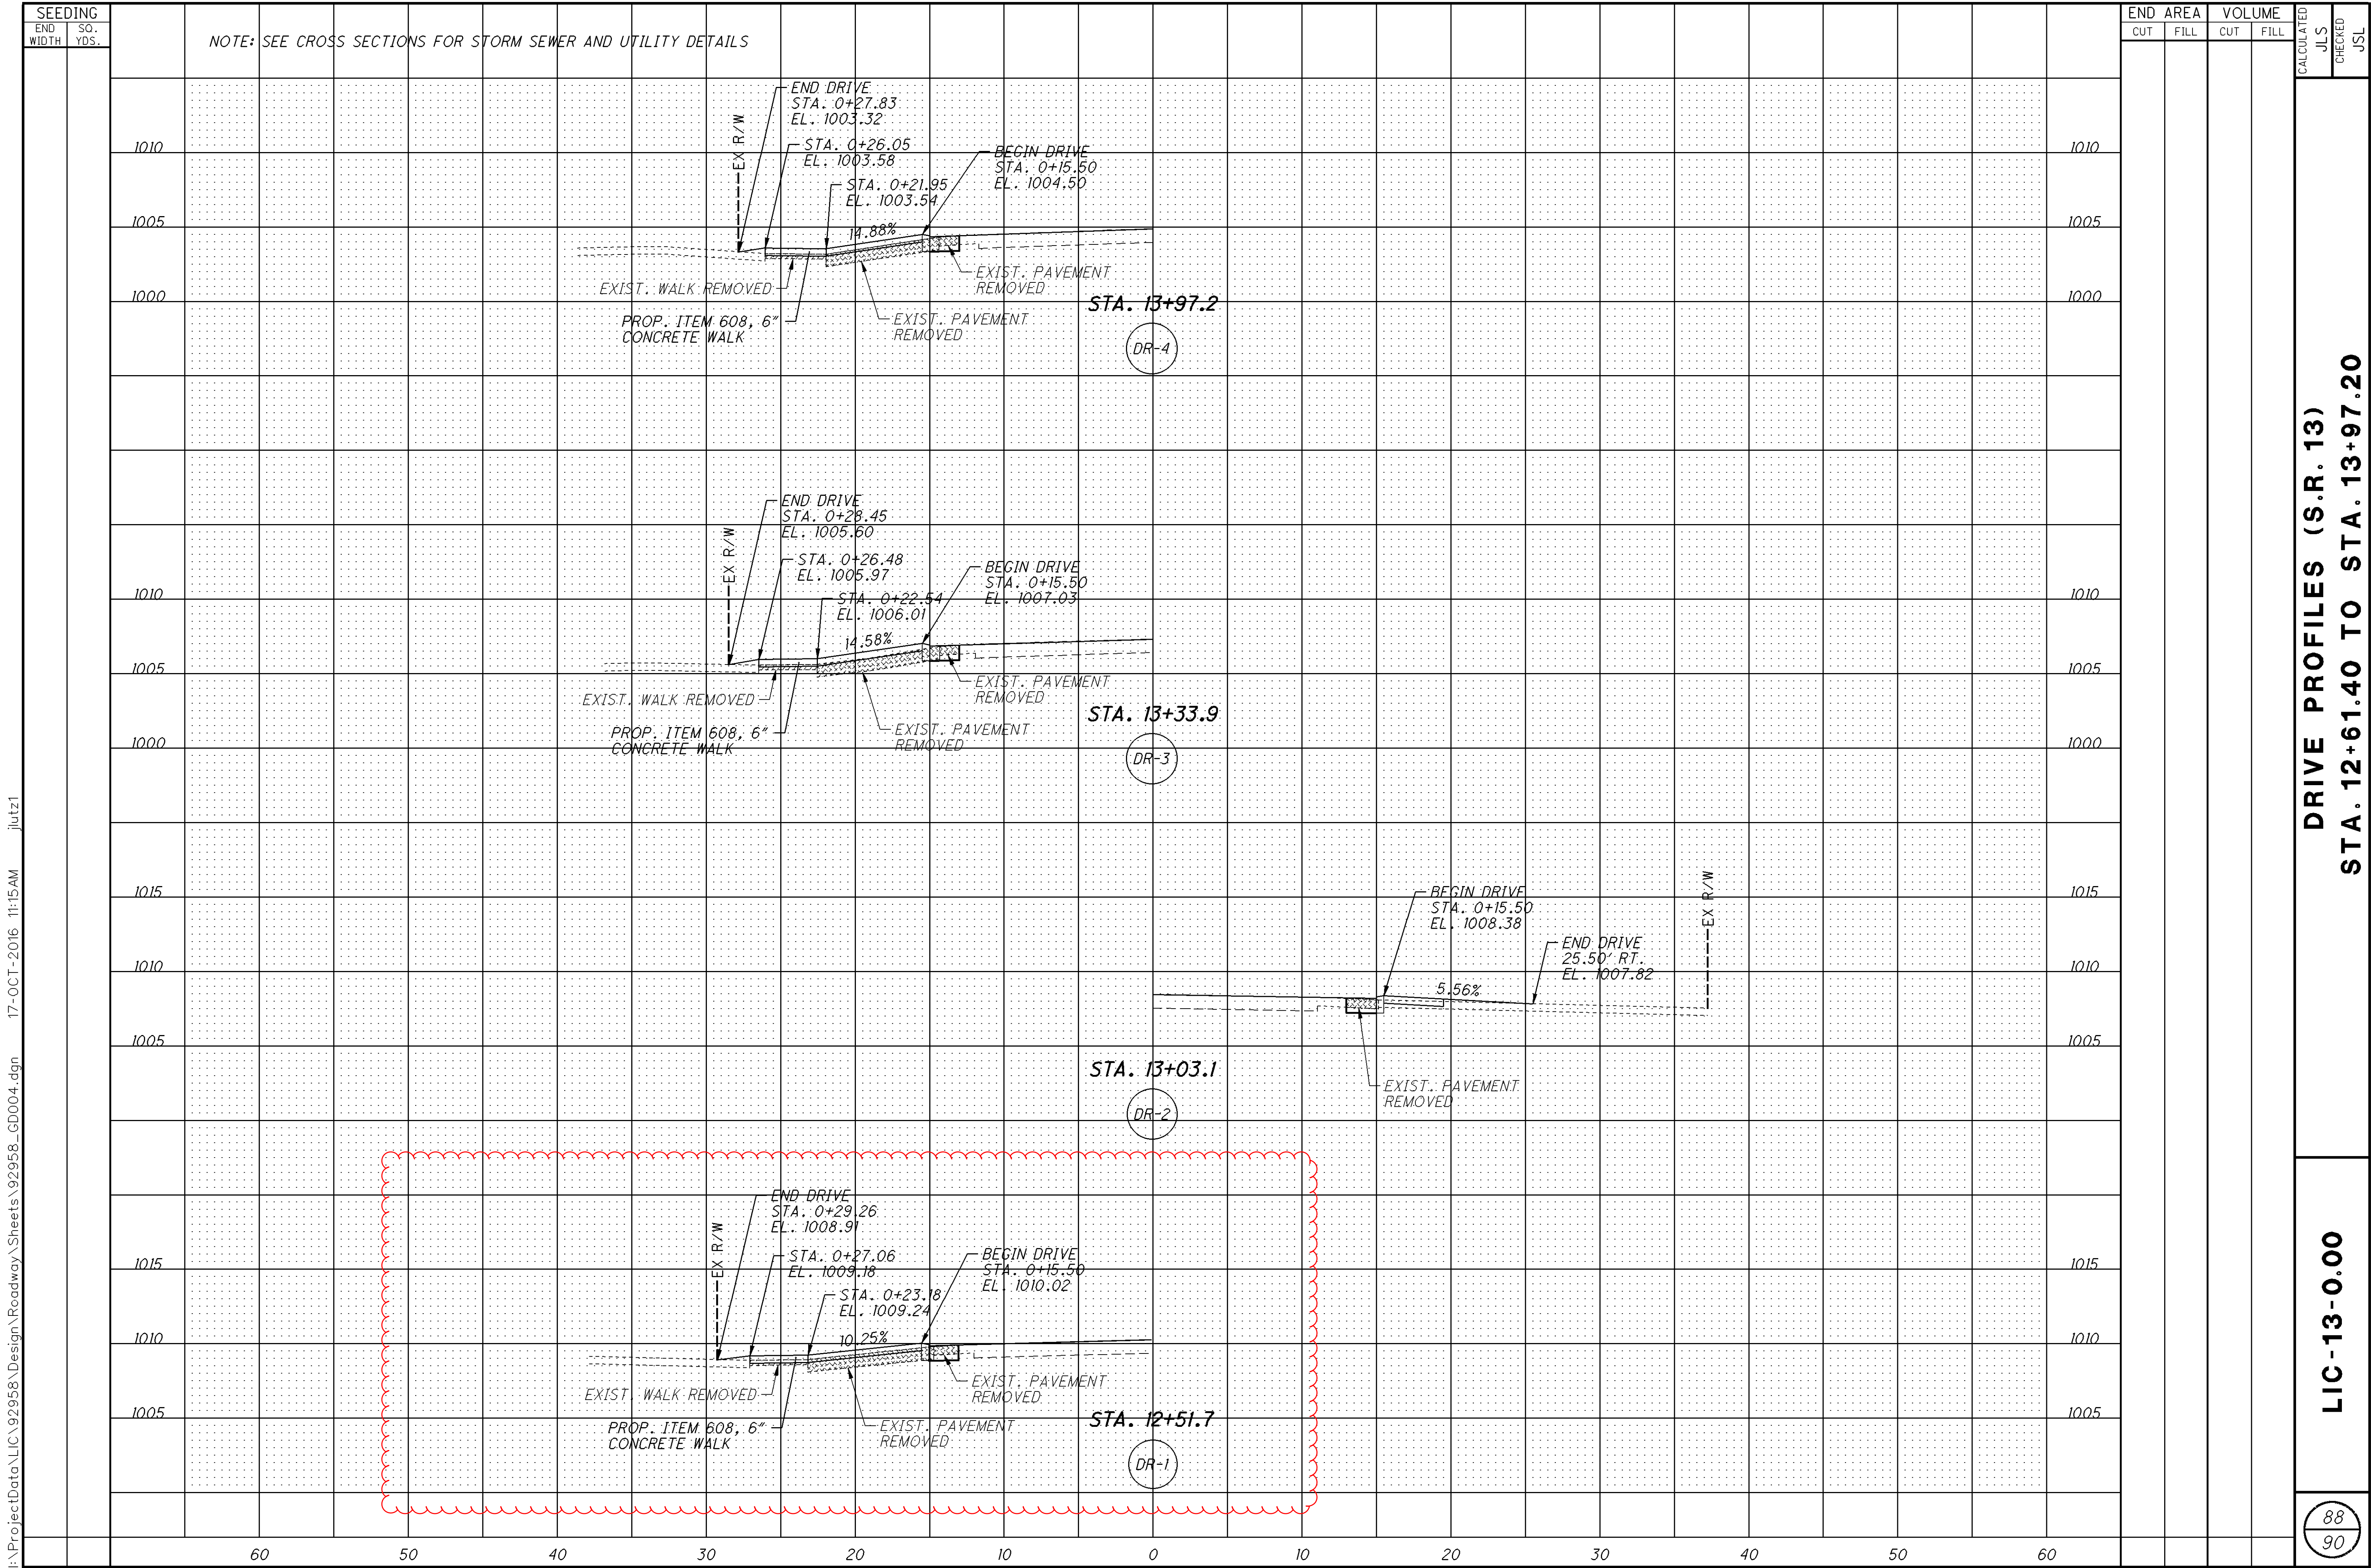


STATE OF OHIO  
DEPARTMENT OF TRANSPORTATION

RIGHT OF WAY  
LEGEND SHEET

LIC-13-0.00

4TH QTR., T1N, R12W, LOT27, U.S.M.L.  
LICKING TOWNSHIP  
LICKING COUNTY

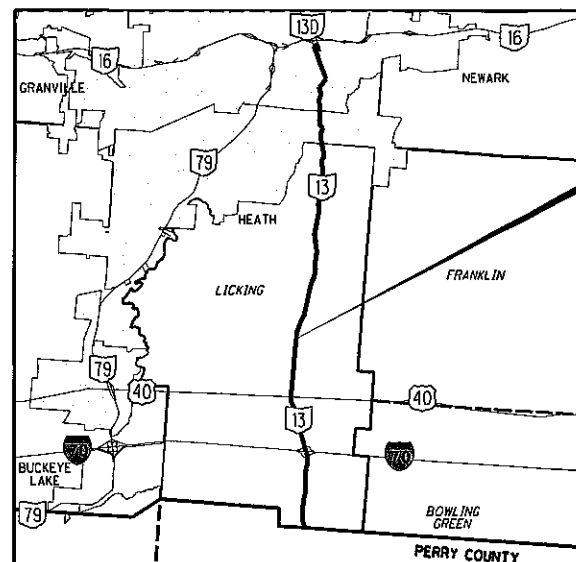

LOCATION MAP

LATITUDE: 39° 59' 28" LONGITUDE: 82° 24' 24"



NOTE:

THE LOCATION OF THE UNDERGROUND UTILITIES SHOWN ON THE PLANS ARE OBTAINED FROM THE OWNER OF THE UTILITIES AS REQUIRED BY SECTION 153.64 O.R.C.

INDEX OF SHEETS:

PROPERTY MAP, SUMMARY OF ADDITIONAL RIGHT OF WAY & DETAIL SHEET . . . 2

UTILITY OWNERS

LISTED BELOW ARE ALL UTILITIES LOCATED WITHIN THE PROJECT CONSTRUCTION LIMITS TOGETHER WITH THEIR RESPECTIVE OWNERS:

|                                                                                                           |                                                                                                                         |                                                                                                                      |                                                                                                 |
|-----------------------------------------------------------------------------------------------------------|-------------------------------------------------------------------------------------------------------------------------|----------------------------------------------------------------------------------------------------------------------|-------------------------------------------------------------------------------------------------|
| TIME WARNER CABLE<br>111 NORTH 11TH STREET<br>NEWARK, OHIO 43055<br>ATTN: BRIAN AMENDE<br>740-322-6703    | CENTURYLINK TELEPHONE<br>441 WEST BROAD STREET<br>PATASKALA, OHIO 43062<br>ATTN: DEE REED<br>740-927-8282               | AMERICAN ELECTRIC POWER<br>850 TECH CENTER DRIVE<br>GAHANNA, OHIO 43230<br>ATTN: PAUL PAXTON<br>614-883-6831         | WINDSTREAM<br>66 NORTH FOURTH STREET<br>NEWARK, OHIO 43055<br>ATTN: DAVE HOLTON<br>740-349-8804 |
| AT&T OHIO<br>160 NORTH SIXTH STREET<br>ZANESVILLE, OHIO 43701<br>ATTN: BARRETT TAMASOVICH<br>740-454-3574 | COLUMBIA GAS OF OHIO<br>2429 NORTH LINDEN AVENUE<br>ZANESVILLE, OHIO 43701<br>ATTN: MICHAEL DIBENEDETTO<br>740-260-0370 | LICKING COUNTY WATER/WASTE WATER<br>4455 WALCUTT ROAD<br>BUCKEYE LAKE, OHIO 43008<br>ATTN: KEVIN EBY<br>740-928-0349 |                                                                                                 |

CONVENTIONAL SYMBOLS

|                             |                            |
|-----------------------------|----------------------------|
| County Line                 | Edge of Shoulder (Ex)      |
| Township Line               | Edge of Shoulder (Pr)      |
| Section Line                | Ditch / Creek (Ex)         |
| Corporation Line            | Ditch / Creek (Pr)         |
| Fence Line (Ex)             | Tree Line (Ex)             |
| Center Line                 | Ownership Hook Symbol      |
| Right of Way (Ex)           | Property Line Symbol       |
| Right of Way (Pr)           | Break Line Symbol          |
| Standard Highway Ease. (Ex) | Tree (Pr)                  |
| Standard Highway Ease. (Pr) | Tree (Ex)                  |
| Slope Ease. (Ex)            | Tree (Remove)              |
| Slope Ease. (Pr)            | Shrub (Ex)                 |
| Temporary Right of Way      | Shrub (Remove)             |
| Channel Ease. (Pr)          | Evergreen (Ex)             |
| Utility Ease. (Ex)          | Evergreen (Remove)         |
| Railroad                    | Stump                      |
| Guardrail (Ex)              | Stump (Remove)             |
| Construction Limits         | Wetland (Pr)               |
| Edge of Pavement (Ex)       | Grass (Pr)                 |
| Edge of Pavement (Pr)       | Aerial Target              |
|                             | Post (Ex)                  |
|                             | Mailbox (Ex)               |
|                             | Mailbox (Pr)               |
|                             | Light (Ex)                 |
|                             | Telephone Marker (Ex)      |
|                             | Fire Hydrant (Ex)          |
|                             | Water Meter (Ex)           |
|                             | Water Valve (Ex)           |
|                             | Utility Valve Unknown (Ex) |
|                             | Telephone Pole (Ex)        |
|                             | Power Pole (Ex)            |
|                             | Light Pole (Ex)            |

STRUCTURE KEY

|  |              |
|--|--------------|
|  | RESIDENTIAL  |
|  | COMMERCIAL   |
|  | OUT-BUILDING |

LEGEND:

SH = STANDARD HIGHWAY EASEMENT  
SL = SLOPE EASEMENT  
T = TEMPORARY EASEMENT  
CH = CHANNEL EASEMENT

PROJECT DESCRIPTION

ASPHALT CONCRETE RESURFACING ON S.R. 13 AND THE ODOT DISTRICT 5 COMPLEX IN LICKING COUNTY WITH DRAINAGE WORK IN THE VILLAGE OF JACKSONTOWN

PROJECT CONTROL

NORTH AMERICAN VERTICAL DATUM (NAVD 88)  
OHIO STATE PLANE GRID COORDINATE SYSTEM,  
SOUTH ZONE, GRID COORDINATES, NAD 1983  
(CONUS), GEOID 12A (OHIO).

PLAN PREPARED BY:

FIRM NAME: ODOT, DISTRICT 5  
PLANS PREPARED BY: CANDY SHOEMAKER  
FIELD REVIEW BY: CHARLES PRICE, JR. & CANDY SHOEMAKER  
OWNERSHIP VERIFIED BY: CHARLES PRICE, JR.  
DATE COMPLETED: 11/21/16

UNDERGROUND UTILITIES

CONTACT BOTH SERVICES  
CALL TWO WORKING DAYS  
BEFORE YOU DIG

CALL  
1-800-362-2764  
(TOLL FREE)  
OHIO UTILITIES PROTECTION SERVICE  
NON-MEMBERS  
MUST BE CALLED DIRECTLY

OIL & GAS PRODUCERS PROTECTIVE  
SERVICE CALL: 1-800-925-0988

I, Charles W. Price, Jr., P. S. have conducted a survey of the existing conditions for the Ohio Department of Transportation in September, 2012. The results of that survey are contained herein.

The horizontal coordinates expressed herein are based on North American Vertical Datum (NAVD 88) Ohio State Plane Grid Coordinate System, South Zone, Grid Coordinates, NAD 83 (Conus), Geoid 12A (Ohio).

As a part of this project I have reestablished the locations of the existing property lines and centerline of existing Right of Way for property takes contained herein.

As a part of this project I have established the proposed property lines, calculated the Gross Take, present roadway occupied (PRO), Net Take and Net Residue; as well as prepared the legal descriptions necessary to acquire the parcels as shown herein.


As a part of this work I have set monuments at the proposed property corners, and other points shown herein. The iron pins and caps will be 3/4" x 30" rebar with aluminum cap stamped "Odor R/W District 5". All of my work contained herein was conducted in accordance with Ohio Administrative Code 4733-37 commonly known as "A Minimum Standards for Boundary Surveys in the State of Ohio" unless so noted.

The words I and my as used herein are to mean that either myself or someone working under my direct supervision.

Charles W. Price, Jr., Professional Land Surveyor # 7825

Date: 11/21/16

SURVEYORS SEAL

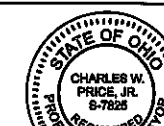

SIGNED:   
DATE: 11/21/16

FEDERAL PROJECT NO. X

RAILROAD INVOLVEMENT NONE

PID NO. 92958

R/W DESIGNER CS  
R/W REVIEWER CP

RIGHT OF WAY  
LEGEND SHEET

LIC-13-0.00

1/2



## NOTES:

ALL EXISTING FENCE LOCATED INSIDE OF PROPOSED RIGHT OF WAY IS TO BE REMOVED.

THE DISPOSITION OF EXISTING CONSTRUCTION ITEMS WITHIN WORK LIMITS ARE SHOWN ON THE CONSTRUCTION PLANS.


ALL STATIONS AND OFFSETS ARE FROM THE CENTERLINE OF SURVEY AND CONSTRUCTION, S.R. 13 UNLESS OTHERWISE STATED.

## NOTE:


THE EXISTING RIGHT OF WAY WIDTH AND LOCATION WERE DETERMINED USING DOCUMENTATION ON FILE FROM THE OHIO DEPARTMENT OF TRANSPORTATION, DISTRICT 5 OFFICE, JACKSONTOWN, OHIO.

CO. RD. AND TWP RD. RIGHT OF WAY DETERMINED FROM THE LICKING COUNTY ENGINEERS OFFICE LICKING COUNTY, OHIO

4TH QTR., T1N, R12W, LOT27, U.S.M.L.  
LICKING TOWNSHIP  
LICKING COUNTY

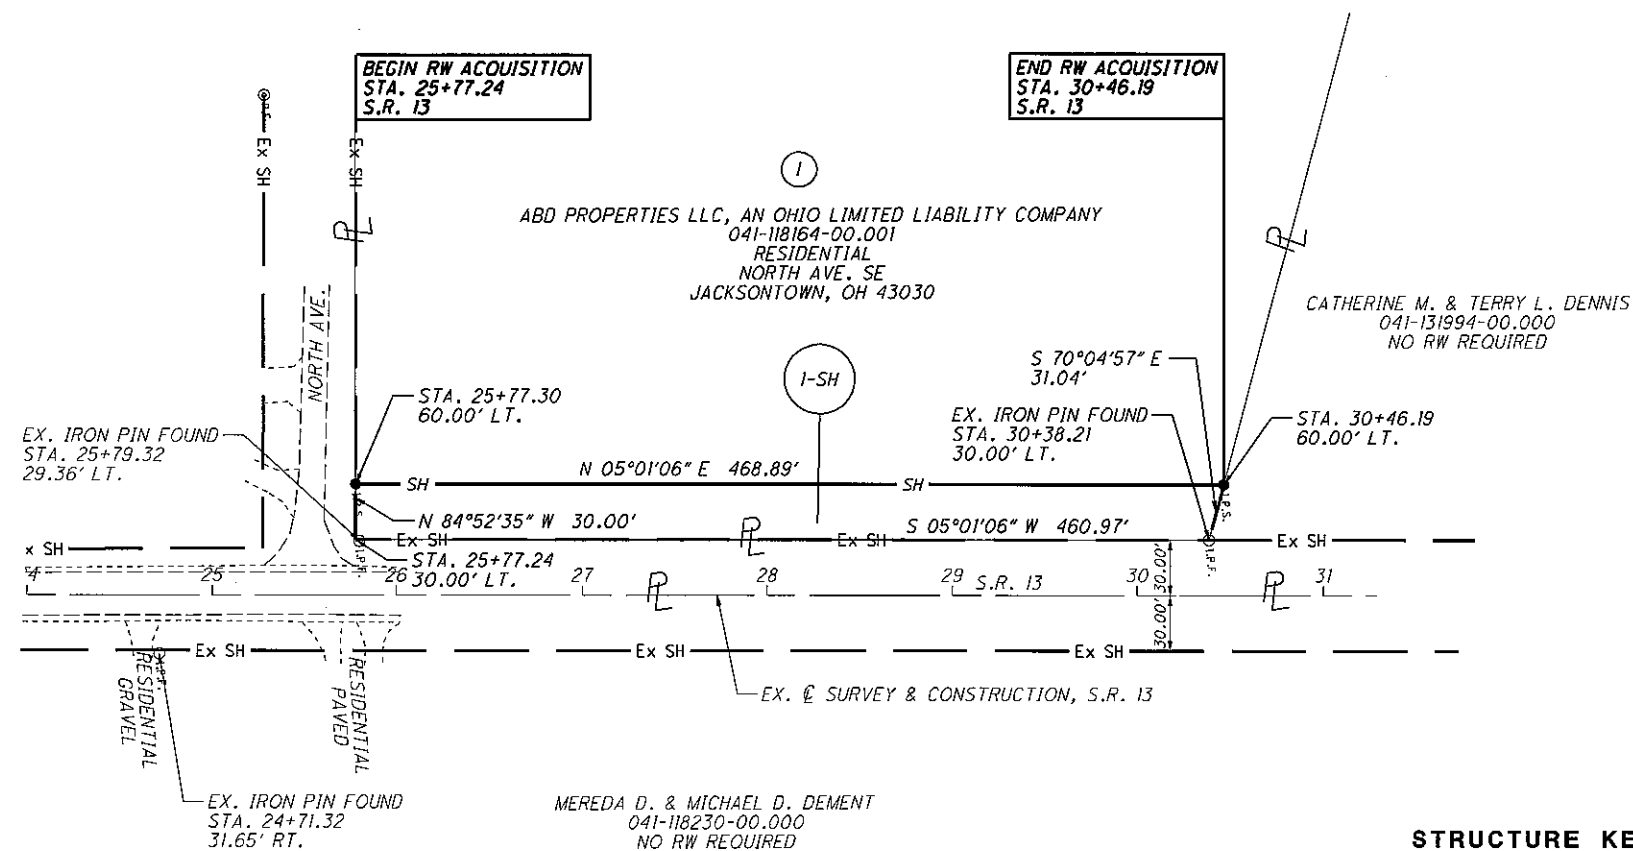

PROPERTY MAP  
(Not to Scale)

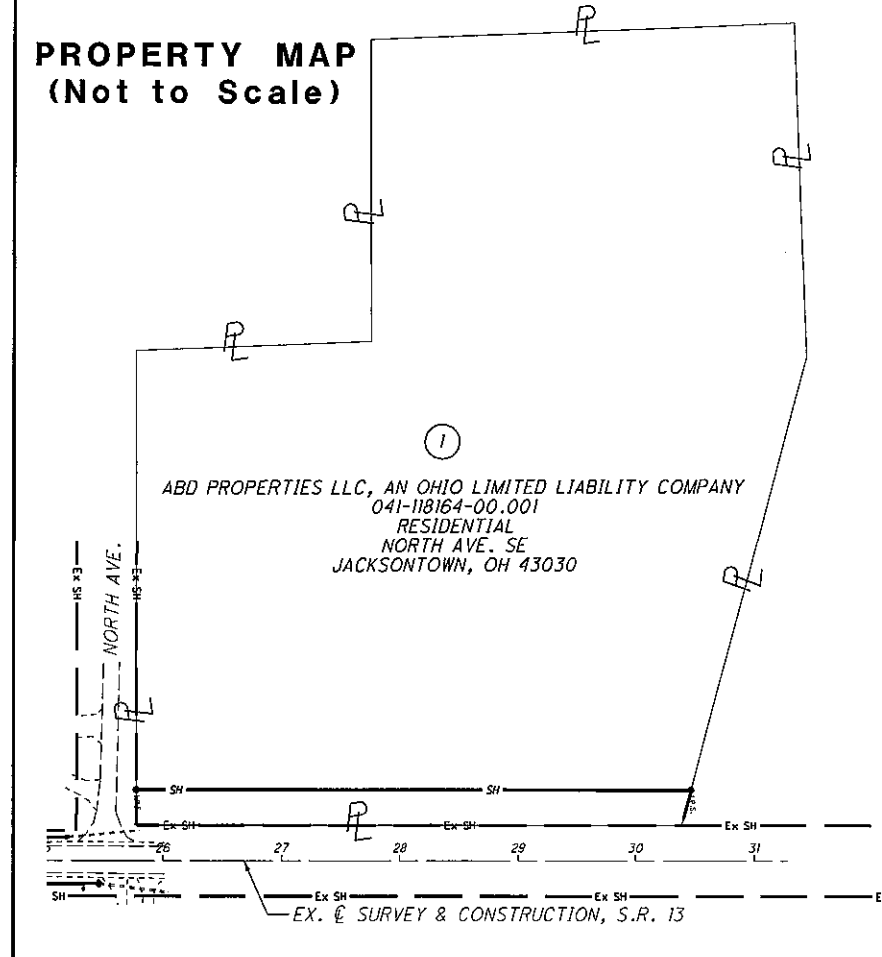

## MONUMENT LEGEND

- EXISTING R/W MONUMENT BOX
- PROPOSED R/W MONUMENT BOX
- EXISTING CONCRETE MONUMENT
- PROPOSED CONCRETE MONUMENT
- RAILROAD SPIKE FOUND
- RAILROAD SPIKE SET
- IRON PIN FOUND
- IRON PIN FOUND W/ ID CAP
- IRON PIN SET W/ ID CAP
- IRON PIPE FOUND
- IRON PIPE SET
- P.K. NAIL FOUND
- P.K. NAIL SET

## STRUCTURE KEY

- RESIDENTIAL
- COMMERCIAL
- OUT-BUILDING

## REV. BY DATE DESCRIPTION

FIELD REVIEW BY: CS & CP  
OWNERSHIP VERIFIED BY: CP  
DATE COMPLETED: 11/21/16

## TOTAL NUMBER OF :

1 OWNERSHIPS 0 TOTAL TAKES  
1 PARCELS 0 OWNERSHIPS W/ STRUCTURES INVOLVED

RECORD AREA - TOTAL PRO - NET TAKE = NET RESIDUE

## ALL AREAS IN ACRES

| PARCEL NO. | OWNER                                                 | OWNERS RECORD DEED BOOK & PG. | AUDITOR'S PARCEL  | RECORD AREA | TOTAL P.R.O. | GROSS TAKE | P.R.O. IN TAKE | NET TAKE | STRUC-TURE | NET RESIDUE LEFT | NET RESIDUE RIGHT | TYPE FUND | REMARKS | AS ACQUIRED DEED BOOK & PG. |
|------------|-------------------------------------------------------|-------------------------------|-------------------|-------------|--------------|------------|----------------|----------|------------|------------------|-------------------|-----------|---------|-----------------------------|
| 1-SH       | ABD PROPERTIES LLC, AN OHIO LIMITED LIABILITY COMPANY | 201412110024554               | 041-118164-00.001 | 7.007       | 0.000        | 0.320      | 0.000          | 0.320    | NO         | 6.687            |                   | STATE     |         |                             |
|            |                                                       |                               |                   |             |              |            |                |          |            |                  |                   | STATE     |         |                             |

NOTE: ALL TEMPORARY PARCELS TO BE OF 12 MONTH DURATION.

RIGHT OF WAY DETAIL SHEET  
STA. 24+00 TO STA. 31+28.89 S.R. 13

LIC-13-0.00  
2/2