


T&M 40 N.E. CORNER & MON. BOX OF CUL-DE-SAC AT
S. END W. 12TH STREET AT N. SIDE I-190 RIGHT-OF-WAY
ELEV. = 762.16

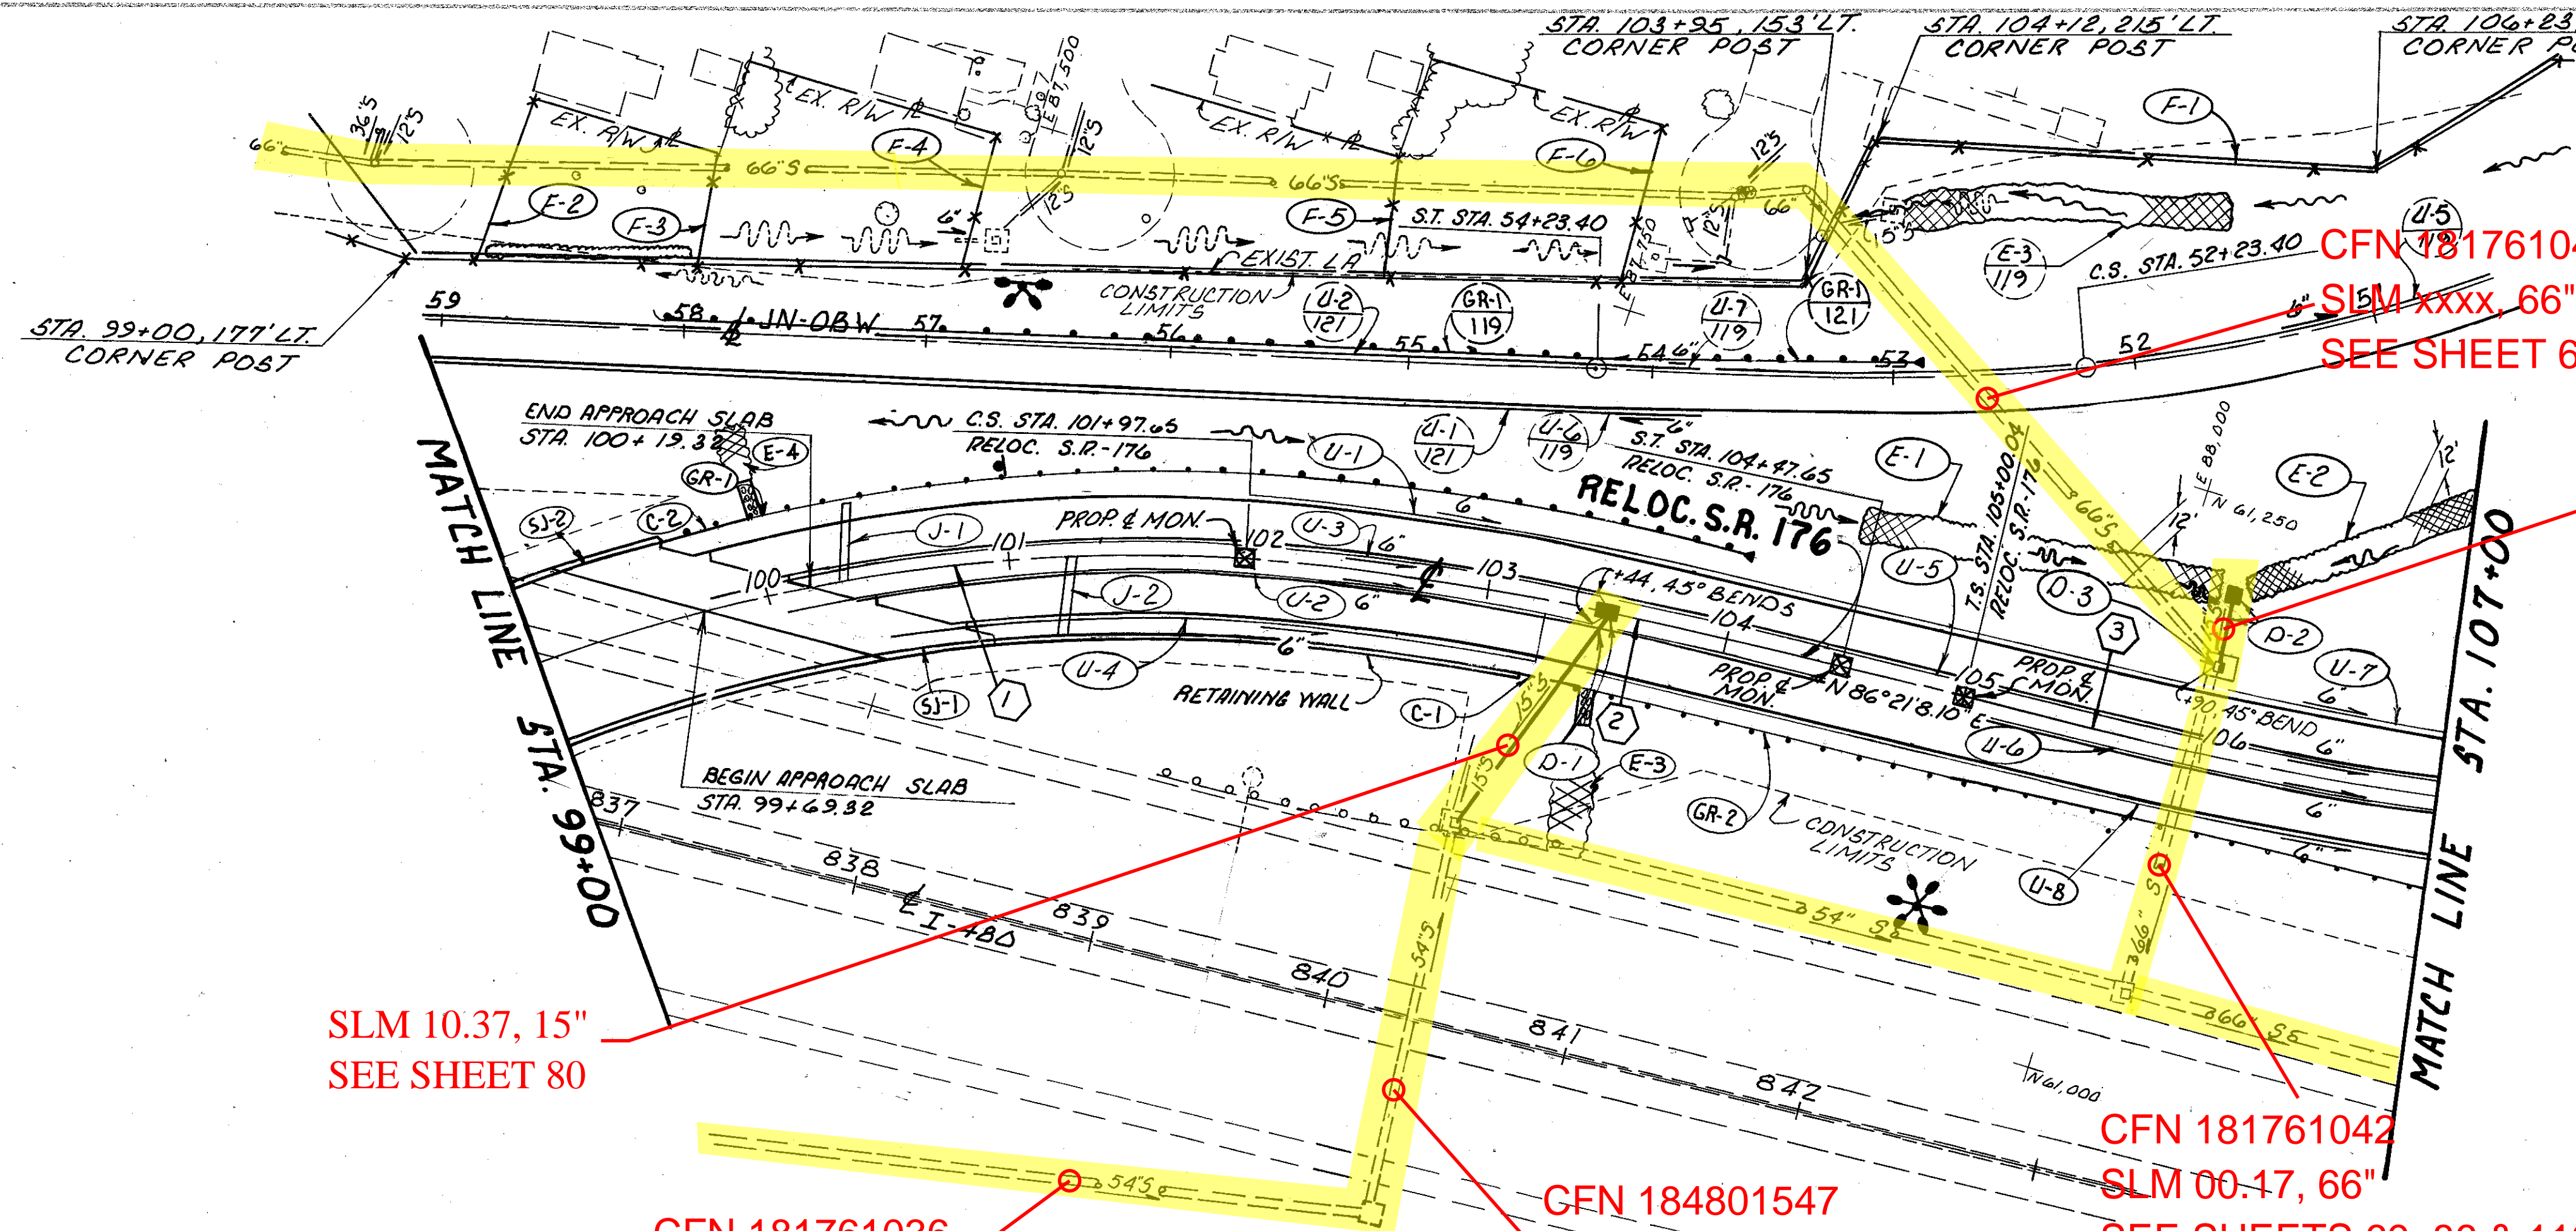

CURVE DATA

Curve	Theta-S	LS	XC	YC	LT	ST	LC	P	K
1	9° 57' 26.20"	250'	249.25'	14.45'	166.93'	83.57'	249.66'	3.62'	124.87'
2	10° 0' 0"	250'	249.24'	14.51'	166.93'	83.58'	249.66'	3.63'	124.87'

DRAINAGE STRUCTURE DATA

- (D-1) STA 103+50 & RELOC. S.R.-176
INLET 11" 3B50 T/G-772.19
- (D-2) STA 106+00, 66' LT. RELOC. S.R.-176
C.B. 11" 5 A.P.D. T/G-757.20
- (D-3) STA 106+01, 36' LT.
C.B. RECONSTRUCTED TO GRADE, AS PER PLAN
T/G-761.00 EX. 764.75

REFERENCES

QUANTITIES FOR REFERENCED ITEMS	SHEET NUMBERS
PIPE PROFILES	54
BRIDGE PLANS	68 & 69
	278-313

SLM 10.37, 15"
SEE SHEET 80


CFN 181761036
SLM 00.09, 54"
SEE SHEETS 84, 91, 92 & 68

CFN 184801547
SLM 15.47, 54"
SEE SHEET xxxx

CFN 181761042
SLM 00.17, 66"
SEE SHEETS 69, 86 & 119

CFN 181761041
SLM xxx, 66"
SEE SHEET 69

SLM 10.42, 15"
SEE SHEET 69

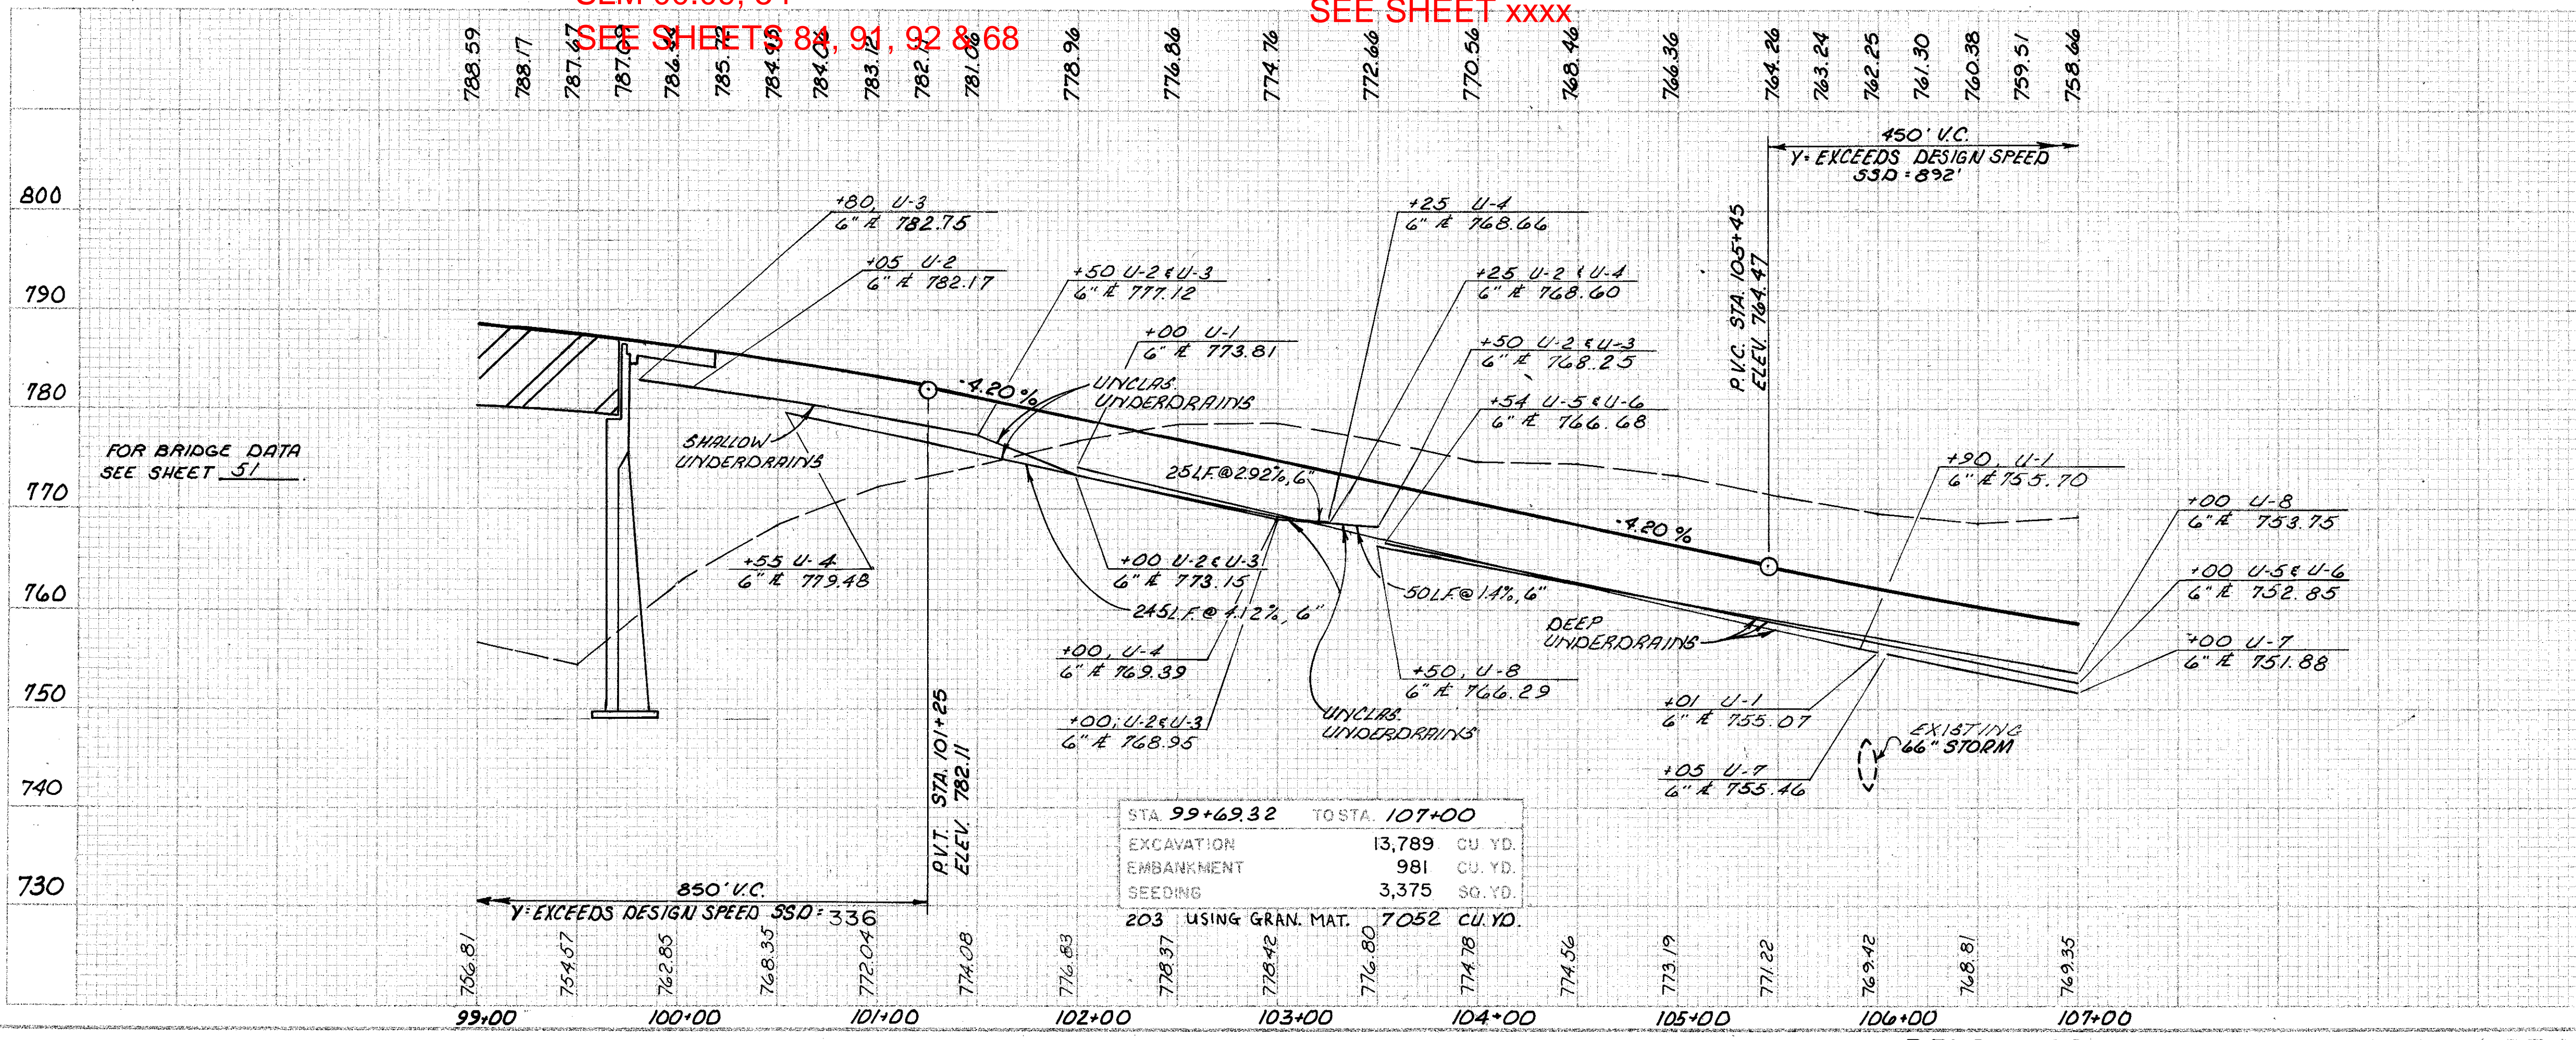

RELOC. S.R.-176

PLAN & PROFILE STA. 99+00

TO STA. 107+00

RELOC. S.R.-176