


CUYAHOGA COUNTY
MED-42-26.17
CUY-42-0.00

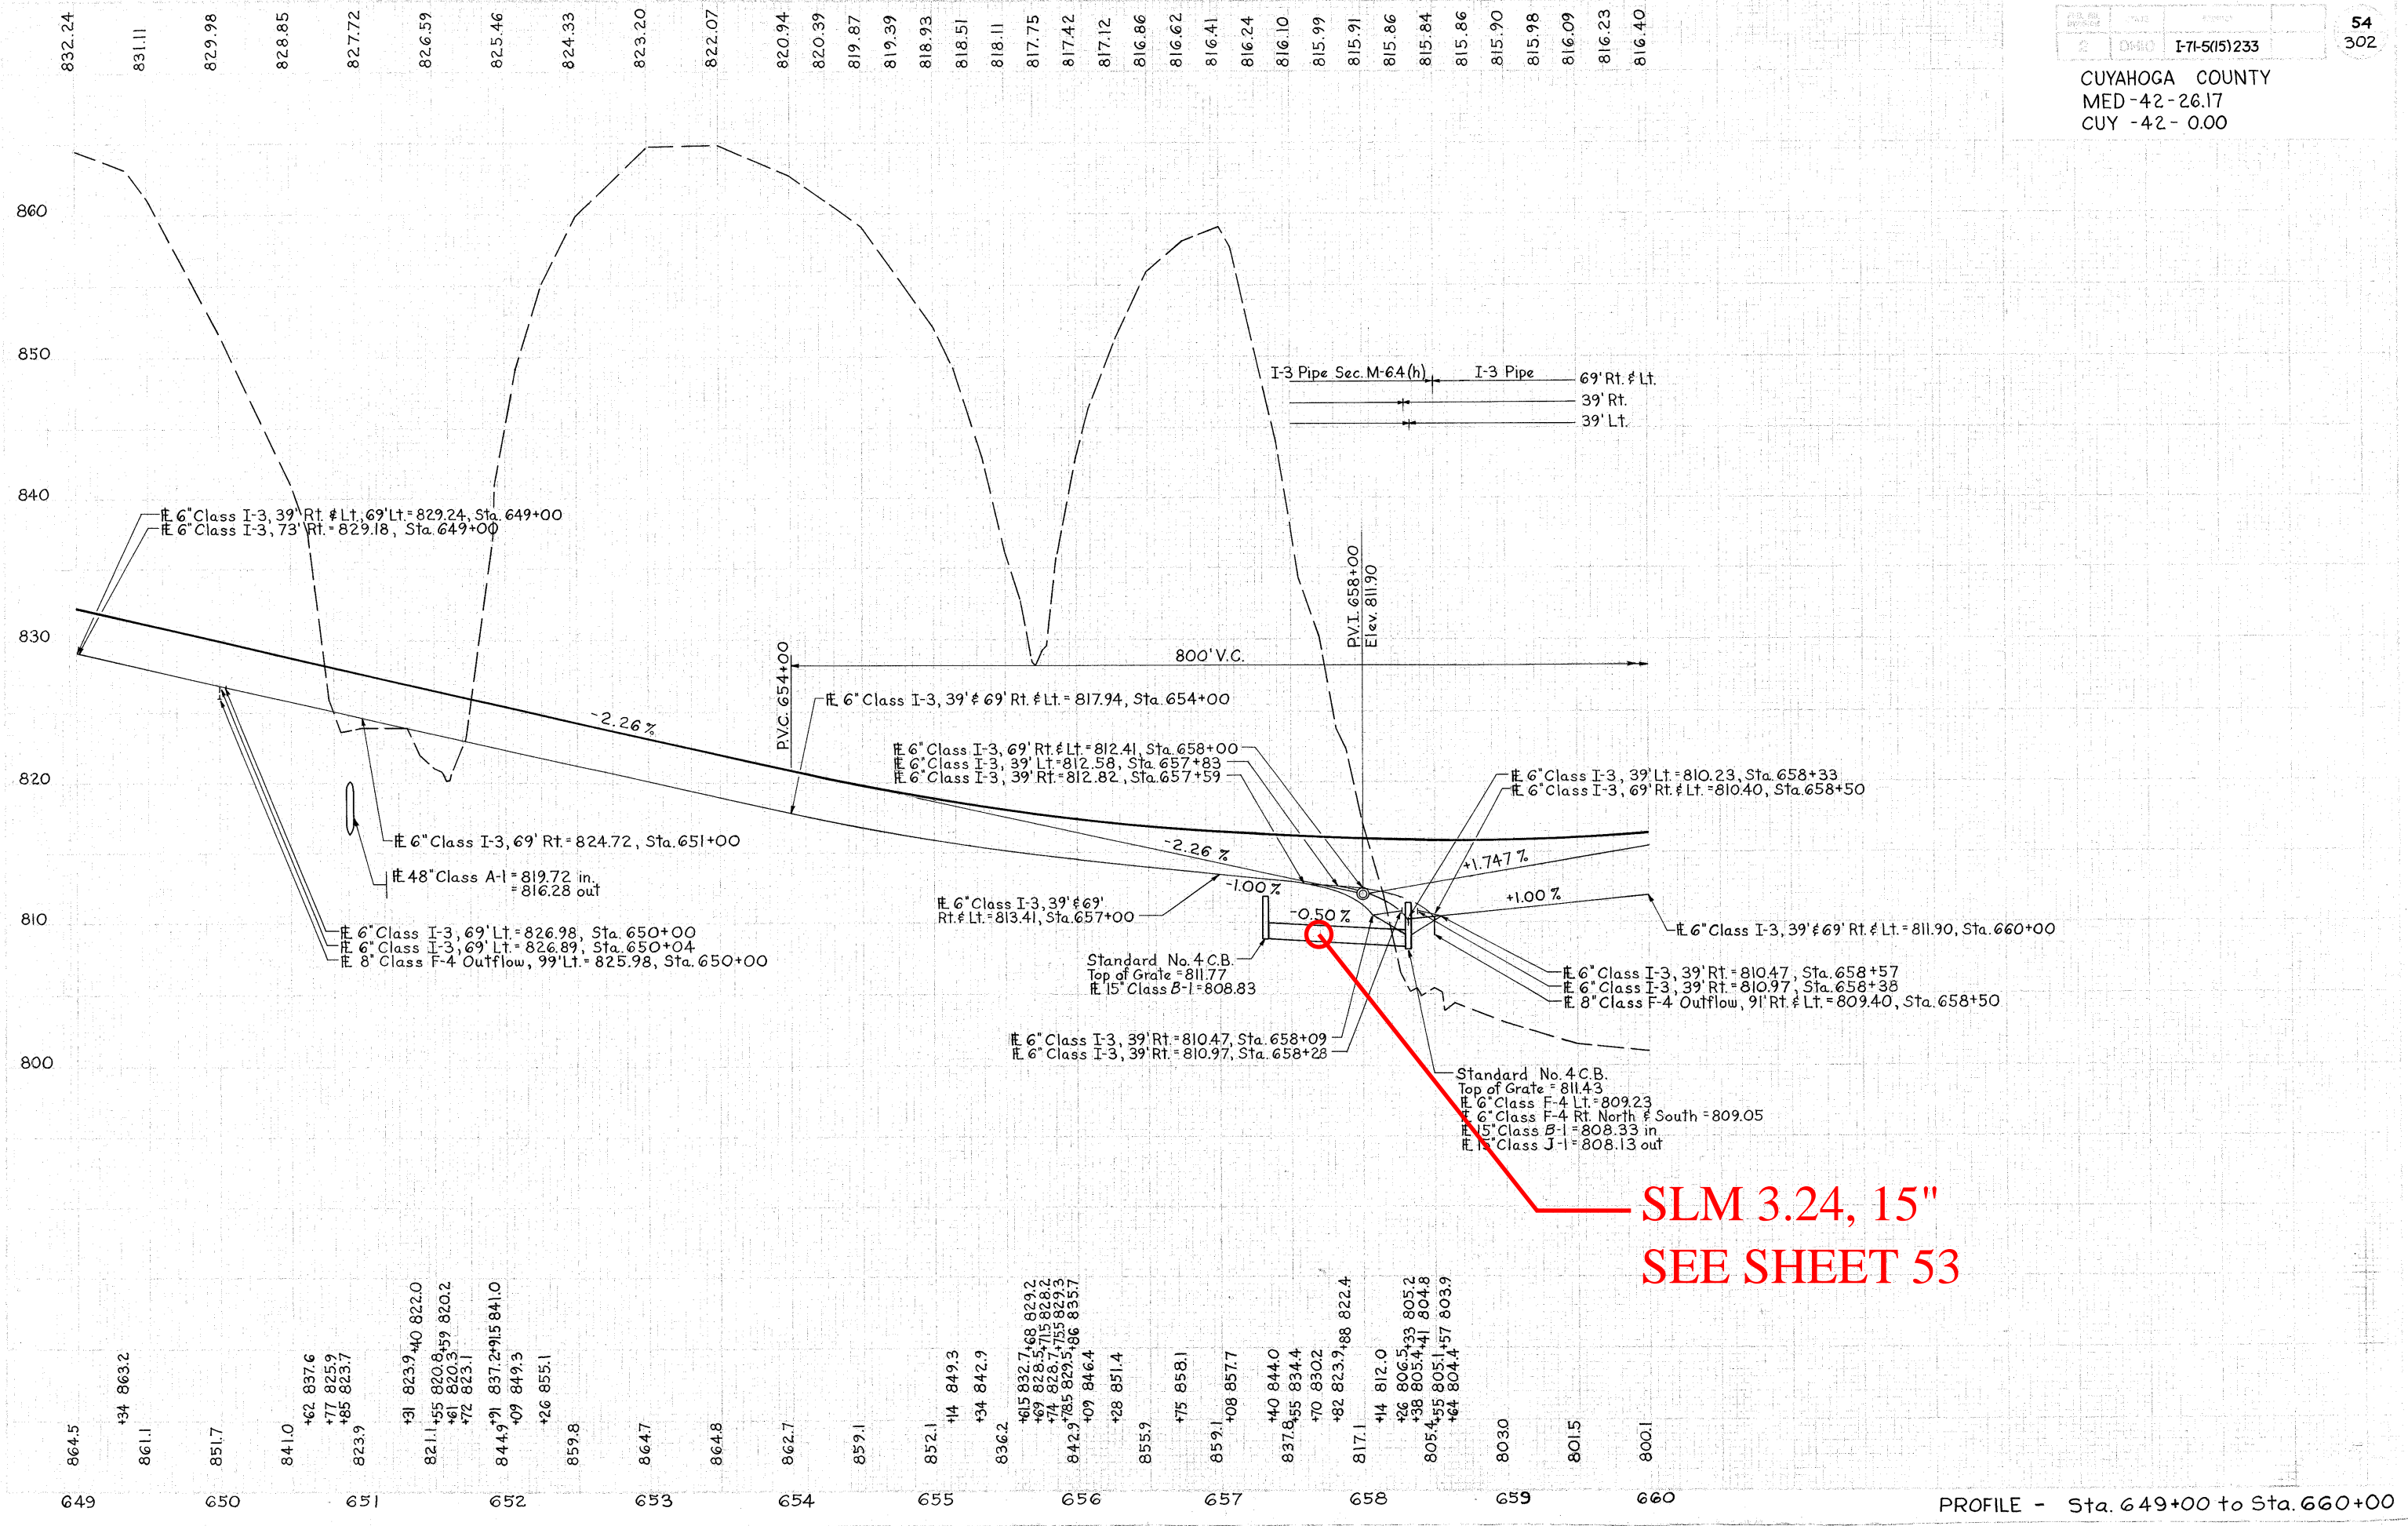

**SLM 3.24, 15"
SEE SHEET 53**

PROFILE - Sta. 649+00 to Sta. 660+00