

SEE 2001 CUY-71-0.00 PLANS FOR MODIFICATIONS TO STORM SEWERS

CFN 180710405
SLM 4.05, 48"
SEE SHEET 144


SLM 4.05, 15"
SEE SHEET 144

CFN 180710422
SLM 4.22, 84"
SEE SHEET 144

CUYAHOGA COUNTY
CUY - 42 - 3.38


2 OHIO I-71-5(11)236

23
263

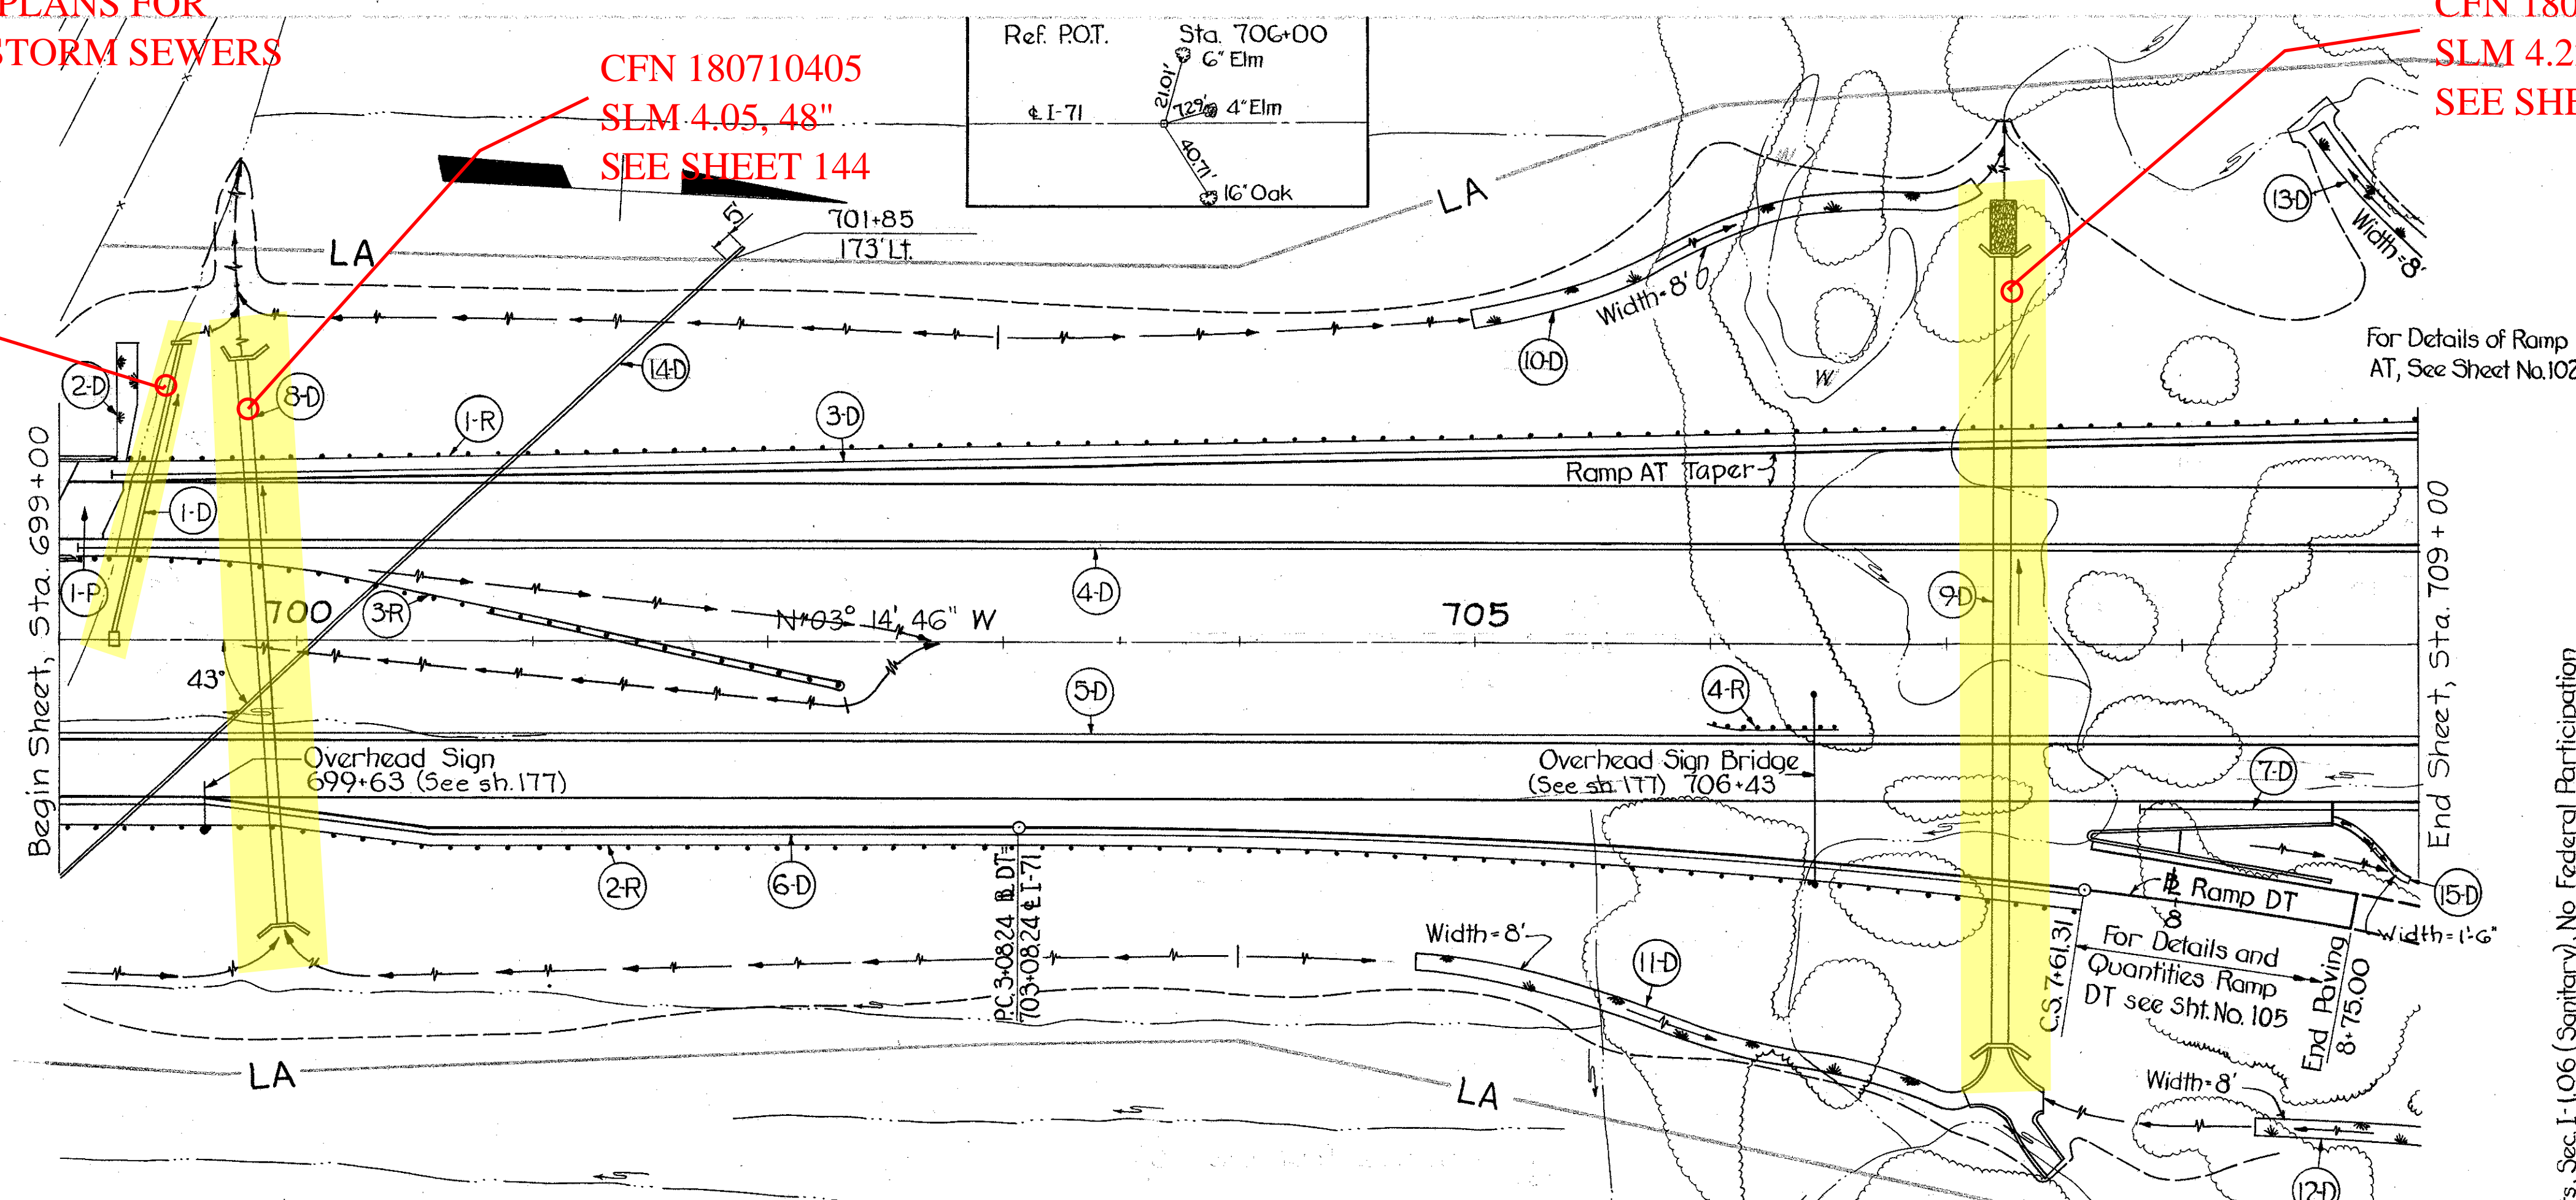

For Details of Ramp AT, See Sheet No.102

For Details and Quantities Ramp DT see Sht. No. 105

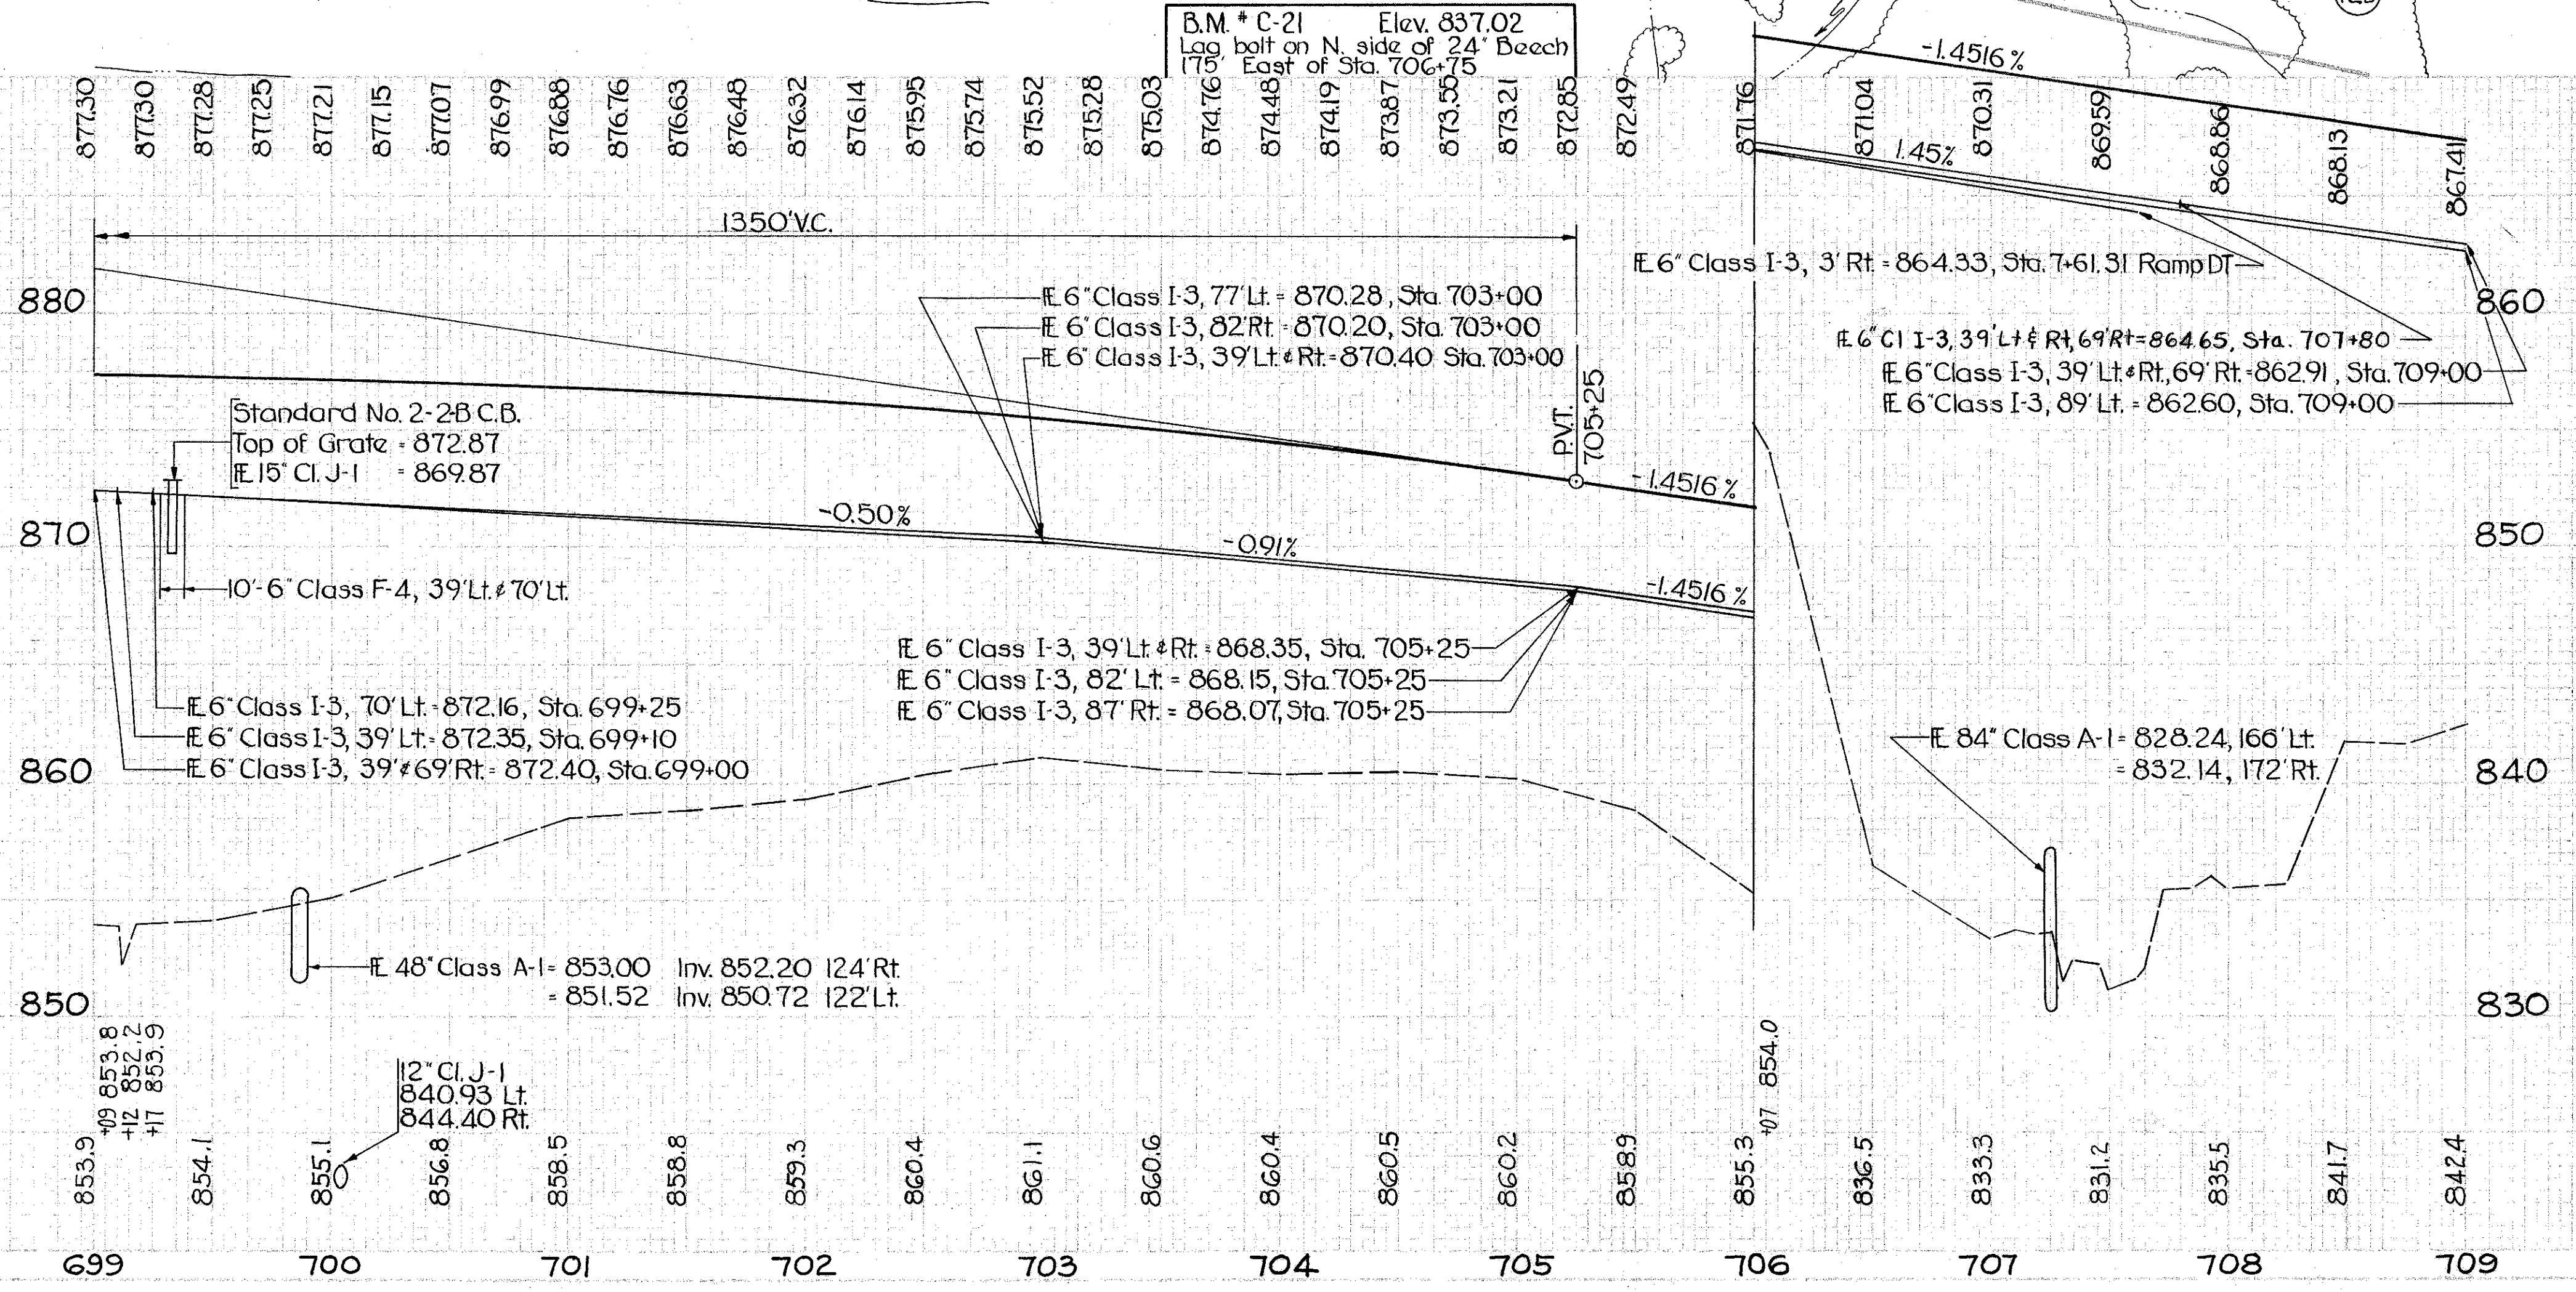

With compression joints, Sec. I-106 (Sanitary), No Federal Participation

(4' 50% slope & 50% Tarpaple; 2.94' Normal)

ESTIMATED QUANTITIES

REF. NO.	STATION TO STATION	SIDE	Class J Pipe	Class A Pipe	CI F-4 Pipe	CI F-4 Pipe	Shallow	Masonry Headwall	Special CI F-4	Stand. Rip Rap	Stand. Rip Rap	Special Guard Rail	Special Spooling	Special Spooling	SEE SHEET NO.
			Lin. Ft.	Lin. Ft.	Lin. Ft.	Lin. Ft.	Lin. Ft.	No.	Each	Sq. Yd.	Sq. Yd.	Lin. Ft.	Sq. Yd.	Sq. Yd.	
I-D	699+25	Med	85						2				2		144
2-D	699+25	Lt.													144
3-D	699+25 to 709+00	Lt.			44	965							52		144
4-D	699+10 to 709+00	Rt.			10	980									144
5-D	699+00 to 709+00	Rt.			10	1000									144
6-D	699+00 to 709+00	Rt.				865									144
7-D	701+80 to 709+00	Rt.				120									144
8-D	699+85														144
9-D	707+23														144
10-D	703+00 to 707+10	Lt.													144
11-D	704+75 to 707+10	Rt.													144
12-D	8-30 to 9100 Ramp DT														144
13-D	708+60 to 709+00	Lt.													144
14-D	700+00														144
15-D	708+64 to 708+95	Rt.													144
1-R	699+65 to 709+00	Lt.													144
2-R	699+00 to 715 Ramp DT														144
3-R	699+45 to 702+40	Med													144
4-R	705+99 to 706+49	Med													144
I-P	699+72.65 to 698+97.65	Lt.													144
TOTALS															