
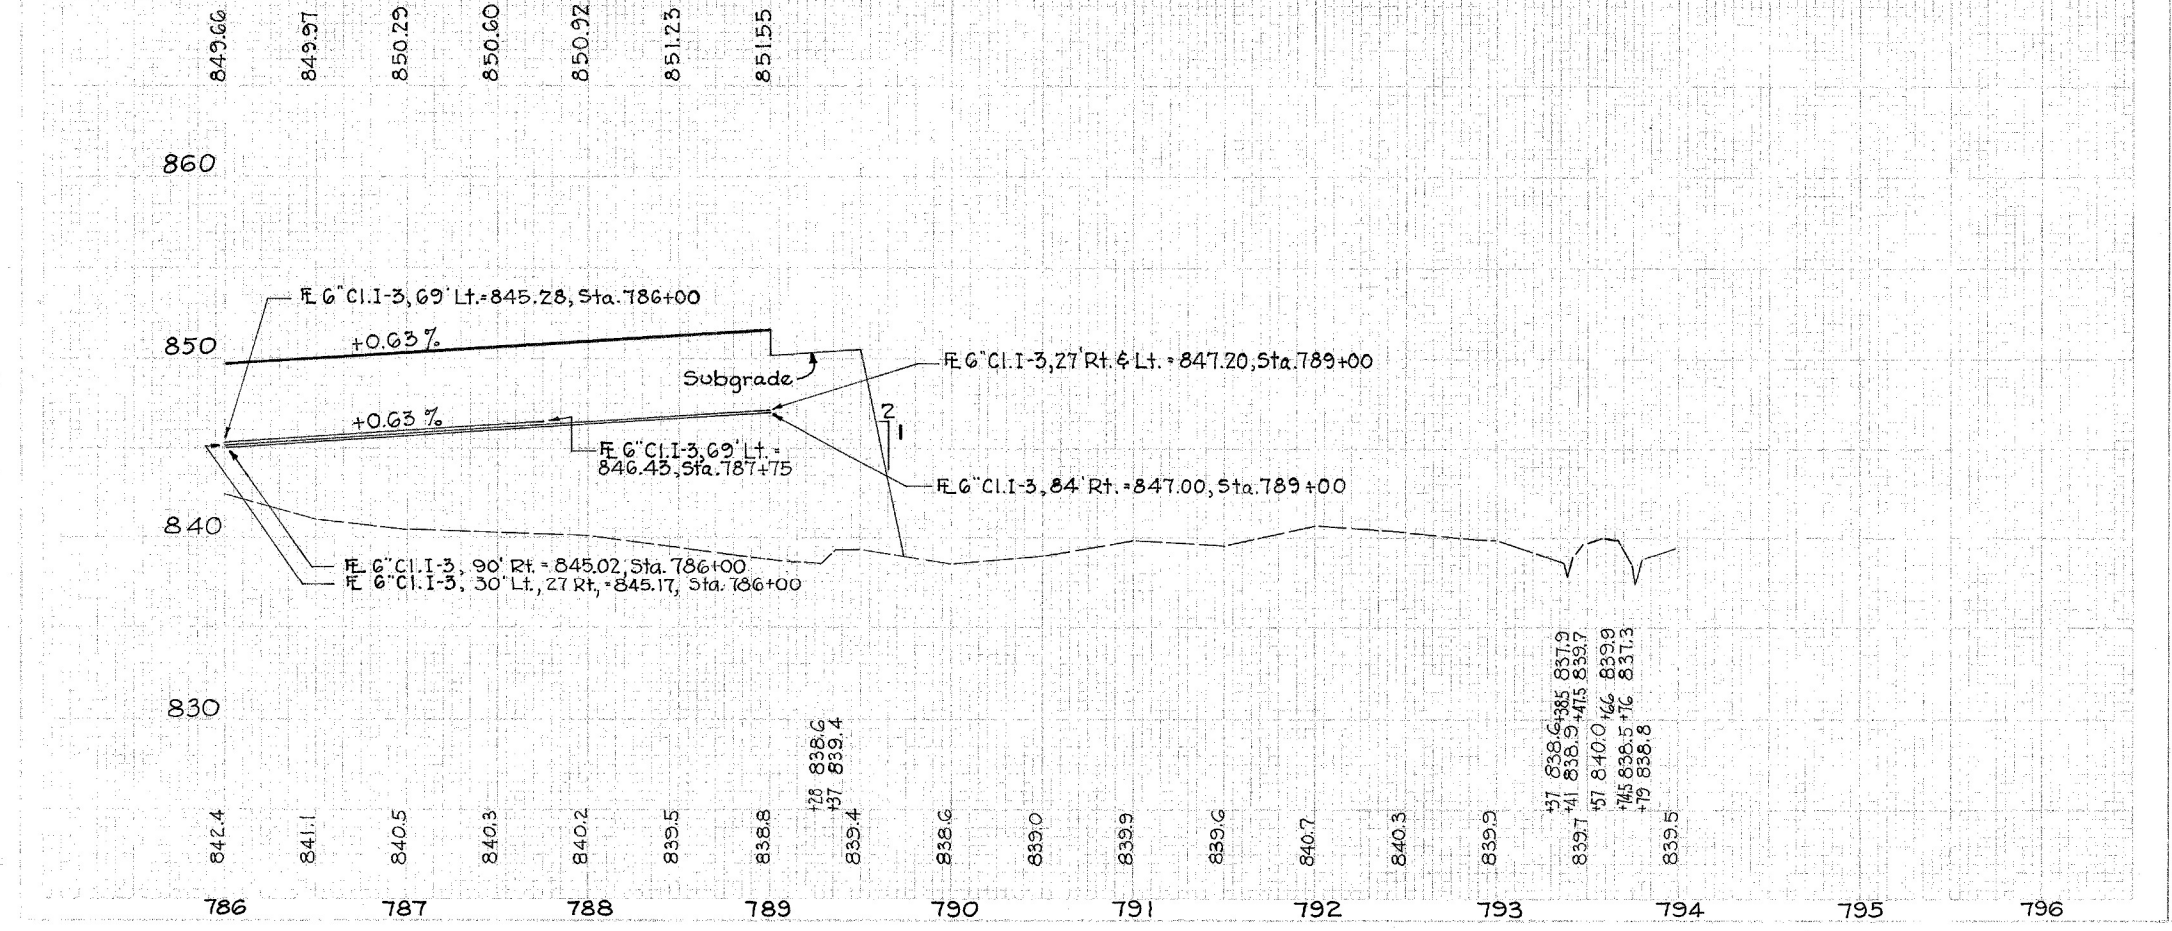


SLM 5.72=MM 234.43

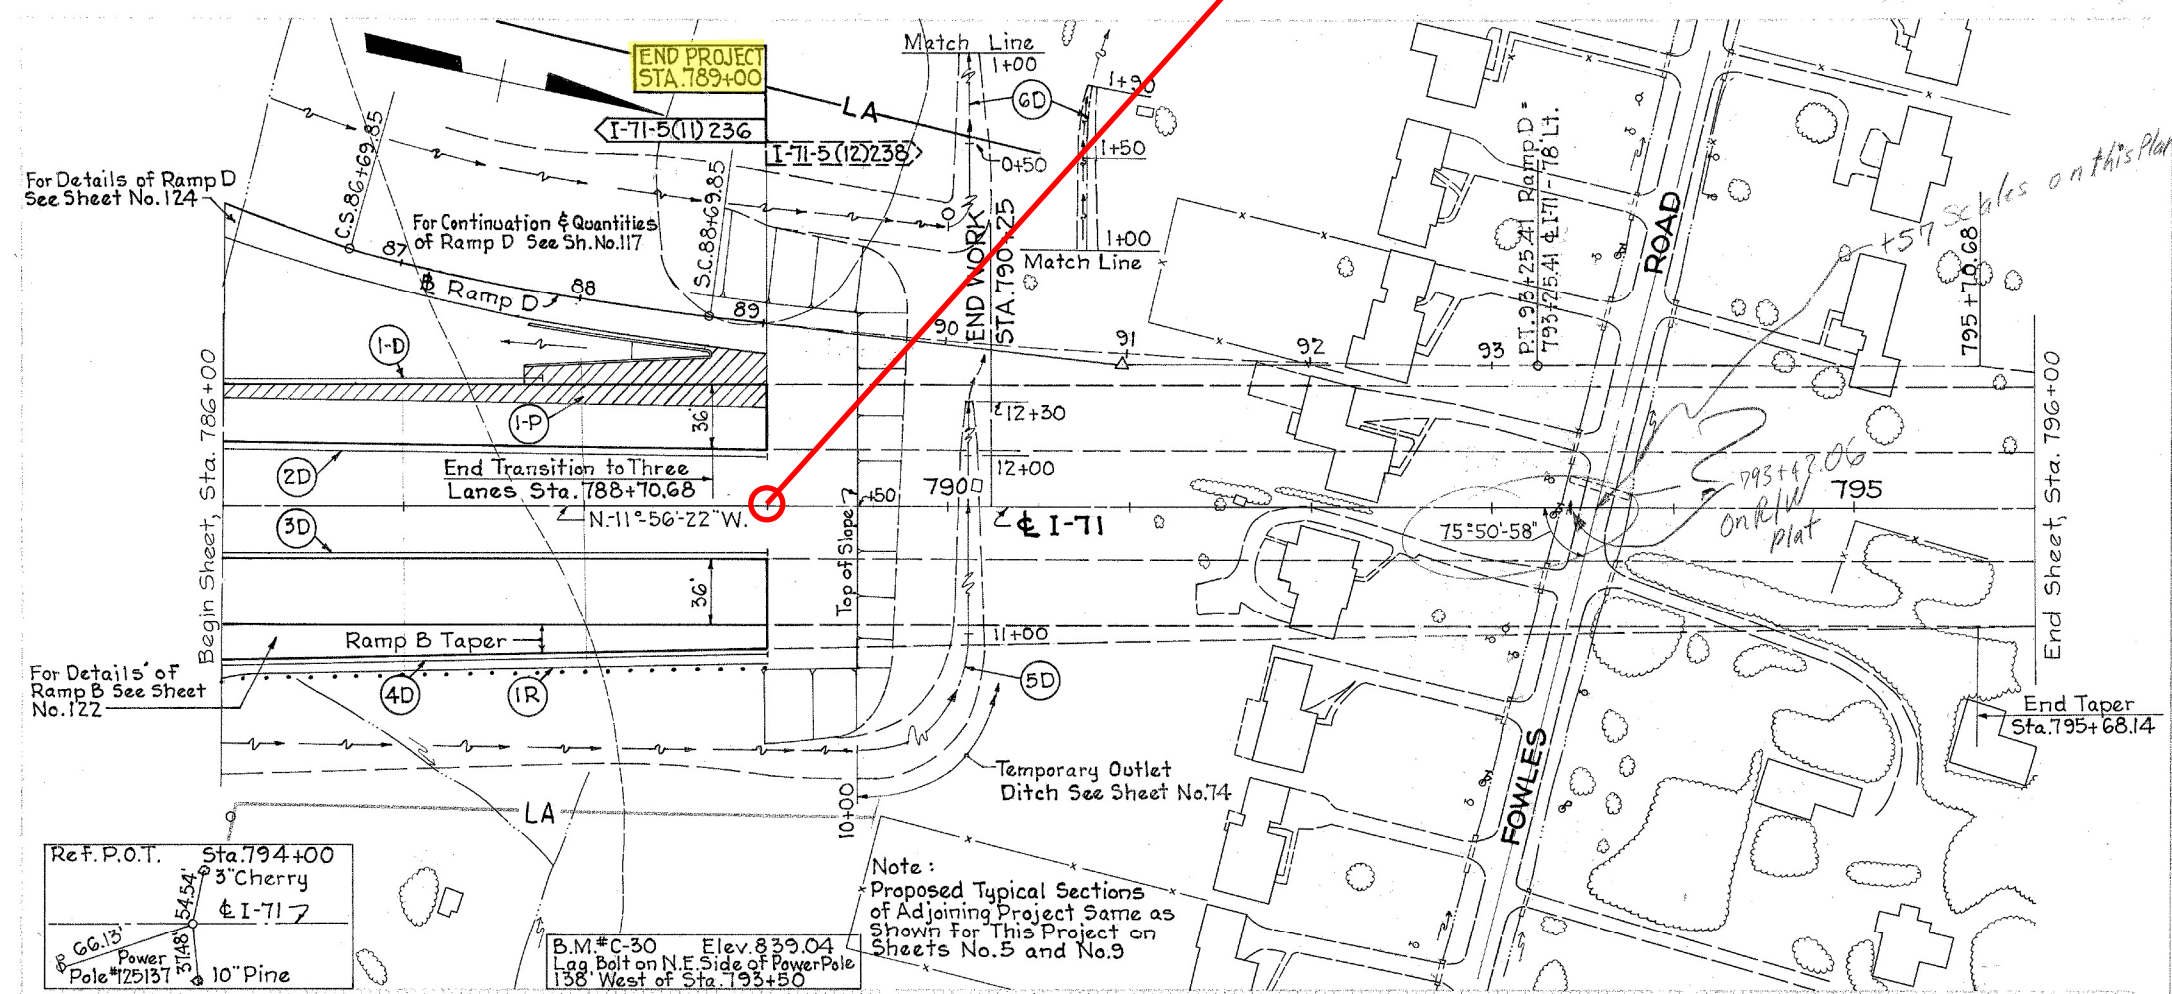

REF. STATION TO STATION	SIDE	ESTIMATED QUANTITIES				SEE SHEET NO.
		I-1 Class 1 1/2 Pipe & Shallow Lin. Ft.	E-3 Channel Excavation Cu. Yd.	I-125 Channel/Drainage Stripping Line Miles Lump	I-15 Guard Rail Lin. Ft.	
I-D 786+00 to 787+75 Lt.	Lt.	175				74
I-D 786+00 to 789+00 Lt.	Lt.	300				74
I-D 786+00 to 785+00 Rt.	Rt.	300				
I-D 786+00 to 785+00 Rt.	Rt.		172			
I-D 789+50 to 790+10 Rt.	Rt.		66			
I-D 790+00 to 790+10 Lt.	Lt.					
I-P 786+00 to 789+00 Lt.	Lt.			0.12 Lump		
I-R 786+00 to 789+00 Rt.	Rt.				300	
TOTALS						

Sta. 786+00 to Sta. 796+00