



End Area		Cu. Yds.	
Cut	Fill	Cut	Fill
24	6.5	66.7	53.7
12	12.5	32.1	38.9
5.5	8.5	10.2	34.3
0	10	0.4	15.8
0.5	7	0.0	11.6
0.5	5.5	0.9	22.7
0.5	19	1.1	18
2	20	2.3	102
3	2	0	0

Excav 316.8 Cu. Yds.
Emb 431.1 Cu. Yds.

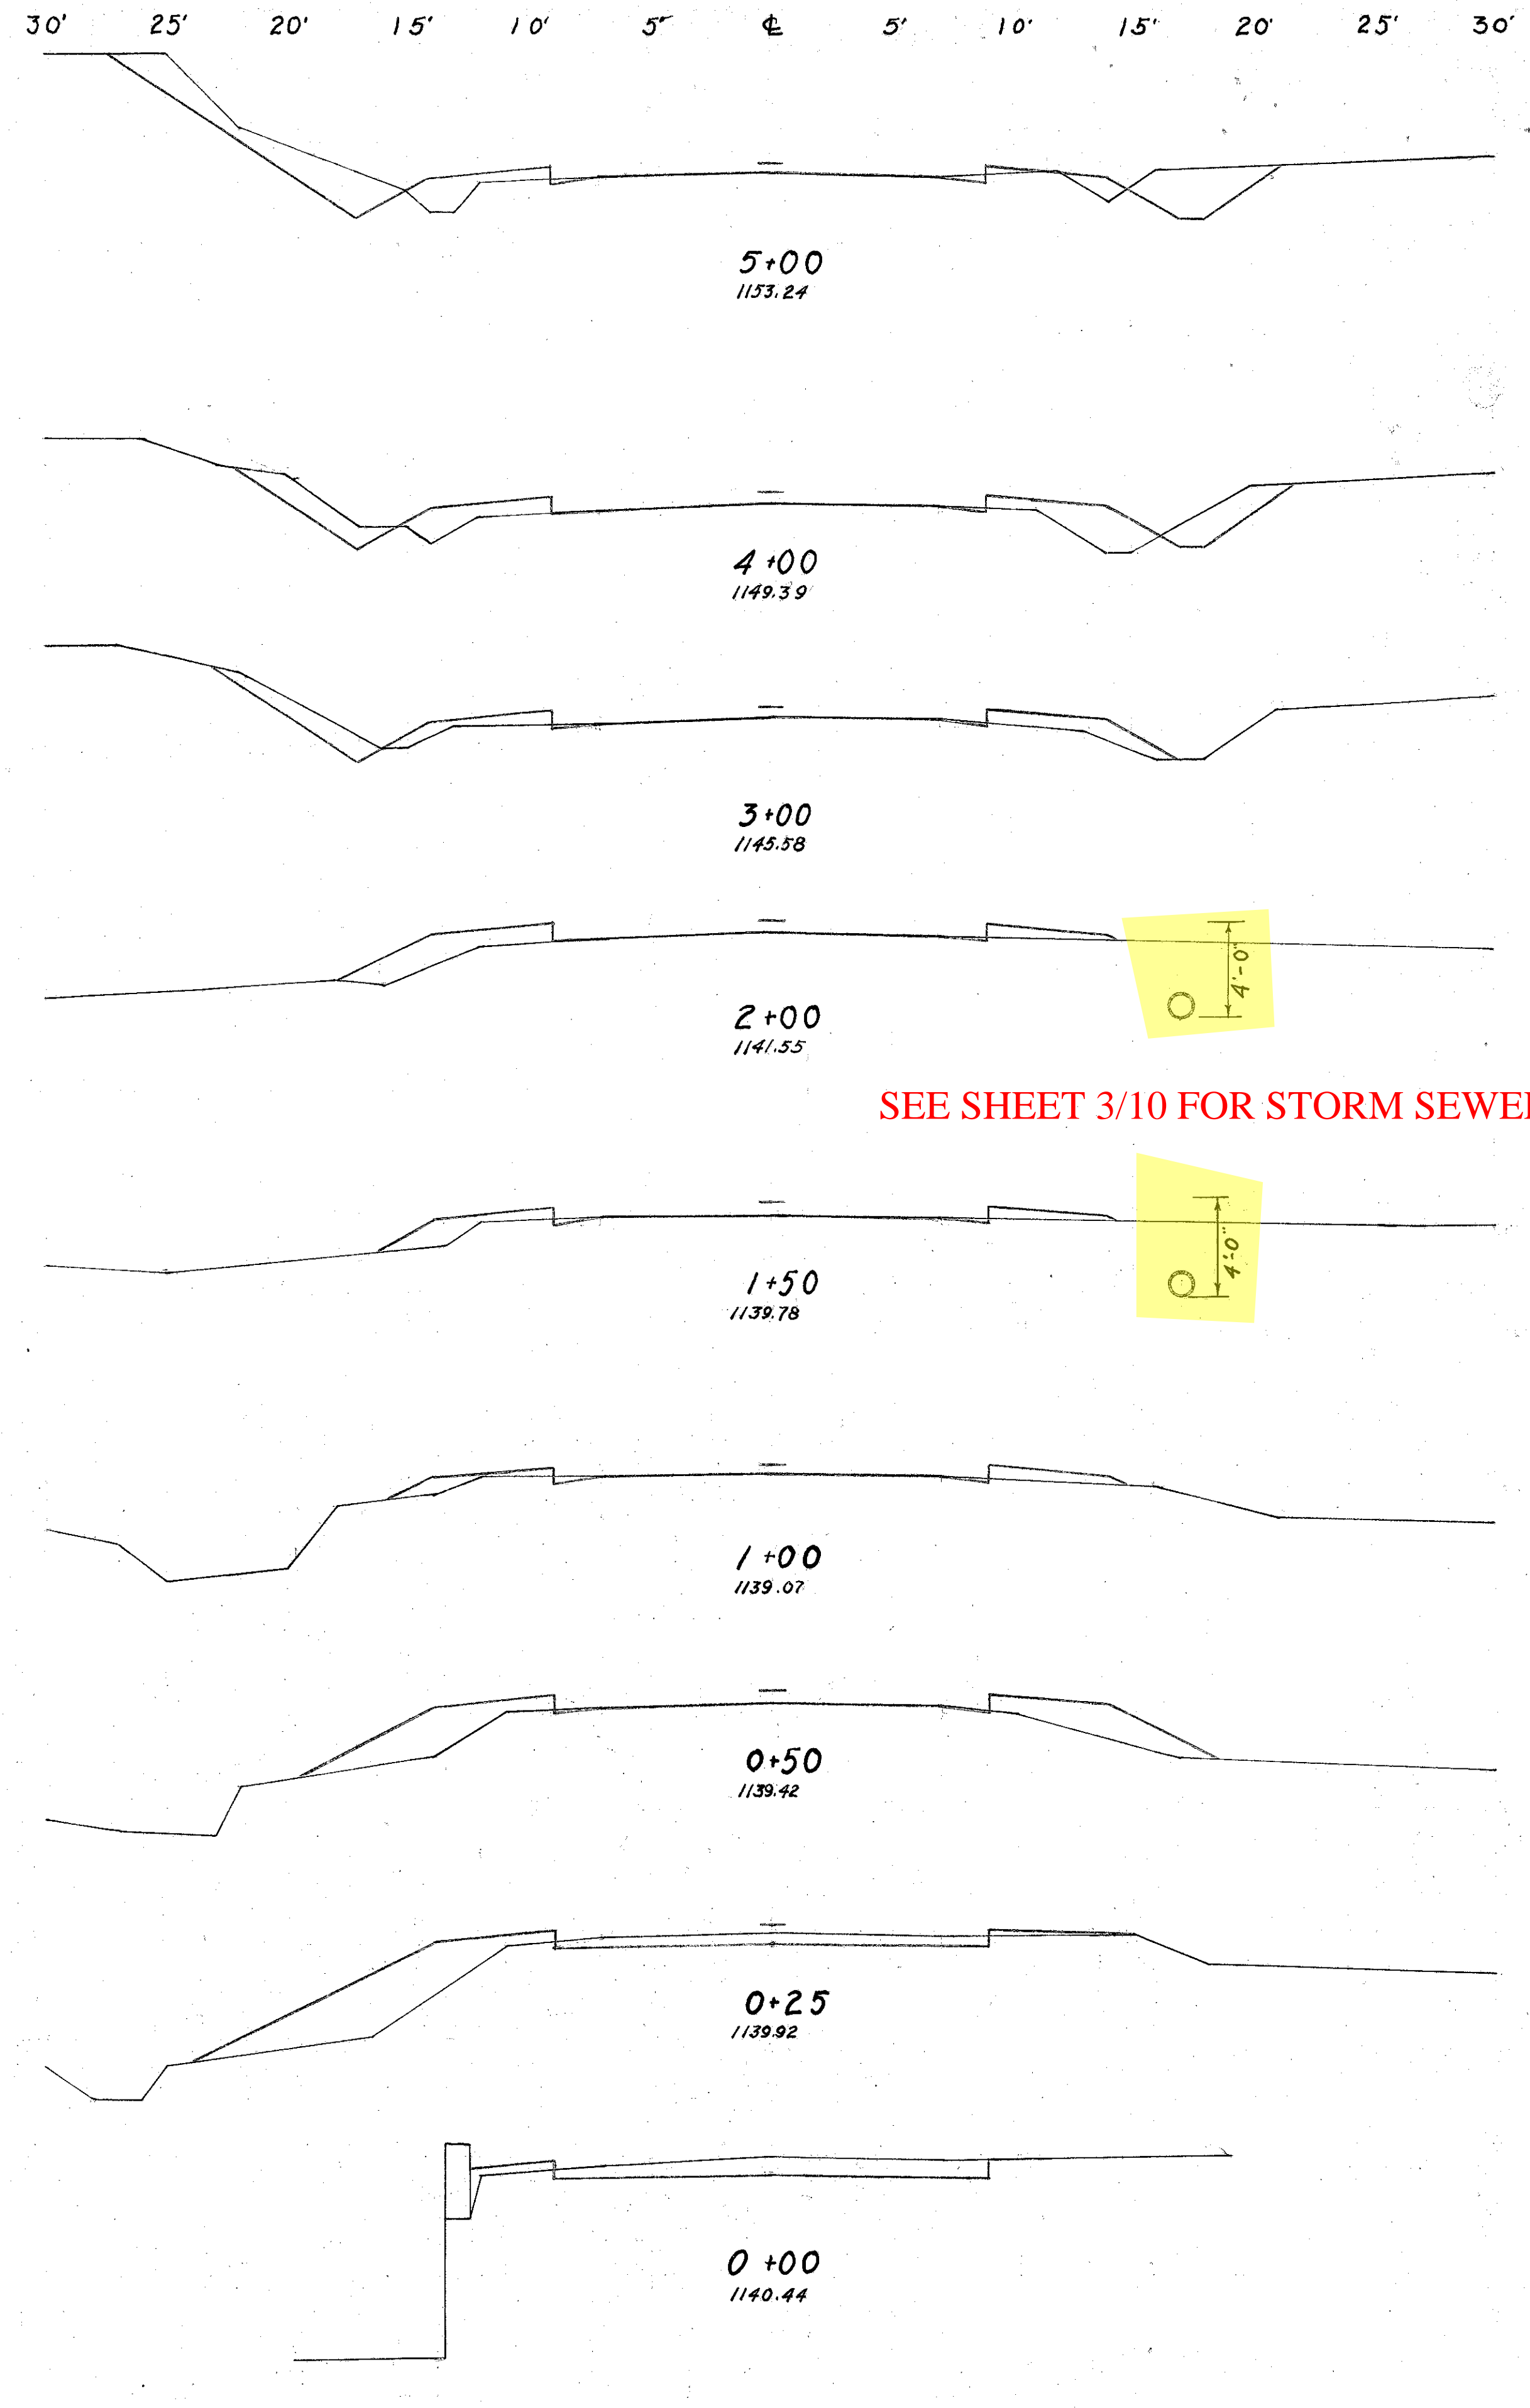

End Area		Cu. Yds.	
Cut	Fill	Cut	Fill
18	8	66.7	35.2
18	11	56.5	45.4
12.5	13.5	38.0	43.5
8	10	21.3	46.3
3.5	15	19.4	47.2
7	10.5	46.3	38.9
18	10.5	77.8	50

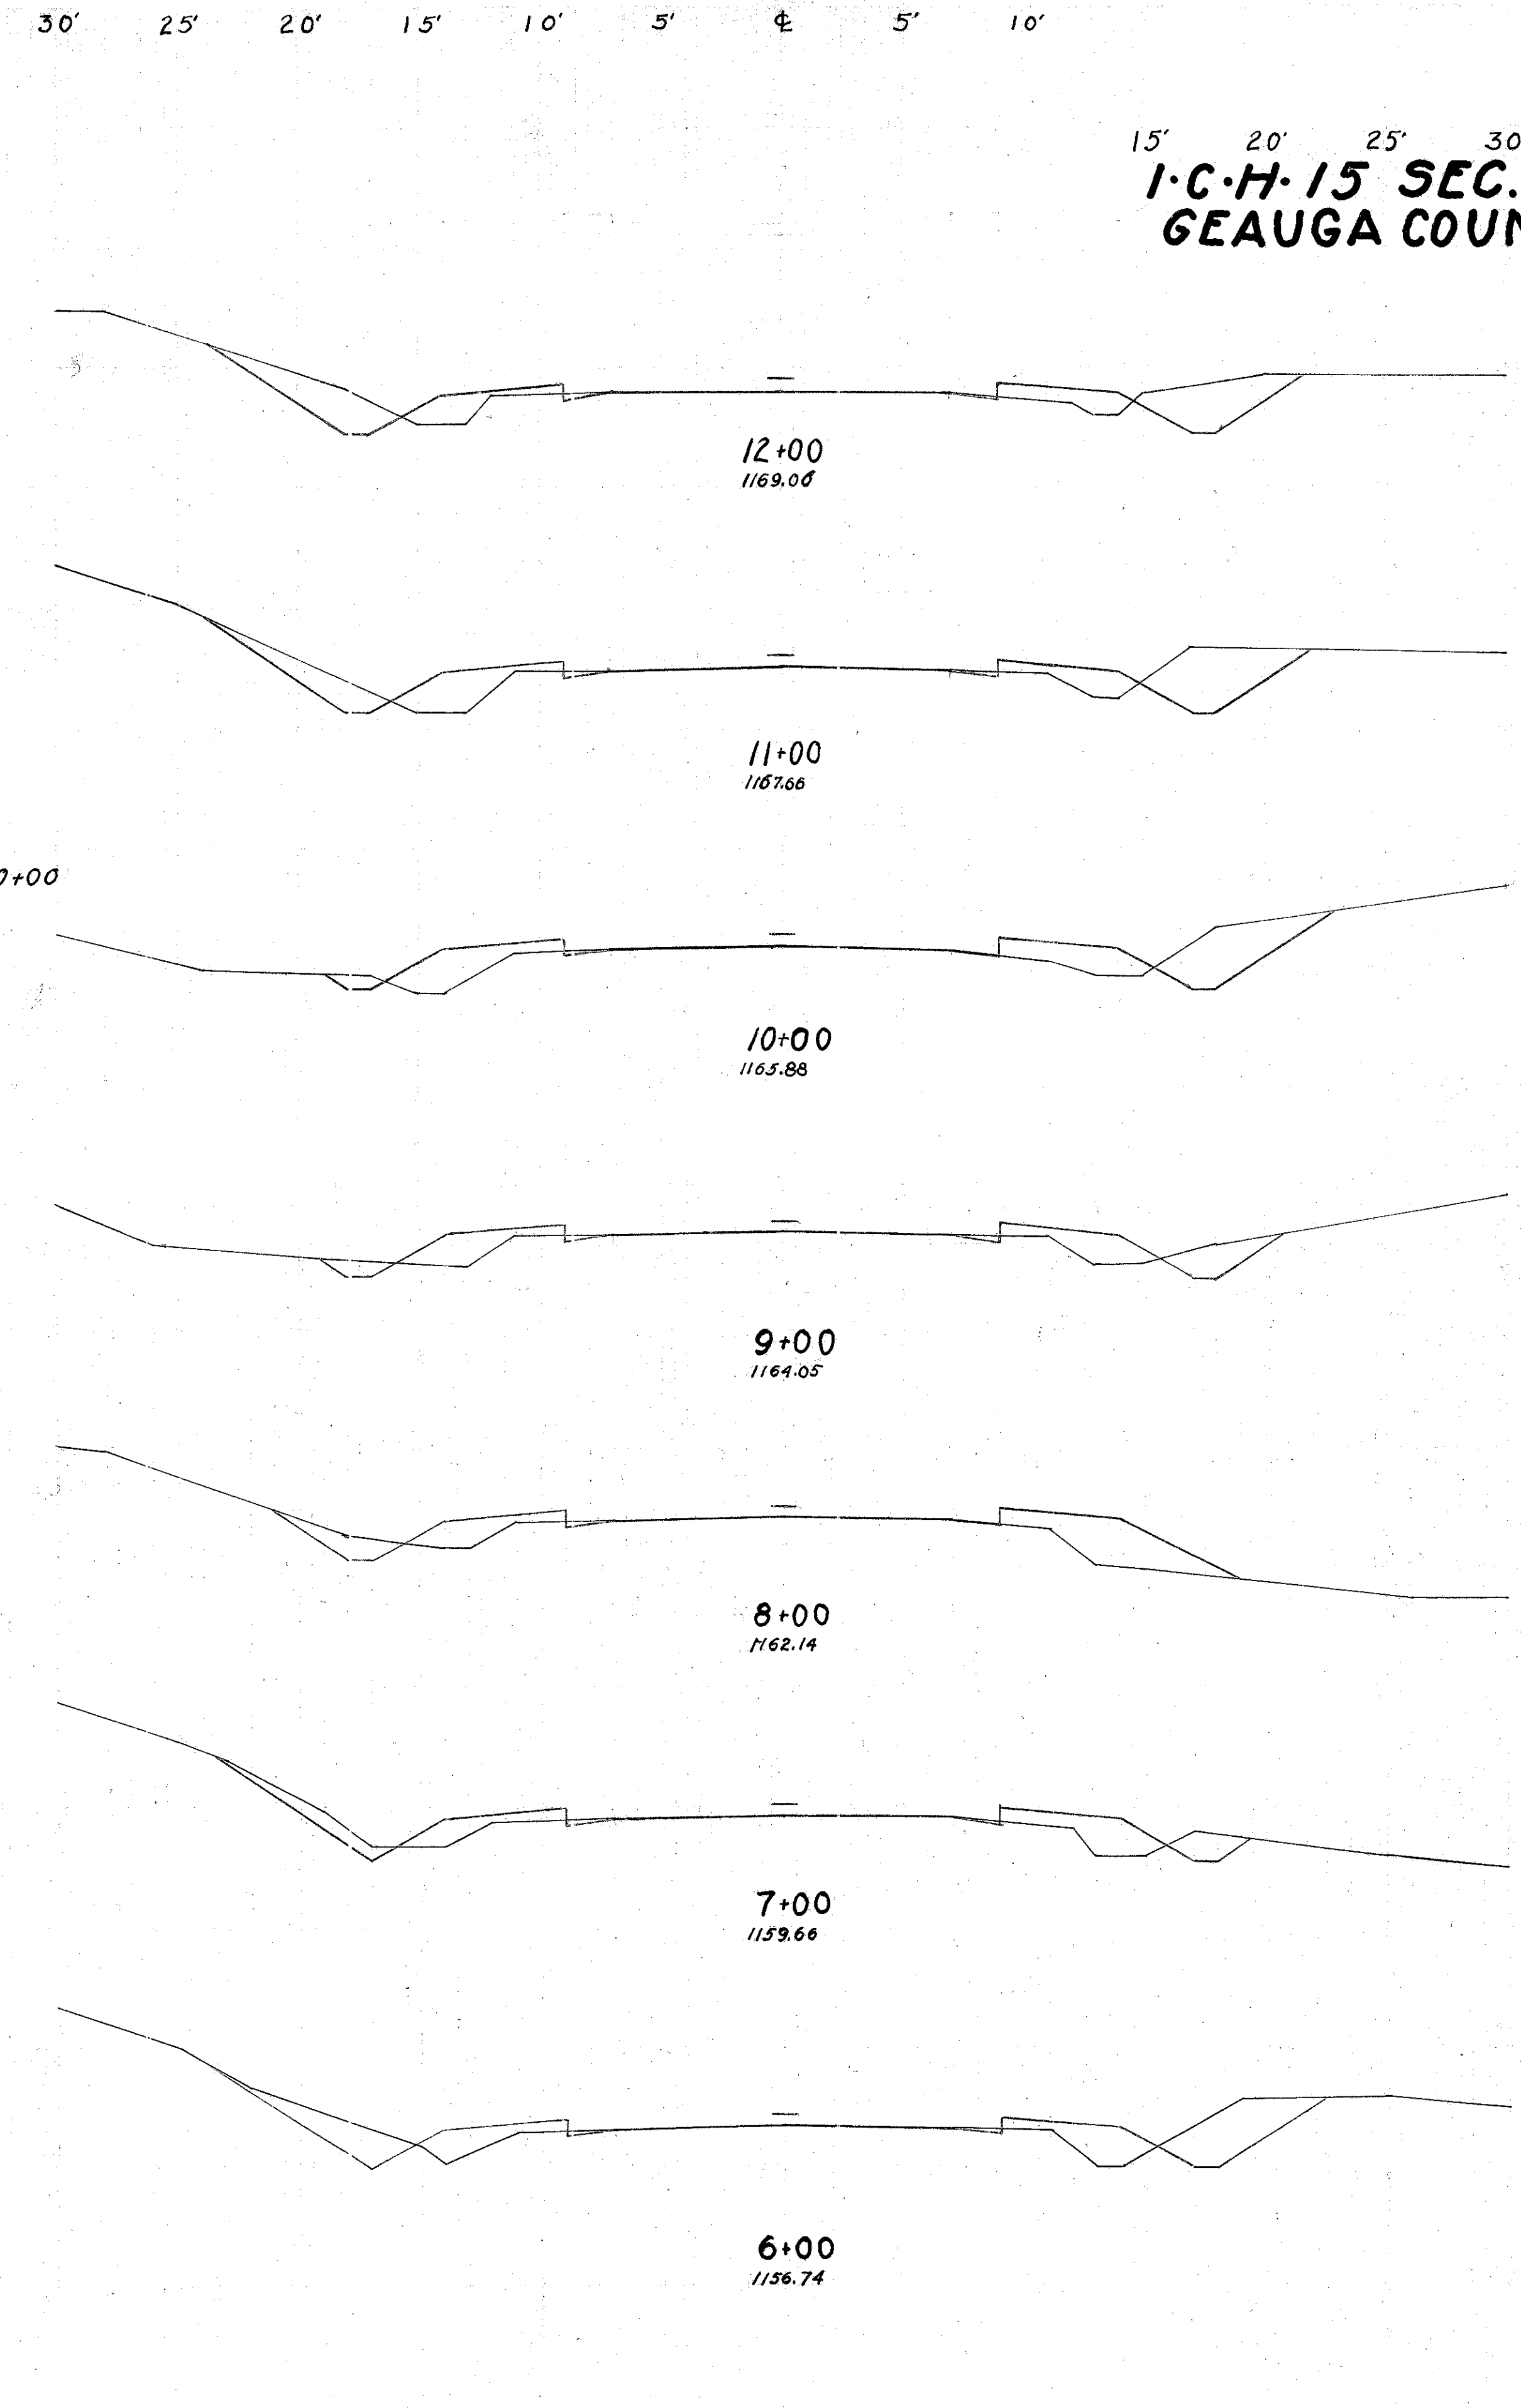

15' 20' 25' 30'

1-C.H. 15 SEC. E
GEAUGA COUNTY

5/10