



End Area		Cu. Yds.	
Cut	Fill	Cut	Fill
10	4.5	18.5	42.6
0	18.5	0	78.6
0	24.5	13.9	77.2
7.5	14.5	21.3	45.4
4	10	51.9	48.1
24	16	105.6	56.5
33	14.5	111.1	56.5
27	16	94.4	57.4
24	15	77.8	54.6

Excav. 504.0 Cu. Yds.
Emb. 556.8 Cu. Yds.

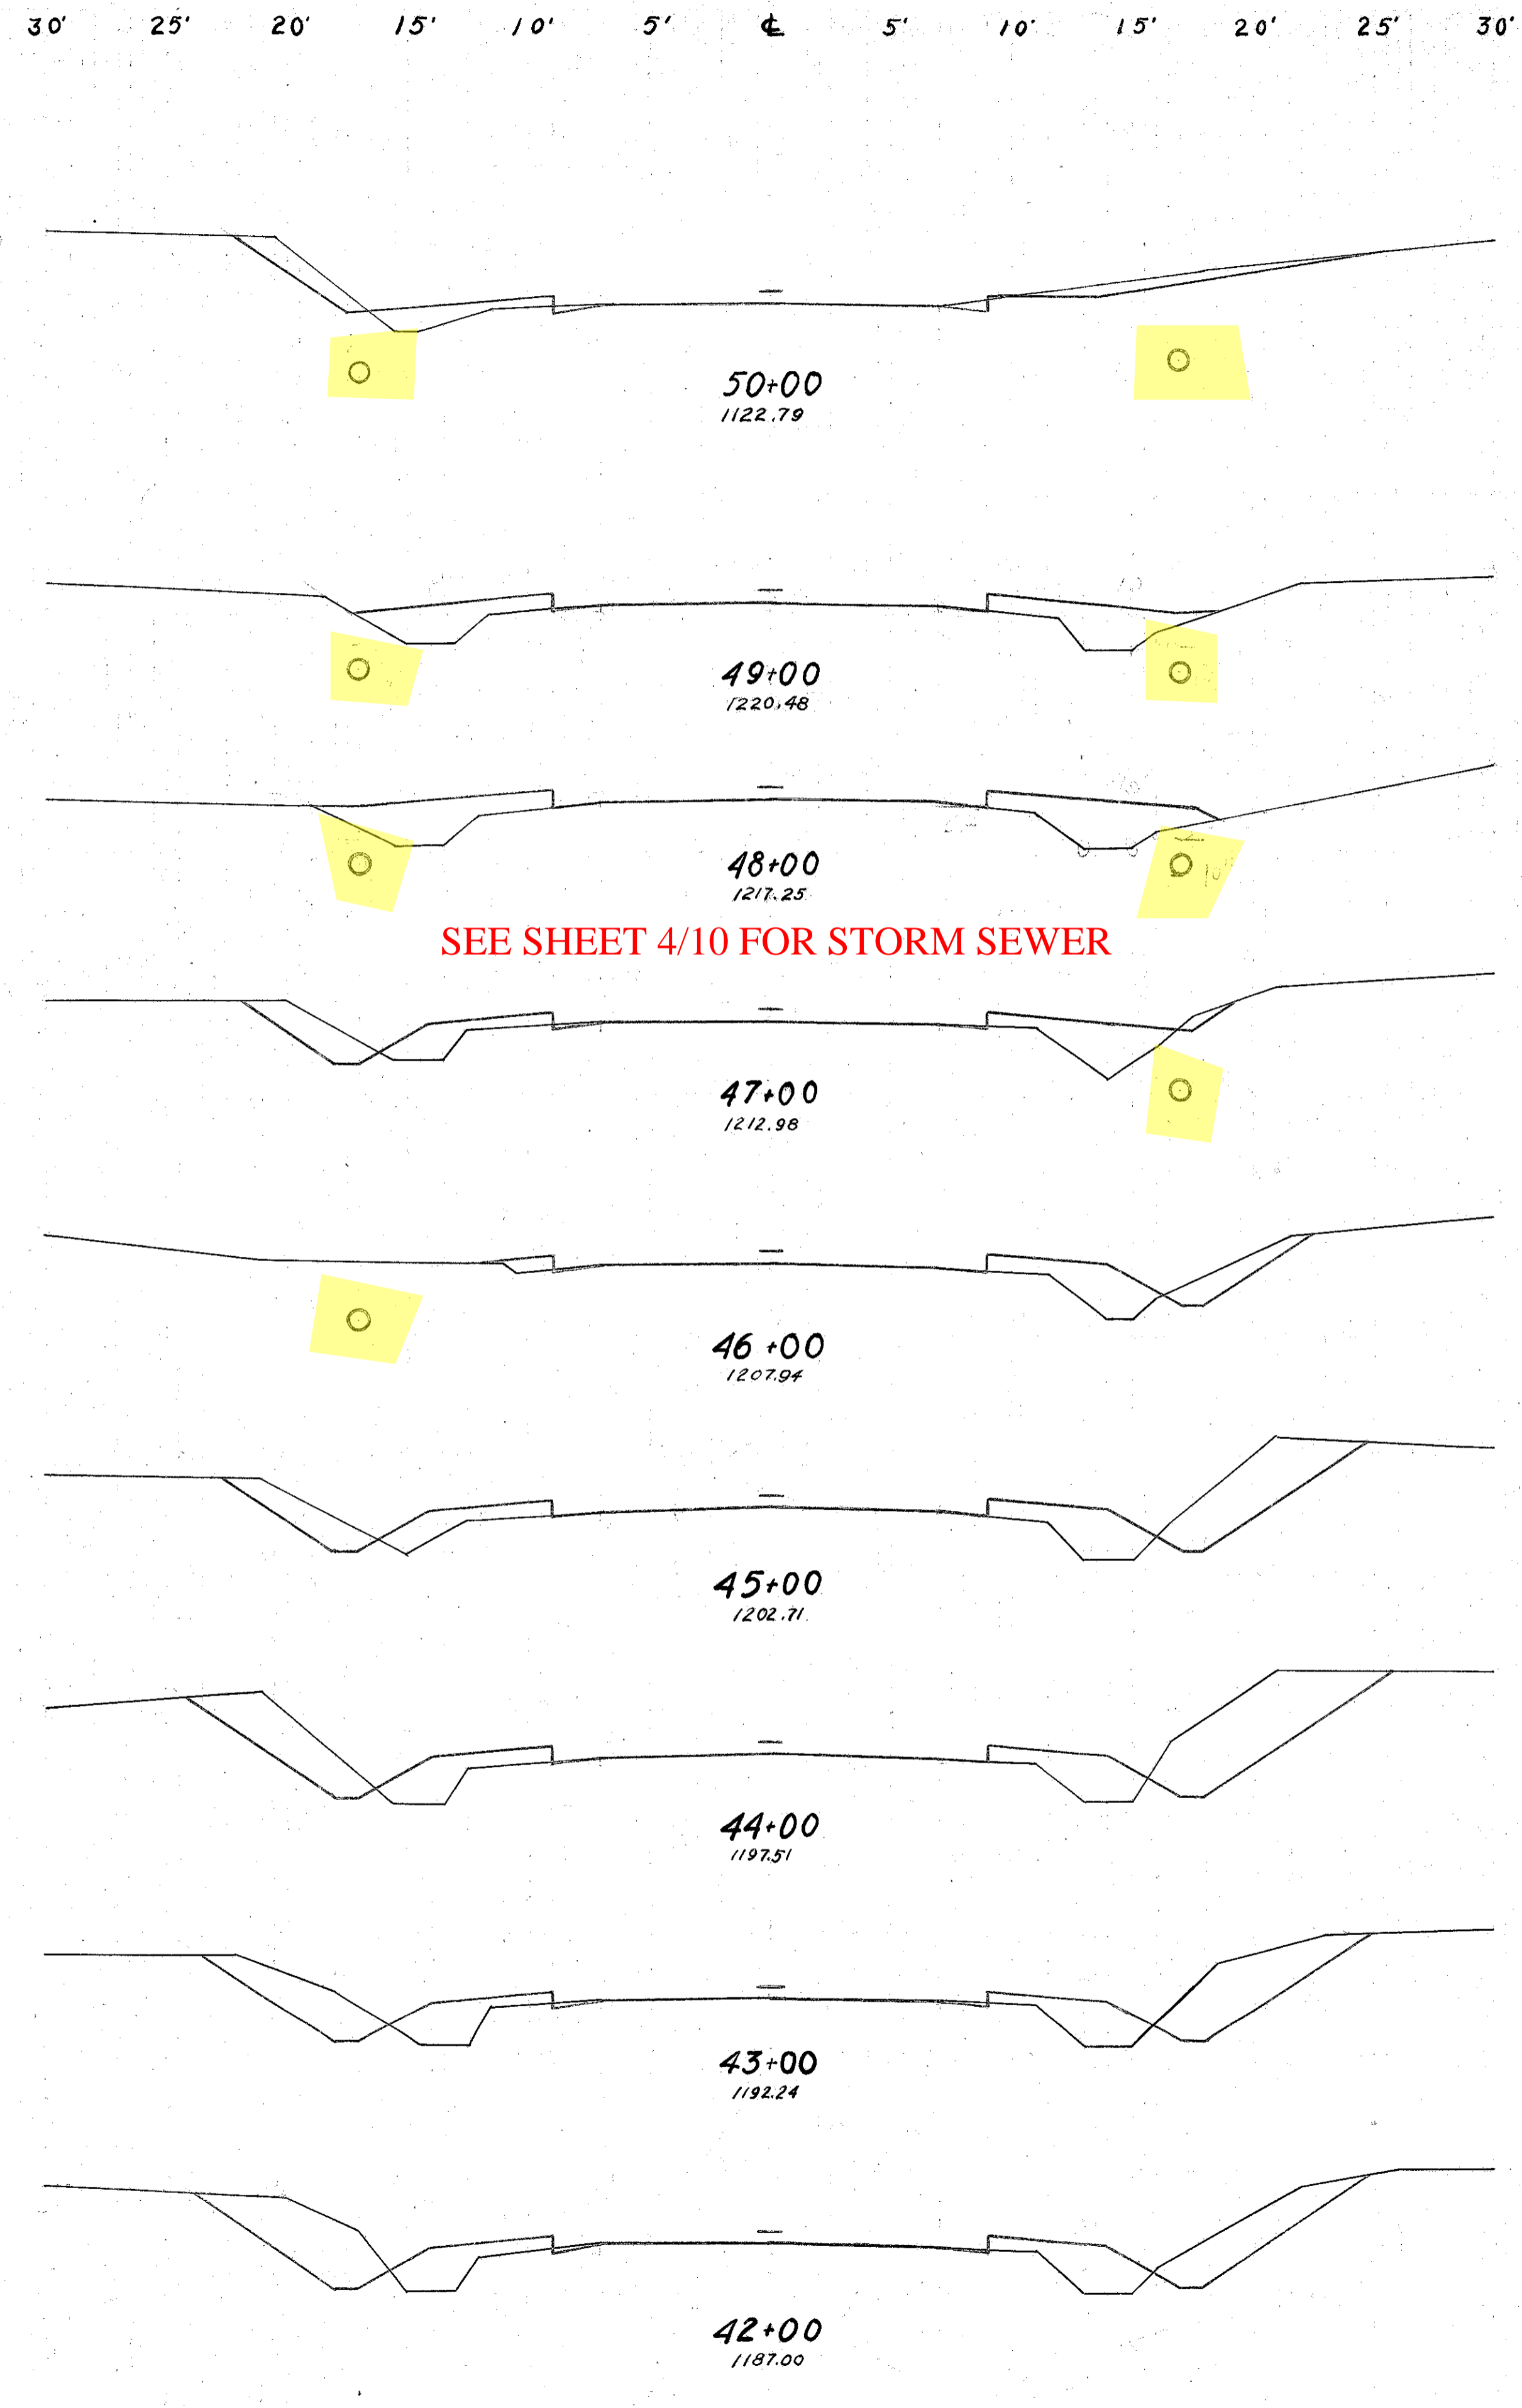

End Area		Cu. Yds.	
Cut	Fill	Cut	Fill
3.5	6.5	6.9	13.9
4	8.5	14.8	19.5
12	12.5	19.5	31
9	11	26.4	19.9
19.5	10.5	28.3	18.0
11	9	19.5	12.5

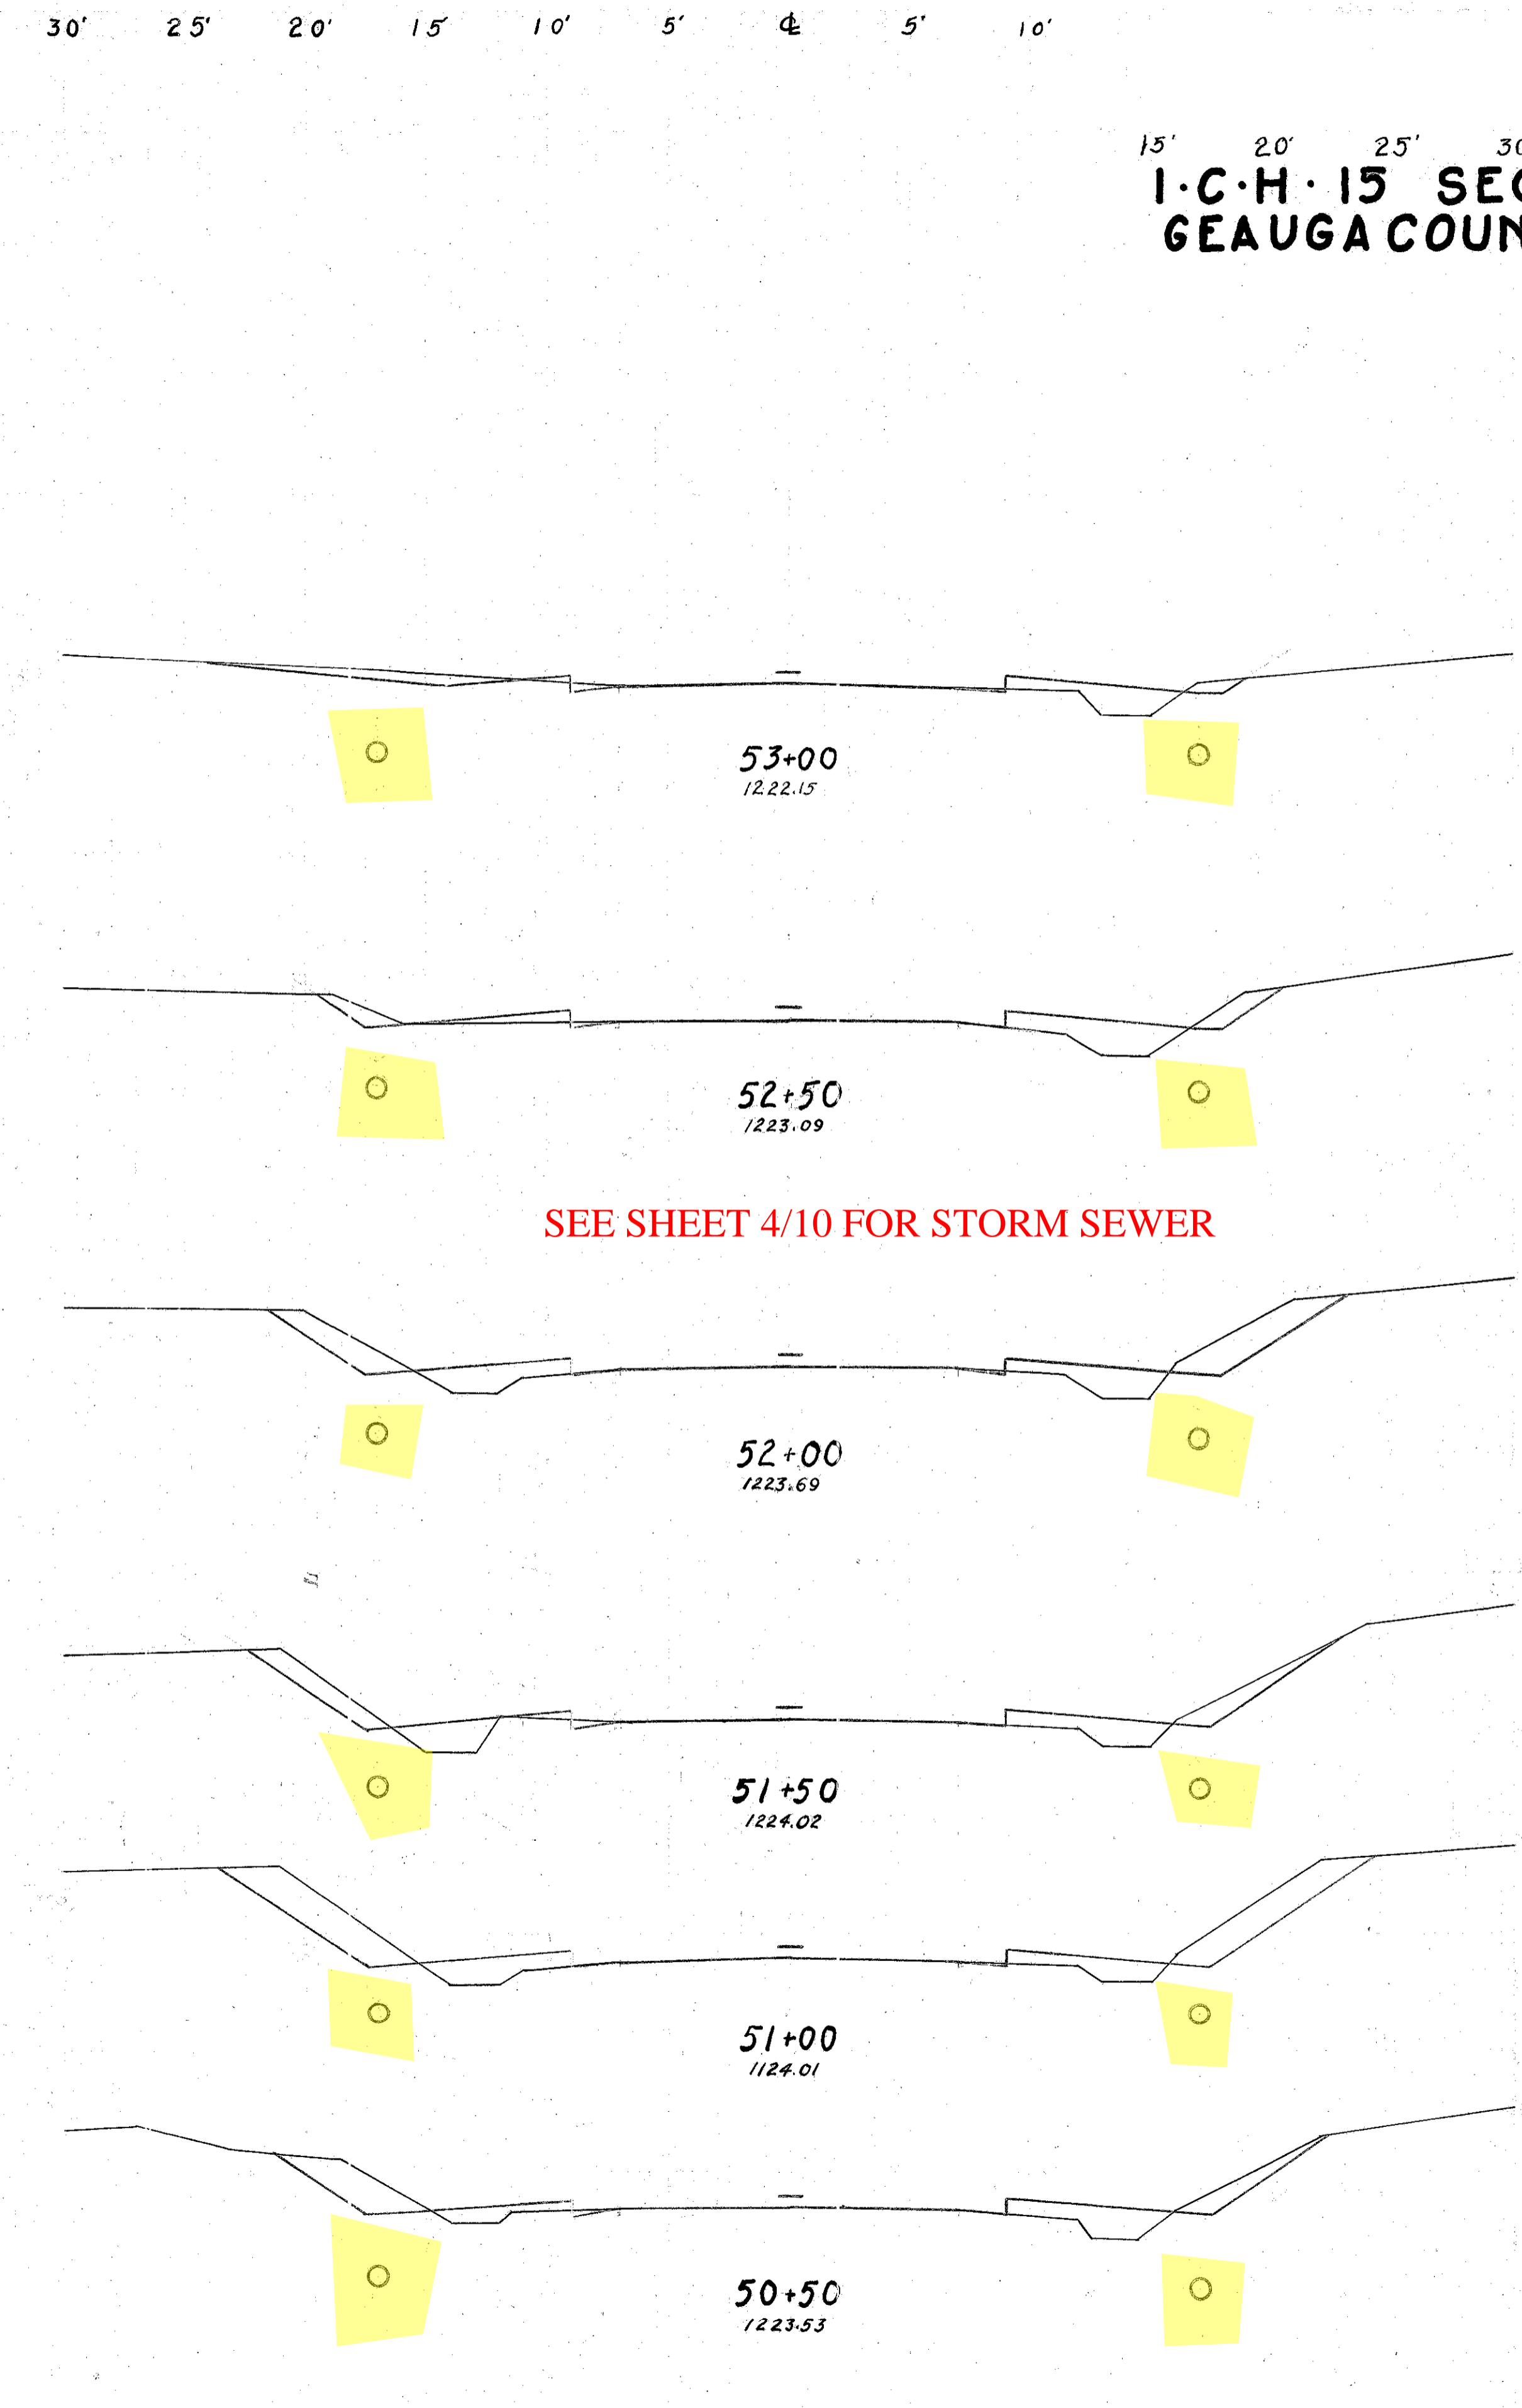

15' 20' 25' 30'
I.C.H. 15 SEC. E
GEAUGA COUNTY