


FED. RD. DIST. NO.	STATE	FED. AID PROJECT	FISCAL YEAR
10	OHIO	388-D	1926

I.C.H. 324 SEC. E  
GEAUGA COUNTY  
GEA-44-8.79 (8.88-10.92)

SR 87  
SLM 8.88

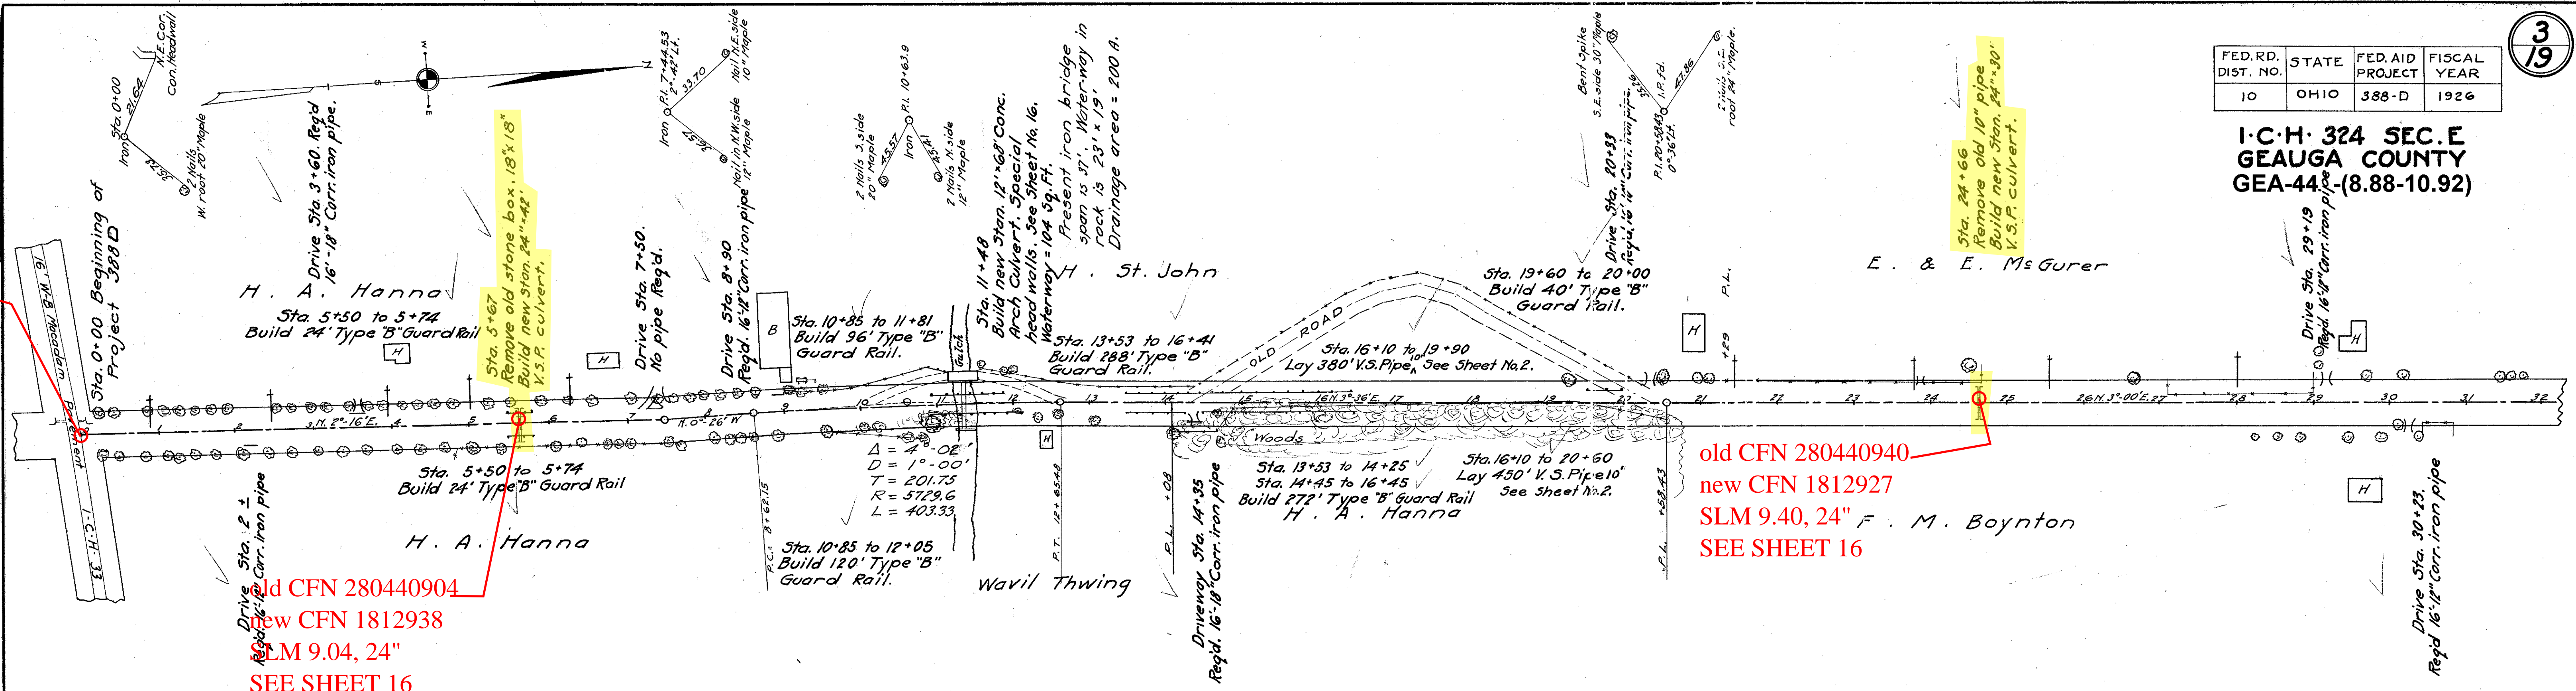

old CFN 28044094  
new CFN 1812938  
SLM 9.04, 24"  
SEE SHEET 16

old CFN 28044094  
new CFN 1812927  
SLM 9.40, 24"  
SEE SHEET 16

B.M. No. 1  
Roofing nail in E. foot  
15" Maple, 40' Lt. Sta. 5+74  
Elev. 1241.65

B.M. No. 2  
Roofing nail N.E. foot  
24" Maple 20' Lt. Sta. 6+25  
Elev. 1225.89

B.M. No. 3  
+ in N.E. Cor. N. Abut.  
Iron Bridge Sta. 11+70  
Elev. 1215.37

B.M. No. 4  
Roofing nail in E. foot  
24" Maple 32' Lt. Sta. 20+35  
Elev. 1265.30

B.M. No. 5  
Roofing nail in E. foot  
36" Elm 35' Lt. Sta. 24+45  
Elev. 1263.61

Grade line shown is crown  
of finished pavement

