


FED. RD. DIST. NO.	STATE	FED. AID PROJECT	FISCAL YEAR
10	OHIO	388 E	1927

1-C-H-324 SEC. F.
GEAUGA COUNTY

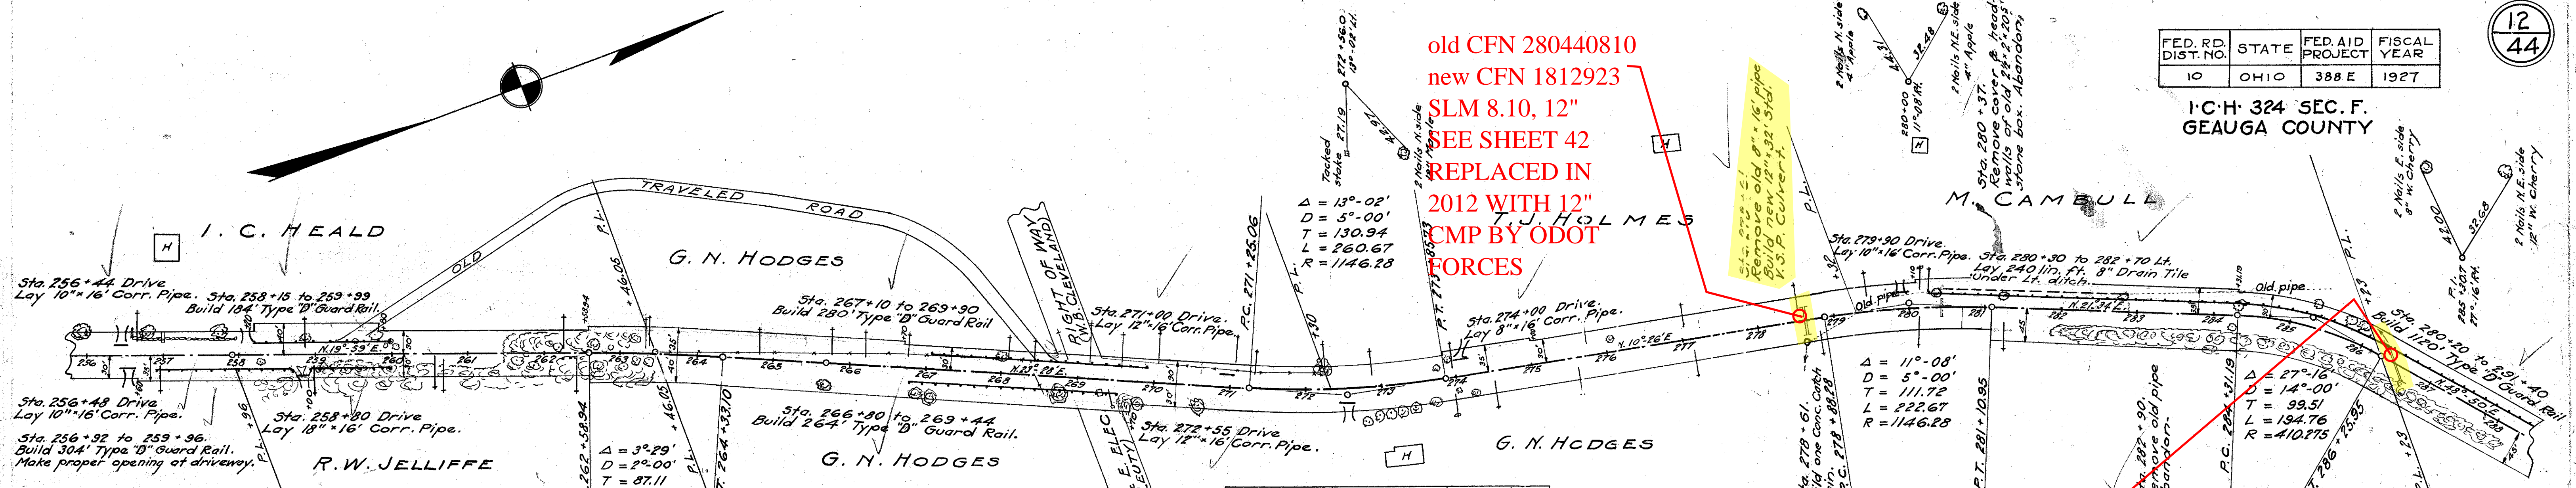

old CFN 280440810
new CFN 1812923
SLM 8.10, 12"
SEE SHEET 42
REPLACED IN
2012 WITH 12"
CMP BY ODOT
FORCES

Sta. 256+44 Drive
Lay 10" x 16" Corr. Pipe. Sta. 258+15 to 259+99
Build 184' Type 'D' Guard Rail.

Sta. 256+48 Drive
Lay 10" x 16" Corr. Pipe.

Sta. 256+92 to 259+96
Build 304' Type 'D' Guard Rail.
Make proper opening at driveway.

Sta. 258+80 Drive
Lay 18" x 16" Corr. Pipe.

Sta. 266+80 to 269+44
Build 264' Type 'D' Guard Rail.

Sta. 271+00 Drive
Lay 12" x 16" Corr. Pipe.

Sta. 274+00 Drive
Lay 8" x 16" Corr. Pipe.

Sta. 277+90 Drive
Lay 10" x 16" Corr. Pipe.

Sta. 280+30 to 282+70 Lt.
Lay 240 lin. ft. 8" Drain Tile
Under Lt. ditch.

Sta. 280+20 to 289+40
Build 110' Type 'D' Guard Rail.

Left Edge of Pav.	Width	Station	Grade Elev.	Right Edge of Pav.
1171.89	9.00	270+24.4	1172.04	9.00 1171.89
1171.57	9.38	271+00.0	1171.72	9.00 1171.79
1171.24	10.08	25.06	1171.39	9.00 1171.69
1170.52	10.73	25.06	1171.07	9.00 1171.58
1170.27	11.00	272+00	1170.42	9.00 1171.17
1169.95	11.00	+25	1170.10	9.00 1170.85
1169.62	11.00	+50	1169.77	9.00 1170.52
1169.30	11.00	+75	1169.45	9.00 1170.20
1168.97	11.00	273+00	1169.12	9.00 1169.87
1168.60	11.00	+25	1168.75	9.00 1169.51
1168.42	11.00	+37.5	1168.57	9.00 1169.32
1167.91	10.73	+62.5	1168.06	9.00 1168.57
1167.33	10.08	+87.5	1167.48	9.00 1167.78
1166.95	9.66	274+00	1167.10	9.00 1167.27
1166.64	9.38	+112.5	1166.79	9.00 1166.86
1165.87	9.00	+137.5	1166.02	9.00 1165.87

Extra Pavement 58.3 Sq. Yds.

Left Edge of Pav.	Width	Station	Grade Elev.	Right Edge of Pav.
1155.07	9.00	278+31.8	1155.72	9.00 1155.07
1154.37	9.00	+62.5	1155.24	9.38 1155.07
1153.63	9.00	+87.5	1154.73	10.28 1154.16
1152.81	9.00	279+00	1154.20	10.83 1153.36
1152.03	9.00	+112.5	1153.57	10.73 1152.56
1151.52	9.00	+137.5	1152.77	11.00 1152.62
1151.07	9.00	+150	1152.92	11.00 1152.77
1150.00	9.00	+175	1152.62	11.00 1152.17
1149.37	9.00	280+00	1152.62	11.00 1152.17
1148.72	9.00	+25	1152.97	11.00 1151.82
1148.07	9.00	+50	1153.32	11.00 1151.17
1147.22	9.00	+75	1153.47	11.00 1151.32
1146.42	9.00	+100	1153.82	10.73 1151.65
1145.42	9.00	281+00	1153.02	10.40 1151.87
1144.67	9.00	+125	1153.17	10.08 1152.02
1143.59	9.00	+150	1153.37	9.38 1152.57
1142.72	9.00	+175	1153.87	9.00 1153.72

Extra Pavement 49.9 Sq. Yds.

Left Edge of Pav.	Width	Station	Grade Elev.	Right Edge of Pav.
1160.90	9.00	283+11.9	1161.05	9.00 1160.90
1161.37	9.00	284+00	1161.72	9.57 1161.07
1161.53	9.00	+25	1161.78	10.05 1161.33
1162.14	9.00	+50	1161.80	12.03 1161.35
1162.77	9.00	+75	1161.73	13.80 1161.58
1163.38	9.00	+100	1161.95	14.60 1161.80
1163.55	9.00	285+00	1162.12	14.60 1161.97
1163.78	9.00	+25	1162.35	14.60 1162.20
1164.00	9.00	+50	1162.57	14.60 1162.42
1164.23	9.00	+75	1162.80	14.60 1162.65
1164.07	9.00	286+00	1163.02	13.85 1162.88
1164.07	9.00	+100	1163.03	13.80 1162.88
1163.89	9.00	+125	1163.03	13.80 1162.88
1163.73	9.00	+150	1163.48	10.05 1163.33
1163.55	9.00	+175	1163.70	9.00 1163.35

Extra Pavement 120.3 Sq. Yds.

EQUATION
Sta. 258 + 00.00 ahead =
Sta. 257 + 71.1 back
Deduct 28.9 lin. ft. from
total length of project.

B.M. Sta. 258+85
Roofing nail in 15"
Cucumber 35' Rt.
Elev. 1166.36

B.M. Sta. 270+65
Roofing nail in W. roof
30" W Cherry 27' Rt.
Elev. 1173.49

B.M. Sta. 285+35
Roofing nail in S.E. roof
14" W Cherry 30' Lt.
Elev. 1158.96

