


FED. RD. DIST. NO.	STATE	FED. AID PROJECT	FISCAL YEAR
10	OHIO	388 E	1927

13
44

old CFN 280440886
new CFN 1852373
SLM 8.85, 15"
SEE SHEET 43
CB INSTALLED AT INLET
AND OUTLET EXTENDED IN
1974 GEA-44-8.79

I.C.H. 324 SEC. F
GEAUGA COUNTY

SR 87
SLM 8.88

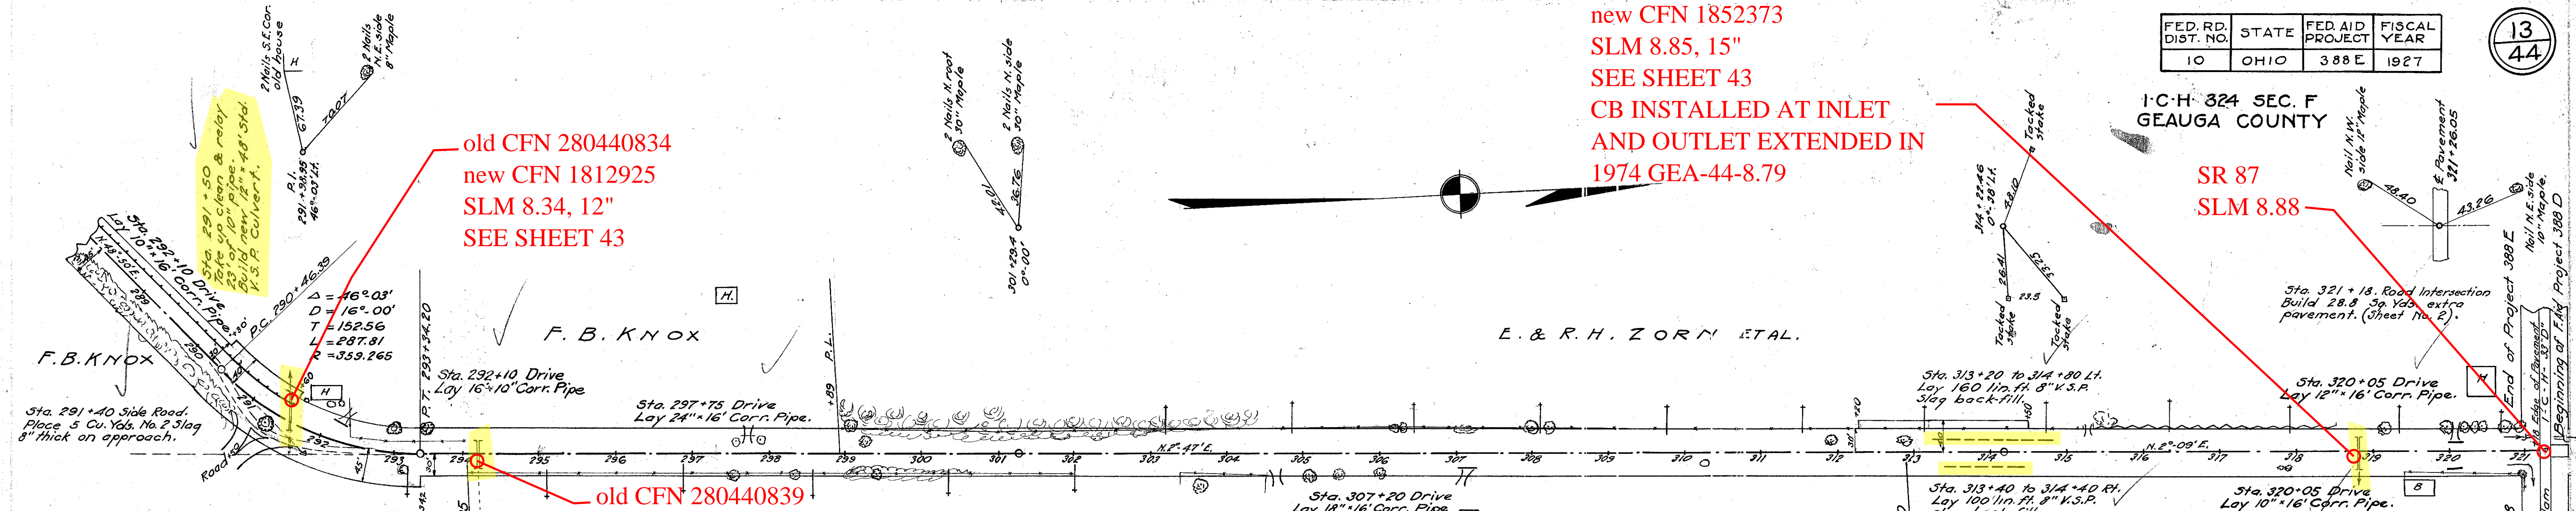

WM FACEY

Left Edge of Pav.	Width	Station	Grade Elev.	Right Edge of Pav.
1166.44	9.00	289+96.9	1166.59	9.00
1166.47	9.04	290+00	1166.52	9.00
1166.66	10.20	291+00	1166.81	9.00
1166.89	12.47	292+00	1167.04	9.00
1166.92	12.25	293+00	1167.07	9.00
1167.11	14.48	294+00	1167.26	9.00
1167.34	15.40	295+00	1167.49	9.00
1167.37	15.40	296+00	1167.52	9.00
1167.59	15.40	297+00	1167.74	9.00
1167.82	15.40	298+00	1167.97	9.00
1168.04	15.40	299+00	1168.19	9.00
1168.27	15.40	300+00	1168.42	9.00
1168.49	15.40	301+00	1168.64	9.00
1168.72	15.40	302+00	1168.87	9.00
1169.03	15.40	303+00	1169.18	9.00
1169.17	14.33	304+00	1169.32	9.00
1169.55	14.43	305+00	1169.40	9.00
1169.83	12.47	306+00	1169.53	9.00
1169.70	10.20	307+00	1169.55	9.00
1169.93	9.00	308+00	1170.03	9.00

Extra Pavement 2011 Sq. Yds.


EQUATION
Sta. 293+38.89 ahead =
Sta. 293+34.2 back =
Deduct 479 lin. ft. from
total length of project.

old CFN 280440839
new CFN 1812926
SLM 8.39, 3'x3'
CONCRETE BOX
SEE SHEET 43

B.M. Sta. 299+08
Roofing nail in N.E. roof
10" Oak 30' Lt.
Elev. 1176.31

B.M. Sta. 308+00
Roofing nail in E. roof
14" Osage tree 25' Lt.
Elev. 1220.40

B.M. Sta. 320+95.
Spike in E. roof
18" Maple 30' Lt.
Elev. 1241.54.

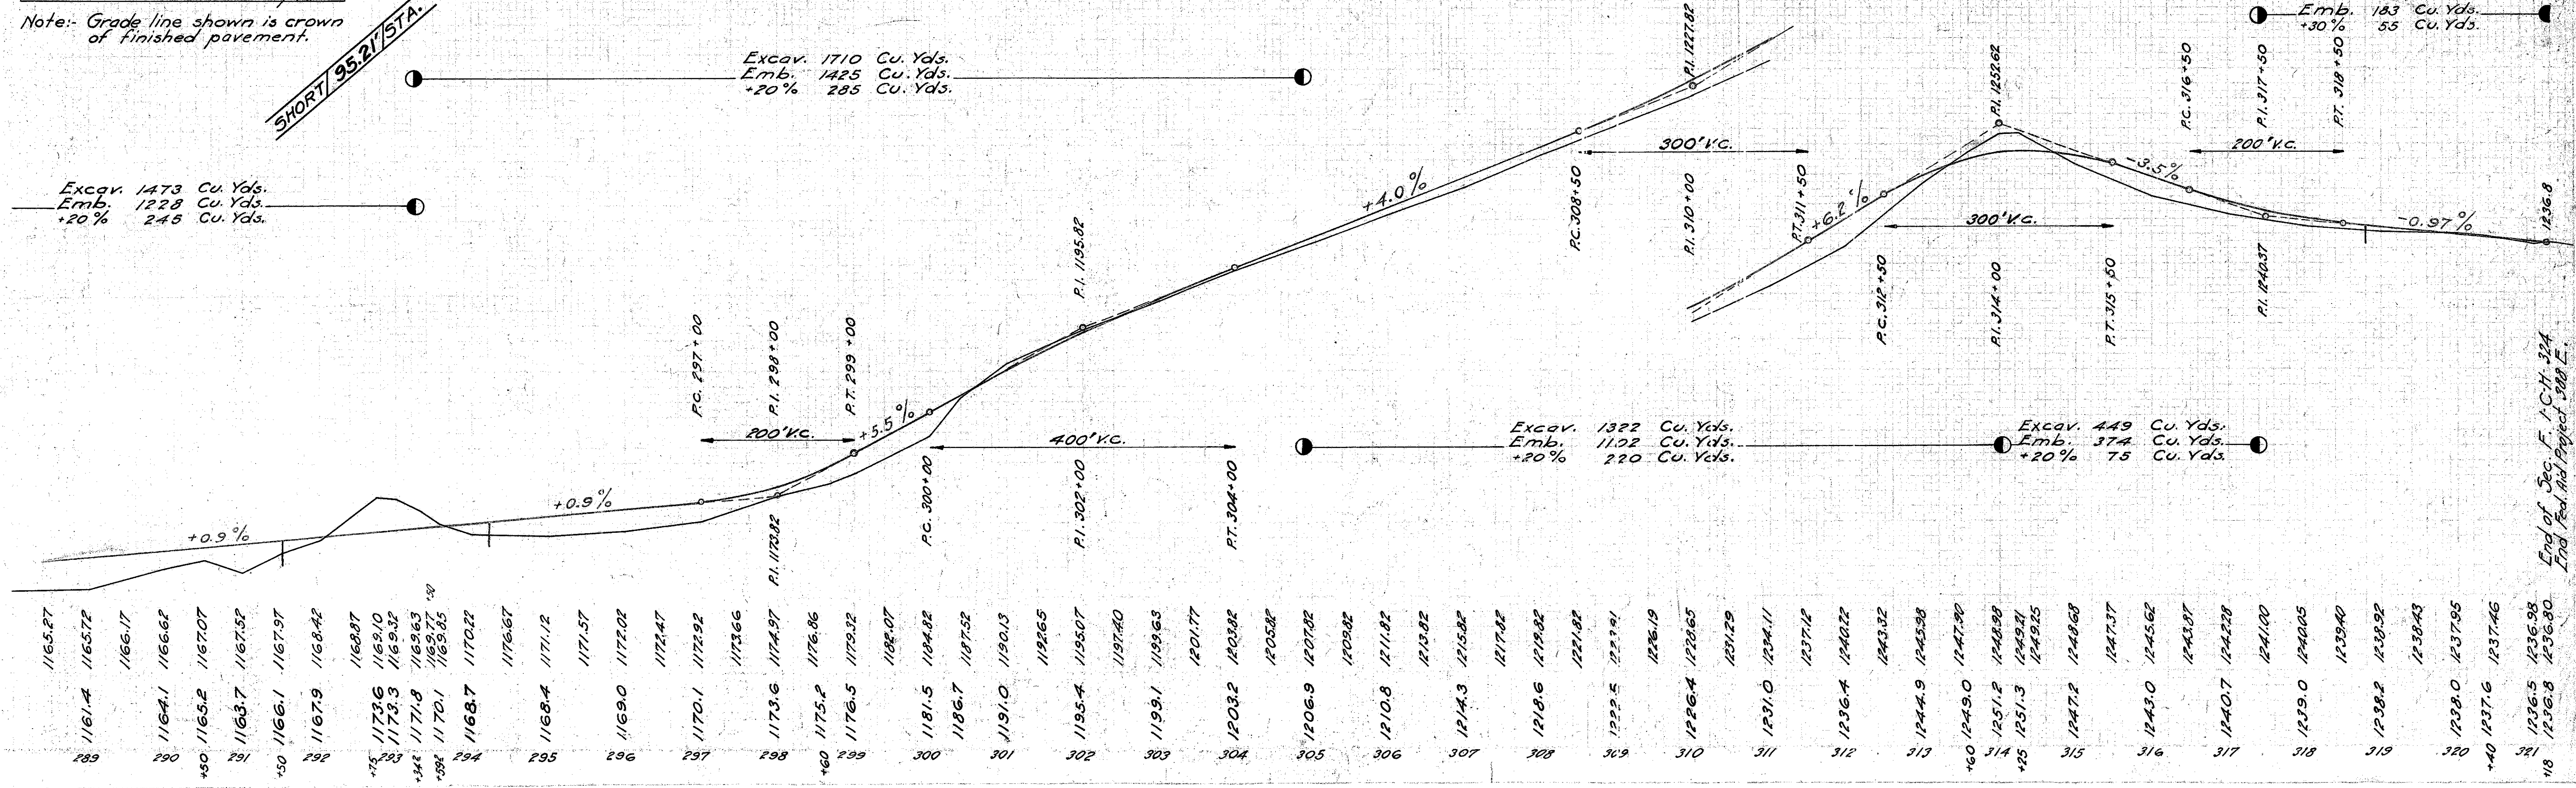

End of Sec. F I.C.H. 324
End Fed. Aid Project 388 E.