


FED. AID DIST.	STATE	FED. AID PROJECT	FISCAL YEAR	3 5
10	OHIO	388E	1927	

**I.C.H. 324 SEC. F.
GEAUGA COUNTY**

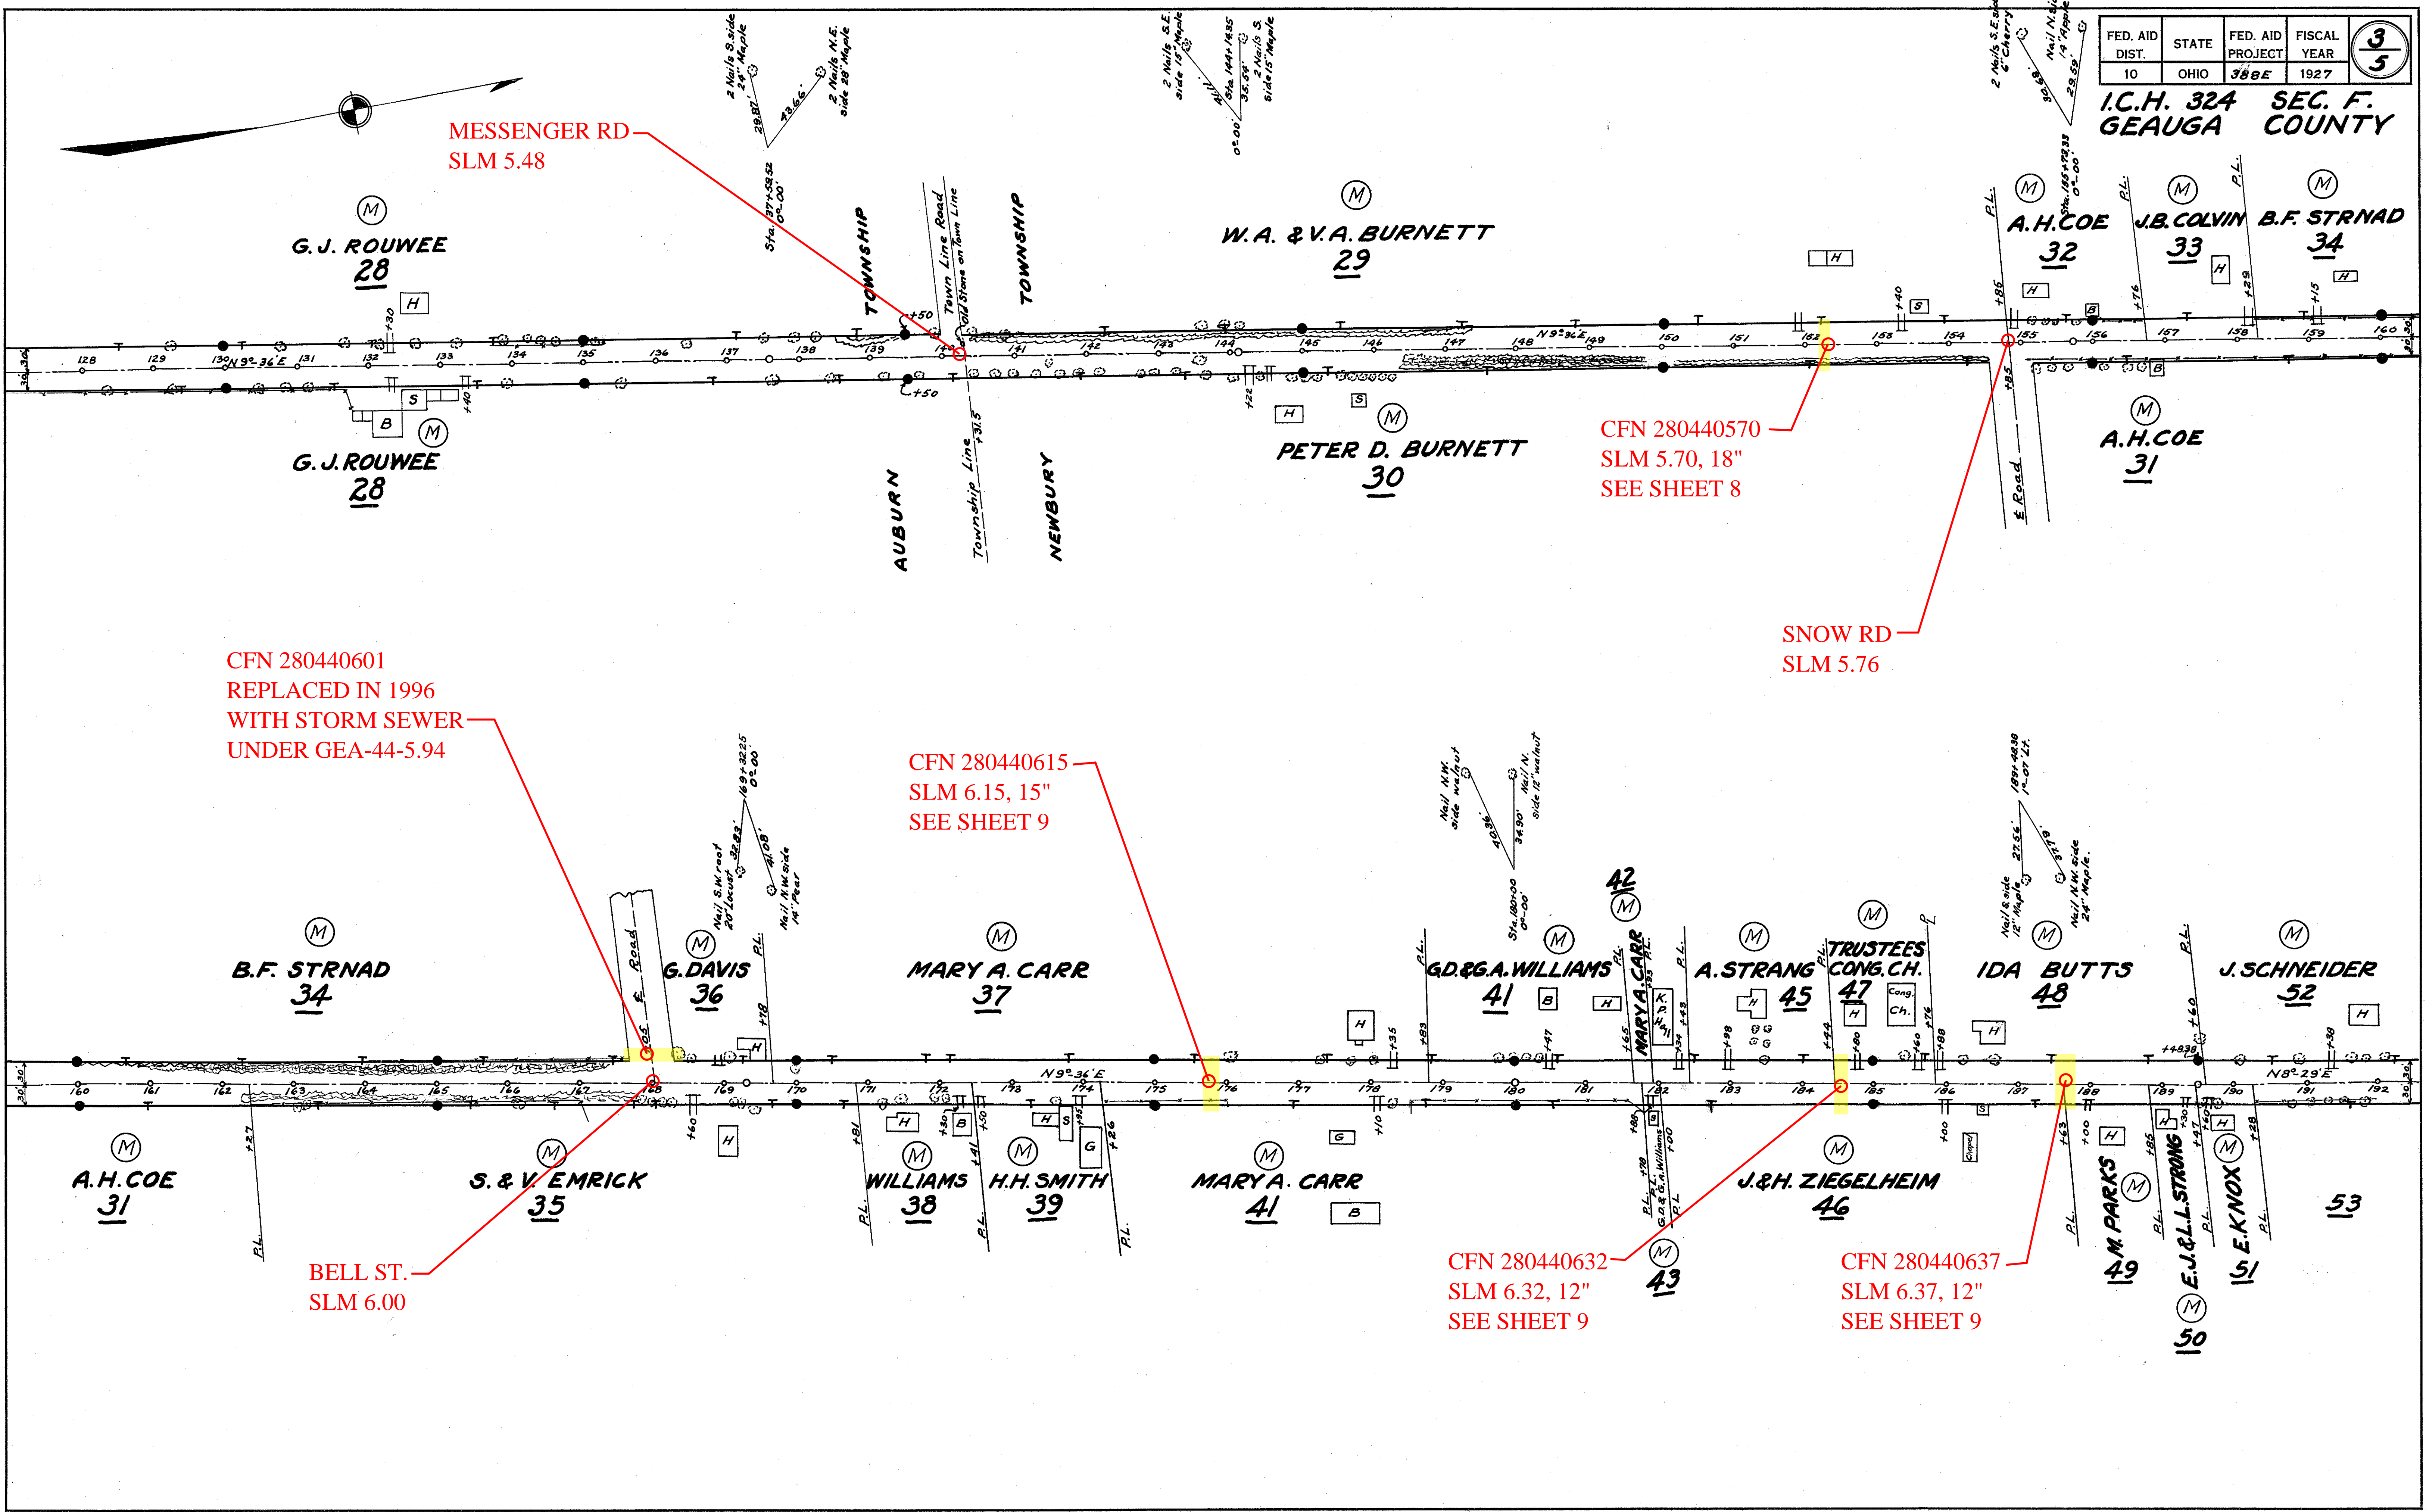

MESSENGER RD
SLM 5.48

CFN 280440570
SLM 5.70, 18"
SEE SHEET 8

SNOW RD
SLM 5.76

CFN 280440601
REPLACED IN 1996
WITH STORM SEWER
UNDER GEA-44-5.94

CFN 280440615
SLM 6.15, 15"
SEE SHEET 9

BELL ST.
SLM 6.00

CFN 280440632
SLM 6.32, 12"
SEE SHEET 9

CFN 280440637
SLM 6.37, 12"
SEE SHEET 9