


FED. AID DIST.	STATE	FED. AID PROJECT	FISCAL YEAR	5/5
10	OHIO	388E	1927	

I.C.H. 324 SEC. F. GAUGA COUNTY

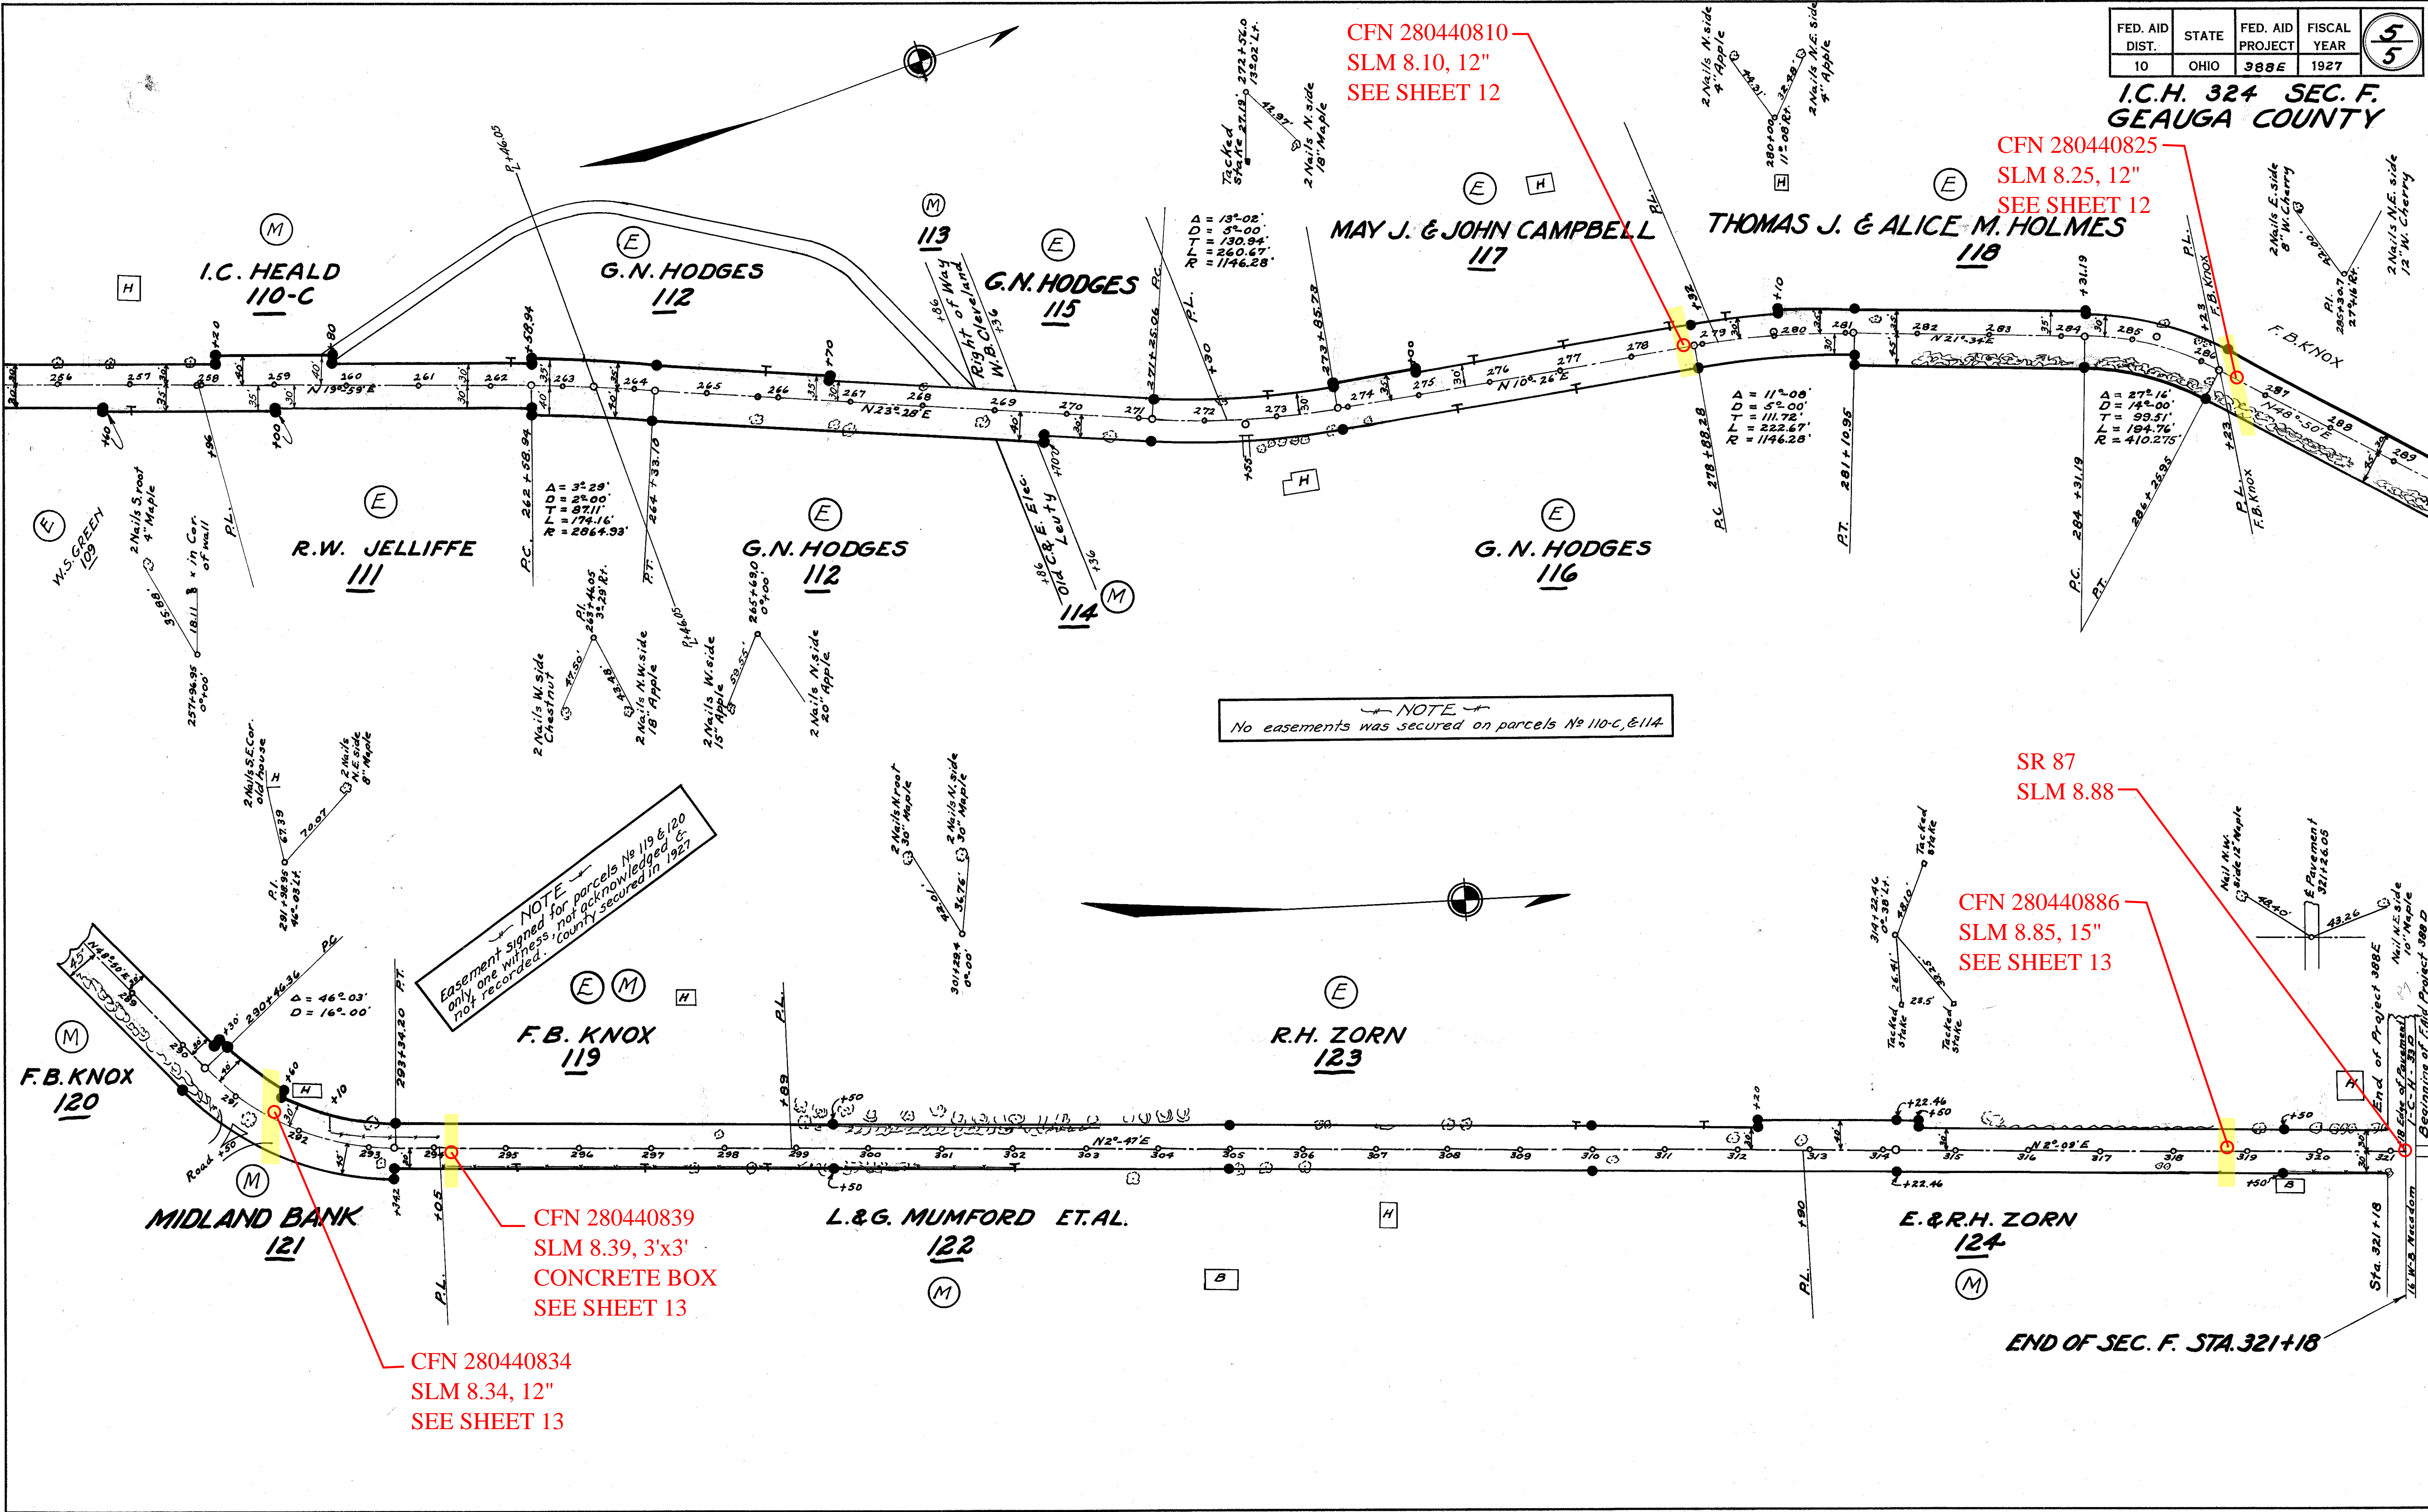

CFN 280440810
SLM 8.10, 12"
SEE SHEET 12

CFN 280440825
SLM 8.25, 12"
SEE SHEET 12

NOTE
No easements was secured on parcels No 110-C, & 114.

NOTE
Easement signed for parcels No 119 & 120 only one witness not acknowledged & not recorded in 1927

SR 87
SLM 8.88

CFN 280440886
SLM 8.85, 15"
SEE SHEET 13

CFN 280440839
SLM 8.39, 3'x3'
CONCRETE BOX
SEE SHEET 13

CFN 280440834
SLM 8.34, 12"
SEE SHEET 13

END OF SEC. F. STA. 321+18