
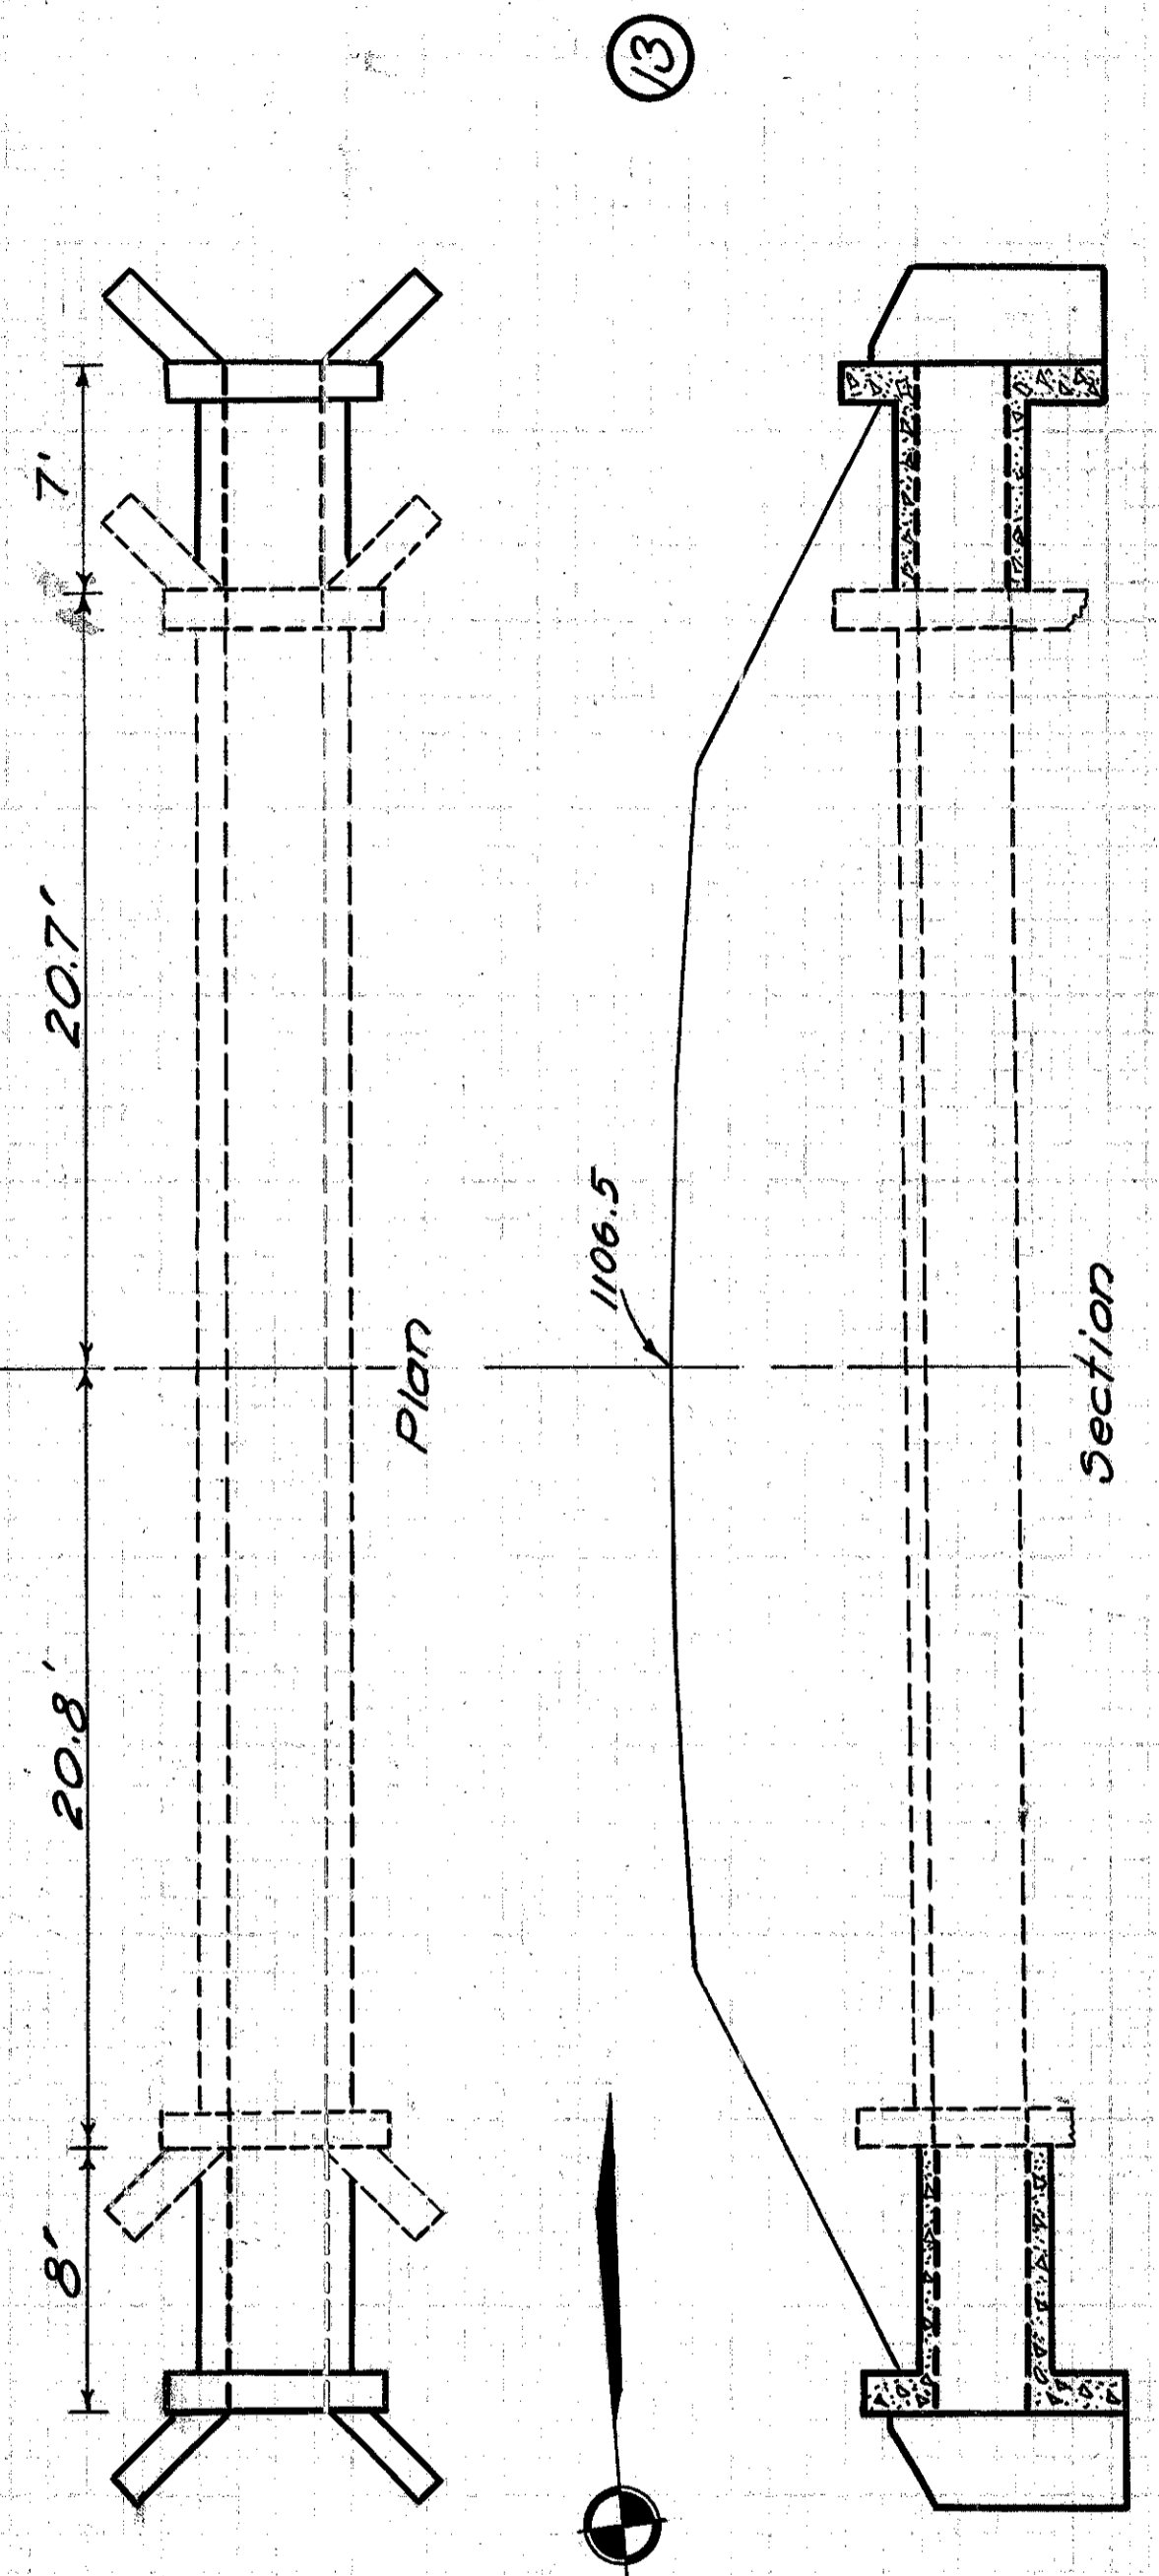
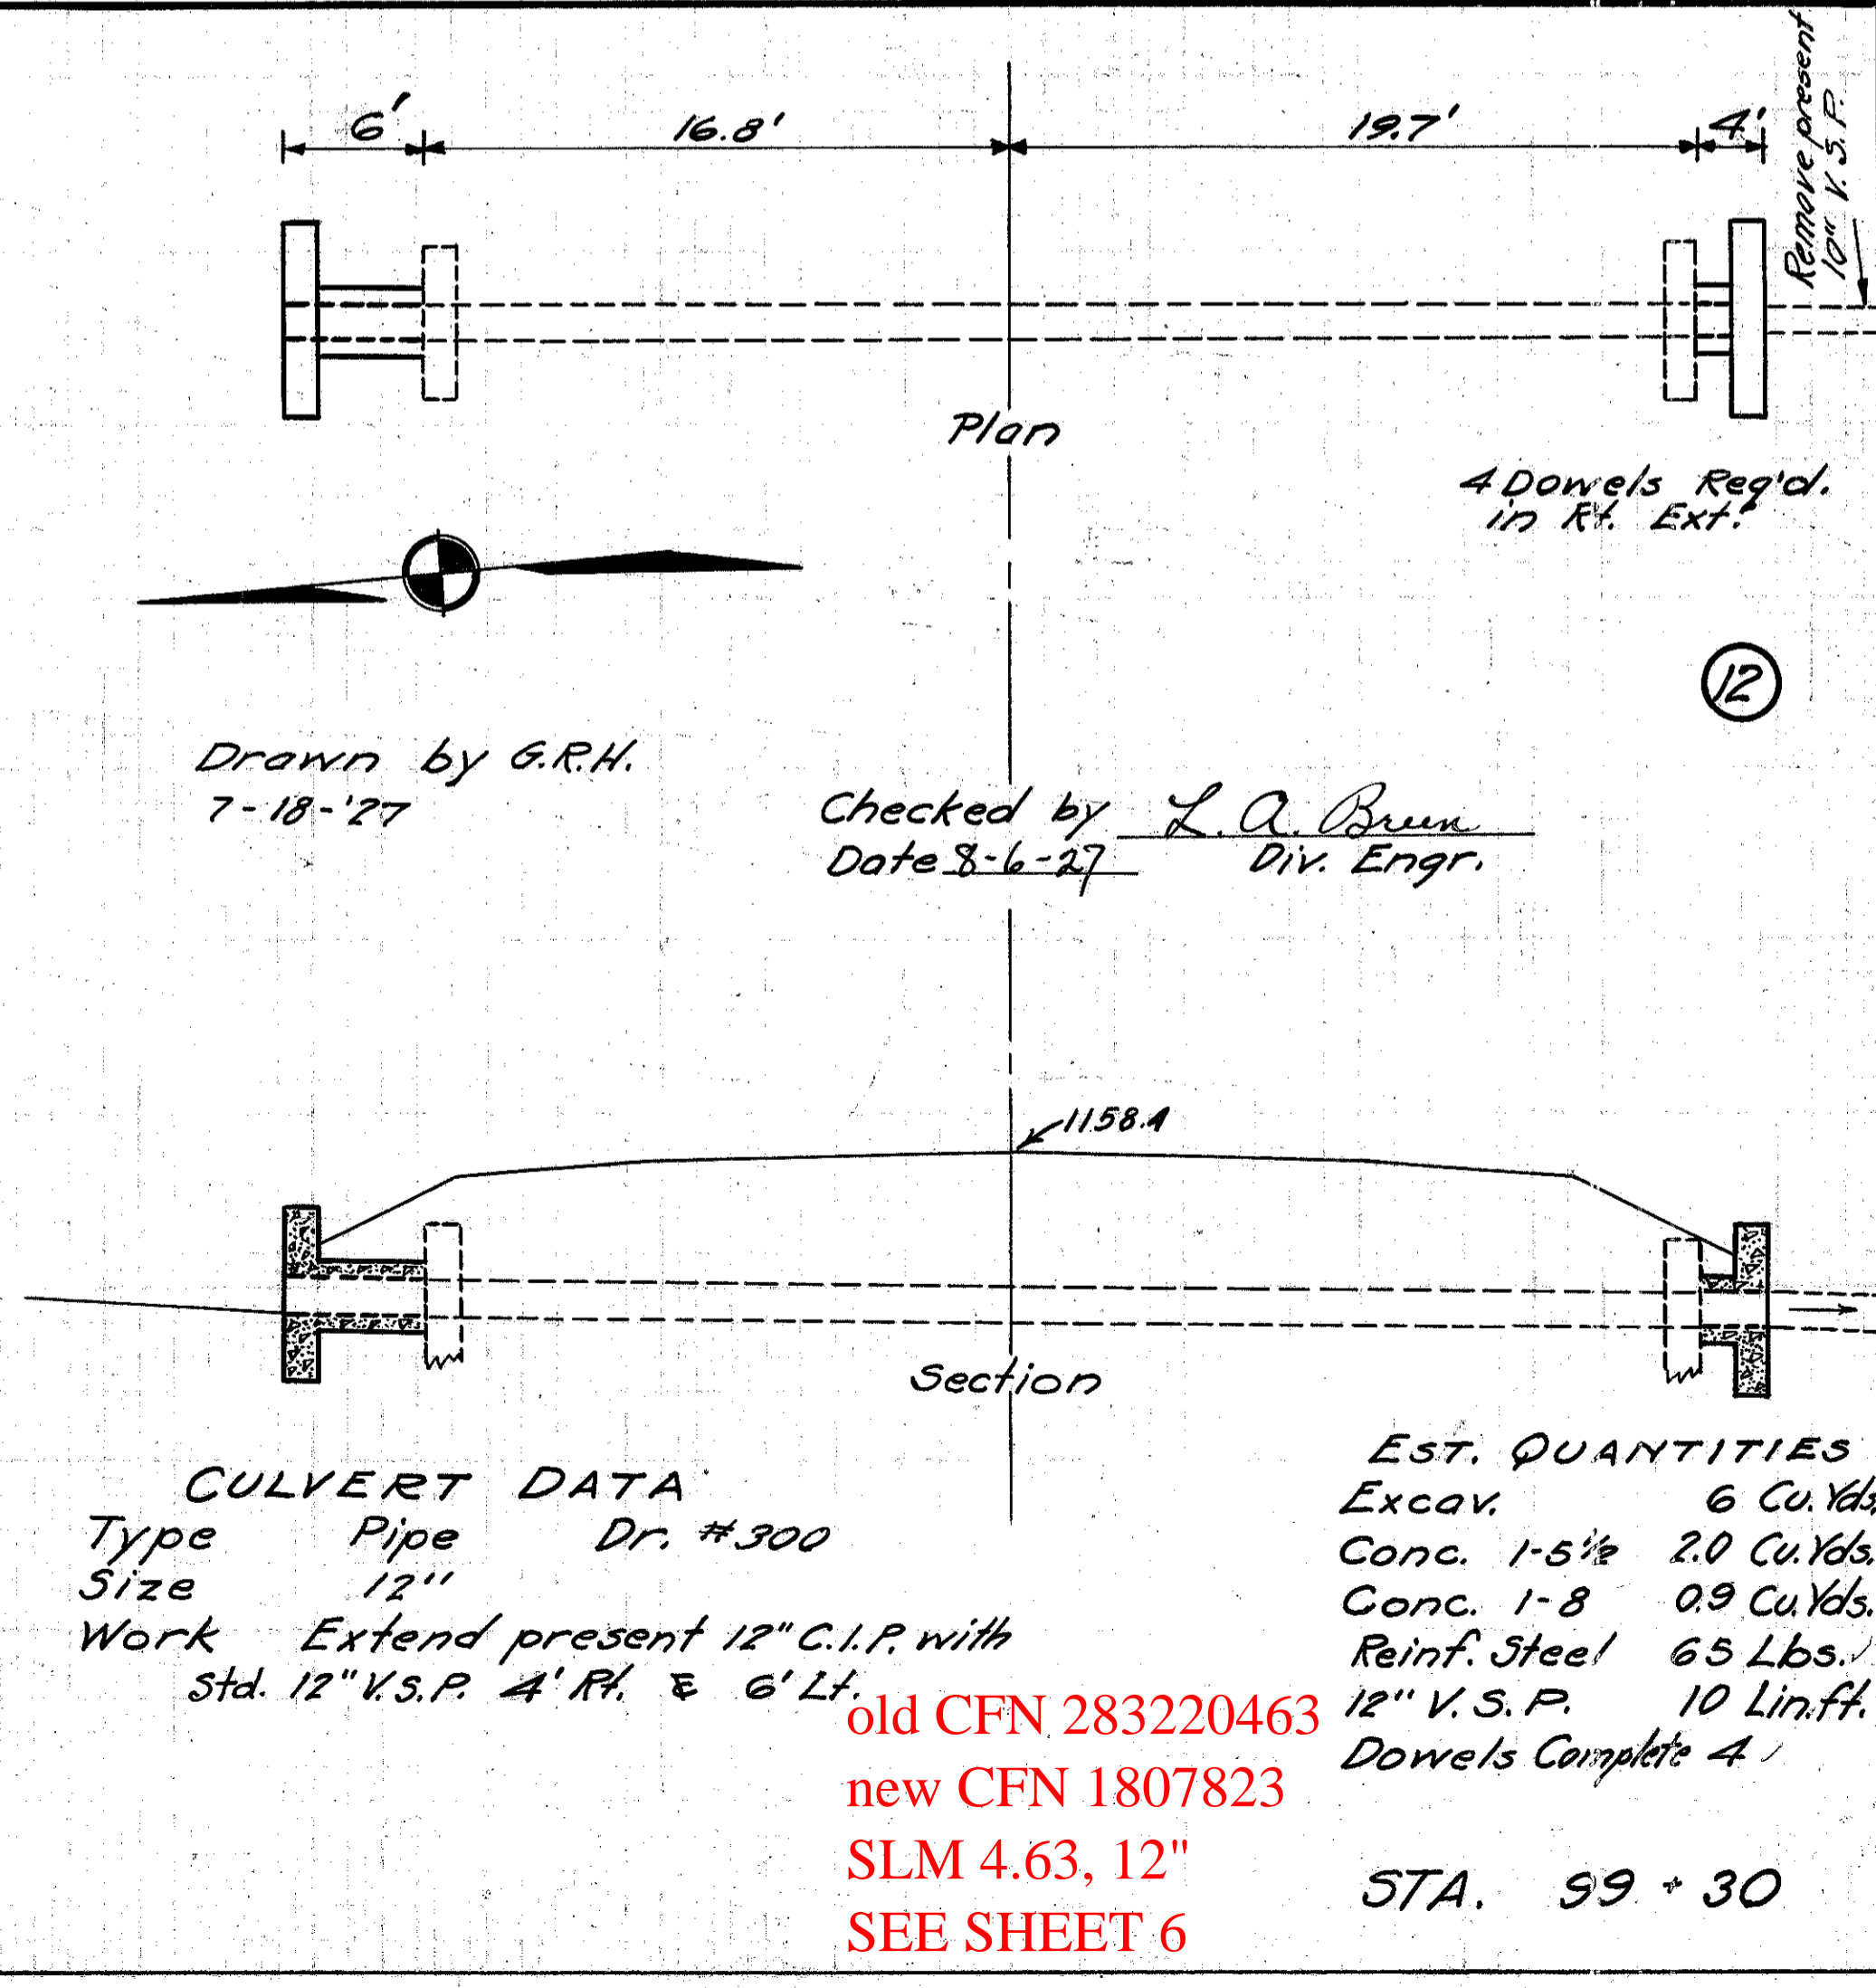
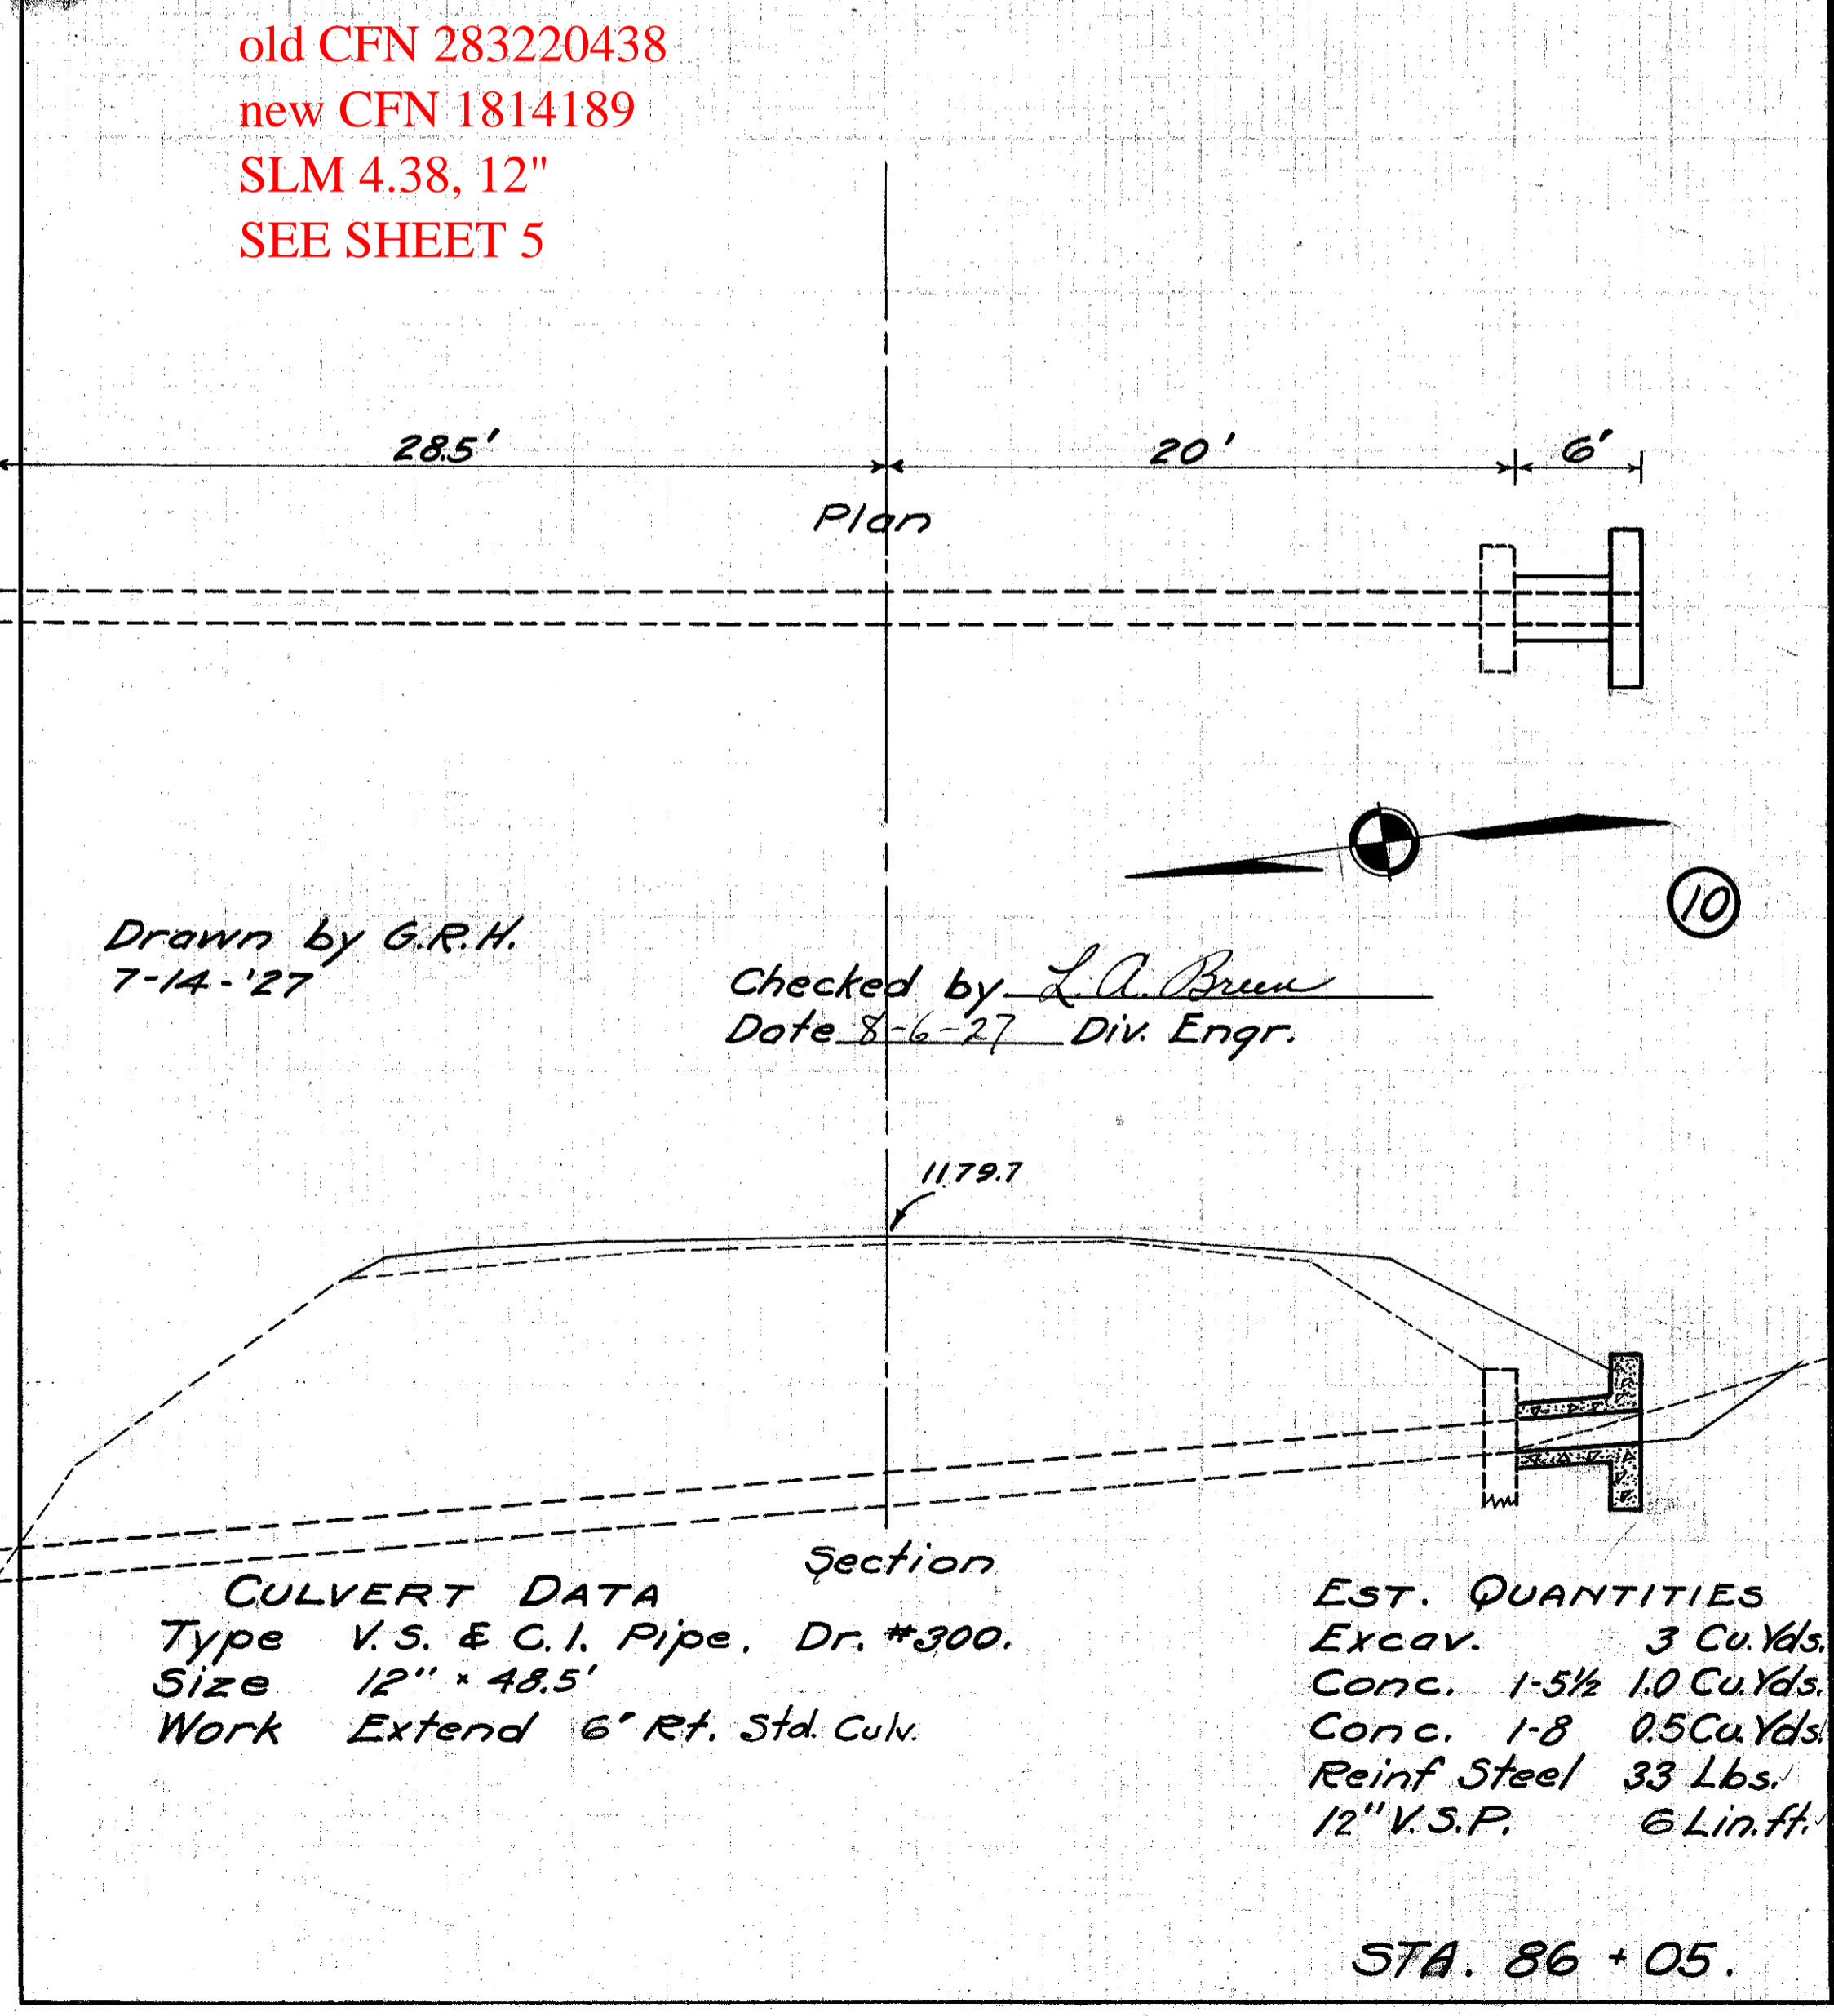
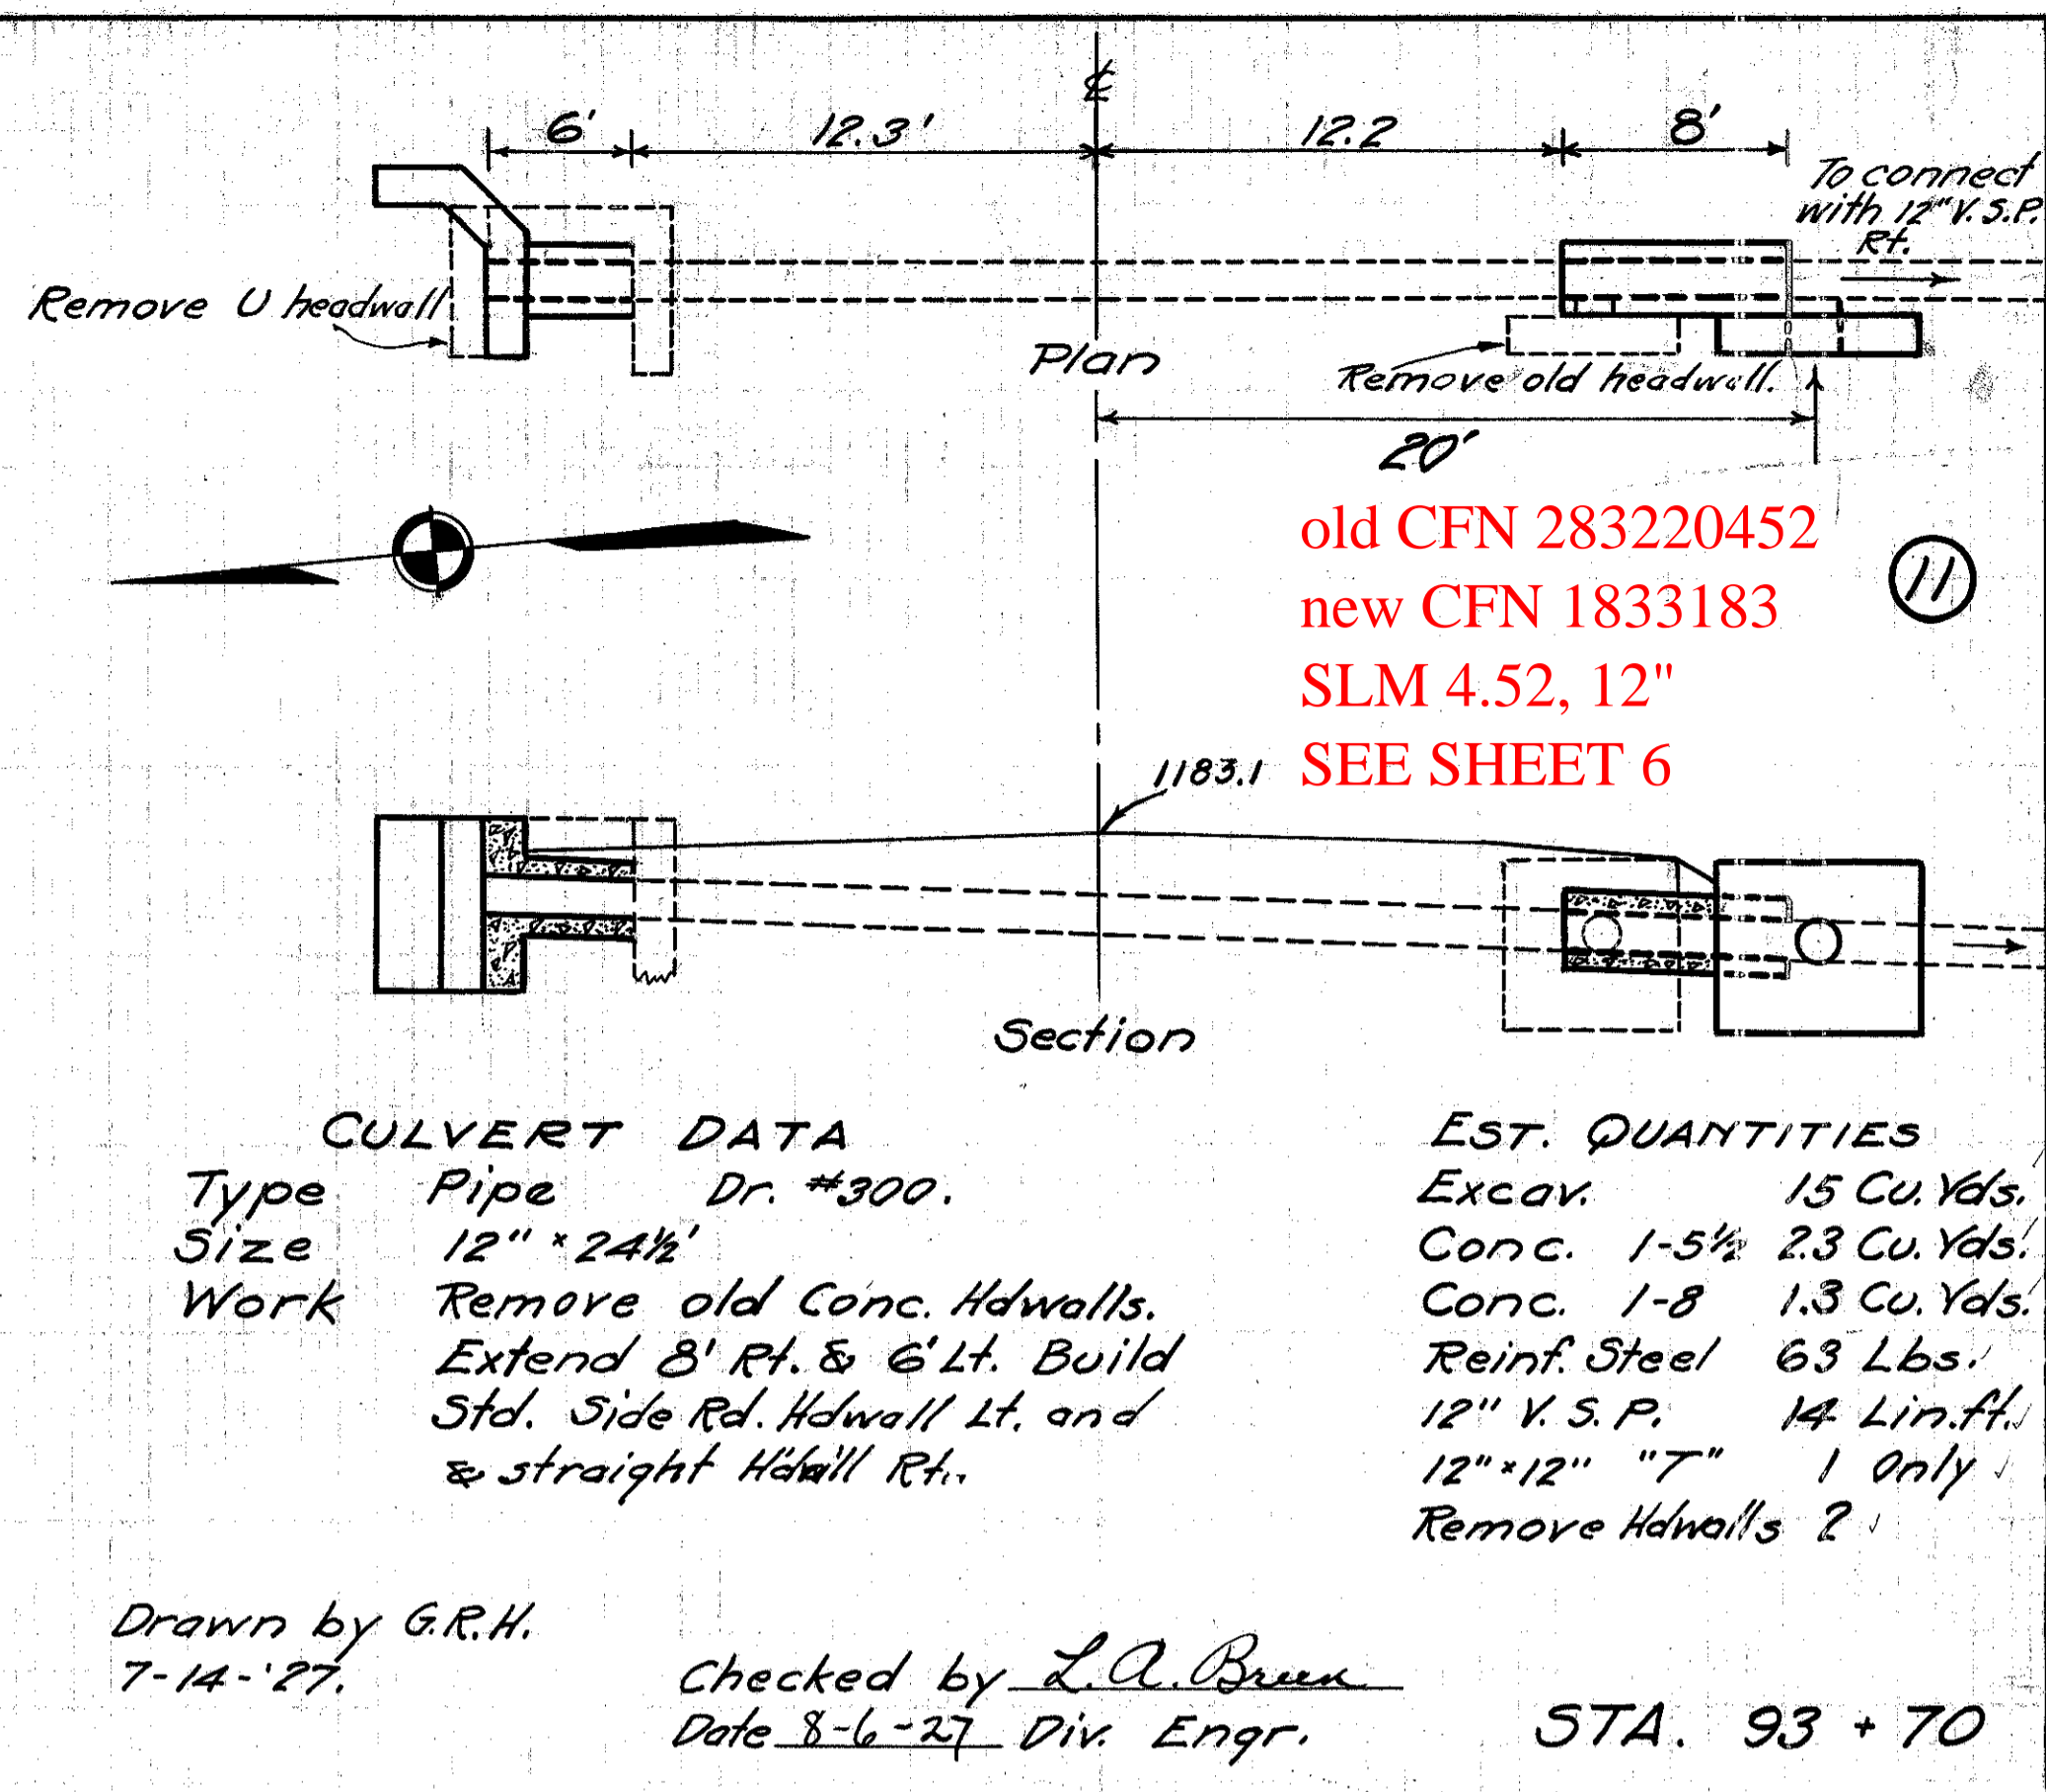


old CFN 283220480  
new CFN 1814191  
SLM 4.80, 2.5'x2.5'  
CONCRETE BOX  
SEE SHEET 6

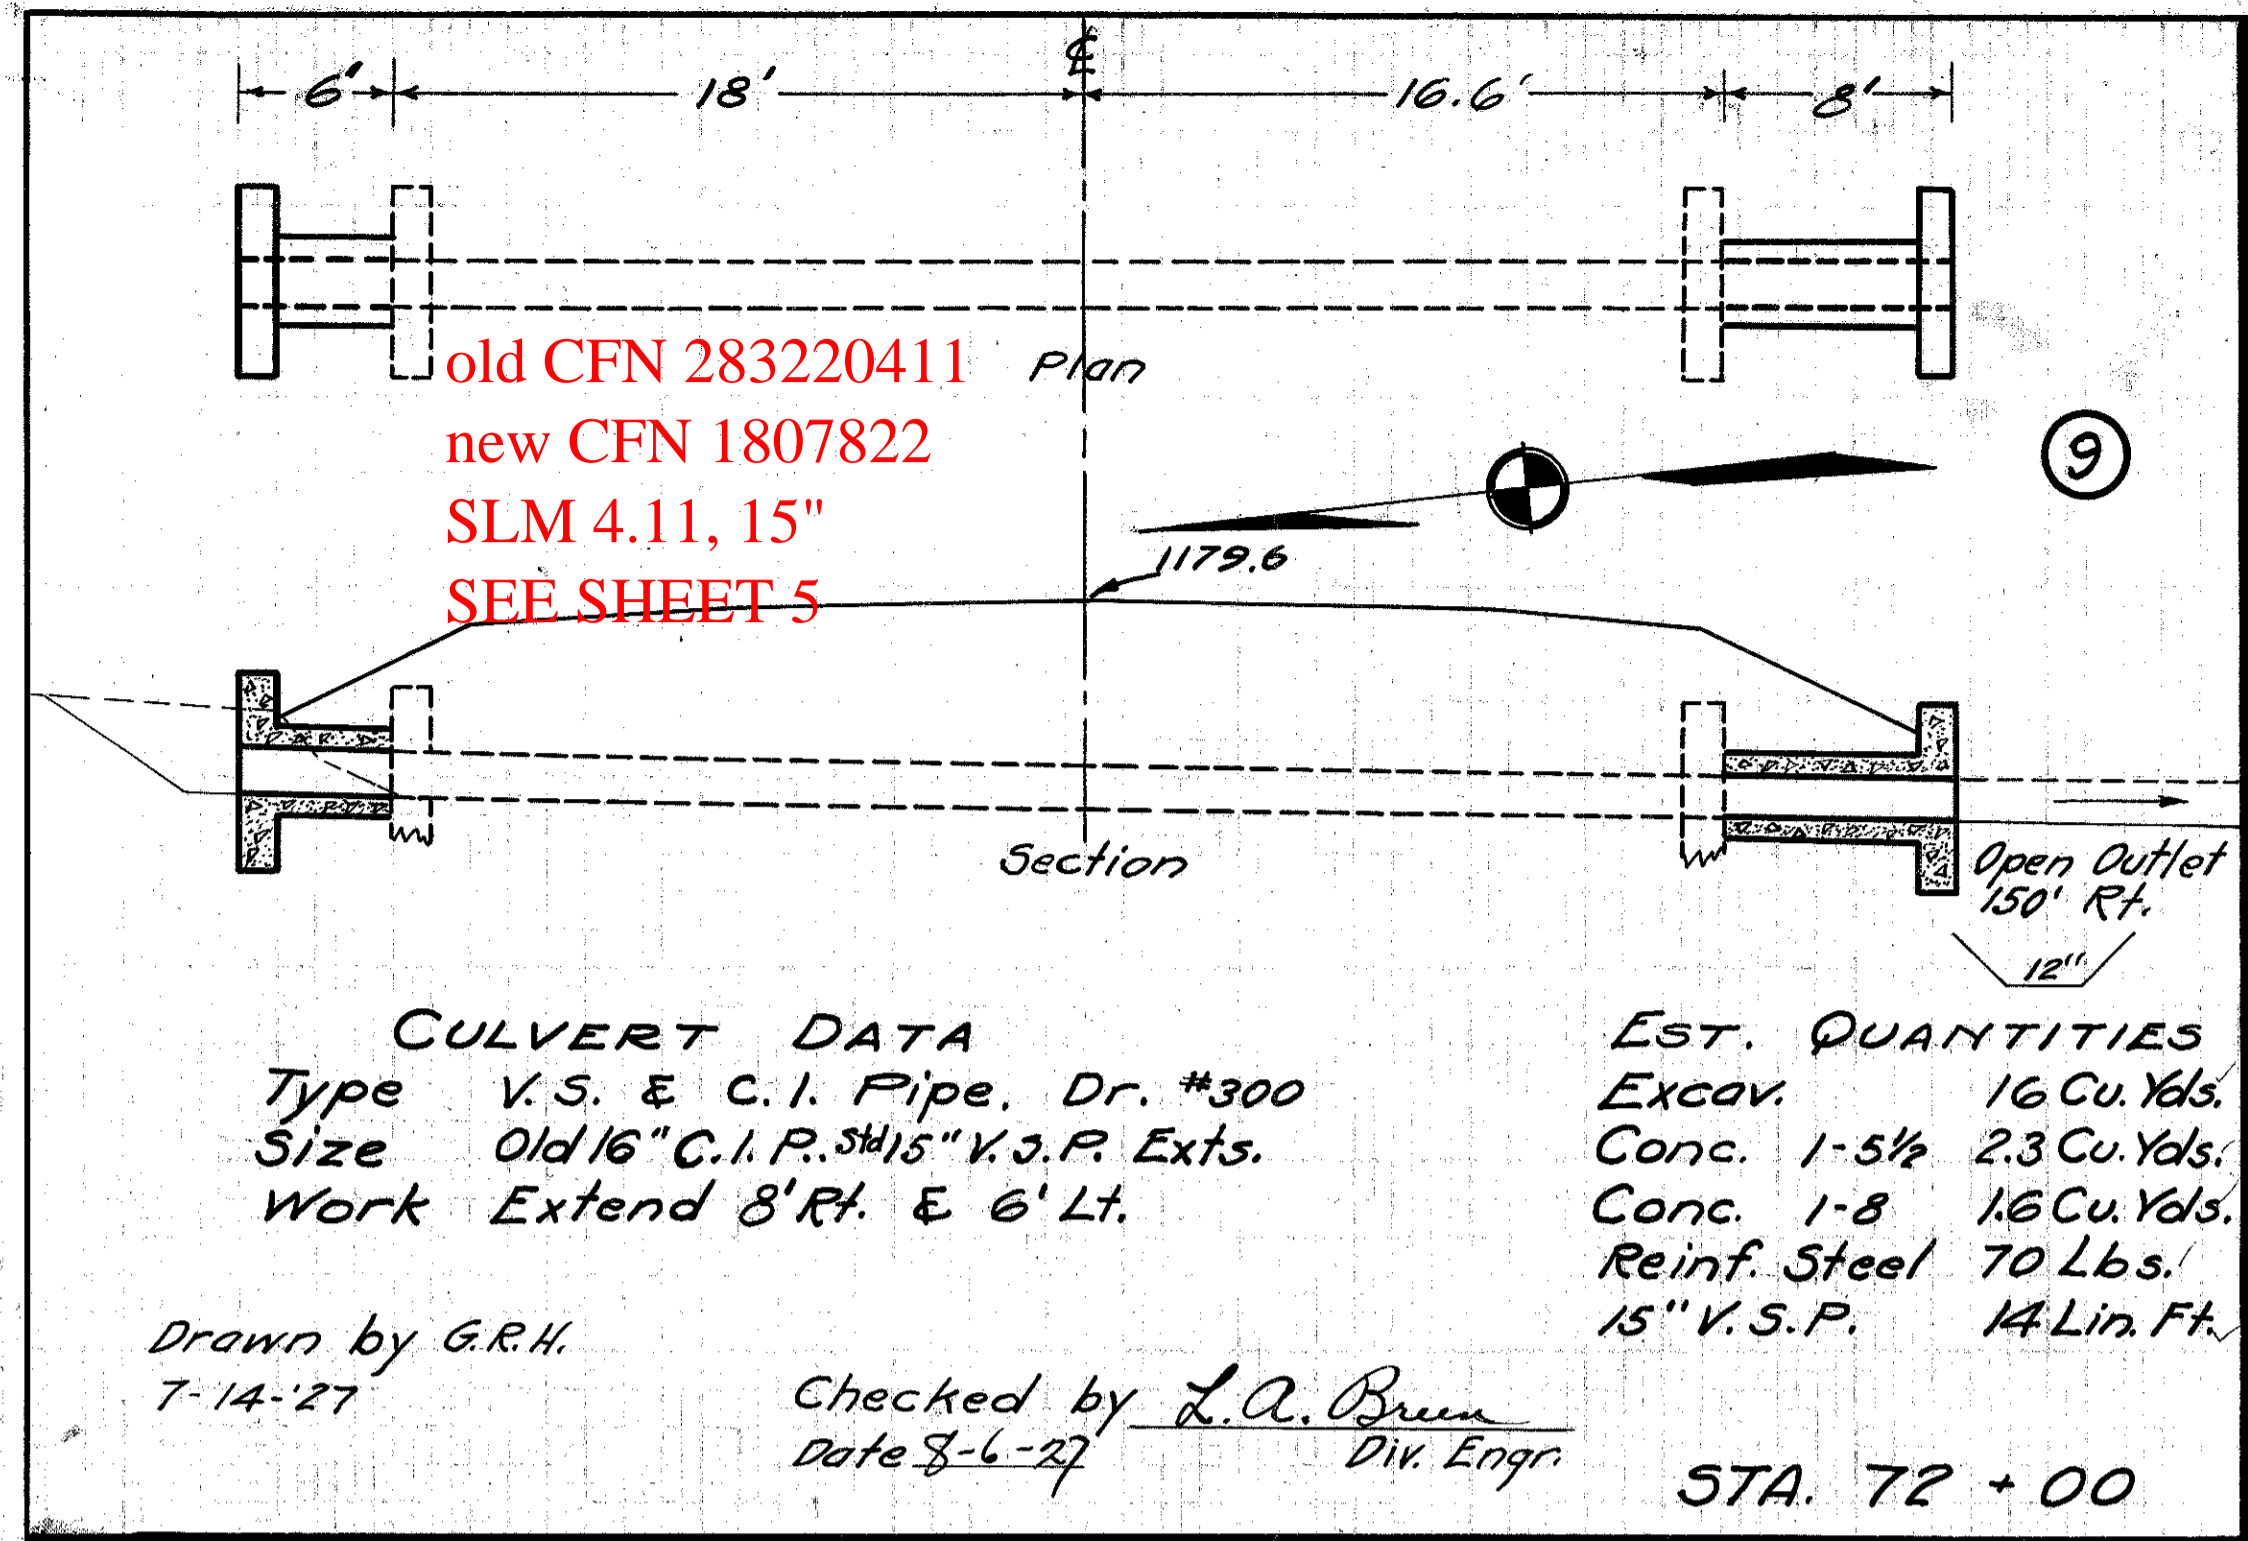

**EST. QUANTITIES**  
Excav. 15 Cu. Yds.  
Conc. 1-5 1/2 8.3 Cu. Yds.  
Reinf. Steel 301 Lbs.  
Dowels Complete 16

**CULVERT DATA**  
Type Conc. Box, Dr. #300.  
Size 2 1/2' x 2 1/2' x 41.5'  
Work Extend present 2 1/2' x 2 1/2' Conc. Box with 7' Rt. & 8' Lt. Std. Box.

STA. 108 + 18

Checked by L.A. Bruun  
Date 8-6-27 Div. Engr.

Drawn by G.R.H.  
7-20-27