


FED. RD. DIVISION	STATE	PROJECT	
2	OHIO		


116
478

CUYAHOGA COUNTY
CUY - 480 - 19.43

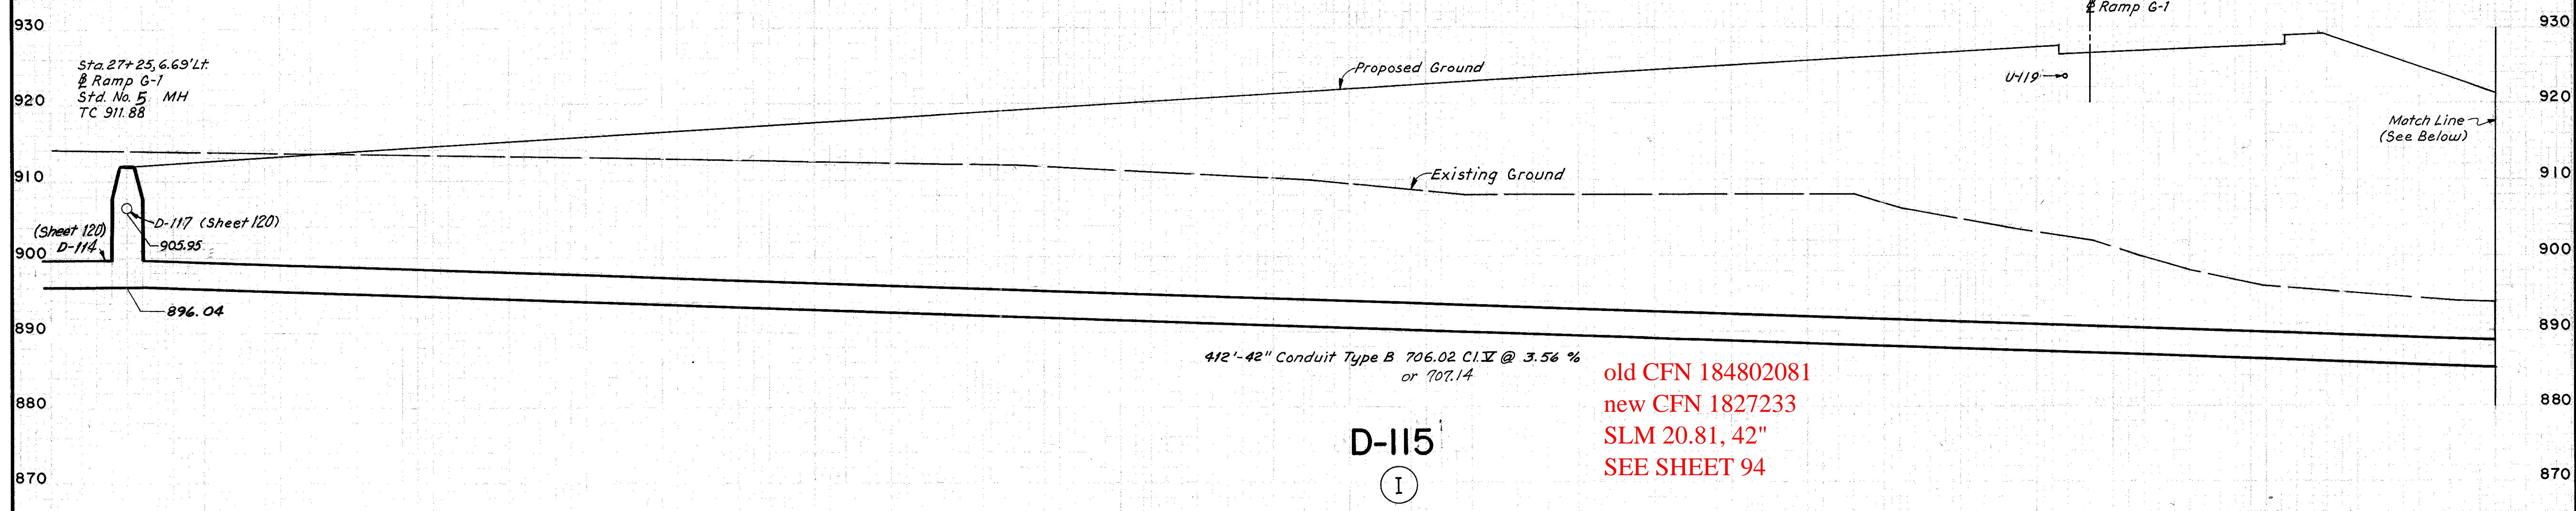

old CFN 184802081
new CFN 1827233
SLM 20.81, 42"
SEE SHEET 94

D-115
(I)

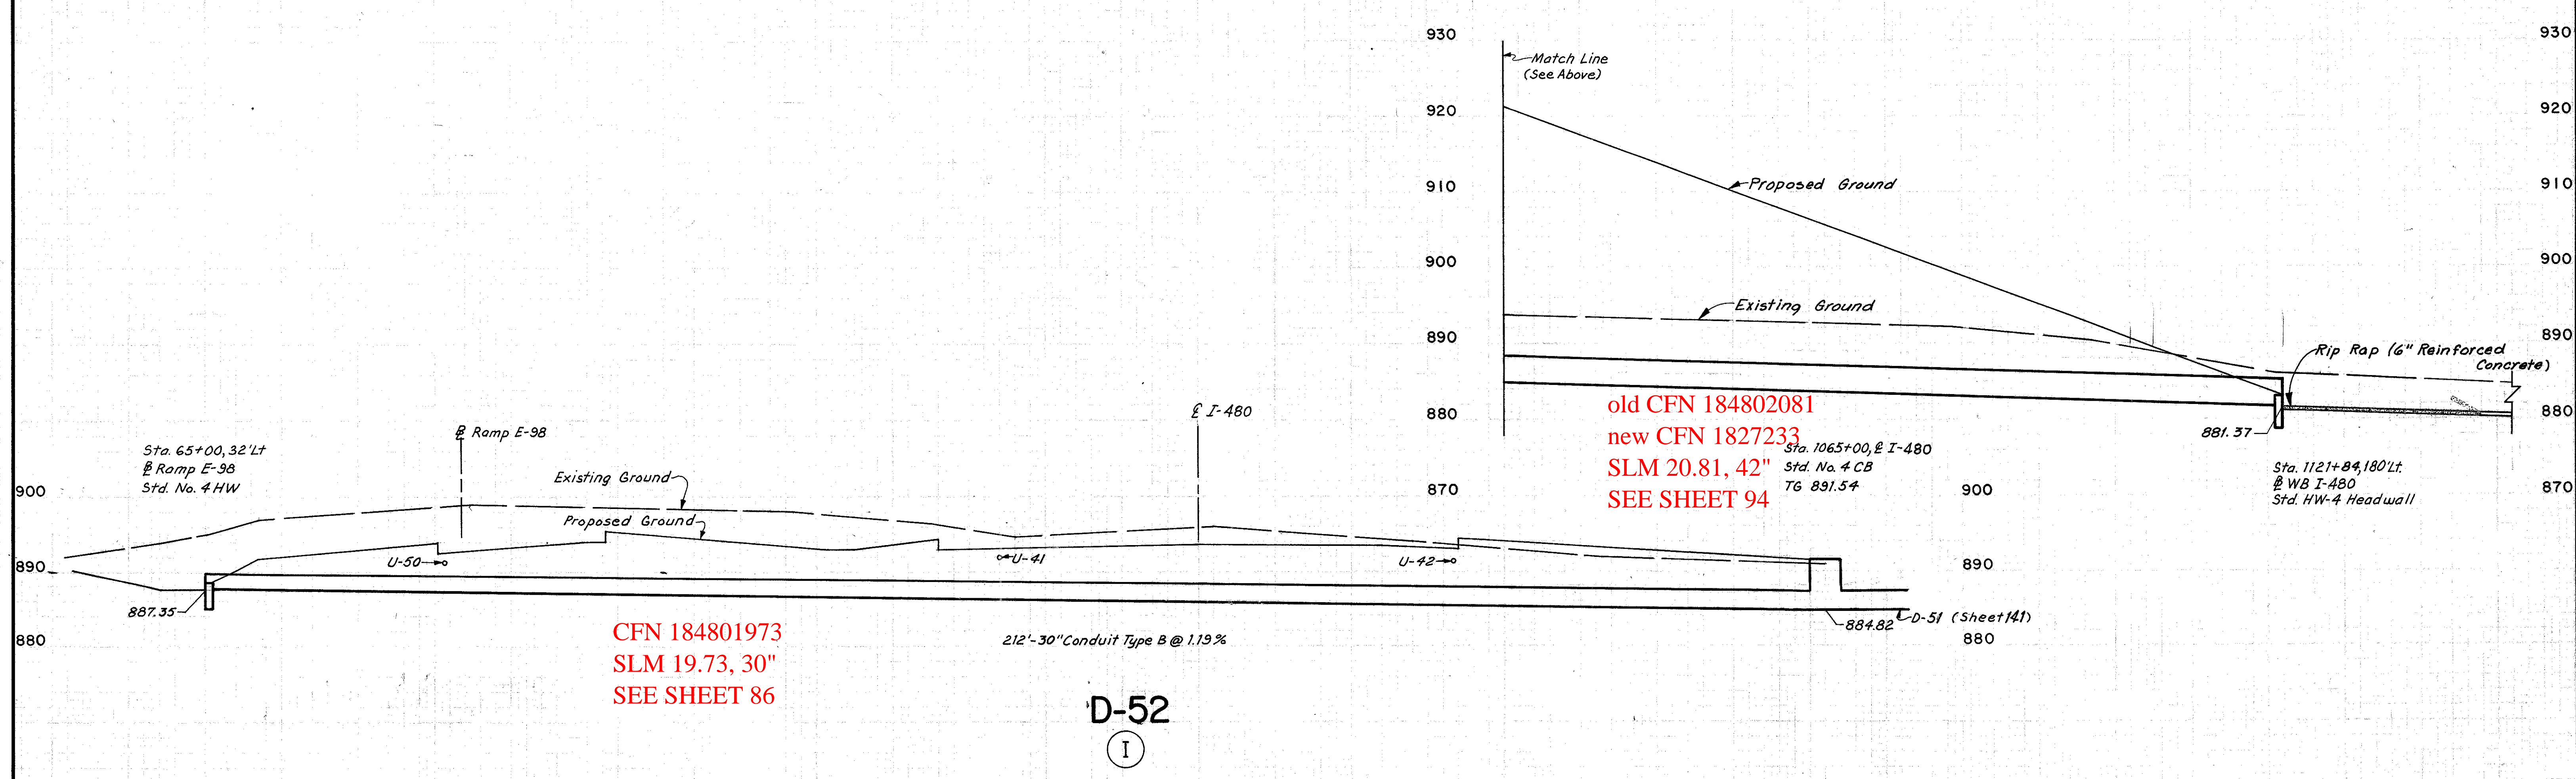

old CFN 184802081
new CFN 1827233
SLM 20.81, 42"
SEE SHEET 94

CFN 184801973
SLM 19.73, 30"
SEE SHEET 86

D-52
(I)

7-1-70
7-3-70
F.P.P.
R.A.E.
Checked