

CUYAHOGA COUNTY
CUY-480-8.26

TREE REMOVAL
470+00 to 480+00

SIZE	NR
	None

CROSS REFERENCE

Sht. No.	Item
17-18	Pavement Details
19	EXIT RAMP Detail
9	Curb & Inlet Detail

DRAINAGE	603	202	602	604	603	605	605	601	603				
ESTIMATED QUANTITIES	Type B	Type F	Pipe removed at 2' number	Masonry	I-3H Inlet	No. 2 A-6 Inlet	No. 6 L.B. Branches	Underdrain Strallow	Branches	Branches	Rock Chamber	Prot. Type B	
Ref. No. Side LOCATION	15" 6" 15"	15" 6" 15"	L.F. L.F. L.F.	L.F. C.Y.	Ca	Ea	Ea	Ea	L.F.	Ea	L.F.	Ea	C.Y.
1-D U&EP 474+17E to 474+17E	66	83	0.27	1					2				1.0
2-D Lt. 470+84	59	79	0.27					1	2				1.0
1-E Lt. 474+00		09	0.27						1				1.4
1-U Lt. 470+16 to 474+00	20												374
2-U Lt. 470+00 to 474+17	10												406
3-U Lt. 470+00 to 474+13	10												425
4-U Lt. 474+04 B5 to 476+00													196
5-U Lt. 474+29 to 476+00													171
6-U Lt. 474+21 to 476+00													179
7-U Lt. 470+00 to 471+84	10												74
1R Rt. 471+00 to 471+30				30									
Total To Gen. Summary	125	50	231	30	0.81	1	1	1	1,825				3.4

See X-Sections for Pipe Profile *With Bedding

ROADWAY		606	
ESTIMATED QUANTITIES		Guard Rail Type 5	Bridge Terminal Assembly, type A
Ref. No. Side	Location	L.F.	Ea.
1-G Lt.	Struct. B-5 to 476+00	584	1
2-G Rt.	470+00 to 476+00	600	
Total to Gen. Summary		1184	1


CFN 1974214
SLM 8.42, 15"
SEE SHEET 30

SLM 8.48, 15"
SEE SHEET 31

IR-71 OVERPASS
SLM 8.54 = MM 10.71

CFN 1974222
SLM 8.48, 15"
SEE SHEET 31

B.M. Sta 469+90 ± 730' R.H.
N.W. Cor. Mon. Box S.R. 17
Elev. 785.98

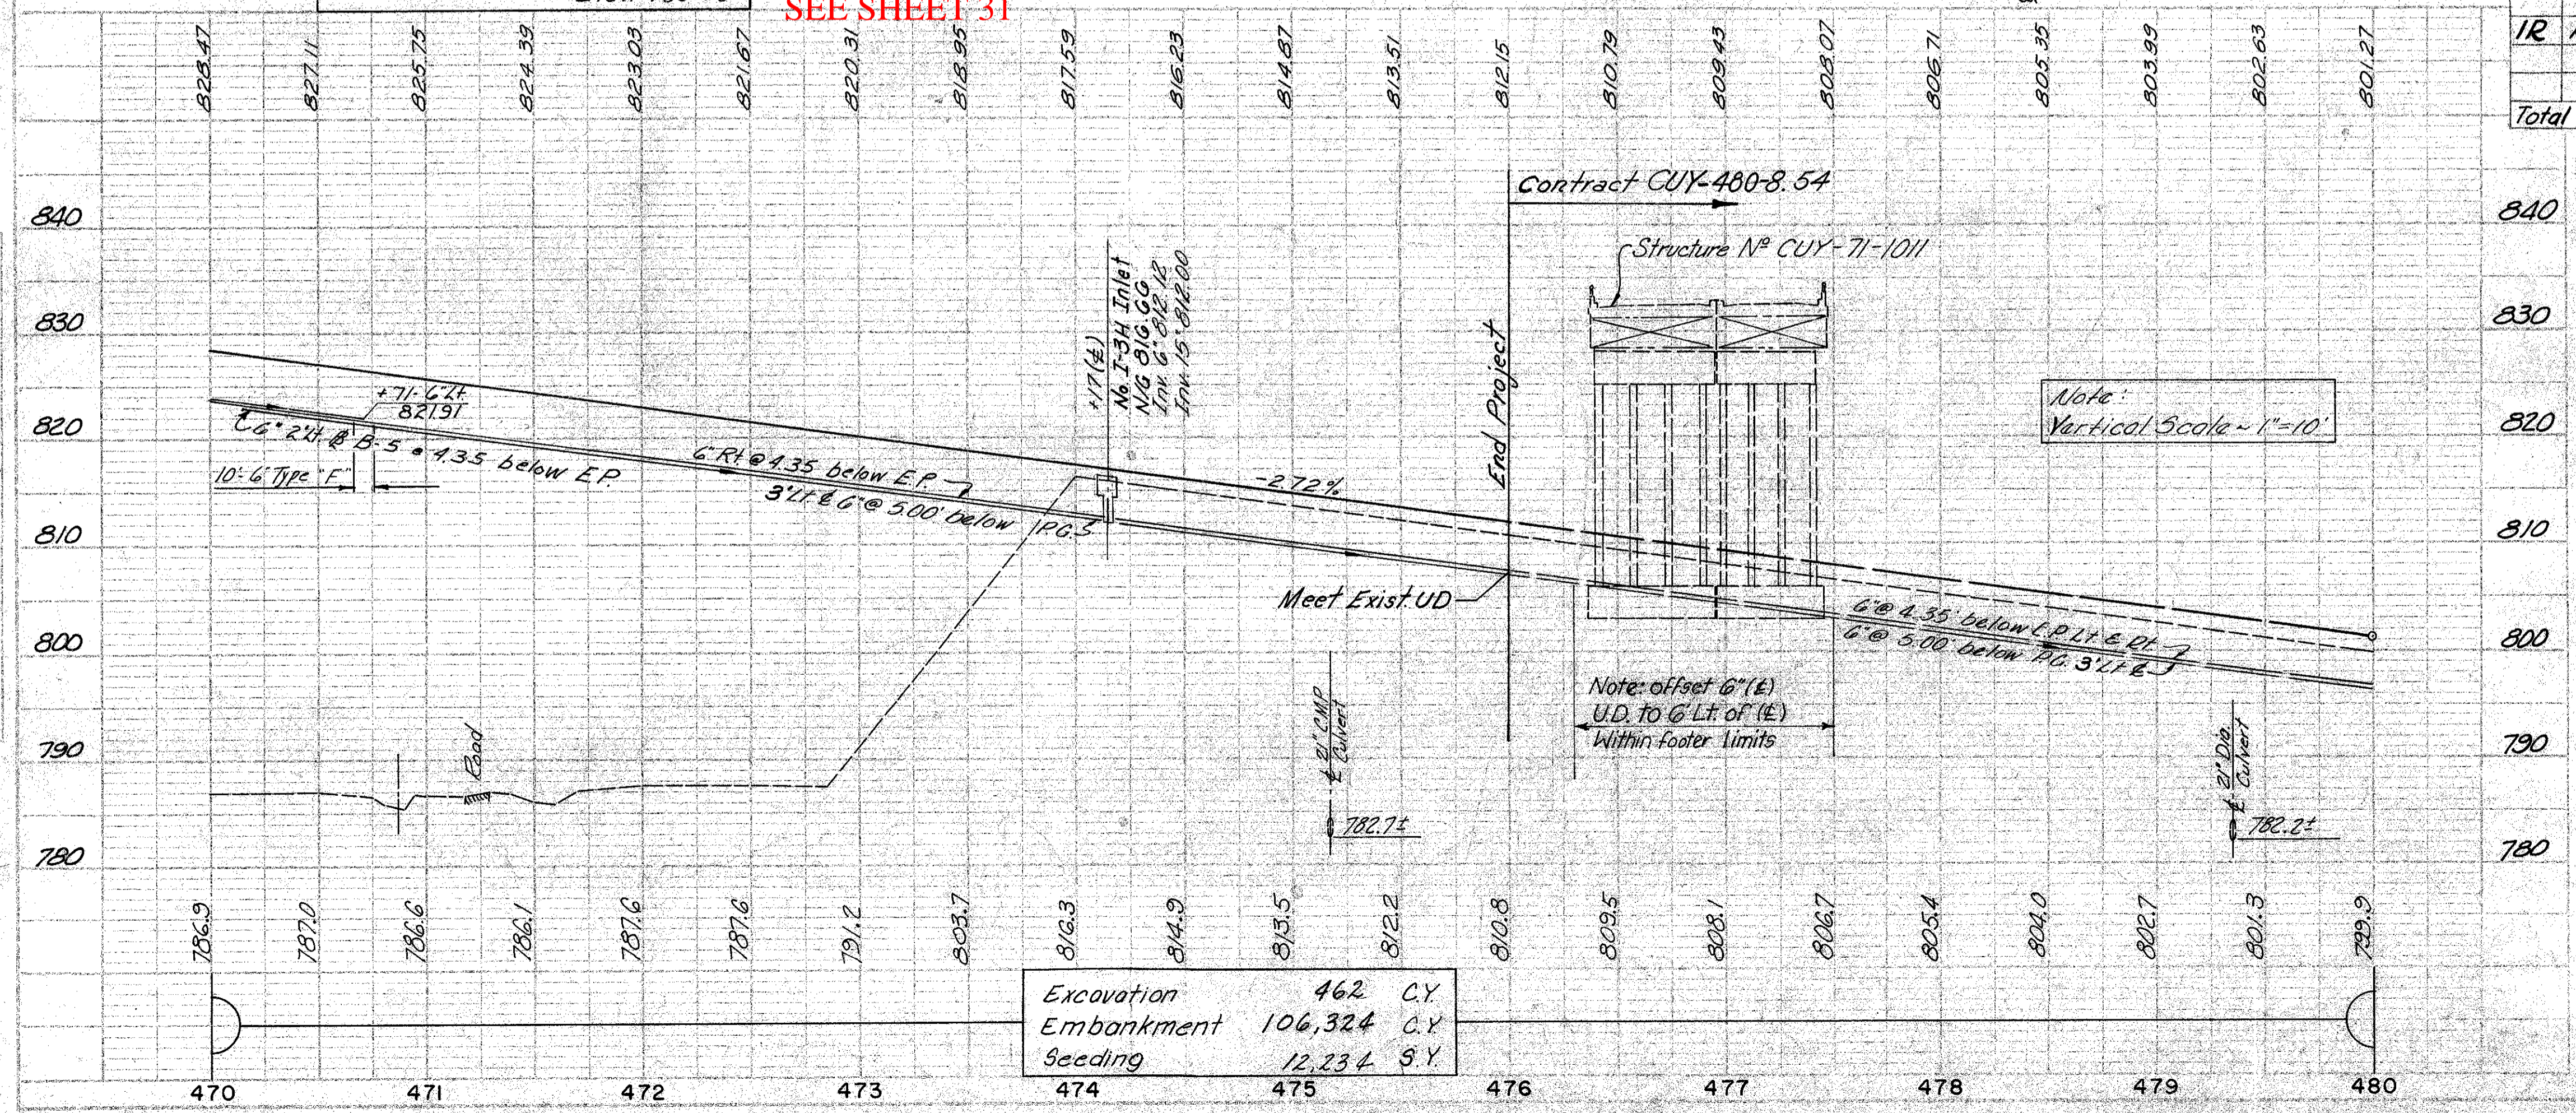

Rev. DRS. 1-6-78
EJK 5-1-69
JTH 8-25-69

Rev. 1-10-78