

old CFN 180710742
 new CFN 1882410
 SLM 7.42, 66"
 SEE SHEET 205

FOR DETAILS ON CULVERT D-4
 SEE SHEET 205

CFN 1972288
 SLM 7.45, 12"
 SEE SHEET 186


CFN 1972298
 SLM 7.50, 12"
 SEE SHEET 186

CFN 1972268
 SLM 7.59, 12"
 SEE SHEET 186

FED. RD. DIVISION	STATE	PROJECT	FISCAL YEAR
2	OHIO		

CUYAHOGA COUNTY
 CUY-71-5.72

33
 353

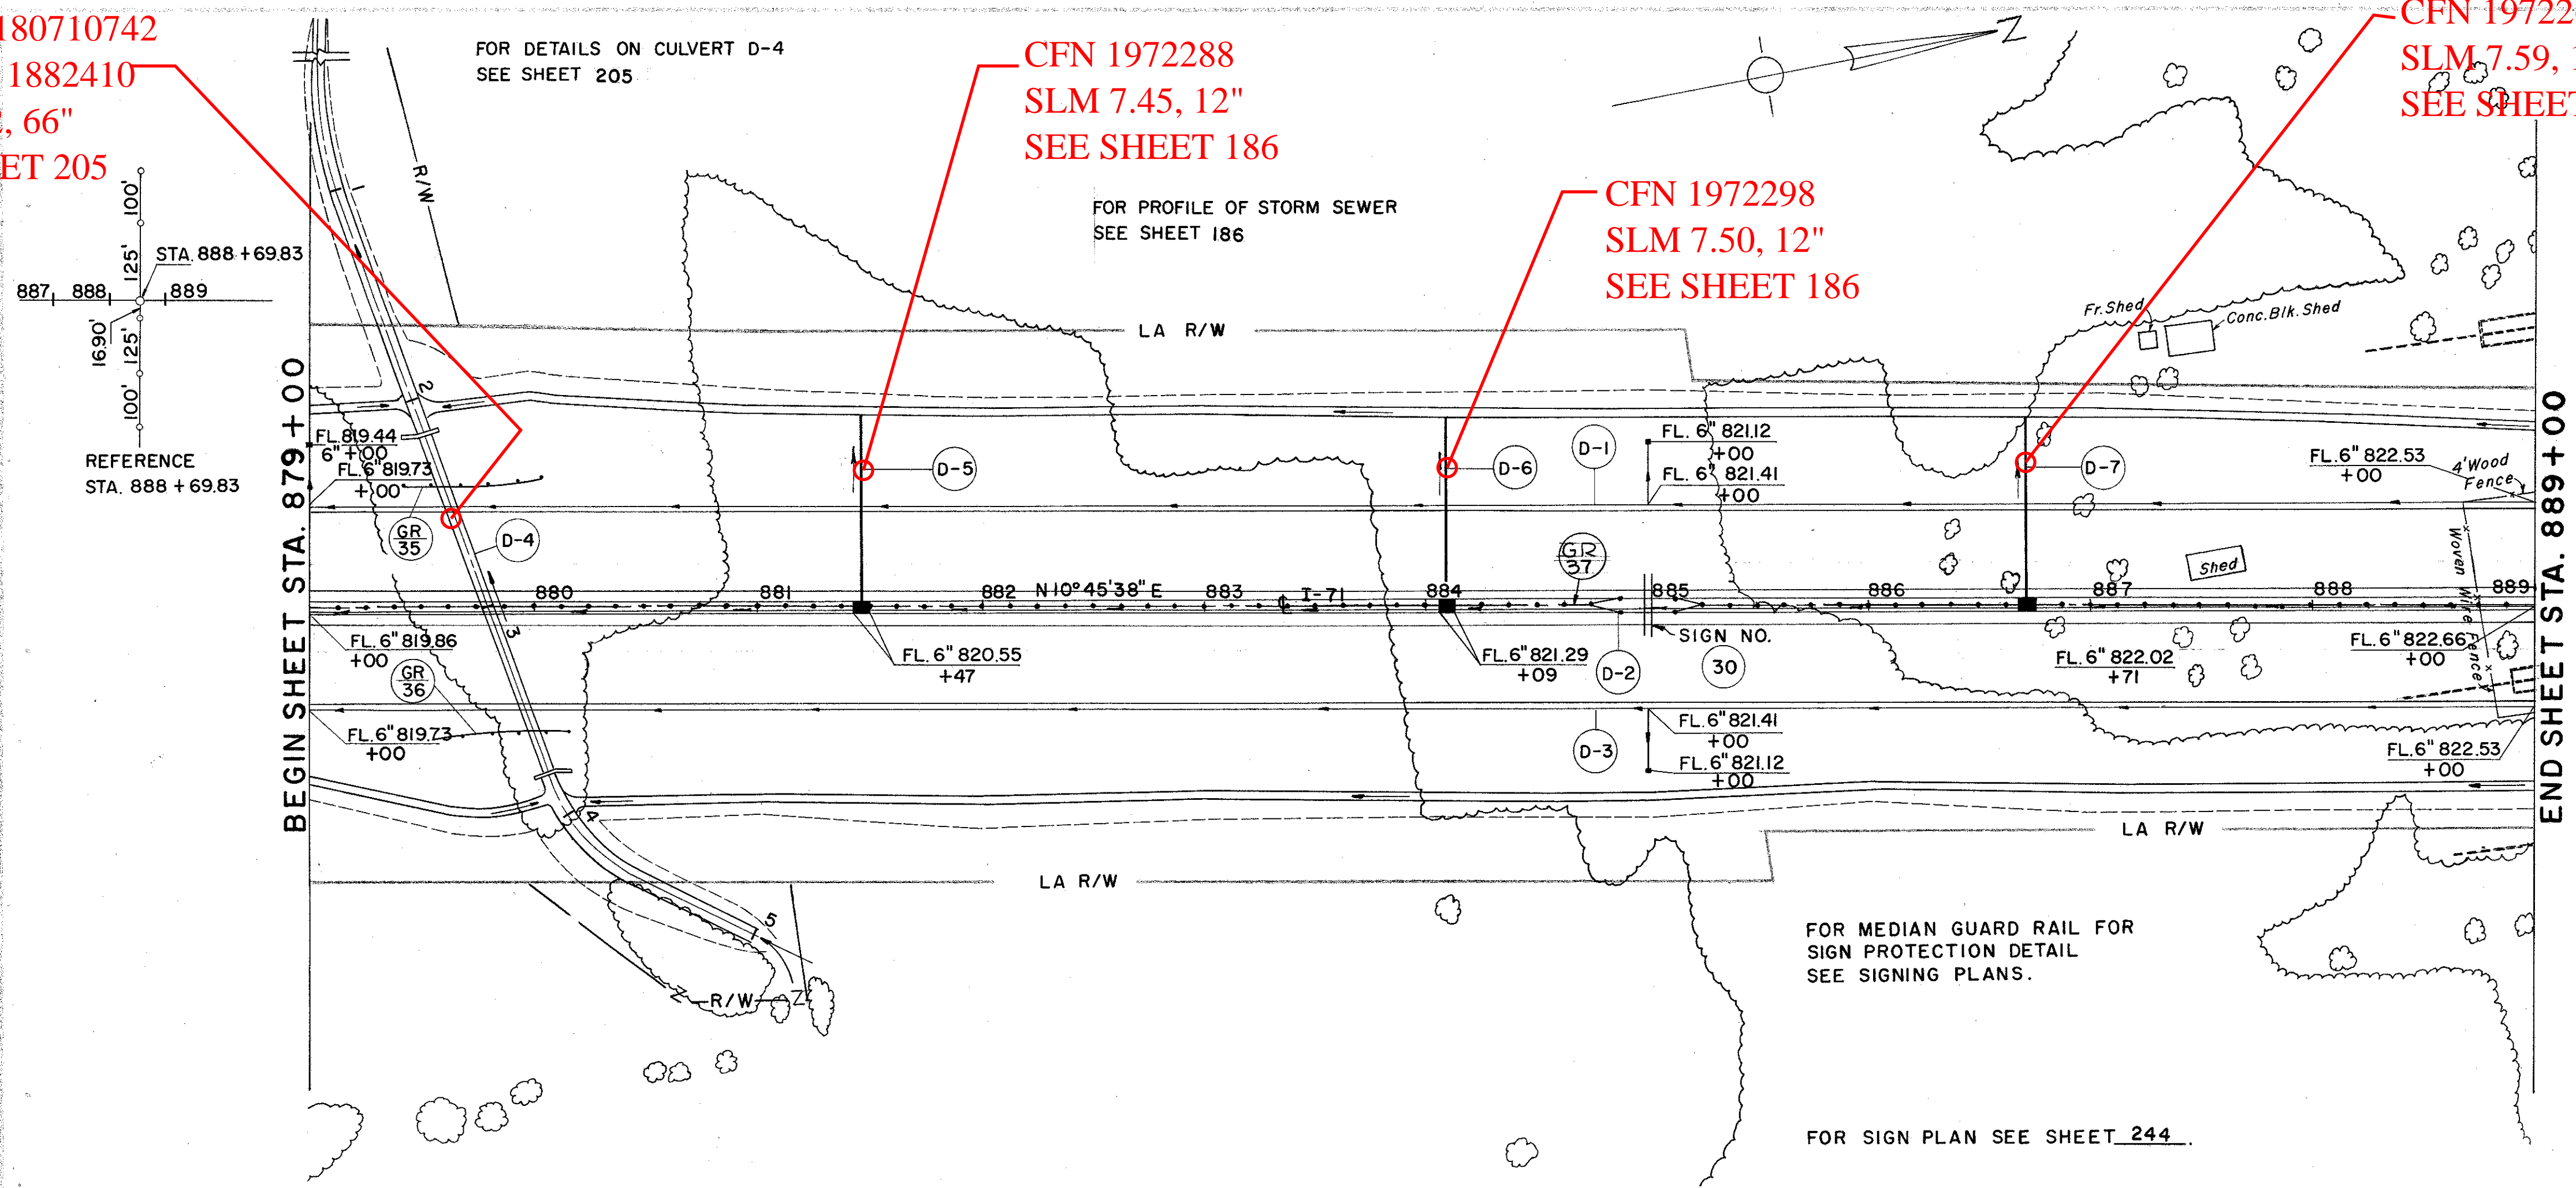


DRAINAGE

REF. NO.	STATION	SIDE	I-1				I-5	I-8	I-2	I-10	L-10	E-3	
			U.D. SHALLOW	6" PIPE CLASS I-3	6" PIPE CLASS F-4	12" PIPE CLASS J-1							66" PIPE CLASS A-1 M=66 (G)
		FROM	TO	LIN. FT.	EACH		C.Y.		S.Y.		C.Y.		
D-1	879+00	889+00	LT.	996	60		2						
D-2	879+00	889+00	CL	960	40								
D-3	879+00	889+00	RT.	1008	20		1						
D-4	879+80		LT.-RT.			166					15	203	
D-5	881+47		CL-LT.		87		1	0.23	2	2			
D-6	884+09		CL-LT.		86		1	0.23	2	2			
D-7	886+71		CL-LT.		85		1	0.23	2	2			
TOTAL				2964	120	258	166	3	3	30.69	26	21	203

ROADWAY

REF. NO.	STATION	SIDE	STEEL BEAM (DEEP)		
			STANDARD	BARRIER	
GR-35	879+42.5	880+05	LT.	62.5	-
GR-36	879+56	880+18.5	RT.	62.5	-
GR-37	879+00	889+00	CL	-	1000
TOTAL				125	1000

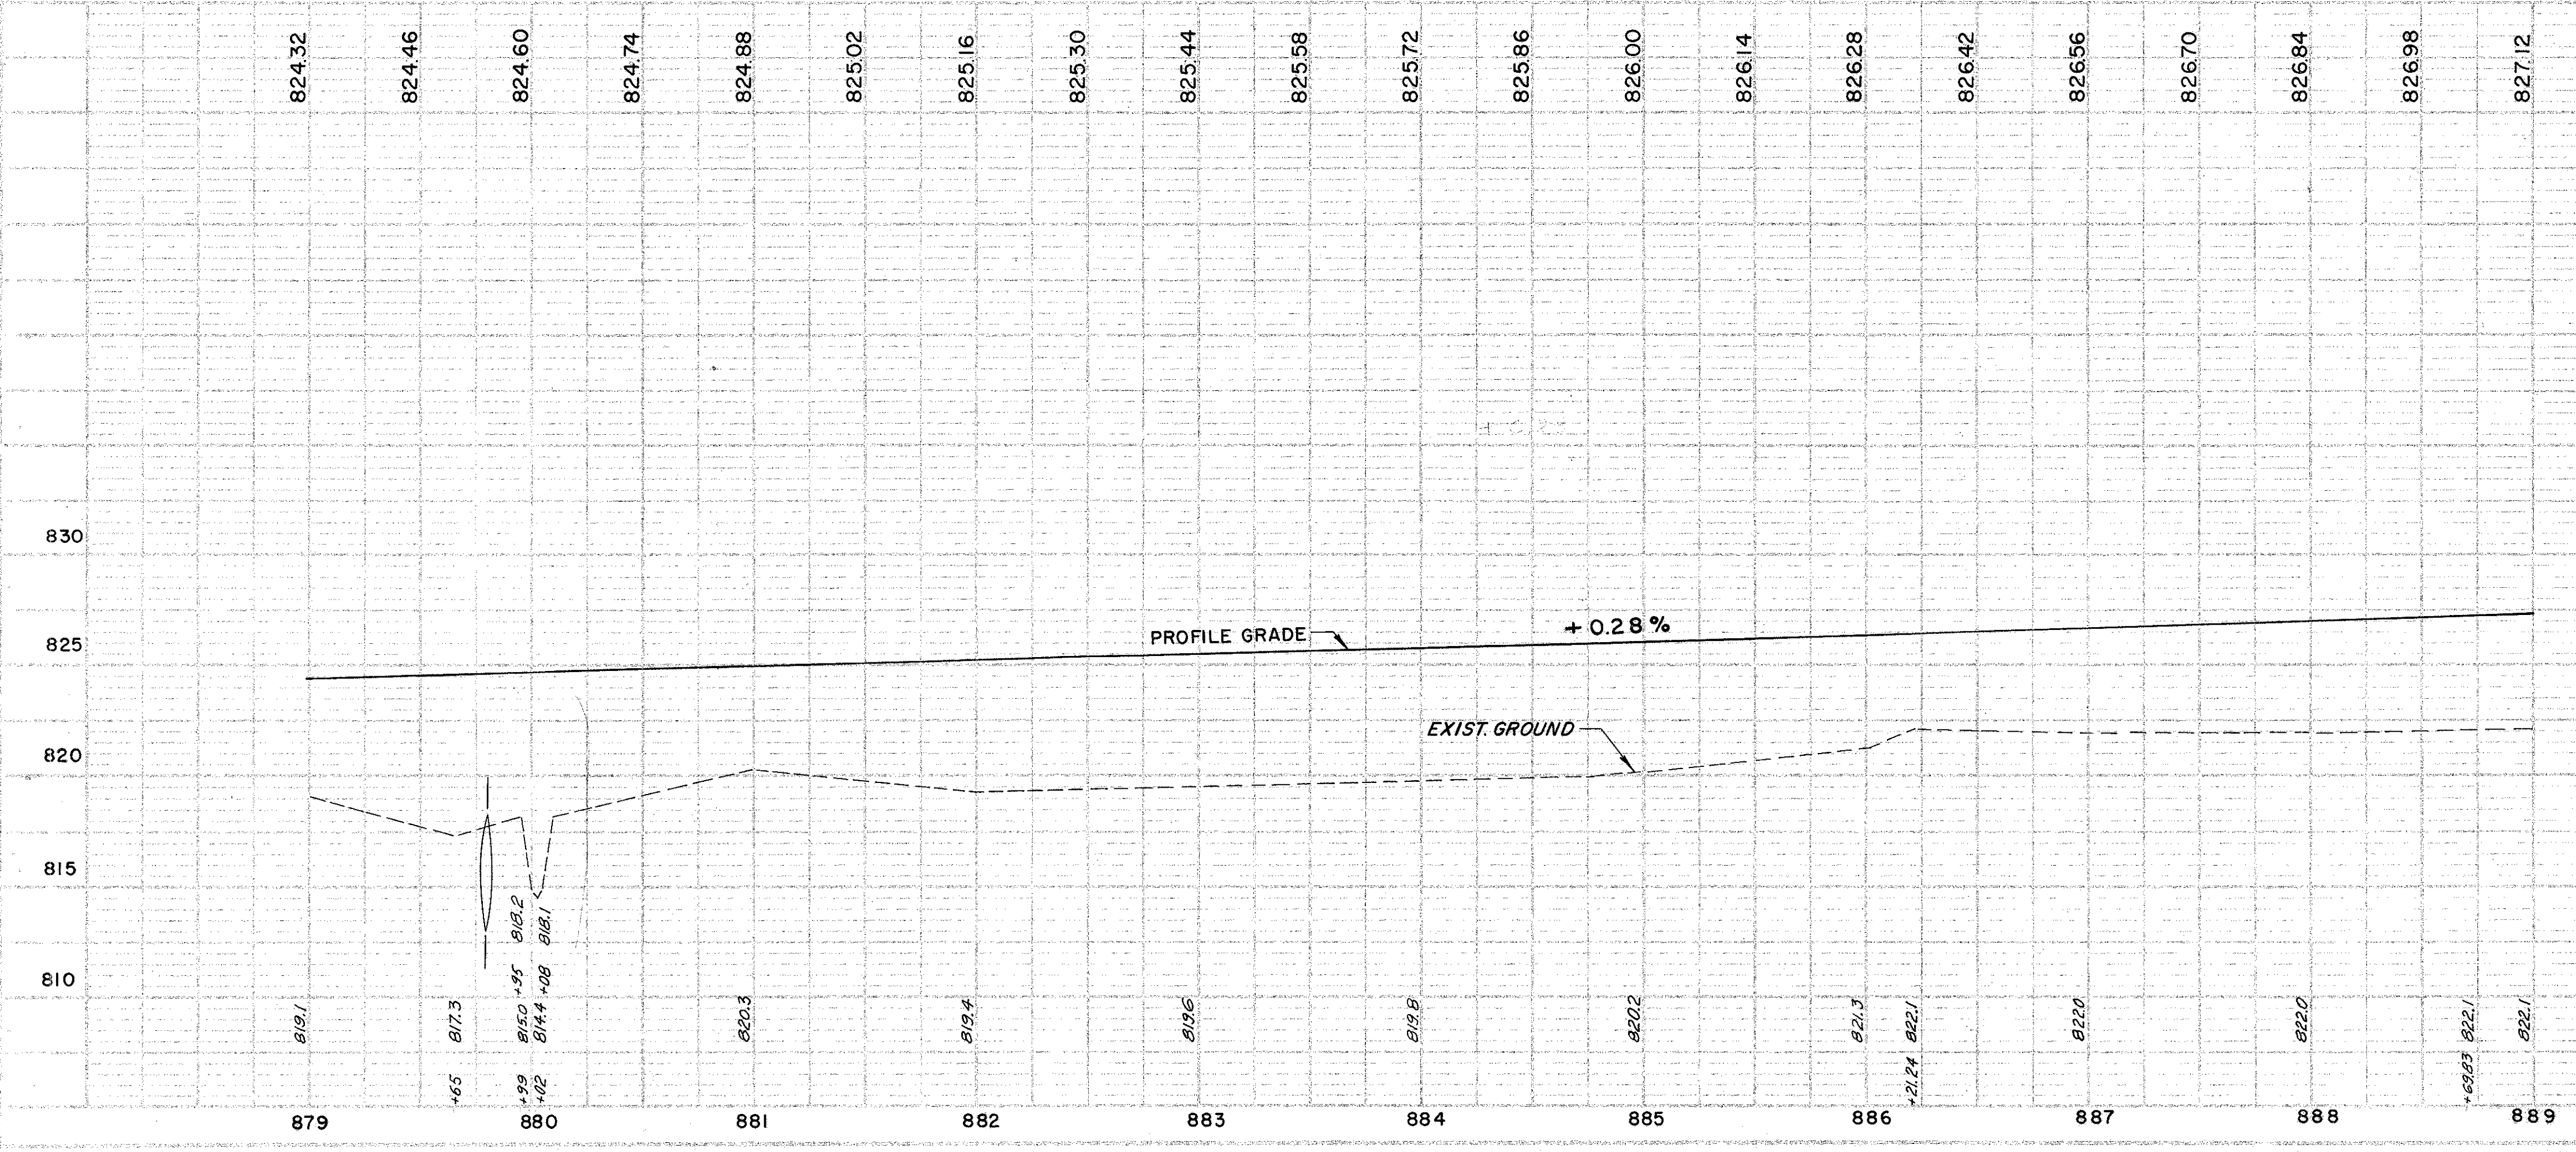

PLAN & PROFILE- STA. 879+00 TO STA. 889+00