


FED. RD. DIVISION	STATE	PROJECT
2	OHIO	

114
230

CUYAHOGA COUNTY
CUY-71-8.41

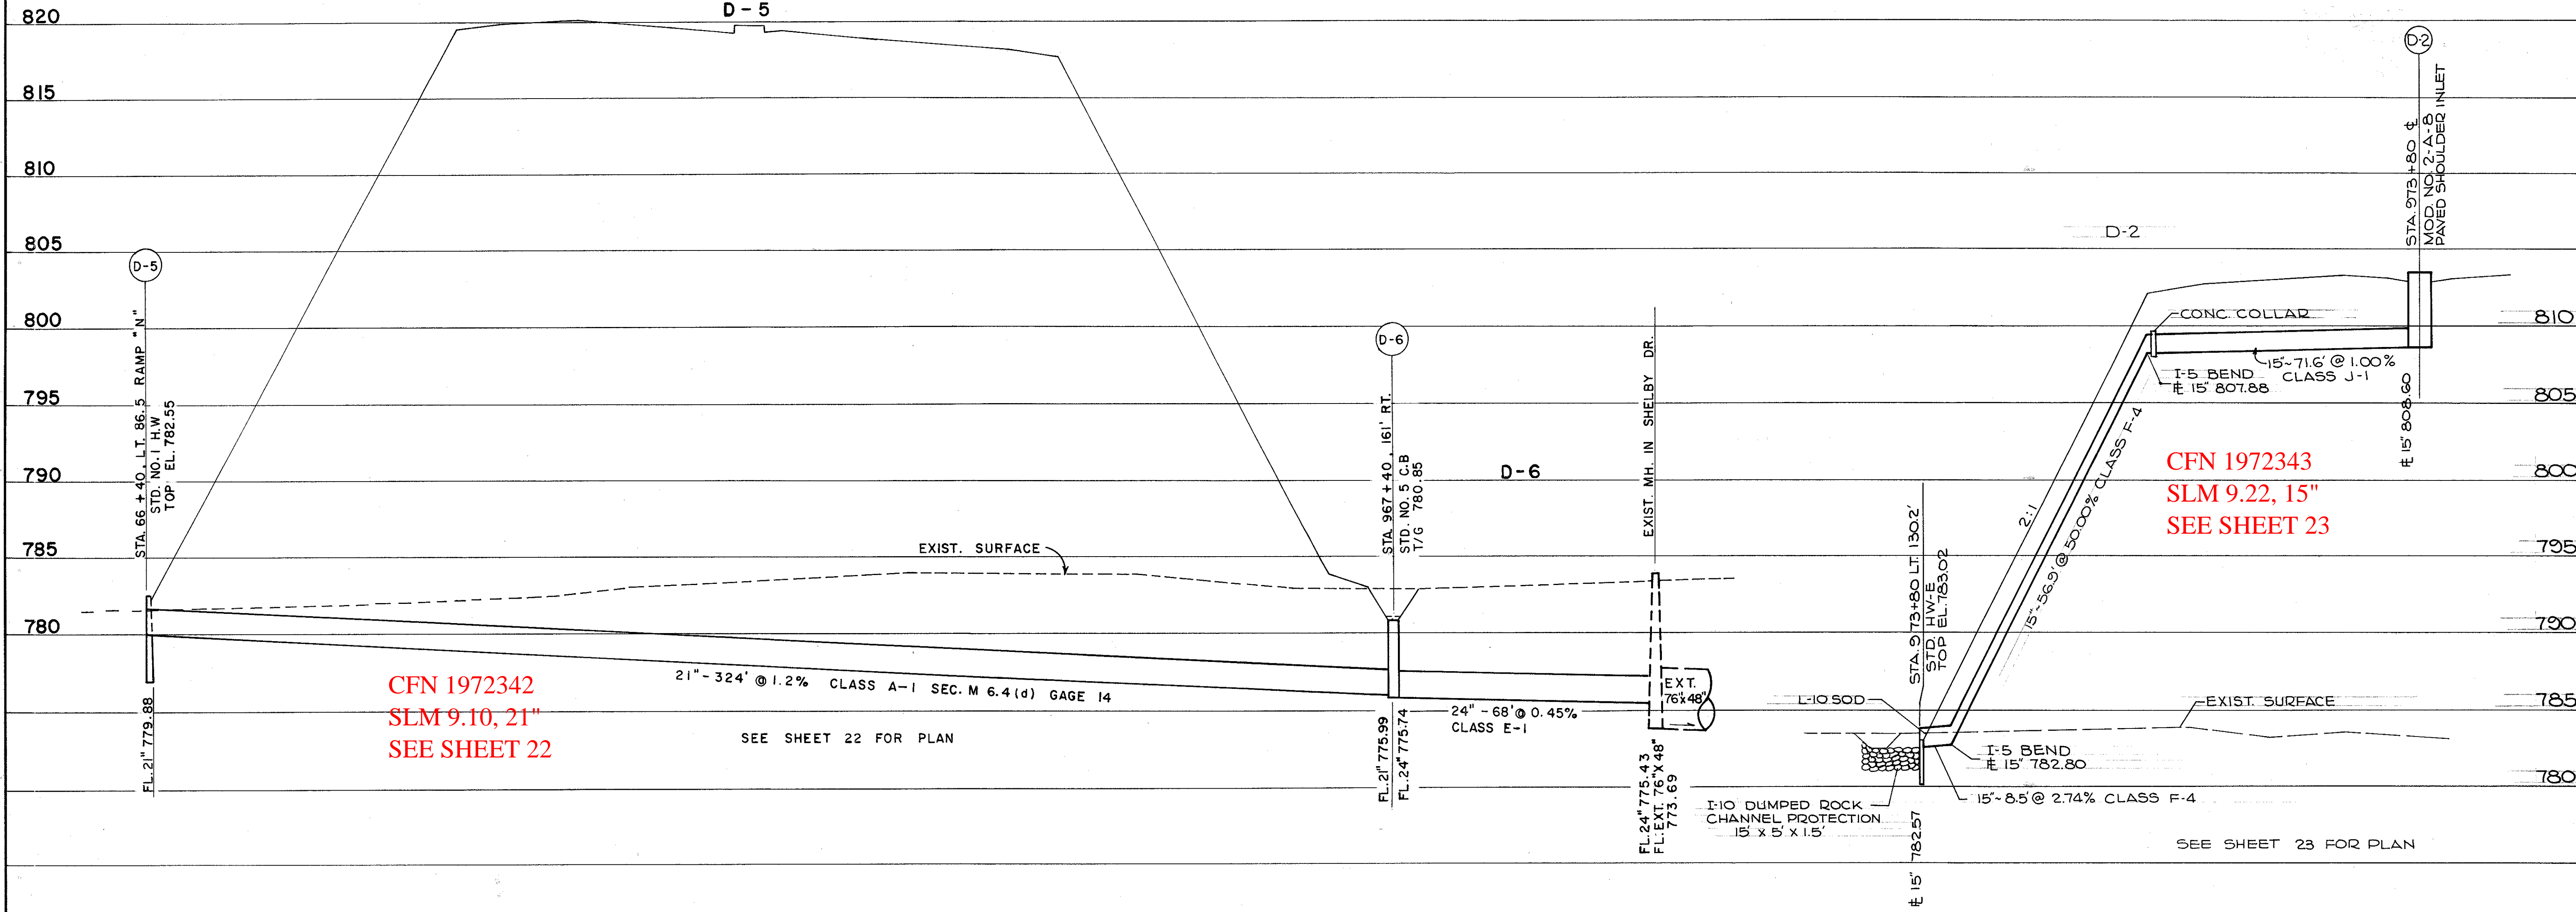

PACE ASSOCIATES OF OHIO 4500 EUCLID AVE. CLEVELAND 3, OHIO	
STORM SEWER PROFILES MAINLINE	
SCALE	DATE
DESIGNED	DRAWN
TRACED	CHECKED
REVIEWED	DATE
REVISOR	REVISION