


SLM 17.61, 15"
SEE SHEET 116

CFN 1972516
SLM 17.61, 15"
SEE SHEET 116

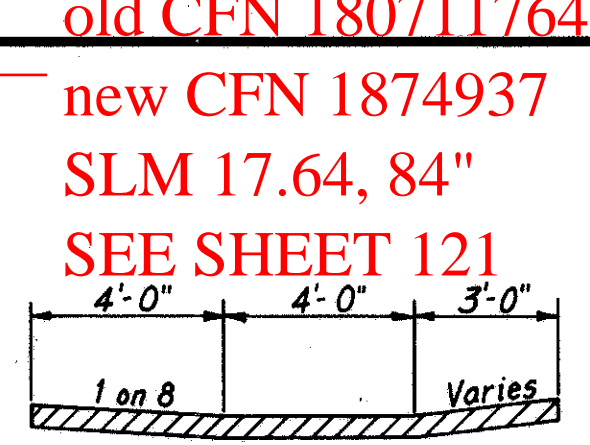

CFN 1972652
SLM 17.74, 15"
SEE SHEET 117

old CFN 180711775
new CFN 1844627
SLM 17.75, 84"
SEE SHEET 122

DRAINAGE QUANTITIES		I-1				I-5	
CODE	LOCATION	Cl. I-3	Cl. I-3	Cl. F-4	Cl. B-1	Cl. I-3	Cl. I-3
		Shallow	Deep	6"	6"	60° Bend	90° Bend
		6"	6"	6"	6"	6"	6"
UNDERDRAINS		Lin. Ft.					
U-58	Ramp 14-M Rt. 26+90 to 28+75		181	8			1
U-59	Ramp 14-M Rt. 21+10 to 26+87		573	8			1
U-60	Ramp 14-M Rt. 19+15 to 21+07		192				
U-61	Lane J Rt. 4+65 to 9+60		485	10			
U-62	Lane J Rt. 4+40 to 4+61		21				
U-63	S.B. Medina Lt. 900+00 to 900+42		42	5			1
U-64	S.B. Medina Lt. 900+46 to 902+00		152	5			1
U-65	S.B. Medina Lt. 902+04 to 903+60		154	5			1
U-66	S.B. Medina Lt. 903+64 to 907+95		429	5			1
U-67	N.B. Medina Lt. 899+21 to 902+10	267		14			
U-68	N.B. Medina Lt. 902+14 to 902+80	62		8			1
U-69	N.B. Medina Lt. 902+80 to 909+35	651		8			1
U-70	N.B. Medina Rt. 899+21 to 902+25		289	20			1
U-71	Lane H Lt. 20+90 to 21+25		32	4			1
U-72	Lane H Lt. 21+28 to 23+75		245	4			1
U-73	Lane H Lt. 23+75 to 24+50		75				
U-74	Lane H Lt. 24+50 to 25+25		75				
U-75	Lane H Lt. 25+25 to 29+08		383				
U-76	Ramp I Lt. 5+50 to 6+95		135	10			
U-77	Ramp I Lt. 6+95 to 7+54		49	10			
U-78	Ramp I Rt. 4+20 to 7+75		368	10			1
Total			1697	3163	134		11

old CFN 180711761
new CFN 1874936
SLM 17.61, 84"
SEE SHEET 121

old CFN 180711758
new CFN 1874935
SLM 17.58, 84"
SEE SHEET 121

old CFN 180711772
new CFN 1844625
SLM 17.72, 84"
SEE SHEET 121
AND 122

old CFN 180711774
new CFN 1844626
SLM 17.74, 84"
SEE SHEET 122

CFN 1972656
SLM 17.72, 15"
SEE SHEET 116

CFN 1972661
SLM 17.58, 15"
SEE SHEET 116

CFN 1972664
SLM 17.58, 15"
SEE SHEET 116

CFN 1972658
SLM 17.64, 18"
SEE SHEET 116

SLM 17.64, 15"
SEE SHEET 116

CFN 1972655
SLM 17.64, 15"
SEE SHEET 116

CFN 1972653
SLM 17.63, 15"
SEE SHEET 116

SLM 17.64, 15"
SEE SHEET 116

SLM 17.64, 15"
SEE SHEET 116

CFN 1972662
SLM 17.64, 15"
SEE SHEET 116

CFN 1972663
SLM 17.65, 15"
SEE SHEET 118

SLM 17.67, 12"
SEE SHEET 118

CFN 1972650
SLM 17.74, 15"
SEE SHEET 117

CFN 1972651
SLM 17.74, 15"
SEE SHEET 117

old CFN 180711781
new CFN 1844628
SLM 17.81, 84"
SEE SHEET 122

- DRAINAGE LEGEND**
- ⊕ PROPOSED STORM SEWER MANHOLE
 - ⊙ PROPOSED SANITARY MANHOLE
 - PROPOSED PAVED SHOULDER INLET
 - ▭ PROPOSED DITCH CATCH BASIN
 - ▭ PROPOSED PAVEMENT CATCH BASIN
 - PROPOSED STORM OR SANITARY SEWER
 - EXISTING MANHOLE
 - EXISTING CATCH BASIN
 - EXISTING STORM OR SANITARY SEWER
 - ▭ JUTE MATTING
 - ▭ SODDED DITCH

DRAINAGE QUANTITIES		L-10	I-14	I-8
CODE	LOCATION	Sodding	Paved Gutter Type 1 Mod.	Std. No. 1 M.H. Mod.
		Sq. Yd.	Lin. Ft.	Each
DITCH PROTECTION				
D-5	Ramp I-Rt. 4+15 to 6+25	256		
D-6	Ramp I-Rt. 8+30 to 12+48	139		
D-7	Ramp I-Rt. 8+10 to 8+20	70		
D-8	S.B. Medina Rt. 903+65 to 910+00	106	635	
SANITARY SEWERS				
SS-18	Evelyn Rd. & 1+65			1
Total		508	635	1

