


FED. RD. DIVISION	STATE	PROJECT
2	OHIO	

117
241

CUYAHOGA COUNTY
CUY. 71-17.18

21
28

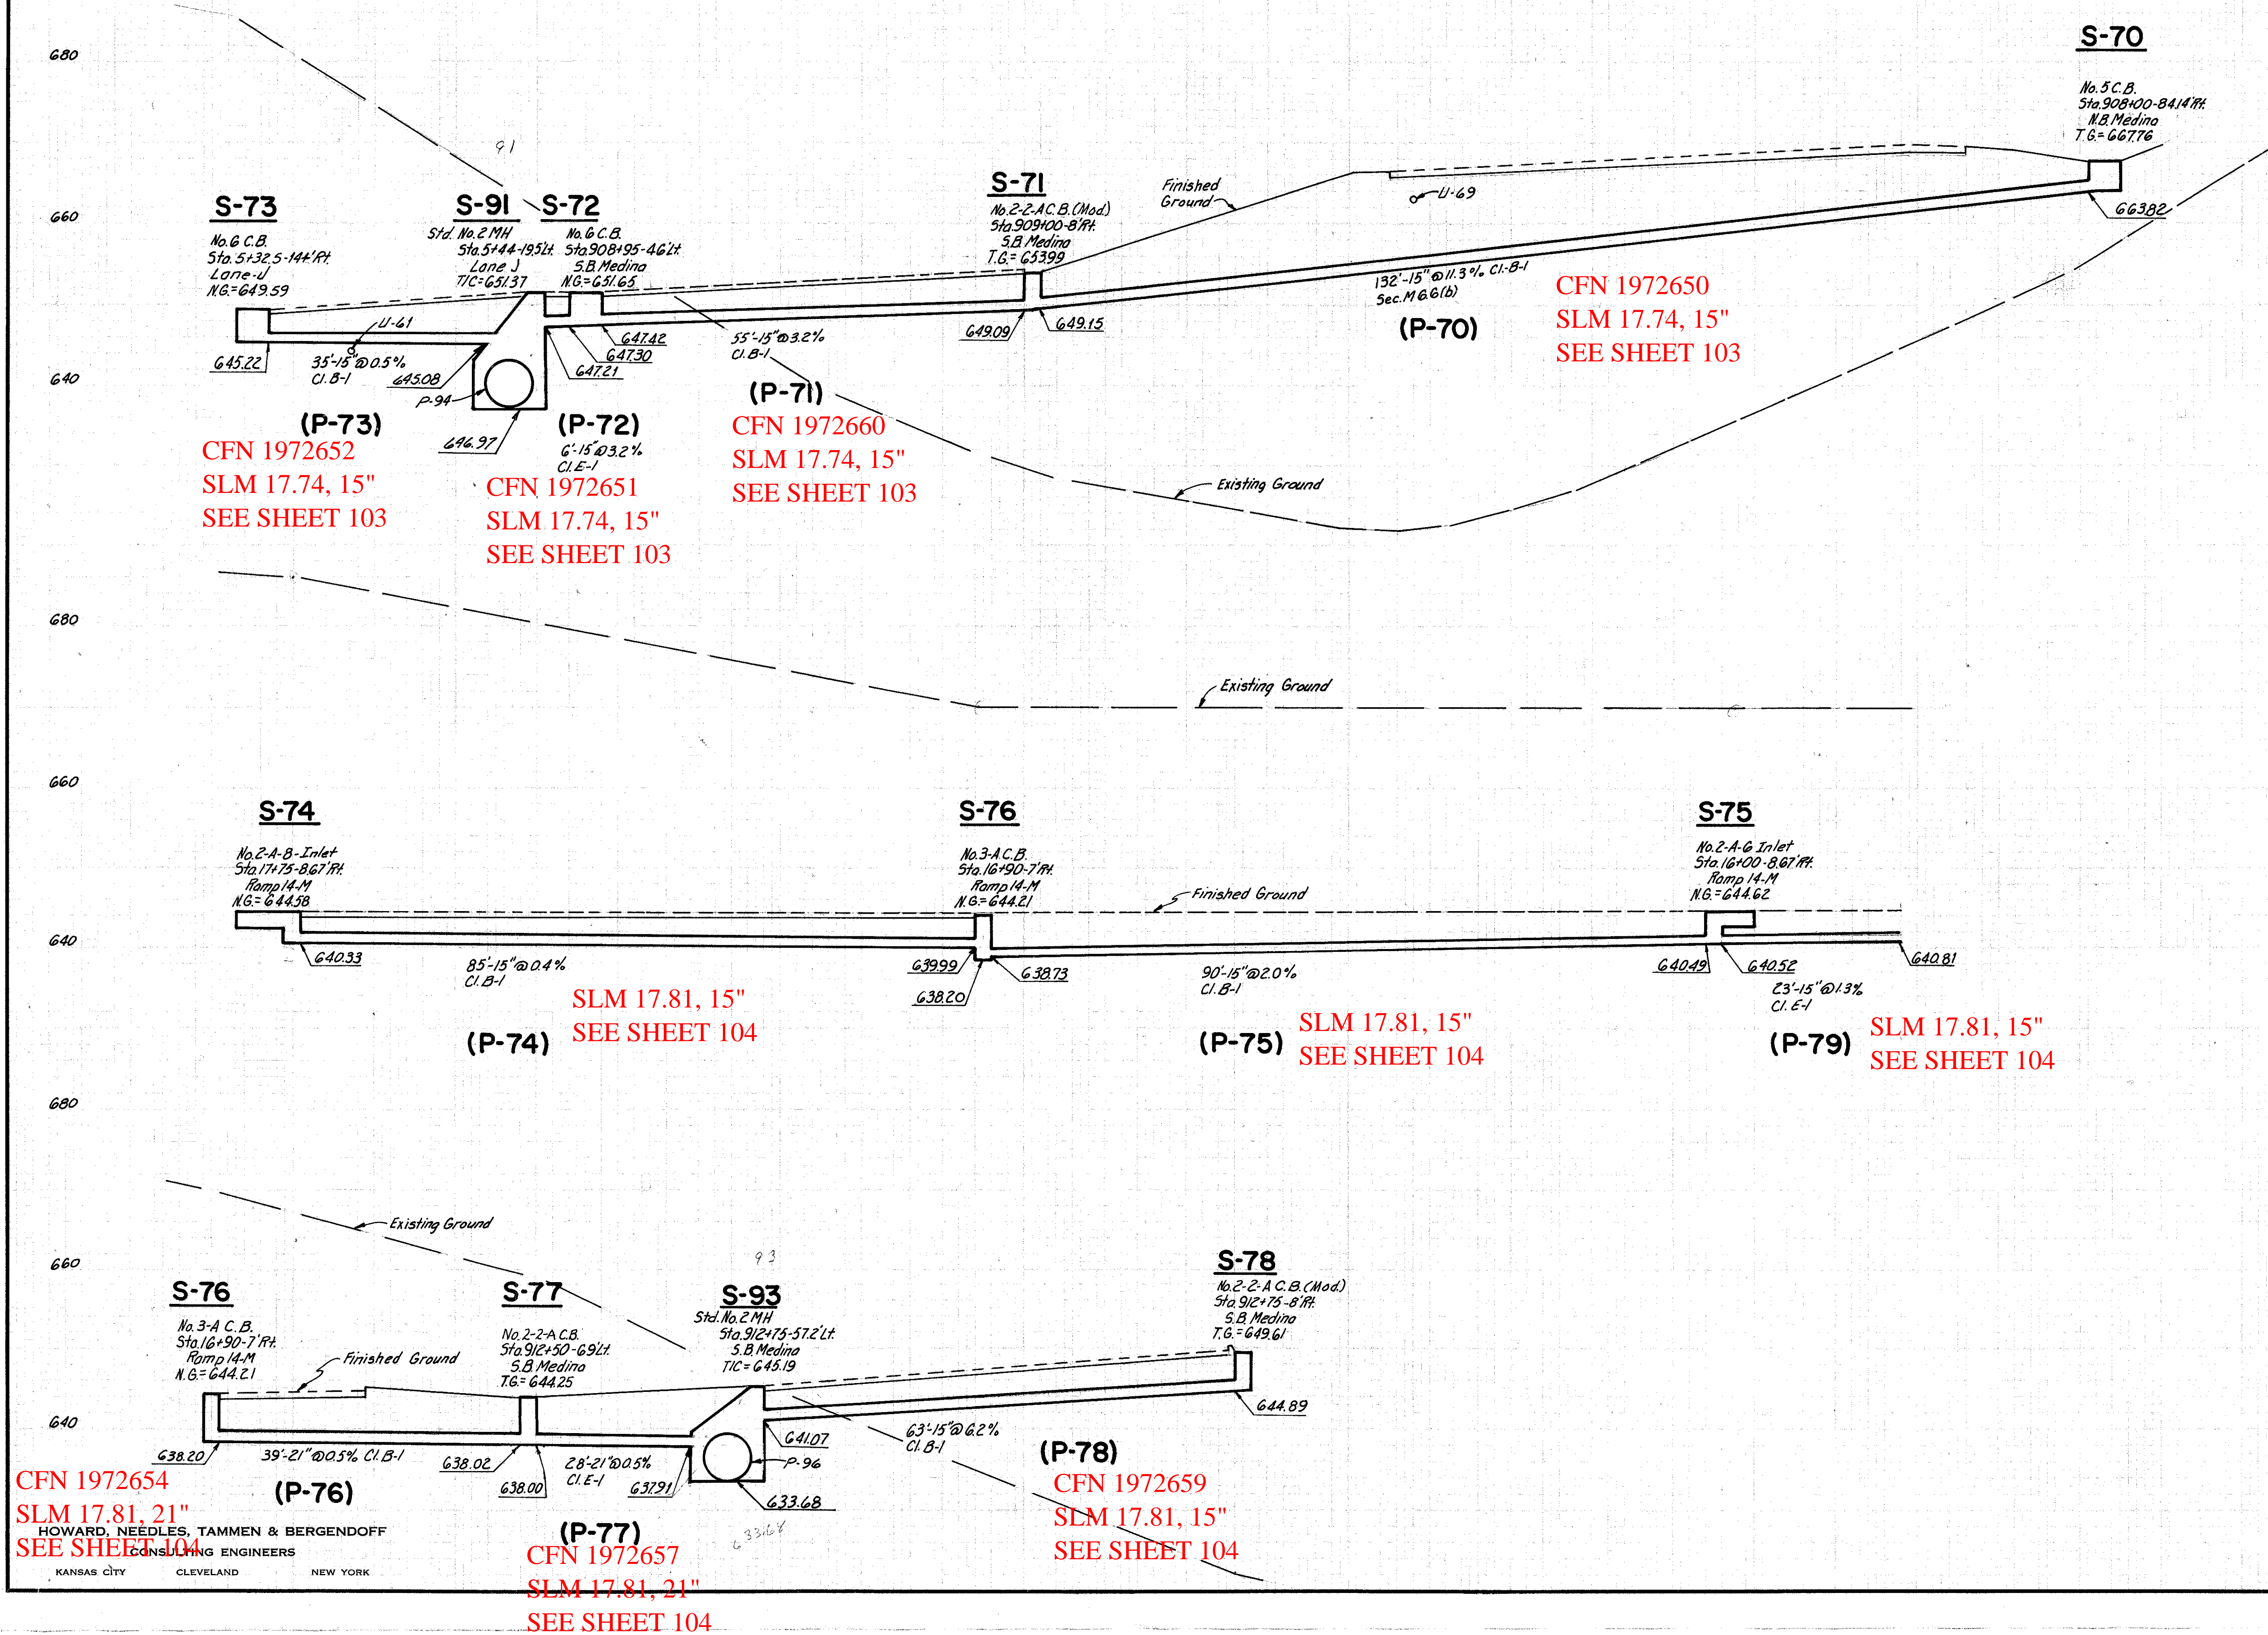

(P-73)
CFN 1972652
SLM 17.74, 15"
SEE SHEET 103

(P-72)
CFN 1972651
SLM 17.74, 15"
SEE SHEET 103

(P-71)
CFN 1972660
SLM 17.74, 15"
SEE SHEET 103

(P-70)
CFN 1972650
SLM 17.74, 15"
SEE SHEET 103

(P-74)
SLM 17.81, 15"
SEE SHEET 104

(P-75)
SLM 17.81, 15"
SEE SHEET 104

(P-79)
SLM 17.81, 15"
SEE SHEET 104

CFN 1972654
SLM 17.81, 21"
SEE SHEET 104
HOWARD, NEEDLES, TAMMEN & BERGENDOFF
CONSULTING ENGINEERS
KANSAS CITY CLEVELAND NEW YORK

(P-77)
CFN 1972657
SLM 17.81, 21"
SEE SHEET 104

(P-78)
CFN 1972659
SLM 17.81, 15"
SEE SHEET 104