


FED. RD. DIVISION	STATE	PROJECT
2	OHIO	

118  
241

22  
28

CUYAHOGA COUNTY  
CUY-71-1718

**S-79**  
No. 1 S. Ditch Inlet  
Sta. 11+40 - 12' R+  
Ramp I  
N.G. 674.25

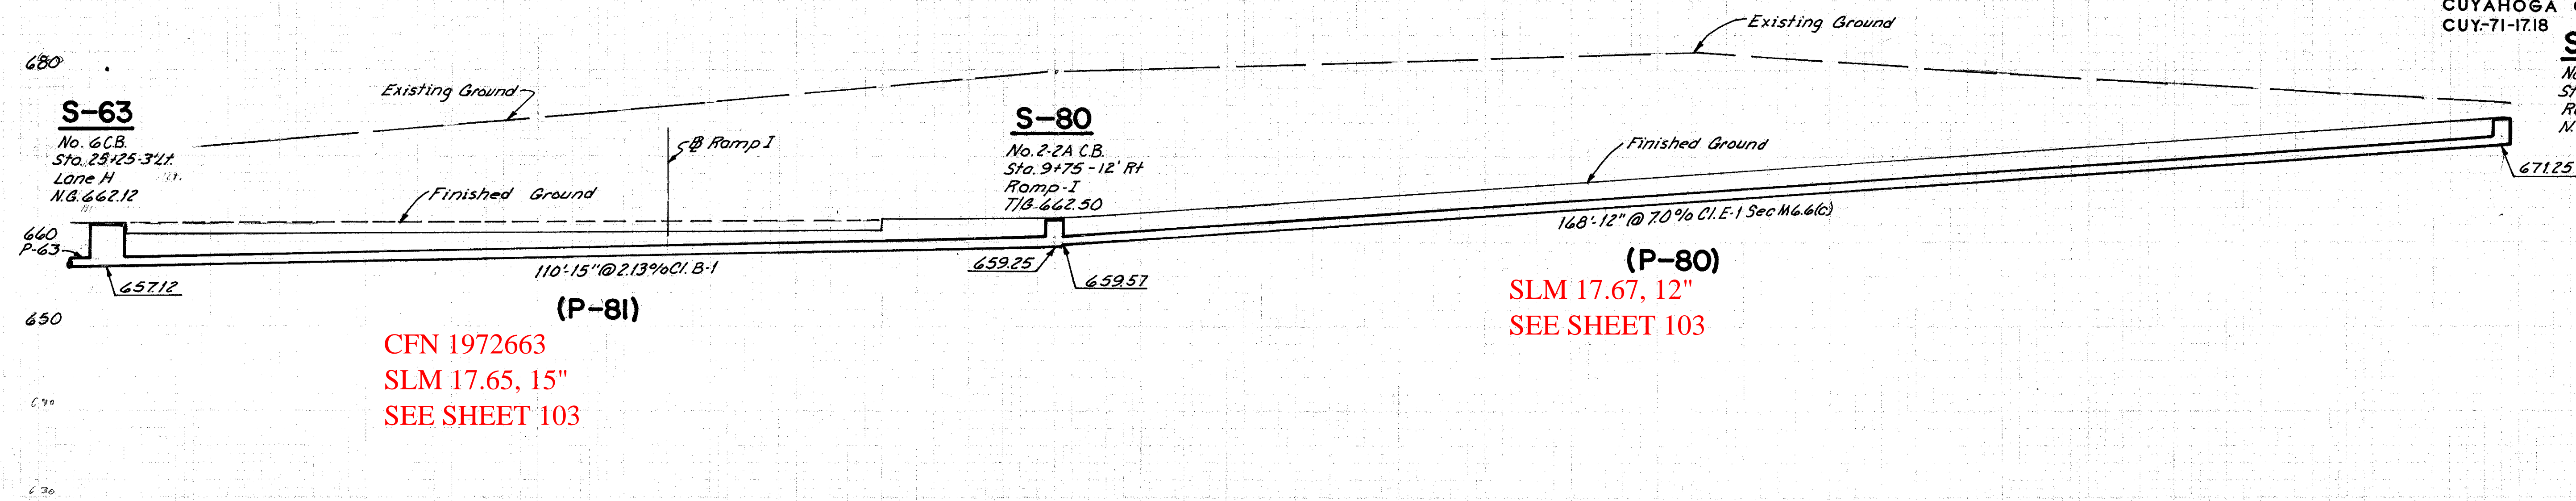

CFN 1972663  
SLM 17.65, 15"  
SEE SHEET 103

(P-80)  
SLM 17.67, 12"  
SEE SHEET 103

RBM 2-12-65/RDJ 2-9-65