
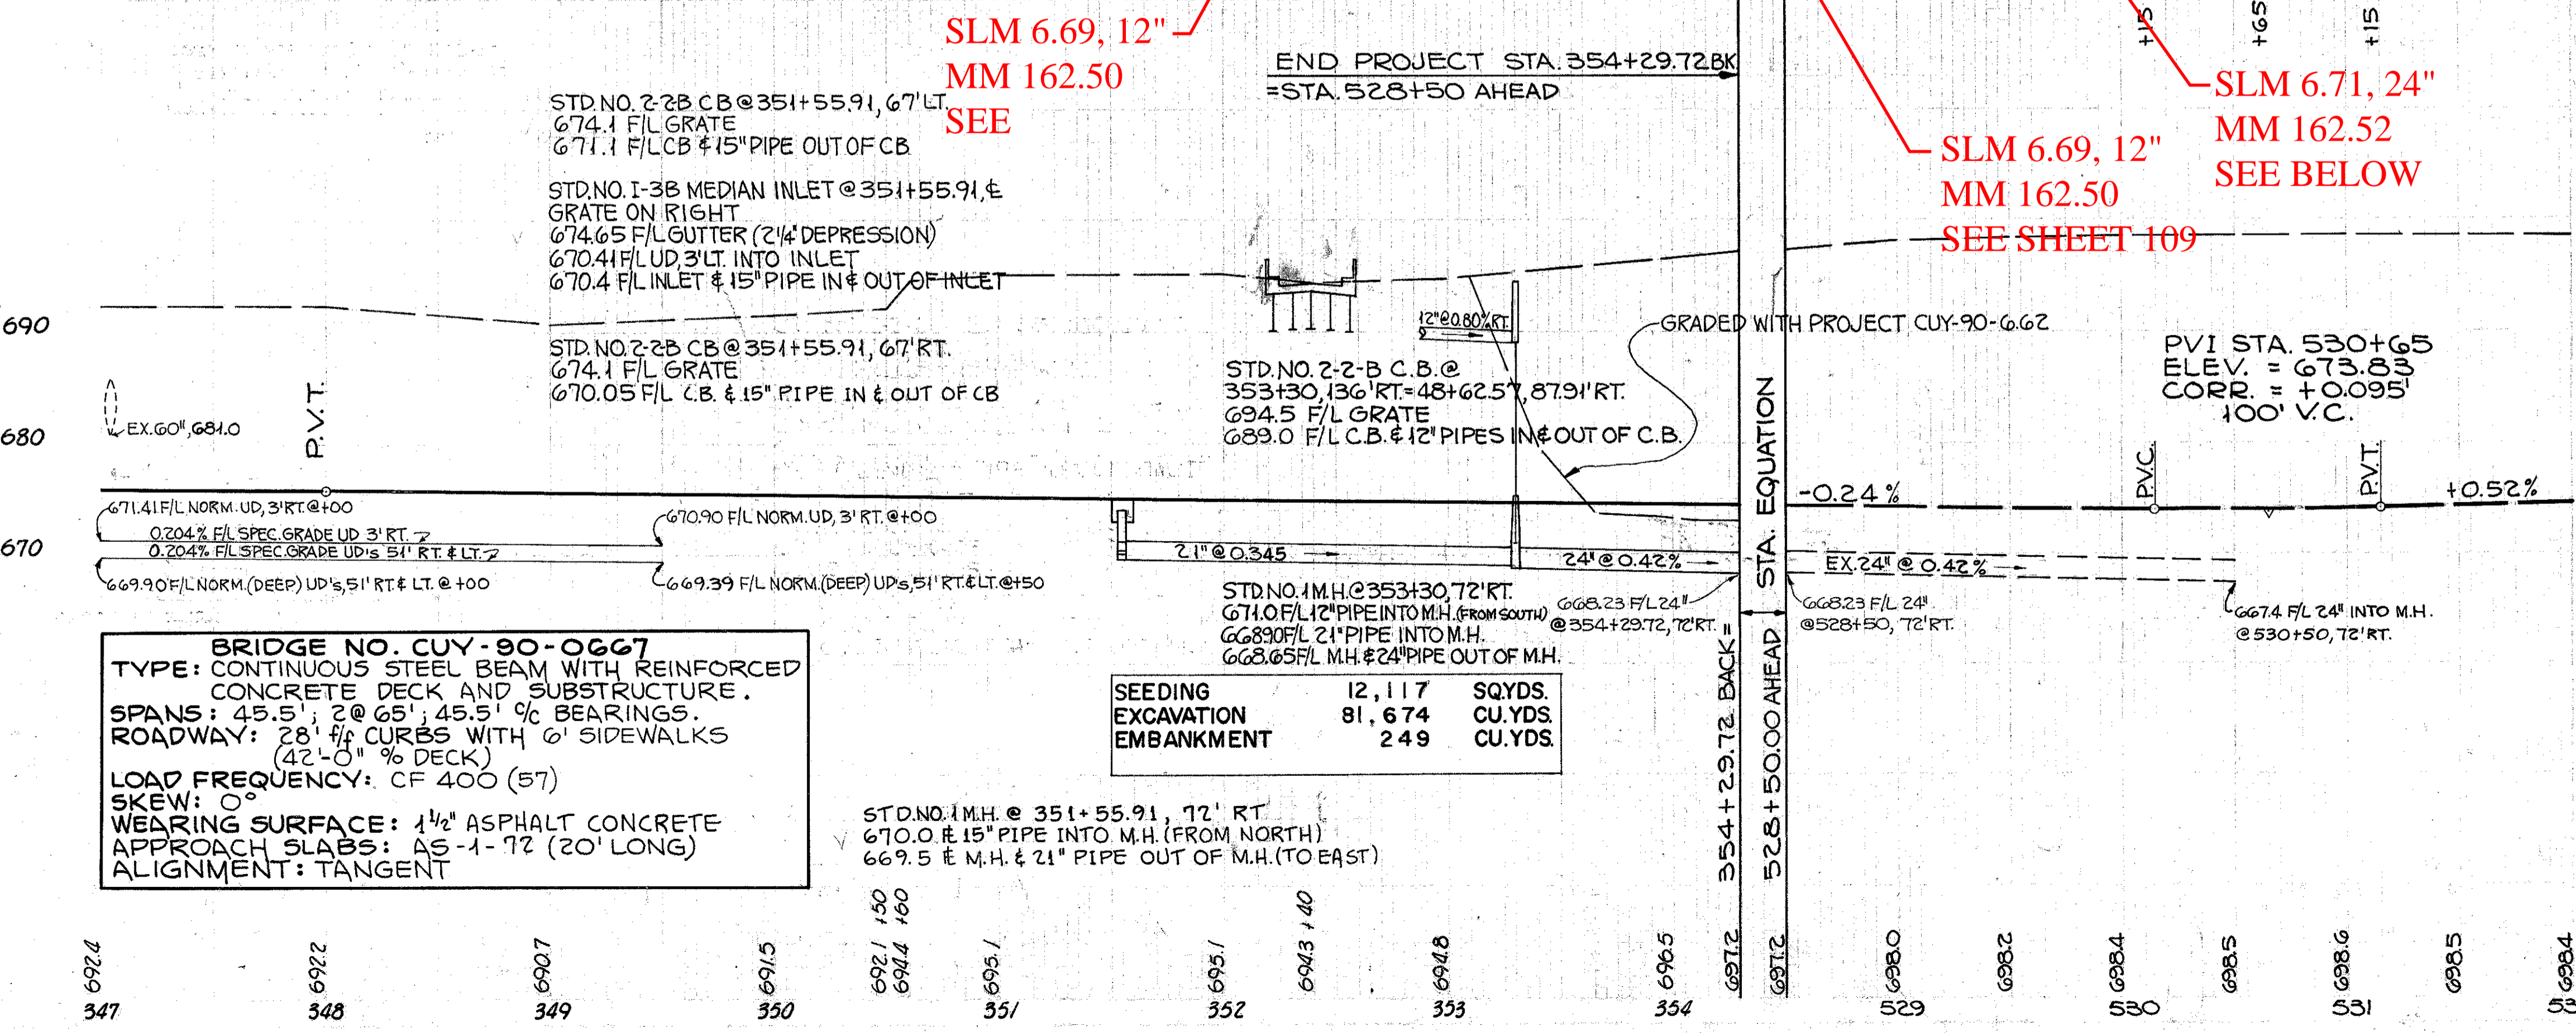


CFN XXXXXXX  
 SLM 6.66, 15"  
 MM 162.47  
 SEE SHEET 109  
 INV. 3/10/2017  
 NEEDS INS

CFN XXXXXXX  
 SLM 6.66, 15"  
 MM 162.47  
 SEE SHEET 109  
 INV. 3/10/2017  
 NEEDS INS

SLM 6.69, 21"  
 MM 162.50  
 SEE SHEET 448

LAKEVIEW AVE.  
 SLM 6.67=MM 162.48

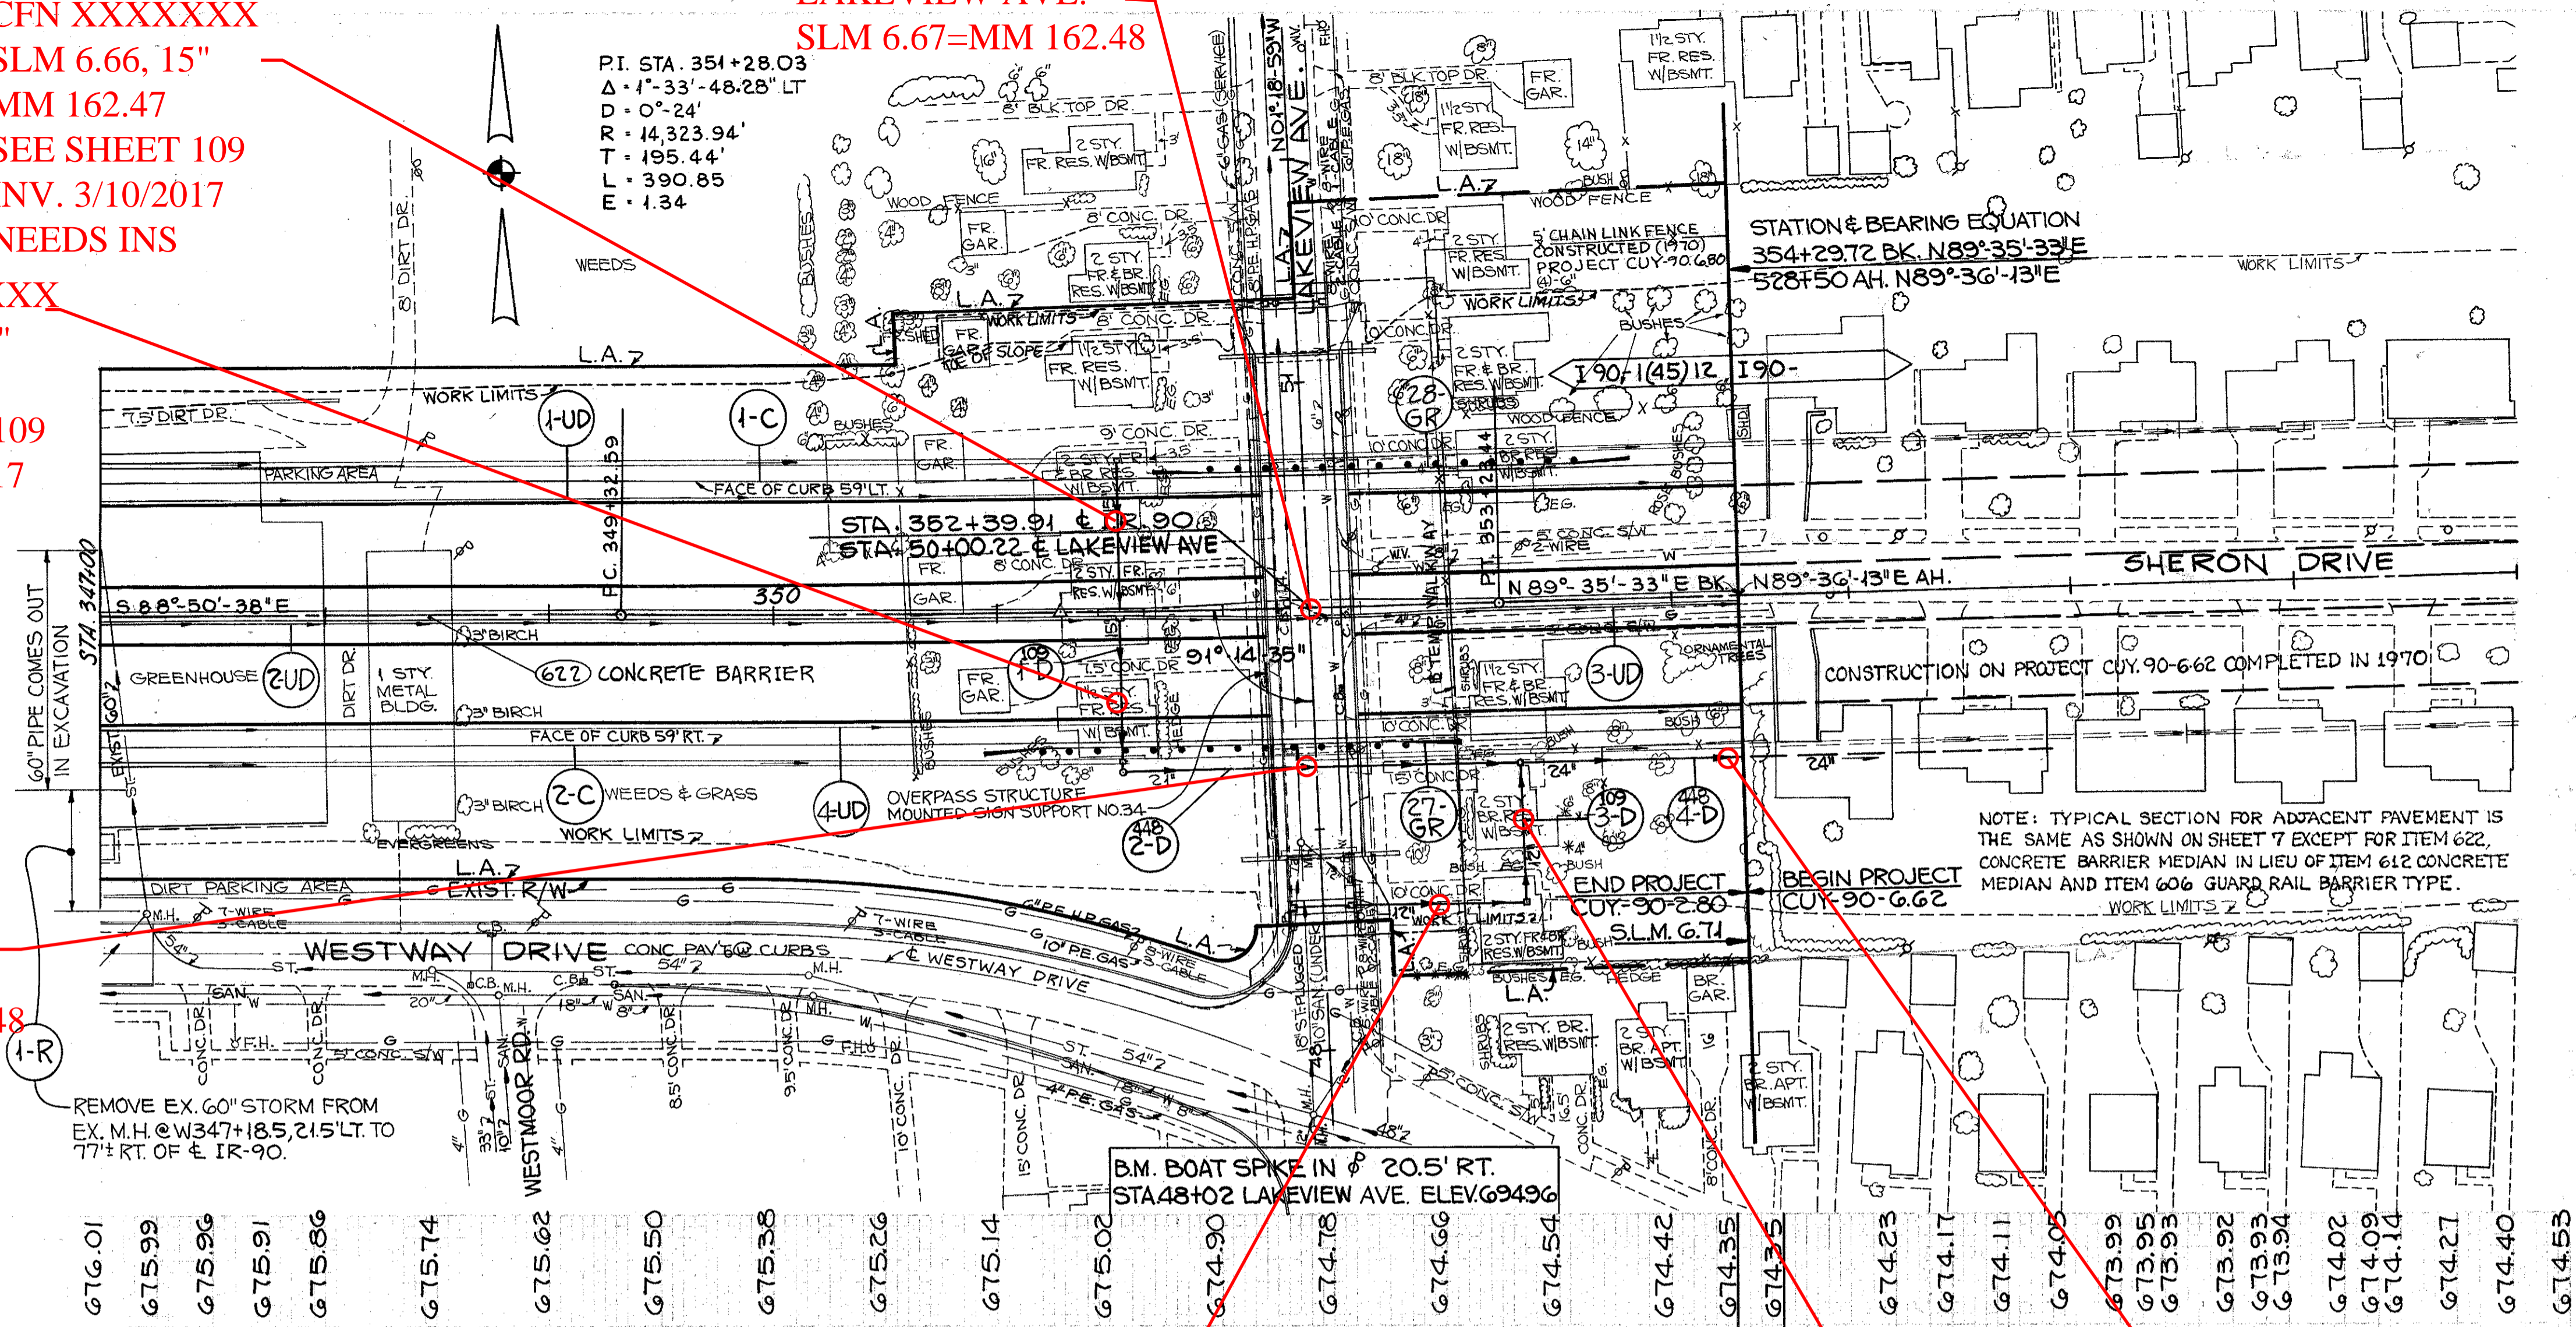


REFERENCE SHEETS	SHEET NOS.
WESTWAY DRIVE	366,367
LAKEVIEW AVENUE	385-388
BRIDGE NO. CUY-90-0667	887-894
WATER LINE WORK	551
TEMPORARY PEDESTRIAN WALKWAY	897
GUARD RAIL SUMMARY	21
CONCRETE BARRIER, DETAILS & SUMMARY	22,25

55  
 966

CUY-90-2.80

QUANTITIES CALC. 7 MAY 1973 J.H.

QUANTITIES CK'D 5-8-73 J.D.

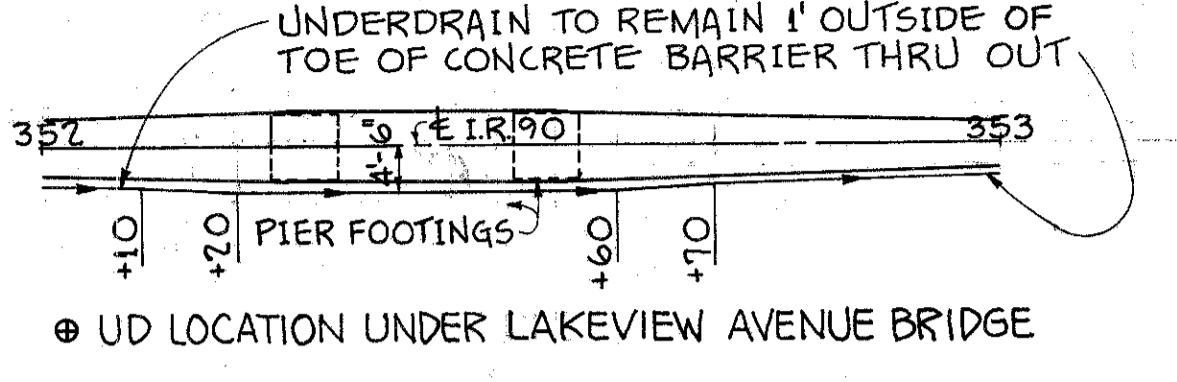

REF.	STATION	605 SHALLOW PIPE UNDER-DRAINS 6"	605 DEEP PIPE UNDER-DRAINS 6"	609 CONCRETE CURB STANDARD TYPE G
		LIN. FT.	LIN. FT.	LIN. FT.
1-UD	347+00 TO 354+29.72, 51' RT.		730	
2-UD	347+00 TO 351+55.91 RT.	455		
3-UD	351+59 TO 354+29.72, 31 RT.	271		
4-UD	347+00 TO 354+29.72, 51' RT.		730	
1-C	347+00 TO 354+29.72 LT.			728.1
2-C	347+00 TO 354+29.72 RT.			731.3
TOTALS		726	1460	1459.4

REF.	STATION	603 CONDUIT TYPE-B	603 CONDUIT TYPE-C	603 CONDUIT TYPE-F	604 CATCH BASINS STD. NO. 2-2-B	604 MANHOLES STD. NO. 1	604 MANHOLES MEDIAN INLET NO. 1-3B	202 PIPE REMOVED OVER 24"
		15" LIN. FT.	15" 21" 24" L.F./L.F.	12" LIN. FT.	EACH	EACH	EACH	LIN. FT.
1-D	351+55.91	129	5					
2-D	351+55.91 TO 353+30 RT.		175					
3-D	353+30 RT.			67	1			
4-D	353+30 TO 354+29.72, 72 RT.		100					
1-R	347+18 RT.							56
TOTALS		129	175	67	3	2	1	56

STA. 347+00 TO STA. 354+29.72