
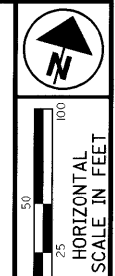


I:\PROJECTS\1738\1738.dgn\final\plans\1738GPO.DGN 09-AUG-2000 3:36PM jgrmovse

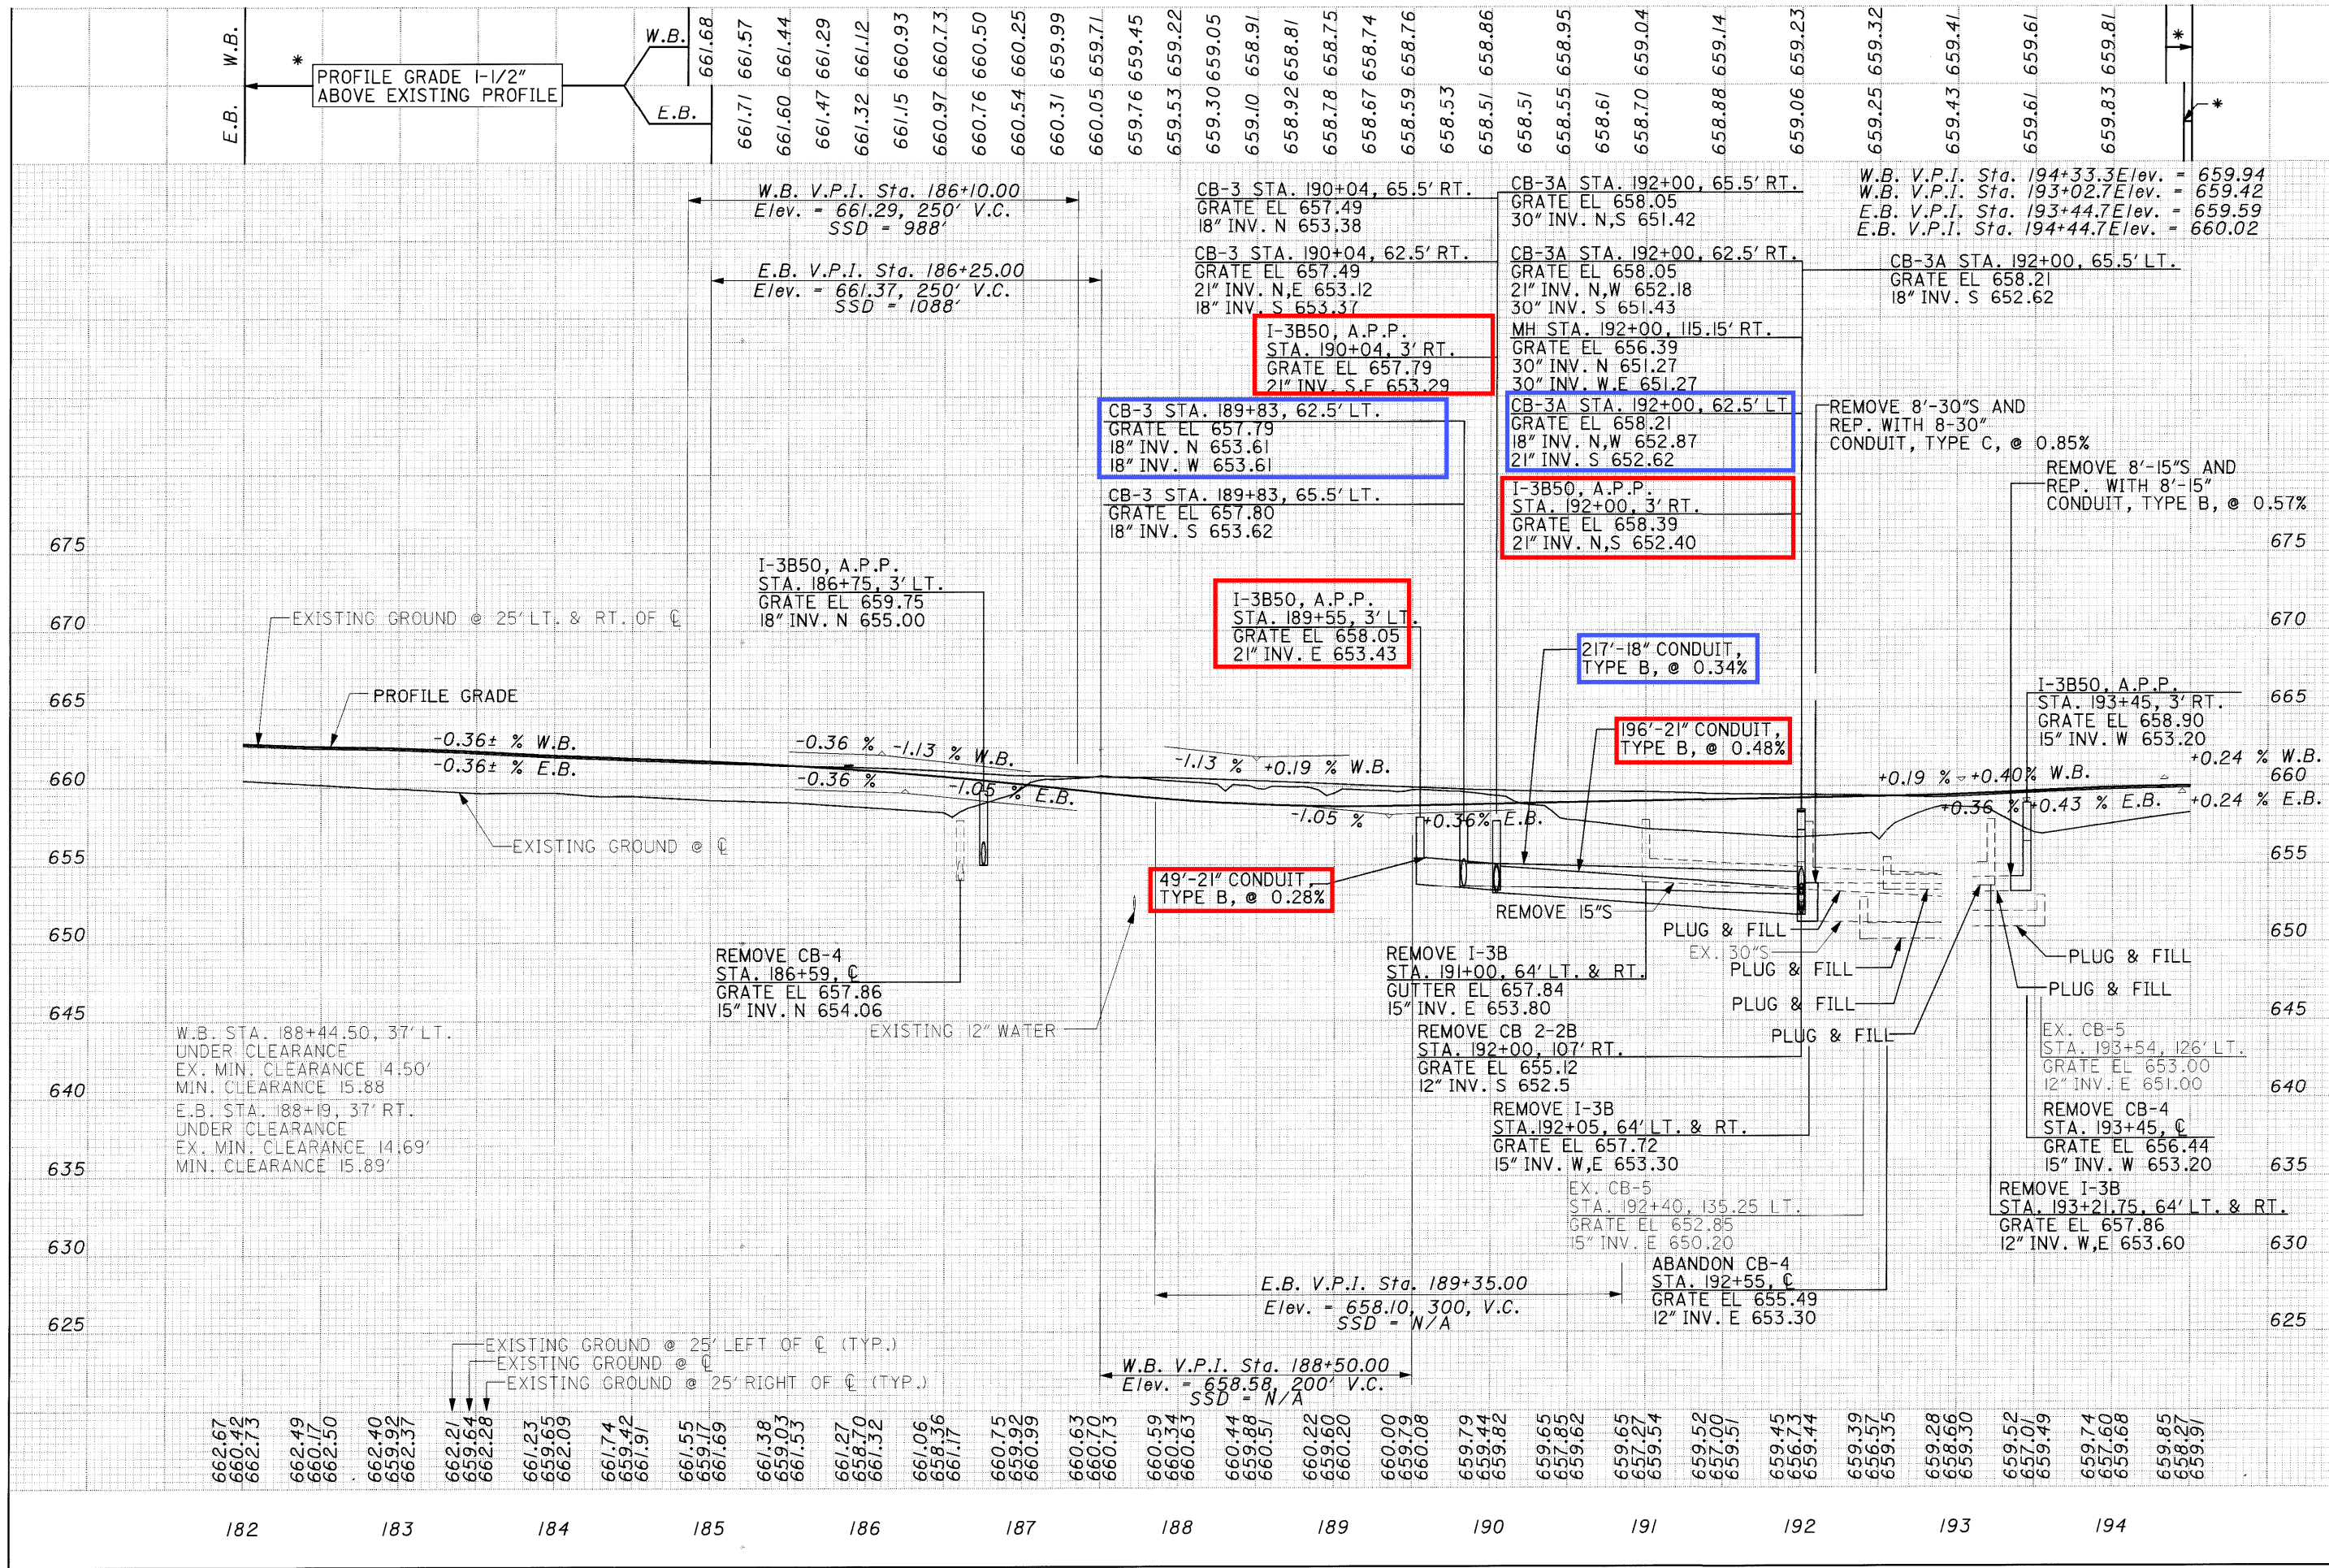

CALCULATED  
CHECKED

PLAN AND PROFILE  
STA 182+00 TO STA 194+50

CUY-90-0.00