

old CFN 43090370
new CFN 1804051
SLM 3.68, 36"
SEE SHEET 267
AND BELOW

CFN 1971961
SLM 3.70, 15"
SEE SHEET 69

MAPLEGROVE RD
SLM 3.77, MM 189.78

LOW PRIORITY OUTFALL
LAK1003L, 18"
SLM 3.80

CFN 1971973
SLM 3.83, 18"
SEE SHEET 81
SEE 1993 SHEET 47

FED. RD. DIVISION	STATE	PROJECT	23 312
2	OHIO	I-1103 (19)	


LAKE COUNTY
LAK-1-2.16

CFN 1971976
SLM 3.66, 30"
SEE SHEET 69
SEE 1993 SHEET 47

SLM 3.66, 21"
SEE SHEET 69
REMOVED IN 1993

SFN 4303601
SLM 3.65, SEE
SHEET 267


CFN 1971969
SLM 3.63, 15"
SEE SHEET 68

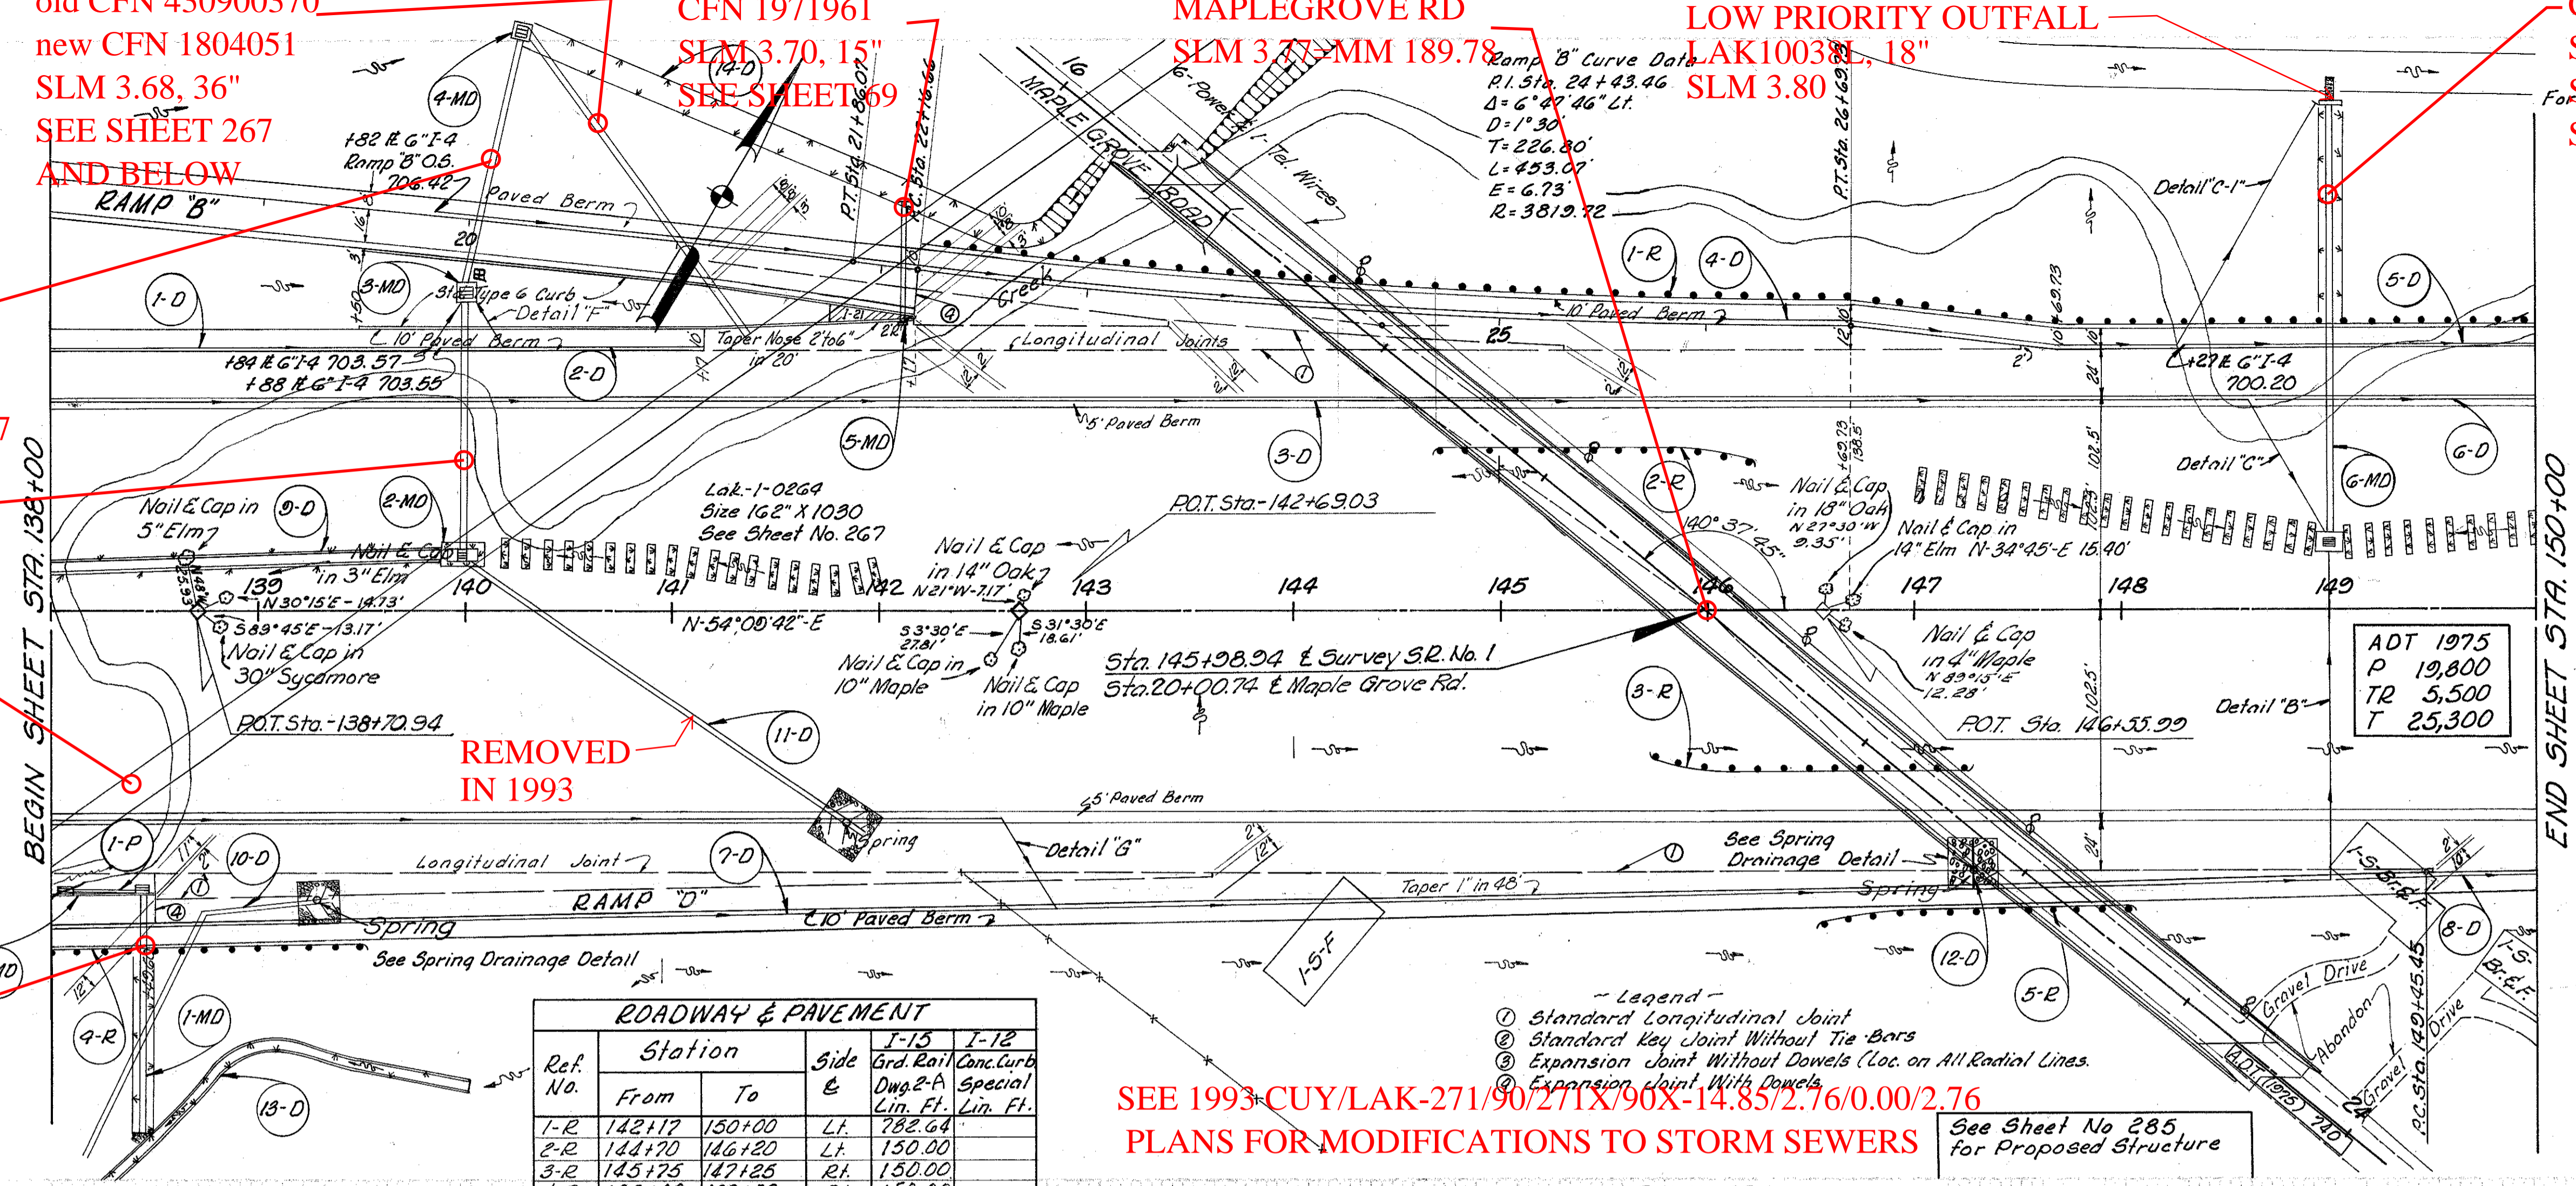

Ref. No.	Station		Side	I-15	
	From	To		Grd. Rail Conc. Curb	Special Lin. Ft.
1-R	142+17	150+00	Lt.	782.64	
2-R	144+70	146+20	Lt.	150.00	
3-R	145+75	147+25	Rt.	150.00	
4-R	138+100	139+50	Rt.	150.00	
5-R	146+55	148+05	Rt.	150.00	
1-P	138+00	138+49.60	Rt.	49.60	
Totals				1382.64	49.60

SEE 1993 CUY/LAK-271/90/271X/90X-14.85/2.76/0.00/2.76
PLANS FOR MODIFICATIONS TO STORM SEWERS

See Sheet No 285 for Proposed Structure

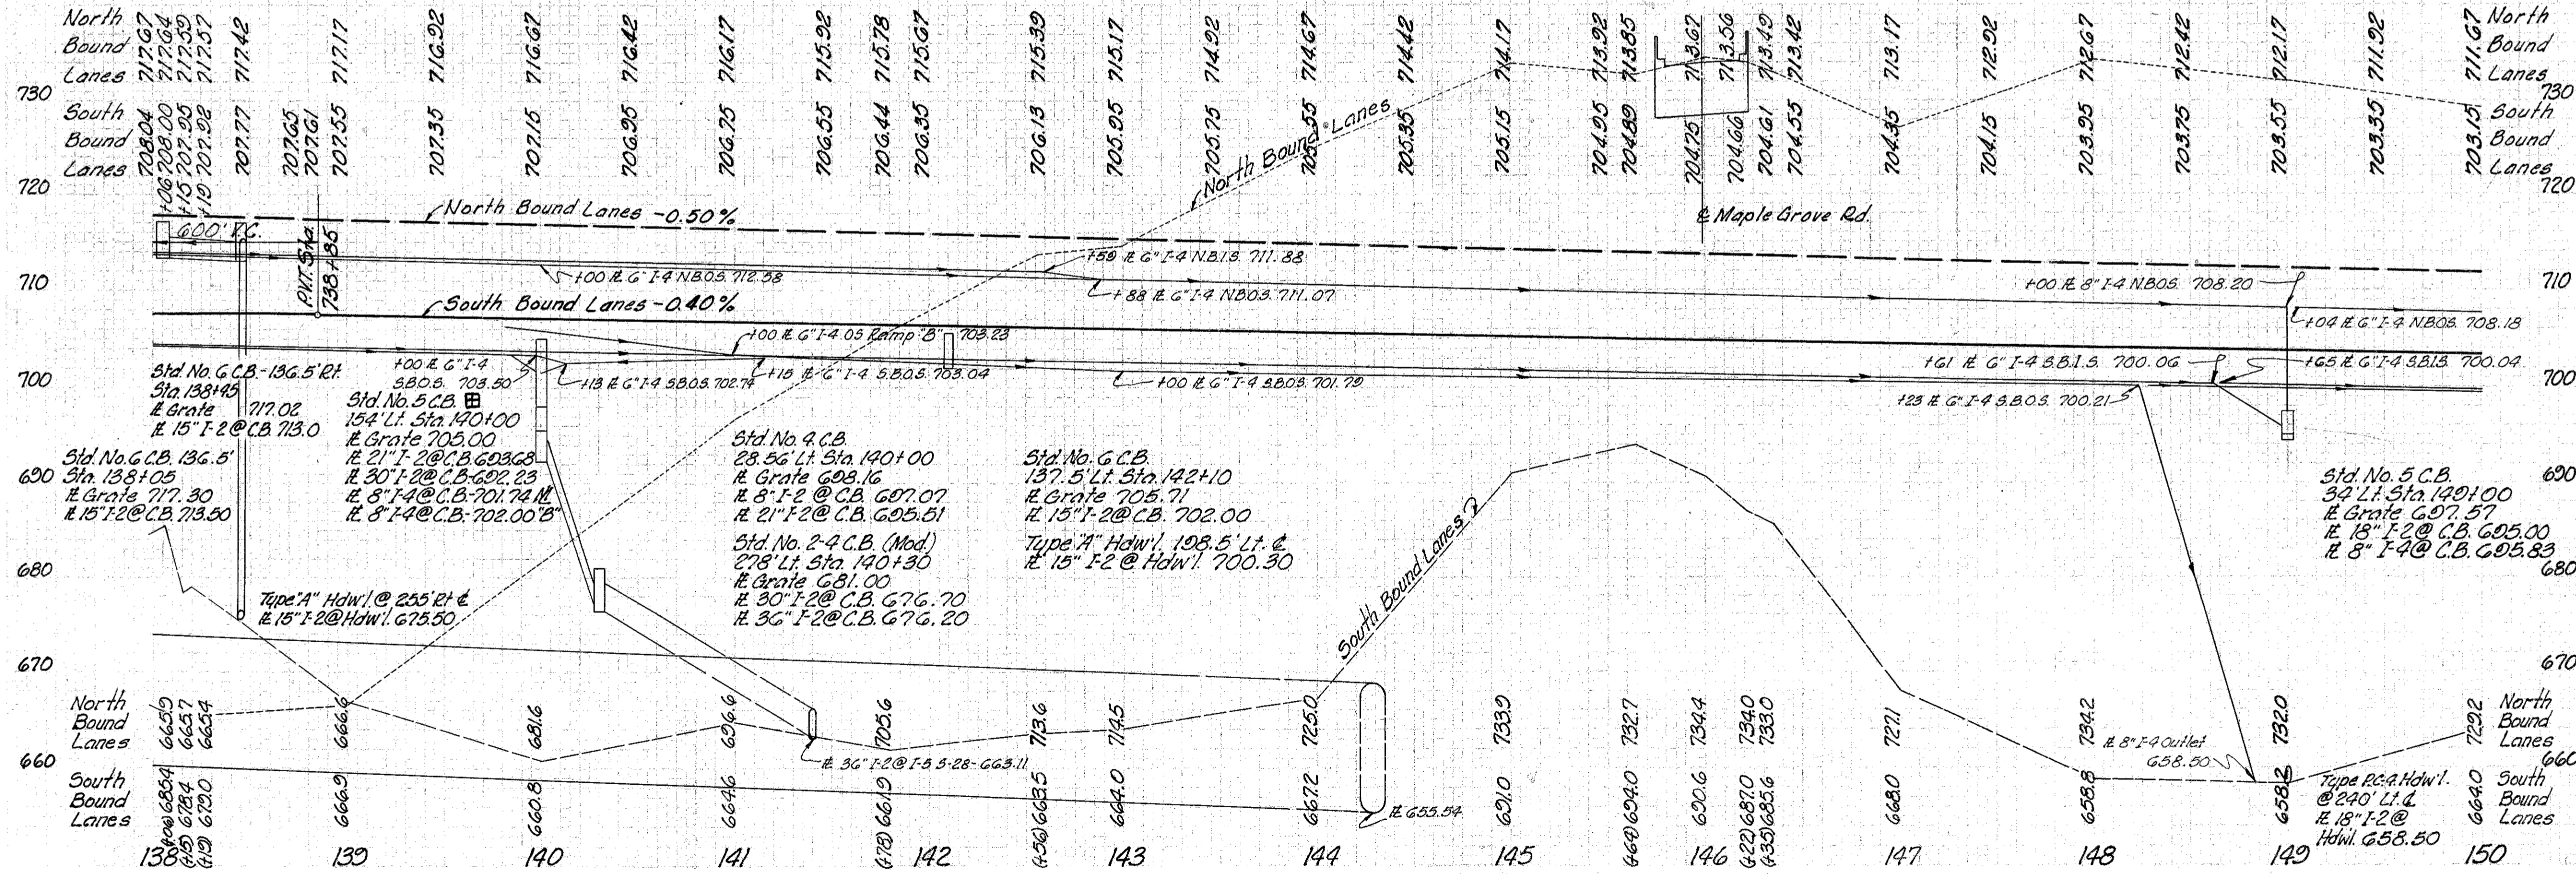

Station	From	To	Material	Quantity	Unit	Notes
Subbase	138+00	138+45	Subbase	100	cu yd	
	138+45	140+00	Subbase	100	cu yd	
	140+00	140+30	Subbase	100	cu yd	
	140+30	140+60	Subbase	100	cu yd	
	140+60	141+00	Subbase	100	cu yd	
	141+00	141+30	Subbase	100	cu yd	
	141+30	141+60	Subbase	100	cu yd	
	141+60	142+00	Subbase	100	cu yd	
	142+00	142+30	Subbase	100	cu yd	
	142+30	142+60	Subbase	100	cu yd	
Excavation for Storm Sewer	138+00	138+45	Excavation	100	cu yd	
	138+45	140+00	Excavation	100	cu yd	
	140+00	140+30	Excavation	100	cu yd	
	140+30	140+60	Excavation	100	cu yd	
	140+60	141+00	Excavation	100	cu yd	
	141+00	141+30	Excavation	100	cu yd	
	141+30	141+60	Excavation	100	cu yd	
	141+60	142+00	Excavation	100	cu yd	
	142+00	142+30	Excavation	100	cu yd	
	142+30	142+60	Excavation	100	cu yd	
Storm Sewer	138+00	138+45	Storm Sewer	100	lin. ft.	
	138+45	140+00	Storm Sewer	100	lin. ft.	
	140+00	140+30	Storm Sewer	100	lin. ft.	
	140+30	140+60	Storm Sewer	100	lin. ft.	
	140+60	141+00	Storm Sewer	100	lin. ft.	
	141+00	141+30	Storm Sewer	100	lin. ft.	
	141+30	141+60	Storm Sewer	100	lin. ft.	
	141+60	142+00	Storm Sewer	100	lin. ft.	
	142+00	142+30	Storm Sewer	100	lin. ft.	
	142+30	142+60	Storm Sewer	100	lin. ft.	

MICHAEL BAKER JR., CONSULTING ENGINEERS
ROCHESTER, PENNSYLVANIA

STATE OF OHIO
DEPARTMENT OF HIGHWAYS
STATE HIGHWAY NO. 1
C-43
PLAN AND PROFILE
STA. 138+00 TO STA. 150+00

Designed	Drawn	Traced	Checked	Reviewed	Date	Revised
B.P.	A.L.H.	K.L.G.	REF.			

PLAN & PROFILE STA. 138+00 TO STA. 150+00