


CUYAHOGA COUNTY  
CUY-480-8.54

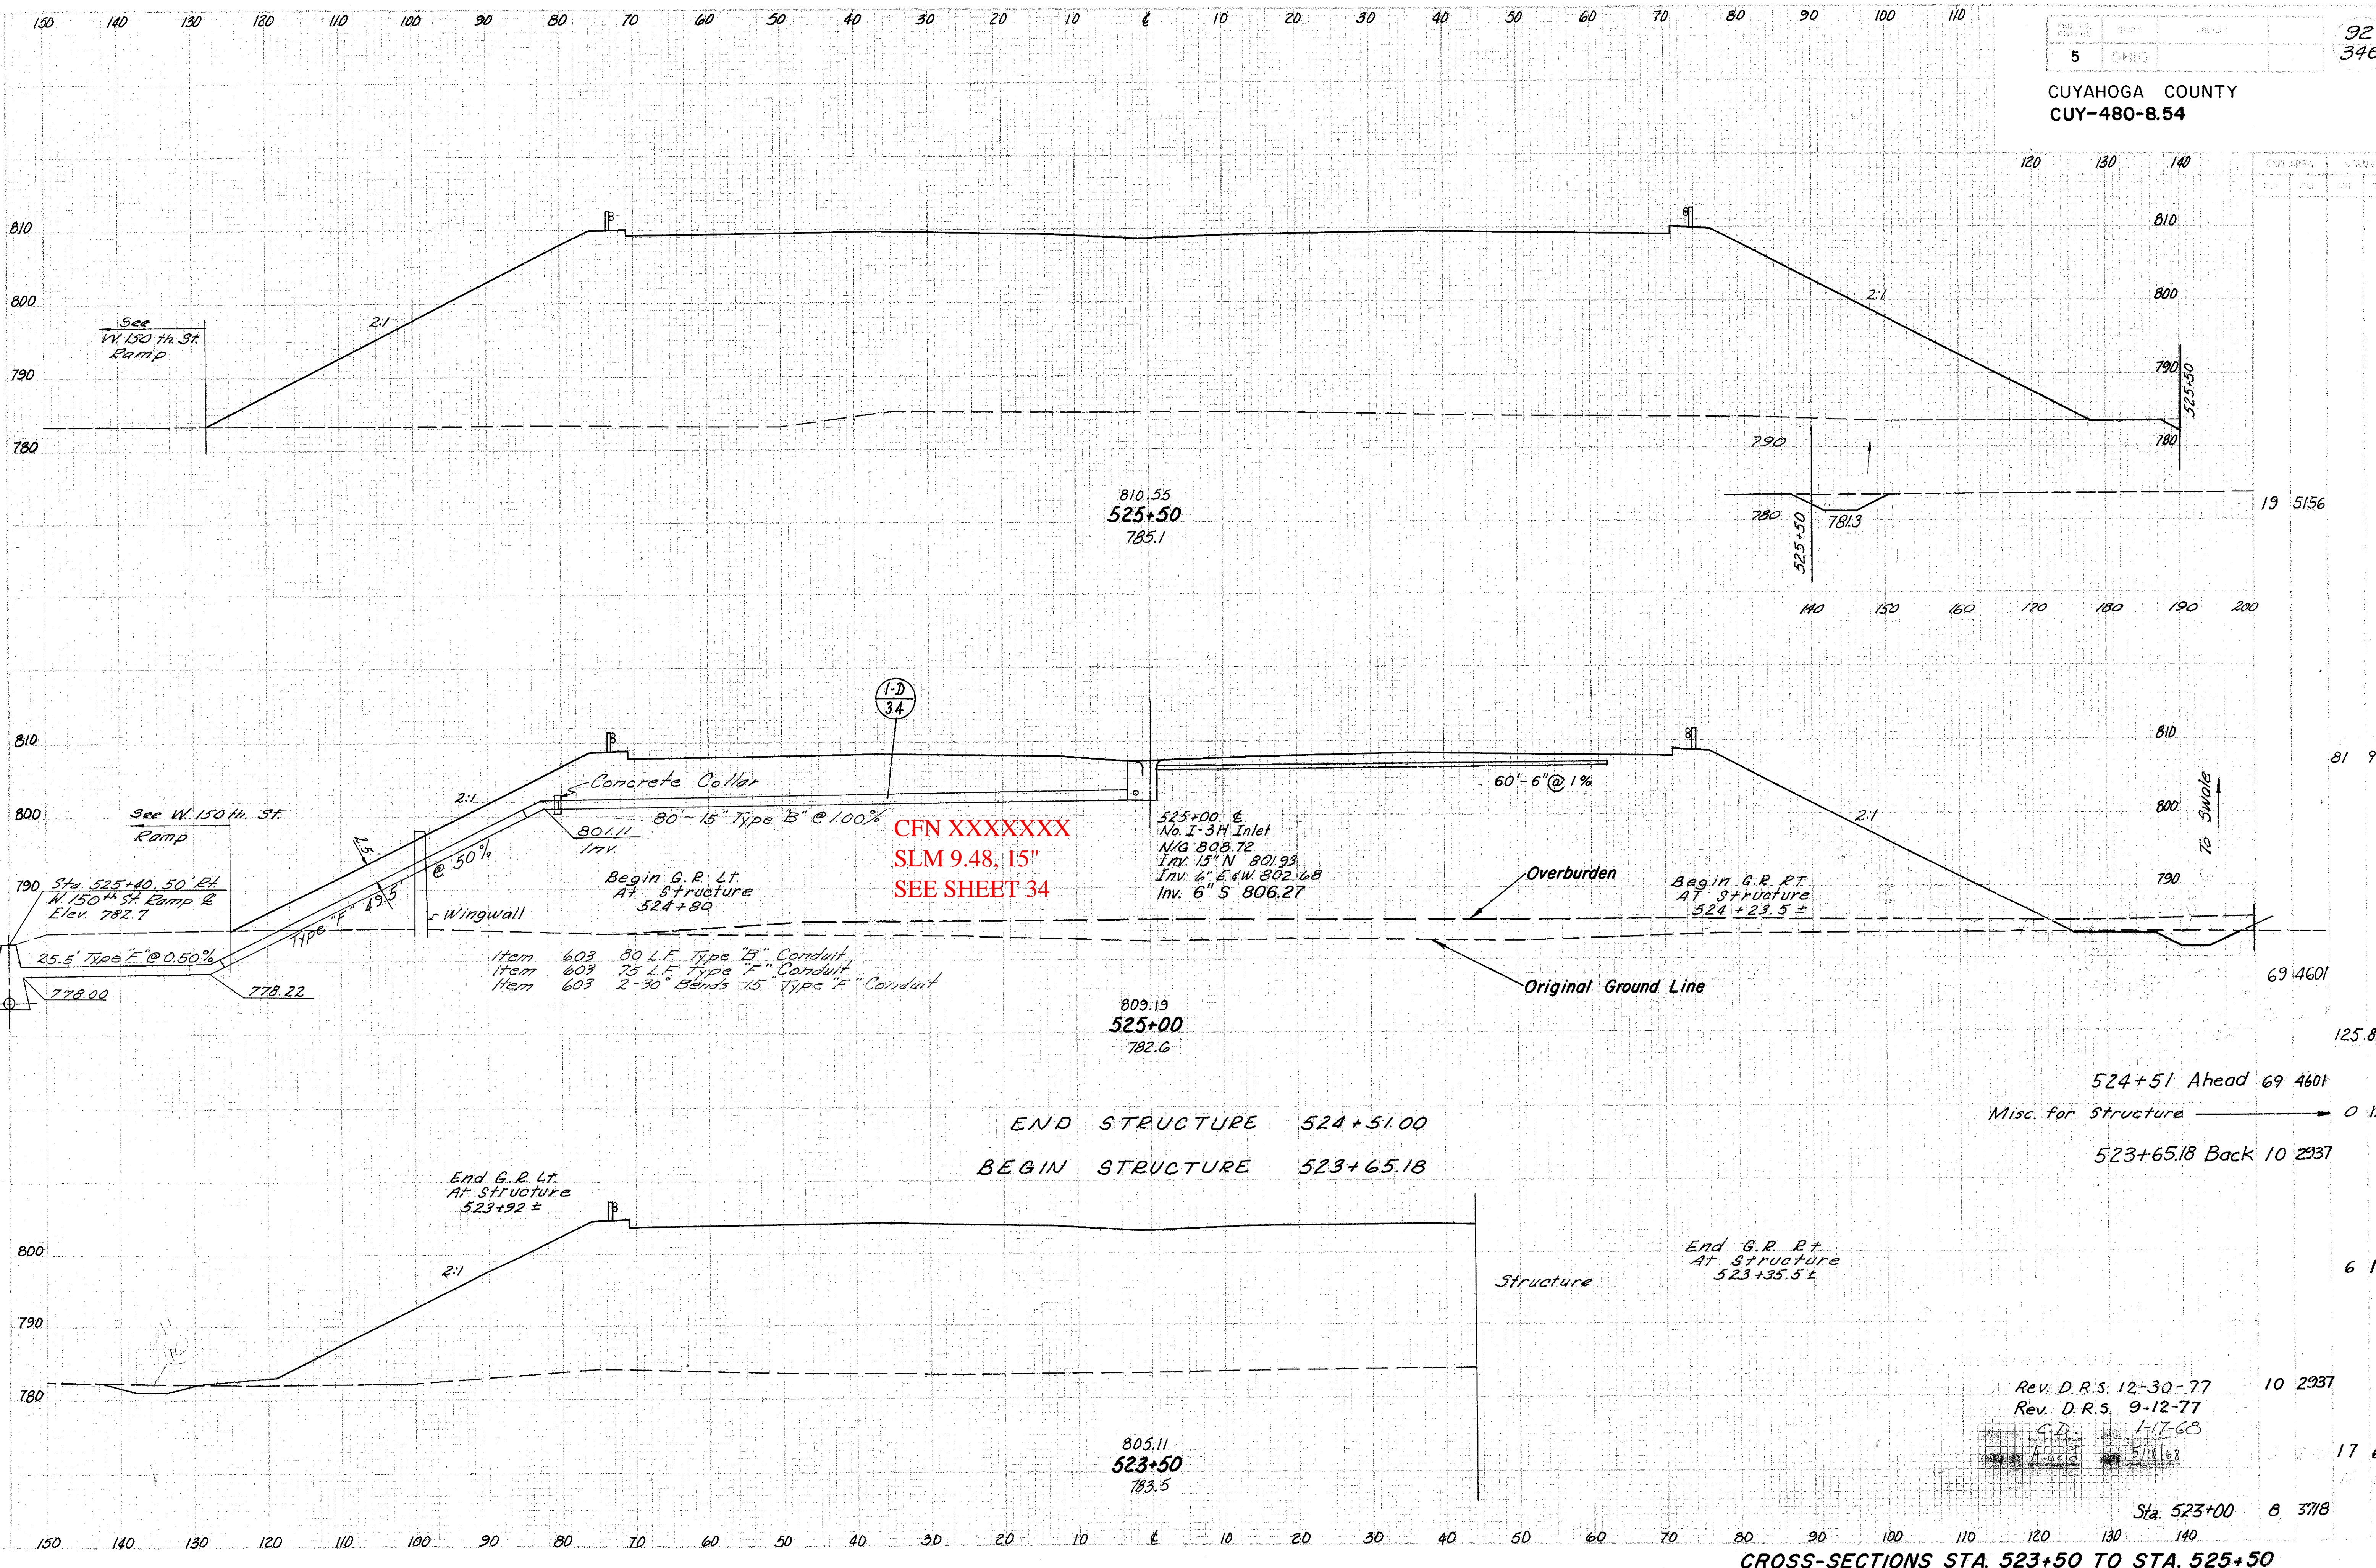

CFN XXXXXXXX  
SLM 9.48, 15"  
SEE SHEET 34

- Item 603 80 L.F. Type "B" Conduit
- Item 603 75 L.F. Type "F" Conduit
- Item 603 2-90 Bends 15" Type "F" Conduit

END STRUCTURE 524+51.00  
BEGIN STRUCTURE 523+65.18

524+51 Ahead 69 4601  
Misc. for Structure → 0 12459  
523+65.18 Back 10 2937

Rev. D.R.S. 12-30-77 10 2937  
Rev. D.R.S. 9-12-77  
C.D. 1-17-68  
Add 5/11/68 17 6162

Sta. 523+00 8 3718

CROSS-SECTIONS STA. 523+50 TO STA. 525+50