


CUYAHOGA COUNTY
CITY OF CLEVELAND
MEDINA-CLARK INTERCHANGE
CUY-71-18.54
CUY-90-13.81

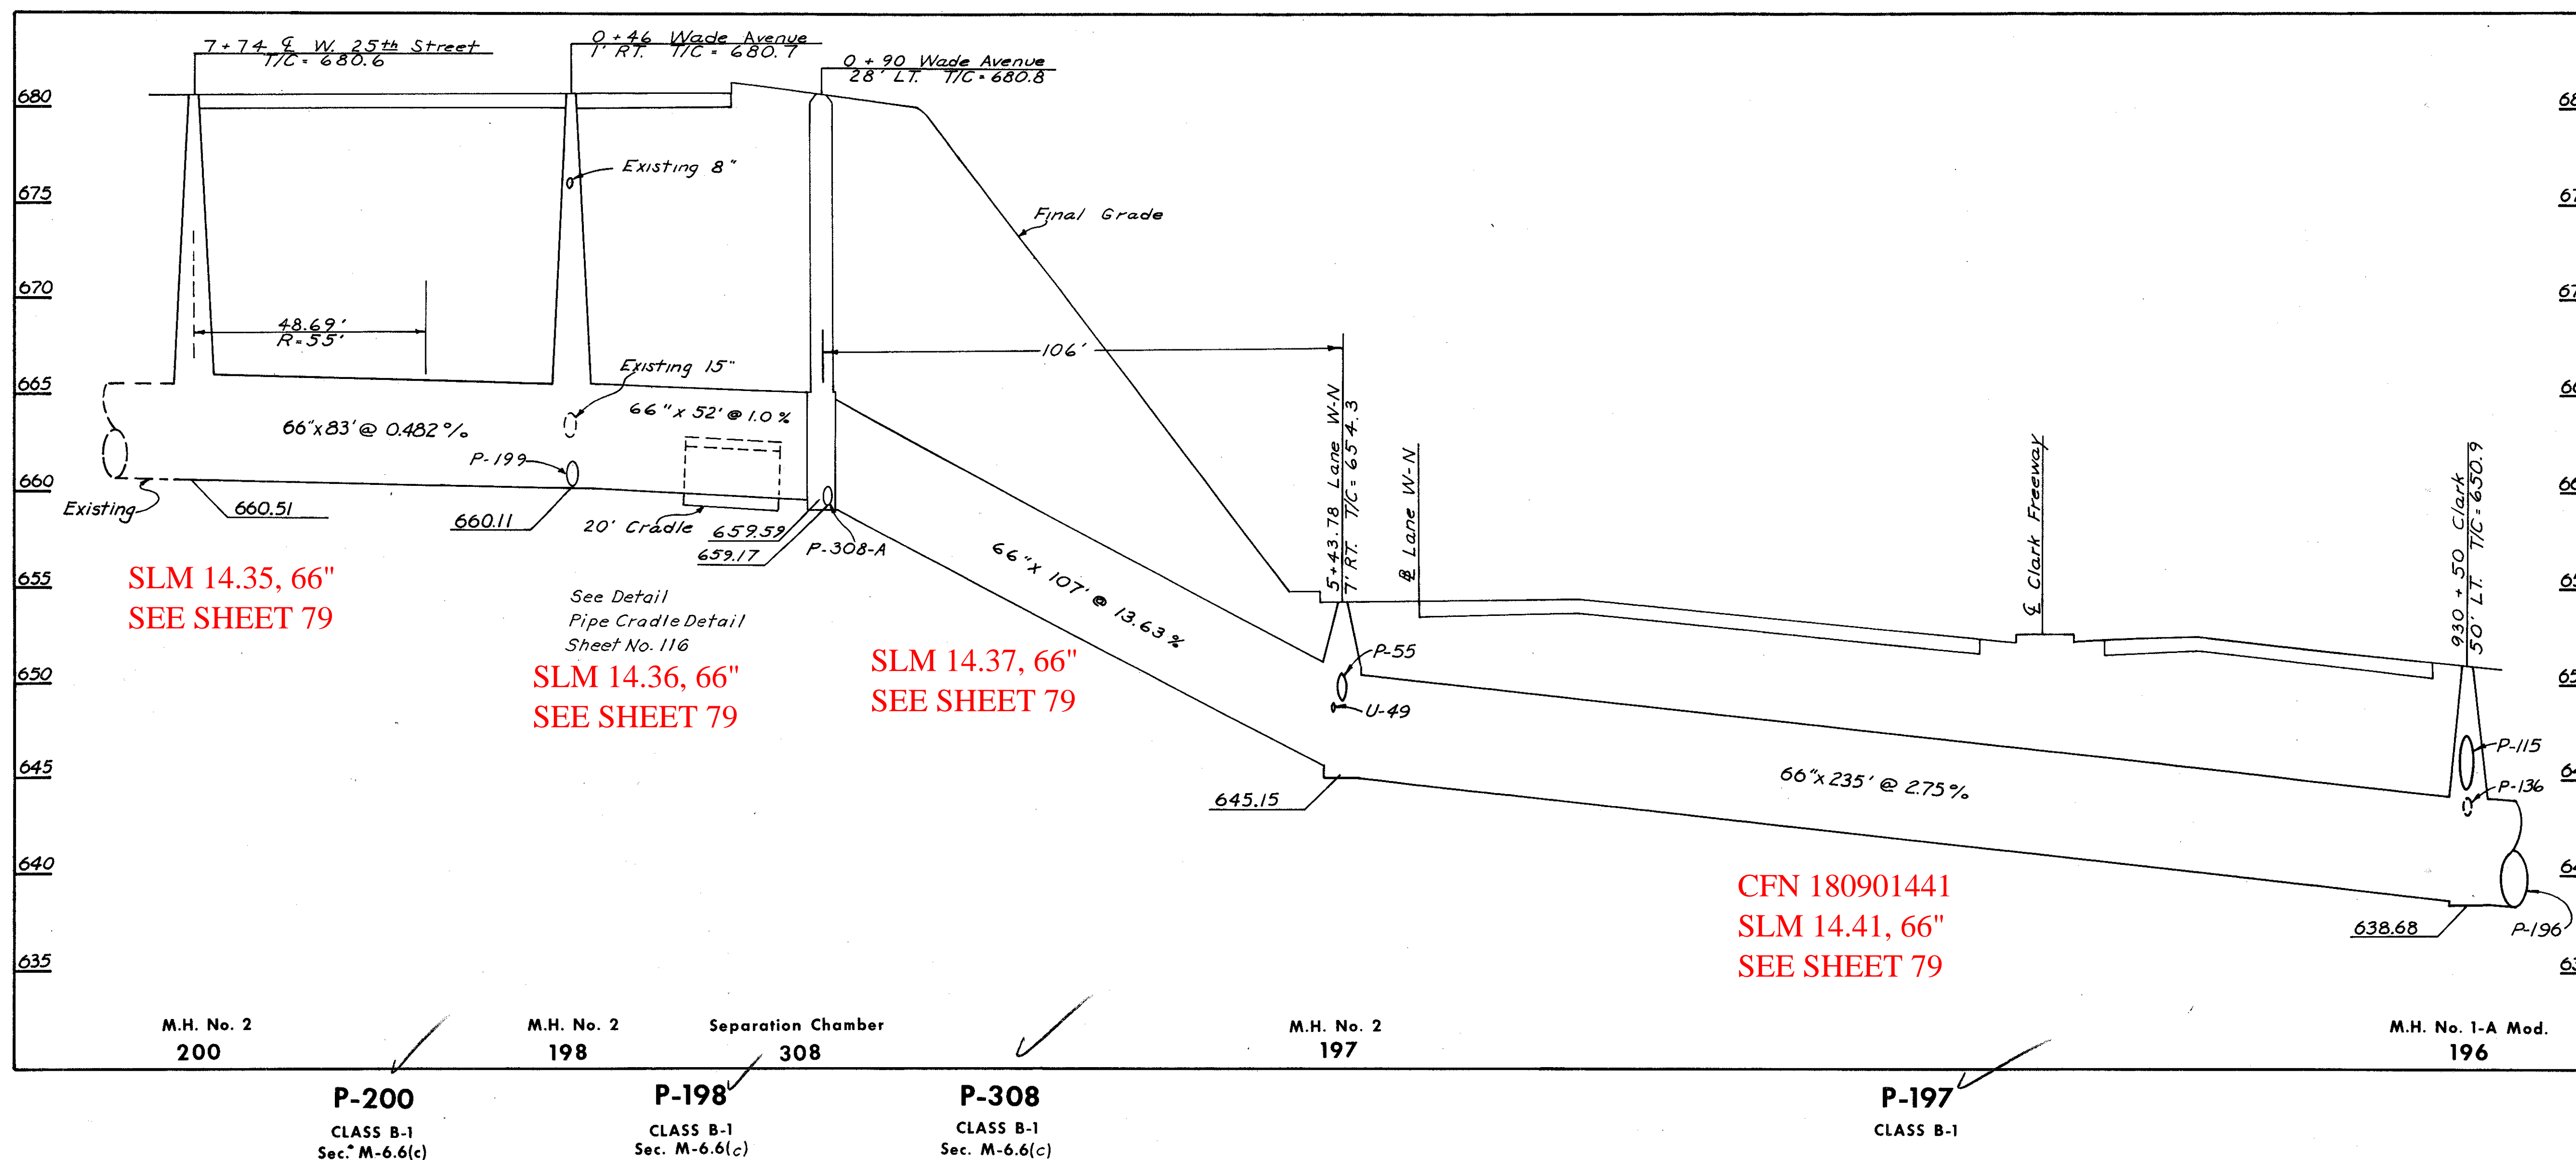

ESTIMATED QUANTITIES

I-B STRUCTURES			
CODE	LOCATION	w/o Drop Pipe M.H. No. 2	
198	0+46 Wade Avenue 1' RT.	1	
200	7+74 W. 25th Street &	1	
CUY-71-18.54 TOTALS			2

CODE	ROADWAY	INLET CODE		I-1 PIPE		
		FROM	TO	CLASS B-1	CLASS B-1	CLASS B-1
				66"	CLASS B-1 Sec. M-6.6(c) 66" R-35'	CLASS B-1 Sec. M-6.6(c) 66"
P-197	LANE W-N *	197	196	235'*		
P-198	Wade Ave.	198	308			52'
P-200	W. 25th St	200	198		49'	34'
P-308	Wade Ave.	308	197			107'
CUY-71-18.54 TOTALS					49'	193'
CUY-90-13.81 TOTALS				235'*		173'

MASONRY
Item
I-2
MASONRY C.Y.
9
9