



CUYAHOGA COUNTY  
CITY OF CLEVELAND  
**MEDINA-CLARK INTERCHANGE**  
CUY-71-18.54  
CUY-90-13.81

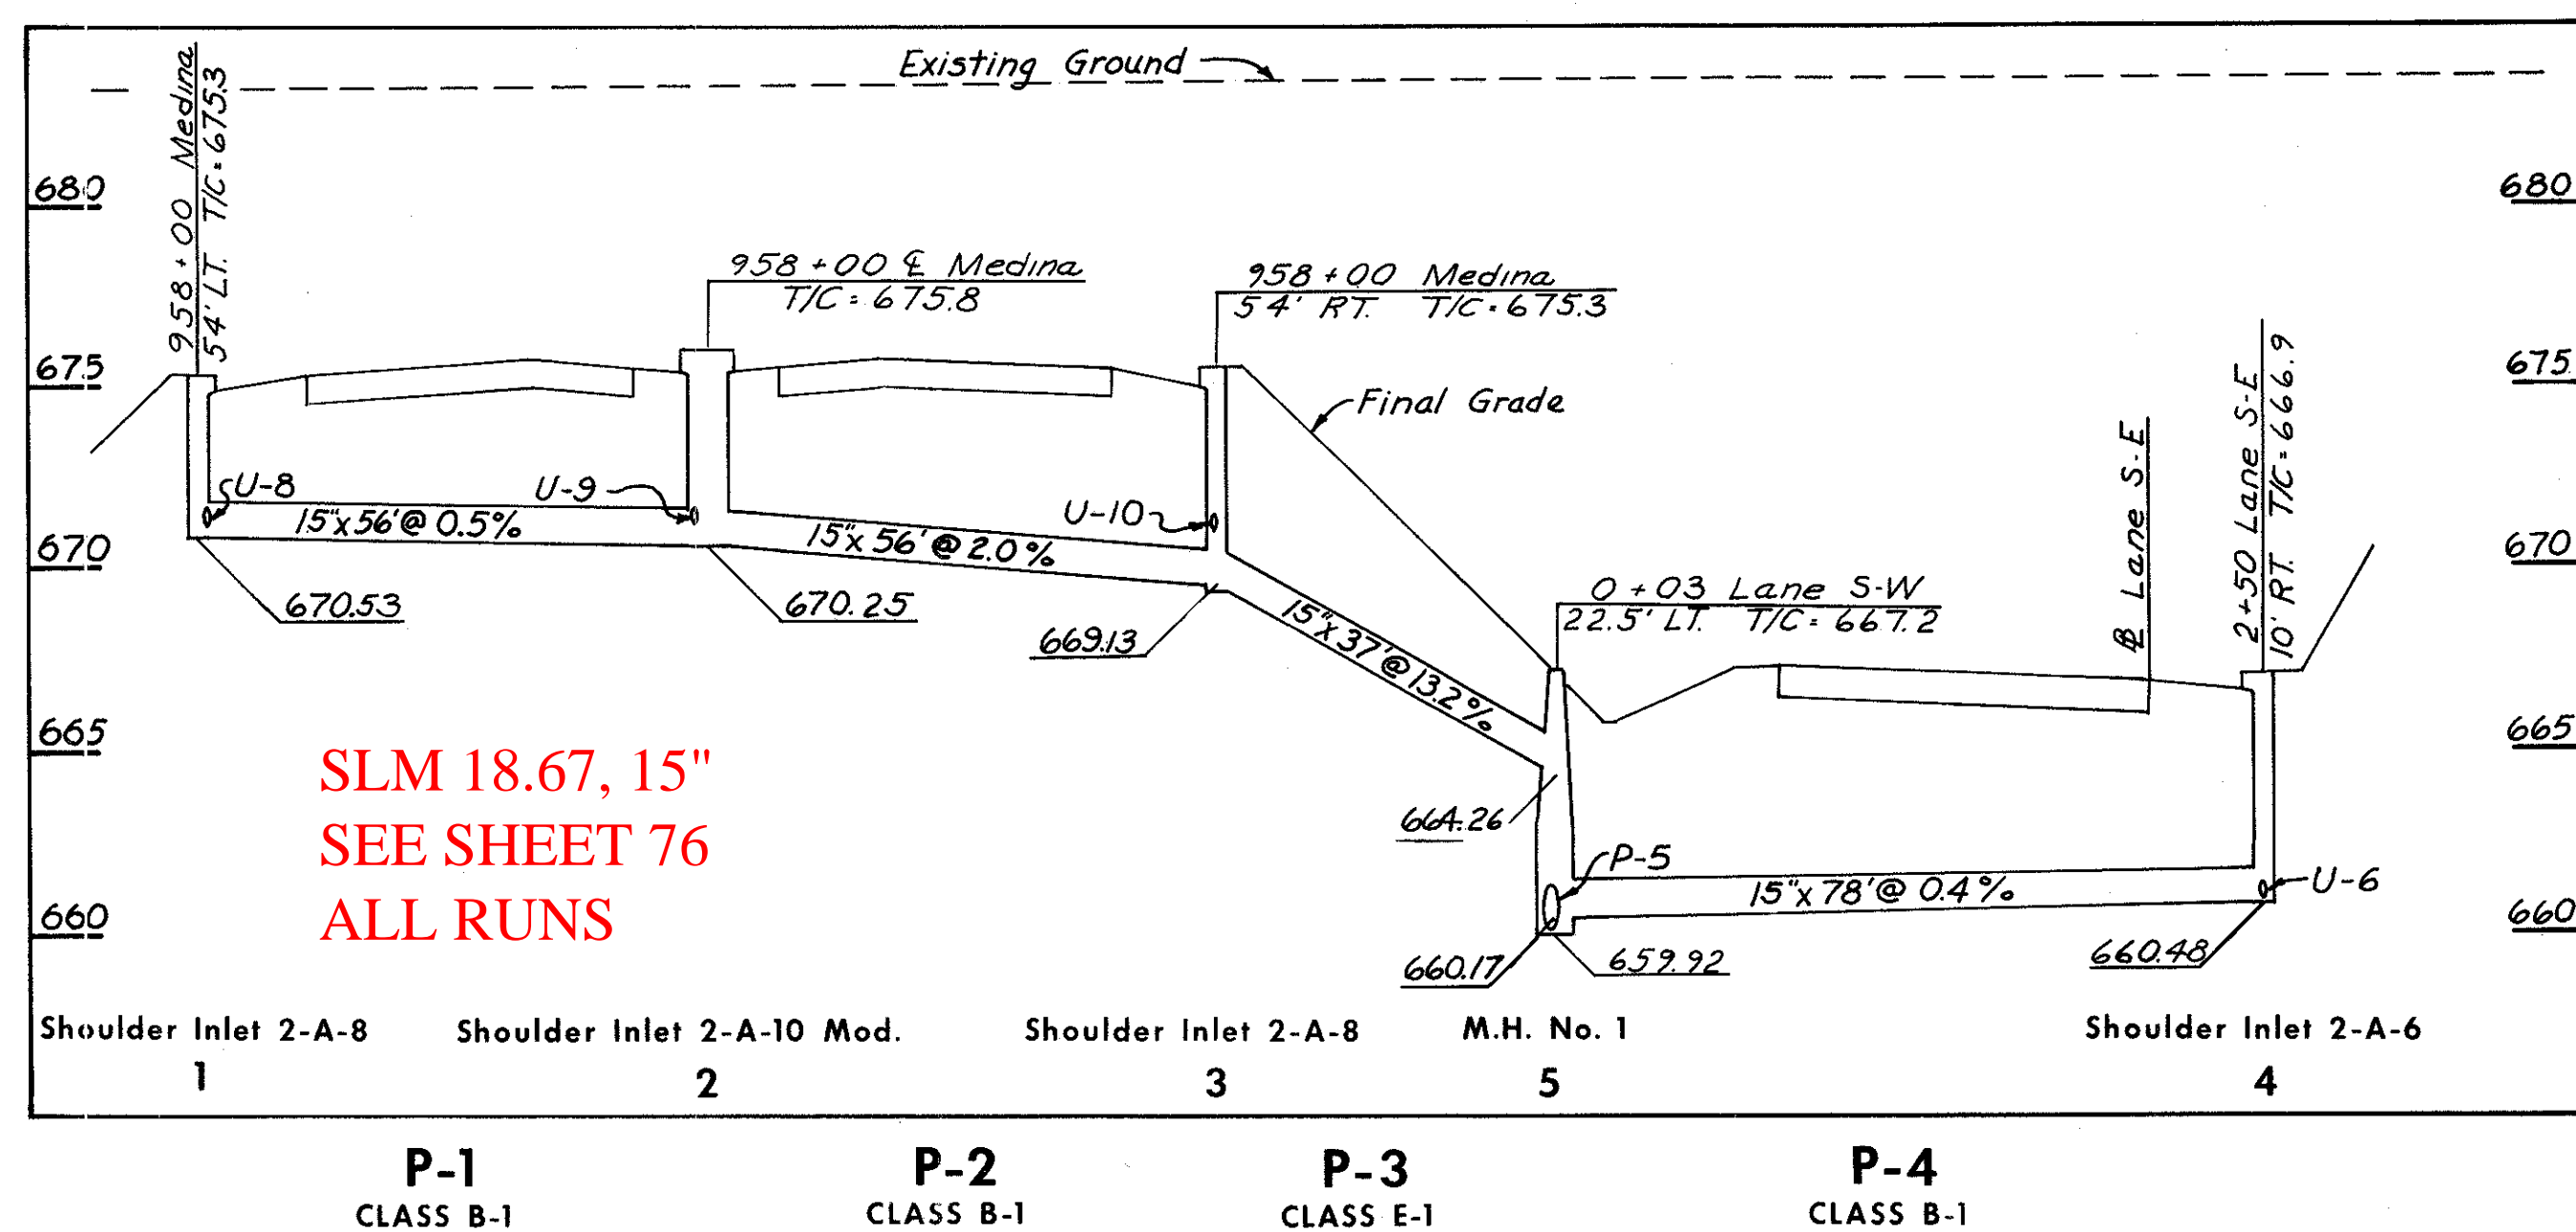

**ESTIMATED QUANTITIES**

		I-B STRUCTURES										
CODE	LOCATION	Shoulder Inlet	Shoulder Inlet	Shoulder Inlet	Shoulder Inlet	Shoulder Inlet	Shoulder Inlet	Shoulder Inlet	C.B. 5 Mod.	M.H. No. 1	M.H. No. 2 with Drop	
		2-A-6	2-A-8	2-A-8 Mod.	2-A-10	2-A-10 Mod.	2-A-12	2-A-14				
1	958+00 Medina Freeway 54' LT.		1									
2	958+00 Medina Freeway 5'					1						
3	958+00 Medina Freeway 54' RT.		1									
4	2+50 Lane S-E 10' RT.	1										
5	0+03 Lane S-W 22.5' LT.									1		
6	963+00 Medina Freeway 54' LT.							1				
7	963+00 Medina Freeway 5'			1								
8	963+00 Medina Freeway 54' RT.				1							
9	8+00 Lane S-E 10' RT.								1			
10	5+07 Lane S-W 24' LT.										1	
11	9+00 Lane S-W 18' LT.									1		
12	9+00 Lane S-W 6.5' LT.										1	
13	10+97 Lane S-W 4' LT.	1										
14	10+35 Lane S-W 4' LT.	1										
15	10+50 Lane S-W 43' RT.								1			
16	10+50 Lane S-W 55' RT.									1		
CUY-71-18.54 TOTALS		3	2	1	1	1	1	1	2	3	1	

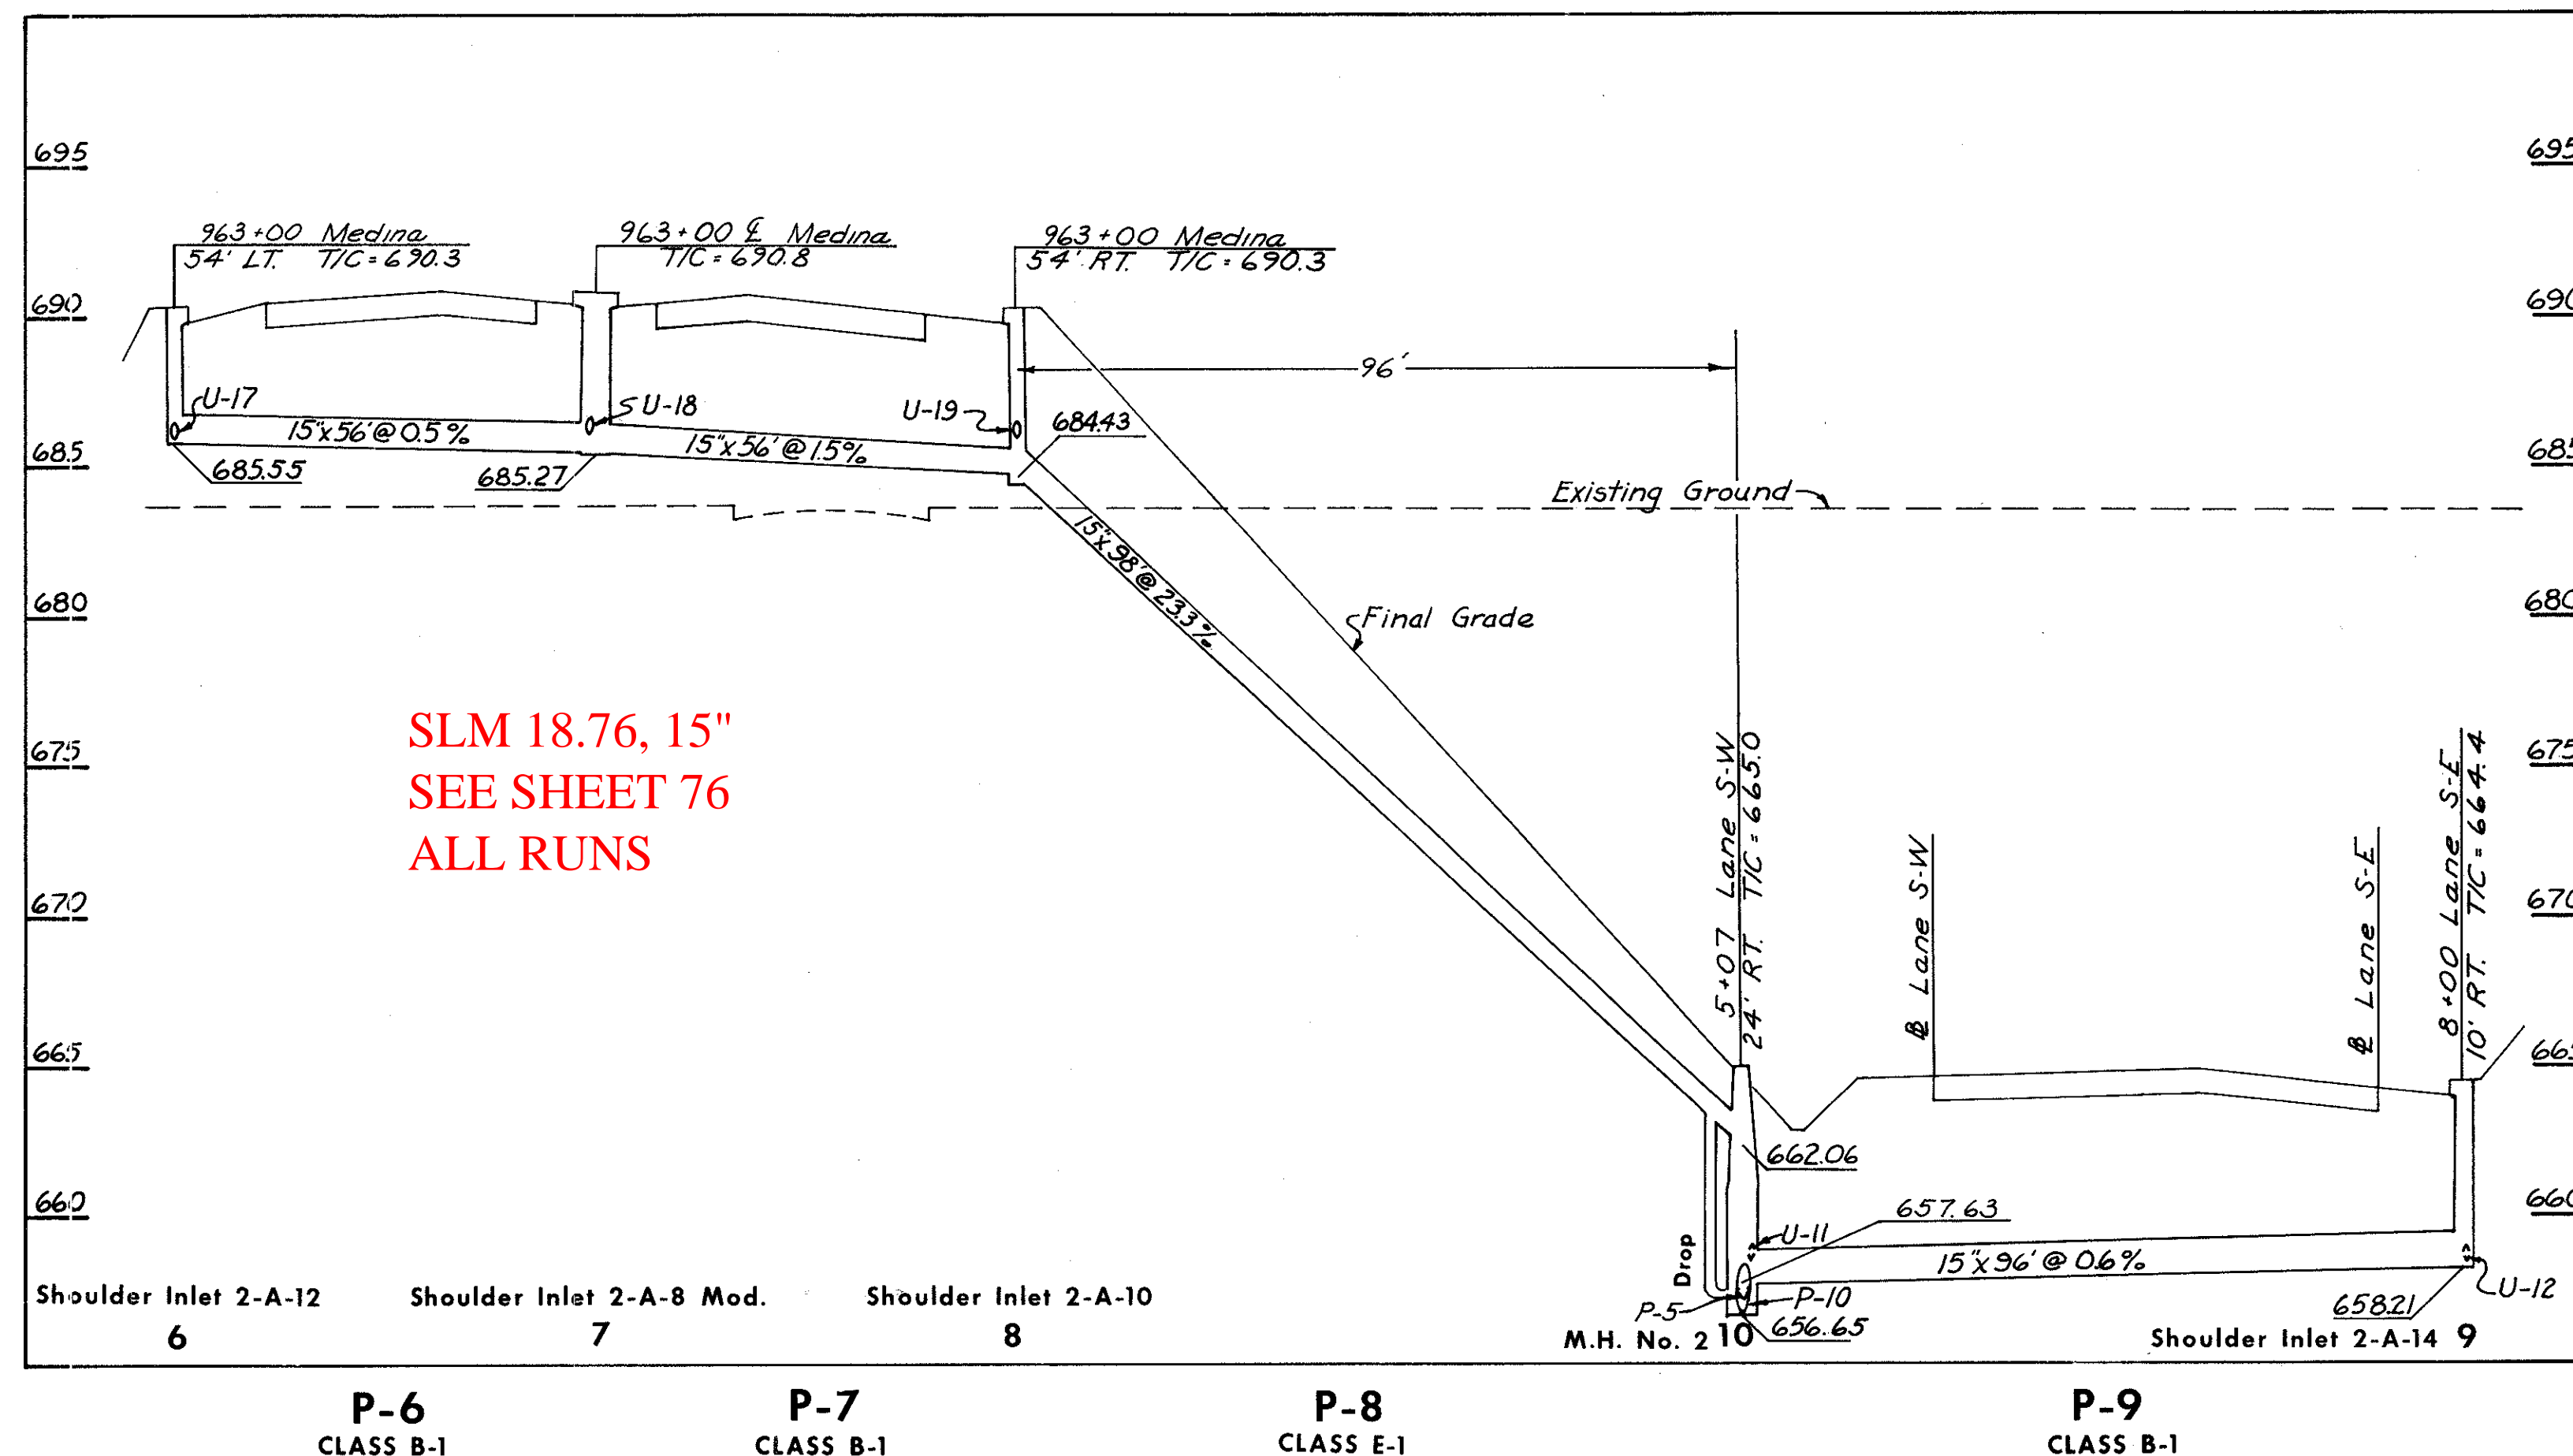

CODE	ROADWAY	INLET CODE		I-1 PIPE		
		FROM	TO	CLASS B-1	CLASS E-1	CLASS E-1
				15"	12"	15"
P-1	Medina Freeway	1	2	56'		
P-2	Medina Freeway	2	3	56'		
P-3	Medina Freeway	3	5			37'
P-4	LANE S-E	4	5	78'		
P-6	Medina Freeway	6	7	56'		
P-7	Medina Freeway	7	8	56'		
P-8	Medina Freeway	8	10			98'
P-9	LANE S-E	9	10	96'		
P-11	LANE S-W	11	12			12'
P-13	LANE S-W	13	14		62'	
P-14	LANE S-W	14	15	52'		
P-15	LANE S-W	15	16			14'
CUY-71-18.54 TOTALS				450	62'	161'

SLM 0.24, 12"  
SEE SHEET 80

