

BU-25 - E 89TH ST PEDESTRIAN BRIDGE
...\\BU-25\\96833_GTO25.dgn 11/19/2019 6:11:04 AM Julia_Hart



LOCATION MAP

LATITUDE: 41°29'08" LONGITUDE: 81°37'22"



PORTION TO BE IMPROVED	
INTERSTATE HIGHWAY	
FEDERAL ROUTES	
STATE ROUTES	
COUNTY & TOWNSHIP ROADS	
OTHER ROADS	

DESIGN DESIGNATION

CURRENT ADT (2017)	35,820
DESIGN YEAR ADT (2020)	48,230
DESIGN HOURLY VOLUME (2020)	3,580
DIRECTIONAL DISTRIBUTION	58%
TRUCKS (24 HOUR B&C)	6%
DESIGN SPEED	40 MPH
LEGAL SPEED	35 MPH
DESIGN FUNCTIONAL CLASSIFICATION	URBAN PRINCIPAL ARTERIAL
NHS PROJECT	NO

DESIGN EXCEPTIONS

NONE

UNDERGROUND UTILITIES
CONTACT BOTH SERVICES TWO WORKING DAYS BEFORE YOU DIG.

Ohio Utilities Protection SERVICE
Call Before You Dig
1-800-362-2764
(Non-members must be called directly)

OIL & GAS PRODUCERS UNDERGROUND PROTECTION SERVICE
1-800-925-0988



ENGINEERS SEAL:

SIGNED: *Julia A. Hart*
DATE: 9/30/19

ENGINEERS SEAL:

SIGNED: _____
DATE: _____

INDEX OF SHEETS:
SEE SHEET 2

BU-25
E 89TH ST
PEDESTRIAN BRIDGE

PLAN PREPARED BY:

2LMN, Inc.
2475 Sugar Grove Rd., SE Lancaster, Ohio 43130
(740) 687-5542 Phone - (740) 687-0086 Fax

ODOT STANDARD CONSTRUCTION DRAWINGS			CITY OF CLEVELAND STANDARD CONSTRUCTION DRAWINGS		ODOT SUPPLEMENTAL SPECIFICATIONS	SPECIAL PROVISIONS
A-1-69	07/19/02				800 4-15-16	GCRTA STANDARDS
BR-2-15	07/17/15				840 4-15-16	SECTION 014500
DM-1.1	07/20/01					SECTION 015010
EXJ-4-87	07/19/02					SECTION 015020
F-1.1	07/19/13					
HL-30.31	01/17/14					NS PUBLIC WORKS MANUAL
HL-50.21	07/15/16					
VPF-1-90	07/17/15					
					ODOT SUPPLEMENTS	
					1078 12-31-12	
					1083 4-15-16	

PROJECT DESCRIPTION

THIS PROJECT CONSISTS OF THE CONSTRUCTION OF 2.09 MILES OF A NEW TWO- TO THREE-LANE BOULEVARD FROM E. 55TH ST. TO E. 93RD ST. WORK INCLUDES PAVEMENT, RAILROAD, STRUCTURES, DRAINAGE, WATERWORK, LIGHTING, POWER DISTRIBUTION, TRAFFIC CONTROL, LANDSCAPING, AND ADJUSTMENT OF EXISTING UTILITIES.

RAILROAD INVOLVMENT INCLUDES GCRTA AND NORFOLK SOUTHERN RAILWAY, (NS DEARBORN DIVISION, LAKE ERIE DISTRICT, MP B-180.79).

EARTH DISTURBED AREAS

PROJECT EARTH DISTURBED AREA: 87.2 ACRES
ESTIMATED CONTRACTOR EARTH DISTURBED AREA: 0 ACRES
NOTICE OF INTENT EARTH DISTURBED AREA: 87.2 ACRES (AREA SERVICED BY COMBINED SEWER)


2016 SPECIFICATIONS

THE STANDARD SPECIFICATIONS OF THE STATE OF OHIO, DEPARTMENT OF TRANSPORTATION, INCLUDING CHANGES AND SUPPLEMENTAL SPECIFICATIONS LISTED IN THE PROPOSAL SHALL GOVERN THIS IMPROVEMENT.

0	2019-09-30	RFC
NO.	DATE	DESCRIPTION
ISSUE RECORD		

<div>1</div> <div>39</div>	CUY-IR490/ SR010- 2.09 / 19.28	RAILROAD INVOLVEMENT NORFOLK SOUTHERN GCRTA	CONSTRUCTION PROJECT NO.	PID NO.	FEDERAL PROJECT NO.
			17 - 3000	96833	E140 (249)
RECORD PLANS			RECORD PLANS		

1	2024-09-10	RECORD DRAWINGS
0	2019-09-30	RFC
NO.	DATE	DESCRIPTION
ISSUE RECORD		

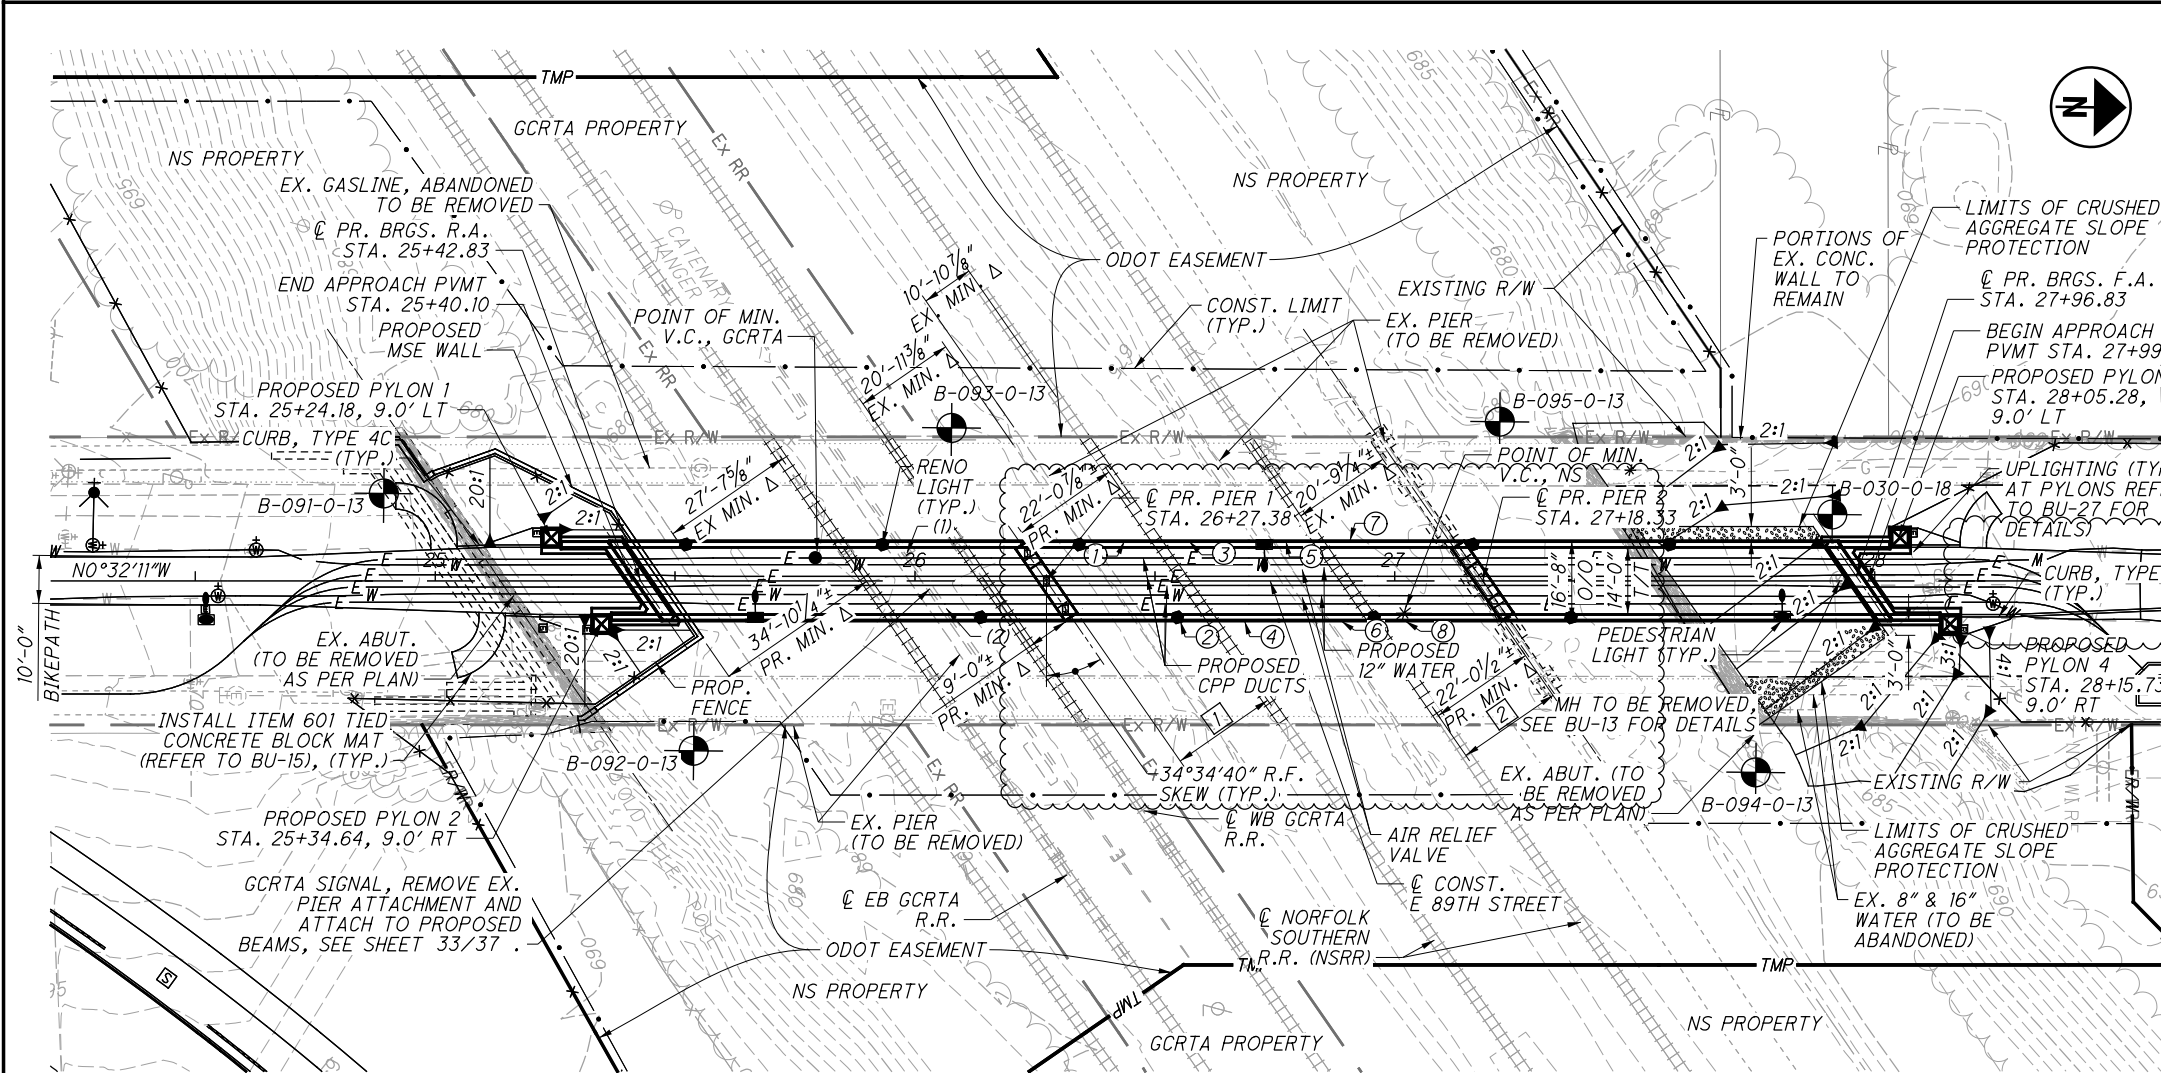


VERTICAL CLEARANCES MEASURED POST-CONSTRUCTION:

① V.C. = 26'-1 1/2"	④ V.C. = 25'-11"	⑦ V.C. = 24'-0"
② V.C. = 26'-1 1/2"	⑤ V.C. = 25'-0"	⑧ V.C. = 23'-9"
③ V.C. = 26'-1"	⑥ V.C. = 24'-9 1/2"	

HORIZONTAL CLEARANCES MEASURED POST-CONSTRUCTION:

① H.C. = 21'-10 5/16"
② H.C. = 21'-11 5/16"

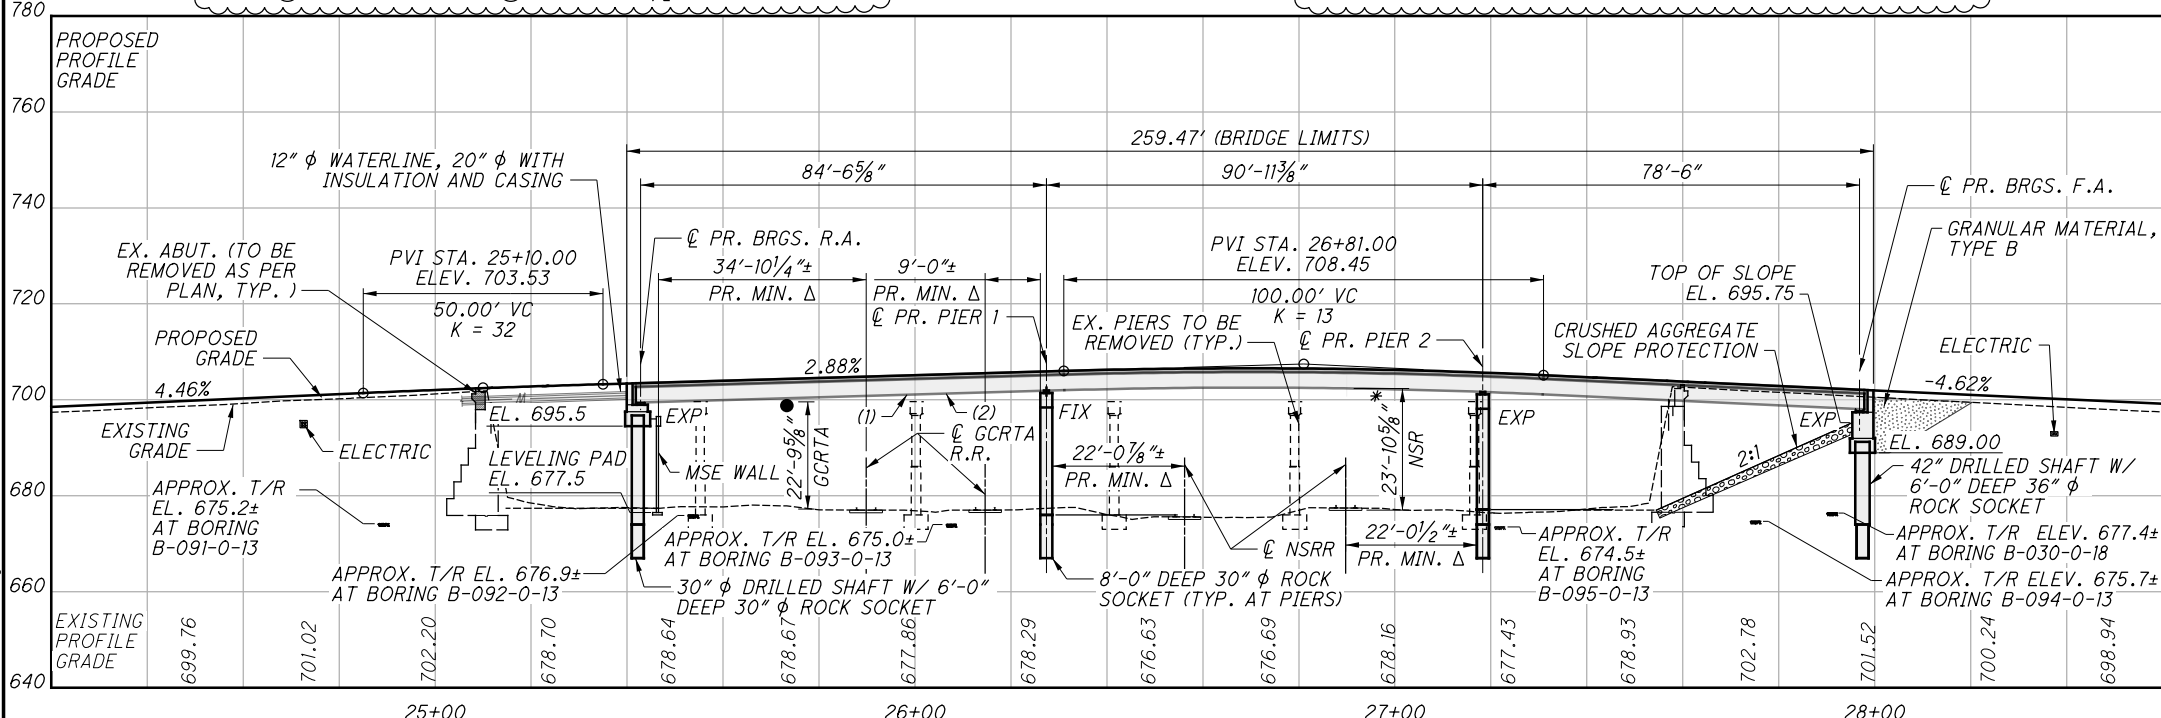

ALONG & CONSTRUCTION E 89TH STREET

BENCHMARK DATA	
BM MN6: FENO SET IN RD. BOX, STA. 20+29.80, 30.38' LT., ELEV. 687.71	
BM MN7: FENO SET IN RD. BOX, STA. 40+14.48, 47.19' RT., ELEV. 690.52	

FOR ADDITIONAL BENCHMARK AND PATH INFORMATION. SEE ROADWAY PLAN SHEETS, BU-15.

NOTES

EARTHWORK LIMITS SHOWN ARE APPROXIMATE. ACTUAL SLOPES SHALL CONFORM TO PLAN CROSS SECTIONS AND GRADING PLANS.

DESIGN TRAFFIC: N/A

LEGEND

- BORING LOCATION
- RENO LIGHT LOCATION
- 17'-0" REQUIRED MINIMUM VERTICAL CLEARANCE (GCRTA)
- * 23'-0" REQUIRED MINIMUM VERTICAL CLEARANCE (NS)
- Δ 9'-0" REQUIRED MINIMUM HORIZONTAL CLEARANCE (GCRTA)
- 22'-0" REQUIRED MINIMUM HORIZONTAL CLEARANCE (NS), PERP. DIMENSION PROVIDED
- (1) GCRTA SIGNAL WIRE ATTACH TO BEAM 1
- (2) GCRTA SIGNAL WIRE ATTACH TO BEAM 3

EXISTING STRUCTURE

TYPE: REINFORCED CONCRETE DECK SLAB ON SIX-SPAN CONTINUOUS COMPOSITE WELDED STEEL PLATE GIRDERS SUPPORTED ON REINFORCED CONCRETE SUBSTRUCTURE

SPANS: 41'-11"±, 44'-11"±, 41'-3"±, 37'-7"±, 37'-6"±, 38'-4"±

ROADWAY: 40'-0"± TOE/TOE SIDEWALK

LOADING: HS 20-44 CASE II

SKEW: 34°34'40"± R.F.

APPROACH SLABS: 15'-0" (AS-1-81)

ALIGNMENT: TANGENT

CROWN: PARABOLIC

STRUCTURAL FILE NUMBER: 1812440

DATE BUILT: 1929, 1998

DISPOSITION: TO BE REPLACED

PROPOSED STRUCTURE

TYPE: COMPOSITE REINFORCED CONCRETE DECK SLAB ON THREE-SPAN CONTINUOUS STEEL BEAMS (WEATHERING STEEL) SUPPORTED ON REINFORCED CONCRETE SUBSTRUCTURES ON DRILLED SHAFTS

SPANS: 84'-6 5/8", 90'-11 3/8", 78'-6" (C/C BEARINGS)

ROADWAY: 14'-0" TOE/TOE PARAPET

LOADING: H15-44 OR 90 PSF PEDESTRIAN LOADING

SKEW: 34°34'40" R.F.

APPROACH SLABS: NONE

ALIGNMENT: TANGENT

CROWN: 0.02 FT/FT

STRUCTURE FILE NUMBER: TBD

COORDINATES: LATITUDE 41°29'20.01" N
LONGITUDE 81°37'28.16" W

NO.	DATE	DESCRIPTION
1	2024-09-10	RECORD DRAWINGS
0	2019-09-30	RFC
ISSUE RECORD		

DESIGN AGENCY
2LMN, inc.
2475 Sugar Grove Rd., SE Lancaster, Ohio 43130
(740) 687-5542 Phone • (740) 687-0086 Fax

DATE
9/23/19

REVIEWED
MUR

DRAWN
MAK

DESIGNED
JBM

CUYAHOGA COUNTY
STA. 25+40.10
STA. 27+99.57




SITE PLAN
CUY-E89ST-4015 (EAST 89TH STREET)
PEDESTRIAN BRIDGE OVER NORFOLK SOUTHERN & GCRTA

CUY-IR490/SR010-2.08/19.28
PID No. 96833

1/37
3
39

RECORD PLANS

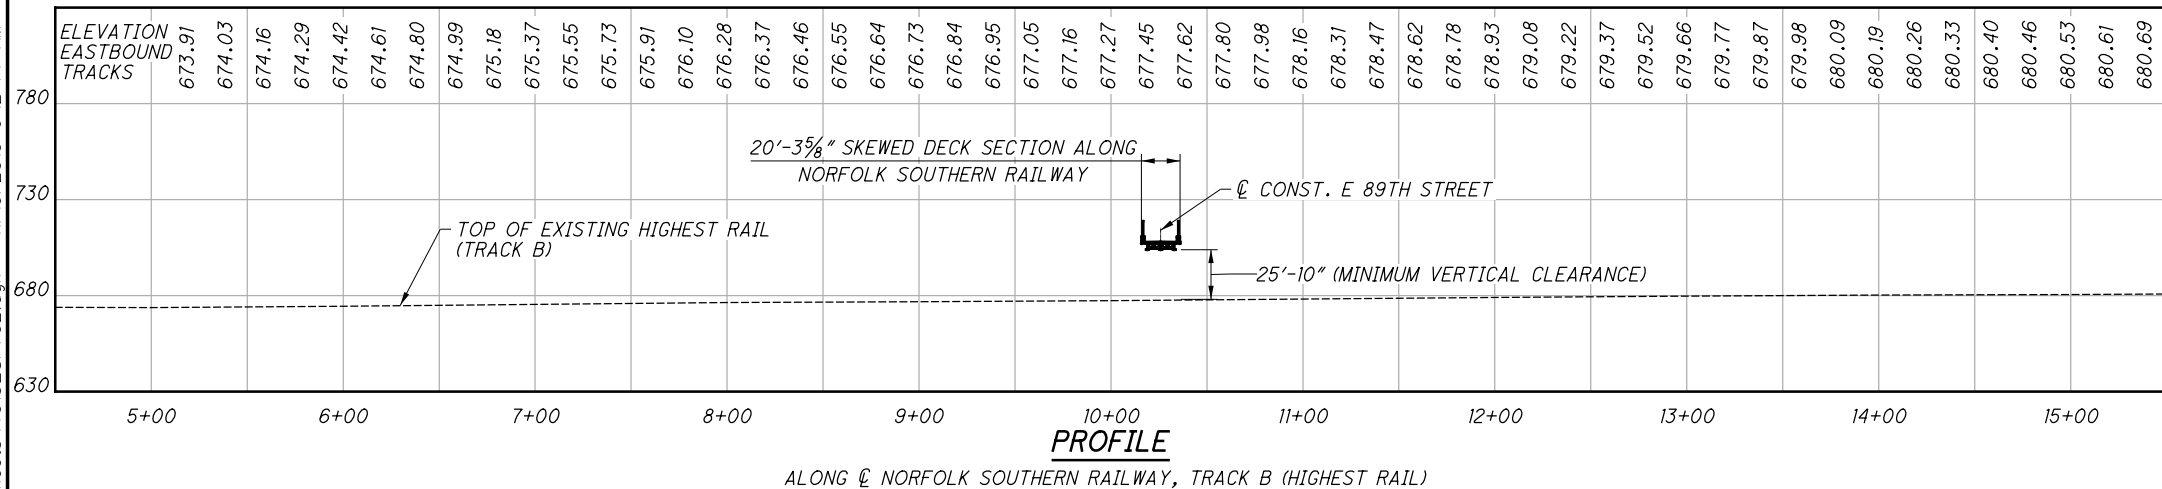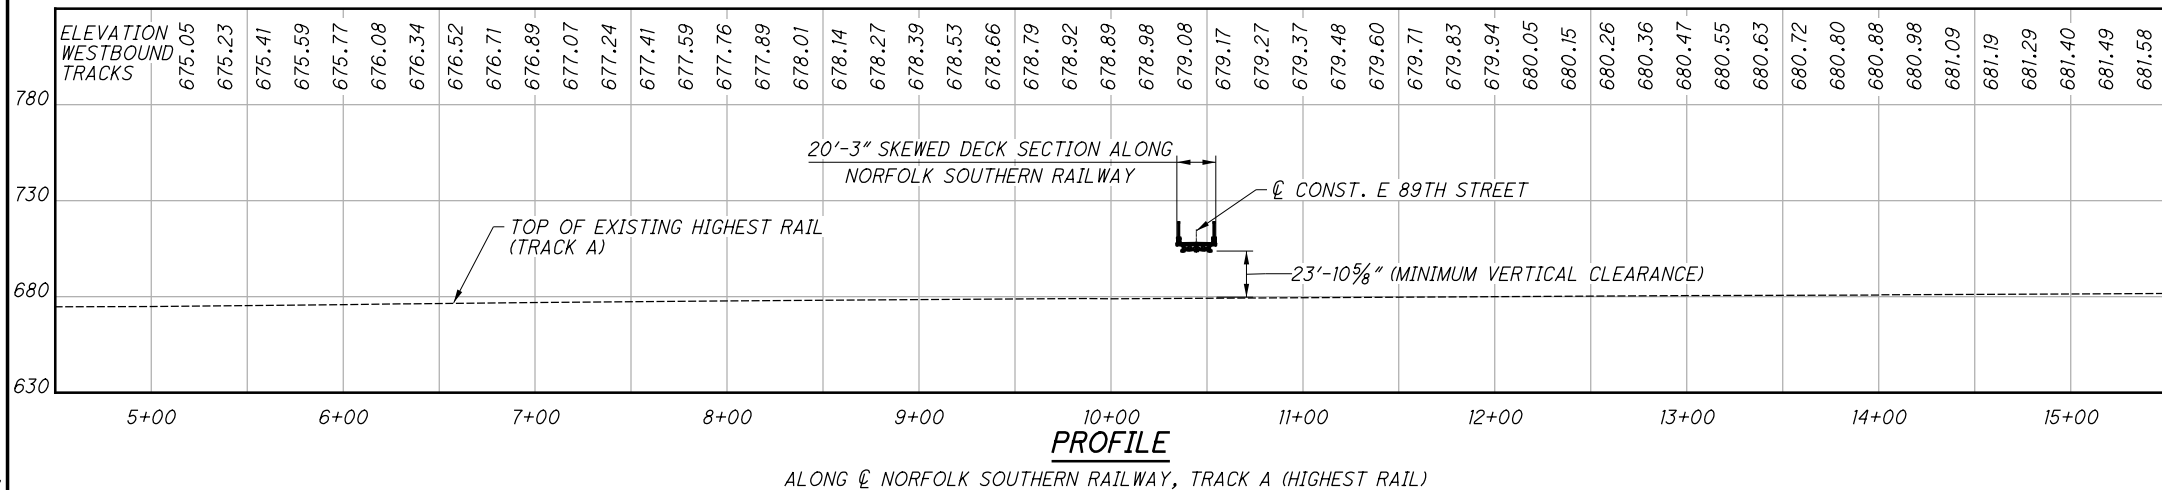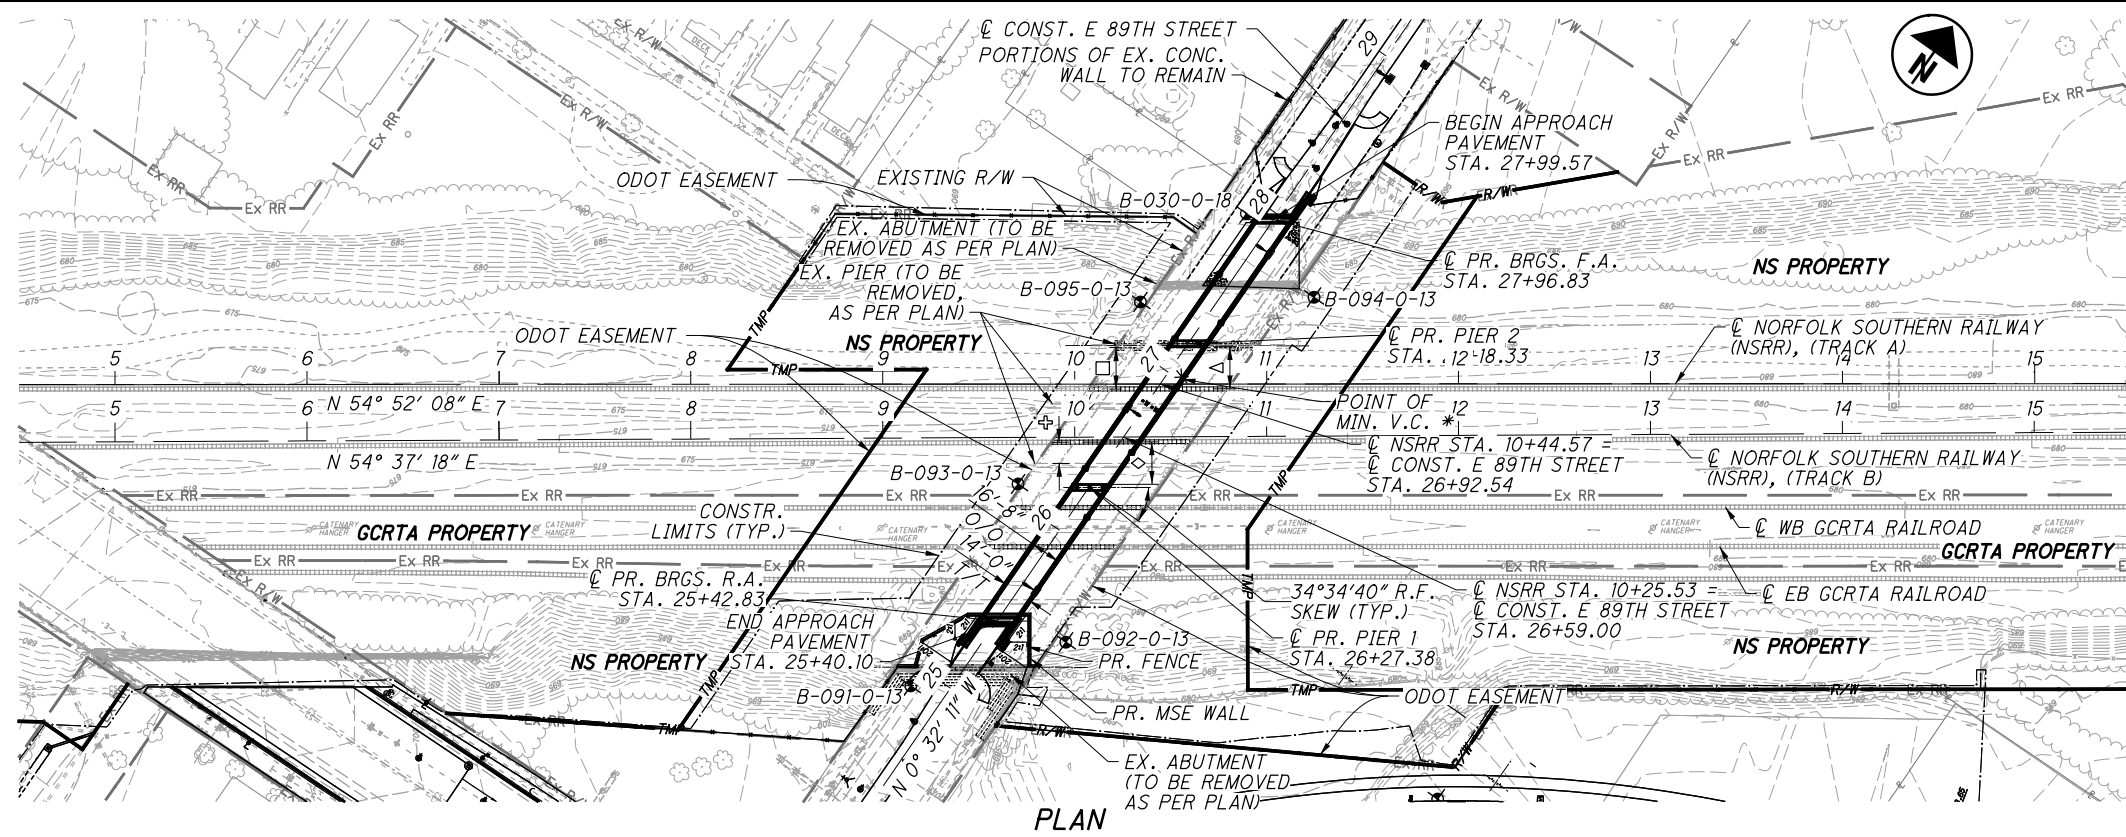


RECORD PLANS



NOTE:

THE ELEVATION OF THE EXISTING TOP-OF-RAIL PROFILE SHALL BE VERIFIED BEFORE BEGINNING CONSTRUCTION. ALL DISCREPANCIES SHALL BE BROUGHT TO THE ATTENTION OF THE NORFOLK SOUTHERN PUBLIC PROJECTS ENGINEER.

LEGEND:

- | | PLAN | SUPPLEMENTAL SITE |
|---|------|-------------------|
|  BORING LOCATION | | |
|  RENO LIGHT LOCATION | | |
|  PEDESTRIAN LIGHT LOCATION | | |
| △ 22'-0" MINIMUM HORIZONTAL CLEARANCE REQUIRED
22'-0 1/2" ACTUAL PROPOSED MINIMUM HORIZONTAL CLEARANCE | | |
| □ 22'-0" MINIMUM HORIZONTAL CLEARANCE REQUIRED
20'-9 1/4" ACTUAL EXISTING MINIMUM HORIZONTAL CLEARANCE | | |
| ◇ 22'-0" MINIMUM HORIZONTAL CLEARANCE REQUIRED
22'-0 7/8" ACTUAL PROPOSED MINIMUM HORIZONTAL CLEARANCE | | |
| ⊕ 22'-0" MINIMUM HORIZONTAL CLEARANCE REQUIRED
10'-10 7/8" ACTUAL EXISTING MINIMUM HORIZONTAL CLEARANCE | | |
| * 23'-0" MINIMUM VERTICAL CLEARANCE REQUIRED
23'-10 5/8" ACTUAL PROPOSED MINIMUM VERTICAL CLEARANCE | | |

CUYAHOGA COUNTY, OHIO
EXISTING E 89TH STREET
NORFOLK SOUTHERN RAILWAY
NS DEARBORN DIVISION, LAKE ERIE DISTRICT
MILE POST B-180.79
AVERAGE DAILY TRAIN TRAFFIC:
20 FREIGHT TRAINS PER DAY AT A MAXIMUM
AUTHORIZED OPERATING SPEED OF 40 MILES PER HOUR

0	2019-09-30	RFC
NO.	DATE	DESCRIPTION
ISSUE RECORD		

STANDARD DRAWINGS AND SUPPLEMENTAL SPECIFICATIONS:

REFER TO THE FOLLOWING STANDARD BRIDGE DRAWINGS:	
A-1-69	REVISED 7-19-02
BR-2-15	REVISED 7-17-15
DM-1.1	REVISED 7-20-01
EXJ-4-87	REVISED 7-19-02
F-1.1	REVISED 7-19-13
HL-30.31	REVISED 1-17-14
HL-50.21	REVISED 7-15-16
VPF-1-90	REVISED 7-17-15

AND THE FOLLOWING SUPPLEMENTAL SPECIFICATIONS:	
800	REVISED 4-15-16
840	REVISED 4-15-16

DESIGN SPECIFICATIONS:

THIS STRUCTURE CONFORMS TO THE "LRFD BRIDGE DESIGN SPECIFICATIONS" ADOPTED BY THE AMERICAN ASSOCIATION OF STATE HIGHWAY AND TRANSPORTATION OFFICIALS, SEVENTH EDITION, INCLUDING THE 2016 INTERIM SPECIFICATIONS AND THE ODOT BRIDGE DESIGN MANUAL, 2007.

DESIGN LOADING:

0.090 KSF AND H15-44 VEHICLE

DESIGN STRESSES:

BRIDGE:

- CONCRETE CLASS QC2 - COMPRESSIVE STRENGTH 4.5 KSI (SUPERSTRUCTURE)
- CONCRETE CLASS QC1 - COMPRESSIVE STRENGTH 4.0 KSI (SUBSTRUCTURE)
- CONCRETE CLASS QC5 - COMPRESSIVE STRENGTH 4.5 KSI (DRILLED SHAFT)
- REINFORCING STEEL - MINIMUM YIELD STRENGTH 60 KSI
- STRUCTURAL STEEL - ASTM A709 GRADE 50 W - YIELD STRENGTH 50 KSI

MSE WALL:

- CONCRETE CLASS QC1 - COMPRESSIVE STRENGTH 4.0 KSI (CONCRETE COPING)
- REINFORCING STEEL - ASTM A615 OR A996 GRADE 60, MINIMUM YIELD STRENGTH 60 KSI.
- ALL REINFORCING STEEL SHALL BE EPOXY COATED PER CMS 709.00
- SOIL UNIT WEIGHT, = 120 PCF
- ANGLE OF INTERNAL FRICTION, ϕ = 30°

WALL	MIN. STRAP LENGTH, (%)	BEGIN STA.	END STA.	WALL OR ABUTMENT	FACTORED BEARING RESISTANCE (KSF)
RA	70%	25+33.27	25+37.79	WALL	18.46
RA	70%	25+37.79	25+54.71	WALL	18.46
RA	70%	25+54.71	25+46.73	ABUTMENT	18.46
RA	70%	25+46.73	25+36.72	ABUTMENT	18.46
RA	70%	25+36.72	25+12.47	WALL	18.46
RA	70%	25+12.47	24+99.91	WALL	18.46

NOTE: THE MINIMUM SOIL REINFORCEMENT LENGTH IS AT LEAST 8 FEET OR THE PERCENTAGE OF THE WALL HEIGHT SHOWN ABOVE, WHICHEVER IS GREATER. FOR WALL SECTIONS DENOTED AS "ABUTMENTS", THE STRAP LENGTH WILL NEED TO BE 70% OF THE DISTANCE BETWEEN THE TOP OF THE LEVELING PAD AND THE TOP OF PAVEMENT.

DECK PROTECTION METHOD:

EPOXY COATED REINFORCING STEEL
2 1/2" CONCRETE COVER

MONOLITHIC WEARING SURFACE:

MONOLITHIC WEARING SURFACE IS ASSUMED, FOR DESIGN PURPOSES, TO BE 1 INCH THICK.

PROPRIETARY WINGWALL DATA:

THE PROPRIETARY WALL SUPPLIER SHALL DESIGN THE INTERNAL STABILITY OF A MECHANICALLY STABILIZED EARTH (MSE) WALL IN ACCORDANCE WITH SS840 TO SUPPORT THE ABUTMENT. THE DESIGN FOR INTERNAL STABILITY SHALL INCLUDE A NOMINAL (I.E. UNFACTORED) HORIZONTAL STRIP LOAD DUE TO FRICTION (FR) FROM THE SUPERSTRUCTURE OF 2.83 K/FT APPLIED PERPENDICULAR TO THE FACE OF WALL AT THE BASE OF THE CONCRETE FOOTING. THIS STRIP LOAD DOES NOT INCLUDE EARTH PRESSURE LOADS FROM THE ABUTMENT BACKFILL. HOWEVER, THE PROPRIETARY WALL SUPPLIER SHALL INCLUDE EARTH PRESSURE LOADS FROM THE ABUTMENT BACKFILL IN THE DESIGN CALCULATIONS.

WATERWORKS:

REFER TO BU-10 PLANS FOR DETAILS OF WATERWORKS.

MATERIALS:

WATERLINE JACKET SHALL BE 17.3" DIA. X 0.016" (THICKNESS) ALUMINUM. WATERLINE CASTING PIPE SHALL BE WELDED SMOOTH WALL 20" DIA. X 10 GAUGE STEEL CONDUIT, AS PER ASTM A-139 OR A-135, CORROSION COATED WITH 30 MILS NOVACOAT COATING.

CLEVELAND PUBLIC POWER (CPP):

REFER TO BU-12 PLANS FOR DETAILS OF CPP DUCTS.

ITEM 203 - EMBANKMENT, AS PER PLAN:

PLACE AND COMPACT EMBANKMENT MATERIAL IN 6 INCH LIFTS FOR THE CONSTRUCTION OF THE APPROACH EMBANKMENT.

ITEM 511 - QC/QA CONCRETE, AS PER PLAN:

BRIDGE PARAPETS AND PYLONS SHALL UTILIZE A RUBBED FINISH PER CMS 511.158.

ITEM 511: CLASS QC2 CONCRETE WITH QA/QC, BRIDGE DECK, AS PER PLAN:

DESCRIPTION:

IN ADDITION TO THE WORK REQUIREMENTS OF 511, EITHER PROVIDE TRADITIONAL BRIDGE DECK FORMS CONFORMING TO CMS 508 OR DESIGN, BUILD, PROVIDE AND CONSTRUCT GALVANIZED STEEL STAY-IN-PLACE (SIP) FABRICATED METAL FORMS CONFORMING TO CMS 508 AND THESE ADDITIONAL REQUIREMENTS.

DESIGN, BUILD, CONSTRUCT AND REMOVE SIP OR REMOVABLE FORMS AT OVERHANGS, WITHIN EIGHT FEET OF ALL EXPANSION JOINTS AND FOUR FEET OF ALL THROUGH DECK DRAINAGE SYSTEMS, AND AT THE AIR REFLEIF VALVE LOCATIONS IN THE DECK SLAB.

DESIGN:

SUBMIT CONSTRUCTION PLANS ACCORDING TO 501.05.B.3. DESIGN SIP FORMS TO SUPPORT THE SELF WEIGHT OF SIP FORMS, REINFORCEMENT, WET CONCRETE FOR THE DECK, ANY CONSTRUCTION EQUIPMENT LOADS, AND AT LEAST A 50 PSF LOAD FOR CONSTRUCTION LIVE LOADS. MEET THE DEFLECTION REQUIREMENTS OF 508.

DESIGN SIP FORMS THAT HAVE THE DEPTH OF THE FORM CORRUGATION FILLED WITH CONCRETE. SYNTHETIC MATERIALS SUCH AS EXPANDED POLYSTYRENE ARE NOT ALLOWED FOR FILLING FLUTES.

ITEM 511: CLASS QC2 CONCRETE WITH QA/QC, BRIDGE DECK, AS PER PLAN (CONTINUED):

INCLUDE THE FOLLOWING INFORMATION IN THE CONSTRUCTION PLAN:

- DESIGN CALCULATIONS
- PHYSICAL PROPERTIES OF THE SIP FORMS (GAGE, SECTION MODULUS, WEIGHT, DEPTH AND PITCH)
- CROSS SECTION VIEW AND DIMENSIONS OF: SIP FORMS, SUPPORT ANGLES, CHANNEL CLOSURES, SAFETY STOPS, CLIPS, PLATES AND HARDWARE.
- INCLUDE AN OVERALL LAYOUT PLAN WITH
 - WORKING POINTS OR CONTROL ELEVATIONS NECESSARY TO SET SUPPORT ANGLES.
 - TYPICAL AND SPECIFIC CROSS SECTIONS OR DETAILS: SUPPORT CONNECTIONS TO THE STRUCTURAL MEMBERS, SIP FORM CONNECTIONS TO SUPPORTS, FORM LAPS AND CLOSURE SECTIONS.
 - MINIMUM BEARING LENGTHS (EDGE DISTANCES) OF SIP FORMS TO THE SUPPORT ANGLES.
 - WELDING DETAILS: SIZE, LENGTH, LOCATIONS, ELECTRODES AND PROCESS.
- WORKER SAFETY RESTRICTIONS
- INSTALLATION INSPECTION CHECK LISTS

MATERIALS:

SUBMIT 501.06 TEST REPORTS AND WRITTEN ACCEPTANCE LETTERS TO THE ENGINEER. MATERIALS INSPECTION AND ACCEPTANCE IS PERFORMED BY THE ENGINEER AT THE PROJECT SITE. FURNISH FORM, SUPPORT MATERIALS AND HARDWARE CONFORMING THE FOLLOWING:


- FORM AND SUPPORT MATERIAL, ASTM A653 HAVING A COATING DESIGNATION OF G235, AND CONFORMING TO THE MECHANICAL PROPERTIES THE DESIGN REQUIRES. SIP FORMS SHALL BE SHOP-GALVANIZED.
- PROVIDE DECK FORMS WITH A 2 INCH MINIMUM FORMDEPTH.
- PROVIDE MINIMUM MATERIAL THICKNESS AS FOLLOWS: SIP FORMS (20 GAGE), SUPPORT ANGLES (12 GAGE) ANDSUPPORT BARS (12 GAGE).
- SUPPLY DECK, SELF DRILLING FASTENERS WITH CADMIUM PLATING PER ASTM B766 WITH MINIMUM THICKNESS OF 5, TEN THOUSANDTHS (0.0005 INCH). THE HEADS OF THESE FASTENERS WILL BE A HIGHLY VISIBLE COLOR, RED OR OTHER, TO AID INSPECTION.

WELDING:

DO NOT WELD SIP FORMS OR THEIR SUPPORTS TO THE STEEL BRIDGE MEMBERS.

INSTALLATION LIMITATIONS:

- FIELD CUT SIP FORMS USING MECHANICAL CUTTING METHODS. THERMAL CUTTING IS NOT PERMITTED. CUTTING OR DRILLING SIP FORMS AFTER BEING SHOP-GALVANIZED IS PROHITED, EXCEPT AS NEEDED FOR INSTALLATION USING SCREWS.
- PLACE FORMS ON FORM SUPPORTS. DO NOT INSTALL SIP FORMS DIRECTLY TO THE BRIDGE'S STRUCTURAL MEMBERS.
- ADJUST THE SCREED ELEVATIONS BY PRORATING THE CONCRETE DEAD LOAD DEFLECTION TO ACCOUNT FOR THE ADDITIONAL PERMANENT DEAD LOADS ASSOCIATED WITH CONCRETE FILLED STAY IN PLACE FORMS.
- SET THE HEIGHT OF THE FORM SUPPORTS TO DEVELOP THE ADJUSTED SCREED ELEVATIONS, DECK THICKNESS AND PLAN PROFILE.
- PLACE SIP FORMS ON FORM SUPPORTS TO ACHIEVE MINIMUM BEARING LENGTH PER MANUFACTURES DESIGN.
- CONNECT SIP FORMS TO FORM SUPPORTS BEFORE USING THE SIP AS A WORKING SURFACE AND BEFORE THE END OF EACH WORK SHIFT.

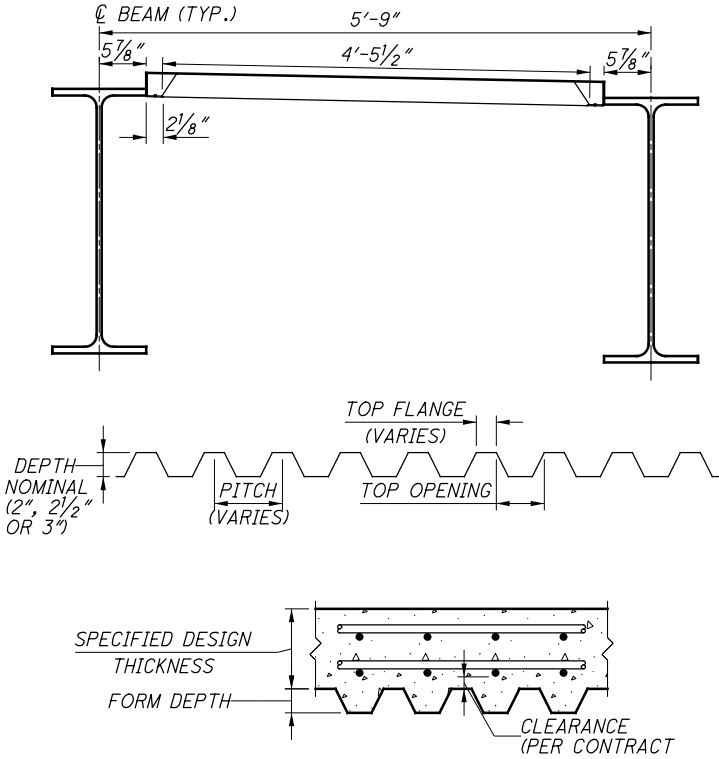

ITEM 511: CLASS QC2 CONCRETE WITH QA/QC, BRIDGE DECK, AS PER PLAN (CONTINUED):

- PROVIDE SAFETY STOPS TO ELIMINATE HAZARDS FROM SUDDEN UPLIFT AND LATERAL MOVEMENT. AFTER THE DECK CONCRETE MEETS THE LOADING REQUIREMENTS OF C&MS 511.17, REMOVE THE VISIBLE PORTION OF ALL SAFETY STOPS.
- COATINGS DAMAGED CAUSED BY MECHANICAL CUTTING OR FIELD WIELDING NEED NOT BE REPAIRED UNLESS SPECIFIED BY THE SIP FORM MANUFACTURER.

INSPECTION:

THE ENGINEER WILL CHECK THAT THE SIP MATERIALS MEET DESIGN REQUIREMENTS AND EVALUATE INSTALLATION BASED ON CONSTRUCTION PLAN.

BASIS OF PAYMENT:

THE DEPARTMENT WILL NOT SEPARATELY PAY FOR SIP FORMS. THE COST OF THIS WORK IS INCLUDED FOR PAYMENT IN THE PRICE BID FOR THE ITEM FOR WHICH THE SIP FORMS ARE USED.

0	2019-09-30	RFC
NO.	DATE	DESCRIPTION
ISSUE RECORD		

DESIGN AGENCY
DLMM, Inc.
2475 Sugar Grove Rd., SE Lancaster, Ohio 43130
(740) 687-5542 Phone • (740) 687-0086 Fax

DATE
09/23/19

REVIEWED
MUR

DRAWN
MAK

DESIGNED
MAK

GENERAL NOTES

CUY-E89ST-4015 (EAST 89TH STREET)
PEDESTRIAN BRIDGE OVER NORFOLK SOUTHERN & GCRTA

CUY-IR490/SR010-
2.09/19.28

PID No. 96833

3 / 37

5
39

RECORD PLANS

RECORD PLANS

ITEM 512 - SEALING OF CONCRETE SURFACES, AS PER PLAN:

APPLY A PERMANENT GRAFFITI COATING QUALIFIED ACCORDING TO SUPPLEMENT 1083 THAT IS COMPATIBLE WITH THE CONCRETE SEALER OVER WHICH IT IS APPLIED. APPLY THE GRAFFITI COATING IN ACCORDANCE WITH THE MANUFACTURER'S PRINTED INSTRUCTIONS.

THE ANTI-GRAFFITI COATING SHALL ALSO MEET THE FOLLOWING REQUIREMENTS:

THE MATERIAL SHALL BE A SINGLE COMPONENT, RTV (ROOM TEMPERATURE VULCANIZED), NEUTRAL MOISTURE CURE, PERMANENT (NON-SACRIFICIAL), TYPE III (WATER CLEANABLE) POLYSILOXANE (SILICONE) ANTI-GRAFFITI COATING (FREE OF ANY WAXES, EPOXIES, OR POLYURETHANE COMPONENTS).

THE COATING SHALL BE A ONE COAT SYSTEM (NO PRIMER) CAPABLE OF BEING SPRAY APPLIED TO A DRY FILM THICKNESS OF 15 MILS (375 MICRONS) WITHOUT RUNS OF SAGS (MULTIPLE COAT APPLICATION ACCEPTABLE FOR BRUSH/ROLLER USAGE AND PRIMER USAGE ACCEPTABLE FOR SPECIALTY SUBSTRATES SUCH AS GALVANIZED METAL).

THE COATING SHALL EMIT LESS THAN 300 G/L (2.5 POUNDS PER GALLON) OF VOLATILE ORGANIZE COMPOUNDS (EPA METHOD 24).

THE COATING SHALL MEET THE FOLLOWING PERFORMANCE REQUIREMENTS:

- CLEANABILITY LEVEL 1 (GRAFFITI COMPLETELY REMOVED WITH COLD WATER POWER WASH) AS PER ASTM D7089 WITH LOW PRESSURE (1200 PSI) COLD WATER WASH AFTER 2000 HOURS ACCELERATED UV-CONDENSATION EXPOSURE IN ACCORDANCE WITH ASTM D4587.
- GRAFFITI REISTANCE LESS THEN 7.5 AS PER ASTM D6578 AFTER 2000 HOURS ACCELERATED UV-CONDENSATION EXPOSURE IN ACCORDACE WITH ASTM 4578.
- NO SIGNS OF GRAFFITI STAINING AND MUST BE INTACT AND EXHIBIT NO SIGNS OF STREAKING, CRACKING, PINHOLING, DISCOLORING, OR OTHER VISIBLE COATING DEGRADATION UPON CASUAL OBSERVATION WHEN TESTED IN ACCORDANCE WITH TXDOT TEX 890-B, TYPE III METHOD.
- BREATHABILITY OF 10 PERMS (+/- 3) PER ASTM D1653 USING "WET CUP METHOD".
- ELONGATION AT BREAK GREATER THAN 100% AS PER ASTM D412 (USING DIE "D").
- ADHESION RATING OF "8" - DIFFICULT TO REMOVE AS PER ASTM D6677 (ADHESION BY KNIFE).
- SEALING COLOR - LIGHT TAN - FEDERAL STANDARD 595C #27769

ITEM 512 - SEALING OF CONCRETE SURFACES (TEX-COTE SILANE)

ALL EXPOSED CONCRETE SURFACES OF THE ABUTMENT, INCLUDING WINGWALLS AND LIMITS OF THE CONCRTE TE SUPERSTRUCTURE, AS PER PLAN DETAILS, SHALL BE SEALED WITH A TEX-COTE SILANE BASED MATERIAL.

ITEM 518 - STRUCTURE DRAINAGE, MISC.: PREFABRICATED GEOCOMPOSITE DRAIN

THIS WORK CONSISTS OF FURNISHING AND PLACING PREFABRICATED GEOCOMPOSITE DRAIN (PGD) AGAINST THE BACK FACE OF THE ABUTMENT.

ITEM 518 - STRUCTURE DRAINAGE, MISC.: PREFABRICATED GEOCOMPOSITE DRAIN (CONTINUED)

FURNISH PGD CONSISTING OF A DRAINAGE CORE WITH A GEOTEXTILE FABRIC BONDED TO AT LEAST ONE SIDE. USE CORE MATERIAL THAT CONSISTS OF A STABLE, POLYMER PLASTIC MATERIAL WITH A CUSPATED OR GEONET STRUCTURE. THE CORE MATERIAL SHALL HAVE SUFFICIENT FLEXIBILITY TO WITHSTAND BENDING AND HANDLING DURING INSTALLATION WITHOUT DAMAGE. FURNISH GEOTEXTILE COMPOSED OF STRONG ROT-PROOF POLYMERIC FIBERS FORMED INTO A WOVEN OR NON-WOVEN FABRIC. FURNISH PGD CONFORMING TO THE FOLLOWING REQUIREMENTS. FURNISH MANUFACTURER'S CERTIFIED TEST DATA.

	PROPERTY	TEST METHOD	VALUE
CORE	THICKNESS	ASTM D 5199	1.0 INCH
	COMPRESSIVE STRENGTH	ASTM D 1621	13,650 PSF MIN.
	FLOW RATE	ASTM D 4716	9 TO 25 GPM/FT
FABRIC	APPARENT OPENING SIZE	ASTM D 4751	0.3 MM MAX.
	FLOW RATE	ASTM D 4491	40 GPM/SQ.FT. MIN.
	GRAB TENSILE STRENGTH	ASTM D 4632	90 LBS MIN.
	CBR PUNCTURE	ASTM D 6241	65 LBS MIN.

PLACE PGD ALONG THE BACKFACE OF THE ABUTMENT AND WINGWALLS. PLACE THE SIDE FACED WITH GEOTEXTILE FACING TOWARDS THE RETAINED GROUND. USE NAILS AND WASHERS AT LEAST 1-INCH DIAMETER IN SIZE TO SECURE THE PGD ALONG THE EDGES OF THE PGD AND AT A MAXIMUM SPACING OF 4 FEET TO THE CONCRETE SURFACES.

SPLICE ABUTTING SECTIONS TOGETHER BY OVERLAPPING THE GEOTEXTILE FLAP (IF PROVIDED) ON ONE SECTION WITH THE ADJACENT SECTION OF PGD. OVERLAP THE GEOTEXTILE IN A SHINGLED OVERLAP SO THAT THE UPPER GEOTEXTILE IS ON TOP OF THE LOWER GEOTEXTILE. IF A GEOTEXTILE FLAP IS NOT PROVIDED, COVER THE SEAM WITH A 12-INCH WIDE STRIP OF GEOTEXTILE FABRIC CENTERED OVER THE SEAM AND SECURED IN PLACE USING 3-INCH WIDE WATERPROOF PLASTIC TAPE.

SEAL ALL EXPOSED EDGES OF THE CORE MATERIAL TO PREVENT SOIL INSTRUSION. SEAL EXPOSED EDGES BY FOLDING THE GEOTEXTILE FLAPS OVER AND AROUND THE PGD OR, IF A FLAP IS NOT PROVIDED, COVERING THE EXPOSED EDGE WITH A 12-INCH WIDE STRIP OF GEOTEXTILE FABRIC, TAPING THE STRIP TO THE PGD GEOTEXTILE 8 INCHES FROM THE EXPOSED EDGE, AND FOLDING THE REMAINING 4 INCHES OVER AND AROUND THE PGD. SECURE LOOSE EDGES OF THE GEOTEXTILE FABRIC WITH 3-INCH WIDE WATERPROOF PLASTIC TAPE.

REPAIR ANY DAMAGE TO THE GEOTEXTILE FABRIC BY COVERING WITH A PATCH WHICH OVERLAPS THE DAMAGED AREA AND EXTENDS AT LEAST 6 INCHES BEYOND THE EDGE OF THE DAMAGED AREA. TAPE THE EDGES OF THE PATCH IN PLACE USING 3-INCH WIDE WATERPROOF PLASTIC TAPE. IF THE CORE OF THE PGD IS DAMAGED, REPLACE IT WITH A NEW SECTION OF PGD AND SPLICE IT AS DESCRIBED ABOVE.

WHERE SHOWN ON THE PLANS, PLACE THE BOTTOM OF THE PGD ADJACENT TO A PERFORATED DRAINAGE COLLECTION PIPE AND POROUS BACKFILL AND COVER WITH GEOTEXTILE FABRIC. ENSURE A CONTINUOUS DRAINAGE PATH FROM THE PGD CORE TO THE PIPE. WHERE A WALL HAS WEEPHOLES FOR DRAINAGE, ENSURE WATER CAN DRAIN FROM THE PGD TO THE WEEPHOLE. IF NECESSARY, CUT A HOLE IN THE CORE TO ALLOW DRAINAGE OR USE A WEEPHOLE FITTING FROM THE PGD MANUFACTURER. DO NOT CUT GEOTEXTILE.

ITEM 607 - VANDAL PROTECTION FENCE, AS PER PLAN

THE CONTRACTOR SHALL FURNISH ALL NECESSARY LABOR, MATERIALS AND EQUIPMENT TO FABRICATE , GALVANIZE, CLEAN, APPLY A TWO-COAT SHOP PAINT SYSTEM (EPOXY/URETHANE) AND INSTALL THE RAILING. ALL FENCE AND RAILING MATERIALS SHALL BE GALVANIZED AND PAINTED PER THIS NOTE.

A. FABRICATION OF THE RAILING SHALL BE IN ACCORDANCE WITH C&MS 513, UF LEVEL. COATING OF THE RAILING SHALL BE IN ACCORDANCE WITH C&MS 514, EXCEPT AS NOTED BELOW.

B. THE ARCHITECTURAL FENCING SHALL SATISFY THE MINIMUM DESIGN REQUIREMENTS FOR POSTS AND ANCHORAGES AS SPECIFIED IN STANDARD BRIDGE DRAWING VPF-1-90 "VANDAL PROTECTION FENCE".

C. THE FENCING SHALL BE CONSTRUCTED USING WELDED WIRE FABRIC WITH 10.5 GAGE CORE WIRE, GALVANIZED AFTER WELDING.

D. STEEL PLATES AND SHAPES SHALL BE ASTM A709 GRADE 36 OR 50. ALL OTHER MATERIALS SHALL BE IN ACCORDANCE WITH C&MS 707.10 OR 711.09.

E. THE GALVANIZED COATING SYSTEM MAY BE APPLIED BY A GALVANIZER NOT PRE-QUALIFIED AS A FABRICATION SHOP UNDER SUPPLEMENT 1078, BUT THE PRE-QUALIFIED FABRICATOR OF THE STRUCTURAL STEEL SHALL BE RESPONSIBLE FOR THE QUALITY OF THE APPLIED GALVANIZED COATING SYSTEM AND ANY REPAIRS, RE-FABRICATION AND ADDITIONAL ASSEMBLIES REQUIRED TO ASSURE THE FABRICATED STEEL MEETS THE PLAN REQUIREMENTS.

F. THE TWO SHOP COATS SHALL BE APPLIED IN A STRUCTURAL STEEL FABRICATION SHOP HAVING PERMANENT BUILDINGS PER 513.04 AND PRE-QUALIFIED AT THE UF LEVEL. THE PAINT QUALITY CONTROL SPECIALIST (QCS) SHALL BE QUALIFIED AS SPECIFIED IN 514.04.

G. PRIOR TO GALVANIZING, ALL CORNERS OF THE THERMALLY CUT OR SHEARED EDGES SHALL HAVE A 1/16-INCH RADIUS OR EQUIVALENT FLAT SURFACE AT A SUITABLE ANGLE.

H. GALVANIZE THE FABRICATED RAILING AND HARDWARE ACCORDING TO C&MS 711.02, EXCEPT THAT FABRICATED RAILING ELEMENTS SHALL NOT BE POST TREATED WITH WATER QUENCHING OR CHROMATE CONVERSION COATED.

I. AFTER GALVANIZATION, REMOVE ZINC HIGH SPOTS SUCH AS METAL DRIP LINE AND OTHERS THAT WOULD DETRACT FROM THE PAINT APPEARANCE BY SSPC SP2 OR SP3. TAKE CARE THAT THE BASE GALVANIZED COATING IS NOT REMOVED. CHECK REPAIRED AREAS FOR REQUIRED COATING THICKNESS.

J. REPAIR GALVANIZED COATINGS DAMAGED IN THE SHOP ACCORDING TO ASTM A780 METHOD A3. REPAIR GALVANIZED COATINGS DAMAGED IN THE FIELD ACCORDING TO ASTM A780 METHOD A1.

K. AFTER REMOVING HIGH SPOTS, CLEAN THE GALVANIZED COATING ACCORDING TO SSPC SP-1. THE CLEANING SOLUTION SHALL BE AN ALKALINE SOLUTION WITH A PH RANGING FROM A MINIMUM OF 11 TO A MAXIMUM OF 12. THIS SOLUTION CAN BE APPLIED BY IMMERSION, SPRAY OR SOFT NYLON BRUSH. FOLLOW CLEANING WITH A HOT WATER OR HOT PRESSURE WASHER RINSE. SEPARATE INDIVIDUAL PIECES AND POSITION TO FACILITATE DRAINAGE AND DRYING. THE PIECES SHALL BE COMPLETELY DRY BEFORE PROCEEDING.

ITEM 607 - VANDAL PROTECTION FENCE, AS PER PLAN (CONTINUED)

L. AFTER CLEANING, ABRASIVE BLAST THE PIECES ACCORDING TO SSPC-SP7 BRUSH-OFF BLAST CLEANING. THE BLASTING OPERATION SHALL ROUGHEN THE GALVANIZED SURFACE TO AN ANGULAR SURFACE PROFILE OF 0.75 TO 1.00 MILS. SELECT THE BLASTING EQUIPMENT, TECHNIQUE AND ABRASIVE MATERIAL TO PROVIDE FOR THE SPECIFIED SURFACE PROFILE WITHOUT REMOVAL OF EXCESSIVE ZINC LAYERS. THE FINAL ZINC MILLAGE SHALL NOT BE LESS THAN 4.0 MILS. REMOVE ALL ABRASIVE RESIDUE WITH CLEAN COMPRESSED AIR OR OTHER METHODS ACCEPTABLE TO THE DEPARTMENT.

M. AFTER OBTAINING SURFACE PROFILE, SHOP APPLY A TWO COAT PAINT SYSTEM CONSISTING OF EPOXY INTERMEDIATE COAT AND A URETHANE FINISH COAT MEETING THE REQUIREMENTS OF C&MS 708.02. THE FINISH COAT SHALL MATCH FEDERAL COLOR STANDARD FS 595C-17038 BLACK. APPLY THE EPOXY COATING WITHIN 24 HOURS OF THE BRUSH-OFF BLASTING.

N. PRIOR TO FABRICATION OF THE RAILING SYSTEM, FABRICATE A SAMPLE RAILING PANEL OF A LENGTH AGREEABLE TO THE PROJECT ENGINEER WHICH INCLUDES TWO POST, ALL HARDWARE, INCIDENTALS AND COATINGS. THE PROJECT ENGINEER WILL USE THIS SAMPLE PANEL TO JUDGE ACCEPTANCE OF THE FABRICATION, COATINGS AND QUALITY CONTROL PROGRAM. AFTER THE REVIEW OF THIS SAMPLE, THE DEPARTMENT AND THE CONTRACTOR MAY AGREE UPON ANY FABRICATION, COATING, QUALITY CONTROL, OR INSTALLATION CHANGES AS A MODIFICATION TO THESE NOTES. THE FABRICATION CAN PROCEED ANY TIME AFTER THE ACCEPTANCE OF THIS SAMPLE PANEL. THE SAMPLE PANEL MAY BE INCORPORATED INTO THE FINISHED WORK AT THE DISCRETION OF THE ENGINEER.

O. REPAIR DAMAGE TO THE PAINT SYSTEM CAUSED DURING STORAGE, TRANSPORTATION, ERECTION, ACCORDING TO C&MS 514.22. EXERCISE EXTREME CARE WHILE HANDLING THE STEEL DURING ERECTION, AND DURING SUBSEQUENT CONSTRUCTION OF THE RAILING AND FENCE. INSULATE THE STEEL FROM THE BINDING CHAINS BY SOFTENERS AND PAD ALL HOOKS AND SLINGS THAT ARE USED TO HOIST/ERECT THE MEMBERS.

P. ALL FENCE ANCHORS SHALL BE CAST INTO THE PARAPET. A WASHER AND NUT SHALL BE TACK WELDED TO THE BOTTOM OF THE THREADED ROD TO AVOID THE ANCHORS PULLING LOOSE WHEN THE TEMPLATES FOR THE BASEPLATES ARE STRIPPED. FENCE ANCHORAGE SHALL BE STAINLESS STEEL PER C&MS 730.10.

Q. THE DBT SHALL DESIGN THE FENCE FOR DEAD LOAD, IN ACCORDANCE WITH AASHTO LRFD SECTION 3.8. THE WIND AREA SHALL INCLUDE THE AREA OF THE WELDED WIRE FABRIC WITHIN A GIVEN PANEL.

ITEM 840 - 6" DRAIN PIPE (NON-PERFORATED), AS PER PLAN

IN ADDITION TO THE REQUIREMENTS OF SUPPLEMENT SPEC 840, THIS ITEM SHALL CONSIST OF SUPPLYING AND PLACING ROCK CHANNEL PROTECTION, TYPE C AND ANIMAL GUARD AT THE OUTLET OF THE DRAIN PIPE AS SHOWN IN THE DETAIL ON SHEET 10/37 .

1	2024-09-10	RECORD DRAWINGS
0	2019-09-30	RFC
NO.	DATE	DESCRIPTION
ISSUE RECORD		

DESIGN AGENCY
RLM, Inc.
2475 Sugar Grove Rd., SE Lancaster, Ohio 43130
(740) 687-5542 Phone • (740) 687-0086 Fax

DATE
09/23/19
REVIEWED
MUR
DRAWN
MAK
DESIGNED
MAK
CHECKED
JAH

FILE NUMBER
TBD
STRUCTURE

RECORD PLANS


GENERAL NOTES
CUY-E88ST-4015 (EAST 89TH STREET)
PEDESTRIAN BRIDGE OVER NORFOLK SOUTHERN & GCRTA

CUY-IR490/SR010-2.09/19.28
PID No. 96833

4/37
6
39

RECORD PLANS

SECTION / DETAIL / VIEW CALLOUTS

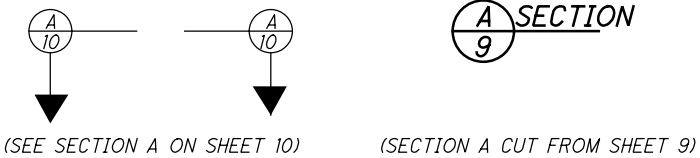

DRILLED SHAFTS

THE MAXIMUM FACTORED LOAD TO BE SUPPORTED BY EACH DRILLED SHAFT IS 213 KIPS AT THE REAR ABUTMENT, 258 KIPS AT THE FORWARD ABUTMENT AND 244 KIPS AT THE PIERS. THESE LOADS ARE RESISTED BY SIDE RESISTANCE WITHIN A PORTION OF THE BEDROCK SOCKET AND ALSO BY TIP RESISTANCE. THE FACTORED RESISTANCE DEVELOPED BY SIDE RESISTANCE IS 88 KIPS, ASSUMED TO ACT ALONG THE BOTTOM 4 FEET OF THE BEDROCK SOCKET FOR THE REAR ABUTMENT; 106 KIPS, ASSUMED TO ACT ALONG THE BOTTOM 4 FEET OF THE BEDROCK SOCKET FOR THE FORWARD ABUTMENT; AND 106 KIPS, ASSUMED TO ACT ALONG THE BOTTOM 6 FEET OF THE BEDROCK SOCKET FOR THE PIERS. THE FACTORED RESISTANCE PROVIDED BY THE DRILLED SHAFT TIP IS 129 KIPS AT THE REAR ABUTMENT, 370 KIPS AT THE FORWARD ABUTMENT, AND 140 KIPS AT THE PIERS.

PARTIAL PAINTING OF A709 GRADE 50W STEEL

PAINT THE LAST 10 FT OF EACH BEAM/GIRDER END ADJACENT TO THE ABUTMENTS INCLUDING ALL CROSS FRAMES AND OTHER STEEL WITHIN THESE LIMITS. THE FINISH COAT SHALL MEET FEDERAL STANDARD NO. 595B - 20045 OR 20059 (THE COLOR OF WEATHERING STEEL).

COARSE AGGREGATE FOR CONCRETE

ALL COARSE AGGREGATE SHALL HAVE AN ABSORPTION OF 1 PERCENT OR GREATER AS DEFINED BY THE AMERICAN SOCIETY OF TESTING MATERIALS (ASTM) C127.

CONSTRUCTION OVER GCRTA TRACKS:

- GCRTA REQUIREMENTS:
- A. NO WORK EQUIPMENT SHALL EVER ACCESS AND/OR CROSS THE TRACKS WITHOUT A TEMPORARY GRADE CROSSING AND/OR TEMPORARY CRIBBING TO PROTECT THE RAIL FROM DAMAGE.
 - B. NO EQUIPMENT SHOULD EVER RUN ON THE ENDS OF TIES.
 - C. PROTECTION OF THE RTA TRACK STRUCTURE (RAIL, BALLAS, TIES), OVERHEAD CATENARY SYSTEM (WIRE AND STRUCTURES INCLUDING FEEDER CABLES, FIBER OPTIC, SIGNAL CABLES, ETC.) FROM DAMAGE IS PARAMOUNT.
 - D. FABRIC TO BE OF TYPE AND PLACEMENT TO PREVENT AND MINIMIZE DEMO DEBRIS CONTAMINATION OF THE TRACK BALLAST.
 - E. IDENTIFY HOW FEEDER CABLE, FIBER OPTIC, OCS AND TRACKS WILL BE PROTECTED DURING CONSTRUCTION.

CONTRACTOR WILL COMPLY WITH THE LATEST REVISIONS OF THE FOLLOWING GCRTA STANDARDS.

- SECTION 014500 - SAFETY PROCEDURES
- SECTION 015010 - MAINTENANCE OF RAIL TRAFFIC AND RESUMPTION OF REVENUE SERVICE
- SECTION 015020 - STANDARD RAIL FLAGGING

CONSTRUCTION CLEARANCE

MAINTAIN A CONSTRUCTION CLEARANCE OF 12 FEET HORIZONTALLY FROM THE CENTER OF TRACKS AND 19.5 FEET VERTICALLY FROM A POINT LEVEL WITH THE TOP OF THE HIGHER RAIL, AND 8.5 FEET FROM THE CENTER OF TRACKS, AT ALL TIMES. TOP OF TEMPORARY SHEETING, IF REQUIRED, SHALL BE PLACED BELOW THE BOTTOM OF ADJACENT TIES.

PRE-CONSTRUCTION SURVEY. VIBRATION MONITORING, AND VIDEO INSPECTION OF SEWERS

CONDUCT A PRE-CONSTRUCTION SURVEY ACCORDING TO THE SETTLEMENT AND VIBRATION MONITORING PLAN OF BUILDINGS, STRUCTURES, UTILITIES, AND CRITICAL LOCATIONS WITHIN THE LIMITS DETERMINED BY THE DBT VIBRATION SPECIALIST. PERFORM A PRE-CONSTRUCTION VIDEO INSPECTION ACCORDING TO CMS 611 OF ALL SEWERS WITHIN THE INFLUENCE ZONES OF CONSTRUCTION. PERFORM SETTLEMENT AND VIBRATION MONITORING ACCORDING TO THE SETTLEMENT AND VIBRATION MONITORING PLAN DURING CONSTRUCTION. AFTER

CONSTRUCTION IS SUBSTANTIALLY COMPLETE, PERFORM A SECOND VIDEO INSPECTION OF THE SEWERS. PROVIDE RECORDINGS OF THE VIDEOS TO THE DEPARTMENT AND MAINTAINING AGENCY FOR REVIEW.

NORFOLK SOUTHERN RAILROAD:

CONTACT:
E.W. CHAMBERS
ENGINEER PUBLIC IMPROVEMENTS
NORFOLK SOUTHERN CORPORATION
1200 PEACHTREE STREET, NE
ATLANTA, GA 30309
(404) 529-1436 (O)
eldridge.chambers@nscorp.com

ALL WORK TO BE PERFORMED ON, OVER, UNDER, OR ADJACENT TO THE RAILROAD RIGHT-OF-WAY SHALL COMPLY WITH THE NORFOLK SOUTHERN RAILWAY COMPANY PUBLIC PROJECTS MANUAL (APPENDIX E, SPECIAL PROVISIONS FOR THE PROTECTION OF RAILWAY INTERESTS, AND APPENDIX HI, OVERHEAD GRADE SEPARATION DESIGN CRITERIA). WHEN IN CONFLICT WITH OTHER PROJECT SPECIFICATIONS, THE MOST STRINGENT ONE SHALL APPLY.

THE RAILROAD WILL BE PROVIDED AS-BUILT DRAWINGS SHOWING THE ACTUAL CLEARANCES AS CONSTRUCTED. DEPTH, SIZE, AND LOCATION OF ALL FOUNDATION COMPONENTS SHALL BE SHOWN ON THE DRAWINGS.

"ONE CALL" SERVICES DO NOT LOCATE BURIED RAILROAD SIGNAL AND COMMUNICATIONS LINES. THE CONTRACTOR SHALL CONTACT THE RAILROAD'S REPRESENTATIVE 2 DAYS IN ADVANCE OF WORK AT THOSE PLACES WHERE EXCAVATION, PILE DRIVING, OR HEAVY LOADS MAY DAMAGE THE RAILROAD'S UNDERGROUND FACILITIES. UPON REQUEST FROM THE CONTRACTOR OR SPONSOR, RAILROAD FORCES WILL LOCATE AND PAINT MARK OR FLAG THE RAILROAD'S UNDERGROUND FACILITIES. (SEE NS PUBLIC PROJECTS MANUAL, APPENDIX E, SECTION 3.D).

FOR PROJECTS REQUIRING MORE THAN 30 CONSECUTIVE DAYS OF FLAGGING, CONTRACTOR SHALL PROVIDE THE FLAGMAN A SMALL WORK AREA WITH A DESK/COUNTER AND CHAIR WITHIN THE FIELD/SITE TRAILER, INCLUDING THE USE OF BATHROOM FACILITIES, WHERE THE FLAGMAN CAN CHECK IN/OUT WITH THE PROJECT AND THE FLAGMAN'S HOME TERMINAL. THE WORK AREA SHOULD PROVIDE ACCESS TO TWO (2) ELECTRICAL OUTLETS FOR RECHARGING RADIO(S), AND A LAPTOP COMPUTER; AND HAVE THE ABILITY TO PRINT OFF NEEDED DOCUMENTATION AND ORDERS AS NEEDED AT THE FIELD/SITE TRAILER. THIS SHOULD AID IN MAXIMIZING THE FLAGMAN'S TIME AND EFFICIENCY ON THE PROJECT.

PROPOSED PROJECT WILL NOT CHANGE THE QUANTITY AND/OR CHARACTER OF FLOW IN THE RAILWAY'S DITCHES AND/OR DRAINAGE STRUCTURES.

ITEM NO.	ITEM DESCRIPTION
202	STRUCTURE REMOVED AS PER PLAN
202	FENCE REMOVED
203	EMBANKMENT, AS PER PLAN
203	GRANULAR MATERIAL, TYPE B
503	COFFERDAMS AND EXCAVATION BRACING
503	UNCLASSIFIED EXCAVATION
509	EPOXY COATED REINFORCING STEEL
511	CLASS QC1 CONCRETE WITH QC/QA, ABUTMENT INCLUDING FOOTING
511	CLASS QC1 CONCRETE WITH QC/QA, PIER ABOVE FOOTING
511	CLASS QC2 CONCRETE WITH QC/QA, BRIDGE DECK, AS PER PLAN
511	CLASS QC2 CONCRETE WITH QC/QA, BRIDGE DECK (PARAPET), AS PER PLAN
511	CLASS QC2 CONCRETE, MISC.: PYLONS WITH QC/QA
512	SEALING OF CONCRETE SURFACES (NON-EPOXY)
512	SEALING OF CONCRETE SURFACES (EPOXY-URETHANE)
512	SEALING OF CONCRETE SURFACES, AS PER PLAN
513	STRUCTURAL STEEL MEMBERS, LEVEL 3
513	WELDED STUD SHEAR CONNECTORS
514	FIELD PAINTING STRUCTURAL STEEL, INTERMEDIATE COAT, AS PER PLAN
514	FIELD PAINTING STRUCTURAL STEEL, FINISH COAT, AS PER PLAN
514	FINAL INSPECTION REPAIR
516	STRUCTURAL EXPAINSION JOINT INCLUDING ELASTOMERIC STRIP SEAL
516	ELASTOMERIC BEARING WITH INTERNAL LAMINATES AND LOAD PLATE (NEOPRENE)
518	6" PERFORATED PIPE, INCLUDING SPECIALS
518	6" NON-PERFORATED PIPE, INCLUDING SPECIALS
518	STRUCTURE DRAINAGE, MISC.: PREFABRICATED GEOCOMPOSITE DRAIN
518	POROUS BACKFILL WITH GEOTEXTILE FABRIC
519	PATCHING CONCRETE STRUCTURE
524	DRILLED SHAFT 30" DIAMETER, INTO BEDROCK
524	DRILLED SHAFT 36" DIAMETER, INTO BEDROCK
524	DRILLED SHAFT 42" DIAMETER, INTO BEDROCK
530	SPECIAL - SUPERSTRUCTURE UTILITY SUPPORTS
601	CRUSHED AGGREGATE SLOPE PROTECTION
607	VANDAL PROTECTION FENCE, AS PER PLAN
625	CONDUIT, MISC.: 5" ELECTRICAL CONDUITS
625	CONDUIT, MISC.: 2" CONDUIT IN PARAPET
625	STRUCTURE GROUNDING SYSTEM
625	JUNTION BOX
840	MECHANICALLY STABILIZED EARTH WALL, AS PER PLAN
840	WALL EXCAVATION
840	FOUNDATION PREPARATION
840	SELECT GRANULAR BACKFILL
840	NATURAL SOIL
840	6" DRAIN PIPE, PERFORATED
840	6" DRAIN PIPE, NON-PERFORATED, AS PER PLAN
840	CONCRETE COPING
840	ON-SITE ASSISTANCE
840	SGB INSPECTION AND COMPACT TESTING

ABBREVIATIONS

ABUT. - ABUTMENT	NO. - NUMBER
APPROX. - APPROXIMATE	NPCPP - NON-PERFORATED
B - BASELINE	CORRUGATED
B.F. - BACK FACE	PLASTIC PIPE
BM - BENCHMARK	NSRR - NORFOLK SOUTHERN
BOT. OR BTM. - BOTTOM	RAILROAD
BRG. - BEARING	O/O - OUT TO OUT
BUND. - BUNDLED	PCPP - PERFORATED
CL - CENETERLINE	CORRUGATED
C/C - CENTER TO CENTER	PLASTIC PIPE
C.I.P. - CAST-IN-PLACE	P.E.J.F. - PREFORMED
CJ - CONSTRUCTION JOINT	EXPANSION JOINT
CLR. - CLEAR	FILLER
CMS - CONSTRUCTION AND MATERIAL SPECIFICATIONS	PR. - PROPOSED
CONC. - CONCRETE	PSF - POUNDS PER SQUARE FOOT
CONSTR. - CONSTRUCTION	P.V.I. - POINT OF VERTICAL INTERSECTION
CVN - CHARPY V-NOTCH	R.A. - REAR ABUTMENT
DIA. - DIAMETER	RCP - ROCK CHANNEL
DIM. - DIMENSION	PROTECTION
DWG. - DRAWING	REQD. - REQUIRED
E - EAST	R.F. - RIGHT FORWARD
EB - EASTBOUND	R.R. - RAILROAD
E.F. - EACH FACE	RT. - RIGHT
EL. OR ELEV. - ELEVATION	R/W - RIGHT OF WAY
EOP - EDGE OF PAVEMENT	SB - SOUTHBOUND
EQ. - EQUAL	SER. - SERIES
EST. - ESTIMATED	SHLDR - SHOULDER
E.W. - EACH WAY	SPA. - SPACE OR SPACES
EX. - EXISTING	STA. - STATION
EXP. - EXPANSION	STD. - STANDARD
F.A. - FORWARD ABUTMENT	STR - STRAIGHT
F/F - FACE TO FACE	T -TOP
F.F. - FAR FACE	T&B - TOP & BOTTOM
FT. - FOOT OR FEET	TBR - TO BE REMOVED
FWD. - FORWARD	TEMP. - TEMPORARY
HMWM - HIGH MOLECULAR WEIGHT METHACRYLATE	T/R - TOP OF ROCK
HW - HIGH WATER	T/S - TOE OF SLOPE
IN. - INCH	T/T - TOE TO TOE
JT. - JOINT	TYP. - TYPICAL
L.F. - LEFT FORWARD	U.N.O. - UNLESS NOTED OTHERWISE
LT. - LEFT	VAR. - VARIES
MAX. - MAXIMUM	V - VELOCITY
MIN. - MINIMUM	W/- WITH
MISC. - MISCELLANEOUS	WB - WESTBOUND
MSE - MECHANICALLY STABILIZED EARTH	WW - WINGWALL
NB - NORTHBOUND	WWR - WELDED WIRE REINFORCEMENT
N.F. - NEAR FACE	

0	2019-09-30	RFC
NO.	DATE	DESCRIPTION
ISSUE RECORD		

DESIGN AGENCY
2LMN, Inc.
2475 Sugar Grove Rd., SE Lancaster, Ohio 43130
(740) 687-5542 Phone - (740) 687-0086 Fax

DATE
09/23/19
MUR
STRUCTURE FILE NUMBER
N/A

DRAWN
MAK
CHECKED
JAH


REVIEWED
MUR
REVISED

GENERAL NOTES
CUI-E89ST-4015 (EAST 89TH STREET)
PEDESTRIAN BRIDGE OVER NORFOLK SOUTHERN & GCRTA


CUI-IR490/SR010-2.09/19.28
PID No. 96833

5/37
7/39


RECORD PLANS

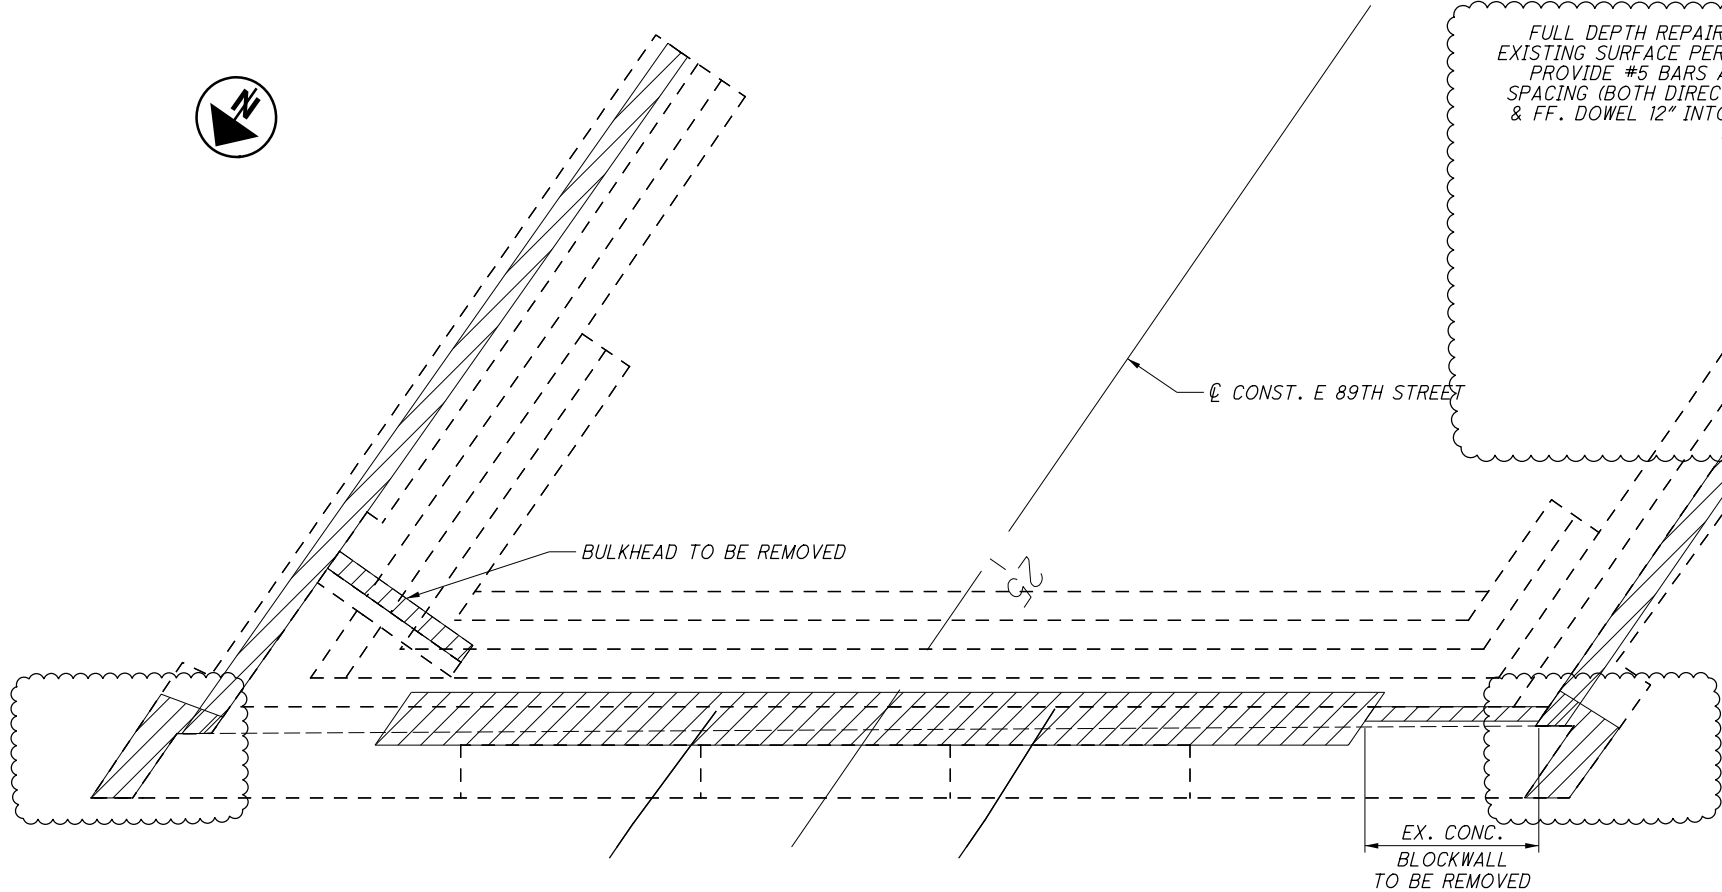

PLAN - EXISTING REAR ABUTMENT
(ALL DIMENSIONS MEASURED ALONG CL BEARING)

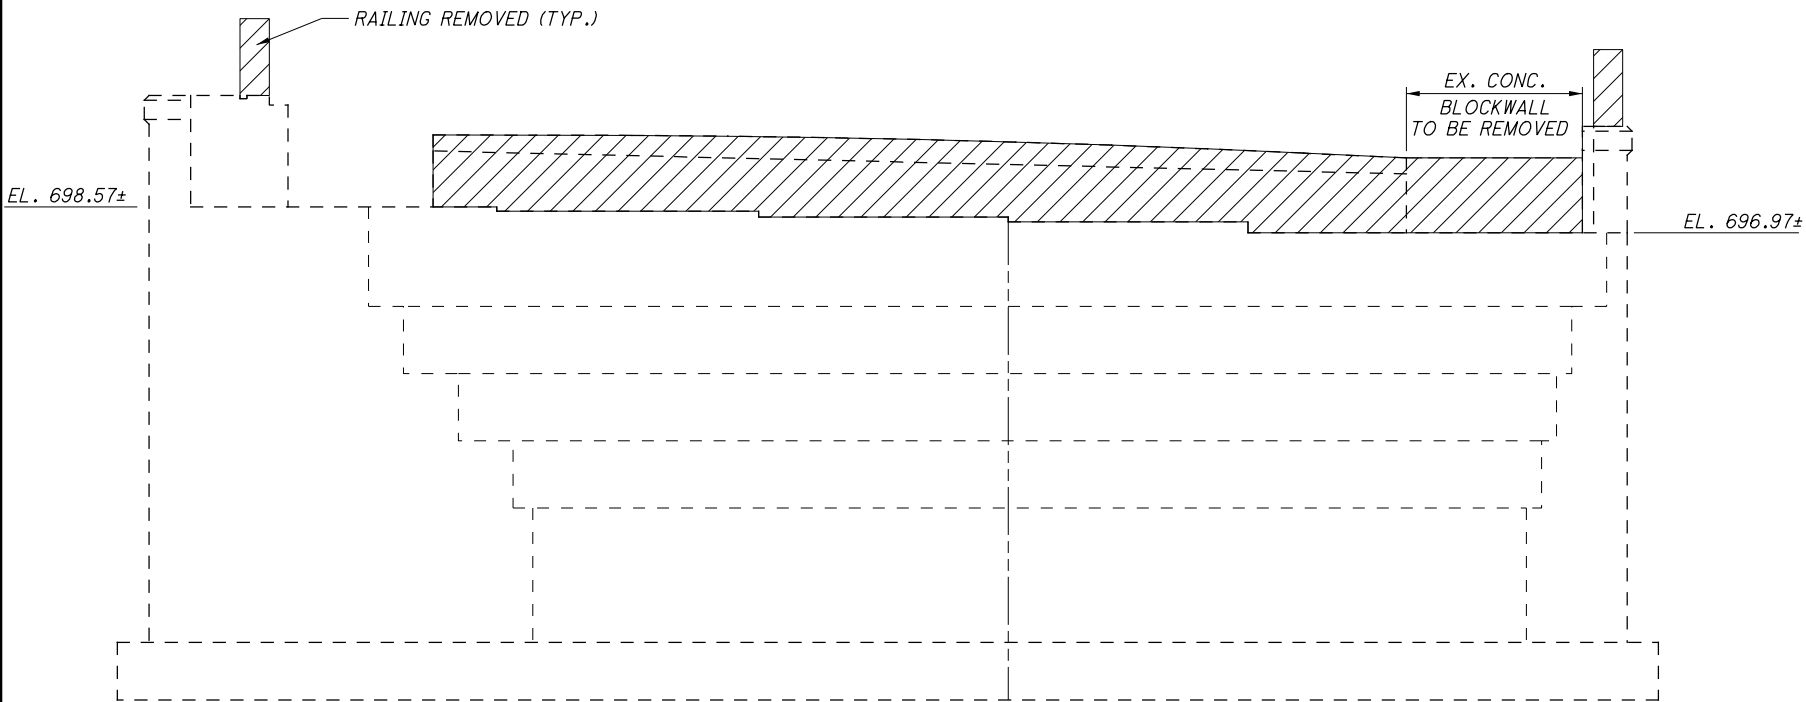


ELEVATION - EXISTING REAR ABUTMENT
(ALL DIMENSIONS MEASURED ALONG FRONT FACE OF ABUTMENT)

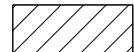


LEGEND:
LIMITS OF REMOVAL PER ITEM 202 -
PORTIONS OF STRUCTURE REMOVED.

NOTES:
1. ALL EXISTING ELEVATIONS AND DIMENSIONS ARE ±.

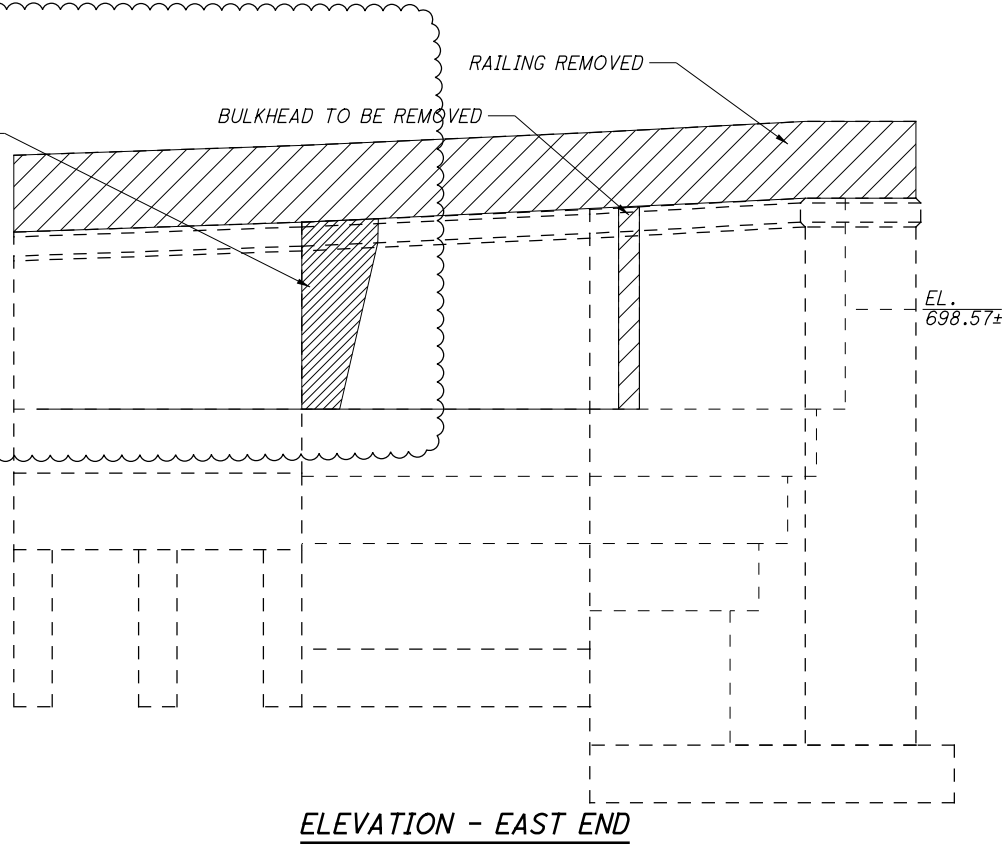


ELEVATION - EAST END

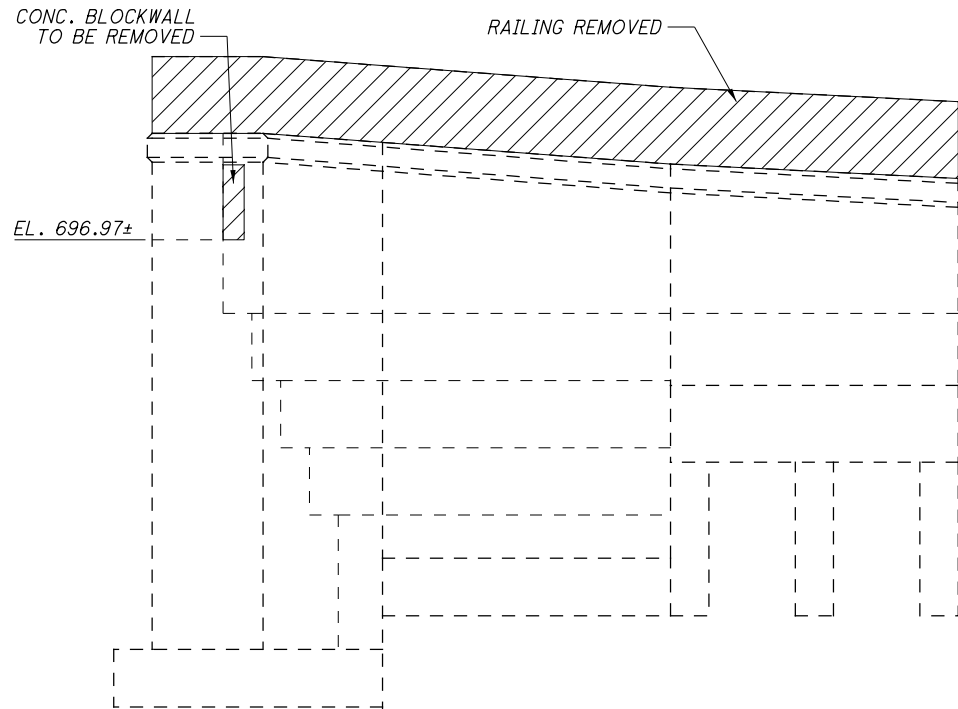

ELEVATION - WEST END

NO.	DATE	DESCRIPTION
1	2024-09-10	RECORD DRAWINGS
0	2019-09-30	RFC
ISSUE RECORD		

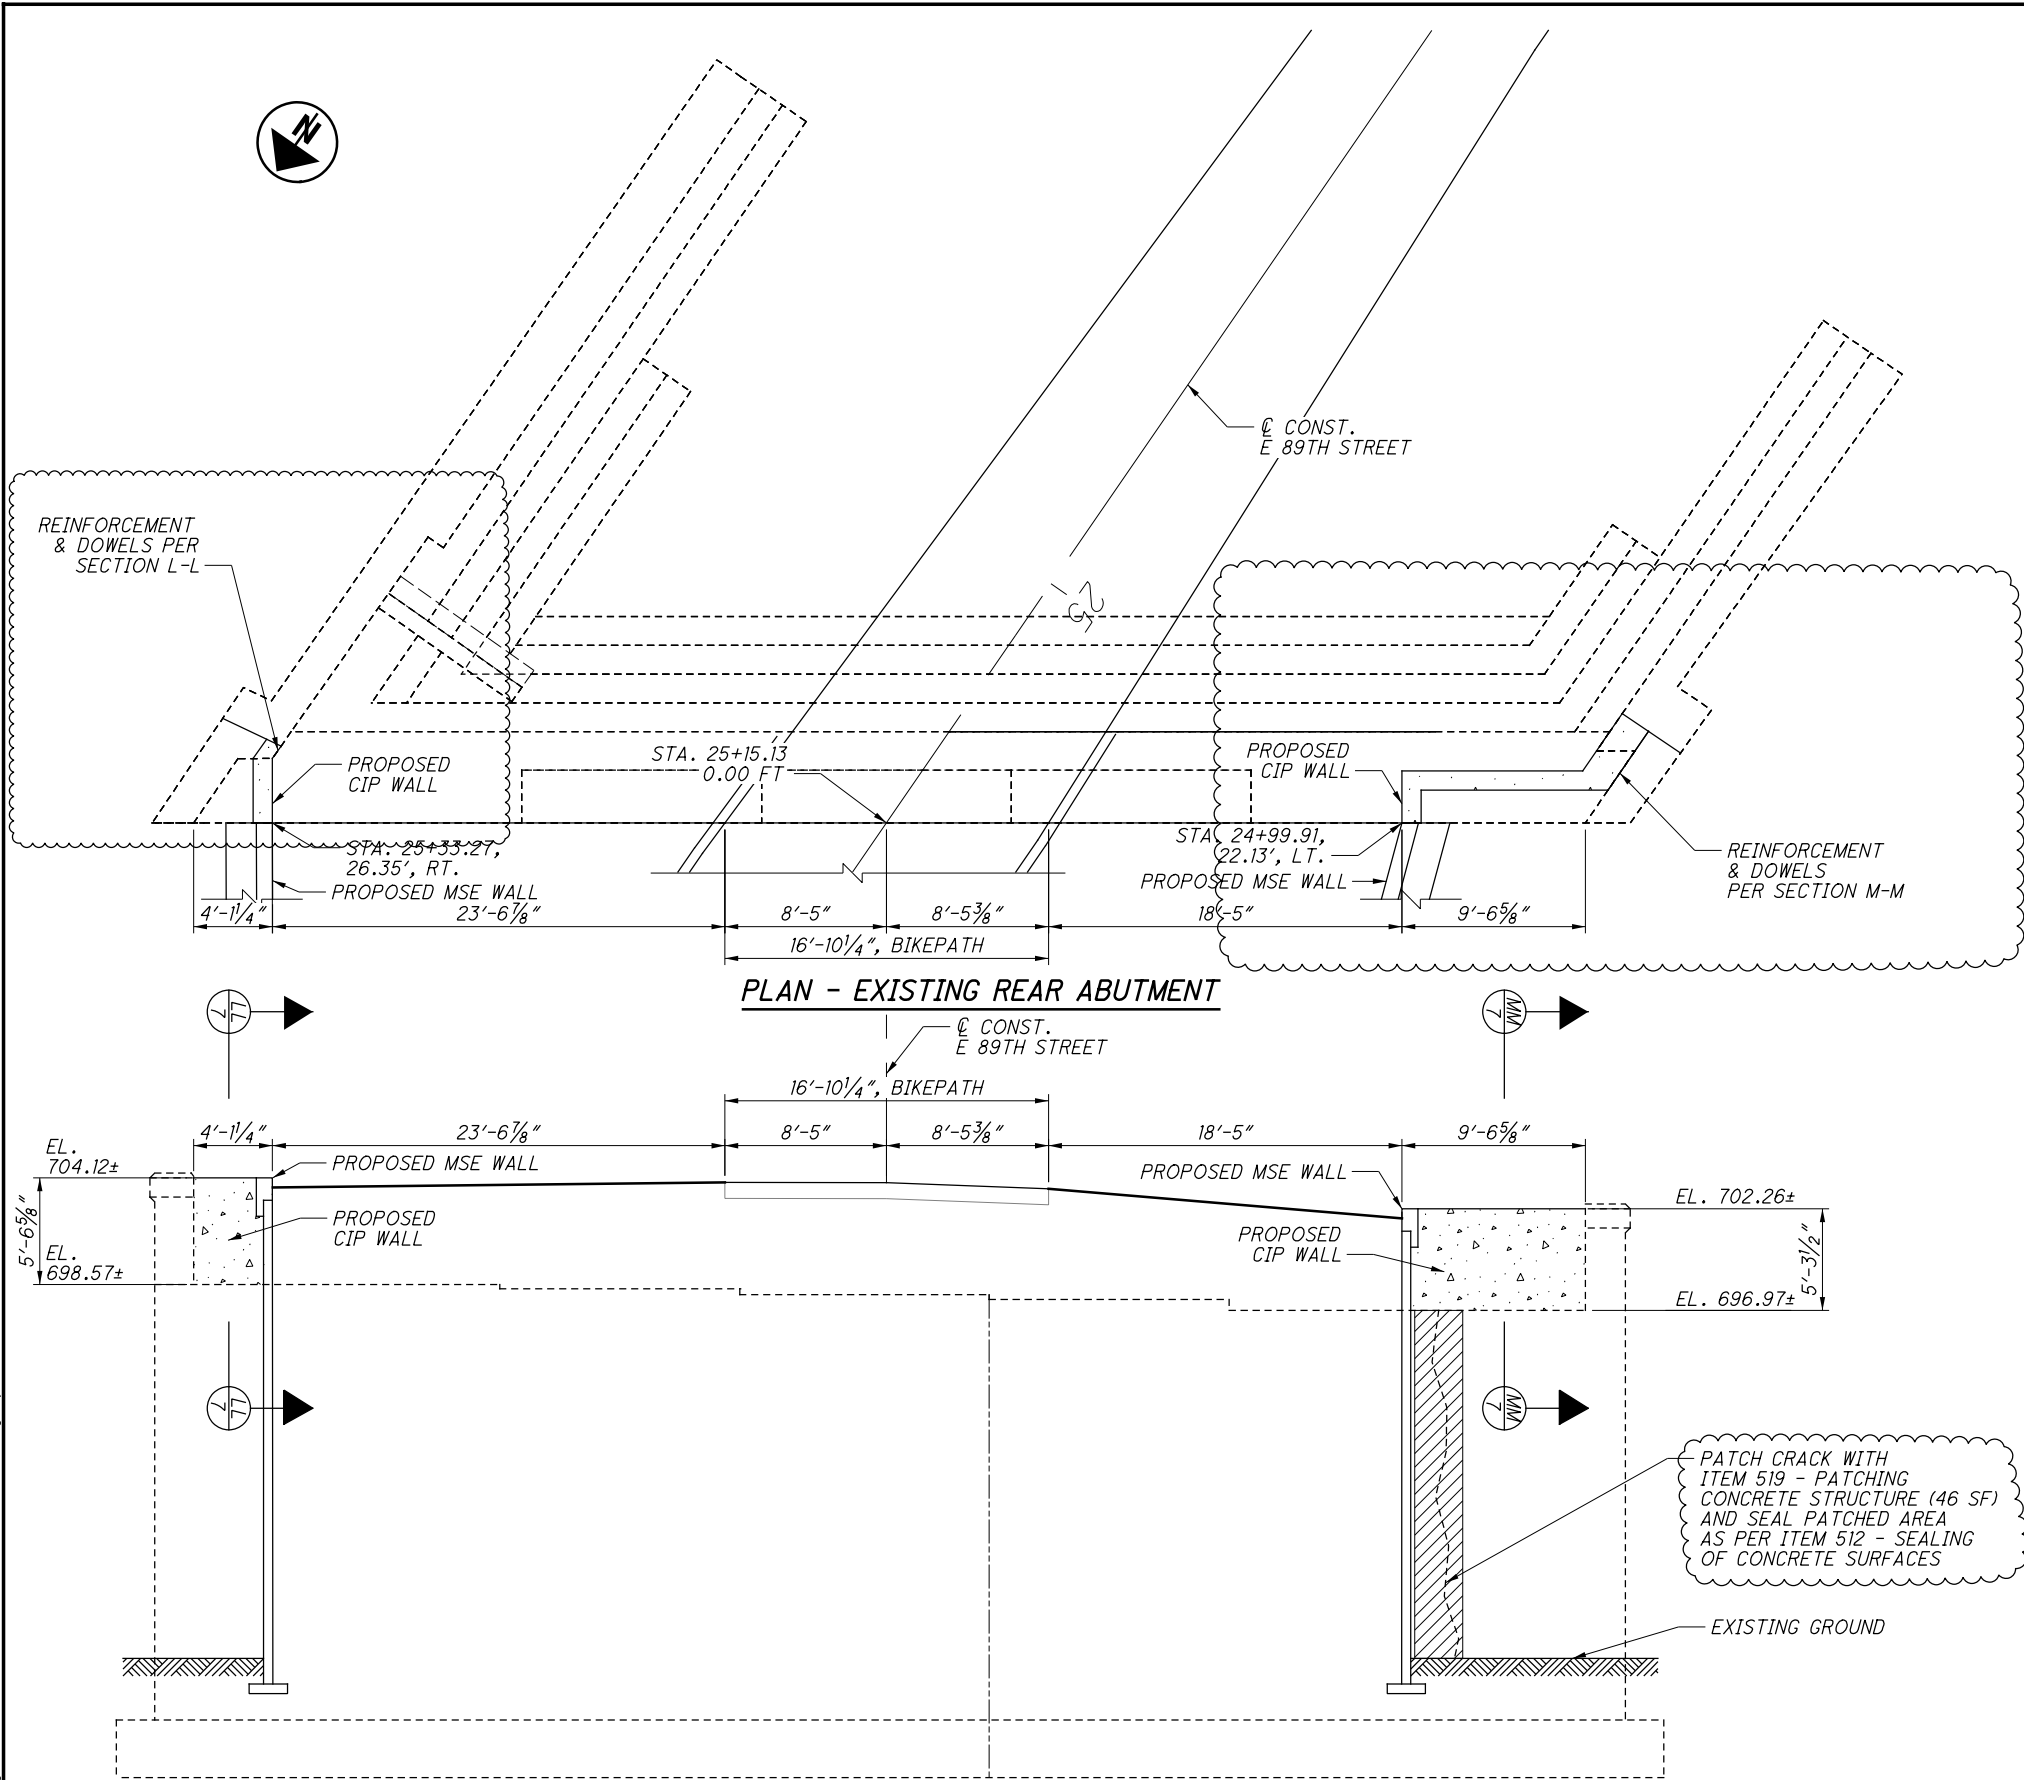


ELEVATION - EXISTING REAR ABUTMENT

LEGEND:


ITEM 519 - PATCHING CONCRETE STRUCTURE

NOTES:

- ALL EXISTING ELEVATIONS AND DIMENSIONS ARE ±.
- SEE SHEETS 10/37 AND 13/37 FOR MSE WALL DETAILS.
- DOWELS SHALL BE GROUTED WITH NON-SHRINK, NON-METALLIC GROUT AS PER CMS 705.20.
- SEE SHEET 36/37 FOR REINFORCING SCHEDULE.


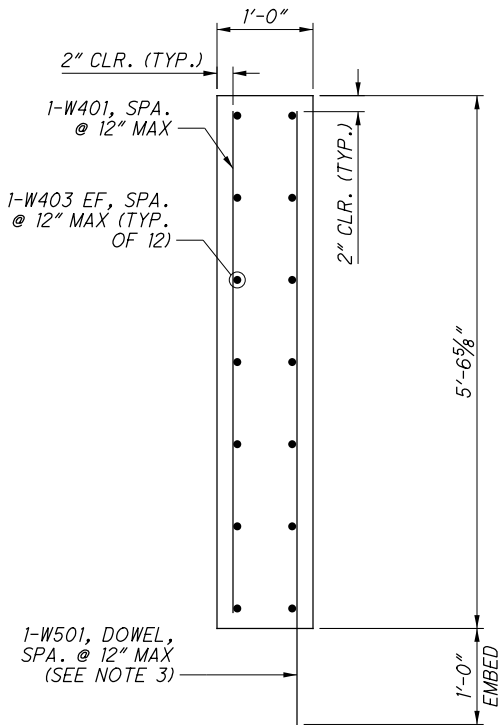


LL SECTION 7

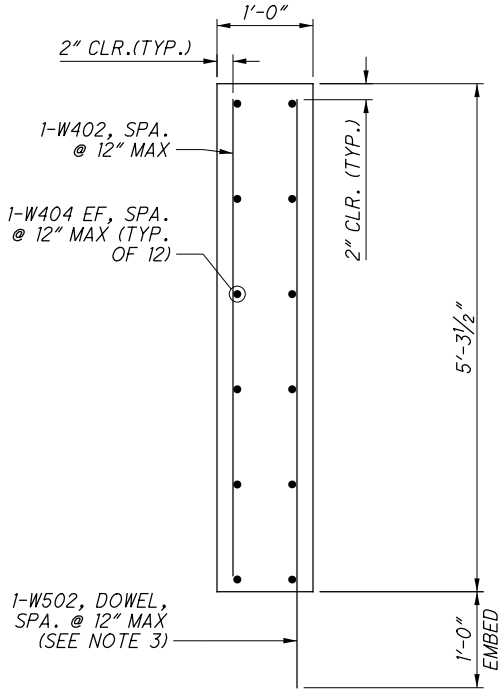


MM SECTION 7

NO.	DATE	DESCRIPTION
1	2024-09-10	RECORD DRAWINGS
0	2019-09-30	RFC
ISSUE RECORD		

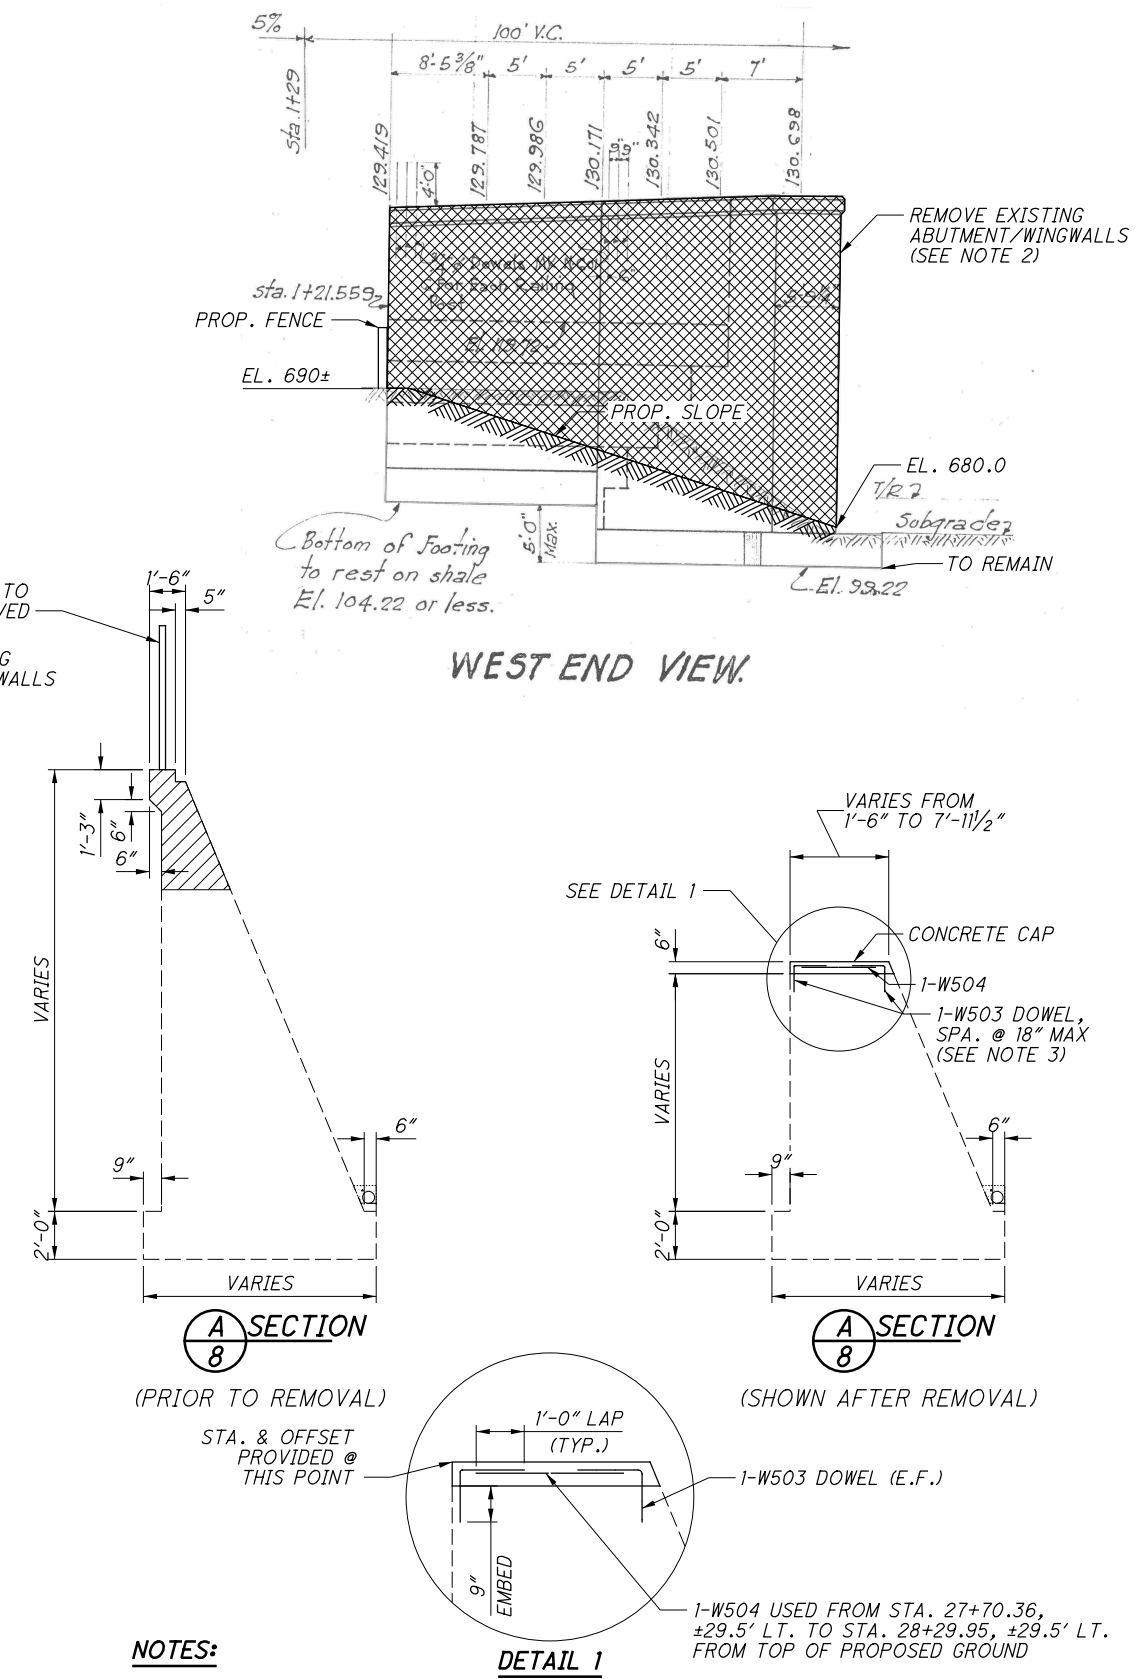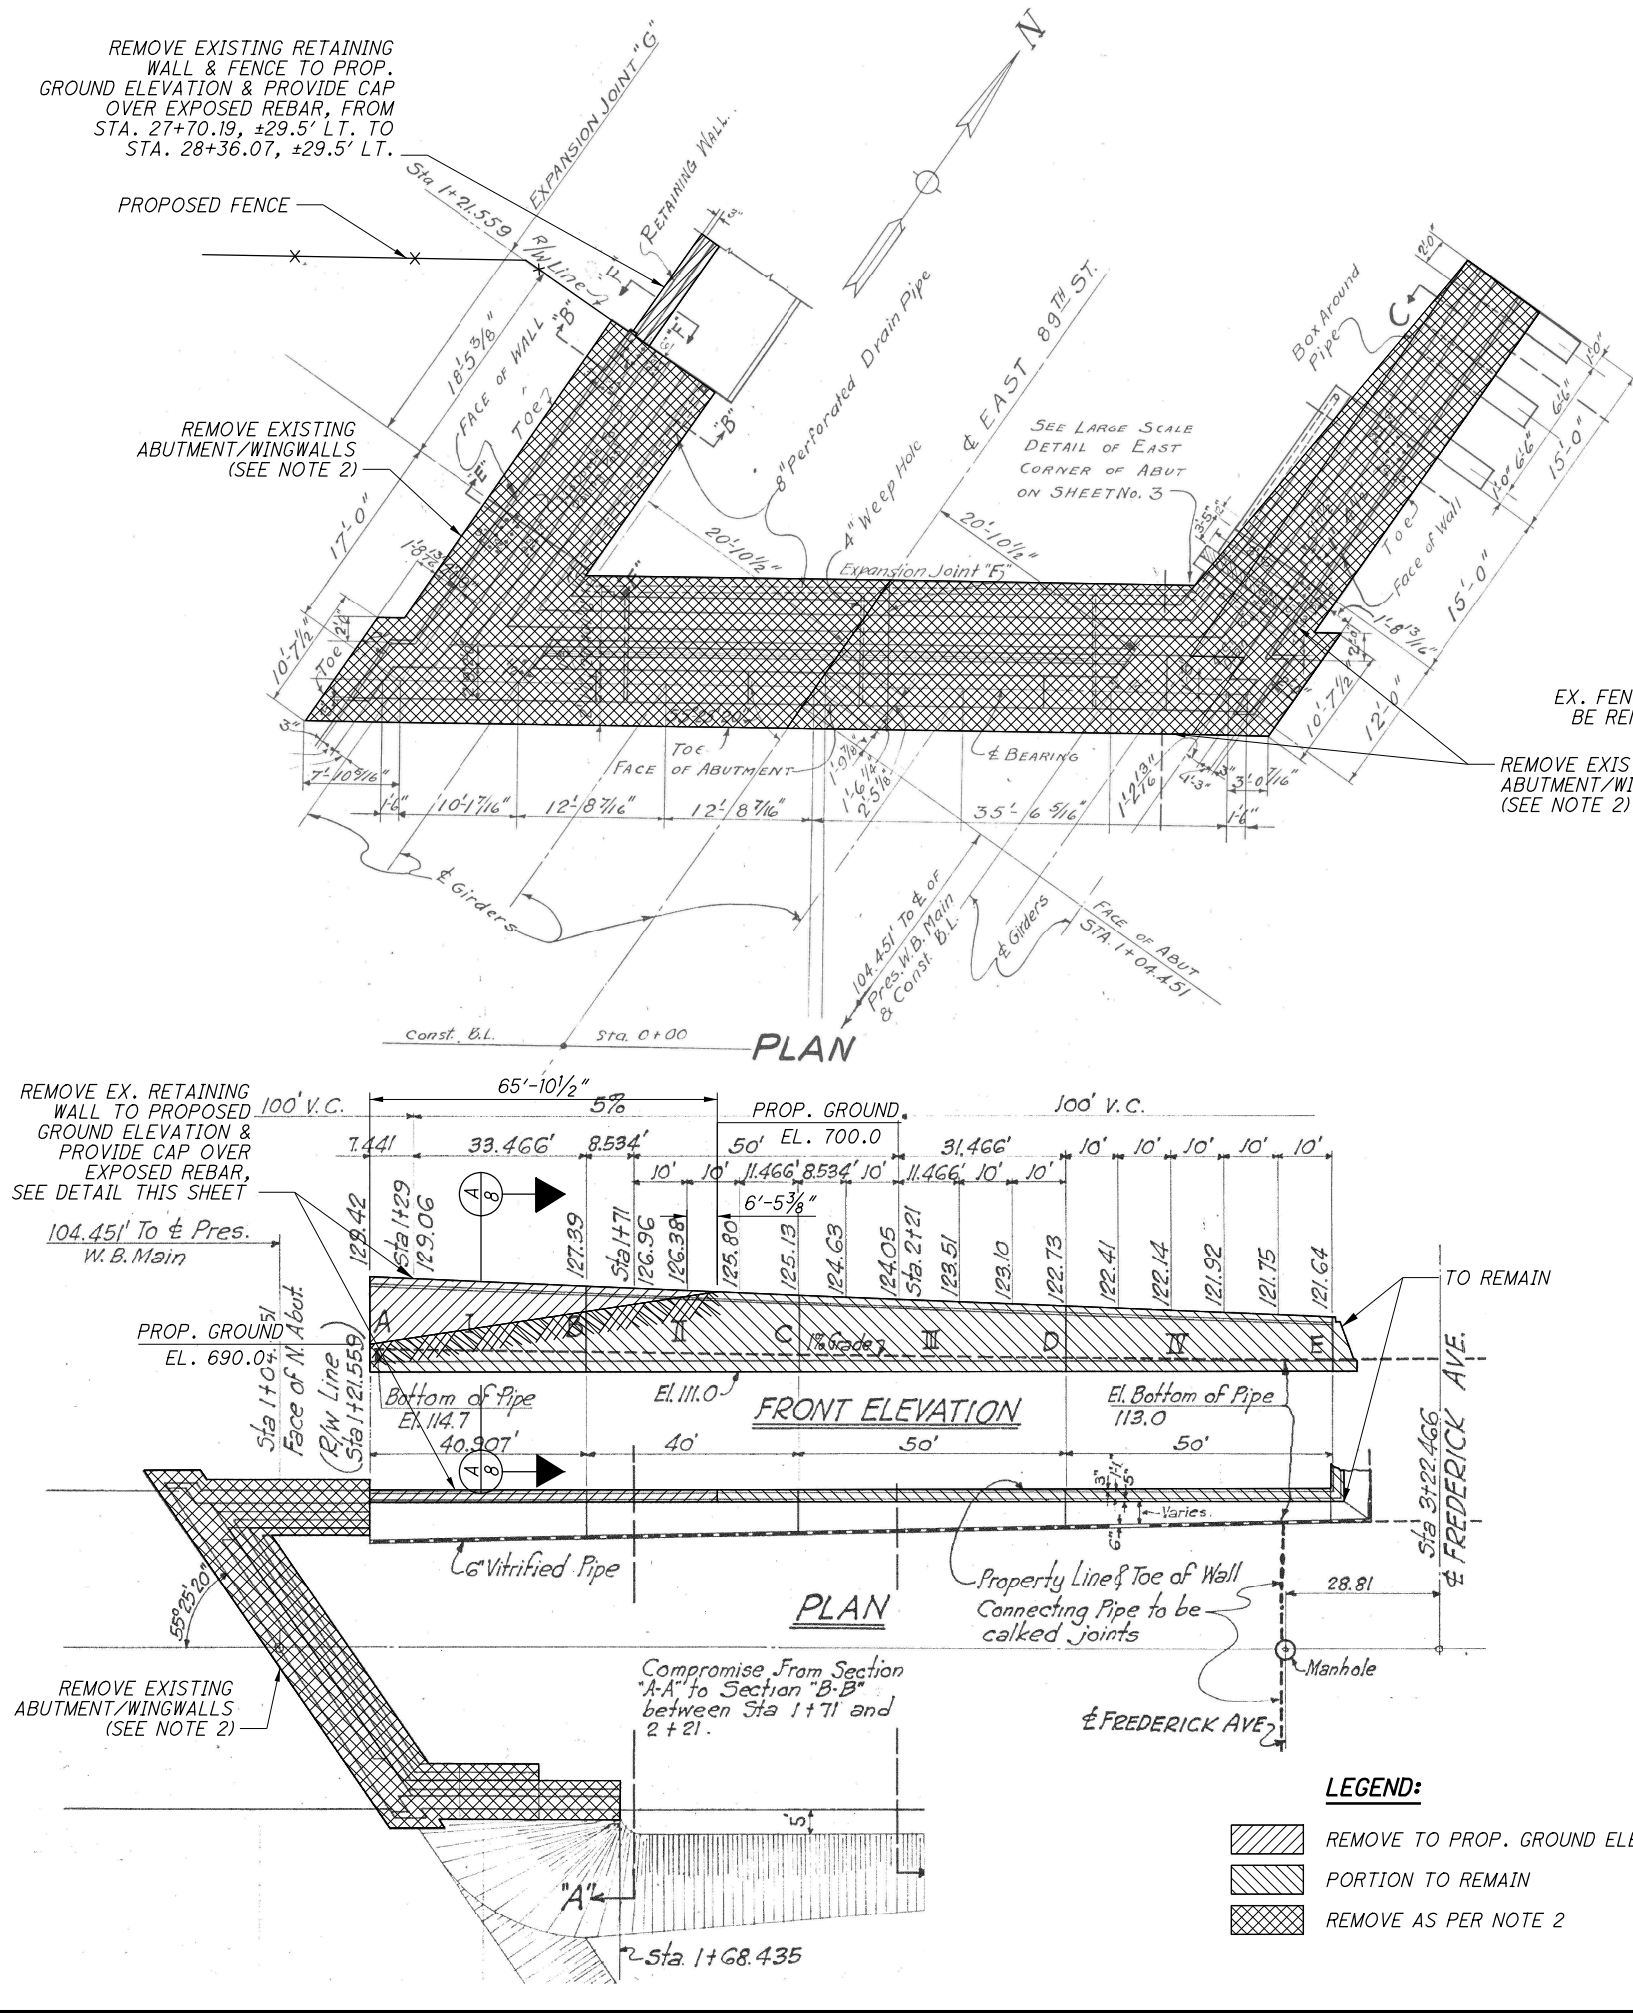


- NOTES:
- ALL EXISTING ELEVATIONS AND DIMENSIONS ARE ±.
 - EX. FORWARD ABUTMENT & WINGWALLS TO BE REMOVED FOLLOWING ODOT CMS 202.03.
 - DOWELS SHALL BE GROUTED WITH NON-SHRINK, NON-METALLIC GROUT AS PER CMS 705.20.
 - SEE SHEET 36/37 FOR REINFORCING SCHEDULE.


NO.	DATE	DESCRIPTION
0	2019-09-30	RFC
ISSUE RECORD		

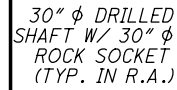


REAR ABUTMENT

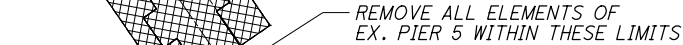

PIER 2

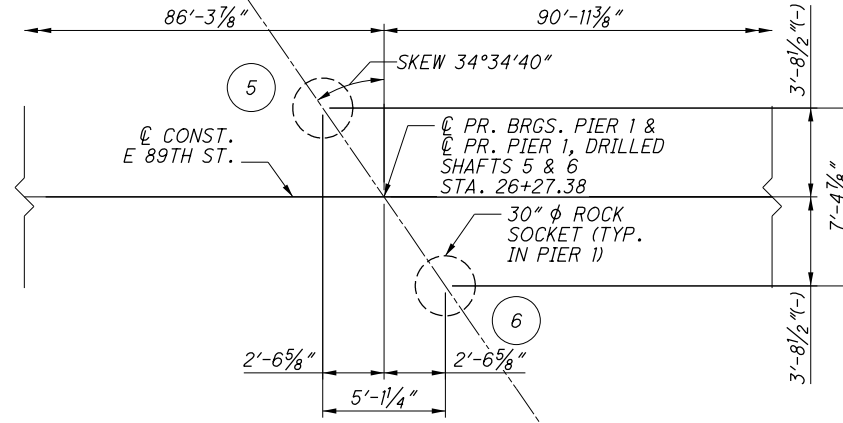

PIER 1

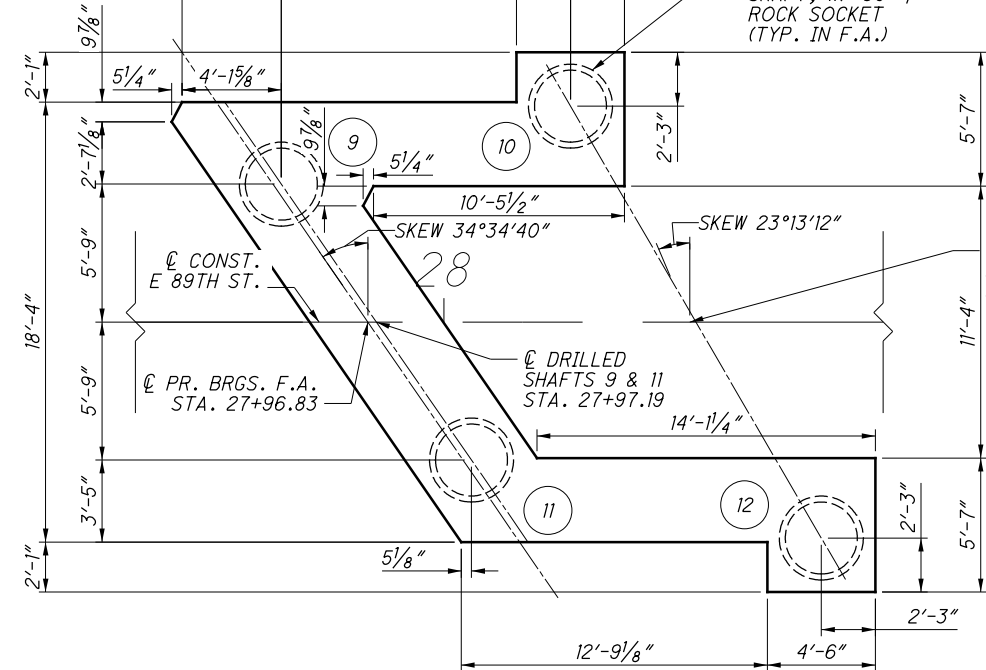

FORWARD ABUTMENT

LEGEND:

PROPOSED DRILLED SHAFT/ROCK SOCKET NUMBER

EX. PIER 5, FULL REMOVAL LIMITS

EX. PIER 5, LIMITS FOR REMOVAL AS PER ODOT CMS 202.03
AND ITEM 202 - STRUCTURE REMOVED, AS PER PLAN


NOTES:

1. ESTIMATED SHAFT LENGTHS:
 R.A. = 19'-0" SHAFT + 6'-0" ROCK SOCKET
 PIER 1 = 8'-0" ROCK SOCKET
 PIER 2 = 8'-0" ROCK SOCKET
 F.A. = 12' SHAFT + 6'-0" ROCK SOCKET

2. REMOVALS AS PER ITEM 202 - STRUCTURE REMOVED, AS PER PLAN: EXISTING PIERS 1 THROUGH 4 AND PORTIONS OF PIER 5 THAT ARE OUTSIDE OF THE FULL REMOVAL LIMITS SHALL BE REMOVED AS PER ODOT CMS 202.03, WITH THE EXCEPTION THAT THE PIERS SHALL BE REMOVED TO A SUFFICIENT DEPTH BELOW GRADE TO ENABLE RESTORATION OF THE EXISTING TRACK DITCH, BUT IN NO CASE LESS THAN 2 FEET BELOW FINAL GRADE.


			<div style="display: flex; align-items: center; justify-content: center;"> <div style="writing-mode: vertical-rl; transform: rotate(180deg);">CUR</div> <div style="margin: 0 10px;">9 / 37</div> <div style="border: 1px solid black; border-radius: 50%; padding: 10px; text-align: center;"> 11 39 </div> </div>
0	2019-09-30	RFC	
NO.	DATE	DESCRIPTION	
ISSUE RECORD			

WALL POINT	STA.	OFFSET	TOP OF COPING ELEV.
A	25+33.27	26.35', RT	704.12
B	25+37.79	23.23', RT	704.12
C	25+54.71	11.57', RT	697.50
D	25+46.73	0.00'	697.50
E	25+36.72	14.52', LT	697.50
F	25+12.47	26.58', LT	702.26
G	24+99.91	22.13', LT	702.26

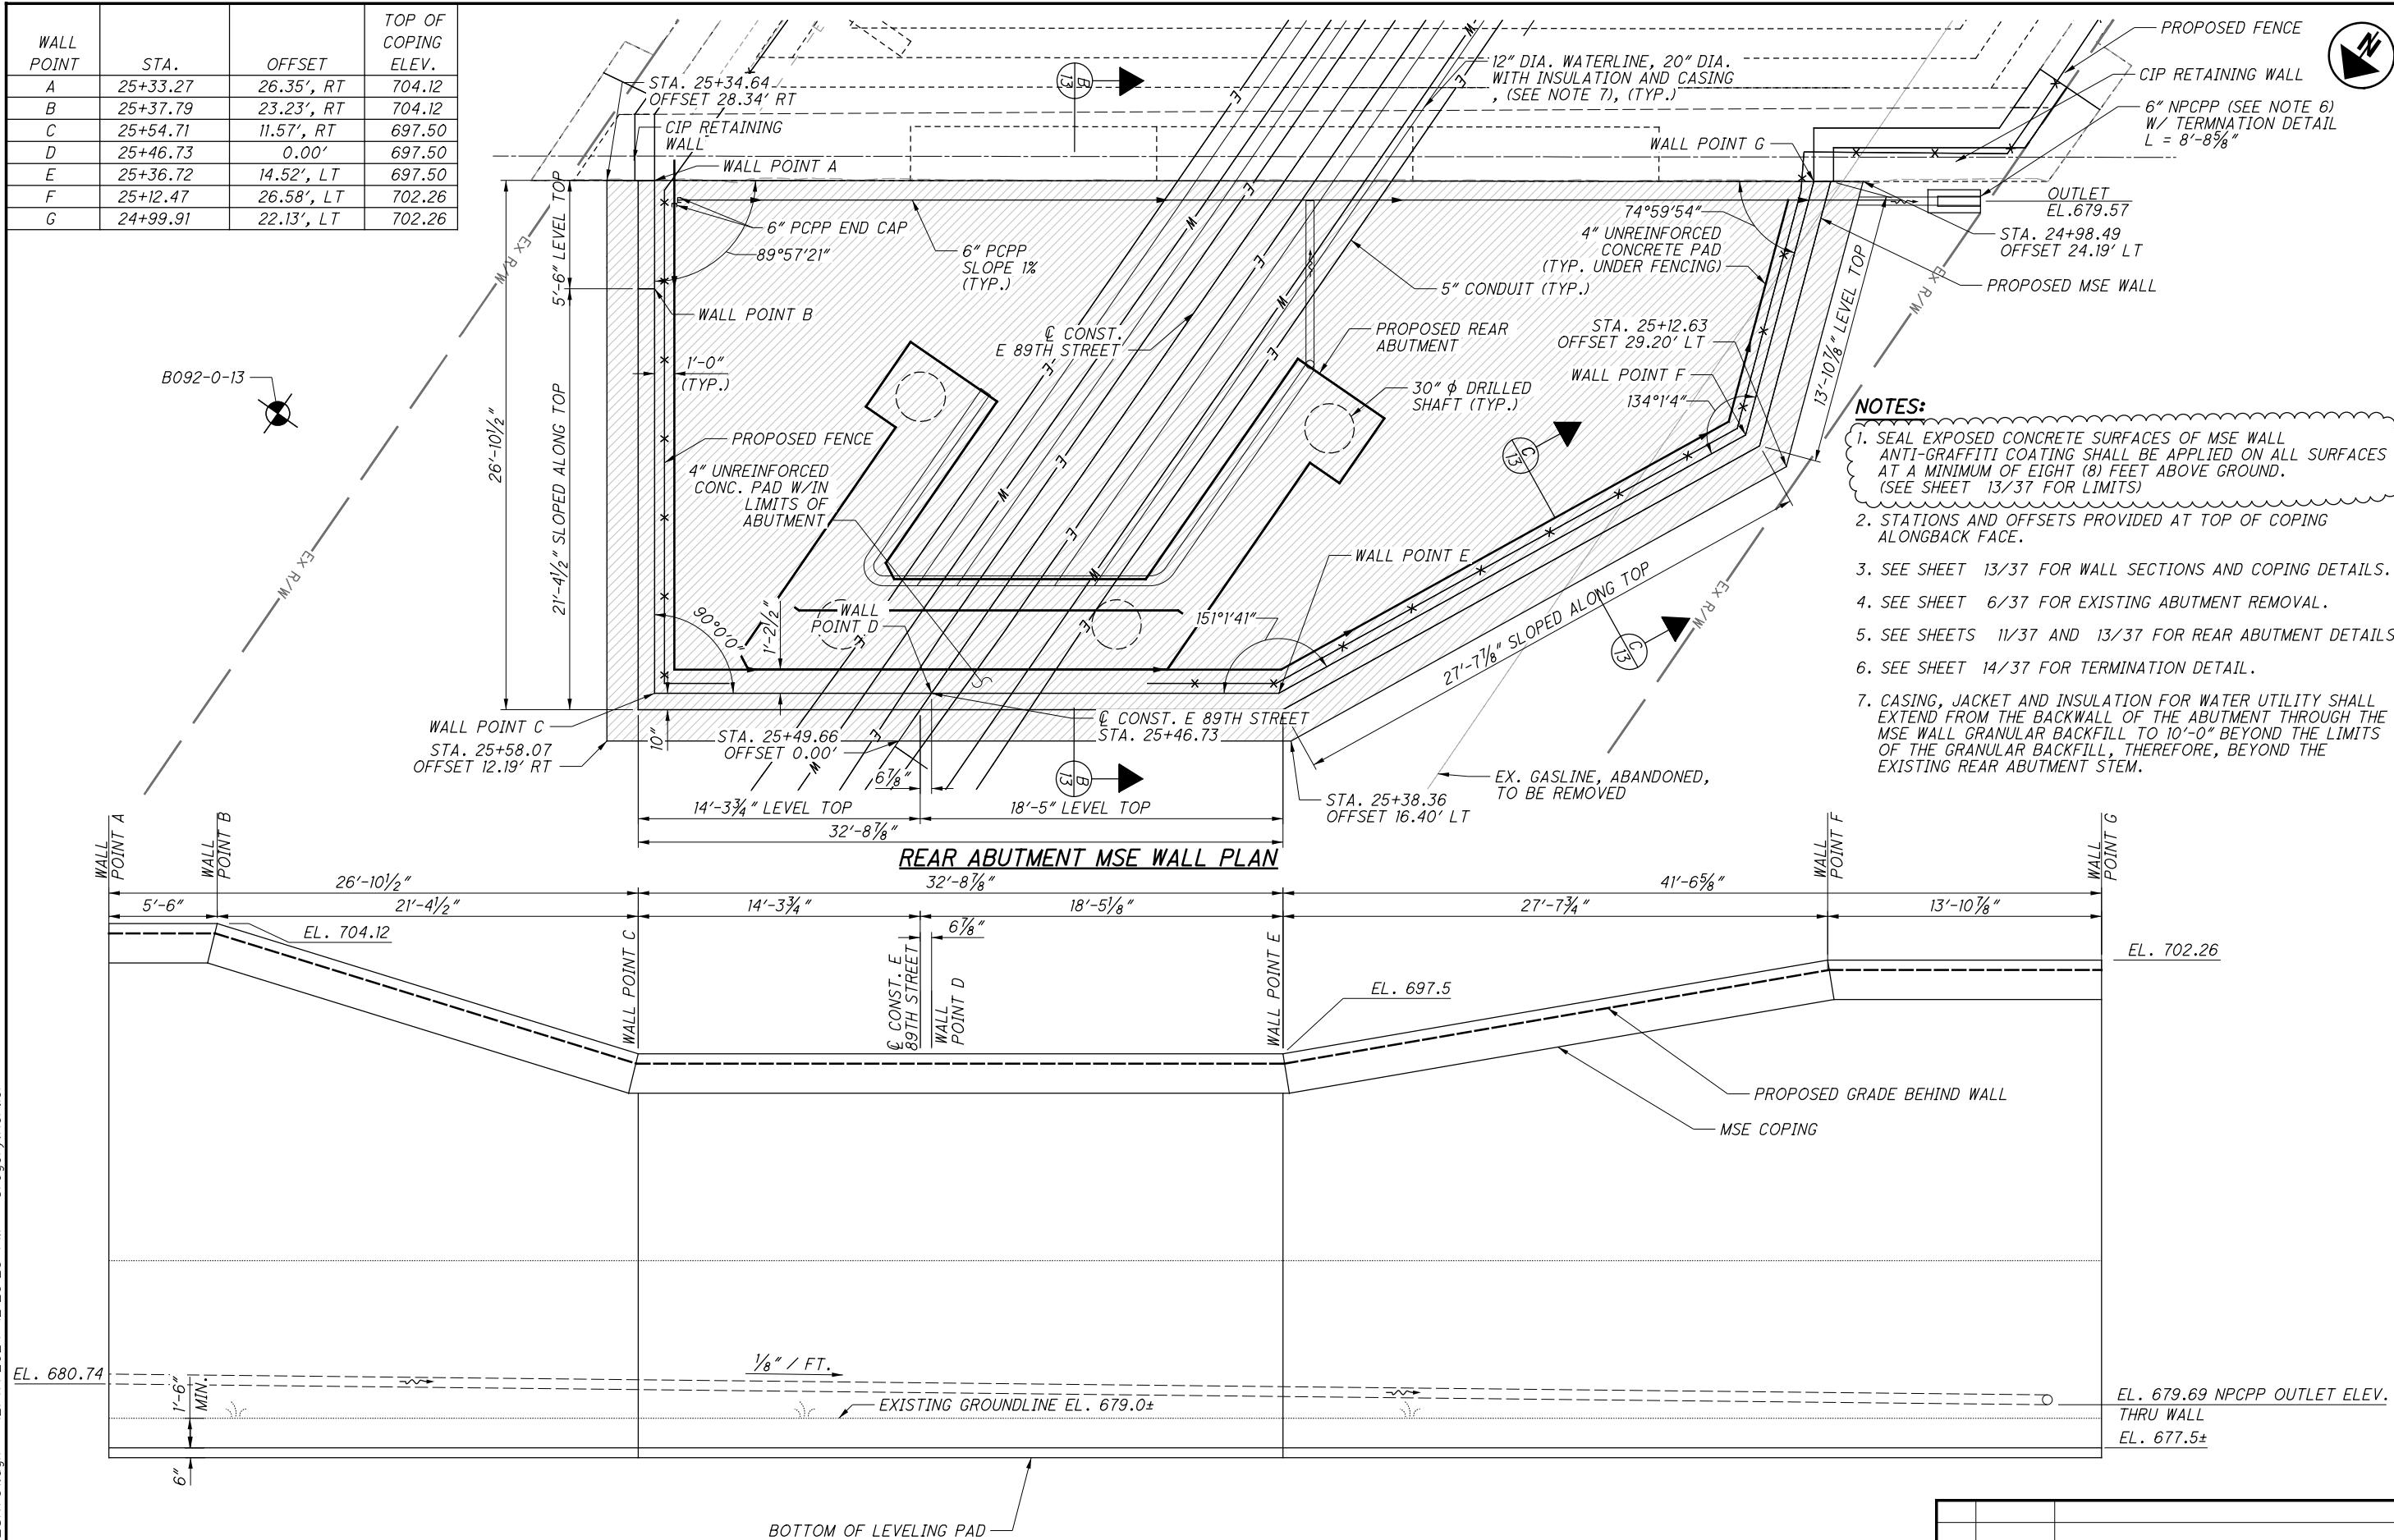


- NOTES:**
- SEAL EXPOSED CONCRETE SURFACES OF MSE WALL ANTI-GRAFFITI COATING SHALL BE APPLIED ON ALL SURFACES AT A MINIMUM OF EIGHT (8) FEET ABOVE GROUND. (SEE SHEET 13/37 FOR LIMITS)
 - STATIONS AND OFFSETS PROVIDED AT TOP OF COPING ALONGBACK FACE.
 - SEE SHEET 13/37 FOR WALL SECTIONS AND COPING DETAILS.
 - SEE SHEET 6/37 FOR EXISTING ABUTMENT REMOVAL.
 - SEE SHEETS 11/37 AND 13/37 FOR REAR ABUTMENT DETAILS.
 - SEE SHEET 14/37 FOR TERMINATION DETAIL.
 - CASING, JACKET AND INSULATION FOR WATER UTILITY SHALL EXTEND FROM THE BACKWALL OF THE ABUTMENT THROUGH THE MSE WALL GRANULAR BACKFILL TO 10'-0" BEYOND THE LIMITS OF THE GRANULAR BACKFILL, THEREFORE, BEYOND THE EXISTING REAR ABUTMENT STEM.

NO.	DATE	DESCRIPTION
1	2024-09-10	RECORD DRAWINGS
0	2019-09-30	RFC
ISSUE RECORD		

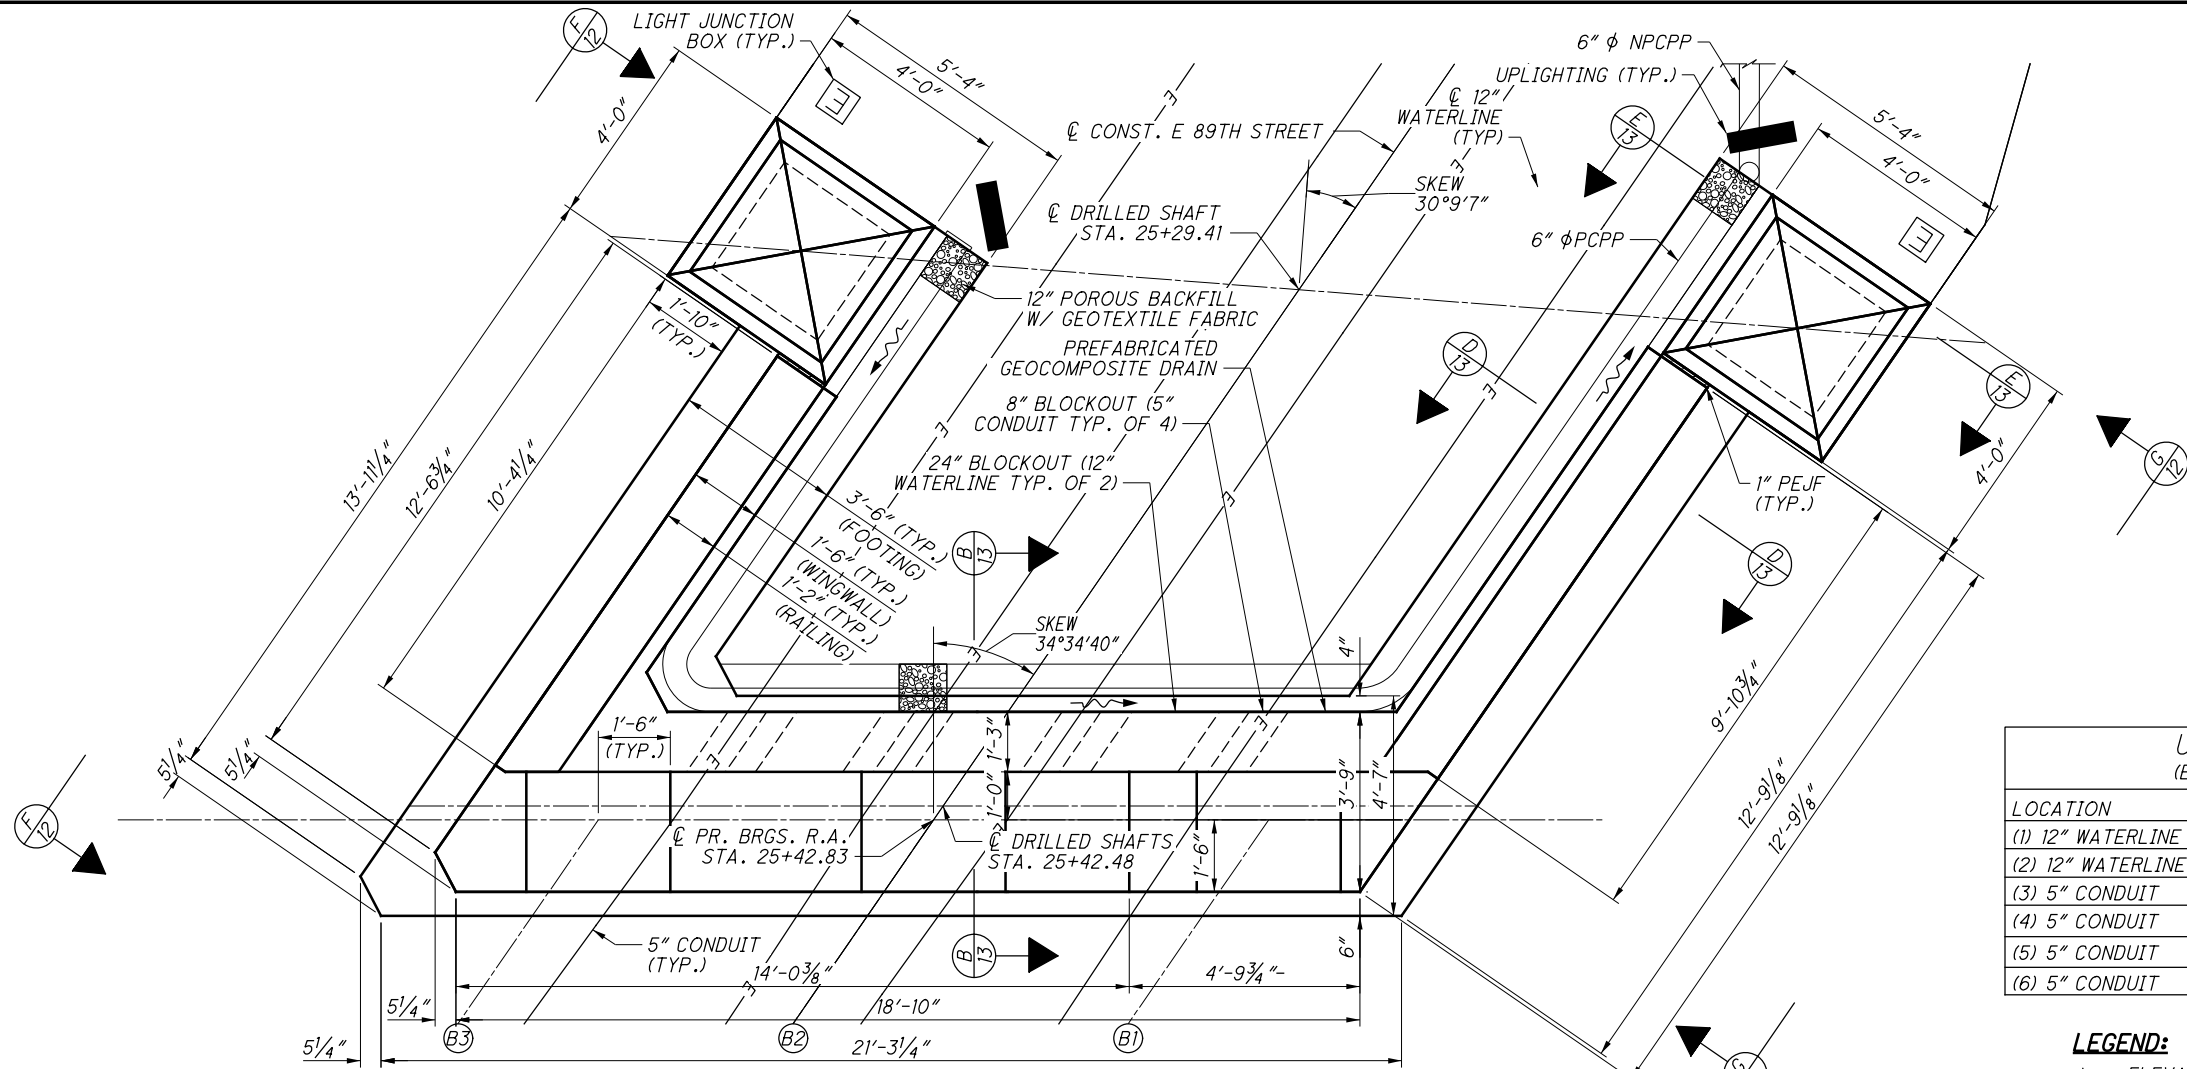

REAR ABUTMENT PLAN

(MSE WALL & DRILLED SHAFTS NOT SHOWN FOR CLARITY)

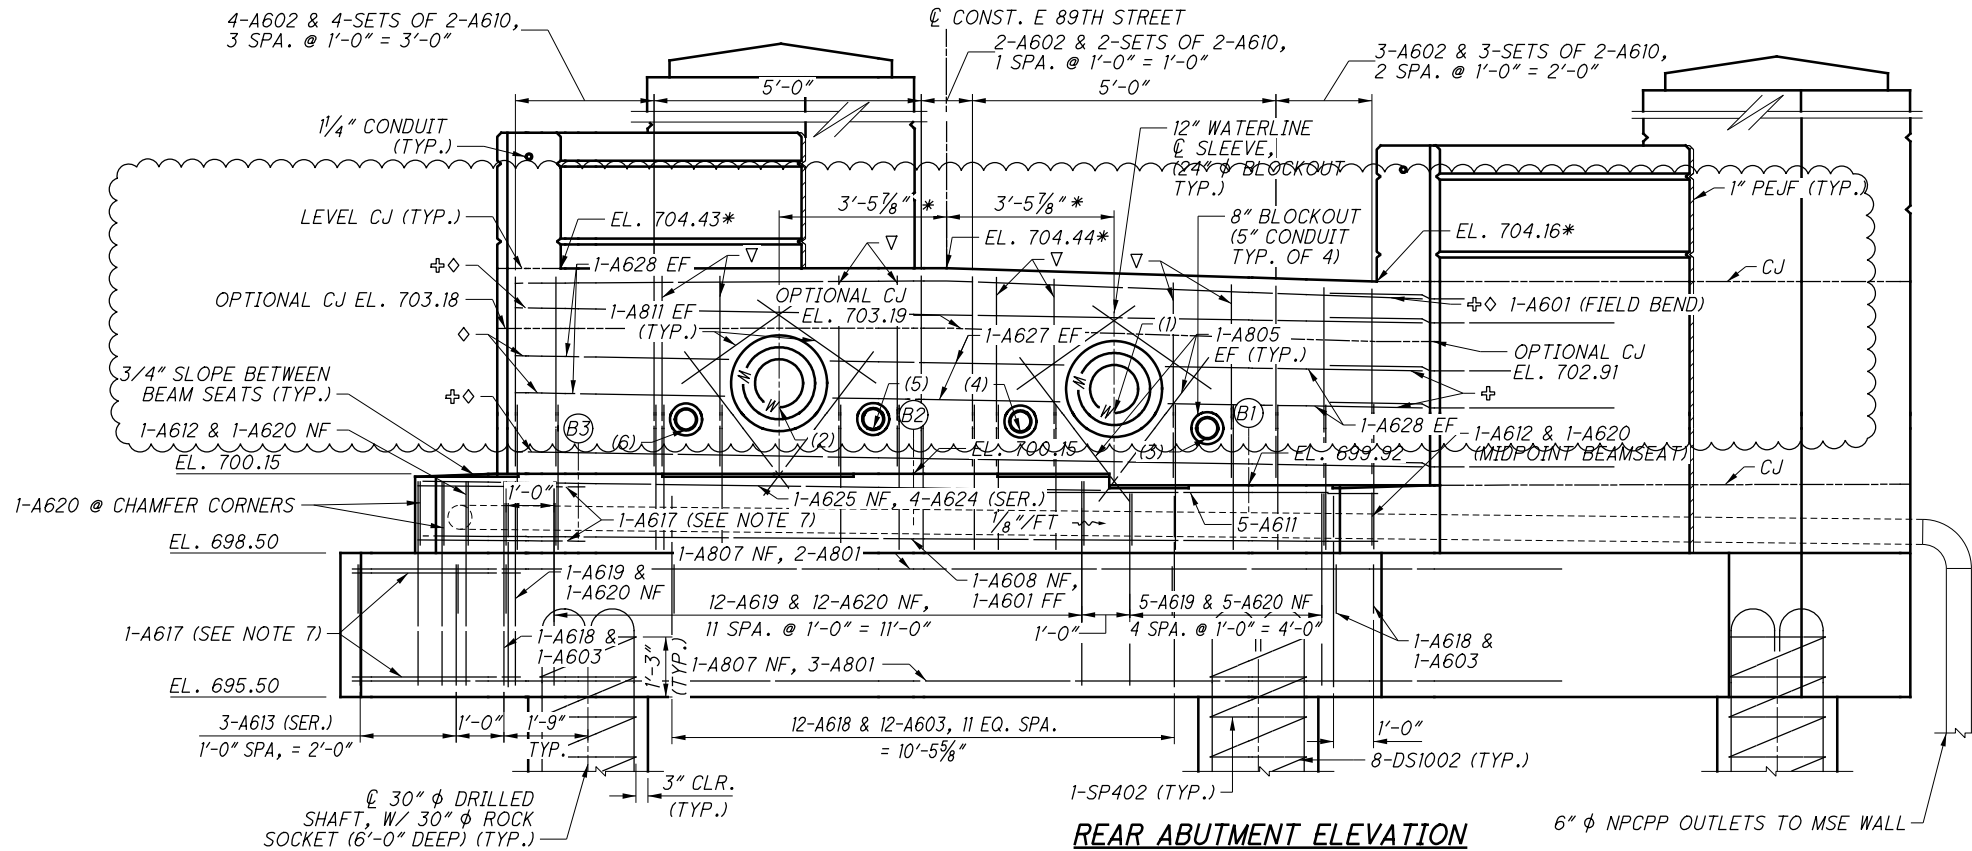

REAR ABUTMENT ELEVATION

(MSE WALL NOT SHOWN FOR CLARITY)

MIN. LAP LENGTH	
# 6	3'-10"

UTILITY & INFORMATION (ELEVATIONS PROVIDED AT INVERT)			
LOCATION	ELEVATIONS	STATION	OFFSET
(1) 12" WATERLINE	701.25	25+39.63	2.88' LT
(2) 12" WATERLINE	701.37	25+43.60	2.88' RT
(3) 5" CONDUIT	700.91	25+38.53	4.47' LT
(4) 5" CONDUIT	701.03	25+40.74	1.27' LT
(5) 5" CONDUIT	701.08	25+42.48	4.47' RT
(6) 5" CONDUIT	701.09	25+44.70	1.27' RT

LEGEND:

* - ELEVATIONS PROVIDED ALONG BACKWALL

(#) - UTILITY DESIGNATION

(BX) - BEAM DESIGNATION

▽ - 1-A622 & 1-SET OF 2-A610 PLACED PARALLEL TO BLOCKOUT

⊕ - 1-A623 TO LAP A607 IN WINGWALLS AND A601 & A614 IN BACKWALLS

◇ - 1-A626 NF TO LAP A607 IN WINGWALLS AND A601 & A614 IN BACKWALLS

NOTES:

1. SEE SECTIONS B, D AND E ON SHEET 13/37.

2. SEE SHEET 10/37 FOR MSE WALL DETAILS.

3. SEE SHEET 12/37 FOR VIEWS F AND G AND WINGWALL REINFORCING.


4. SEE SHEET 30/37 FOR PYLON REINFORCING AND DETAILS.

5. SEE SHEETS 26/37 AND 27/37 FOR RAILING REINFORCING AND DETAILS.

6. SEE SHEET 35/37 FOR REINFORCING SCHEDULE.

7. A617 TO LAP A609 WINGWALL BARS, A601 BARS AND A614 BAR ALONG CHAMFERED CORNER.

NO.	DATE	DESCRIPTION
1	2024-09-10	RECORD DRAWINGS
0	2019-09-30	RFC
ISSUE RECORD		

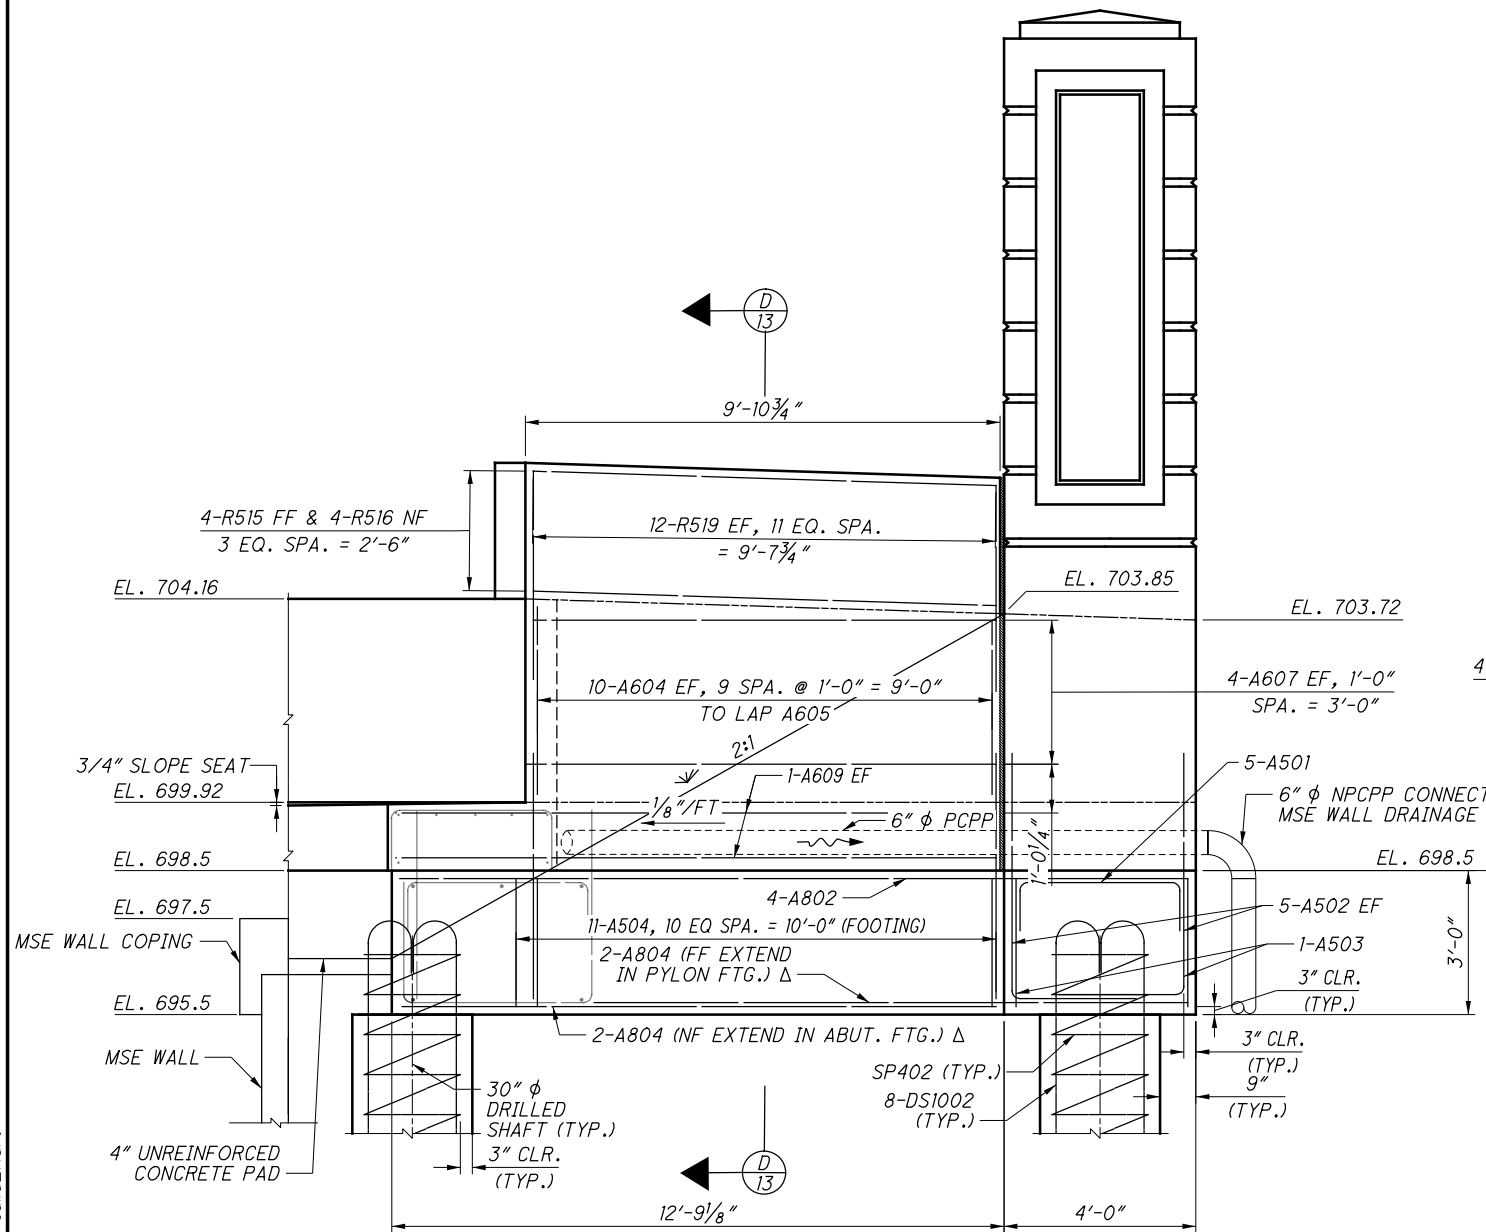


LEFT WINGWALL ELEVATION

G VIEW
11

LEGEND:

Δ PLACED TO AVOID DRILLED SHAFTS

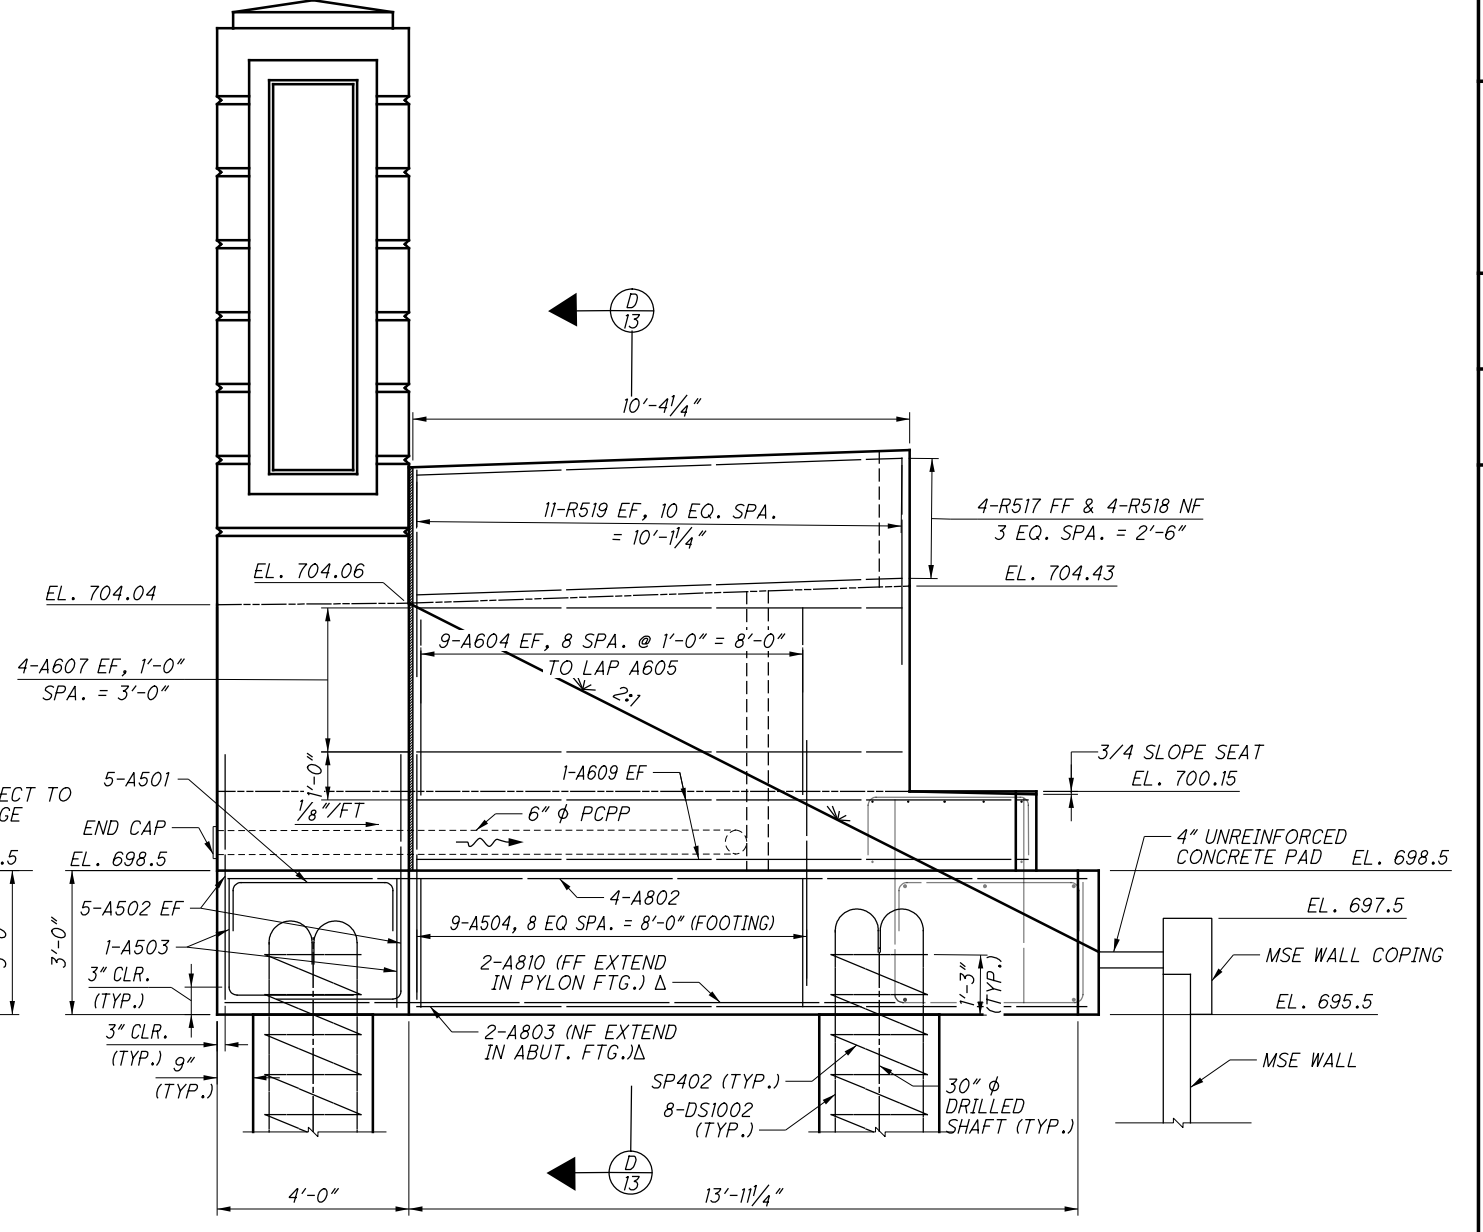

RIGHT WINGWALL ELEVATION

F VIEW
11

NOTES:

1. SEE SHEET 11/37 FOR ABUTMENT PLAN & ELEVATION.
2. SEE SHEET 12/37 FOR LOCATION OF VIEWS F & G.
3. SEE SHEET 30/37 FOR PYLON REINFORCEMENT.
4. SEE SHEETS 26/37 AND 27/37 FOR RAILING REINFORCEMENT.
5. SEE SHEET 35/37 FOR REINFORCING SCHEDULE.

MIN. LAP LENGTH	
# 6	3'-10"

NO.	DATE	DESCRIPTION
0	2019-09-30	RFC
ISSUE RECORD		

NOTES:


1. SEAL EXPOSED CONCRETE SURFACES. ANTI- GRAFFITI COATING SHALL BE APPLIED ON ALL SURFACES AT A MINIMUM OF EIGHT (8) FEET ABOVE GROUND.
2. LEVEL PAD TO BE PLACED ON ROCK. IF ROCK IS DEEPER THAN ANTICIPATED, EXCAVATE TO ROCK AND REPLACE WITH ITEM 203, GRANULAR MATERIAL TYPE C.
3. REFER TO SHEET 10/37 FOR OUTLET LOCATIONS.
4. REFER TO SHEET 32/37 FOR EXPANSION JOINT DETAILS.
5. SEE SHEETS 26/37 AND 27/37 FOR RAILING REINFORCEMENT AND SHEET 30/37 FOR PYLON REINFORCEMENT. SEE SHEET 35/37 FOR REINFORCING SCHEDULE.
6. REFER TO SHEET 34/37 FOR UTILITY CASING PIPE THROUGH THE BACKWALL.

1	2024-09-10	RECORD DRAWINGS
0	2019-09-30	RFC
NO.	DATE	DESCRIPTION
ISSUE RECORD		



FORWARD ABUTMENT PLAN
(DRILLED SHAFTS NOT SHOWN FOR CLARITY)



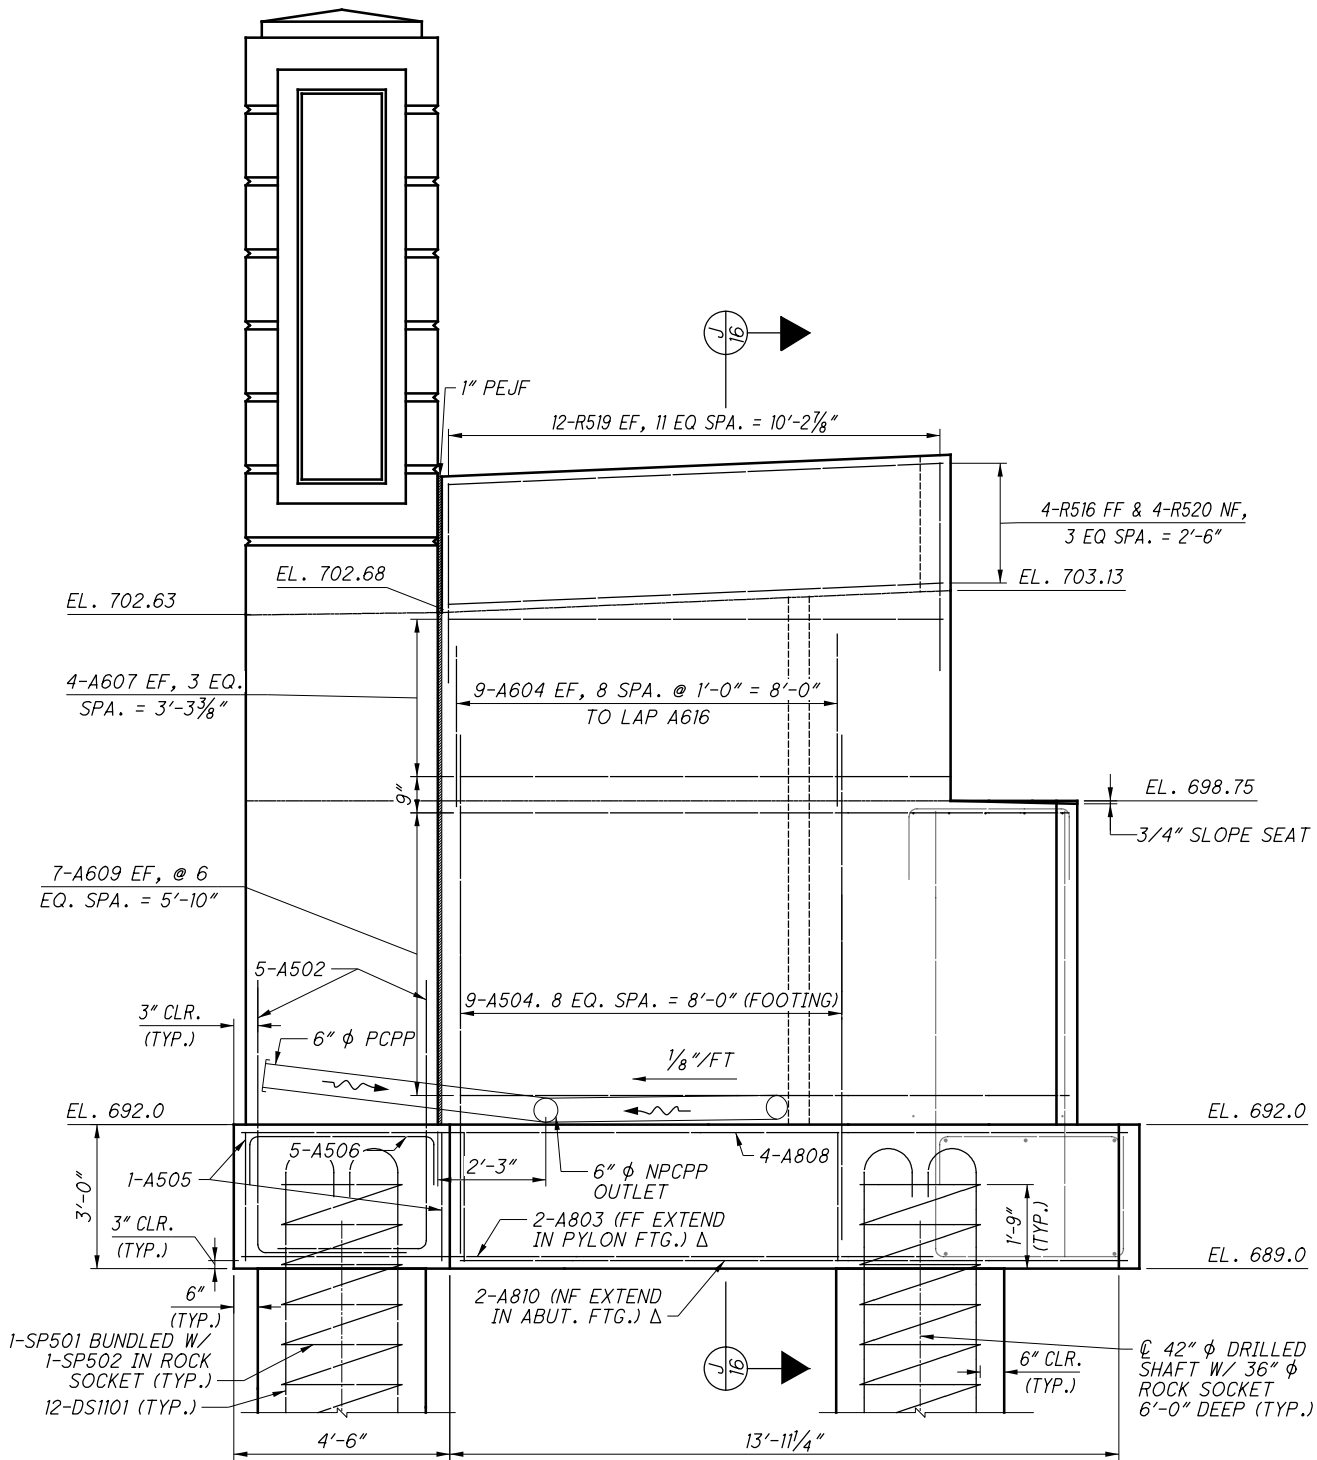


LEFT WINGWALL ELEVATION

M SECTION
11

LEGEND:

Δ PLACED TO AVOID DRILLED SHAFTS

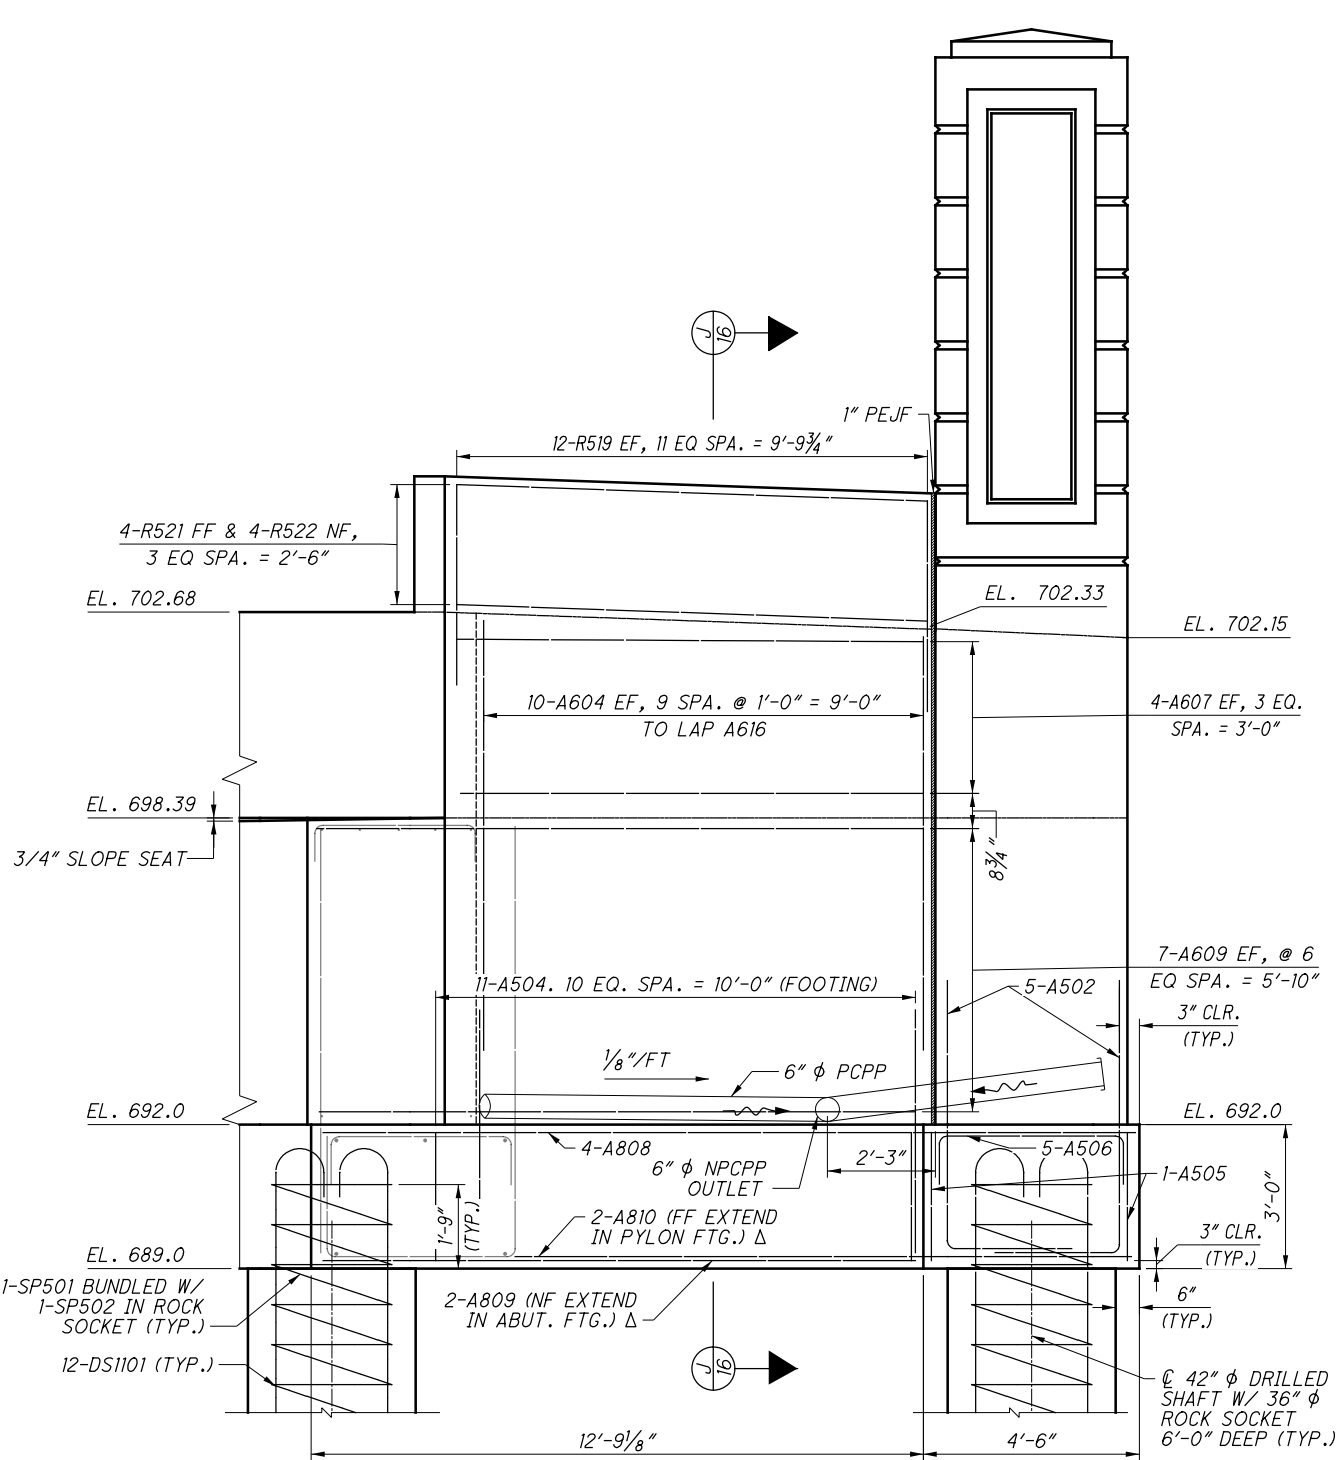

RIGHT WINGWALL ELEVATION


L SECTION
11

NOTES:

1. SEE SHEET 14/37 FOR ABUTMENT PLAN & ELEVATION.
2. SEE SHEET 14/37 FOR LOCATION OF VIEWS L & M AND SECTION B.
3. SEE SHEETS 29/37 FOR PYLON REINFORCEMENT.
4. SEE SHEETS 26/37 AND 27/37 FOR RAILING REINFORCEMENT.
5. SEE SHEET 35/37 FOR REINFORCING SCHEDULE.



MIN. LAP LENGTH	
# 6	3'-10"

NO.	DATE	DESCRIPTION
0	2019-09-30	RFC
ISSUE RECORD		

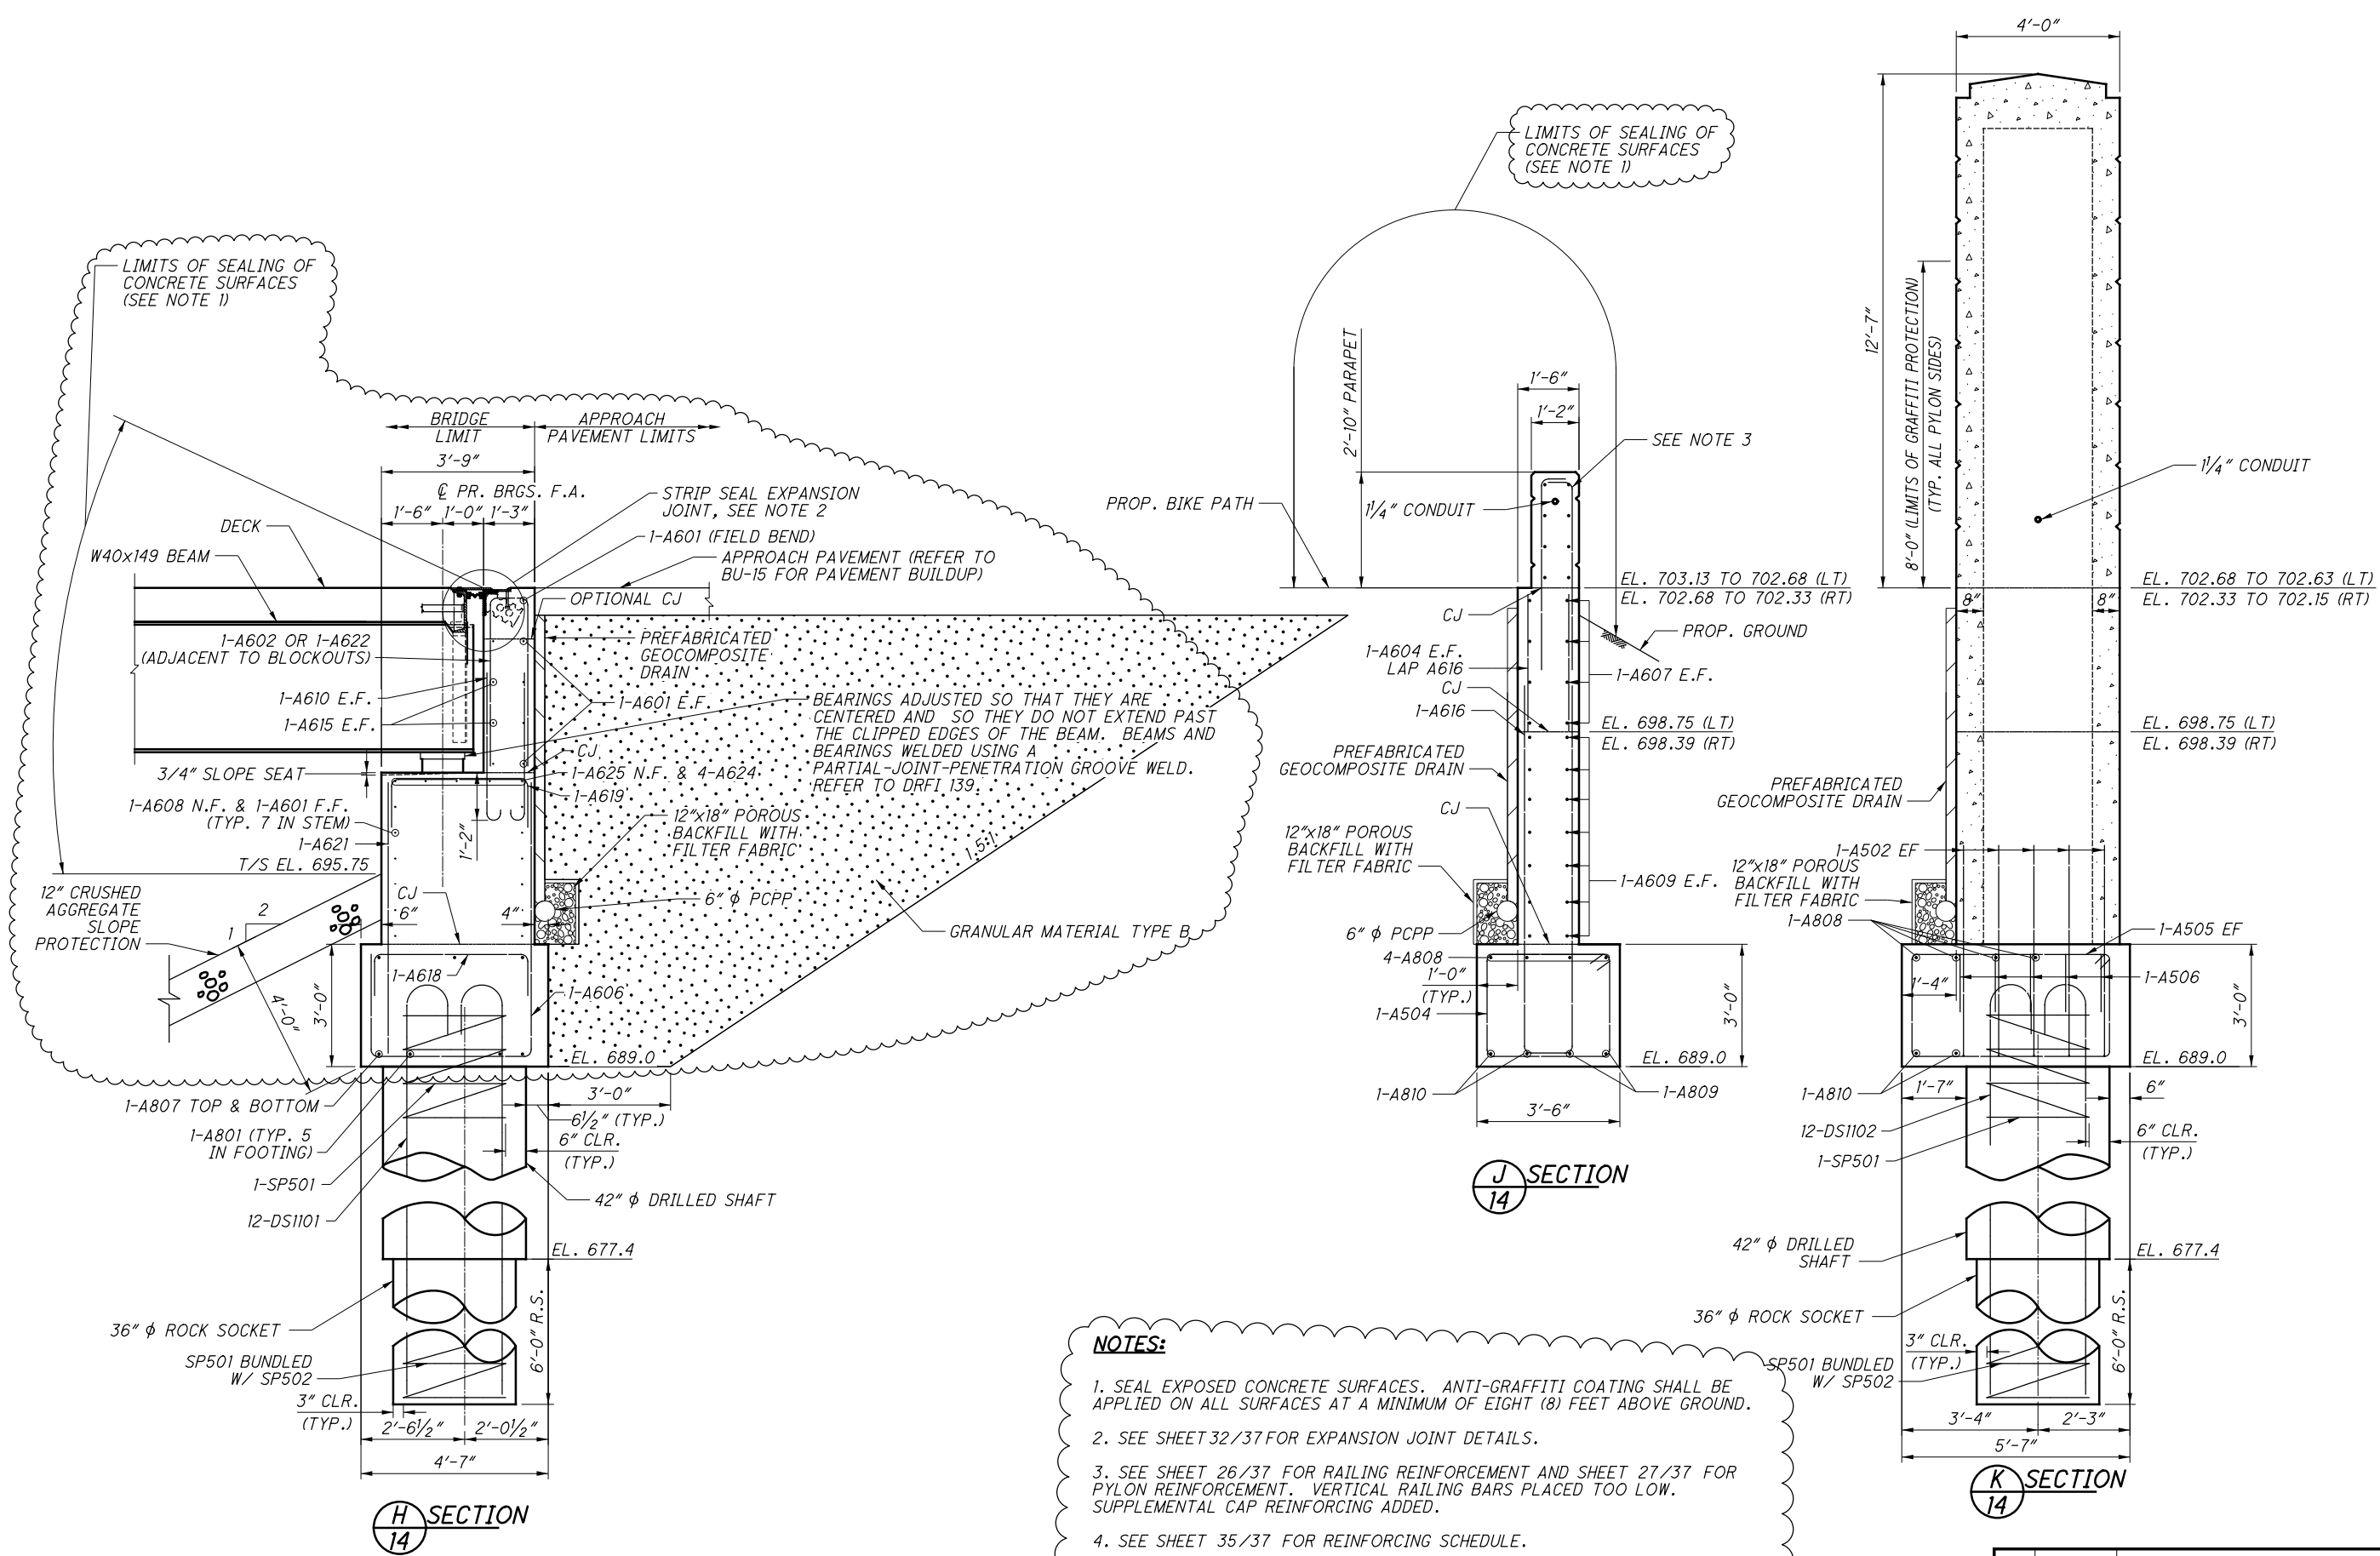

MIN. LAP LENGTH		
# 6	3'-10"	

NO.	DATE	DESCRIPTION
1	2024-09-10	RECORD DRAWINGS
0	2019-09-30	RFC
ISSUE RECORD		

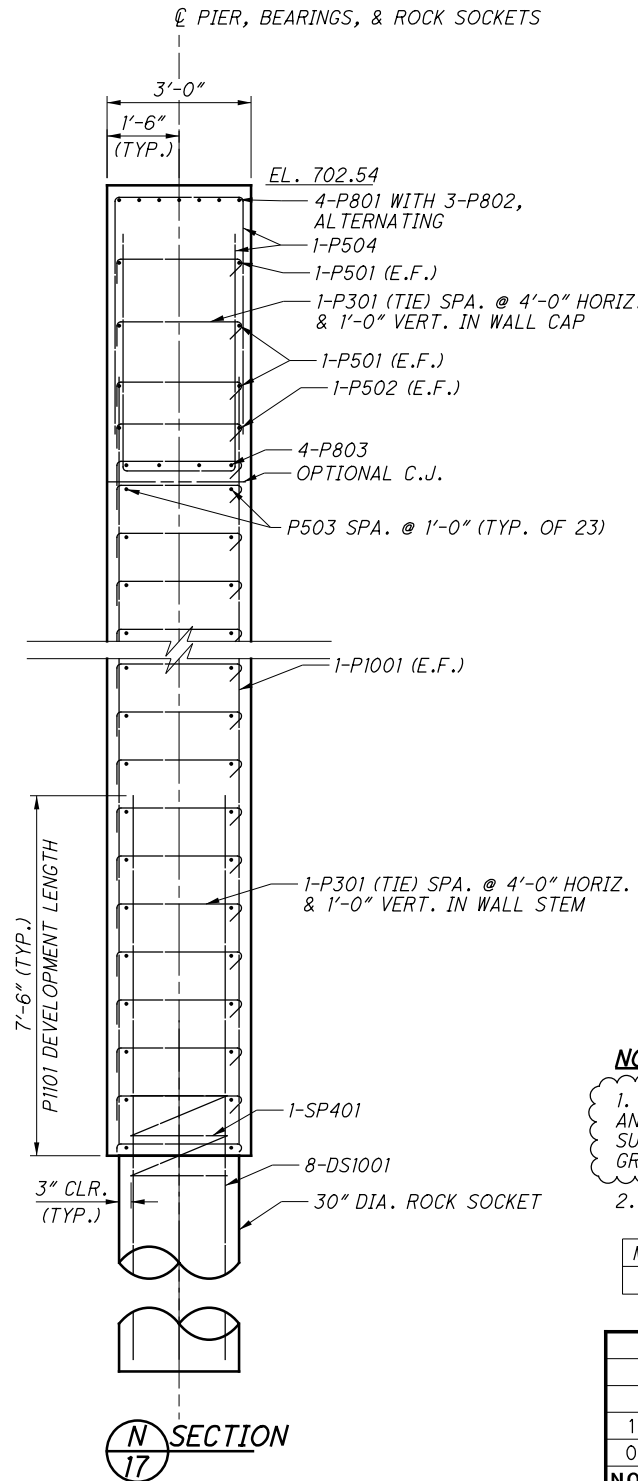
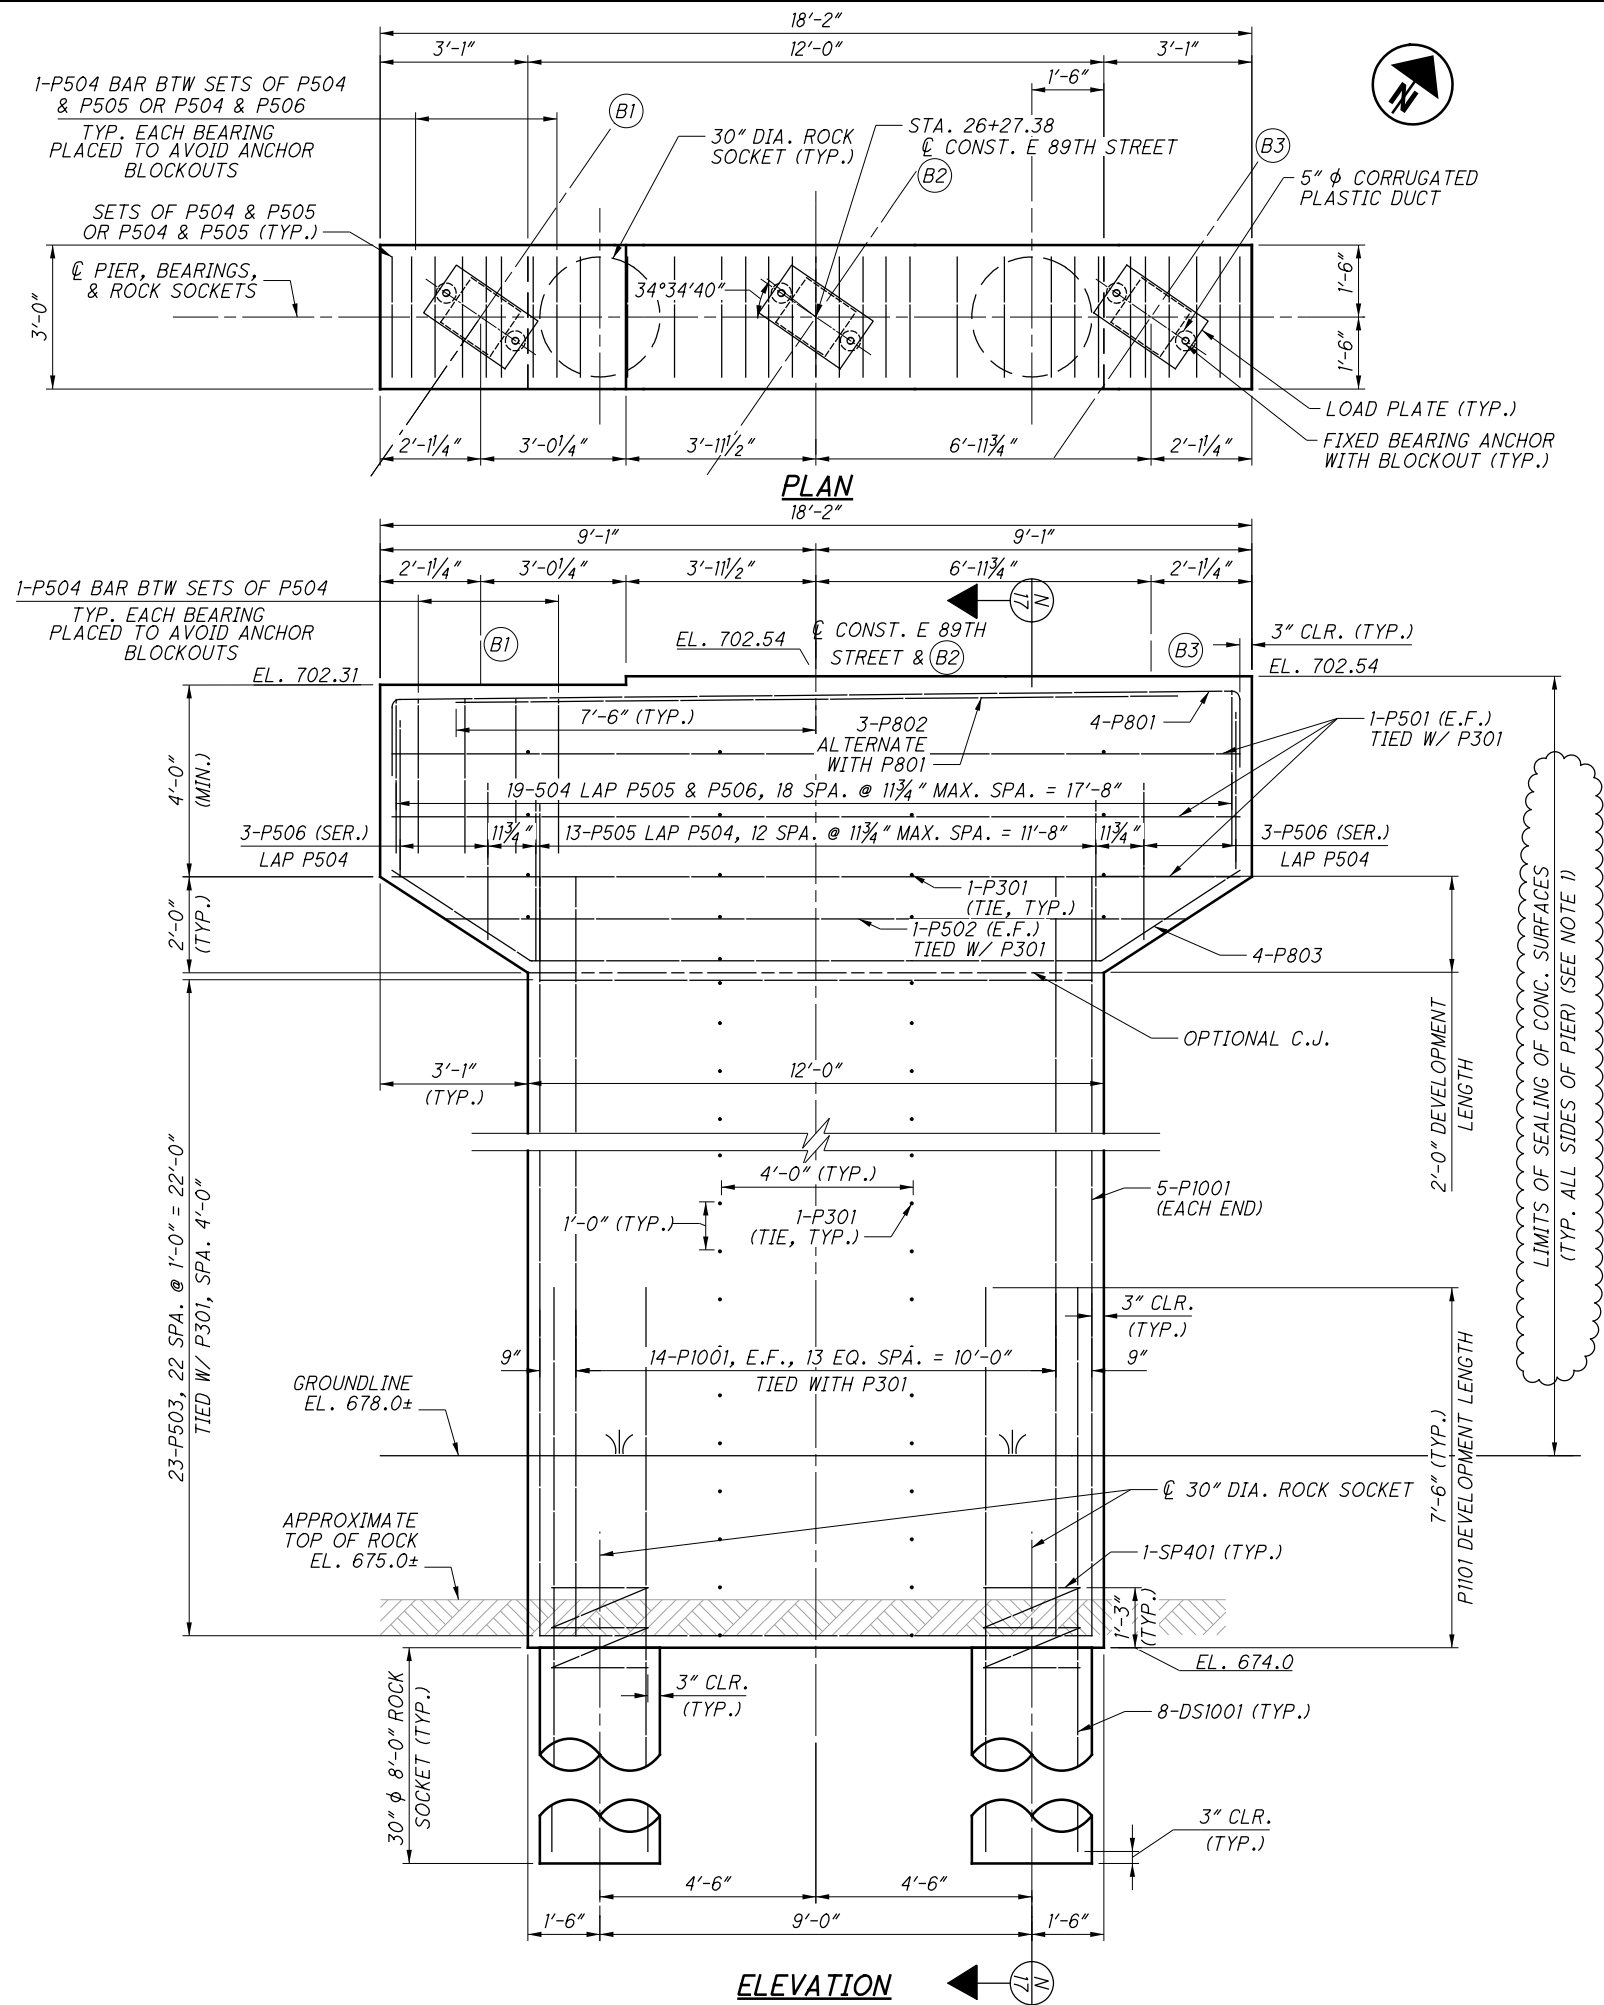


NOTES:
1. SEAL EXPOSED CONCRETE SURFACES. ANTI-GRAFFITI COATING SHALL BE APPLIED ON ALL SURFACES AT A MINIMUM OF EIGHT (8) FEET ABOVE GROUND.
2. SEE SHEET 36/37 FOR REINFORCING SCHEDULE.




MIN. LAP LENGTH	
# 5	2'-5"

NO.	DATE	DESCRIPTION
1	2024-09-10	RECORD DRAWINGS
0	2019-09-30	RFC
ISSUE RECORD		

17	37
19	39

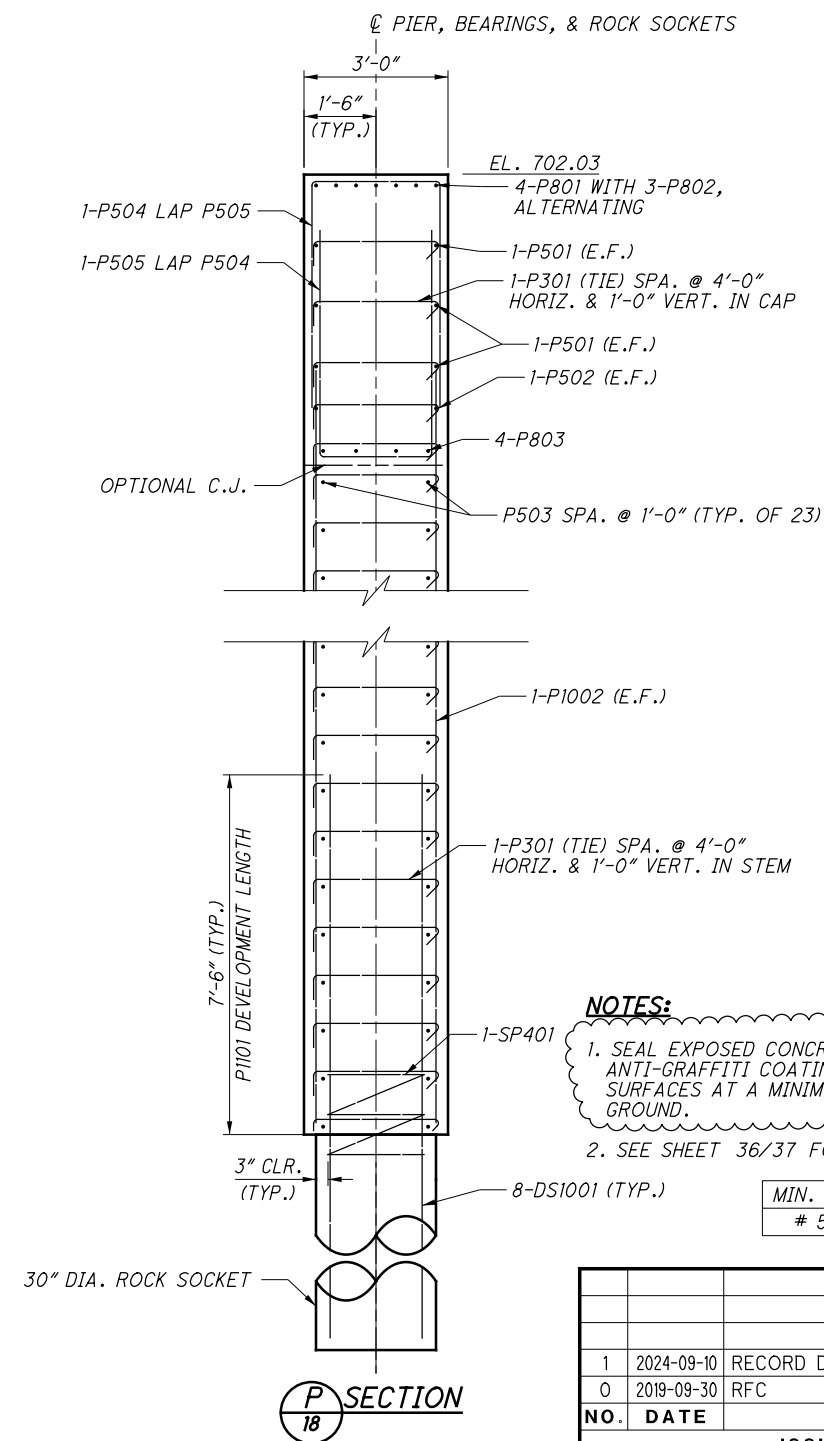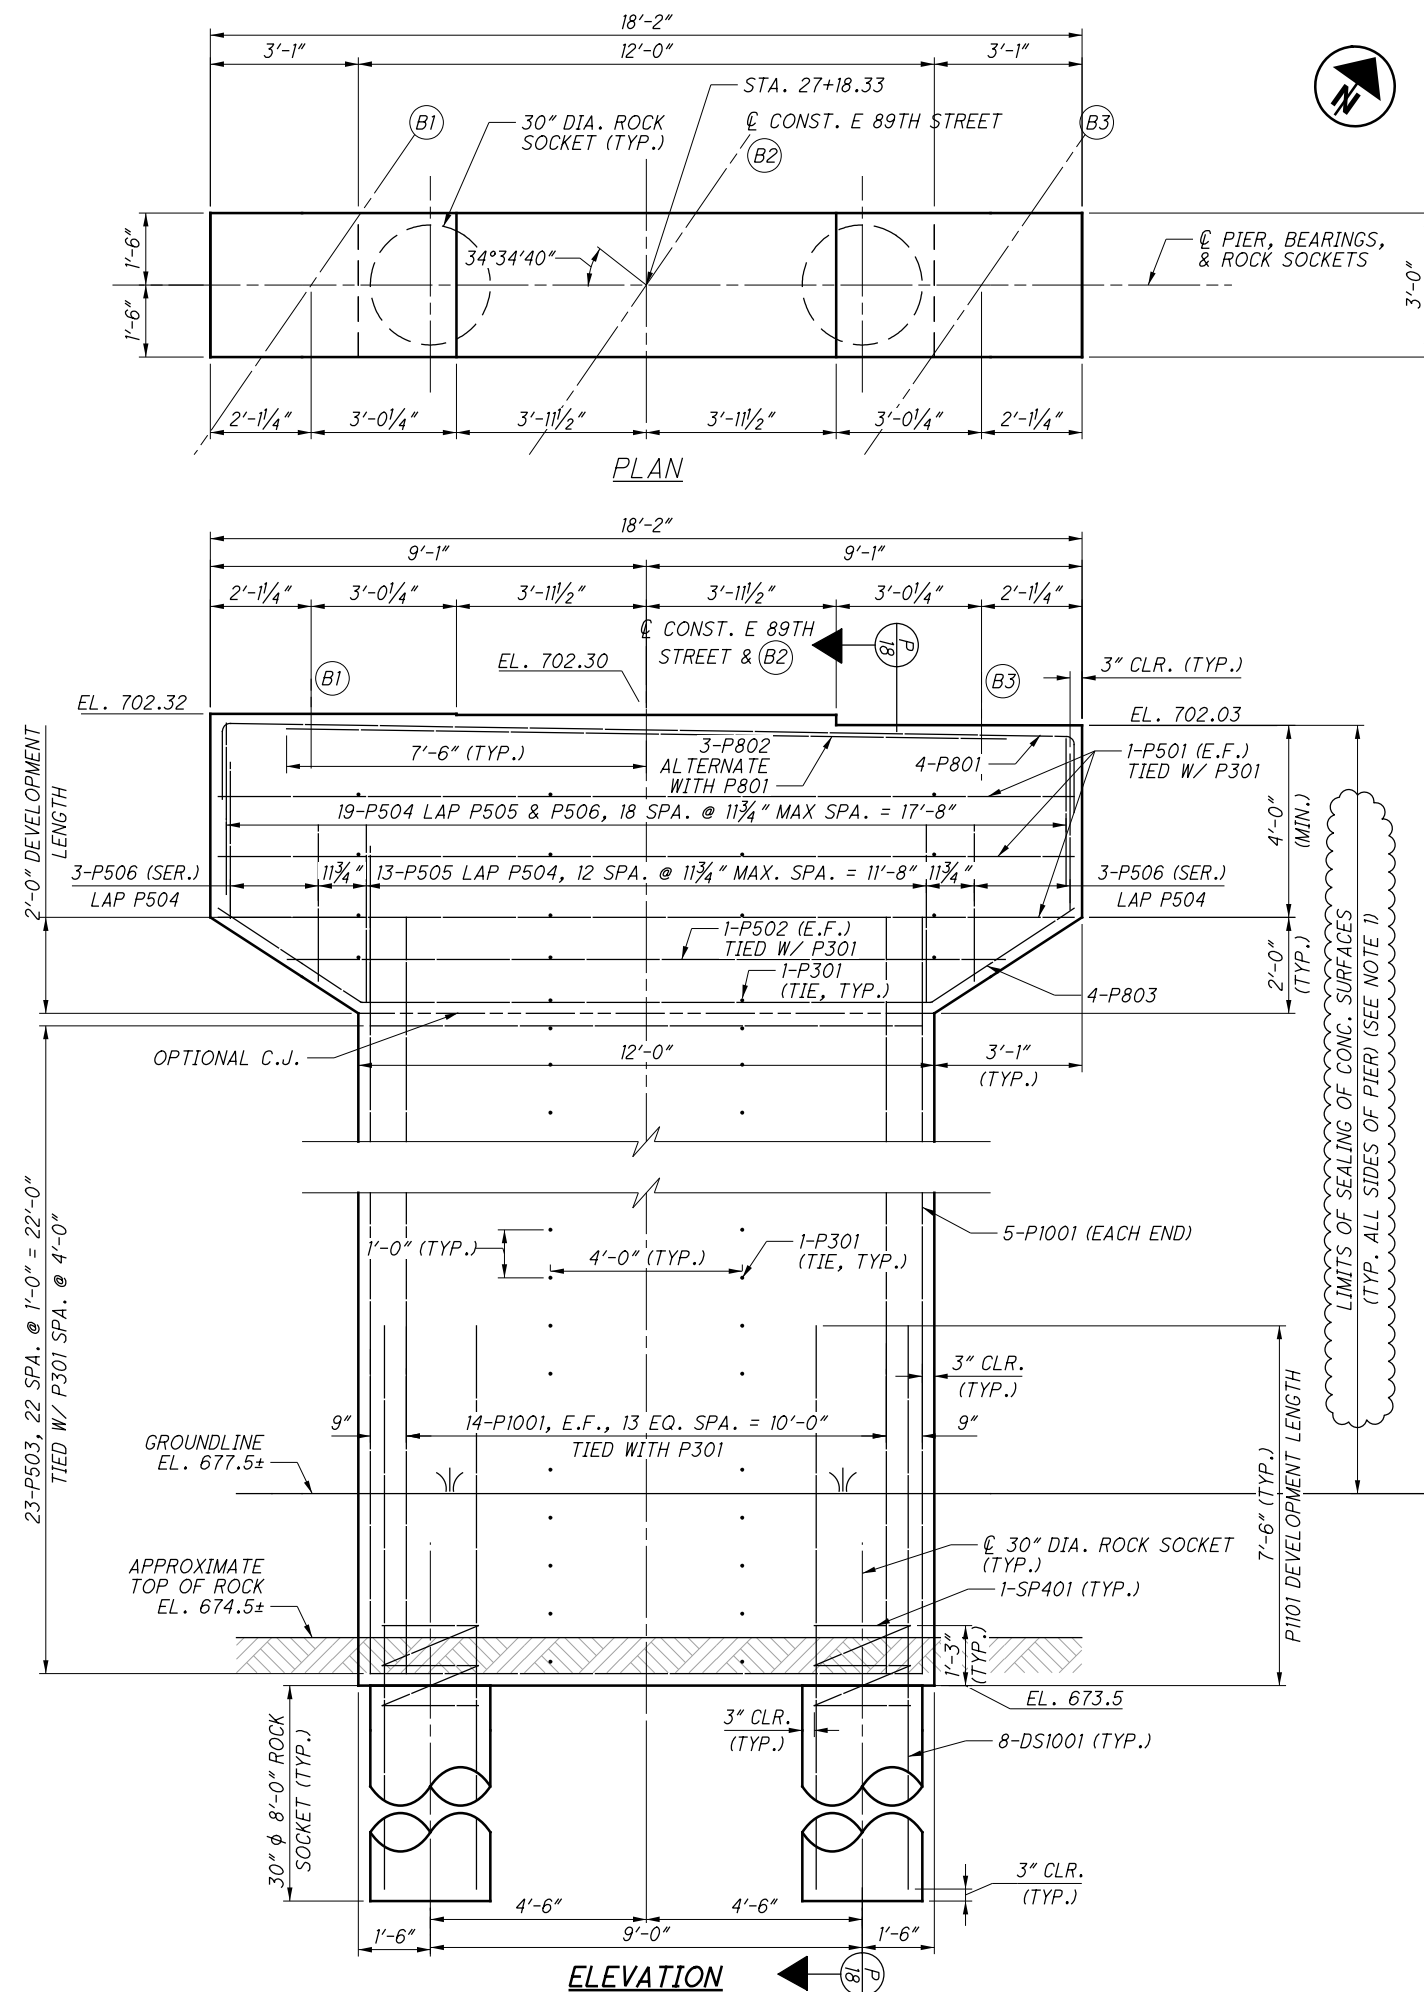

1	2024-09-10	RECORD DRAWINGS
0	2019-09-30	RFC
NO.	DATE	DESCRIPTION
ISSUE RECORD		

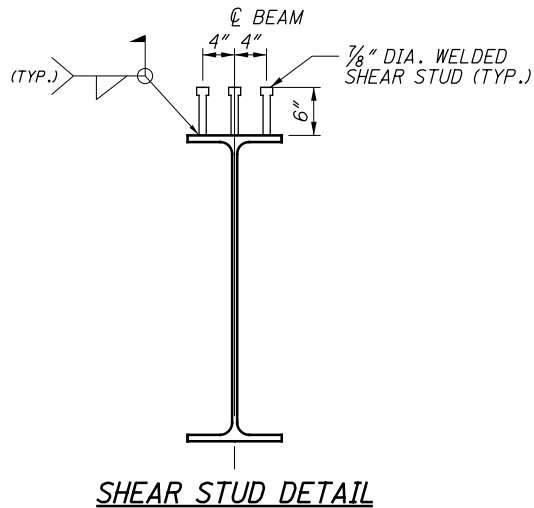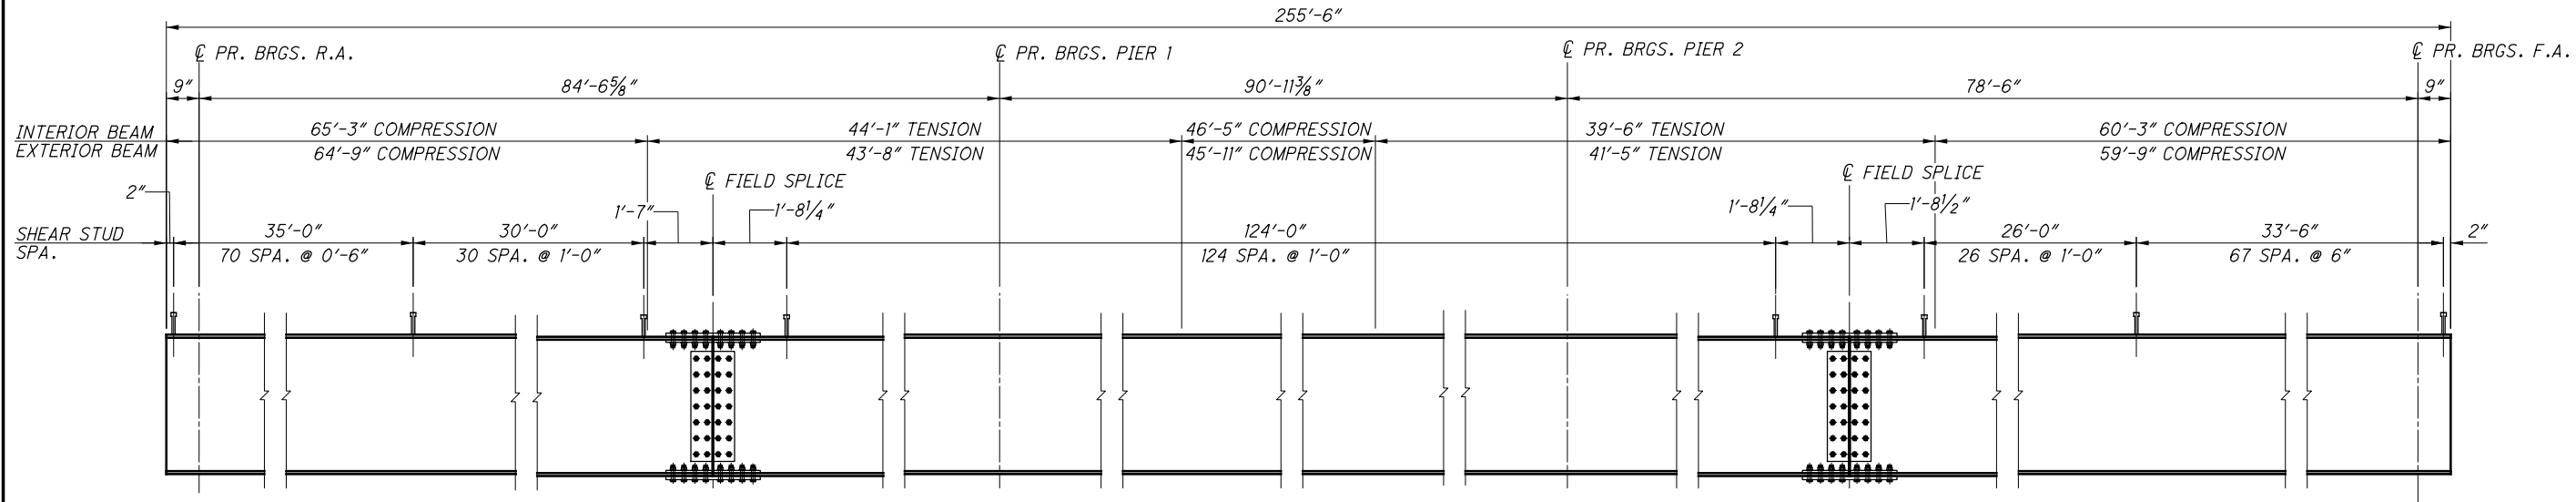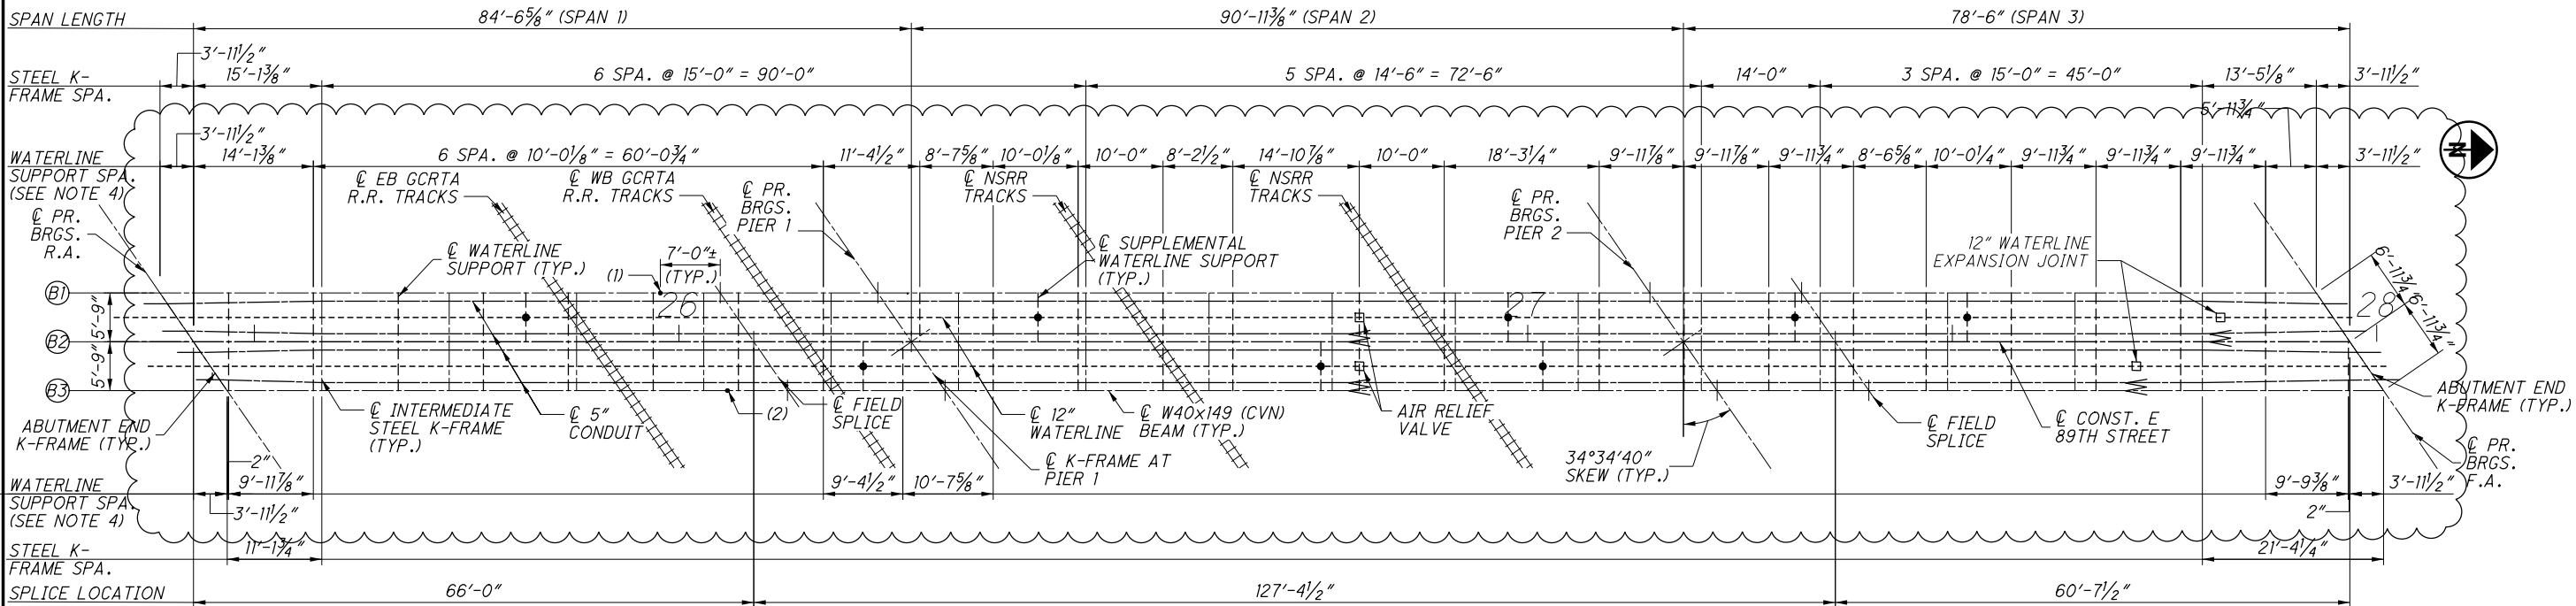

LEGEND:


(1) SIGNAL SUPPORT STA. 25+97.80, 5.75' LT.

(2) SIGNAL SUPPORT STA. 26+05.72, 5.75' RT.

(BX) BEAM DESIGNATION.


- NOTES:**
- ALL STEEL IS ASTM 709, GRADE 50W, UNLESS NOTED OTHERWISE.
 - SEE SHEET 20/37 FOR SPLICE DETAILS.
 - W40x149 ROLLED BEAMS SHALL BE DESIGNATED "CVN". WHERE A MEMBER IS DESIGNATED (CVN), FURNISH MATERIAL THAT MEETS THE MINIMUM NOTCH TOUGHNESS REQUIREMENTS AS SPECIFIED IN 711.01.
 - SEE SHEET 33/37 FOR SIGNAL WIRE DETAIL.
 - WELD ATTACHMENT OF SUPPORTS FOR CONCRETE DECK FINISHING MACHINE TO AREAS OF THE FASCIA STRINGER FLANGES DESIGNATED "COMPRESSION". DO NOT WELD ATTACHMENTS TO AREAS DESIGNATED "TENSION". FILLET WELDS TO COMPRESSION FLANGES SHALL BE AT LEAST 1" FROM EDGE OF FLANGE, BE NO MORE THAN 2" LONG, AND BE AT LEAST 1/4" FOR THICKNESSES UP TO 3/4" OR 5/16" FOR GREATER THAN 3/4" THICK.

NO.	DATE	DESCRIPTION
1	2024-09-10	RECORD DRAWINGS
0	2019-09-30	RFC
ISSUE RECORD		

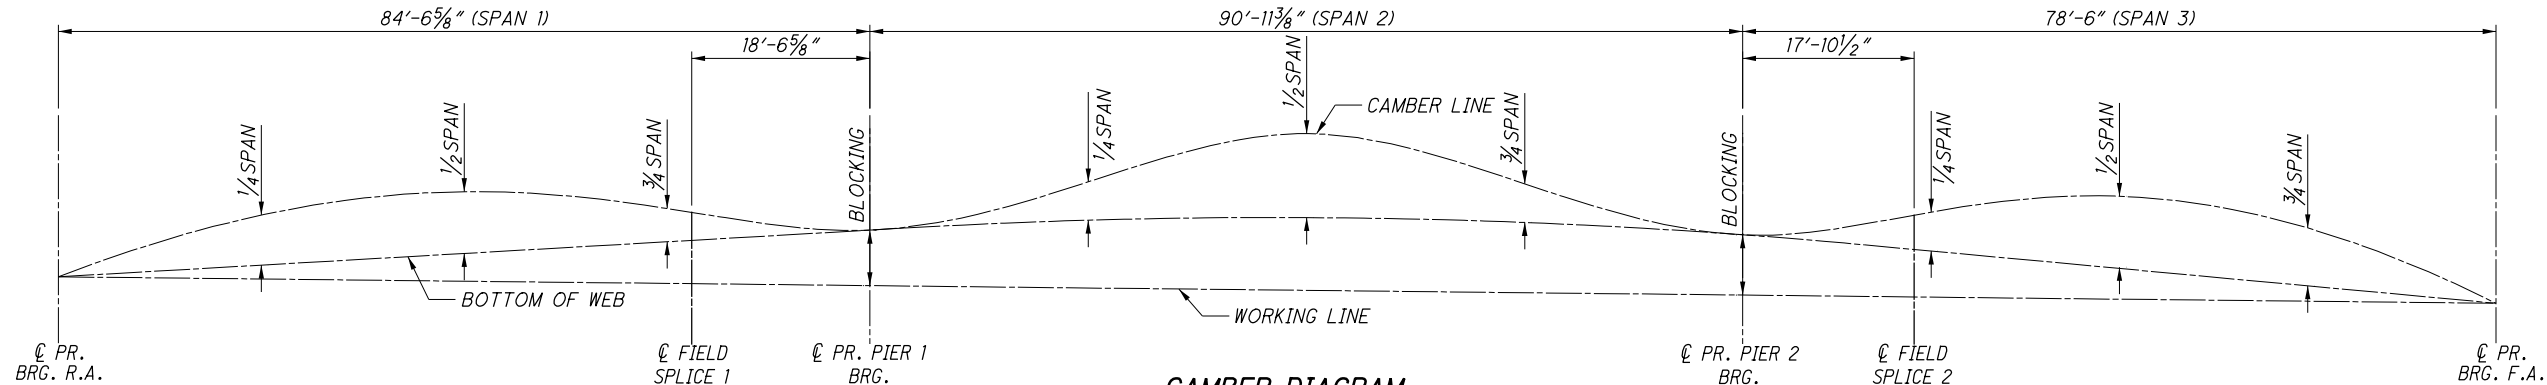


CAMBER DIAGRAM
(BEAM 1 SHOWN; OTHER BEAMS SIMILAR)


EXTERIOR BEAM 1 - DEFLECTION & CAMBER															
	℄ PR. BRG. R.A.	SPAN 1				℄ PR. PIER 1 BRG.				℄ PR. PIER 2 BRG.	SPAN 3				℄ PR. BRG. F.A.
		1/4 SPAN	1/2 SPAN	3/4 SPAN	℄ FIELD SPLICE 1		1/4 SPAN	1/2 SPAN	3/4 SPAN		℄ FIELD SPLICE 2	1/4 SPAN	1/2 SPAN	3/4 SPAN	
DEFLECTION DUE TO WEIGHT OF STEEL	0"	1/4"	5/16"	1/8"	1/8"	0"	1/16"	1/8"	1/16"	0"	1/16"	1/8"	3/16"	3/16"	0"
DEFLECTION DUE TO REMAINING DEAD LOAD	0"	1 7/16"	1 3/4"	15/16"	13/16"	0"	5/16"	11/16"	3/8"	0"	9/16"	5/8"	1 1/4"	1"	0"
ADJUSTMENT REQUIRED FOR VERTICAL CURVE	0"	0"	0"	0"	0"	0"	6 13/16"	9 3/16"	6 15/16"	0"	15/16"	15/16"	5/8"	5/16"	0"
TOTAL REQUIRED SHOP CAMBER	0"	1 5/8"	2 1/16"	1 1/16"	15/16"	0"	7 1/8"	10"	7 5/16"	0"	1 5/8"	1 11/16"	2 1/16"	1 1/2"	0"
INTERIOR BEAM 2 - DEFLECTION & CAMBER															
DEFLECTION DUE TO WEIGHT OF STEEL	0"	1/4"	5/16"	1/8"	1/8"	0"	1/16"	1/8"	1/16"	0"	1/16"	1/8"	3/16"	3/16"	0"
DEFLECTION DUE TO REMAINING DEAD LOAD	0"	1 7/16"	1 13/16"	15/16"	13/16"	0"	5/16"	11/16"	3/8"	0"	9/16"	11/16"	1 5/16"	1 1/16"	0"
ADJUSTMENT REQUIRED FOR VERTICAL CURVE	0"	0"	0"	0"	0"	0"	6 15/16"	9 1/4"	6 15/16"	0"	9/16"	9/16"	3/8"	3/16"	0"
TOTAL REQUIRED SHOP CAMBER	0"	1 11/16"	2 1/8"	1 1/8"	15/16"	0"	7 5/16"	10 1/16"	7 3/8"	0"	1 1/4"	1 5/16"	1 7/8"	1 3/8"	0"
EXTERIOR BEAM 3 - DEFLECTION & CAMBER															
DEFLECTION DUE TO WEIGHT OF STEEL	0"	1/4"	5/16"	1/8"	1/8"	0"	1/16"	1/8"	1/16"	0"	1/16"	1/8"	3/16"	3/16"	0"
DEFLECTION DUE TO REMAINING DEAD LOAD	0"	1 7/16"	1 3/4"	15/16"	13/16"	0"	5/16"	11/16"	3/8"	0"	9/16"	5/8"	1 1/4"	1"	0"
ADJUSTMENT REQUIRED FOR VERTICAL CURVE	0"	0"	0"	0"	0"	0"	7"	9 5/16"	7"	0"	1/4"	1/4"	3/16"	1/16"	0"
TOTAL REQUIRED SHOP CAMBER	0"	1 5/8"	2 1/16"	1 1/16"	15/16"	0"	7 5/16"	10 1/8"	7 3/8"	0"	15/16"	1"	1 5/8"	1 1/4"	0"

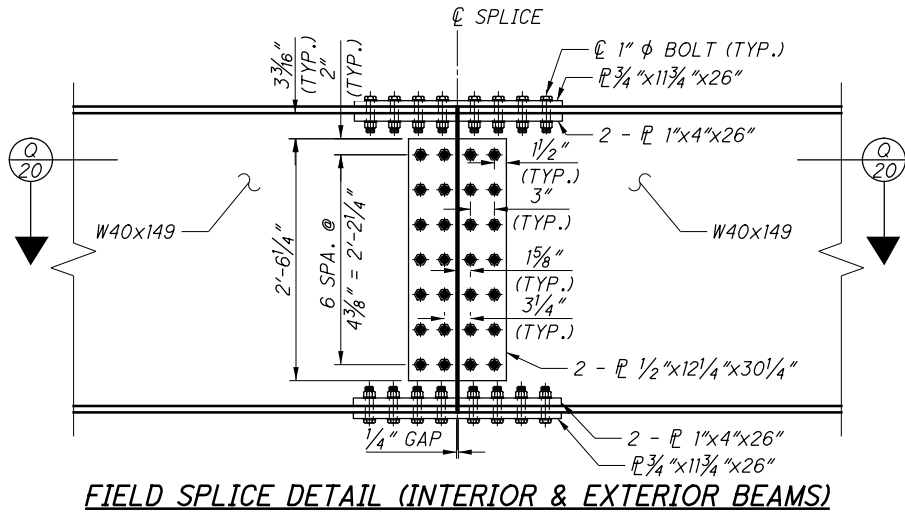


FIELD SPLICE DETAIL (INTERIOR & EXTERIOR BEAMS)

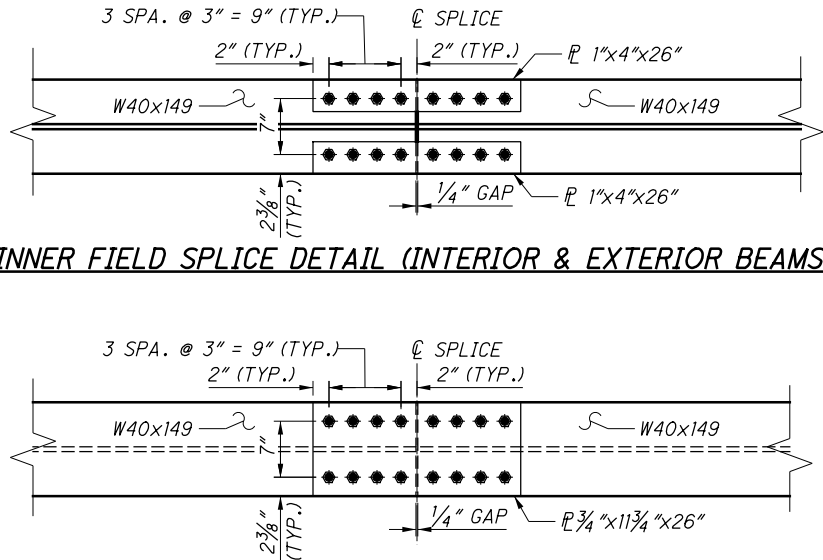

OUTER FIELD SPLICE DETAIL (INTERIOR & EXTERIOR BEAMS)

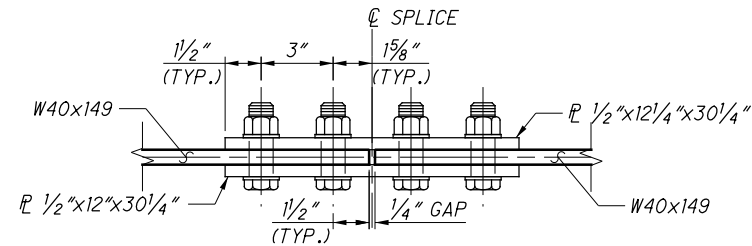

SECTION 20

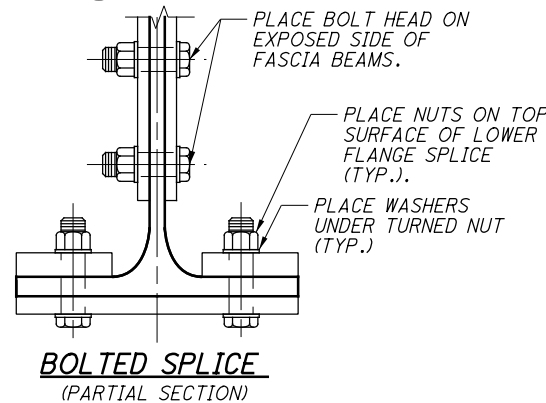

BOLTED SPLICE (PARTIAL SECTION)

REQUIRED BLOCKING				
	℄ PR. BRG. R.A.	℄ PR. PIER 1 BRG.	℄ PR. PIER 2 BRG.	℄ PR. BRG. F.A.
EXTERIOR BEAM 1	0'-0"	2'-9 1/2"	3'-2 5/16"	0'-0"
INTERIOR BEAM 2	0'-0"	2'-10 11/16"	3'-1 11/16"	0'-0"
EXTERIOR BEAM 3	0'-0"	2'-11 7/8"	3'-1"	0'-0"


NOTES:

- ALL W40X149 BEAMS AND SPLICE PLATES SHALL BE "CVN." FURNISH MATERIAL THAT MEETS THE MINIMUM NOTCH TOUGHNESS REQUIREMENTS AS SPECIFIED IN 711.01. ALL PLATES SHALL BE ASTM A709 GRADE 50W UNLESS OTHERWISE NOTED.
- HIGH STRENGTH BOLTS SHALL BE 1" DIAMETER A325 TYPE III UNLESS OTHERWISE NOTED.

- ALL VALUES IN THE DEFLECTION AND CAMBER TABLE ARE GIVEN TO THE NEAREST 1/16".
- POSITIVE VALUES FOR DEFLECTION INDICATE DOWNWARD DEFLECTIONS.
- SPAN LENGTHS ARE MEASURED FROM CENTER TO CENTER OF BEARINGS ALONG THE CENTERLINE.


- SEE SHEET 19/37 FOR FIELD SPLICE LOCATIONS.
- DEFLECTION DUE TO REMAINING DEAD LOAD ARE DEFLECTIONS DUE TO SLAB AND COMPOSITE DECK LOADS (WATERLINE, PARAPET, AND FENCING LOADS).
- PREPARE FAYING SURFACES TO PROVIDE CLASS A SURFACES.

NO.	DATE	DESCRIPTION
0	2019-09-30	RFC
ISSUE RECORD		

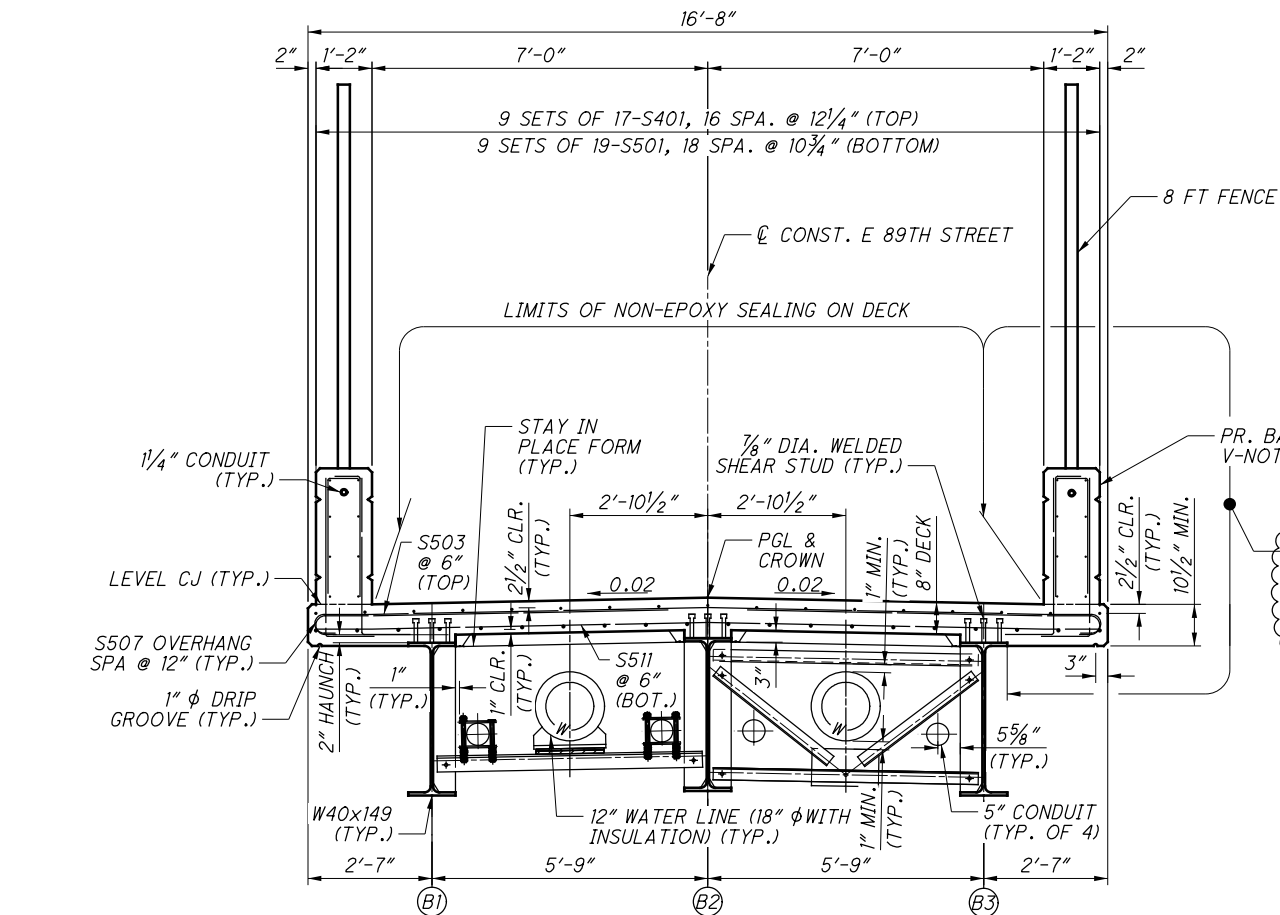

TRANSVERSE SECTION - INTERMEDIATE K-FRAME & WATERLINE SUPPORT

(WATERLINE SUPPORT OR INTERMEDIATE K-FRAME WILL BE IN BOTH BAYS, ONE OF EACH TYPE SHOWN HERE)


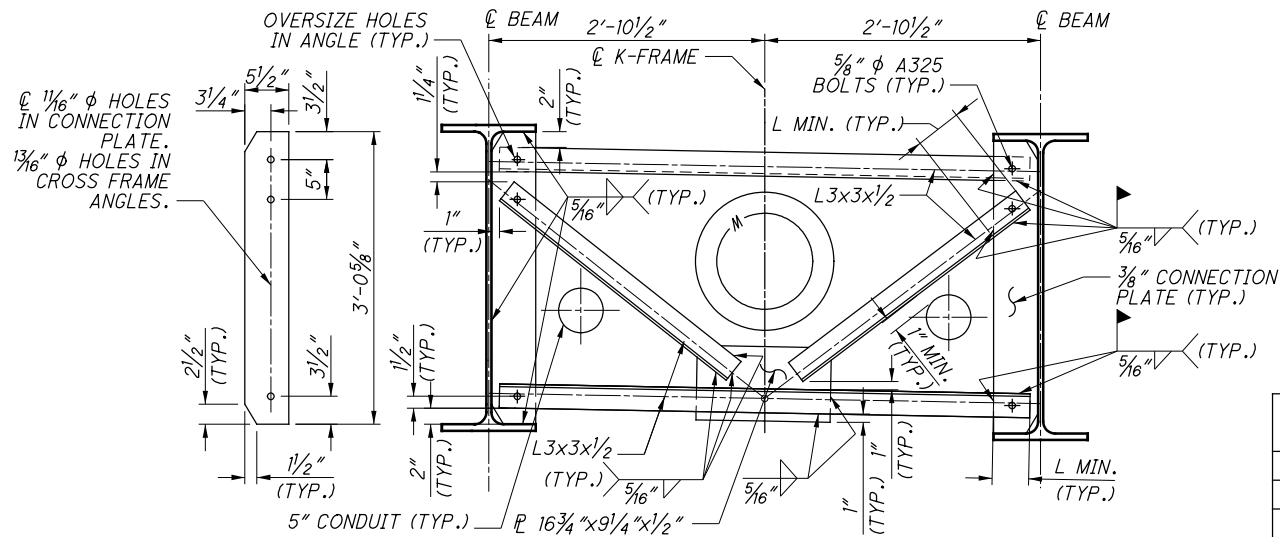


CONNECTION PLATE

INTERMEDIATE K-FRAME


NOTES:

1. GRAFFITI PROTECTION SHALL BE APPLIED TO PARAPETS. SEE SHEETS 25/37 TO 29/37 FOR RAILING & FENCE DETAILS.
2. SEE STANDARD DRAWING EXJ-4-87 AND SHEET 32/37 FOR ADDITIONAL NOTES AND DETAILS.
3. REFER TO SHEET 34/37 FOR WATERLINE SUPPORT DETAILS.
4. ALL STEEL IS ASTM 709, GRADE 50W, UNLESS NOTED OTHERWISE.
5. ERECTION BOLTS SHALL BE 5/8" DIAMETER, ASTM A325, TYPE III, UNLESS NOTED OTHERWISE.
6. PREPARE FAYING SURFACES FOR INTERMEDIATE K-FRAME BOLTED CONNECTIONS TO PROVIDE CLASS B SURFACES.
7. THE FIELD-WELDED INTERMEDIATE K-FRAME INCLUDES AN ERECTION BOLT FOR STEEL BEAM ERECTION AND FIELD WELDED CONNECTION PRIOR TO THE DECK POUR.

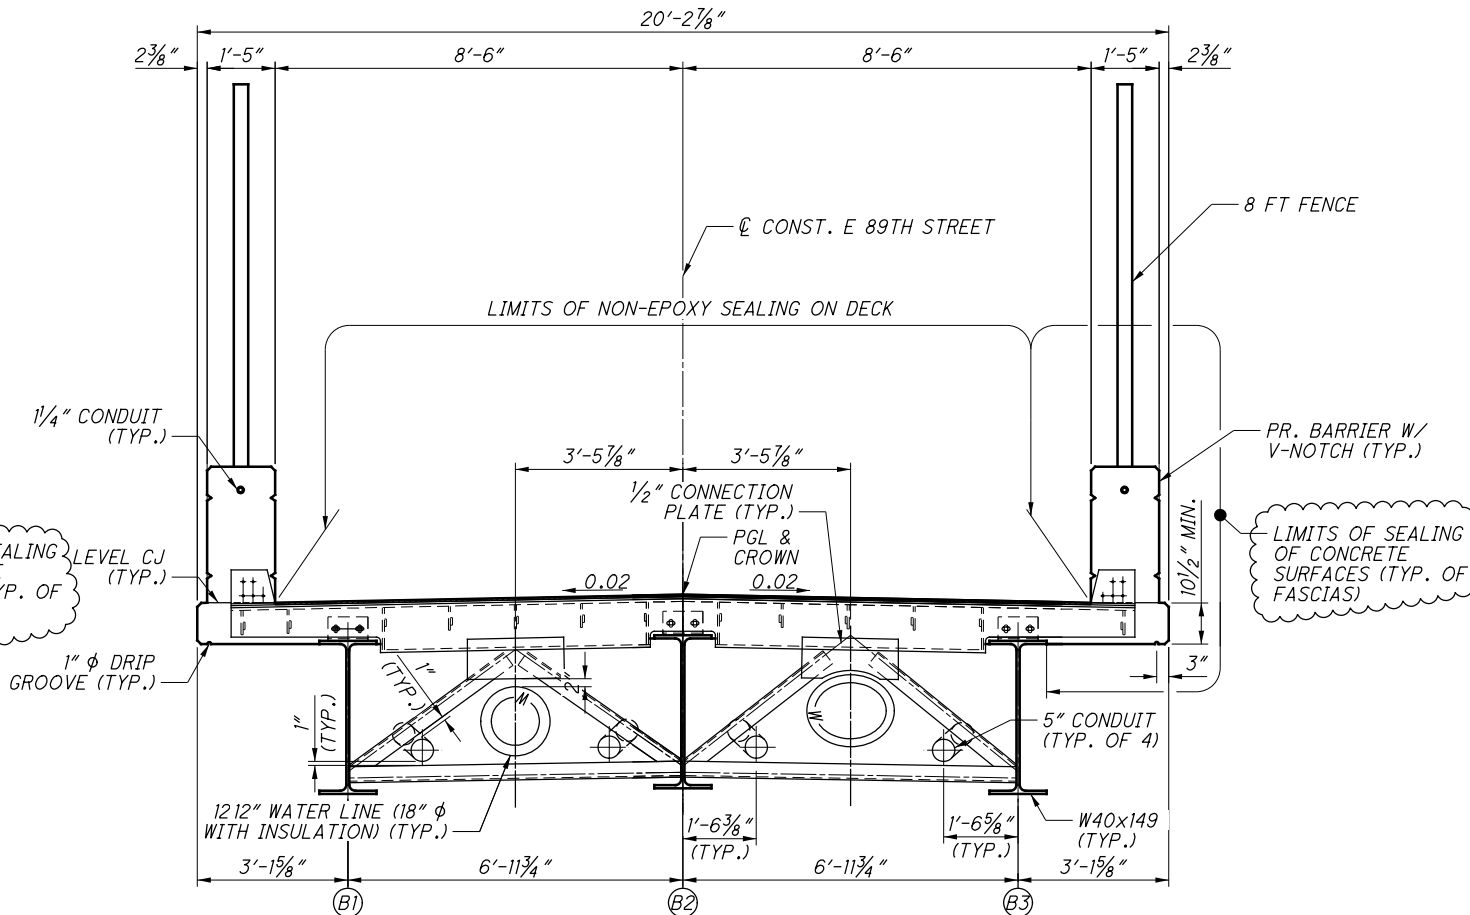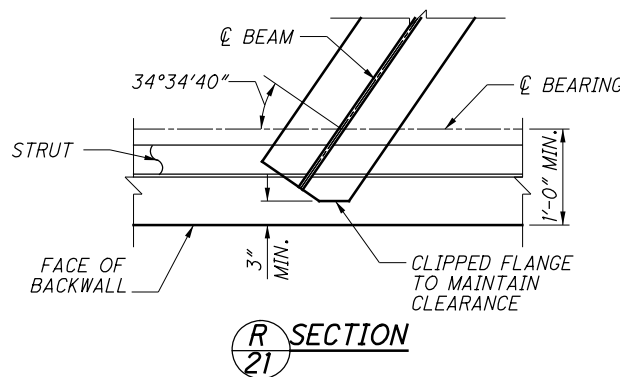



TRANSVERSE SECTION - END K-FRAME

(SHOWN ALONG SKEW)

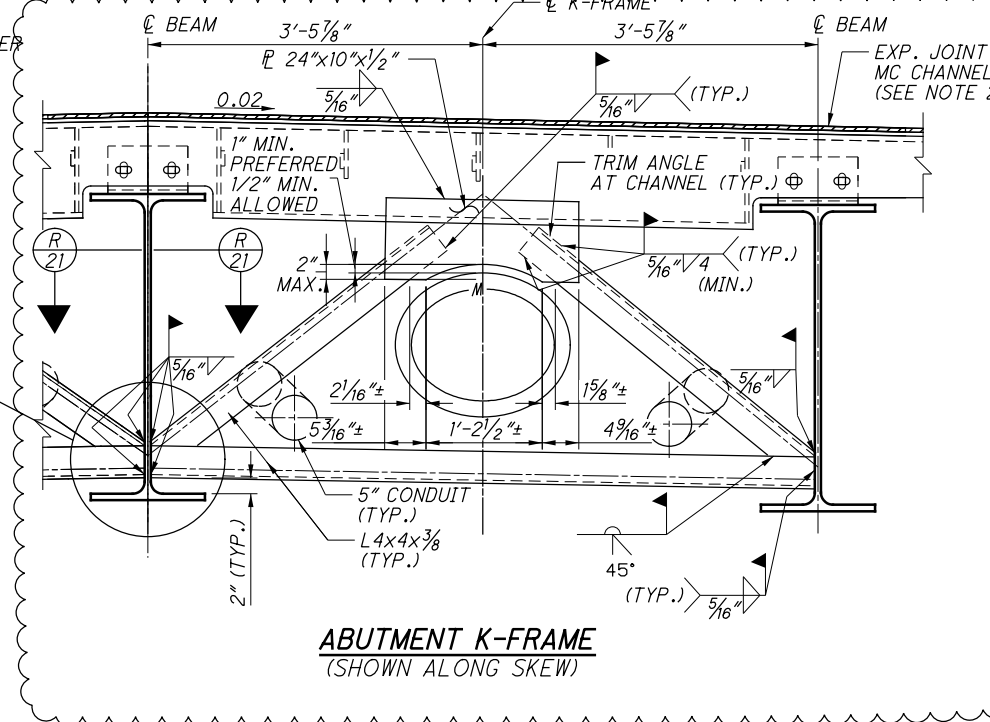




ABUTMENT K-FRAME
(SHOWN ALONG SKEW)

ISSUE RECORD		
NO.	DATE	DESCRIPTION
1	2024-09-10	RECORD DRAWINGS
0	2019-09-30	RFC

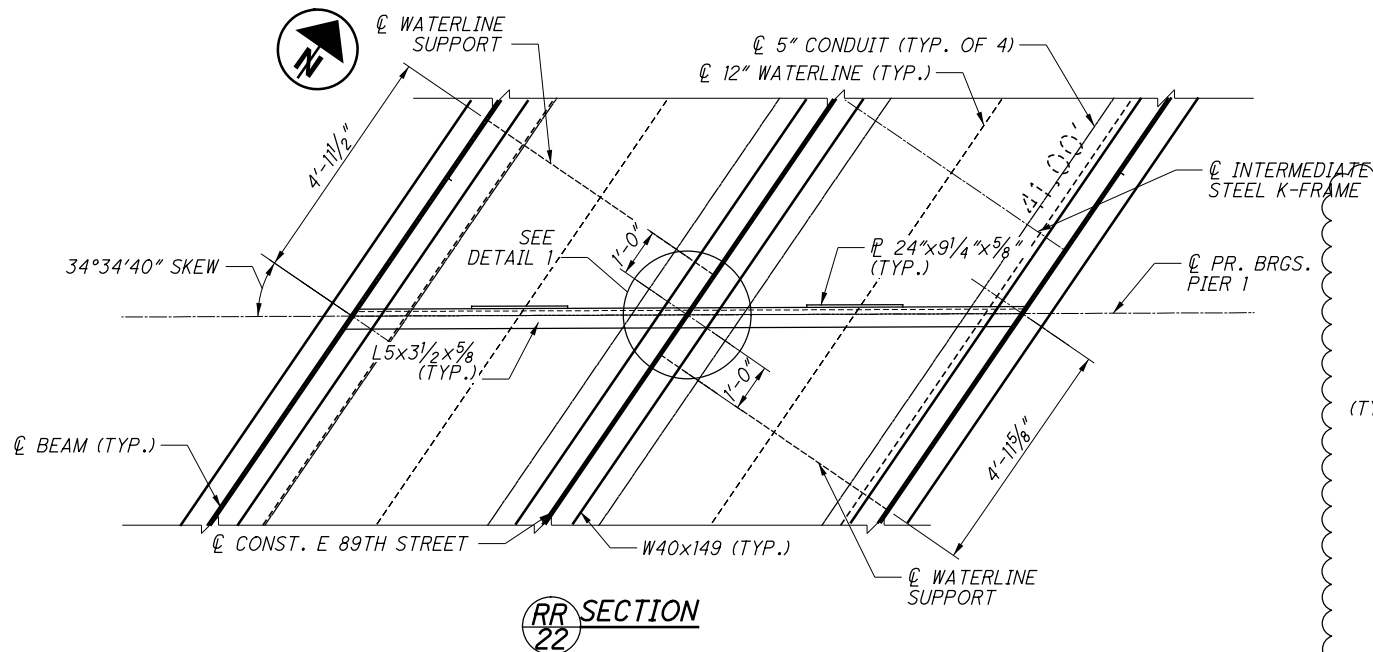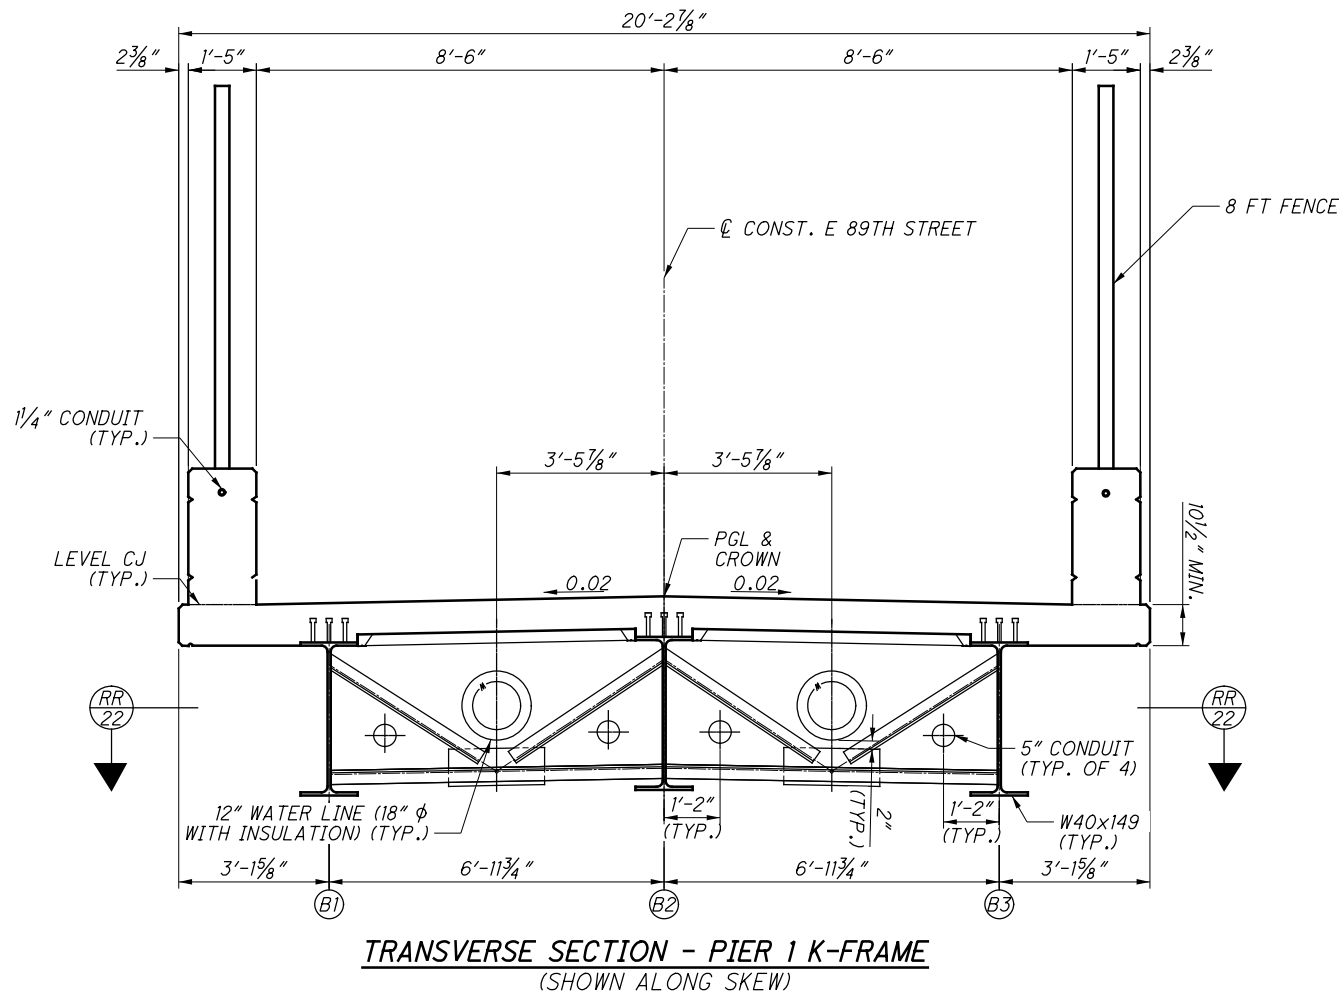

NOTES:


- GRAFFITI PROTECTION SHALL BE APPLIED TO PARAPETS. SEE SHEETS 25/37 TO 29/37 FOR RAILING & FENCE DETAILS.
- SEE STANDARD DRAWING EXJ-4-87 AND SHEET 32/37 FOR ADDITIONAL NOTES AND DETAILS.
- REFER TO SHEET 34/37 FOR WATERLINE SUPPORT DETAILS.
- ALL STEEL IS ASTM 709, GRADE 50W, UNLESS NOTED OTHERWISE.
- REFER TO SHOP DRAWINGS FOR ALTERNATIVE WELD DETAIL FOR K-FRAMES.

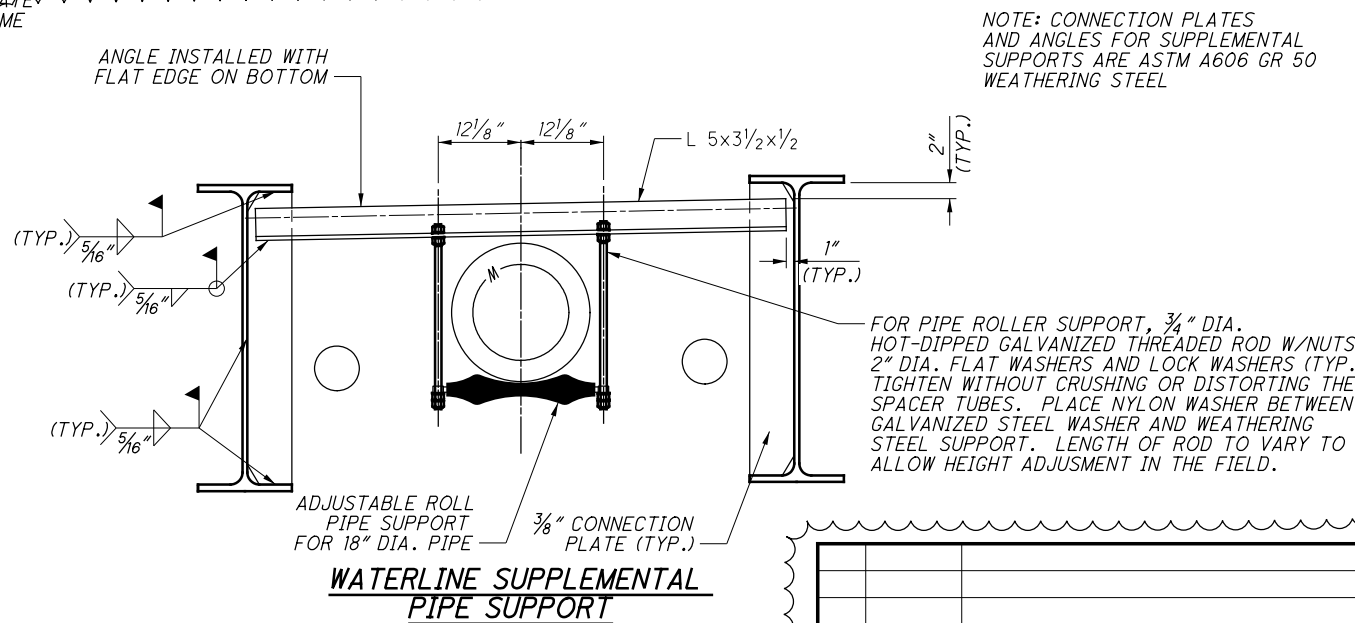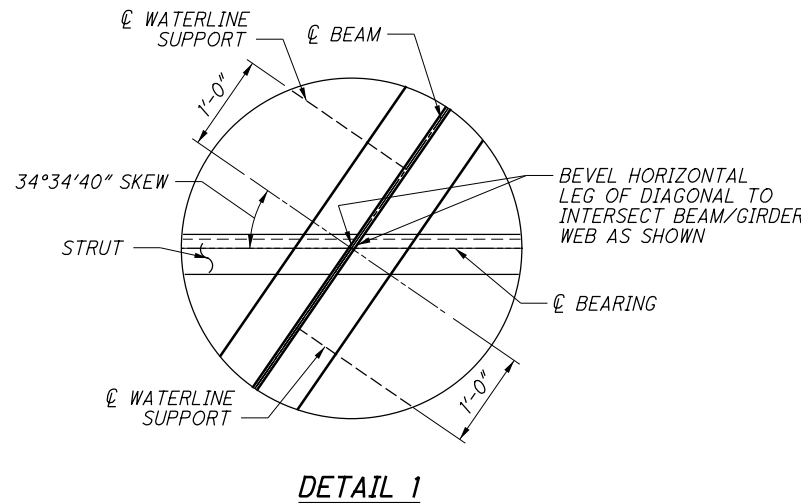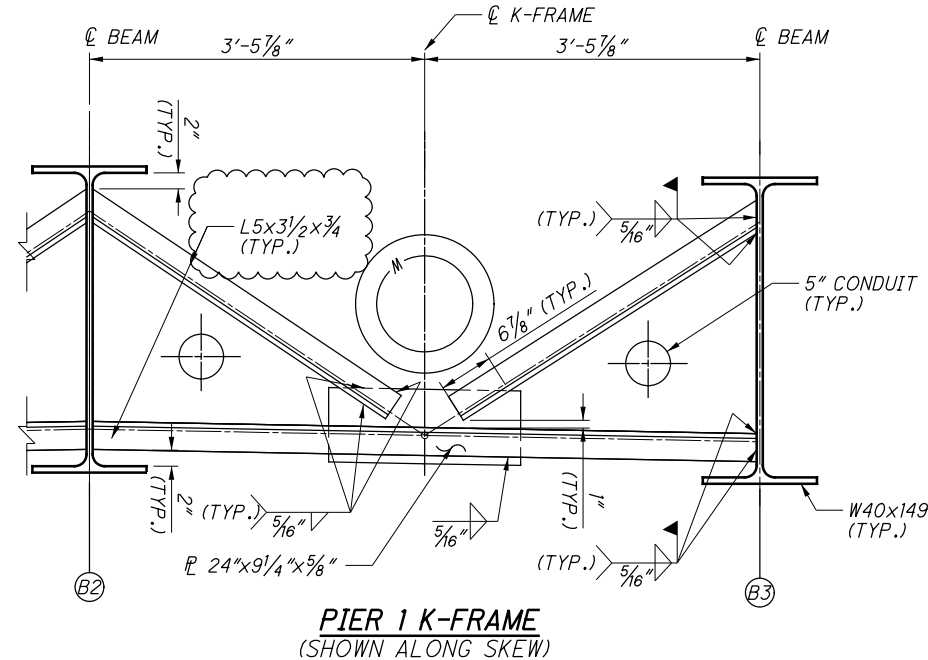


NOTE: CONNECTION PLATES AND ANGLES FOR SUPPLEMENTAL SUPPORTS ARE ASTM A606 GR 50 WEATHERING STEEL

FOR PIPE ROLLER SUPPORT, 3/4" DIA. HOT-DIPPED GALVANIZED THREADED ROD W/NUTS, 2" DIA. FLAT WASHERS AND LOCK WASHERS (TYP.) TIGHTEN WITHOUT CRUSHING OR DISTORTING THE SPACER TUBES. PLACE NYLON WASHER BETWEEN GALVANIZED STEEL WASHER AND WEATHERING STEEL SUPPORT. LENGTH OF ROD TO VARY TO ALLOW HEIGHT ADJUSTMENT IN THE FIELD.


NO.	DATE	DESCRIPTION
1	2024-09-10	RECORD DRAWINGS
0	2019-09-30	RFC
ISSUE RECORD		

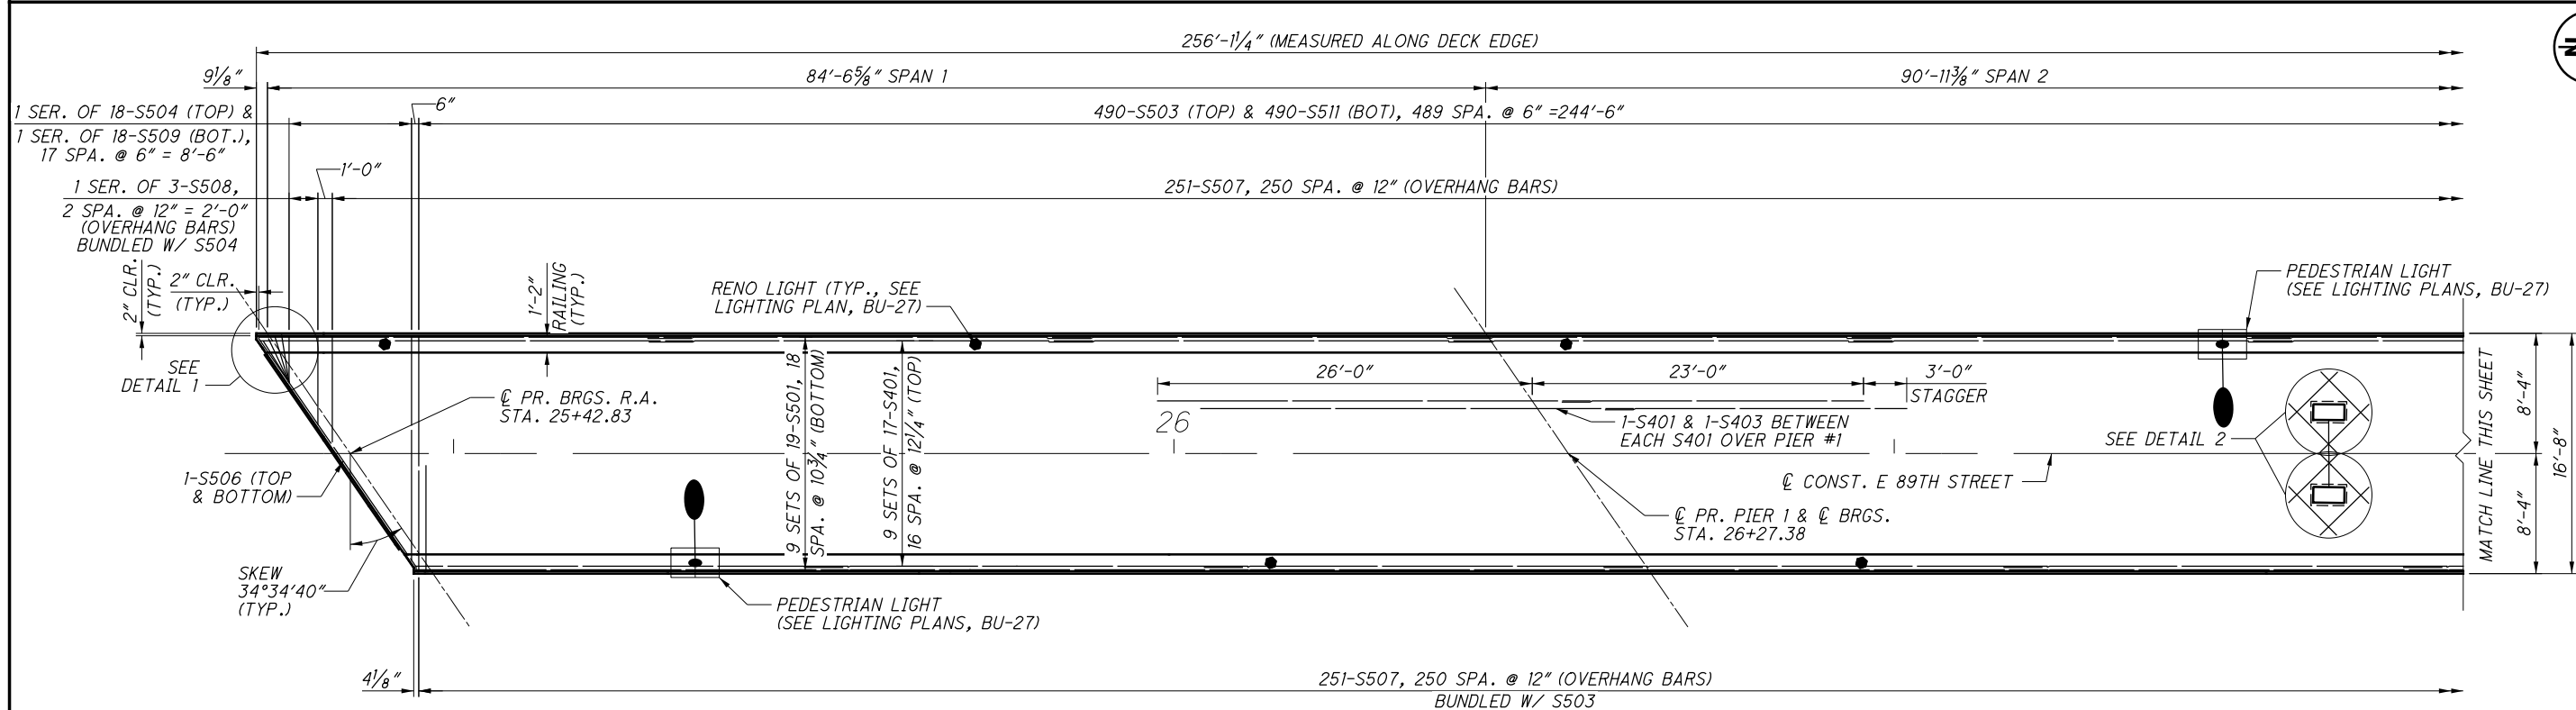

DECK PLAN

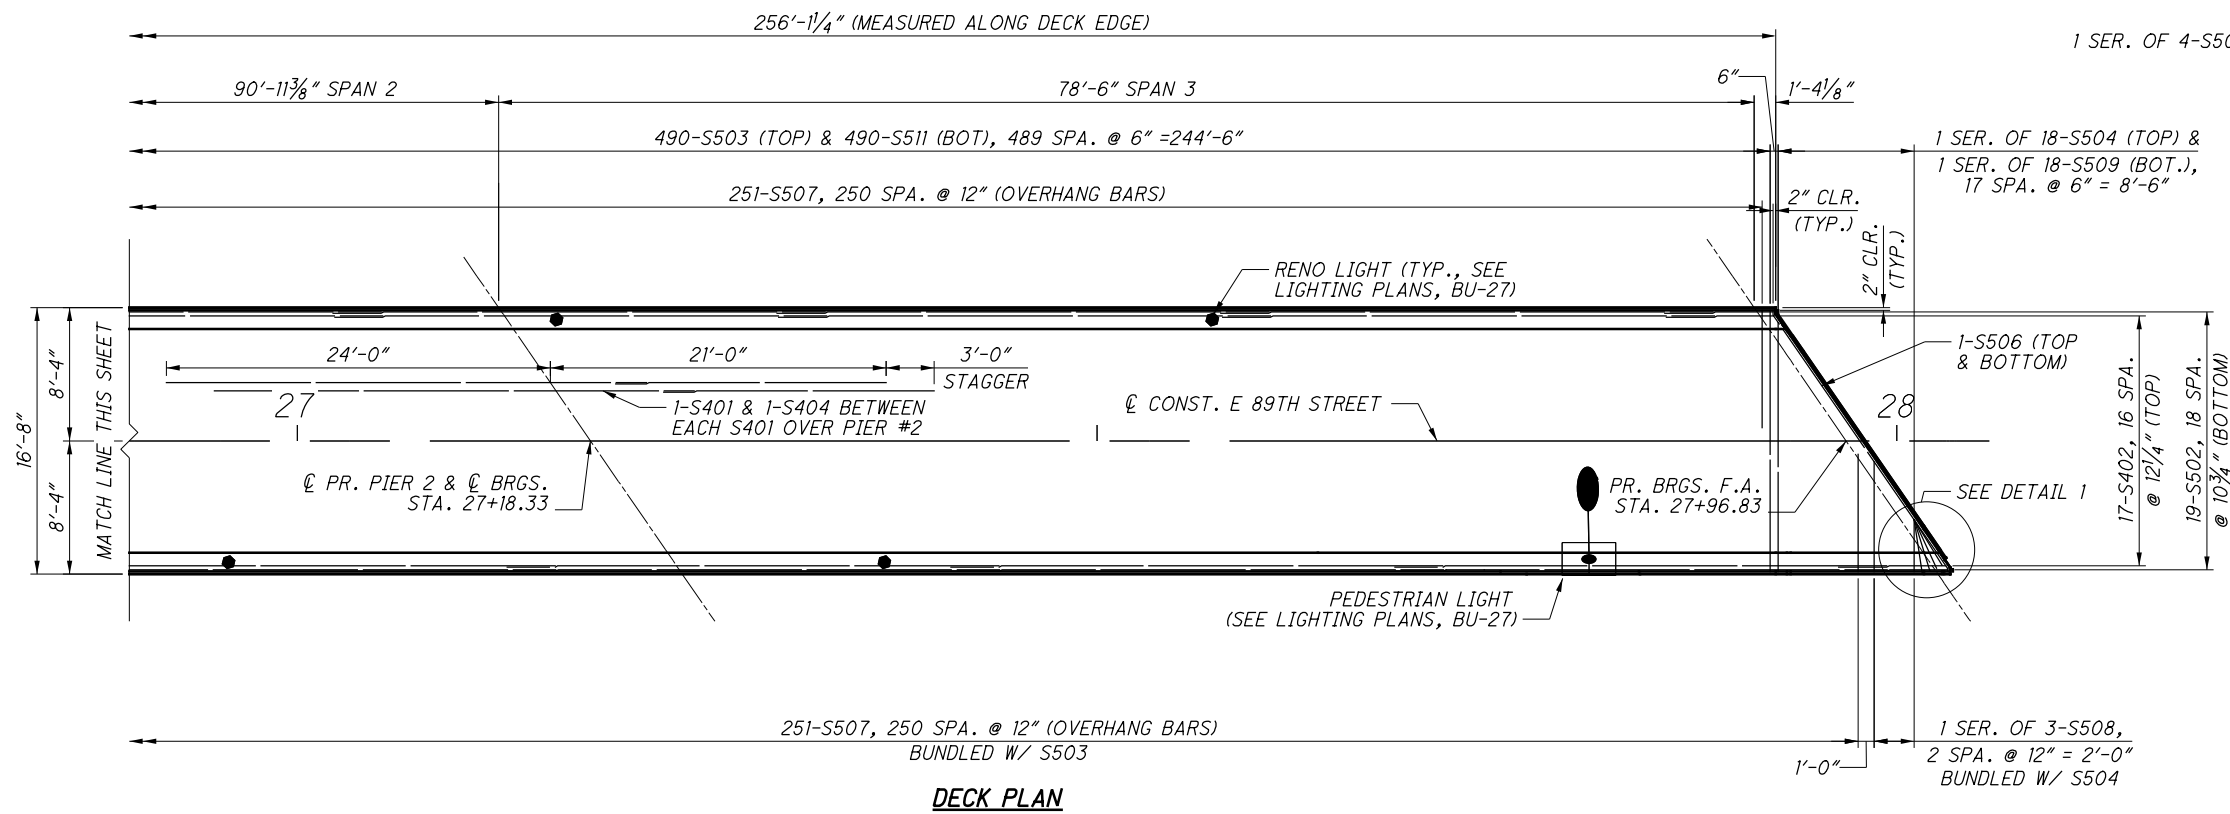


DECK PLAN

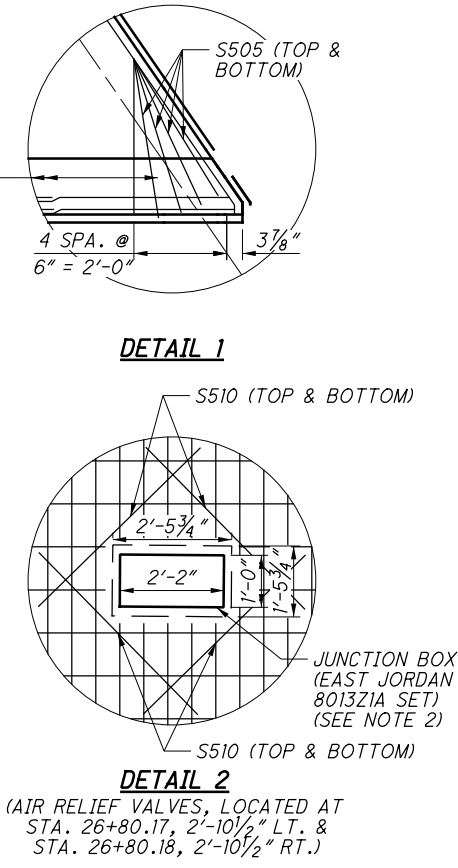

MIN. LAP LENGTH	
# 4	2'-7"
# 5	3'-2"


- NOTES:
- SEE SHEET 21/37 FOR TRANSVERSE SECTION.
 - FIELD CUT LONGITUDINAL AND TRANSVERSE REBAR TO AVOID INTERFERENCE WITH JUNCTION BOX.
 - SEE SHEET 36/37 FOR REINFORCING SCHEDULE.

NO.	DATE	DESCRIPTION
0	2019-09-30	RFC
ISSUE RECORD		

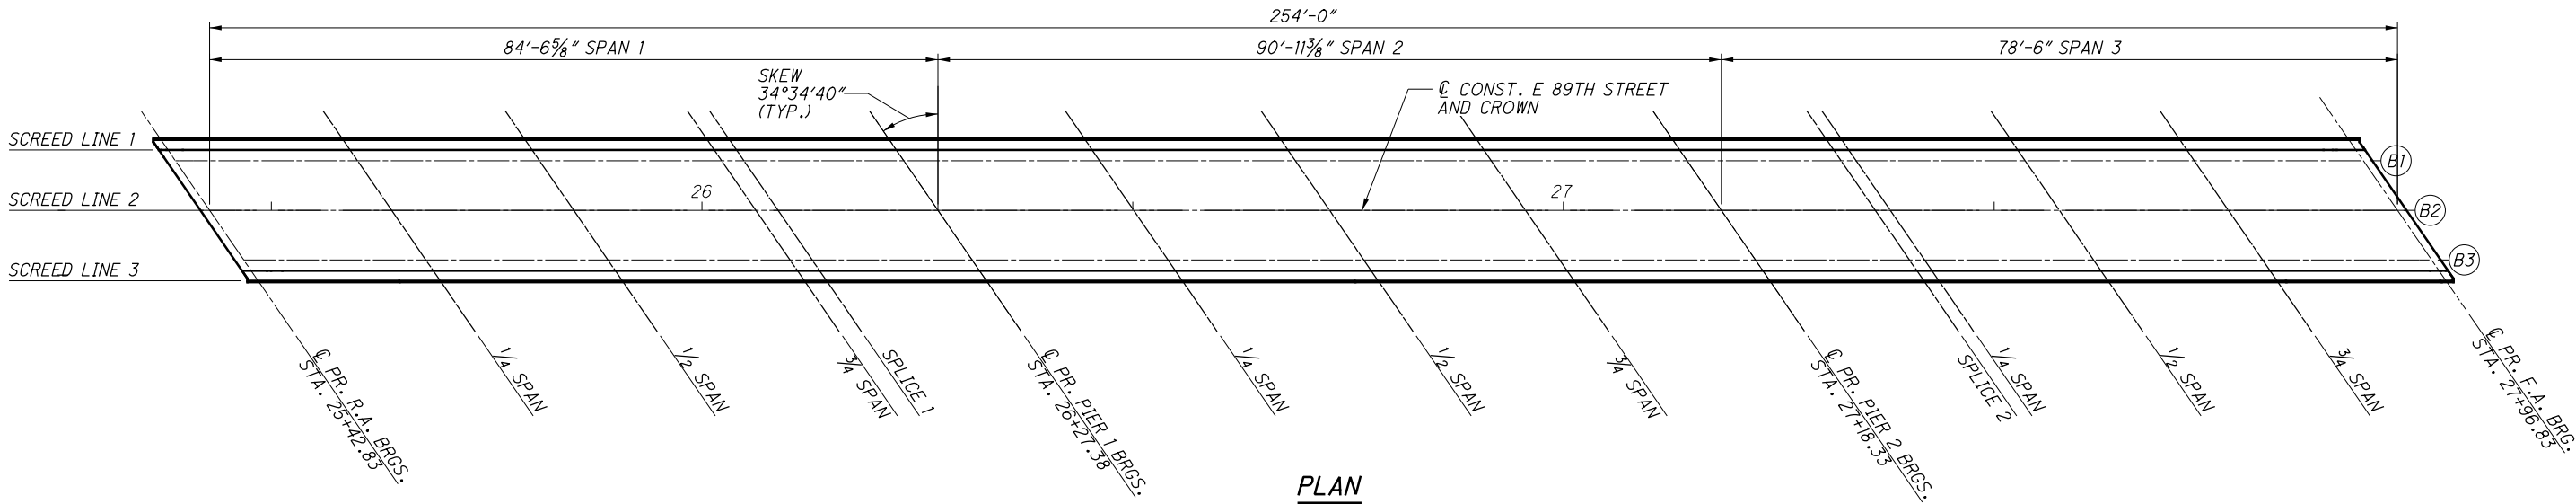

PLAN

SCREED ELEVATION TABLE																
SCREED LINE	DESCRIPTION	℄ RA BRG.	SPAN 1				℄ PIER 1 BRG.	SPAN 2			℄ PIER 2 BRG.	SPAN 3				℄ FA BRG.
			1/4 SPAN	1/2 SPAN	3/4 SPAN	SPLICE 1		1/4 SPAN	1/2 SPAN	3/4 SPAN		SPLICE 2	1/4 SPAN	1/2 SPAN	3/4 SPAN	
LEFT TOE OF PARAPET SCREED LINE 1	STATION	25+38.01	25+59.14	25+80.28	26+01.42	26+04.01	26+22.56	26+45.29	26+68.03	26+90.77	27+13.51	27+31.38	27+33.13	27+52.76	27+72.38	27+92.01
	FINAL DECK EL.	704.20	704.81	705.41	706.02	706.10	706.63	707.21	707.42	707.25	706.69	705.98	705.90	704.99	704.09	703.18
	SCREED EL.	704.20	704.92	705.56	706.10	706.16	706.63	707.23	707.48	707.28	706.69	706.03	705.95	705.10	704.17	703.18
℄ CONST. E. 89TH SCREED LINE 2	STATION	25+42.83	25+63.97	25+85.11	26+06.24	26+08.83	26+27.38	26+50.12	26+72.86	26+95.59	27+18.33	27+36.20	27+37.96	27+57.58	27+77.21	27+96.83
	FINAL DECK EL.	704.48	705.08	705.69	706.30	706.38	706.91	707.42	707.56	707.31	706.67	705.90	705.82	704.91	704.01	703.10
	SCREED EL.	704.48	705.20	705.84	706.38	706.44	706.91	707.45	707.62	707.34	706.67	705.95	705.87	705.02	704.09	703.10
RIGHT TOE OF PARAPET SCREED LINE 3	STATION	25+47.65	25+68.79	25+89.93	26+11.07	26+13.65	26+32.21	26+54.94	26+77.68	27+00.42	27+23.15	27+41.02	27+42.78	27+62.40	27+82.03	28+01.65
	FINAL DECK EL.	704.47	705.08	705.69	706.30	706.38	706.90	707.34	707.40	707.06	706.34	705.54	705.46	704.55	703.64	702.74
	SCREED EL.	704.47	705.20	705.83	706.38	706.44	706.90	707.37	707.45	707.09	706.34	705.58	705.51	704.65	703.73	702.74
TOP OF HAUNCH AND FINAL DECK ELEVATIONS TABLE																
SCREED LINE	DESCRIPTION	℄ RA BRG.	SPAN 1				℄ PIER 1 BRG.	SPAN 2			℄ PIER 2 BRG.	SPAN 3				℄ FA BRG.
			1/4 SPAN	1/2 SPAN	3/4 SPAN	SPLICE 1		1/4 SPAN	1/2 SPAN	3/4 SPAN		SPLICE 2	1/4 SPAN	1/2 SPAN	3/4 SPAN	
BEAM 1	STATION	25+38.87	25+60.00	25+81.14	26+02.28	26+04.87	26+23.42	26+46.16	26+68.89	26+91.63	27+14.37	27+32.24	27+33.99	27+53.62	27+73.24	27+92.87
	FINAL DECK EL.	704.25	704.86	705.46	706.07	706.15	706.68	707.25	707.45	707.26	706.69	705.97	705.89	704.98	704.07	703.17
	TOP OF HAUNCH	703.58	704.304	704.939	705.482	705.545	706.015	706.603	706.837	706.625	706.023	705.348	705.273	704.415	703.490	702.500
	SCREED EL.	704.25	704.97	705.61	706.15	706.21	706.68	707.27	707.50	707.29	706.69	706.01	705.94	705.08	704.16	703.17
BEAM 2	STATION	25+42.83	25+63.97	25+85.11	26+06.24	26+08.83	26+27.38	26+50.12	26+72.86	26+95.59	27+18.33	27+36.20	27+37.96	27+57.58	27+77.21	27+96.83
	FINAL DECK EL.	704.48	705.08	705.69	706.30	706.38	706.91	707.42	707.56	707.31	706.67	705.90	705.82	704.91	704.01	703.10
	TOP OF HAUNCH	703.81	704.537	705.173	705.713	705.776	706.244	706.782	706.949	706.669	705.998	705.281	705.206	704.350	703.424	702.432
	SCREED EL.	704.48	705.20	705.84	706.38	706.44	706.91	707.45	707.62	707.34	706.67	705.95	705.87	705.02	704.09	703.10
BEAM 3	STATION	25+46.79	25+67.93	25+89.07	26+10.21	26+12.79	26+31.35	26+54.08	26+76.82	26+99.56	27+22.29	27+40.16	27+41.92	27+61.54	27+81.17	28+00.79
	FINAL DECK EL.	704.47	705.08	705.69	706.30	706.38	706.90	707.36	707.43	707.11	706.40	705.60	705.52	704.61	703.71	702.80
	TOP OF HAUNCH	703.81	704.532	705.168	705.710	705.773	706.238	706.717	706.816	706.469	705.732	704.981	704.906	704.049	703.123	702.134
	SCREED EL.	704.47	705.20	705.83	706.38	706.44	706.90	707.38	707.48	707.14	706.40	705.65	705.57	704.72	703.79	702.80

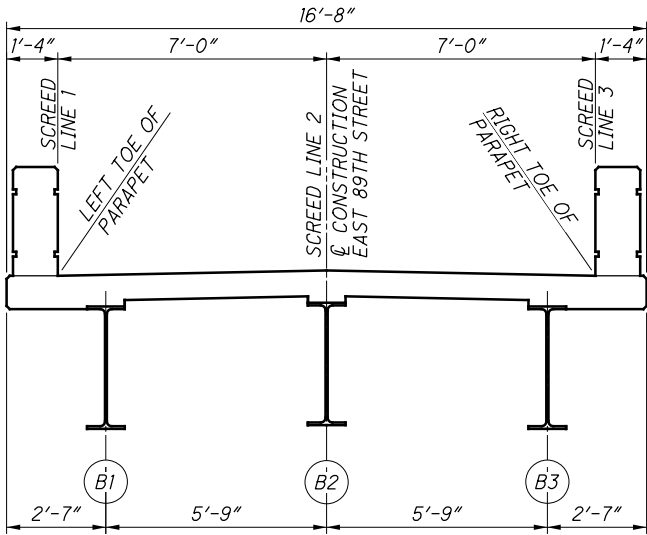

TRANSVERSE SECTION


LEGEND

BX BEAM DESIGNATION


NOTES

- DEAD LOAD DEFLECTIONS USED TO DETERMINE SCREED ELEVATIONS ACCOUNT FOR THE LOADING OF THE RAILING, FENCING AND WATER WITHIN THE WATERLINE. THE WEIGHT OF THE WATERLINE WAS INCLUDED WITH THE SELF WEIGHT LOAD OF THE BEAMS.
- SCREED ELEVATIONS SHOWN REPRESENT THE THEORETICAL DECK SURFACE LOCATION PRIOR TO DEFLECTIONS CAUSED BY DECK PLACEMENT AND OTHER ANTICIPATED DEAD LOADS.
- TOP OF HAUNCH ELEVATIONS SHOWN REPRESENT THE THEORETICAL LOCATION OF THE BOTTOM OF THE DECK ABOVE THE BEAM/GIRDER HAUNCH PRIOR TO DEFLECTIONS CAUSED BY DECK PLACEMENT AND OTHER ANTICIPATED DEAD LOADS.
- FINAL DECK SURFACE ELEVATIONS SHOWN REPRESENT THE DECK SURFACE LOCATION AFTER ALL ANTICIPATED DEAD LOAD DEFLECTIONS HAVE OCCURRED.


0	2019-09-30	RFC
NO.	DATE	DESCRIPTION
ISSUE RECORD		

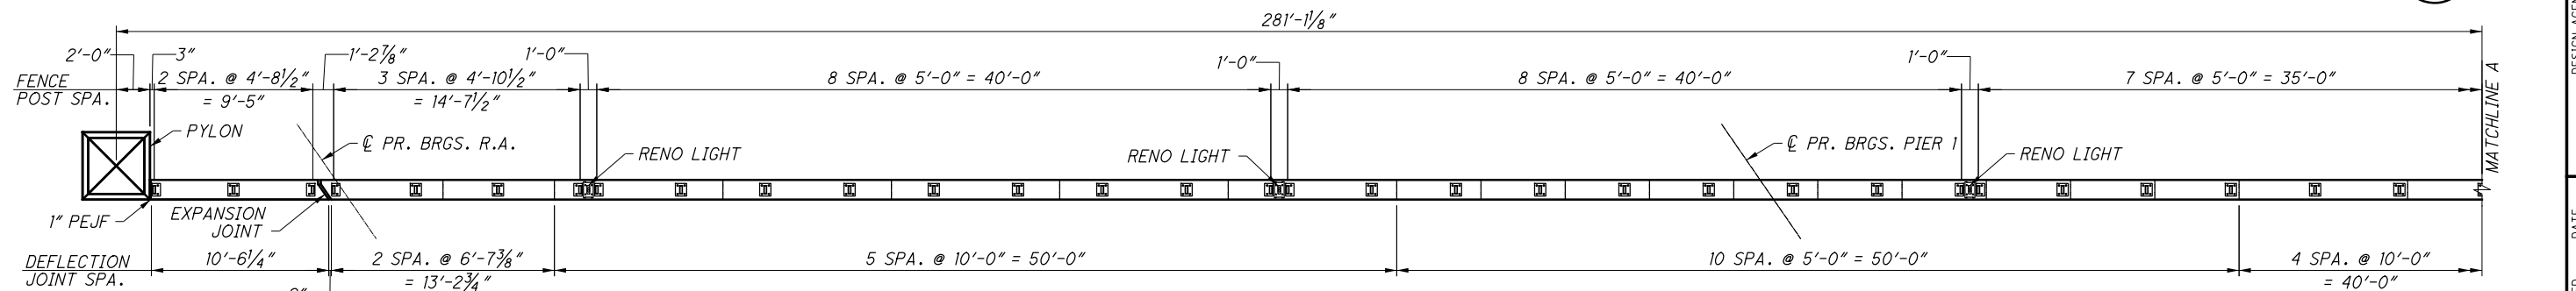


LEFT PARAPET PLAN

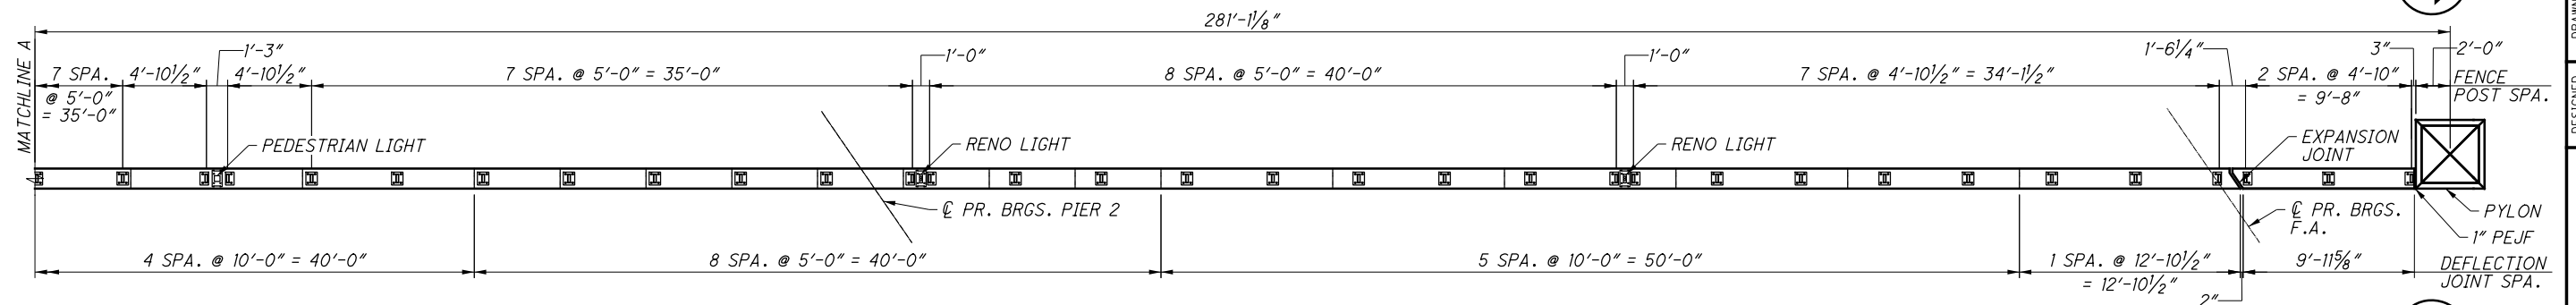

LEFT PARAPET PLAN

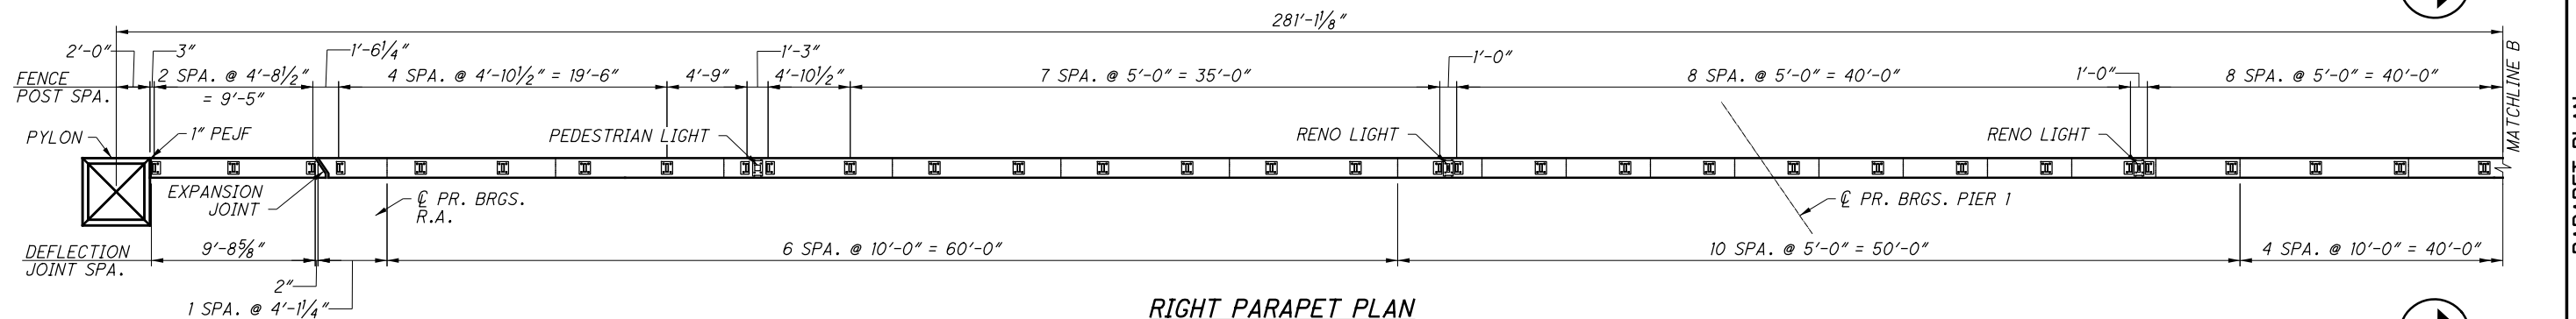

RIGHT PARAPET PLAN

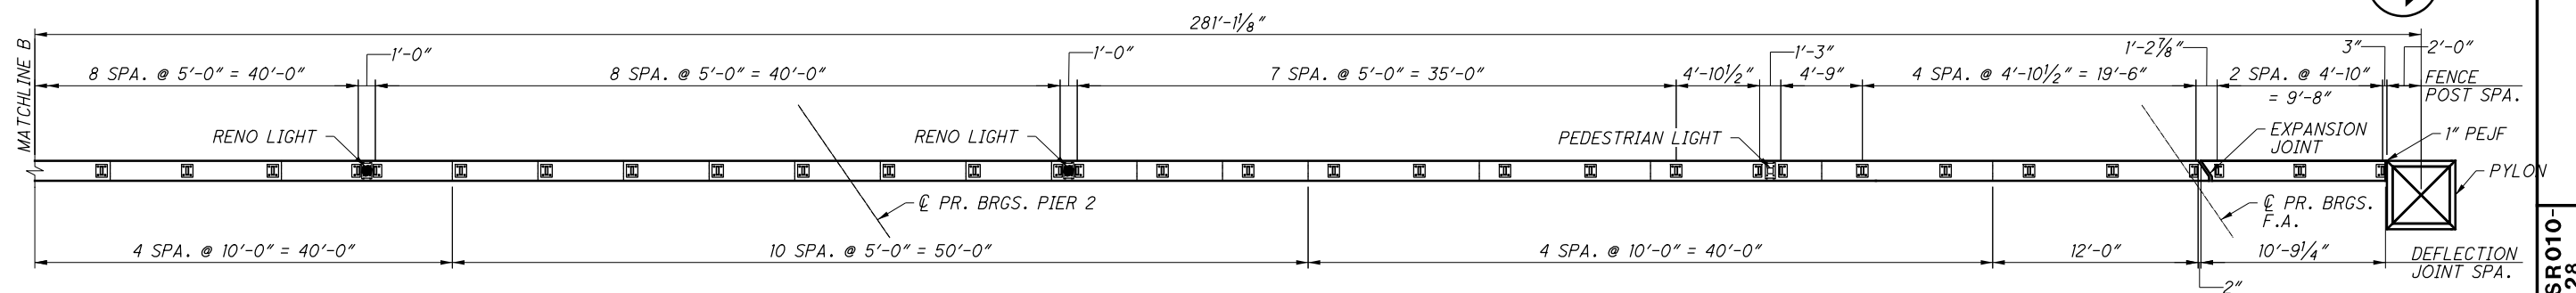


RIGHT PARAPET PLAN


NOTE:

1. ALL DIMENSIONS MEASURED ALONG TOE OF PARAPET.
2. SEE STD. DWG. BR-2-15 FOR ADDITIONAL RAILING DEFLECTION JOINT DETAILS.
3. RENO LIGHT COLUMNS ARE BY HESSAMERICA, PRODUCT CODE: REN3200-LED2-10RB-GG OR APPROVED EQUAL. CONDUIT SHALL BE EMBEDDED AND NOT VISIBLE.
4. FOR PARAPET ELEVATIONS, SEE SHEETS 26/37 AND 27/37.

O	2019-09-30	RFC
NO.	DATE	DESCRIPTION
ISSUE RECORD		

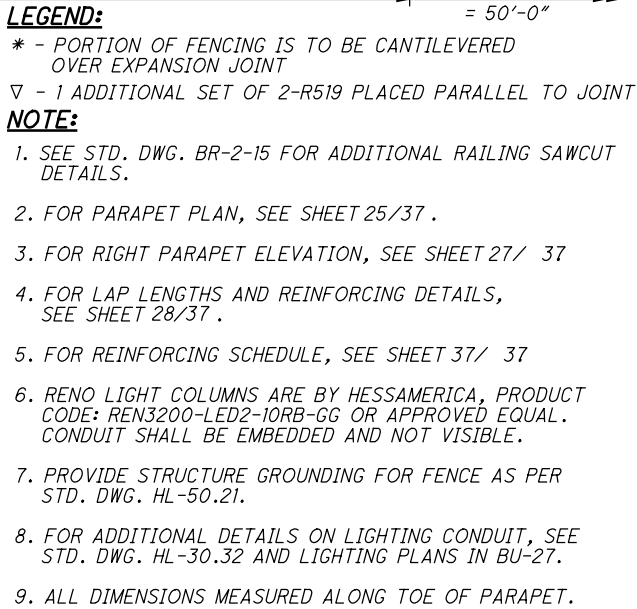


0	2019-09-30	RFC
NO.	DATE	DESCRIPTION
ISSUE RECORD		

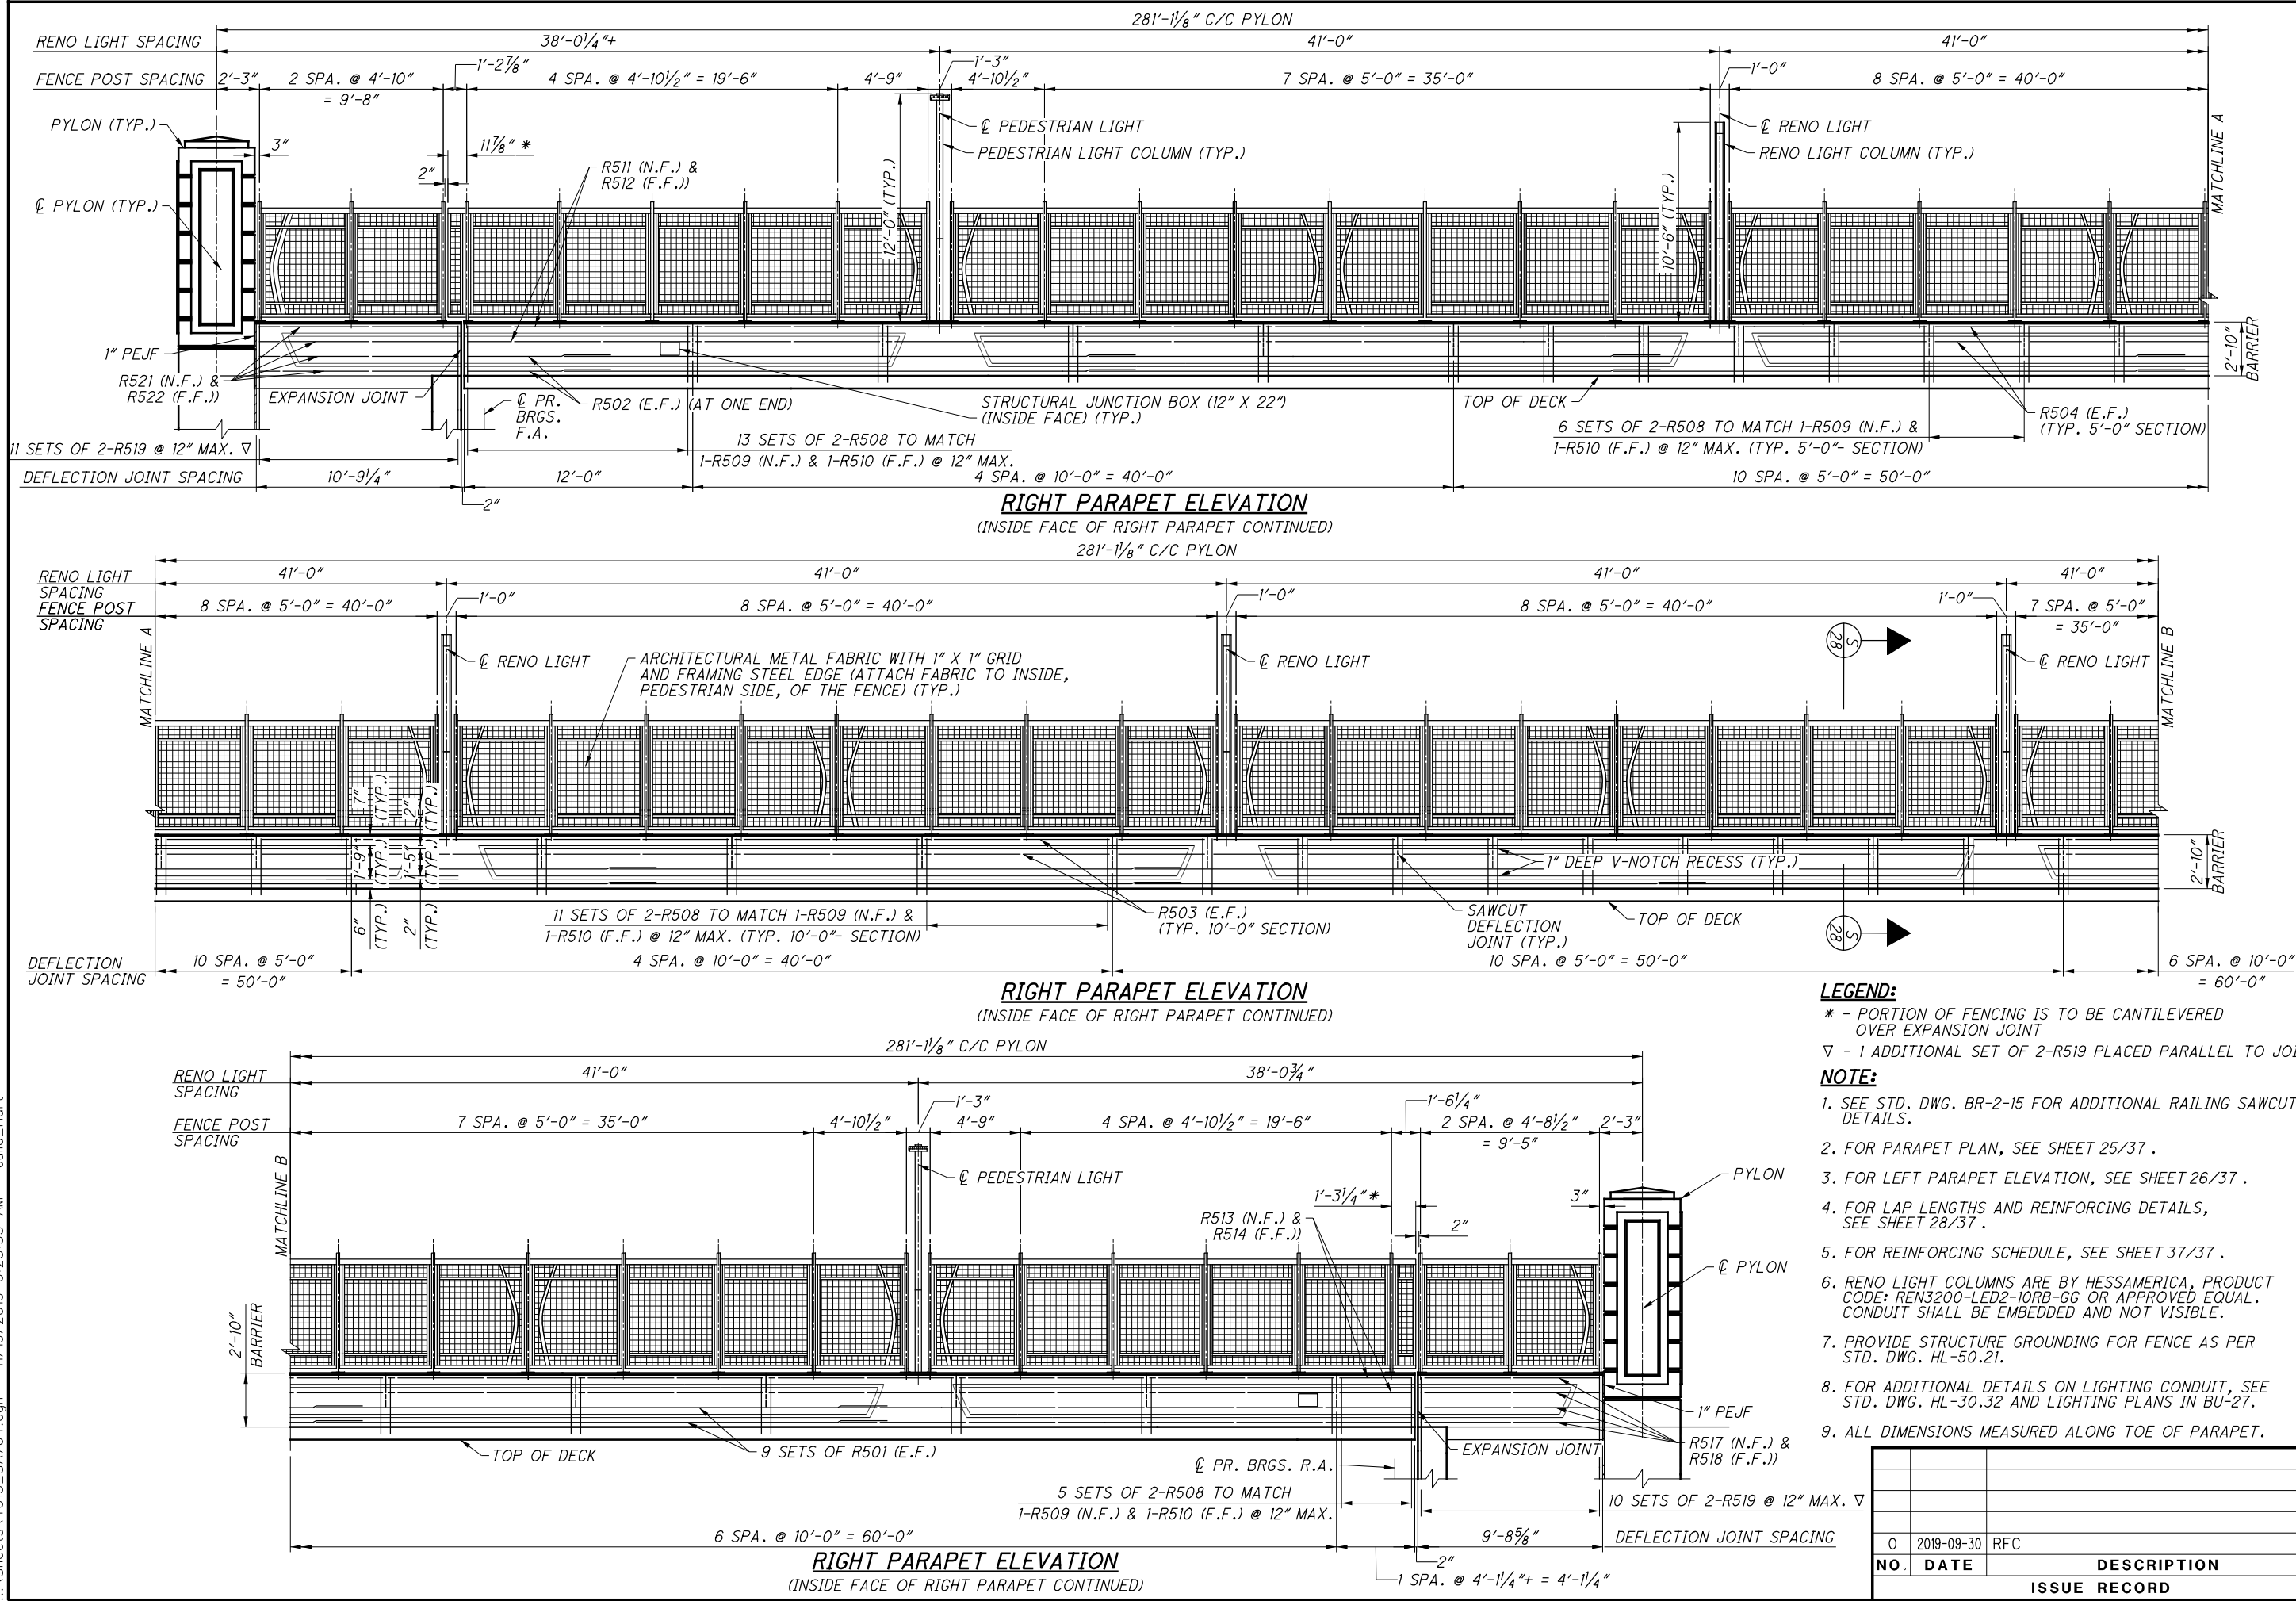


- LEGEND:**
- * - PORTION OF FENCING IS TO BE CANTILEVERED OVER EXPANSION JOINT
 - ▽ - 1 ADDITIONAL SET OF 2-R519 PLACED PARALLEL TO JOINT
- NOTE:**
- SEE STD. DWG. BR-2-15 FOR ADDITIONAL RAILING SAWCUT DETAILS.
 - FOR PARAPET PLAN, SEE SHEET 25/37.
 - FOR LEFT PARAPET ELEVATION, SEE SHEET 26/37.
 - FOR LAP LENGTHS AND REINFORCING DETAILS, SEE SHEET 28/37.
 - FOR REINFORCING SCHEDULE, SEE SHEET 37/37.
 - RENO LIGHT COLUMNS ARE BY HESSAMERICA, PRODUCT CODE: REN3200-LED2-10RB-GG OR APPROVED EQUAL. CONDUIT SHALL BE EMBEDDED AND NOT VISIBLE.
 - PROVIDE STRUCTURE GROUNDING FOR FENCE AS PER STD. DWG. HL-50.21.
 - FOR ADDITIONAL DETAILS ON LIGHTING CONDUIT, SEE STD. DWG. HL-30.32 AND LIGHTING PLANS IN BU-27.
 - ALL DIMENSIONS MEASURED ALONG TOE OF PARAPET.

			CU
0	2019-09-30	RFC	27 / 37
NO.	DATE	DESCRIPTION	<div>29</div> <div>39</div>
ISSUE RECORD			

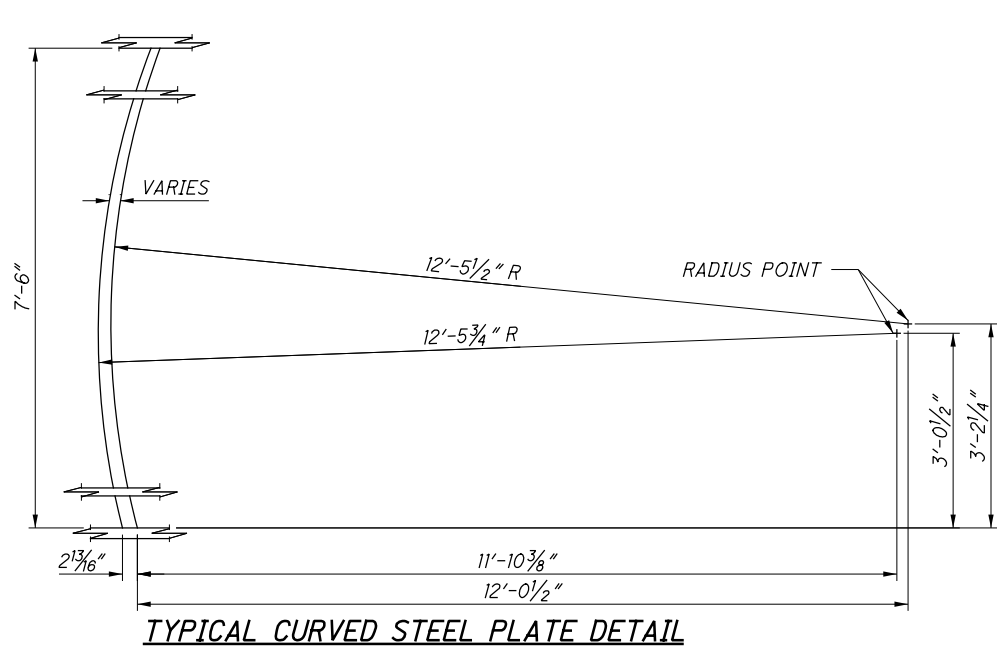


TYPICAL CURVED STEEL PLATE DETAIL

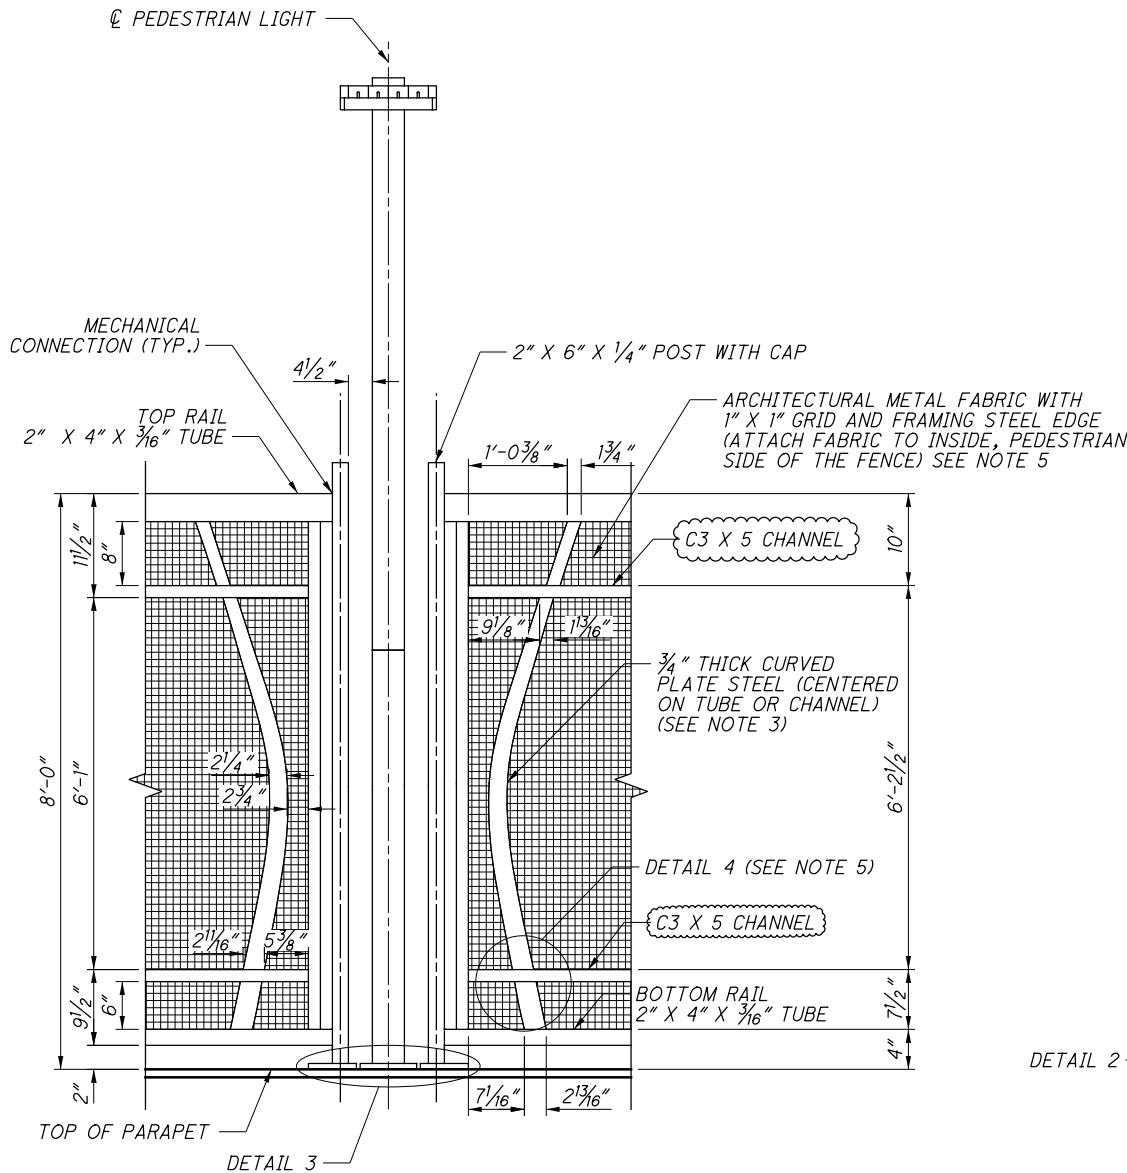


PEDESTRIAN LIGHT FENCE DETAILS

(PLACE FABRIC ON INSIDE, PEDESTRIAN SIDE OF THE FENCE)
(FENCE FABRIC FASTENERS NOT SHOWN)

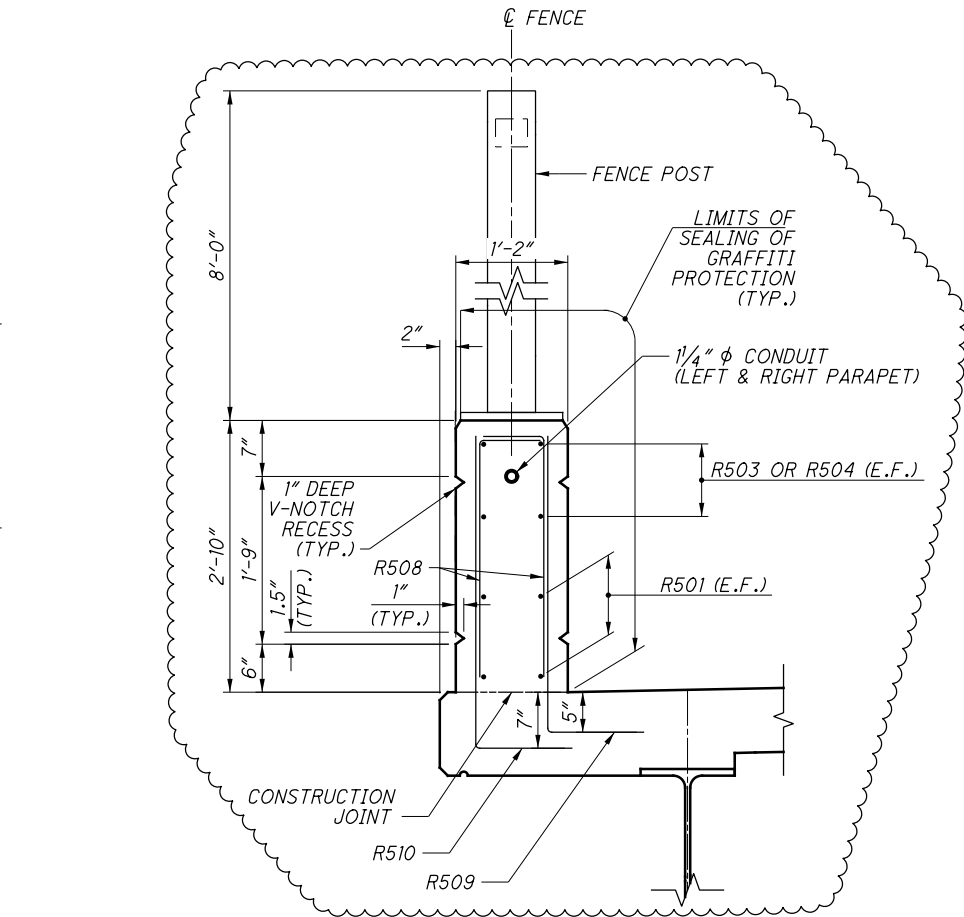


TYPICAL CANTILEVERED FENCE PANEL ELEVATION DETAIL

(PLACE FABRIC ON INSIDE, PEDESTRIAN SIDE OF THE FENCE)
(FENCE FABRIC FASTENERS NOT SHOWN)

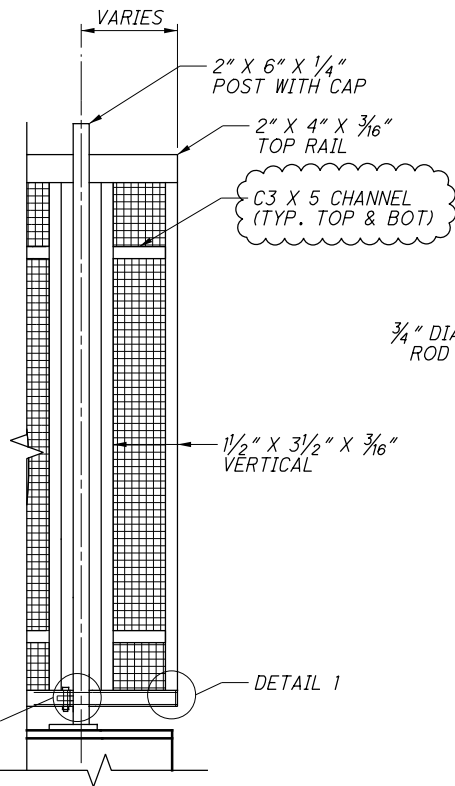


PEDESTRIAN LIGHT ANCHOR BOLT DETAILS

THREADED ROD SHALL BE ASTM A320 B8
CLASS 2 HARDENED STAINLESS STEEL (ANSI 304),
Fy=100 KSI, WITH ASTM A194 GRADE 8
NUTS AND SS304 WASHERS

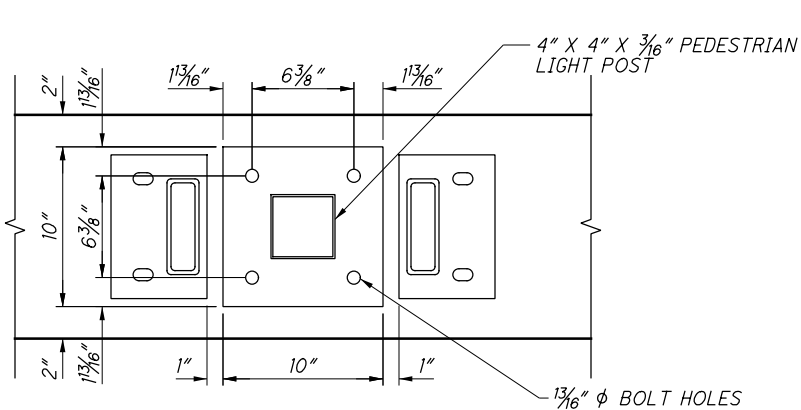


DETAIL 3

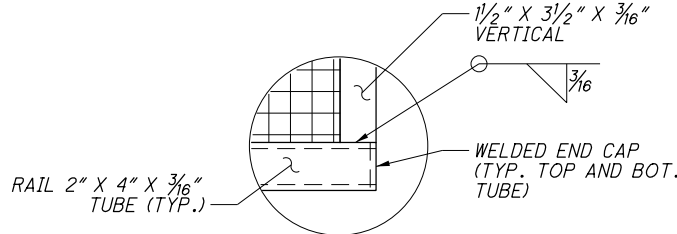

DETAIL 1

(TYP. TOP AND BOTTOM)

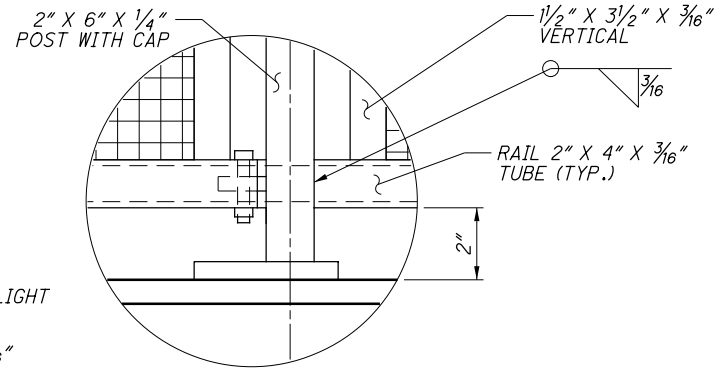


DETAIL 2

(TYP. TOP AND BOTTOM)


NOTE:

1. FOR PARAPET PLAN AND LOCATION OF PEDESTRIAN LIGHT POLES, SEE SHEET 25/37.
2. FOR REINFORCING SCHEDULE, SEE SHEET 37/37.
3. PEDESTRIAN LIGHT COLUMNS SHALL BE COOPER GALLEON LED FIXTURES ON 4" SQUARE, 12' HIGH ALUMINUM POLE, OR APPROVED EQUAL. CONDUIT SHALL BE EMBEDDED AND NOT VISIBLE.
4. FOR DETAIL 4, SEE SHEET 29/37.
5. FENCING FABRIC AND HARDWARE SHALL BE COLOR: BLACK - FEDERAL, STANDARD 595C #17038
6. SEE STD. DWG. VPF-I-90 FOR ADDITIONAL NOTES AND DETAILS RELATED TO BASE PLATE SHIMS AND CAULKING.


NO.	DATE	DESCRIPTION
1	2024-09-10	RECORD DRAWINGS
0	2019-09-30	RFC
ISSUE RECORD		

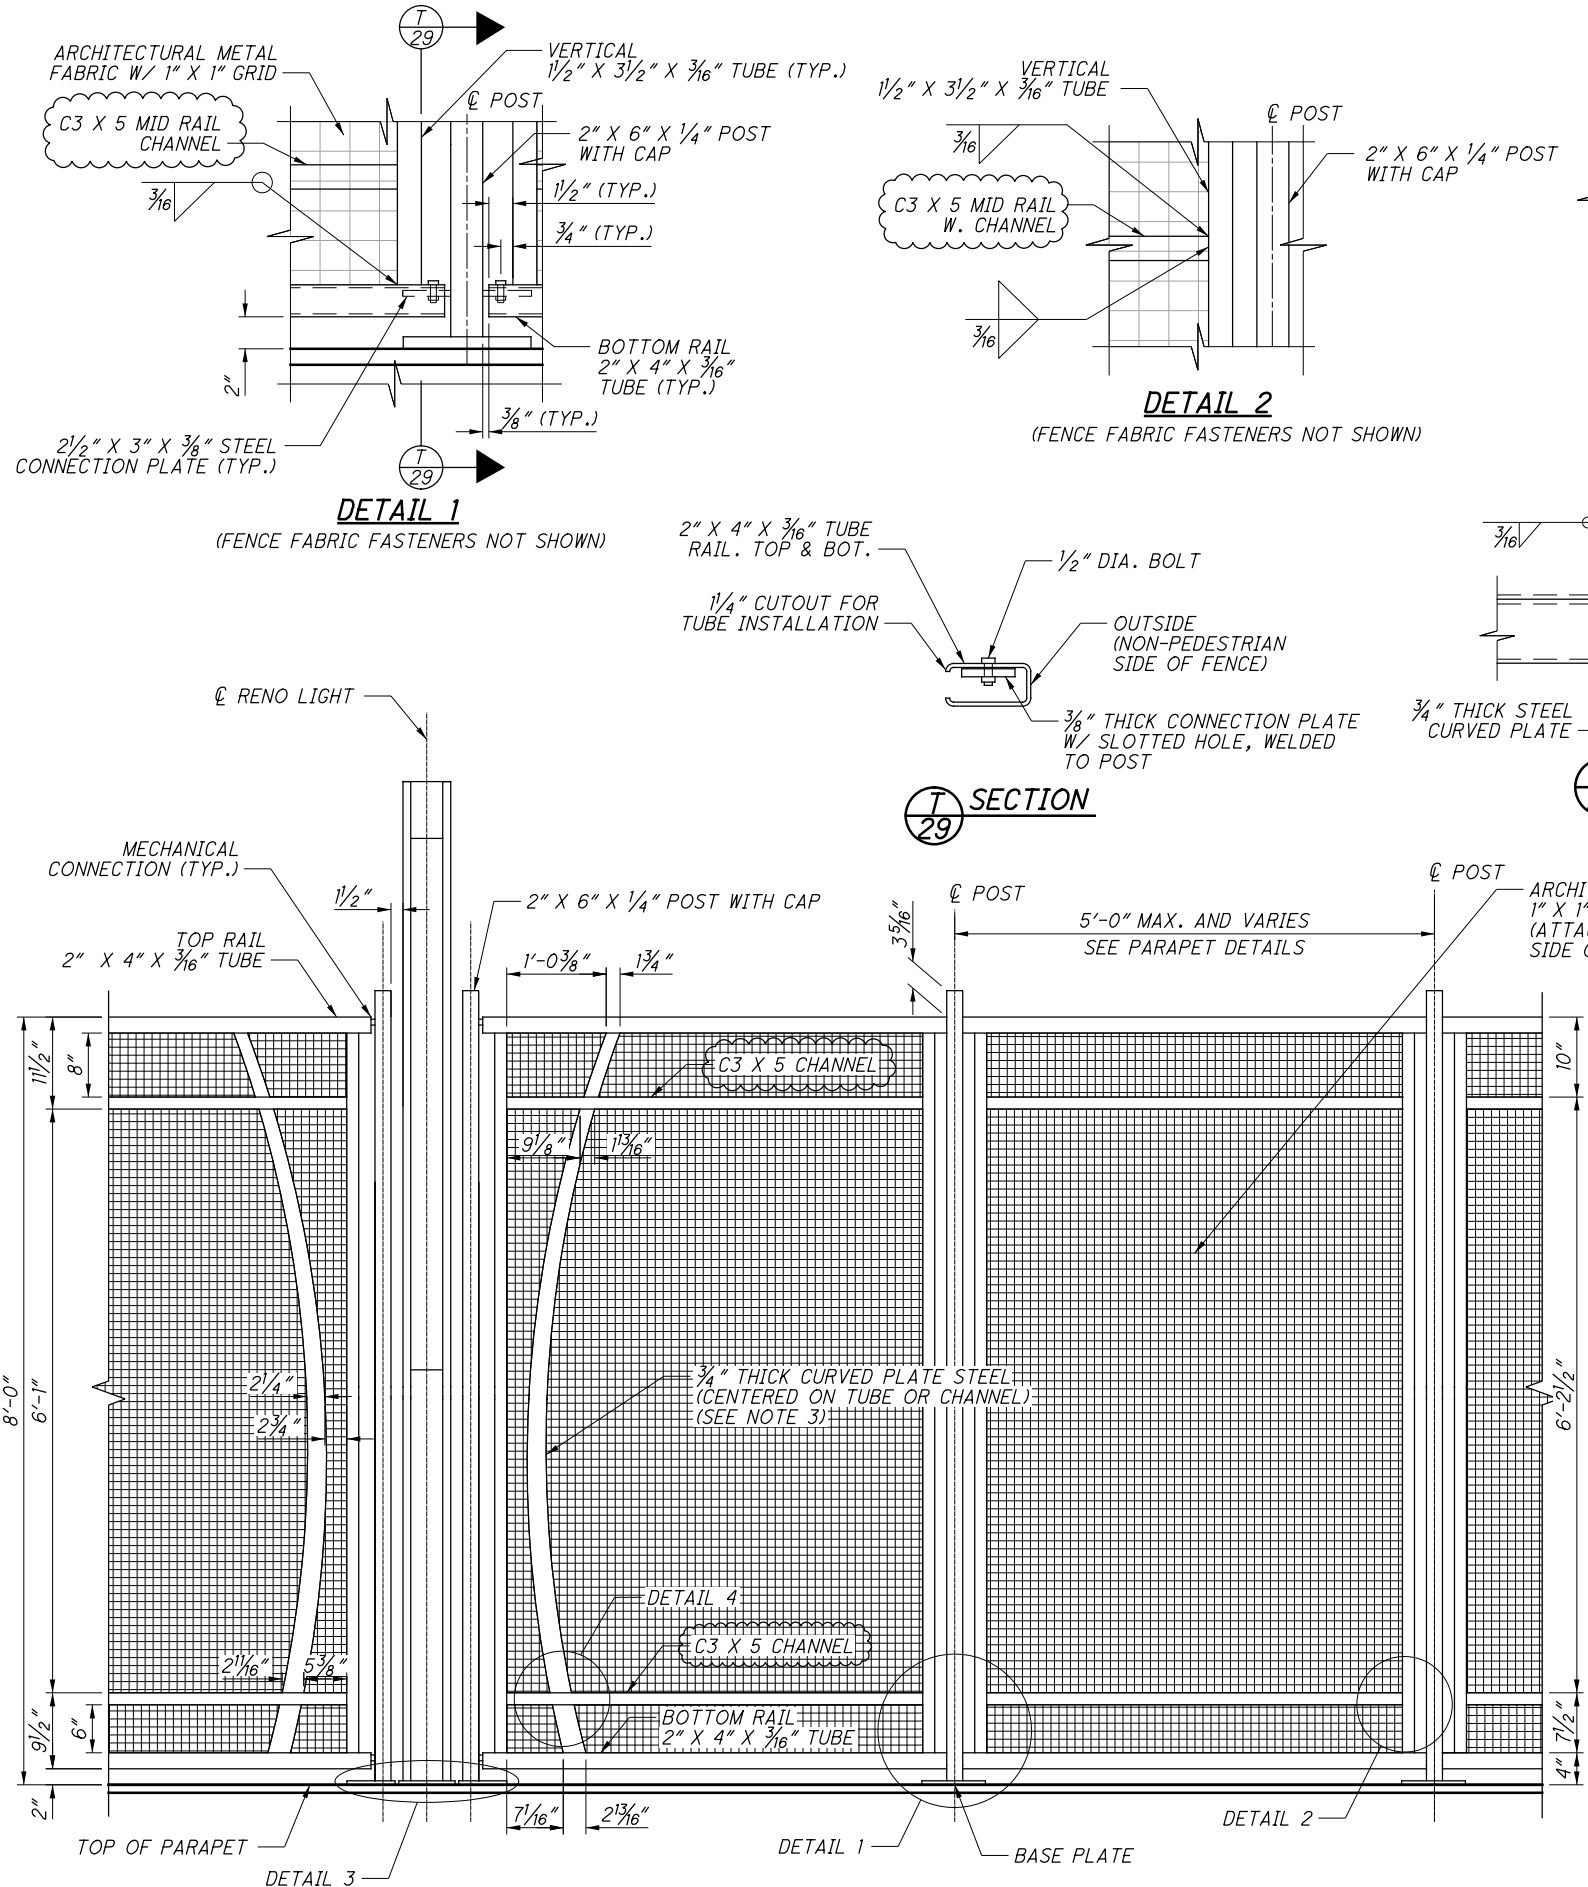


RENO LIGHT FENCE AND TYPICAL FENCE PANEL DETAILS
(PLACE FABRIC ON INSIDE, PEDESTRIAN SIDE OF THE FENCE)
(FENCE FABRIC FASTENERS NOT SHOWN)

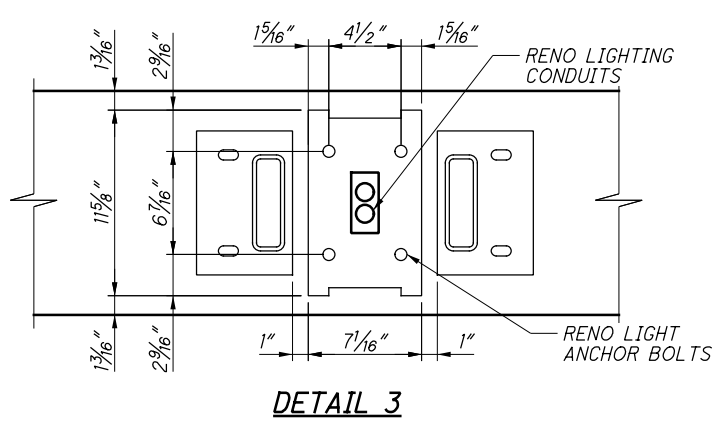


CONNECTION PLATE DETAILS
(PLAN VIEW)

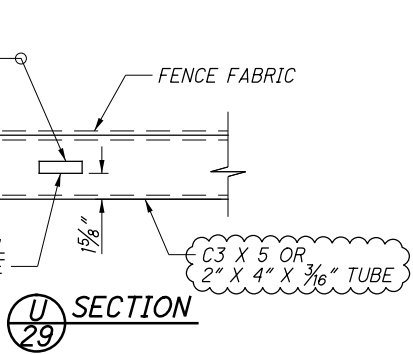


TYPICAL MID-POST BASE PLATE DETAIL

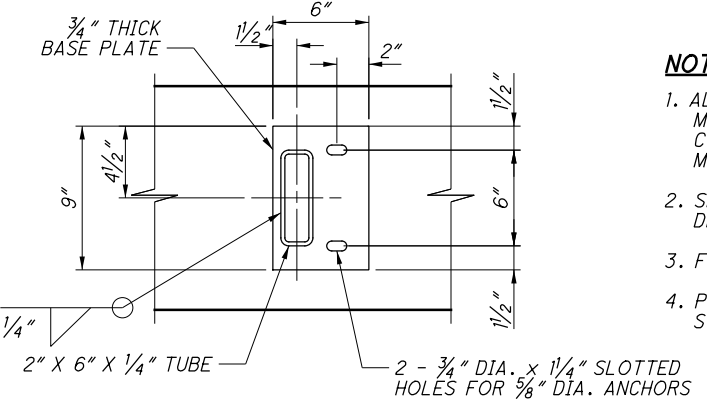

TYPICAL END POST BASE PLATE DETAIL

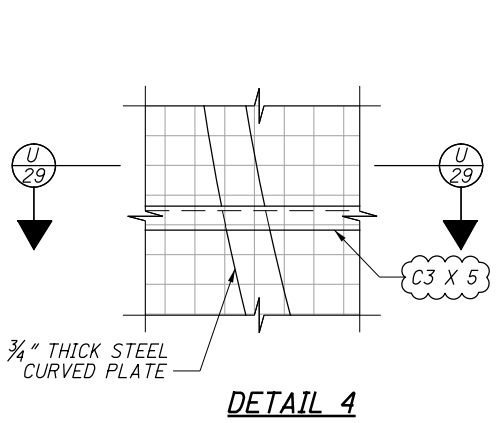


TYPICAL TUBE CUTOUT DETAIL

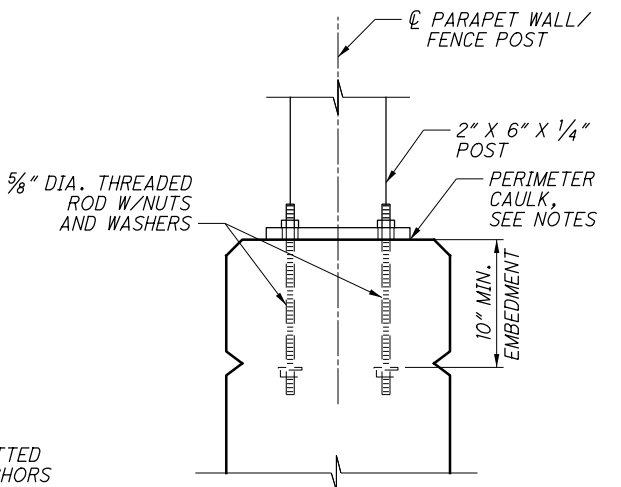


TYPICAL ANCHOR BOLT DETAILS

- NOTES:**
1. ALL POSTS SHALL BE INSTALLED PLUMB. PROVIDE SHIMS MADE FROM MULTI-POLYMER PLASTIC WITH MINIMUM COMPRESSIVE STRENGTH OF 5,000 PSI. ENDS OF POSTS MAY BE CUT ON BIAS TO PROVIDE PLUMB INSTALLATION.
 2. SEE STD. DWG. VPF-1-90 FOR ADDITIONAL NOTES AND DETAILS RELATED TO BASE PLATE SHIMS AND CAULKING.
 3. FOR CURVED STEEL PLATE DETAILS, SEE SHEET 25/37.
 4. PROVIDE GROUNDING OF RENO LIGHT ANCHOR BOLTS PER STD. DWG. HL-50.21.

NO.	DATE	DESCRIPTION
1	2024-09-10	RECORD DRAWINGS
0	2019-09-30	RFC
ISSUE RECORD		


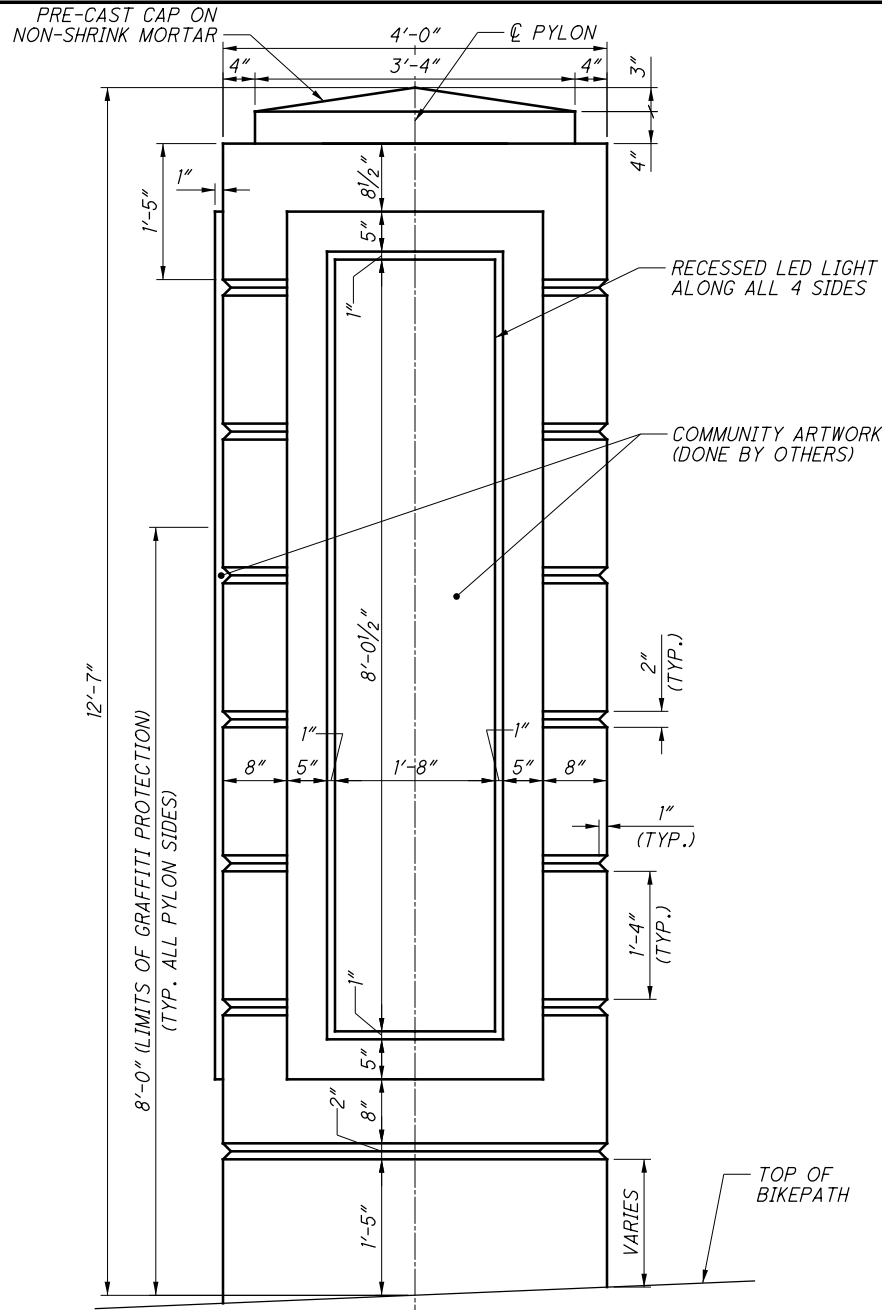


VIEW
(VIEW V SHOWN, VIEW X SIMILAR BUT OPPOSITE HAND)

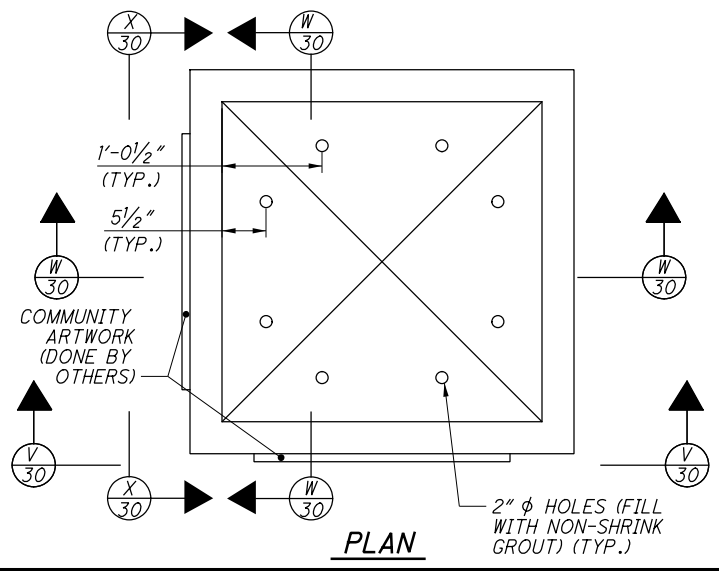

LEGEND:


- ▽ - 4-R413 E.F. (PYLON 1), 4-R414 E.F. (PYLON 2), 4-R415 E.F. (PYLON 3), 4-R416 E.F. (PYLON 4)
- ⊕ - 4-R409 N.F. (PYLON 1), 4-R410 N.F. (PYLON 2), 4-R411 N.F. (PYLON 3), 4-R412 N.F. (PYLON 4)
- ◇ - 4-R413 F.F. (PYLON 1), 4-R414 F.F. (PYLON 2), 4-R415 F.F. (PYLON 3), 4-R416 F.F. (PYLON 4)
- ★ - R413 (PYLON 1), R414 (PYLON 2), R415 (PYLON 3), R416 (PYLON 4)

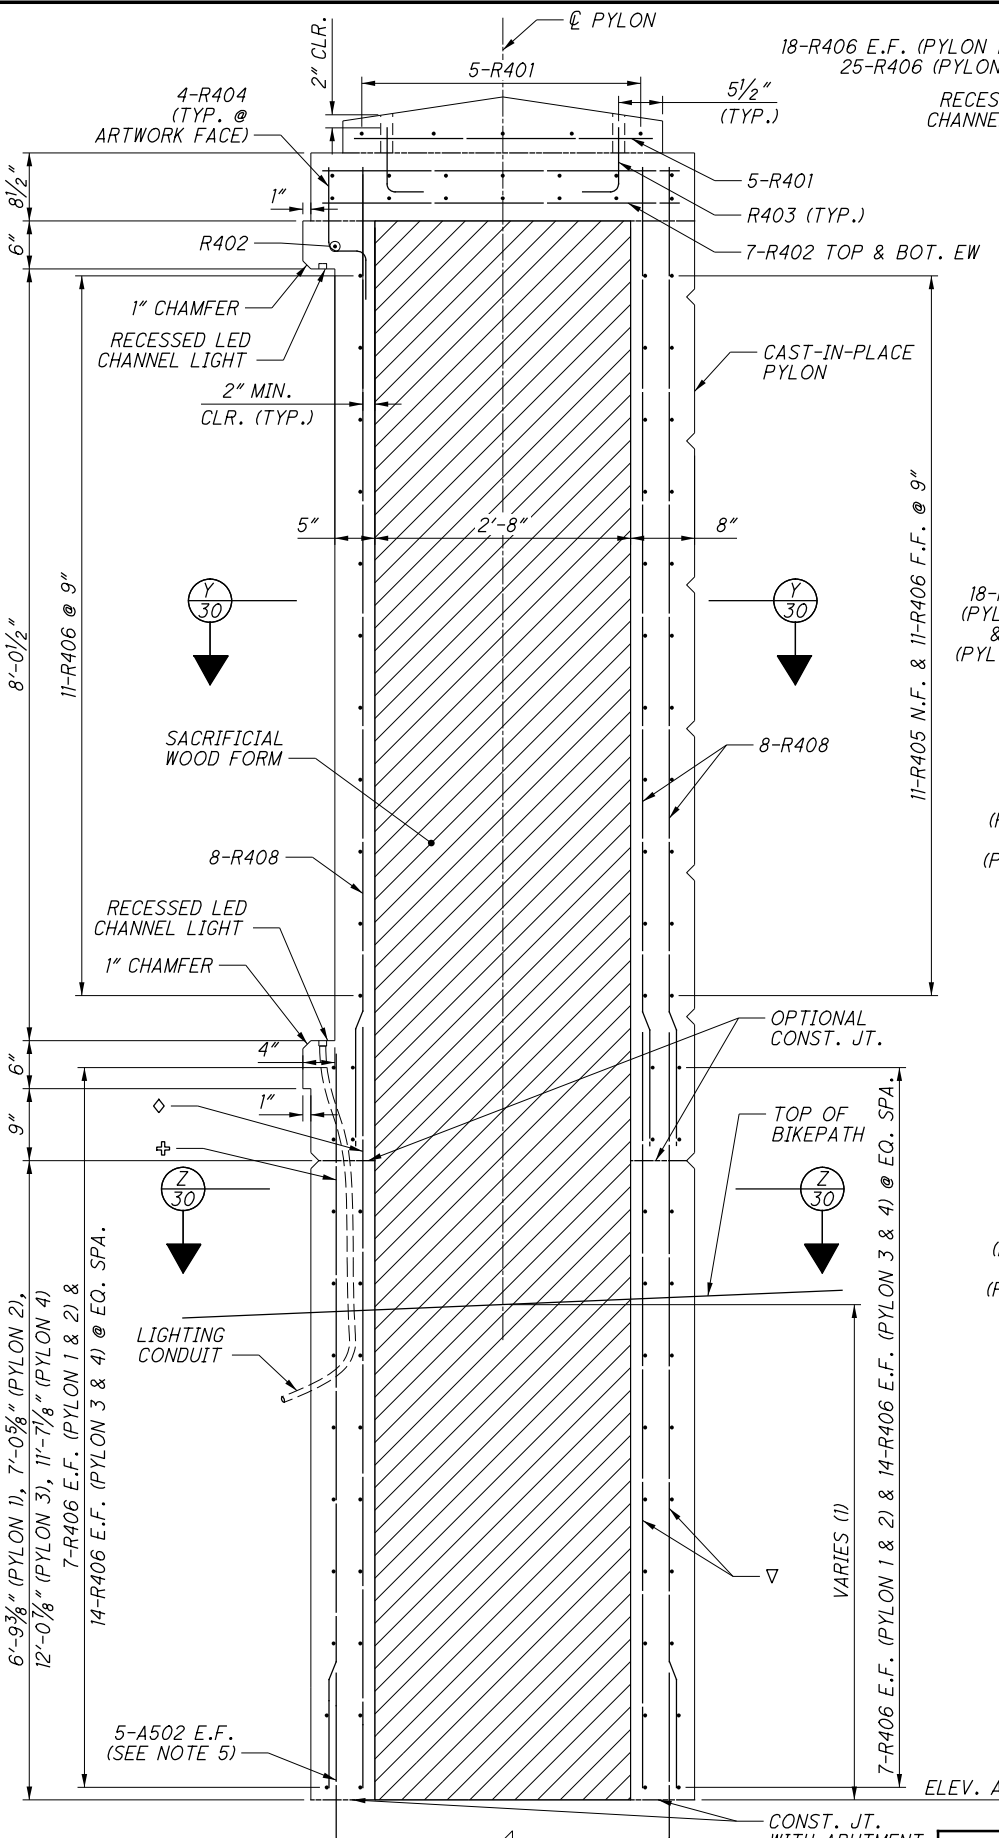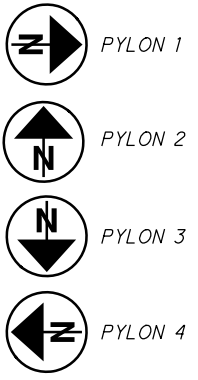


SECTION
(SEE NOTE 5)

PYLON NUMBER	DIMENSION (1)
PYLON 1	5'-3 3/8"
PYLON 2	5'-6 5/8"
PYLON 3	10'-6 7/8"
PYLON 4	10'-1 1/8"

ELEVATION TABLE	
PYLON NUMBER	ELEV. A
PYLON 1	698.50
PYLON 2	698.50
PYLON 3	692.00
PYLON 4	692.00

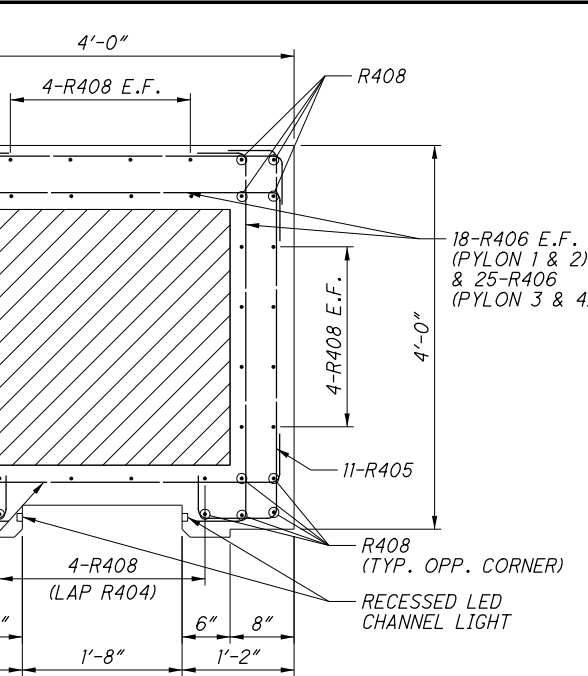

SECTION

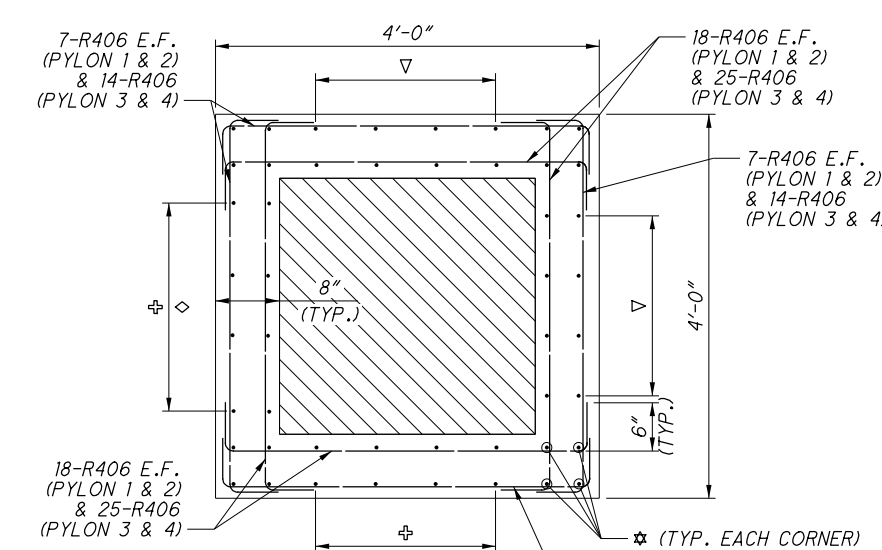


SECTION

NOTES:

- FOR LOCATION OF PYLONS, SEE SHEET 1/37.
- SEAL ALL EXPOSED SURFACES OF PYLONS PER ITEM 512 SEALING OF CONCRETE SURFACES.
- ALL CONCRETE SHALL BE CLASS QC2 WITH QC/QA.
- FOR LIGHTING CONDUIT DETAILS, SEE THE LIGHTING PLANS IN BU-27.
- FOR PYLON REBAR CONNECTION TO ABUTMENTS, SEE SHEETS 11/37 THROUGH 16/37.
- SEE SHEET 37 FOR REINFORCING SCHEDULE.



ISSUE RECORD		
NO.	DATE	DESCRIPTION
1	2024-09-10	RECORD DRAWINGS
0	2019-09-30	RFC

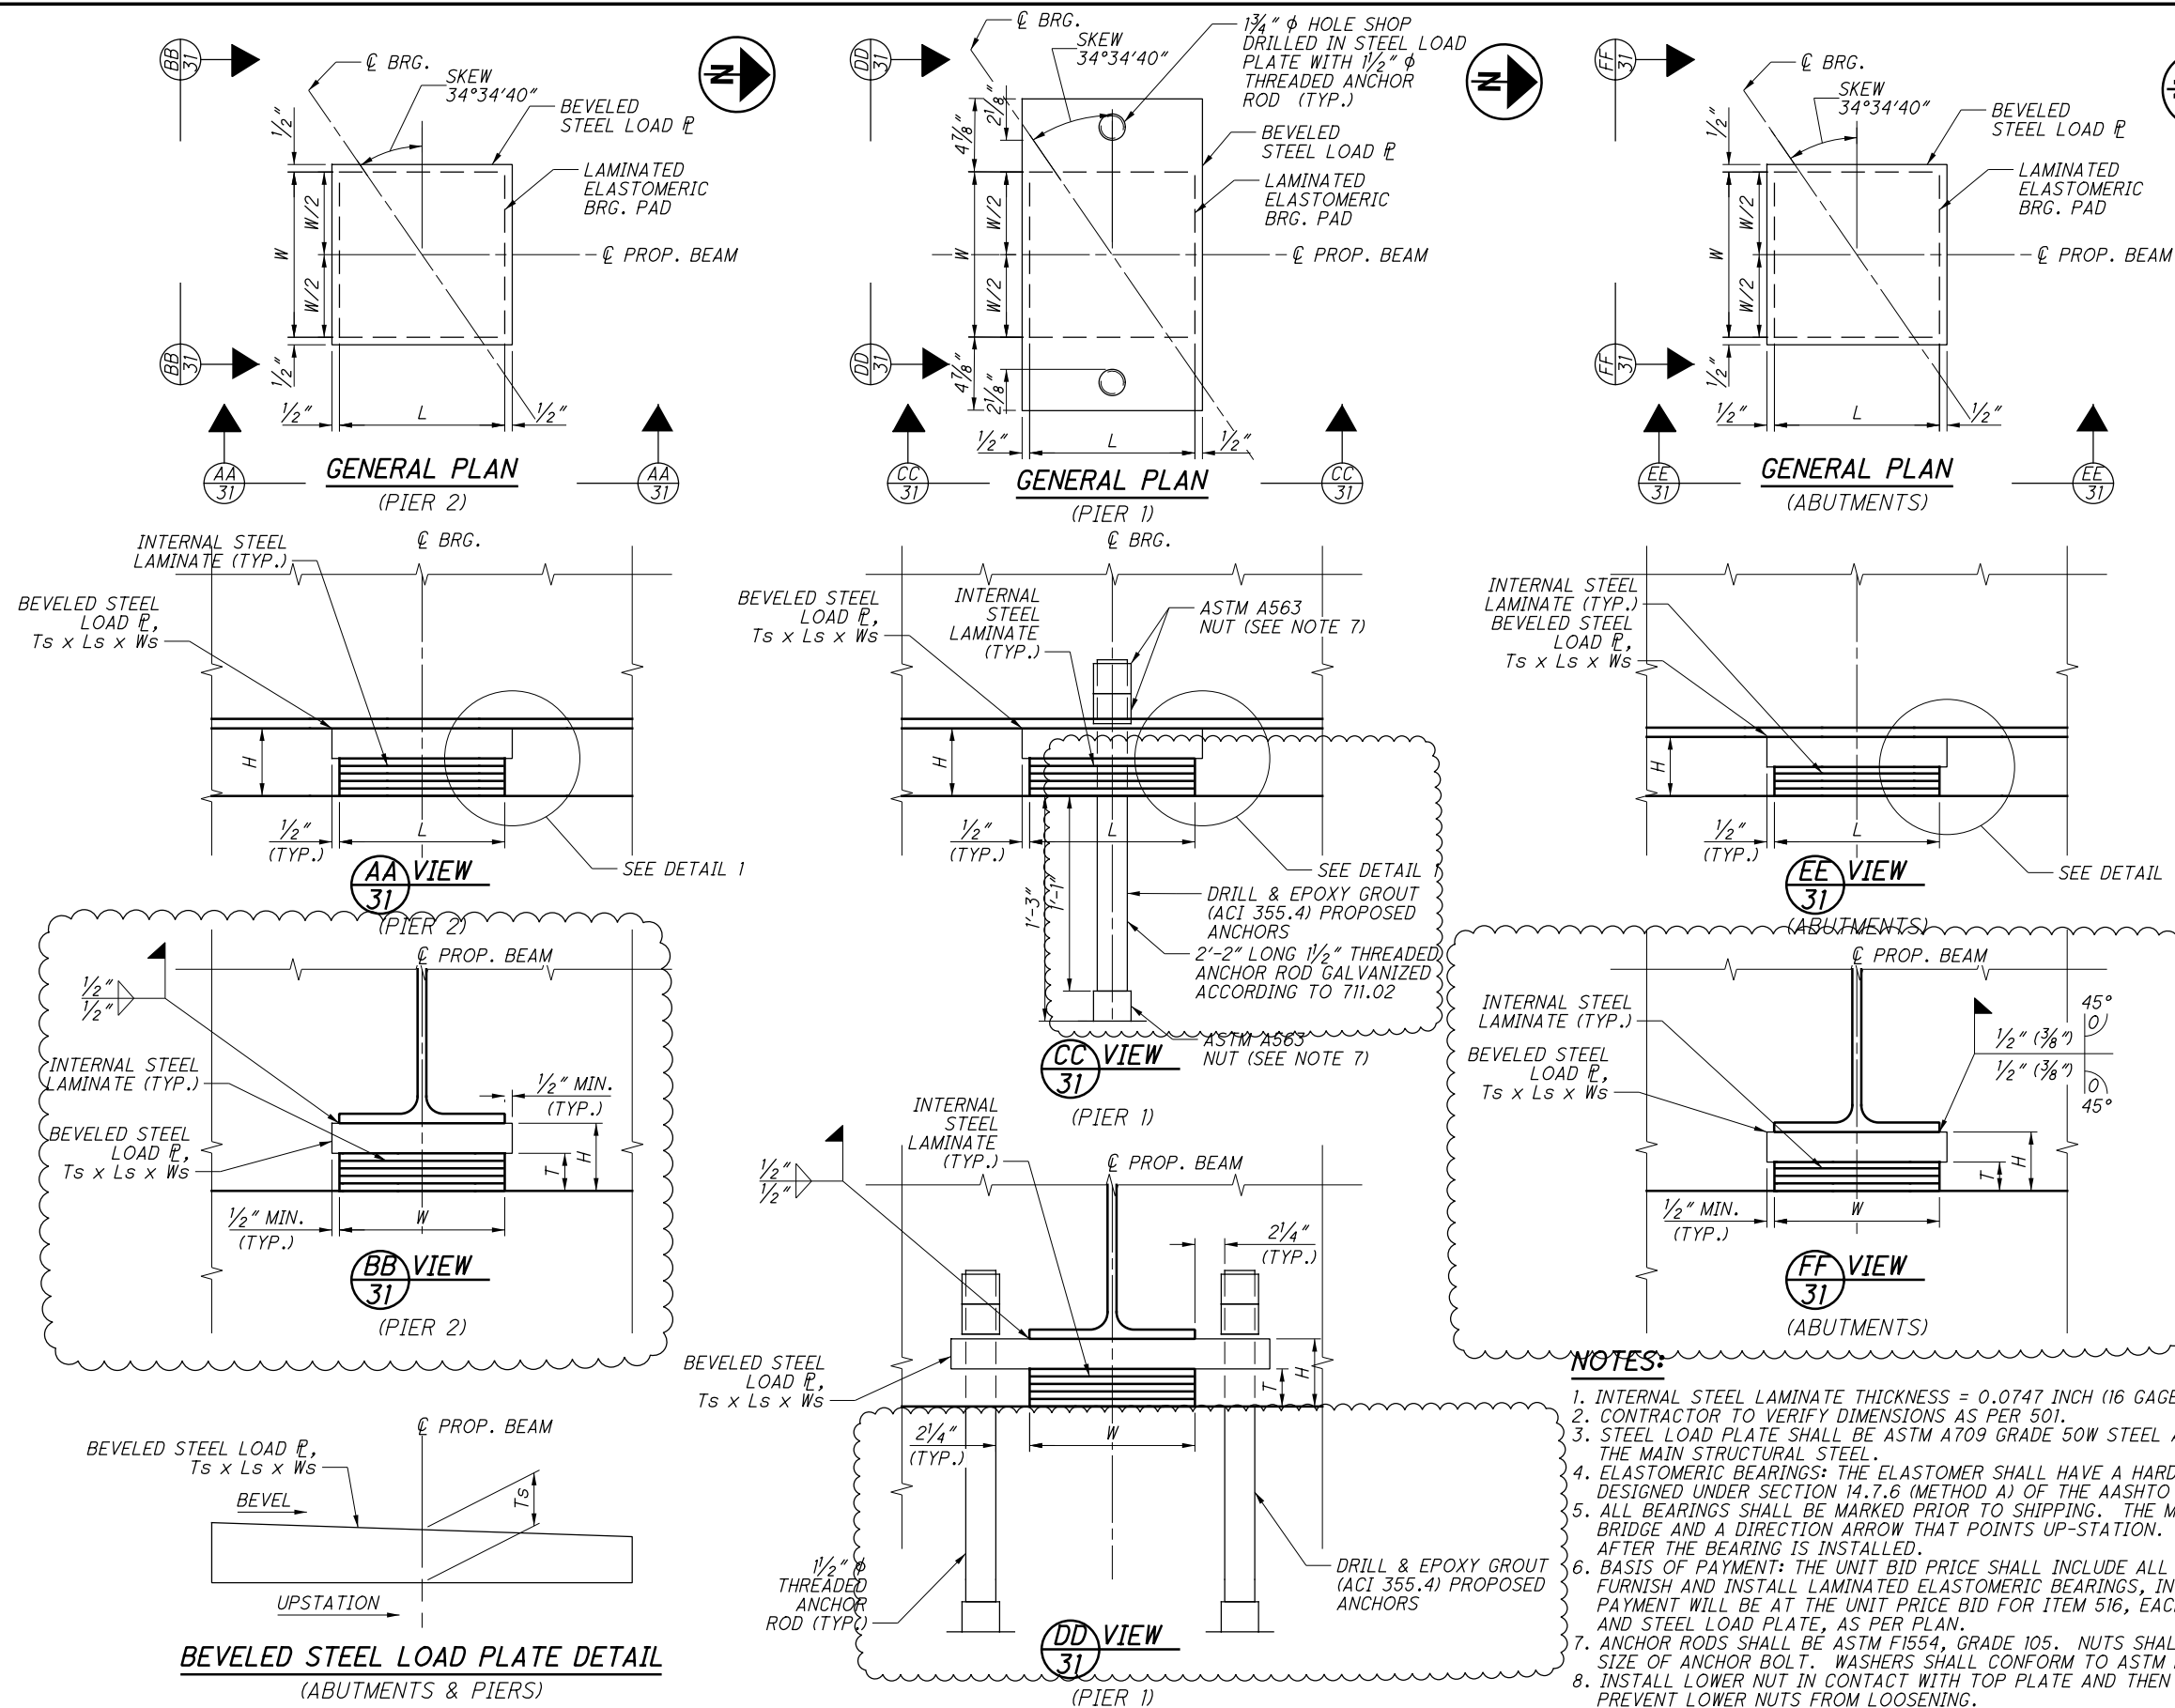


- NOTES:**
- INTERNAL STEEL LAMINATE THICKNESS = 0.0747 INCH (16 GAGE).
 - CONTRACTOR TO VERIFY DIMENSIONS AS PER 501.
 - STEEL LOAD PLATE SHALL BE ASTM A709 GRADE 50W STEEL AND SHALL HAVE THE SAME PROTECTIVE COATING AS THE MAIN STRUCTURAL STEEL.
 - ELASTOMERIC BEARINGS: THE ELASTOMER SHALL HAVE A HARDNESS OF 50 DUROMETER. THE BEARINGS WERE DESIGNED UNDER SECTION 14.7.6 (METHOD A) OF THE AASHTO LRFD DESIGN SPECIFICATIONS.
 - ALL BEARINGS SHALL BE MARKED PRIOR TO SHIPPING. THE MARKS SHALL INCLUDE THE BEARING LOCATION ON THE BRIDGE AND A DIRECTION ARROW THAT POINTS UP-STATION. ALL MARKS SHALL BE PERMANENT AND SHALL BE VISIBLE AFTER THE BEARING IS INSTALLED.
 - BASIS OF PAYMENT: THE UNIT BID PRICE SHALL INCLUDE ALL MATERIALS, LABOR, AND INCIDENTALS NECESSARY TO FURNISH AND INSTALL LAMINATED ELASTOMERIC BEARINGS, INCLUDING LOAD PLATES AND MISC. HARDWARE. PAYMENT WILL BE AT THE UNIT PRICE BID FOR ITEM 516, EACH, ELASTOMERIC BEARING WITH INTERNAL LAMINATES AND STEEL LOAD PLATE, AS PER PLAN.
 - ANCHOR RODS SHALL BE ASTM F1554, GRADE 105. NUTS SHALL CONFORM TO ASTM A563 FOR APPROPRIATE GRADE AND SIZE OF ANCHOR BOLT. WASHERS SHALL CONFORM TO ASTM F436.
 - INSTALL LOWER NUT IN CONTACT WITH TOP PLATE AND THEN BACK OFF 1/2 TURN. INSTALL UPPER NUT SNUG TIGHT TO PREVENT LOWER NUTS FROM LOOSENING.

LAMINATED ELASTOMERIC BEARING DETAILS (INTERIOR AND EXTERIOR BEARINGS ARE THE SAME)																	
SUBSTRUCTURE UNIT	TYPE	BEARING DIMENSIONS, SEE DETAIL 1 (INCHES)								BEVELED PLATE (INCHES)				SERVICE REACTIONS (KIP)			
		L	W	Te	Ti	N	n	T	H	Ls	Ws	Ts	%	DL	LL (MAX.)	DESIGN	
REAR ABUTMENT	EXP.	11	11	0.35	0.5	3	3	2.07	3.57	12	12	1.5	2.88%	43.03	22.35	65.38	
PIER 1	FIX.	13.5	15	0.35	0.5	4	4	2.65	4.15	14.5	24.75	1.5	2.88%	127.72	29.72	157.44	
PIER 2	EXP.	13.5	15	0.35	0.5	4	4	2.65	4.15	14.5	16	1.5	-3.67%	120.93	28.67	149.60	
FORWARD ABUTMENT	EXP.	11	11	0.35	0.5	5	5	3.22	4.72	12	12	1.5	-4.62%	39.53	22.22	61.75	


NO.	DATE	DESCRIPTION
1	2024-09-10	RECORD DRAWINGS
0	2019-09-30	RFC
ISSUE RECORD		

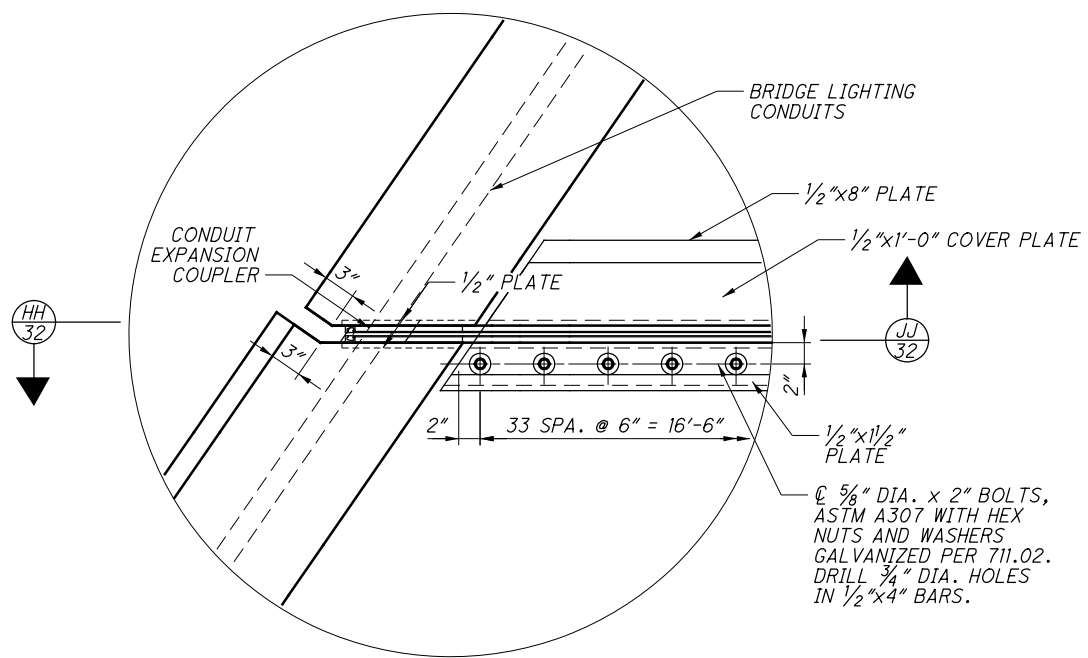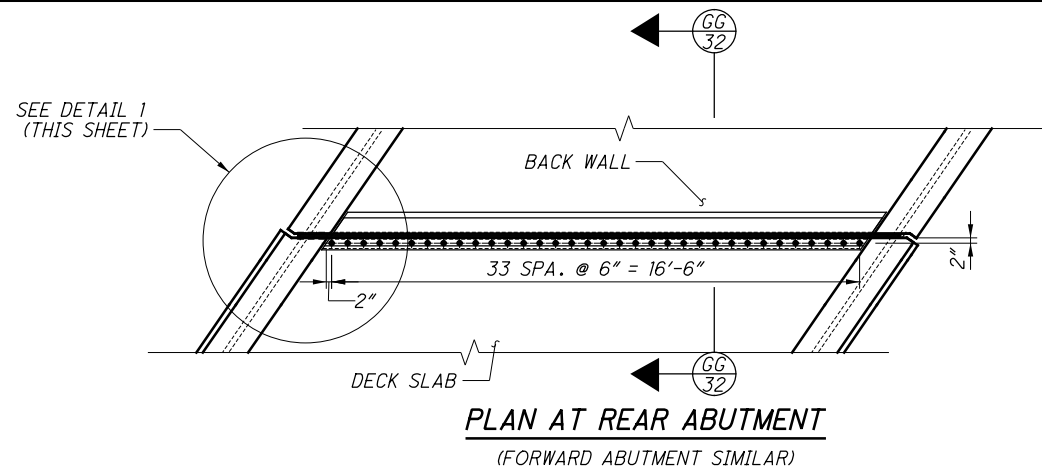

DETAIL 1

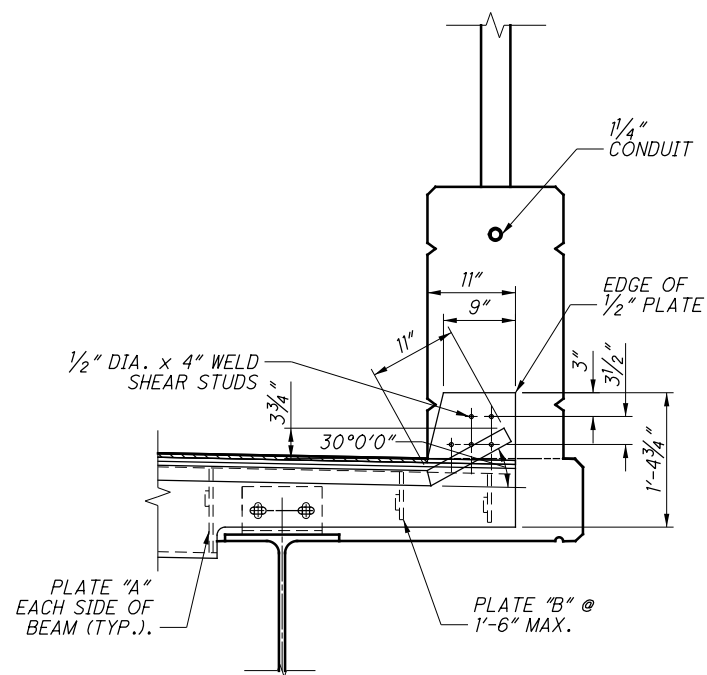


HH SECTION
32

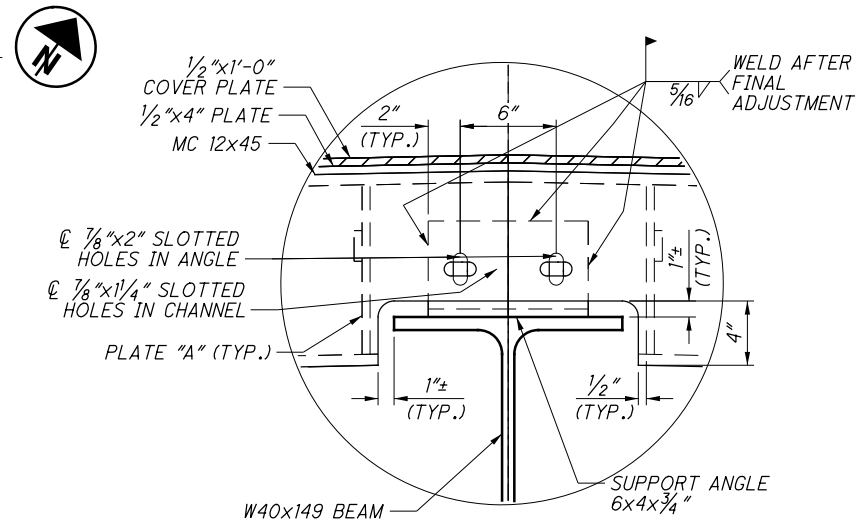


DETAIL 2

DIMENSION "A"		
TEMP.	RA	FA
30°	1 $\frac{13}{16}$ "	1 $\frac{15}{16}$ "
40°	1 $\frac{3}{4}$ "	1 $\frac{13}{16}$ "
50°	1 $\frac{3}{4}$ "	1 $\frac{11}{16}$ "
60°	1 $\frac{11}{16}$ "	1 $\frac{9}{16}$ "
70°	1 $\frac{5}{8}$ "	1 $\frac{1}{2}$ "
80°	1 $\frac{9}{16}$ "	1 $\frac{3}{8}$ "
90°	1 $\frac{1}{2}$ "	1 $\frac{1}{4}$ "

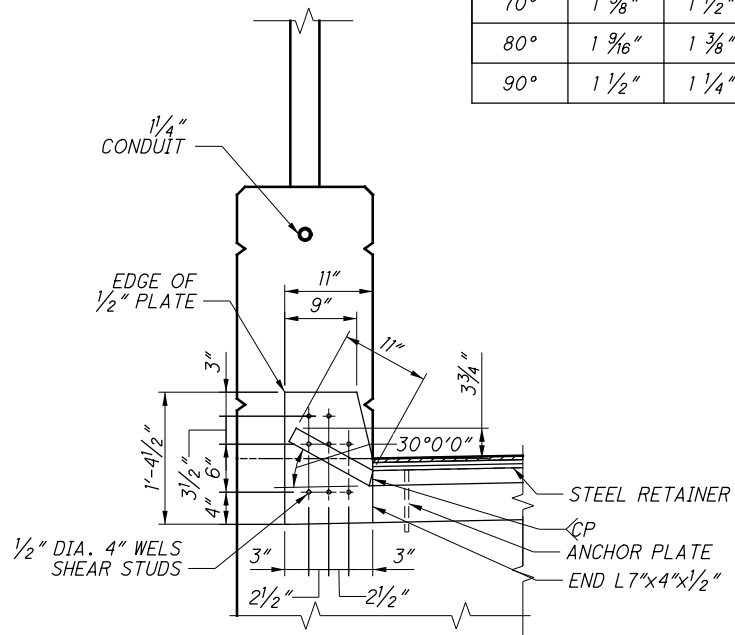JJ SECTION
32


NOTES:

1. SEE STANDARD DRAWING EXJ-4-87 FOR ADDITIONAL NOTES AND DETAILS

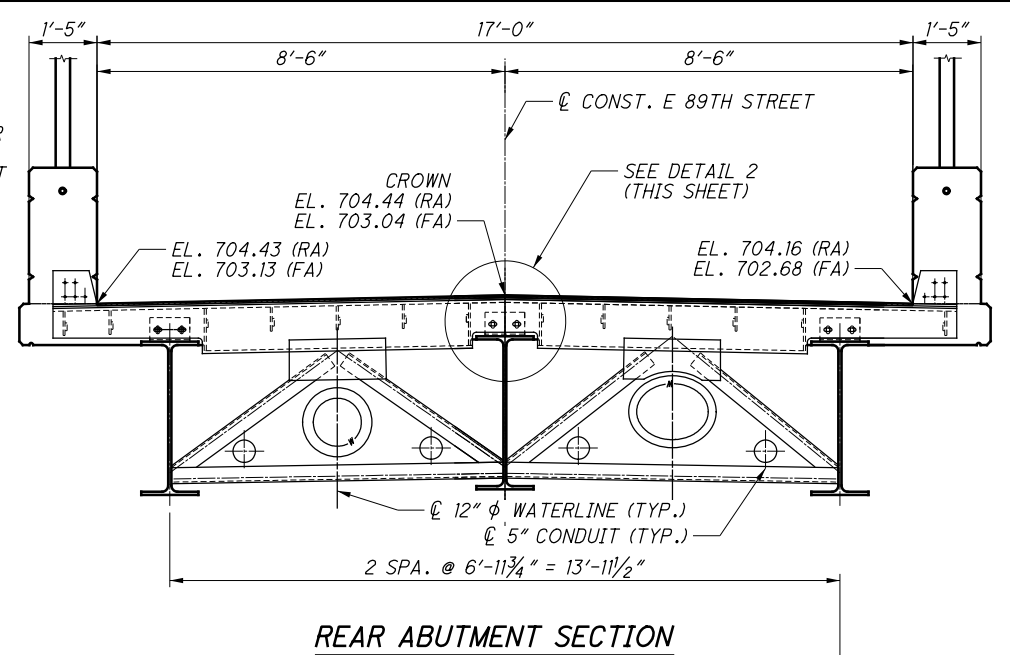

REAR ABUTMENT SECTION

(FORWARD ABUTMENT SIMILAR, OPPOSITE HAND)
(DIMENSIONS ALONG FACE OF BACKWALL ALONG THE SKEW)

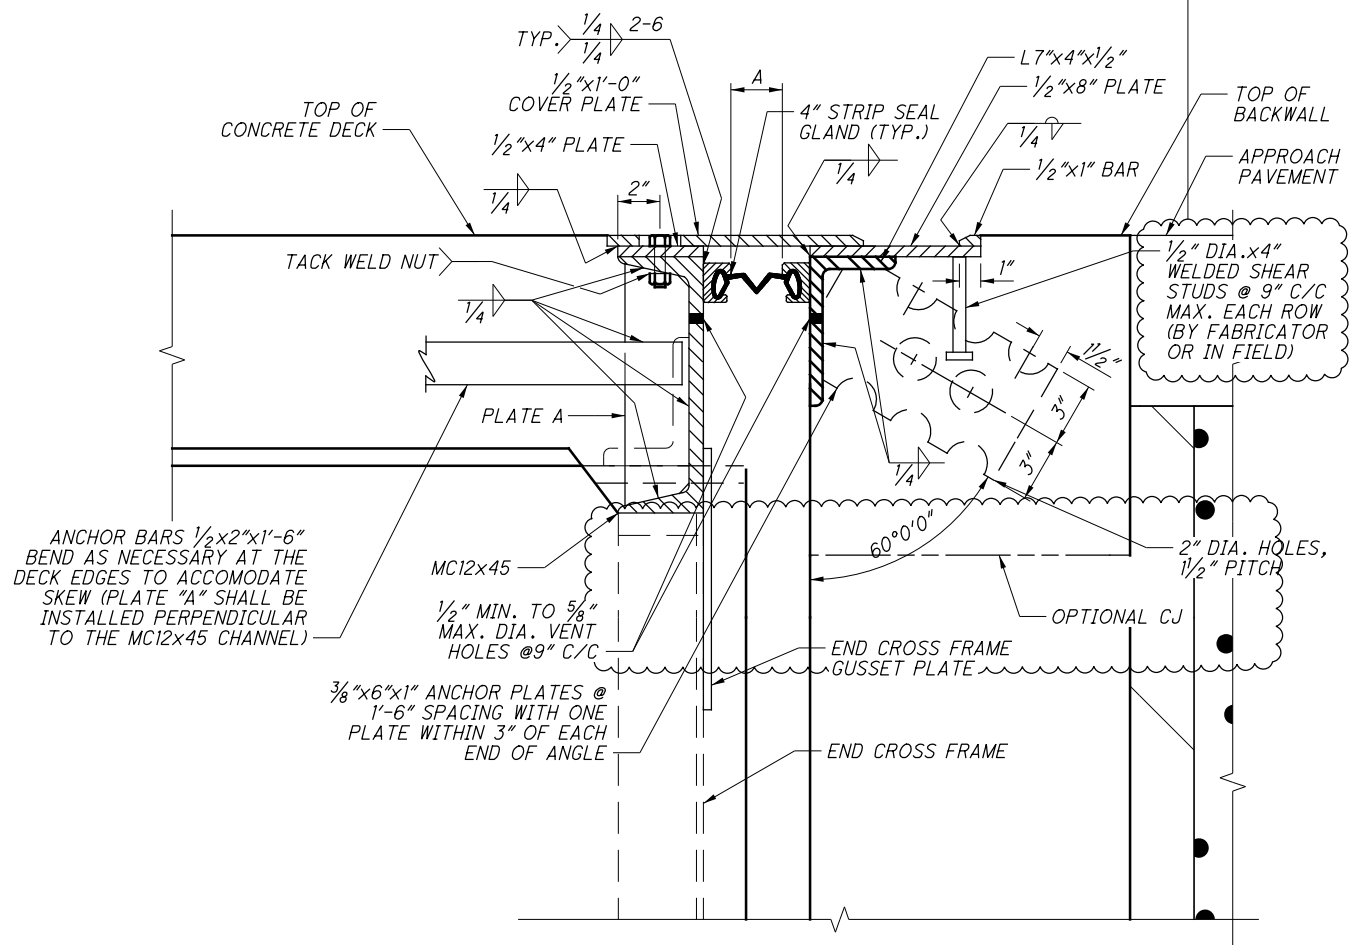


EXPANSION JOINT DETAIL

REAR ABUTMENT SHOWN (FORWARD SIMILAR)

GG SECTION
32


1	2024-09-10	RECORD DRAWINGS
0	2019-09-30	RFC
NO.	DATE	DESCRIPTION
ISSUE RECORD		

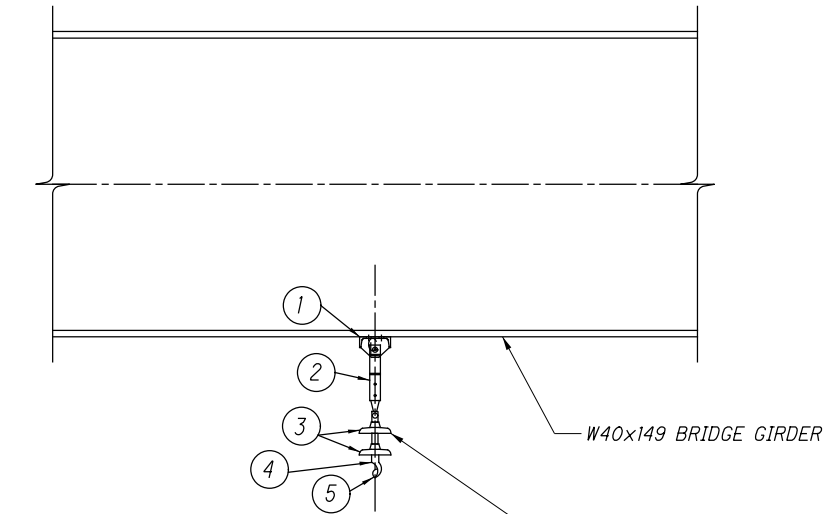


BSC-1
BEAM SLIDING CONNECTION
(2 REQUIRED - B1 & B3)

ALTERNATIVE HANGER ASSEMBLY
APPROVED BY RTA AND USED IN THE
FIELD. NO SHOP DRAWINGS AVAILABLE.

BEAM SLIDING CONNECITON			
ITEM	DESCRIPTION	PART NO.	QTY.
1	BEAM SLIDING CONNECTION, BSC-1	-	1
2	O.B. TWISTED LINK, FIGURE 8	79668	1
3	O.B. SUSPENSION INSULATOR, CLEVIS TYPE HIGH IMPACT (5000# WORKING LOAD)	47033	2
4	O.B. MESSENGER SUSPENSION CLAMP	83106	1
5	MESSENGER CABLE	-	-

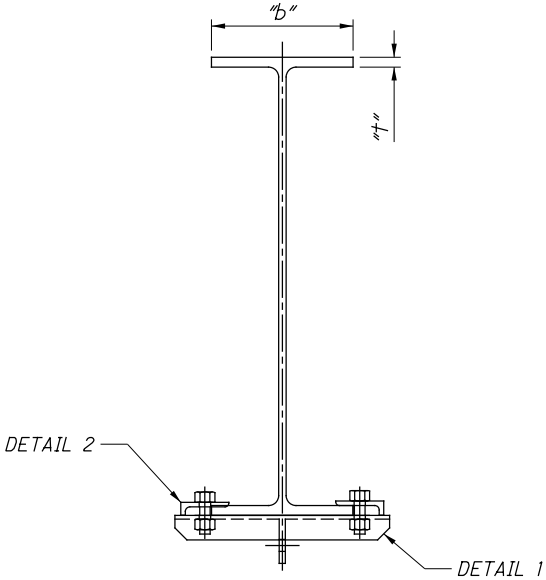


DETAIL BSC-1
(BEAM SLIDING CONNECTION)
SCALE: 1/2"=1'-0"

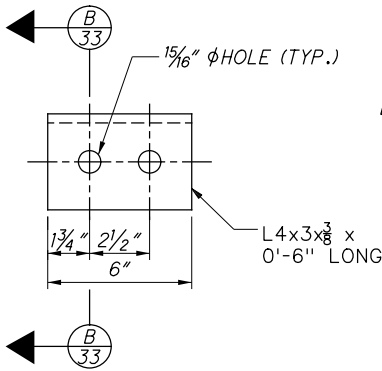


DETAIL 2
SCALE: 3"=1'-0"


BSC-1 DIMENSION SCHEDULE				
BEAM SIZE	"b"	"B"	"t"	"H"
W40X149	11 3/4"	1'-0 7/8"	13/16"	13/16"

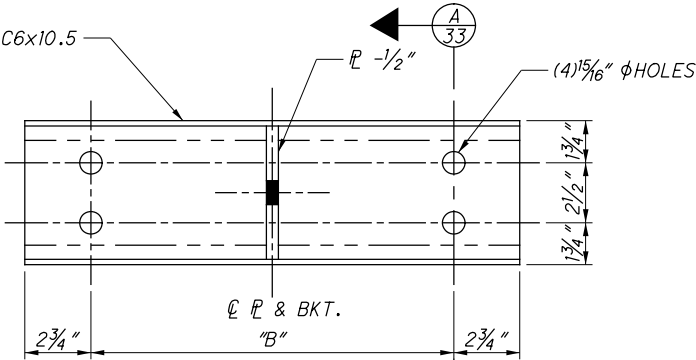

DETAIL 1
SCALE: 3"=1'-0"

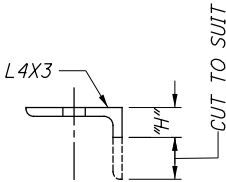

SECTION B
SCALE: 3"=1'-0"

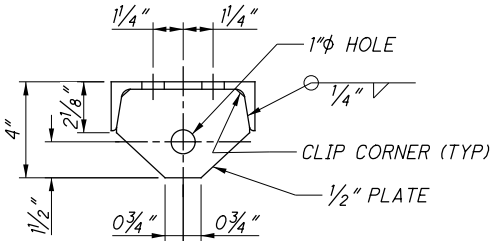


SECTION A
SCALE: 3"=1'-0"
CONNECTION PLATE


NOTE:

1. REFER TO SHEET 19 / 37 FOR SIGNAL WIRE CONNECTION STATION AND OFFSET.


NO.	DATE	DESCRIPTION
1	2024-09-10	RECORD DRAWINGS
0	2019-09-30	RFC
ISSUE RECORD		

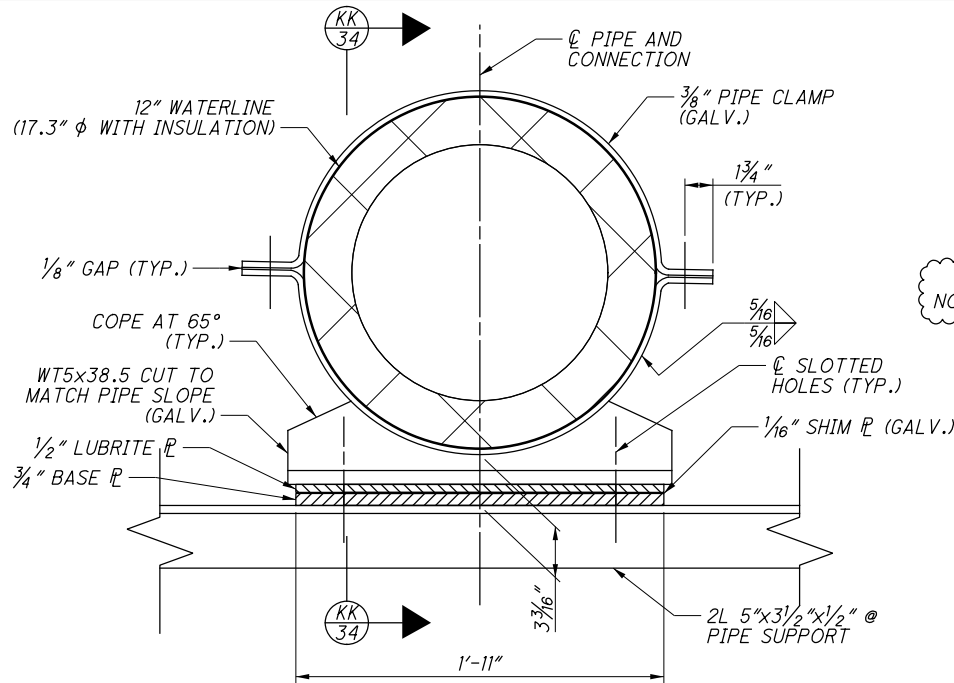

12" WATERLINE (18" ϕ WITH INSULATION)

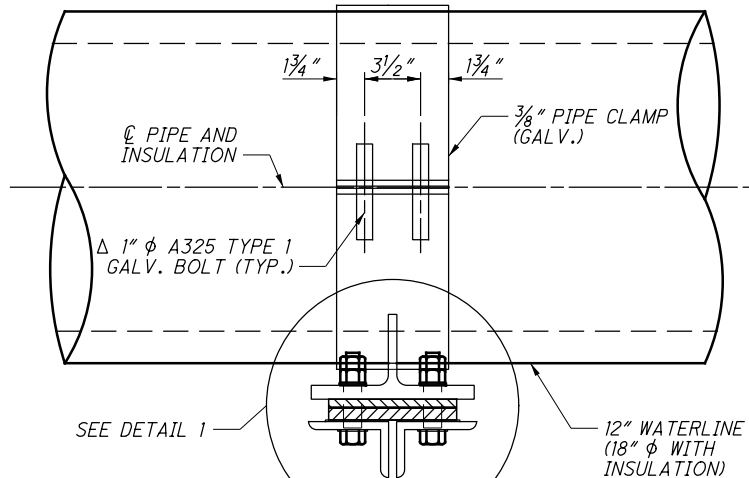


SECTION 34

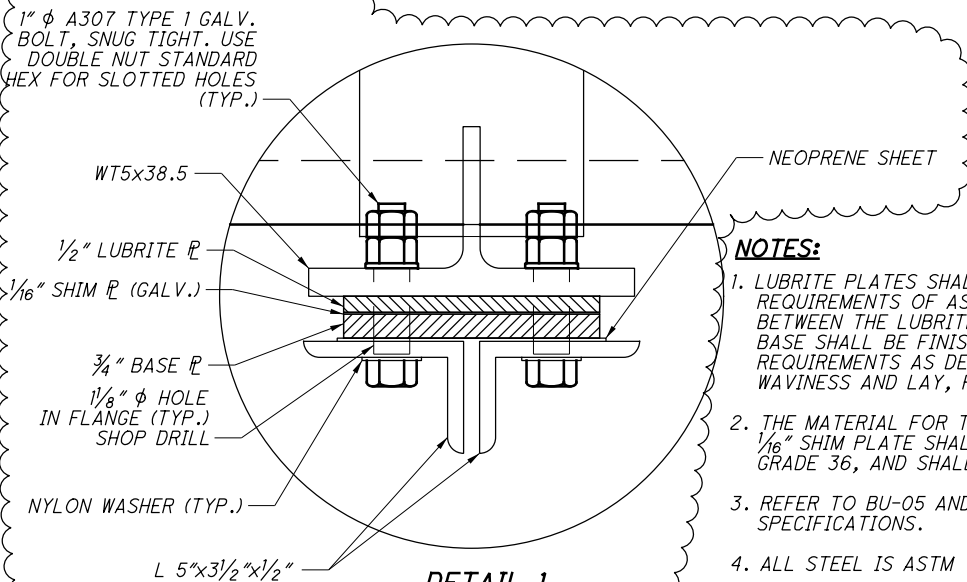


DETAIL 1

NOTES:


- LUBRITE PLATES SHALL BE 1/2" THICK #237 TYPE G1, MEETING THE REQUIREMENTS OF ASTM B22, ALLOY C9100. THE CONTACT SURFACE BETWEEN THE LUBRITE PLATE AND THE WT5x38.5 PIPE SUPPORT BASE SHALL BE FINISHED WITH 125 MICROMETER SURFACE ROUGHNESS REQUIREMENTS AS DEFINED IN ANSI B46.1. SURFACE ROUGHNESS WAVINESS AND LAY, PART 1.
- THE MATERIAL FOR THE 3/8" PIPE CLAMP, PIPE SUPPORT BASE AND 1/16" SHIM PLATE SHALL MEET THE REQUIREMENTS OF ASTM A709, GRADE 36, AND SHALL BE GALVANIZED PER CMS 711.02.
- REFER TO BU-05 AND BU-07 PLANS FOR PIPE INSULATION SPECIFICATIONS.
- ALL STEEL IS ASTM 709, GRADE 50W, UNLESS NOTED OTHERWISE.
- HIGH STRENGTH BOLTS SHALL BE 5/8" DIAMETER, ASTM A325, TYPE III, UNLESS NOTED OTHERWISE.

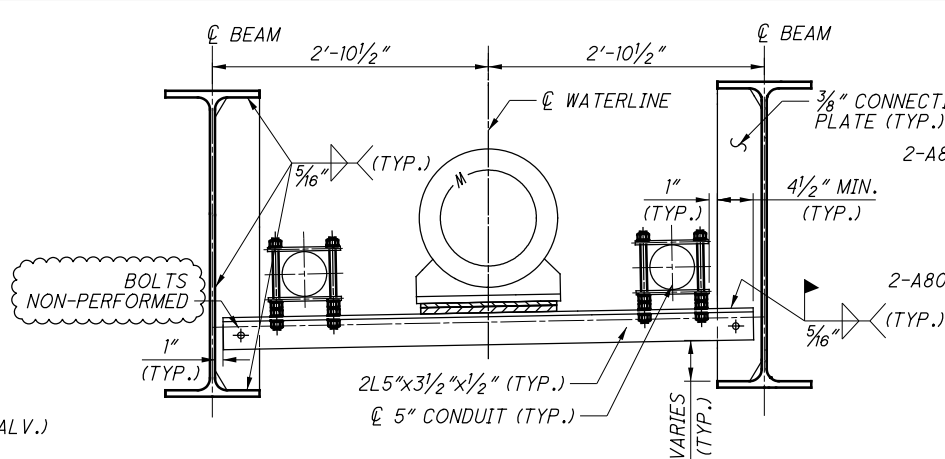


WATERLINE SUPPORT

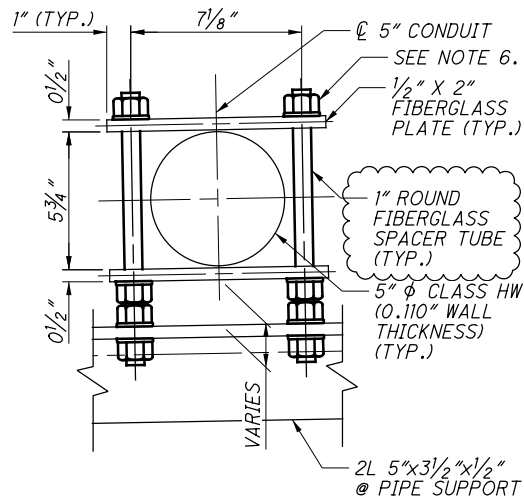


5" ϕ CPP ELECTRIC DUCT
(SEE NOTE 7)

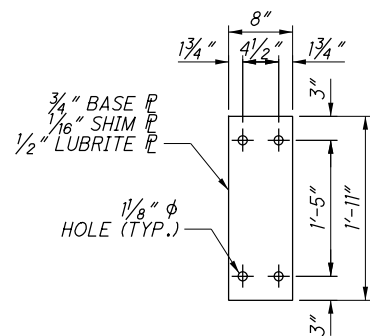


BASE PLATE, LUBRITE PLATE
AND SHIM PLATE
(12" WATERLINE)

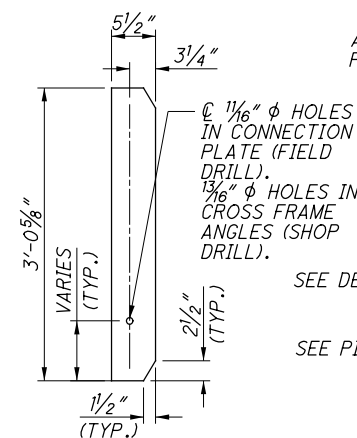

CONNECTION PLATE

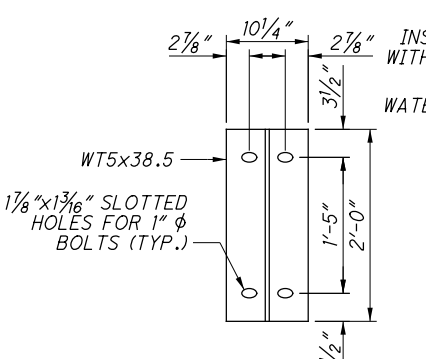


PIPE SUPPORT BASE
(12" WATERLINE)

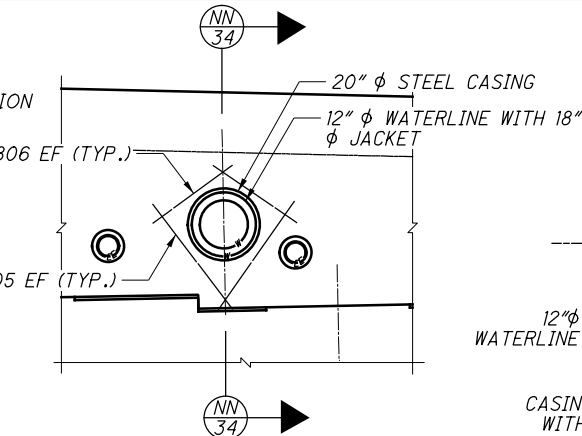

PARTIAL ABUTMENT ELEVATION


BACKWALL REINFORCING NOT SHOWN FOR CLARITY REAR ABUTMENT SHOWN

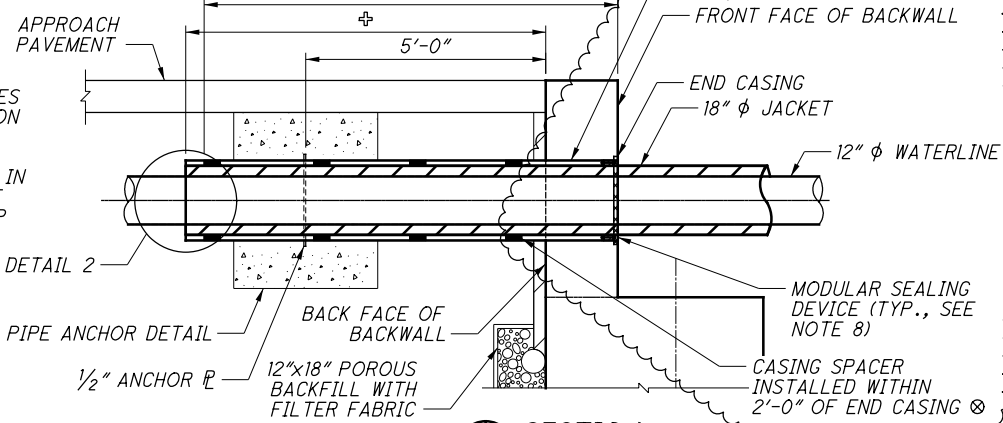

DETAIL 2

WATER MAIN CASING TERMINATION DETAIL

SECTION 34

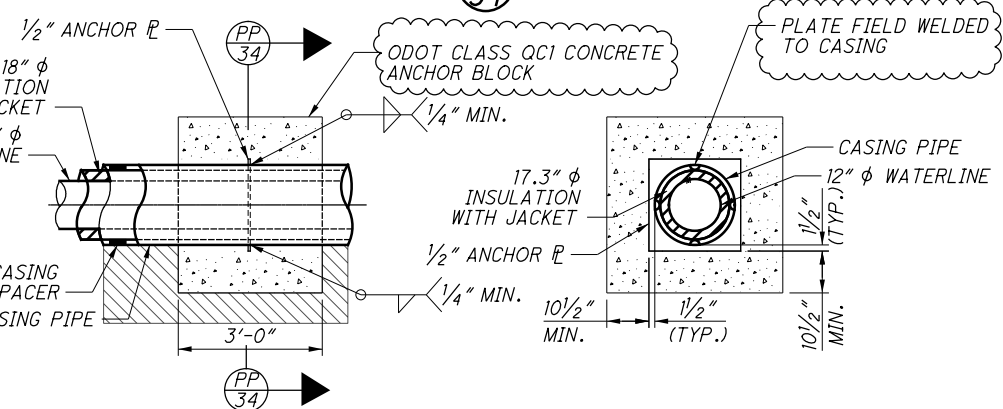

TYPICAL PIPE ANCHOR DETAIL

SECTION 34

LEGEND:

- PIPE CLAMP BOLTS SHALL NOT BE TIGHTENED UNTIL AFTER DECK AND SIDEWALK CONCRETE HAS BEEN PLACED.
- AT REAR ABUTMENT UTILITY CASING SHALL EXTEND FROM BACK FACE OF BACKWALL TO 10'-0" BEYOND THE LIMITS OF THE MSE WALL GRANULAR BACKFILL.
- ANCHOR PLATES ARE 1/2" STEEL CENTERED ON WATERLINE WITH DIMENSIONS 1/2" LARGER HORIZONTAL AND 1/2" LARGER VERTICALLY THAN NOMINAL WATERLINE DIAMETER. CONCRETE ANCHOR BLOCK EXTENDS MINIMUM OF 10 1/2" OUTSIDE ANCHOR PLATE AND IS MINIMUM OF 36" IN LENGTH.
- CASING SPACER SPA. @ 2'-0" THROUGH THE ENTIRE LENGTH OF CASING PIPE.

NO.	DATE	DESCRIPTION
1	2024-09-10	RECORD DRAWINGS
0	2019-09-30	RFC
ISSUE RECORD		

UTILITY DETAILS

CUY-E89ST-4015 (EAST 89TH STREET)

PEDESTRIAN BRIDGE OVER NORFOLK SOUTHERN & GCRTA

CUY-IR490/SR010-2.09/19.28

PID No. 96833

34/37

36/39

DESIGN AGENCY
2475 Sugar Grove Rd., SE Lancaster, Ohio 43130
(740) 687-5542 Phone • (740) 687-0086 Fax

DATE
09/23/19

REVIEWED
MUR

DRAWN
MAK

DESIGNED
MAK

CHECKED
JAH

STRUCTURE FILE NUMBER
TBD

RECORD PLANS

RECORD PLANS

MARK	NUMBER			LENGTH	WEIGHT (LBS)	TYPE	DIMENSIONS						
	REAR	FORWARD	TOTAL				A	B	C	D	E	R	INC.
ABUTMENTS													
A501	10		10	6'-5"	67	2	1'-7"	3'-6"	1'-7"				
A502	20	20	40	7'-11"	330	1	2'-7"	5'-5"					
A503	4		4	15'-3"	64	3	4'-10"	2'-6"					
A504	20	20	40	11'-6"	480	3	3'-0"	2'-6"					
A505		4	4	15'-9"	66	3	5'-1"	2'-6"					
A506		10	10	6'-11"	72	2	1'-7"	4'-0"	1'-7"				
A601	6	12	18	19'-6"	527	STR.							
A602	9	9	18	8'-7"	232	2	4'-0"	0'-11"	4'-0"				
A603	15		15	10'-0"	225	2	4'-0"	3'-10"	2'-6"				
A604	38	38	76	3'-7"	409	STR.							
A605	19		19	13'-10"	395	2	6'-6"	1'-2"	6'-6"				
A606		15	15	15'-1"	340	2	9'-1"	3'-10"	2'-6"				
A607	16	16	32	9'-4"	449	STR.							
A608	1	7	8	18'-7"	223	STR.							
A609	8	28	36	12'-4"	667	STR.							
A610	34	34	68	5'-10"	596	16	5'-2"						
A611	5	5	10	11'-1"	166	STR.							
A612	2	2	4	4'-6"	27	2	1'-5"	2'-0"	1'-5"				
	1	1	2	7'-11"			1'-2"						
A613	SER. OF	SER. OF	SER. OF	TO	98	3	TO	2'-6"					1'-5"
	3	3	3	13'-9"			4'-1"						
A614	8	8	16	5'-2"	124	STR.							
A615	4	4	8	5'-0"	60	STR.							
A616		19	19	24'-0"	685	2	11'-7"	1'-2"	11'-7"				
A617	9	15	24	8'-1"	291	13	3'-10"	0'-4"	0'-4"	3'-10"			
A618	15	15	30	5'-10"	263	2	1'-2"	3'-10"	1'-2"				
A619	18	18	36	5'-11"	320	2	1'-5"	3'-5"	1'-5"				
A620	22		22	4'-0"	132	STR.							
A621		22	22	9'-1"	300	STR.							
A622	8	8	16	8'-9"	210	2	4'-0"	1'-1"	4'-0"				
A623	5	5	10	8'-8"	130	19	4'-10"	3'-2"	2'-2"				
	1	1	2	12'-2"									
A624	SER. OF	SER. OF	SER. OF	TO	157	STR.							7"
	4	4	4	13'-11"									
A625	1	1	2	13'-8"	41	STR.							
A626	5	5	10	8'-6"	128	11	2'-2"	3'-2"	4'-10"				
A801	5	5	10	21'-9"	581	STR.							
A802	8		8	15'-11"	340	STR.							
A803	2	2	4	12'-3"	131	STR.							
A804	4		4	13'-6"	144	STR.							
A805	8	8	16	3'-10"	164	STR.							
A806	8	8	16	2'-2"	93	STR.							
A807	2	2	4	21'-0"	224	STR.							
A808		8	8	16'-7"	354	STR.							
A809		2	2	12'-10"	69	STR.							
A810	2	4	6	13'-11"	223	STR.							
DS1002	32		32	27'-5"	3775	16	26'-0"						
DS1101		48	48	20'-10"	5313	16	19'-3"						
SP402	4		4	339'-6"	907	27	0'-6"	2'-0"	26'-0"				
SP501		4	4	300'-8"	1254	27	0'-6 1/2"	2'-6"	19'-6"				
SP502		4	4	123'-4"	515	27	0'-6 1/2"	2'-6"	7'-3"				
SUBTOTAL ABUTMENTS =					22361								
TOTAL CARRIED TO SHEET 34/35 =					22361								

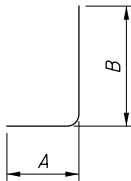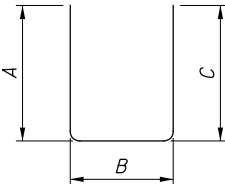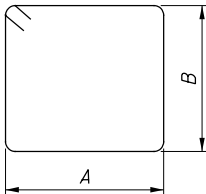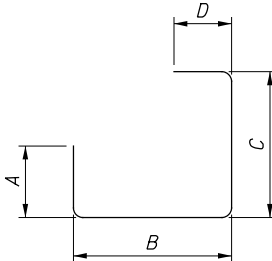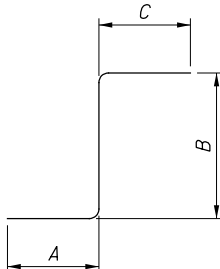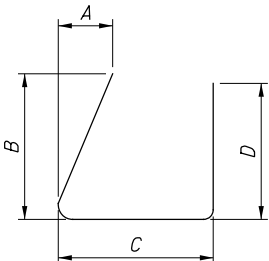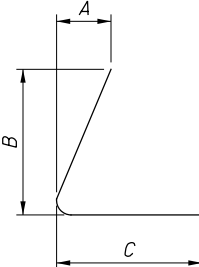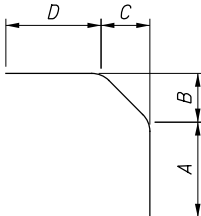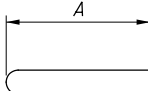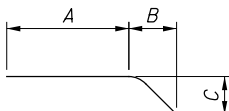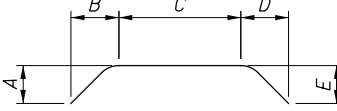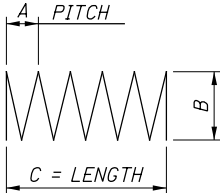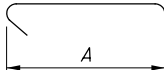BEND DIAGRAMS			
 <u>TYPE-1</u>	 <u>TYPE-2</u>	 <u>TYPE-3</u>	
 <u>TYPE-7</u>	 <u>TYPE-8</u>	 <u>TYPE-9</u>	
 <u>TYPE-11</u>	 <u>TYPE-13</u>	 <u>TYPE-16</u>	
 <u>TYPE-19</u>	 <u>TYPE-20</u>	 <u>TYPE-27</u>	
		 <u>TYPE-41</u>	

NOTES:

1. THE BAR SIZE NUMBER IS SPECIFIED ON THE PLANS IN THE BAR MARK COLUMN. THE FIRST DIGIT WHERE 3 DIGITS ARE USED, AND THE FIRST 2 DIGITS WHERE FOUR DIGITS ARE USED, INDICATES THE BAR SIZE NUMBER. FOR EXAMPLE, W501 IS A NO. 5 BAR AND 01 INDICATES BAR SEQUENCE NUMBER. BAR DIMENSIONS SHOWN ARE OUT UNLESS OTHERWISE INDICATED.
2. ALL REINFORCING STEEL TO BE EPOXY COATED.
3. FOR ABBREVIATIONS LEGEND, SEE SHEET 5/37.

0	2019-09-30	RFC
NO.	DATE	DESCRIPTION
ISSUE RECORD		

DESIGN AGENCY
DLMM, Inc.
2475 Sugar Grove Rd., SE Lancaster, Ohio 43130
(740) 687-5542 Phone • (740) 687-0086 Fax

DATE
09/23/19
REVIEWED
MUR
DRAWN
JBM
DESIGNED
JBM
CHECKED
JAH

STRUCTURE FILE NUMBER
TBD

REINFORCING STEEL LIST
CUY-E89ST-4015 (EAST 89TH STREET)
PEDESTRIAN BRIDGE OVER NORFOLK SOUTHERN & GCRTA

CUY-IR490/SR010-
2.09 / 19.28
PID No. 96833

35 / 37

37
39

RECORD PLANS

MARK	NUMBER			LENGTH	WEIGHT	TYPE	DIMENSIONS						
	REAR	FORWARD	TOTAL		(LBS)		A	B	C	D	E	R	INC.
SUPERSTRUCTURE													
S401			185	30'-0"	3708	STR.							
S402			17	9'-0"	103	STR.							
S403			16	21'-7"	231	STR.							
S404			16	17'-7"	188	STR.							
S501			171	30'-0"	5351	STR.							
S502			19	14'-4"	285	STR.							
S503			490	17'-6"	8944	17	16'-4"						
			2	3'-10"			3'-3"						
S504			SER. OF	TO	965	16	TO						0'-8 3/4"
			18	16'-3"			15'-7 3/4"						
S505			16	3'-4"	56	STR.							
S506			8	19'-11"	167	STR.							
S507			502	7'-11"	4146	16	7'-4"						
			2	3'-7"			3'-0"						
S508			SER. OF	TO	81	16							2'-10"
			3	6'-5"			5'-10"						
			2	3'-3"									
S509			SER. OF	TO	910	STR.							0'-8 3/4"
			18	15'-8"									
S510			16	4'-9"	80	STR.							
S511			490	16'-4"	8348	STR.							
SUBTOTAL SUPERSTRUCTURE =					33563								
MARK	NUMBER			LENGTH	WEIGHT	TYPE	DIMENSIONS						
	PIER 1	PIER 2	TOTAL		(LBS)		A	B	C	D	E	R	INC.
PIERS													
P301	62	62	124	3'-7"	168	41	2'-6"						
P501	6	6	12	17'-8"	222	STR.							
P502	2	2	4	14'-7"	61	STR.							
P503	23	23	46	28'-7"	1372	3	11'-6"	2'-6"					
P504	31	19	54	9'-9"	550	2	3'-8"	2'-8"	3'-8"				
P505	13	13	26	11'-11"	324	2	4'-9"	2'-8"	4'-9"				
	2	2	4	9'-9"			3'-8"		3'-8"				
P506			SER. OF	TO	534	2	TO	2'-8"	TO				0'-7"
	3	3	3	10'-11"			4'-3"		4'-3"				
P801	4	4	8	20'-5"	437	2	1'-7"	17'-8"	1'-7"				
P802	3	3	6	15'-0"	241	STR.							
P803	4	4	8	19'-3"	412	20	2'-0"	3'-1"	11'-11"	3'-1"	2'-0"		
P1001	38	38	76	24'-3"	7931	STR.							
DS1001	16	16	32	15'-3"	2100	STR.							
SP401	2	2	4	132'-4"	354	27	0'-6"	2'-0"	9'-0"				
SUBTOTAL PIERS =					14706								
SHEET TOTAL =					48269								
TOTAL CARRIED FROM SHEET 33/35 =					22361								
TOTAL CARRIED TO SHEET 35/35 =					70630								

NOTES:

1.

THE BAR SIZE NUMBER IS SPECIFIED ON THE PLANS IN THE BAR MARK COLUMN. THE FIRST DIGIT WHERE 3 DIGITS ARE USED, AND THE FIRST 2 DIGITS WHERE FOUR DIGITS ARE USED, INDICATES THE BAR SIZE NUMBER. FOR EXAMPLE, W501 IS A NO. 5 BAR AND 01 INDICATES BAR SEQUENCE NUMBER. BAR DIMENSIONS SHOWN ARE OUT UNLESS OTHERWISE INDICATED.
2.

ALL REINFORCING STEEL TO BE EPOXY COATED.
3.

FOR ABBREVIATIONS LEGEND, SEE SHEET 5/37.
4.

FOR BEND DIAGRAMS, SEE SHEET 35/37.

0	2019-09-30	RFC
NO.	DATE	DESCRIPTION
ISSUE RECORD		

DESIGN AGENCY
DUMIN, Inc.
2475 Sugar Grove Rd., SE Lancaster, Ohio 43130
(740) 687-5542 Phone • (740) 687-0086 Fax

REVIEWED
MUR
DATE
07/23/19
STRUCTURE FILE NUMBER
TBD

DRAWN
MAK
MAK
REVISID

DESIGNED
MAK
CHECKED
JAH

REINFORCING STEEL LIST
CUY-E89ST-4015 (EAST 89TH STREET)
PEDESTRIAN BRIDGE OVER NORFOLK SOUTHERN & GCRTA

CUY-IR490/SR010-
2.09/19.28
PID No. 96833

36/37

38
39

RECORD PLANS

RECORD PLANS

MARK	NUMBER			LENGTH	WEIGHT	TYPE	DIMENSIONS						
	REAR	FORWARD	TOTAL		(LBS)		A	B	C	D	E	R	INC.
WALLS													
W401			4	5'-2"	14	STR.							
W402			10	5'-0"	34	STR.							
W403			14	3'-9"	36	STR.							
W404			10	9'-3"	62	STR.							
W501			4	6'-5"	27	STR.							
W502			10	6'-2"	65	STR.							
W503			90	2'-4"	220	1	1'-1"	1'-4"					
			1	1'-2"									
W504			SER. OF	TO	145	STR.							2 1/8"
			34	7'-0"									
SUBTOTAL WALLS =					603								
MARK	NUMBER			LENGTH	WEIGHT	TYPE	DIMENSIONS						
	REAR	FORWARD	TOTAL		(LBS)		A	B	C	D	E	R	INC.
RAILINGS													
R501			72	30'-0"	2253	STR.							
R502			8	7'-7"	64	STR.							
R503			112	9'-8"	1130	STR.							
R504			152	4'-8"	740	STR.							
R505			6	6'-3"	40	STR.							
R506			2	6'-11"	15	STR.							
R507			2	11'-11"	25	STR.							
R508			1168	3'-4"	4061	1	0'-9"	2'-8"					
R509			584	4'-6"	2742	1	1'-6"	3'-1"					
R510			584	4'-8"	2843	1	1'-6"	3'-3"					
R511			2	11'-8"	25	STR.							
R512			2	12'-3"	26	STR.							
R513			4	3'-9"	16	STR.							
R514			4	3'-1"	13	STR.							
R515			4	10'-2"	43	STR.							
R516			8	9'-7"	80	STR.							
R517			4	9'-5"	40	STR.							
R518			4	10'-0"	42	STR.							
R519			94	5'-11"	581	1	0'-9"	5'-3"					
R520			4	10'-3"	43	STR.							
R521			4	10'-5"	44	STR.							
R522			4	9'-10"	42	STR.							
R523			2	12'-6"	27	STR.							
SUBTOTAL RAILINGS =					14935								
MARK	NUMBER			LENGTH	WEIGHT	TYPE	DIMENSIONS						
	REAR	FORWARD	TOTAL		(LBS)		A	B	C	D	E	R	INC.
PYLONS													
R401			40	3'-0"	81	STR.							
R402			120	3'-8"	294	STR.							
R403			32	1'-5"	31	1	0'-9"	0'-9"					
R404			32	3'-1"	66	8	0'-10 1/2"	0'-4"	2'-0"				
R405			88	5'-2"	304	7	0'-4"	0'-9"	3'-8"	0'-8"			
R406			512	4'-6"	1540	2	0'-6"	3'-8"	0'-6"				
R407			44	1'-11"	57	7	0'-4"	0'-9"	0'-9"	0'-4"			
R408			176	10'-2"	1196	STR.							
R409			8	7'-8"	41	STR.							
R410			8	7'-11"	43	STR.							
R411			8	13'-0"	70	STR.							
R412			8	12'-6"	67	STR.							
R413			40	8'-8"	232	STR.							
R414			40	9'-0"	241	STR.							
R415			40	14'-0"	375	STR.							
R416			40	13'-6"	361	STR.							
SUBTOTAL PYLONS =					4999								
SHEET TOTAL =					20537								
TOTAL CARRIED FROM SHEET 34/35 =					70630								
TOTAL =					91167								

* - DOWEL BAR

NOTES:

1. THE BAR SIZE NUMBER IS SPECIFIED ON THE PLANS IN THE BAR MARK COLUMN. THE FIRST DIGIT WHERE 3 DIGITS ARE USED, AND THE FIRST 2 DIGITS WHERE FOUR DIGITS ARE USED, INDICATES THE BAR SIZE NUMBER. FOR EXAMPLE, W501 IS A NO. 5 BAR AND 01 INDICATES BAR SEQUENCE NUMBER. BAR DIMENSIONS SHOWN ARE OUT UNLESS OTHERWISE INDICATED.
2. ALL REINFORCING STEEL TO BE EPOXY COATED.
3. FOR ABBREVIATIONS LEGEND, SEE SHEET 5/37.
4. FOR BEND DIAGRAMS, SEE SHEET 35/37.

0	2019-09-30	RFC
NO.	DATE	DESCRIPTION
ISSUE RECORD		

CUY-IR490/SR010-2.09/19.28
PID No. 96833

REINFORCING STEEL LIST
CUY-E89ST-4015 (EAST 89TH STREET)
PEDESTRIAN BRIDGE OVER NORFOLK SOUTHERN & GCRTA

DESIGNED
JBM
CHECKED
JAH

DRAWN
MAK
REVISED

REVIEWED
MUR
STRUCTURE FILE NUMBER
TBD

DATE
09/23/19

DESIGN AGENCY
DLMN, Inc.
2475 Sugar Grove Rd., SE Lancaster, Ohio 43130
(740) 687-5542 Phone - (740) 687-0086 Fax

RECORD PLANS

RECORD PLANS

37/37

39/39




DESIGN SUBMITTAL FOR

CUY-IR490/SR010-2.09/19.28

SHEET INDEX		
SHEET NO.	DRAWING NAME	
1	COVER SHEET	
2	GENERAL NOTES	
3	MSE PLAN & ELEVATION VIEW	
3A	STRIP SKEW PLAN VIEW	
4-5	TYPICAL MSE SECTION(S) & DETAILS	
6	STANDARD PANEL DETAILS	
6A	ANGLE DETAILS	


REAR ABUTMENT MSE WALL AT

EAST 89TH ST.

	12/23/20	REVISED PER ODOT COMMENT
	10/15/20	REVISED PER ODOT COMMENT
	6/4/20	REVISED PER 2LMN COMMENT

This drawing contains information proprietary to The Reinforced Earth Company, and is being furnished for the use of The Ohio Department of Transportation only in connection with this project, and the information contained is not to be transmitted to any other organization unless specifically authorized in writing by The Reinforced Earth Company. The Reinforced Earth Company is the exclusive licensee in the United States under patents held by our affiliated companies, and the furnishing of this drawing does not constitute an expressed or implied license under any applicable patents.

The design contained on these drawings is based on information provided by the Owner. On the basis of this information, The Reinforced Earth Company has designed, and is responsible for the internal stability of the structure only. External stability, including foundation (bearing capacity and settlement) and global stability (including sliding and rotation), is the responsibility of the Owner.

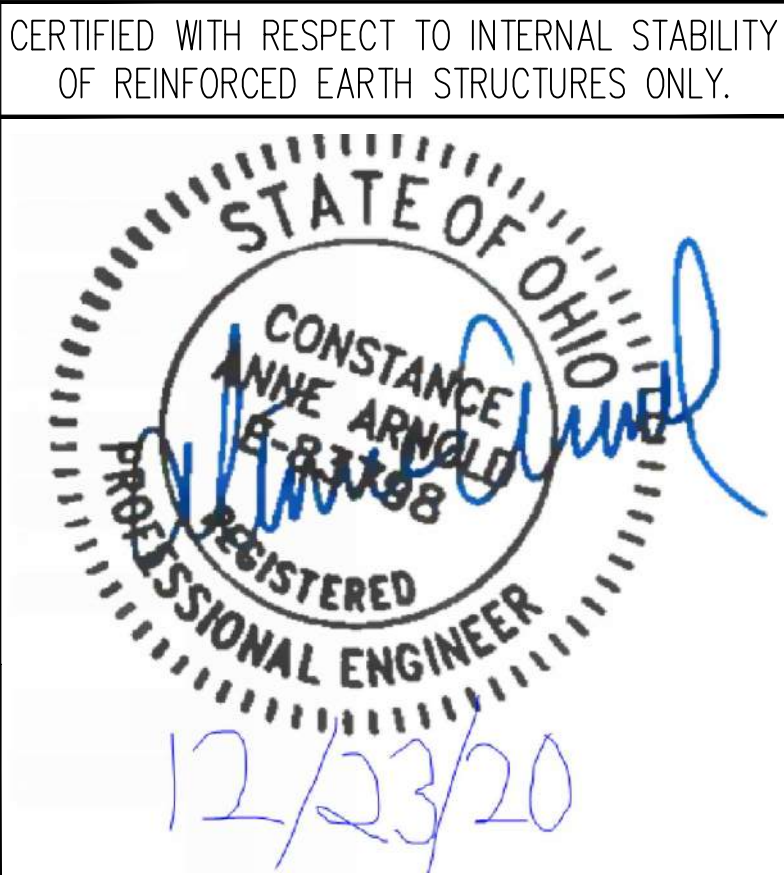

GENERAL NOTES:

DESIGN CRITERIA:

1. DESIGN IS BASED ON THE PARAMETERS BELOW, AND THE ASSUMPTION THAT THE FOUNDATION AND BACKFILL MATERIALS, METHODS OF CONSTRUCTION AND MATERIALS INSTALLED SHALL CONFORM TO THE APPLICABLE PROJECT TECHNICAL SPECIFICATIONS FOR M.S.E. WALLS.
2. CONTRACT DOCUMENT REFERENCE:
THE M.S.E. WALLS SHOWN IN THESE PLANS WERE DESIGNED AND DETAILED PER INFORMATION REFERENCED IN THE FOLLOWING CONTRACT DOCUMENTS:
- CONTRACT PLANS: RFC PLANS DATED 09/30/2019, SHT's 1 TO 39
 - AASHTO SPECIFICATIONS: LRFD BRIDGE DESIGN SPECIFICATIONS, 7TH EDITION, (INCLUDING 2015 INTERIMS)
 - DOT SPECIFIED DOCUMENTS: ODOT BRIDGE DESIGN MANUAL, 2007.
 - SS840 DATED 4/15/2016
3. SOIL DESIGN PARAMETERS:(TO BE VERIFIED BY GEOTECHNICAL ENGINEER OF RECORD)

SELECT GRANULAR BACKFILL (REINFORCED SOIL ZONE):
φ = 34 degrees (MINIMUM), c = 0 p.s.f., γ = 120 p.c.f.

RETAINED BACKFILL (COMPACTED EMBANKMENT FILL / IN SITU MATERIAL BEYOND SOIL REINFORCEMENT LIMITS):
φ = 30 degrees, c = 0 p.s.f., γ = 120 p.c.f.

FOUNDATION MATERIAL:
φ = 30 degrees, c = 0 p.s.f.

IF THE TESTED UNIT WEIGHT (γ) FOR THE SELECT MATERIAL VARIES (+ OR -) BY MORE THAN 10% FROM THE VALUE INDICATED ABOVE, THE CONTRACTOR SHALL CONTACT RECo AND THE GEOTECHNICAL ENGINEER OF RECORD TO ASSESS ANY POTENTIAL CHANGES TO THE MSE WALL DESIGN.

IF THE SHEAR STRENGTH (φ), Cohesion (c) or COEFFICIENT OF SLIDING (μ) FOR THE FOUNDATION MATERIAL IS LESS THAN THE VALUES INDICATED ABOVE, THE CONTRACTOR SHALL CONTACT THE GEOTECHNICAL ENGINEER OF RECORD TO DETERMINE IF FOUNDATION IMPROVEMENT IS REQUIRED, AND CONTACT RECo TO ASSESS ANY POTENTIAL CHANGES TO THE MSE WALL DESIGN.

IF THE TESTED UNIT WEIGHT (γ) FOR THE RETAINED MATERIAL IS HEAVIER BY MORE THAN 10% FROM THE VALUE INDICATED ABOVE, THE CONTRACTOR SHALL CONTACT RECo AND THE GEOTECHNICAL ENGINEER TO ASSESS ANY POTENTIAL CHANGES TO THE MSE WALL DESIGN. IF THE SHEAR STRENGTH (φ) FOR THE RETAINED MATERIAL IS LESS THAN THE VALUE INDICATED ABOVE, THE CONTRACTOR SHALL CONTACT RECo AND THE GEOTECHNICAL ENGINEER OF RECORD TO ASSESS ANY POTENTIAL CHANGES TO THE MSE WALL DESIGN.

4. DESIGN VEHICULAR SURCHARGE LOADING (IN ACCORDANCE WITH PROJECT SPECIFICATIONS)
HS-20/HL-93 TRUCK = 250 PSF EQUIVALENT DESIGN SURCHARGE

NOTE: THE DESIGN DOES NOT INCLUDE HEAVY TRUCK, EXCAVATOR OR CRANE LOADS (EQUIPMENT WITH A GROSS OPERATING WEIGHT GREATER THAN 72,000 LBS). COMPACTION EQUIPMENT SHALL BE SIZED BY THE CONTRACTOR WITH CONSIDERATION OF NECESSARY OFFSETS TO WALL FACING, BACKFILL TYPE AND LIFT THICKNESS (TYPICAL ROLLER STATIC WEIGHT: 8 TO 15 TON – DEPENDING ON APPLICATION). CONTRACTOR TO COORDINATE ANY HEAVY EQUIPMENT LOADING WITH RECo PRIOR TO FABRICATION OF WALL MATERIALS. ALL COSTS DUE TO LOADING IN EXCESS OF SPECIFICATIONS SHALL BE BORNE BY CONTRACTOR.

DESIGN LIFE: THE M.S.E. WALL HAS BEEN DESIGNED FOR A 100 YEAR SERVICE LIFE IN ACCORDANCE WITH PROJECT SPECIFICATIONS.

FOUNDATION PREPARATION:

5. THE CALCULATED MAXIMUM APPLIED BEARING PRESSURE AT THE FOUNDATION LEVEL IS SHOWN ON THE WALL ELEVATIONS FOR EACH DESIGN CASE. IT IS THE RESPONSIBILITY OF THE GEOTECH TO DETERMINE IF THE FOUNDATION SOILS HAVE ADEQUATE STRENGTH TO RESIST THE APPLIED DESIGNED BEARING PRESSURES.
- M.S.E. WALL SUB-GRADE (ENTIRE FOOTPRINT = 2.0' IN FRONT OF WALL ALIGNMENT TO 2.0' BEYOND THE END OF THE DESIGNED LENGTH OF SOIL REINFORCEMENT AND ALONG THE ENTIRE LENGTH), SHOULD BE PROOF ROLLED WITH A HEAVY ROLLER, OR OTHERWISE EVALUATED IN ACCORDANCE WITH THE RECOMMENDATIONS OF THE GEOTECH. ANY UNSUITABLE FOUNDATION MATERIAL BELOW THE REINFORCED EARTH VOLUME, AS DETERMINED BY THE GEOTECH, SHALL BE EXCAVATED AND REPLACED WITH SUITABLE MATERIAL (PLACED IN CONTROLLED, COMPACTED LIFTS) OR OTHERWISE STABILIZED AS DIRECTED BY THE GEOTECH.

SOIL REINFORCEMENT NOTES:

6. SOIL REINFORCEMENT MAY BE ONE OR MORE OF THE FOLLOWING AS DESIGNED AND SUPPLIED BY RECo.

- HIGH ADHERENCE "HA" STEEL STRIPS SHALL BE RIBBED, 50mm WIDE BY 4mm THICK AND COMPLY WITH THE FOLLOWING SPECIFIED REQUIREMENTS DEFINED WITHIN ASTM A6/A6M-07 "GENERAL REQUIREMENTS", AND ASTM A572/A572M, GRADE 65, TYPE 1, 2, OR 3.
- HA STEEL STRIPS SHALL BE HOT-DIP GALVANIZED AFTER FABRICATION HAS BEEN COMPLETED. GALVANIZATION SHALL CONFORM TO THE MINIMUM REQUIREMENTS DEFINED WITHIN ASTM A123/A123M, SECTION 6.1, TABLE 2, COATING GRADE 85. (2 oz/sf).

WALL CONSTRUCTION:

7. FOR GENERAL INFORMATION PERTAINING TO WALL CONSTRUCTION PLEASE REFER TO THE "CONSTRUCTION AND QUALITY CONTROL PROCEDURE MANUAL" FOR RECTANGULAR PANELS AVAILABLE ONLINE AT www.reinforcedearth.com

8. REINFORCED EARTH WALLS ALIGNED ALONG CURVES WILL FORM A SERIES OF SHORT CHORDS 9.84' EACH TO MATCH THE DESIRED WALL ALIGNMENT.
9. FOR LOCATION OF REINFORCED EARTH WALLS SEE CONTRACTS AND RECo PLAN VIEW (DRAWING 3 OF THESE PLANS).
10. BACKFILL MATERIAL SHALL BE PLACED AND COMPACTED IN LIFTS (NO THICKER THAN 8" LOOSE LIFTS) AND IN ACCORDANCE WITH THE SPECIFICATIONS COVERING MSE WALLS, TO A LEVEL OF 2"(±) ABOVE THE LEVEL OF THE STRIPS EMBEDDED AND PROTRUDING FROM THE REAR FACE OF THE PRECAST CONCRETE WALL FACING PANELS. INSTALLATION OF THE REINFORCING STRIPS SHALL BE PERMITTED ONLY AFTER PLACEMENT AND COMPACTION OF THE BACKFILL MATERIAL HAS REACHED THE REQUIRED LEVEL. WHERE THE PROJECT OR DEPARTMENT COMPACTION REQUIREMENTS ARE STRICTER (I.E. 98% DENSITY REQUIREMENT, 8" LOOSE LIFTS) THE STRICTER REQUIREMENT WILL BE USED.
11. M.S.E. SELECT BACKFILL SHALL BE COMPACTED IN ACCORDANCE WITH THE PROJECT SPECIFICATIONS, AS A MINIMUM: M.S.E. SELECT FILL SHALL BE COMPACTED TO 95% STANDARD PROCTOR (ASTM D-698 OR AASHTO T-99, WITH OVERSIZE CORRECTION) AT A MOISTURE CONTENT 1% TO 2% BELOW OPTIMUM MOISTURE CONTENT. IF 30% OR MORE OF THE SELECT GRANULAR BACKFILL IS GREATER THAN ¾" IN SIZE, ASTM D-698/AASHTO T-99 IS NOT APPLICABLE. FOR SUCH A MATERIAL, THE ACCEPTANCE CRITERION FOR CONTROL OF COMPACTION SHALL BE EITHER A MINIMUM OF 70% OF THE RELATIVE DENSITY OF THE MATERIAL AS DETERMINED BY ASTM D-4253 AND D-4254, OR A METHOD SPECIFICATION, BASED ON A TEST COMPACTION SECTION WHICH DEFINES THE TYPE OF EQUIPMENT, LIFT THICKNESS NUMBER OF PASSES OF THE SPECIFIED EQUIPMENT, AND PLACEMENT MOISTURE CONTENT. WHERE THE DEPARTMENT'S COMPACTION REQUIREMENTS ARE MORE STRICT, THAT DEPARTMENT'S REQUIREMENTS SHALL BE USED IN GENERAL.
12. HEAVY COMPACTION AND OPERATION EQUIPMENT SHALL BE KEPT A MINIMUM DISTANCE OF 3'-0" FROM THE BACK FACE OF THE PRECAST CONCRETE WALL FACING PANELS. COMPACTION WITHIN THE 3'-0" ZONE SHALL BE ACHIEVED WITH AT LEAST SIX (6) PASSES OF A LIGHTWEIGHT MECHANICAL TAMPER, ROLLER OR VIBRATORY SYSTEM (LESS THAN 1,000 LBS.), SMALLER LIFTS MAY BE REQUIRED TO ACHIEVE ADEQUATE COMPACTION (GENERALLY REGARDED AS 90% STANDARD PROCTOR FOR THIS ZONE). COMPACTION DENSITY TESTS ARE NOT REQUIRED WITHIN SAID 3 FT. ZONE, EXCEPT WHERE REQUIRED BY PROJECT SPECIAL PROVISIONS AND IF STRUCTURAL FOOTINGS ARE TO BE PLACED ATOP THE MSE WALL WITHIN THE 3 FT ZONE.
13. THE FINISHED GRADE BACKFILL IN FRONT OF THE WALL SHALL BE PLACED AND COMPACTED AS SOON AS POSSIBLE (AS CONSTRUCTION SEQUENCE PERMITS TO ALLOW FOR BOTTOM PANELS TO MOVE TOWARDS A PLUMB POSITION) TO MITIGATE THE POTENTIAL FOR EROSION AND UNDERMINING OF THE CONCRETE LEVELING PAD. IN ANY EVENT, BACKFILL IN FRONT OF THE WALL SHALL BE PLACED AND COMPACTED BEFORE WALL CONSTRUCTION EXCEEDS A HEIGHT OF 20 FT. FINISHED GRADE BACKFILL SHALL BE PLACED IN LIFTS AND PROPERLY COMPACTED AS REQUIRED BY PROJECT SPECIFICATIONS.
14. FOR MANHOLES, DRAIN PIPES, DROP INLETS AND/OR OTHER UTILITIES LOCATED WITHIN THE MSE VOLUME, WHERE REINFORCING STRIPS ARE BLOCKED FROM BEING PLACED NORMALLY, REINFORCING STRIPS MAY BE SKEWED UP TO THE MAXIMUM OF 15' TO AVOID THE OBSTRUCTION. IF SPECIFIC DETAILS HAVE NOT BEEN INCLUDED ADDRESSING AN OBSTRUCTION, AND THE ANGLE OF THE NECESSARY SKEW TO CLEAR THE OBSTRUCTION IS GREATER THAN 15', THE CONTRACTOR SHALL CONTACT RECo FOR APPROPRIATE DETAIL TO ACCOMMODATE THE OBSTRUCTION.
15. IF PILES ARE TO BE LOCATED WITHIN THE MSE VOLUME, THEY SHALL BE ALIGNED AND DRIVEN PRIOR TO THE CONSTRUCTION OF THE MSE STRUCTURE. UNLESS A METHOD TO PROTECT THE MSE STRUCTURE AND ALL NECESSARY ELEMENTS HAS BEEN DEVISED BY THE CONTRACTOR AND FOUND ACCEPTABLE TO THE GEOTECH AND/OR ON-SITE ENGINEER, AND RECo.
16. STRUCTURAL FOUNDATIONS, DRAINAGE ELEMENTS, SLABS, AND/OR LOADINGS PROPOSED ATOP THE MSE COMPACTED MASS SHALL BE CONSTRUCTED ONLY AFTER THE GEOTECH HAS DETERMINED THAT SUFFICIENT SETTLEMENT OF THE M.S.E. STRUCTURE AND EMBANKMENT HAS TAKEN PLACE TO ADEQUATELY SUPPORT THE SUPERIMPOSED ELEMENTS AND/OR LOADINGS.
17. IT IS THE CONTRACTOR'S RESPONSIBILITY TO DETERMINE THE LOCATION OF ANY GUARDRAIL, FENCE AND/OR LIGHT POSTS (ETC.) BEHIND THE RECo WALL PANELS. PRIOR TO THE PLACEMENT OF THE TOP LAYER(S) OF SOIL REINFORCEMENT STRIPS, INDIVIDUAL STRIPS MAY BE SKEWED TO AVOID THE PROPOSED VERTICAL OBSTRUCTIONS IF AUTHORIZED BY RECo. ANY DAMAGE DONE TO THE SOIL REINFORCEMENT STRIPS DUE TO THE INSTALLATION OF THE VERTICAL OBSTRUCTIONS SHALL BE REPAIRED OR REPLACED BY THE CONTRACTOR, AND AT THE CONTRACTOR'S EXPENSE.
18. IF EXISTING AND/OR PROPOSED STRUCTURES, PIPES, FOUNDATIONS OR SAFETY GUARDRAIL POST WHICH ARE LOCATED WITHIN THE RECo VOLUME MASS, AND MAY INTERFERE WITH THE NORMAL PLACEMENT OF THE SOIL REINFORCING STRIPS AND SPECIFIC DIRECTION HAS NOT BEEN PROVIDED ON THE PLANS, THE CONTRACTOR SHALL NOTIFY RECo TO OBTAIN NECESSARY DETAILS FOR REINFORCING STRIP PLACEMENT.
19. ALL DESIGN, DETAILING, FABRICATION AND CHECKING OF REQUIRED REINFORCING STEEL FOR ANY C.I.P. CONCRETE WORK IS THE RESPONSIBILITY OF THE CONTRACTOR, UNLESS OTHERWISE STATED AND DETAILED WITHIN THESE PLANS PREPARED BY THE REINFORCED EARTH COMPANY.
20. PRECAST TOP OUT PANELS BENEATH CAST-IN-PLACE COPING, PRECAST COPING AND PRECAST TRAFFIC BARRIER (LEVEL UP CONCRETE) MAY HAVE #4 DOWELS PROTRUDING FROM THE PANELS AS DETAILED IN PANEL CASTING SHOP DRAWINGS. DOWELS SHALL BE FIELD CUT BY CONTRACTOR WHERE PANELS ARE EMBEDDED INTO A CAST IN PLACE MOMENT SLAB OR OTHER FOOTING/SLAB ELEMENT. EXPANSION JOINT MATERIAL, AND/OR BOND BREAKER SHALL BE PLACED BETWEEN EACH SIDE OF FACING PANEL IN CONTACT WITH CAST IN PLACE CONCRETE ELEMENTS (EXCEPT AS SHOWN IN THE PLANS).
21. THE CONTRACTOR IS RESPONSIBLE FOR GRADUALLY DEFLECTING THE UPPER LEVEL OF SOIL REINFORCEMENT STRIPS DOWNWARD TO AVOID CONFLICTS WITH PAVING AND ROADWAY SUBGRADE PREPARATION. THE CONTRACTOR'S ATTENTION IS DIRECTED ESPECIALLY TO SITUATIONS WHERE ROADWAY SUPER-ELEVATION AND/OR SOIL MIXING ARE ANTICIPATED. SPECIAL ATTENTION SHOULD BE DIRECTED TO PROPER PLACEMENT OF IMPERVIOUS MEMBRANES, GEOTEXTILES, FOUNDATION AREAS AND UNDERGROUND UTILITIES. A MINIMUM OF 3" SELECT BACKFILL COVER IS REQUIRED BETWEEN SOIL REINFORCING STRIPS AND ANY ELEMENT OTHER THAN SELECT FILL MATERIAL.
22. THE CONTRACTOR IS RESPONSIBLE FOR CONTROLLING STORM WATER DRAINAGE IN THE VICINITY OF THE WALL DURING CONSTRUCTION. STORM WATER RUNOFF IS TO BE COLLECTED AND DISCHARGED AWAY FROM THE WALL AND THE REINFORCED BACKFILL MASS. M.S.E. WALL BACKFILL SHALL NOT BE PLACED OR TRAVELED UPON WHEN SATURATED. COMPACTED BACKFILL SHALL BE RE-WORKED OR ALLOWED TO DRY WHEN THE MOISTURE CONTENT EXCEEDS OPTIMUM.

23. FINISHED GRADE TREATMENT DESIGN ALONG TOP AND TOE OF M.S.E. WALLS, INCLUDING EROSION CONTROL, IS THE RESPONSIBILITY OF THE CIVIL ENGINEER OF RECORD.

MATERIALS NOTES:

SIEVE SIZE	MIN. PERCENT PASSING
4"	100
No. 40	0 – 60
No. 200	0 – 15

PLASTICITY INDEX (PI), AS DETERMINED BY AASHTO T-90, SHALL NOT EXCEED 6.

25. SELECT BACKFILL ELECTROCHEMICAL REQUIREMENTS:

PROPERTY	REQUIREMENT	TEST METHOD
RESISTIVITY	MINIMUM 3,000 ohm-cm AT 100% SATURATION	AASHTO T-288 / ASTM G-57
pH	4.5 TO 9	AASHTO T-289 / ASTM G-51
CHLORIDES*	MAXIMUM 100 ppm	AASHTO T-291 / ASTM D-512
SULFATES*	MAXIMUM 200 ppm	AASHTO T-29 / ASTM D-516

* IF THE MINIMUM RESISTIVITY EXCEEDS 5,000 ohm-cm AT 100% SATURATION, THE NEED FOR TESTING OF CHLORIDES AND SULFATES IS WAIVED.


26. SELECT BACKFILL DURABILITY REQUIREMENTS:
THE MATERIAL SHALL BE SUBSTANTIALLY FREE OF SHALE OR OTHER SOFT, POOR DURABILITY PARTICLES. THE MATERIAL SHALL HAVE A MAGNESIUM SULFATE SOUNDNESS LOSS OF LESS THAN 30 PERCENT AFTER FOUR (4) CYCLES, AS DETERMINED BY AASHTO T-104 (OR ASTM C-88).
27. NOMINAL STRIP LENGTHS:
THE REINFORCING STRIPS LENGTHS SHOWN ON THESE PLANS, ARE MEASURED FROM THE REAR FACE OF THE M.S.E. WALL FASCIA PANEL, AND ARE NOMINAL LENGTHS REQUIRED BY THE DESIGN CALCULATIONS. THE REQUIRED HORIZONTAL LIMIT OF GRANULAR BACKFILL IS EQUAL TO THE NOMINAL STRIP LENGTH. ADDITIONAL GRANULAR BACKFILL BEYOND THE NOMINAL STRIP IS NOT REQUIRED BY DESIGN, HOWEVER MAY BE REQUIRED BY SPECIAL PROVISIONS AS DIRECTED BY THE OWNER'S DESIGN.
28. PANEL FINISH:
 - IF THE PRECAST CONCRETE FACING PANEL SHALL HAVE A PLAIN FINISH. UNLESS NOTED OTHERWISE. CORNER ELEMENTS, SLIP JOINT UNITS AND PRECAST COPING UNITS SHALL HAVE A PLAIN SMOOTH FINISH.
 - ALL FACING ELEMENTS WILL BE PROVIDED WITH NATURAL CONCRETE GRAY CEMENT. ANY PREPARATION FOR, AND APPLICATION OF PENETRATING STAIN, SEALANTS OR OTHER COATINGS SHALL BE PROVIDED BY OTHERS.
29. NOTE TO CONTRACTORS:
ONLY THE FOLLOWING MATERIALS ARE SUPPLIED BY THE REINFORCED EARTH COMPANY:
 - PRECAST CONCRETE FACING PANELS, CORNER ELEMENTS AND SLIP JOINT COVERS.
 - SOIL REINFORCEMENTS: HIGH ADHERENCE (HA) STRIPS
 - BOLT SETS FOR ATTACHING REINFORCING STRIPS TO PANELS (BOLT, NUT & WASHER)
 - BEARING PADS, (CONTROL HORIZONTAL JOINT SPACING)
 - RUBBER SHIMS (CONTROL PANEL ALIGNMENT)
 - JOINT GEOTEXTILE AND ADHESIVE

ANY OTHER MATERIALS CALLED FOR IN THE CONTRACT PLANS OR SPECIFICATIONS ARE TO BE SUPPLIED BY THE CONTRACTOR. ANY JOINT MATERIALS SHOWN AT THE INTERFACE OF PRECAST PANELS AND CAST-IN-PLACE CONCRETE STRUCTURES ARE TO BE SUPPLIED BY THE ERECTION CONTRACTOR. ALL SANDBLASTING, PAINTING, SEALERS OR OTHER SPECIAL APPLIED COATINGS ARE ALSO SUPPLIED/INSTALLED BY THE CONTRACTOR IN THE FIELD FOLLOWING PANEL ERECTION.

30. HANDLING, LOADING AND LIFTING PROCEDURES REFERENCED IN THESE PLANS OR THE CONSTRUCTION AND QUALITY CONTROL PROCEDURE MANUAL WHEN FURNISHED BY THE REINFORCED EARTH COMPANY ("RECo"), ARE GENERAL IN NATURE AND DO NOT INCLUDE ANY ANALYSIS OR ASSESSMENT OF SITE SPECIFIC CONDITIONS, THE NATURE OF ANY EQUIPMENT USED BY OTHERS, OR MEANS AND METHODS UTILIZED BY ANY CONTRACTOR, FABRICATOR, OR DELIVERY COMPANY. ALL FIRMS OR ENTITIES USING THESE PLANS OR INVOLVED IN THE HANDLING, TRANSPORT, LOADING, UNLOADING OR ERECTION OF PRODUCTS SUPPLIED BY RECo. SHALL MAKE AN INDEPENDENT REVIEW AND ASSESSMENT OF ALL HANDLING, LOADING AND LIFTING CONDITIONS AND PROCEDURES AND SHALL NOT SOLELY RELY ON ANY GENERAL RECOMMENDATIONS SUPPLIED BY RECo. THE CONTRACTOR SHALL DEVISE AND EXECUTE PROJECT SPECIFIC PROCEDURES FOR HANDLING, LOADING AND LIFTING WHICH COMPLY WITH ALL FEDERAL, STATE AND LOCAL SAFETY LAWS, REGULATIONS AND REQUIREMENTS AND ALL APPLICABLE CONTRACT REQUIREMENTS AT ALL LOCATIONS WHERE RECo MATERIALS ARE LOADED, UNLOADED, HANDLED OR ERECTED.

SPECIAL REFERENCE KEY:	
•	THE REINFORCED EARTH COMPANY (HEREINAFTER REFERRED TO AS "RECo")
•	GEOTECHNICAL ENGINEER OF RECORD (HEREINAFTER REFERRED TO AS "GEOTECH")
•	MECHANICALLY STABILIZED EARTH (HEREINAFTER REFERRED TO AS "MSE")
•	CAST-IN-PLACE (HEREINAFTER REFERRED TO AS "C.I.P.")
•	INTERNAL STABILITY: FAILURE MODES NOT ENGAGING OUTSIDE THE VOLUME LIMITED BY THE TOP OF LEVELING PAD ELEVATION, THE TOP OF PANEL ELEVATION, THE FACING ELEMENTS AND THE END OF THE SOIL REINFORCEMENT.
•	INTERNAL STABILITY INCLUDES:
••	SOIL REINFORCEMENT TENSILE CAPACITY
••	SOIL REINFORCEMENT PULL-OUT CAPACITY
••	FACING ELEMENTS STRUCTURAL CAPACITY
••	STRUCTURAL CAPACITY OF CONNECTIONS BETWEEN SOIL REINFORCEMENTS AND FACING ELEMENTS.

CERTIFIED WITH RESPECT TO INTERNAL STABILITY OF REINFORCED EARTH STRUCTURES ONLY.

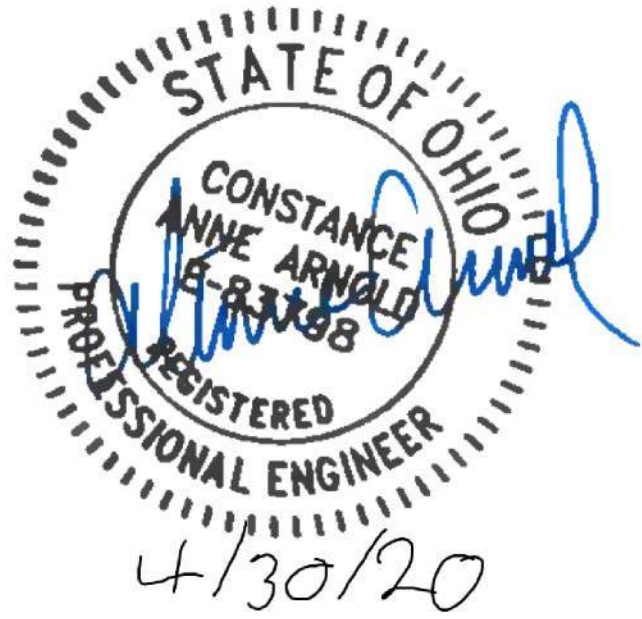

REINFORCED EARTH®

45610 Woodland Rd., Suite 200, Sterling, VA 20166

REINFORCED EARTH®

AND THE REINFORCED EARTH LOGO ARE REGISTERED TRADEMARKS OF THE REINFORCED EARTH COMPANY.

DATE: 04/27/2020

REVIEWED: CA

DRAWN: MS

DESIGNED: MS

PID No: 96833

CHECKED: CA

GENERAL NOTES

CUY-IR490/SR010-2.09/19.28

CITY OF CLEVELAND, CUYAHOGA COUNTY, OHIO

OHIO DEPARTMENT OF TRANSPORTATION

CUY-IR490

SR010-2.09/19.28


02 OF 6

18631

This drawing contains information proprietary to The Reinforced Earth Company, and is being furnished for the use of The Ohio Department of Transportation only in connection with this project, and the information contained is not to be transmitted to any other organization unless specifically authorized in writing by The Reinforced Earth Company. The Reinforced Earth Company is the exclusive licensee in the United States under patents held by our affiliated companies, and the furnishing of this drawing does not constitute an expressed or implied license under any applicable patents.


The design contained on these drawings is based on information provided by the Owner. On the basis of this information, The Reinforced Earth Company has designed, and is responsible for the internal stability of the structure only. External stability, including foundation (bearing capacity and settlement) and global stability (including sliding and rotation), is the responsibility of the Owner.

R:\RE18631_RLA_OH_CUY-IR 490\2nd Structure (2020-04-23) Rear Abut. At E. 89th St\Dwg\2020-04-27) 18631 R. Abut. At E. 89th St. MSE Wall Design.dwg

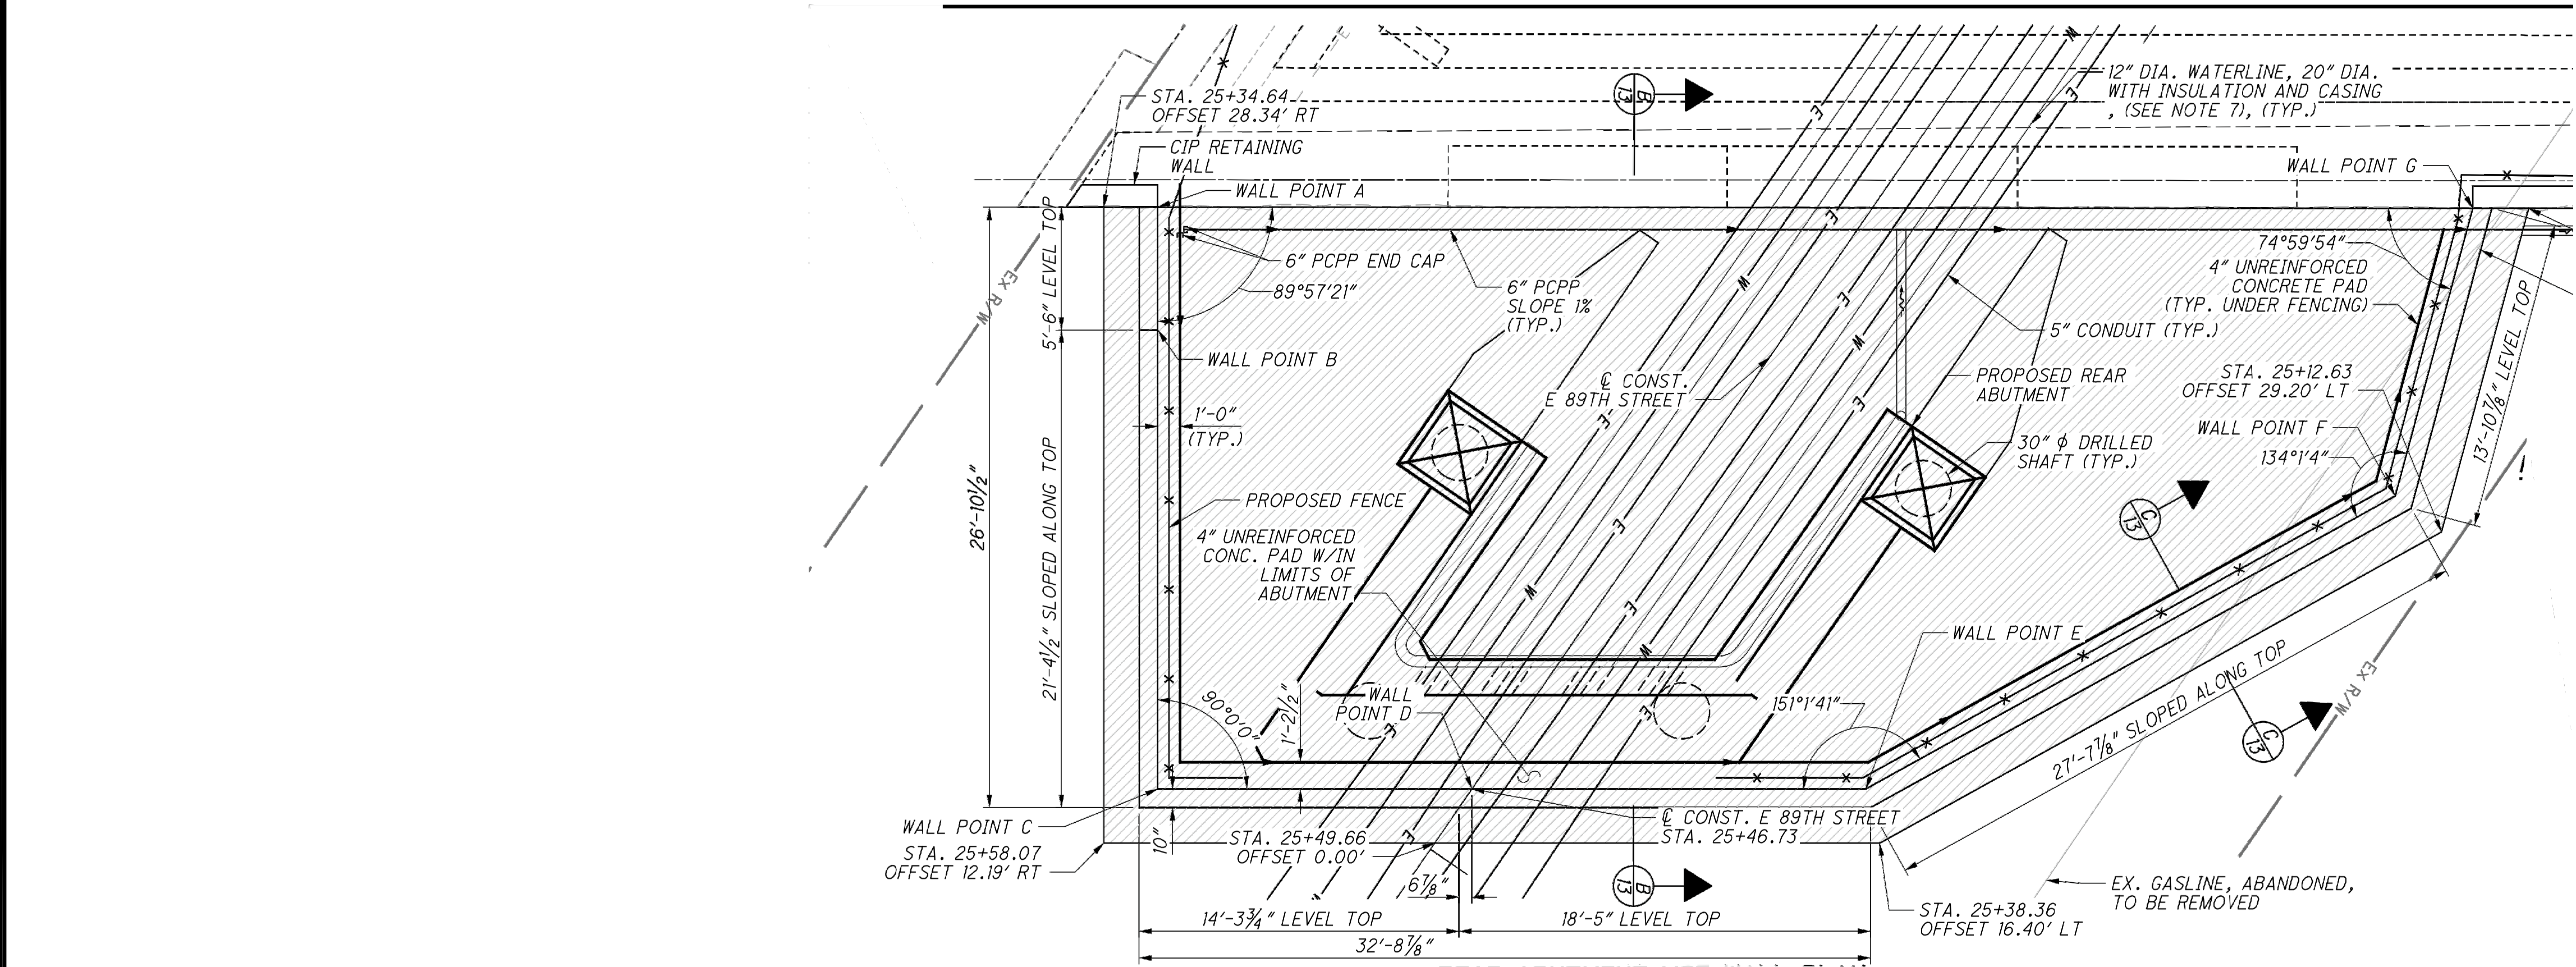

PLAN VIEW NOTE:

1. THE PLAN VIEW SHOWN ON THIS SHEET WERE COPIED FROM THE CONTRACT PLANS AND WERE ATTACHED ON THE REINFORCED EARTH COMPANY DRAWINGS FOR INFORMATION ONLY. THIS INFORMATION WAS DESIGNED, DETAILED, AND SEALED BY 2LMN, INC. THE REINFORCED EARTH COMPANY IS RESPONSIBLE FOR INTERNAL STABILITY OF THE STRUCTURE ONLY.

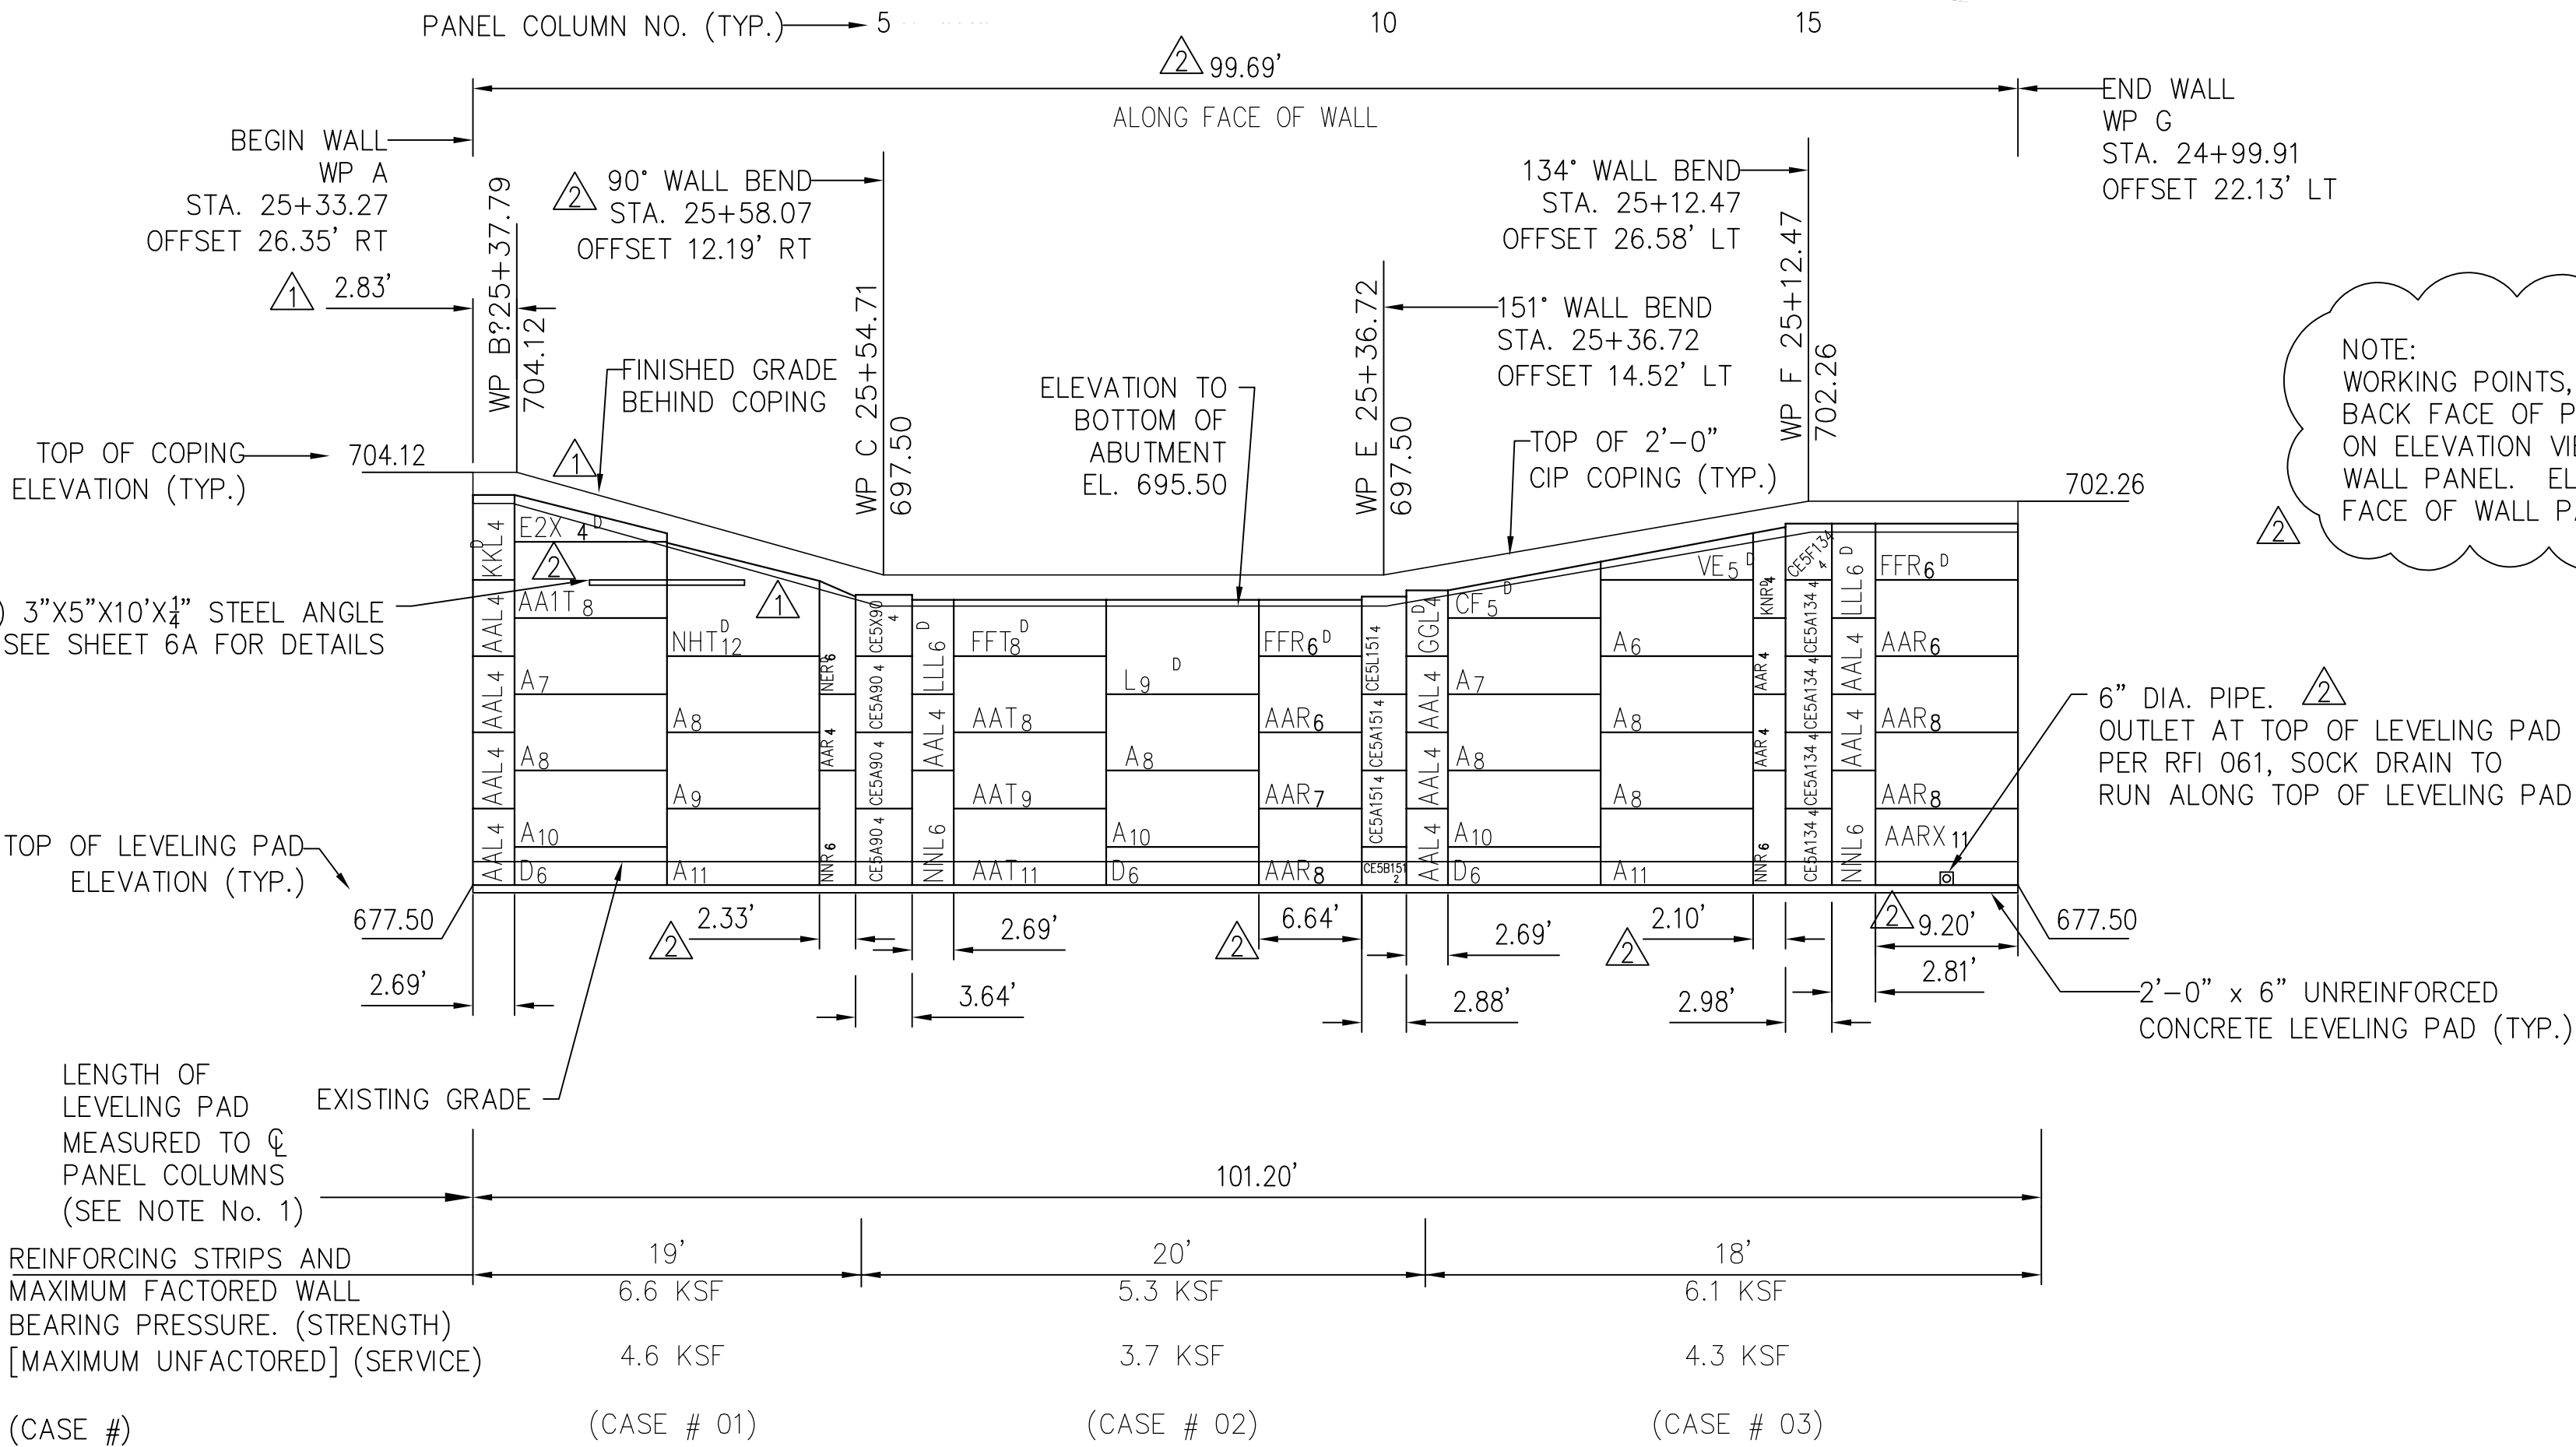

NOTE:
WORKING POINTS, STATIONS, AND OFFSETS ARE GIVEN TO BACK FACE OF PANELS. HOWEVER, DIMENSIONS SHOWN ON ELEVATION VIEW ARE GIVEN ALONG FRONT FACE OF WALL PANEL. ELEVATION VIEW ARE SHOWN TO FRONT FACE OF WALL PANEL.

NOTE:
FOR "M" AND "N" HEIGHT PANELS AT THE TOP OF A WALL, THE PANELS SHALL BE PLACED, CLAMPED AND BACKFILLED TO AT LEAST 10" ABOVE BOTTOM ROW OF TIE STRIPS EMBEDDED IN THE "M" OR "N" PANEL WITHIN THE SAME DAY. NO "M" OR "N" HEIGHT PANEL SHALL BE PLACED AND CLAMPED AND THEN LEFT OVERNIGHT WITHOUT ALSO PLACING AT LEAST 10" OF BACKFILL OVER THE BOTTOM ROW OF REINFORCING STRIPS. AS AN ALTERNATIVE TO THIS BACKFILL REQUIREMENT, THE "M" OR "N" PANEL MAY BE EXTERNALLY BRACED IN ADDITION TO BEING CLAMPED TO ADJACENT PANELS.

PANEL KEY:

AARX^D ← COPING DOWEL
PANEL FORM SHAPE
REQUIRED PANEL CUT EDGE
(R) = RIGHT SIDE
(L) = LEFT SIDE
NO. OF REQUIRED TIE STRIPS
TYPE

NOTES

1. LENGTH OF LEVELING PAD IS BASED ON INDIVIDUAL PANEL WIDTHS FROM CL OF PANEL JOINT TO CL OF PANEL JOINT.
2. TOP OF WALL ELEVATIONS ARE SHOWN TO TOP OF COPING.
3. ALL DIMENSIONS ARE IN FEET UNLESS OTHERWISE NOTED.


ELEVATION VIEW – FRONT FACE REAR ABUTMENT AT EAST 89TH ST.

This drawing contains information proprietary to The Reinforced Earth Company, and is being furnished for the use of The Ohio Department of Transportation only in connection with this project, and the information contained is not to be transmitted to any other organization unless specifically authorized in writing by The Reinforced Earth Company. The Reinforced Earth Company is the exclusive licensee in the United States under patents held by our affiliated companies, and the furnishing of this drawing does not constitute an expressed or implied license under any applicable patents.

The design contained on these drawings is based on information provided by the Owner. On the basis of this information, The Reinforced Earth Company has designed, and is responsible for the internal stability of the structure only. External stability, including foundation (bearing capacity and settlement) and global stability (including sliding and rotation), is the responsibility of the Owner.

CERTIFIED WITH RESPECT TO INTERNAL STABILITY
OF REINFORCED EARTH STRUCTURES ONLY.



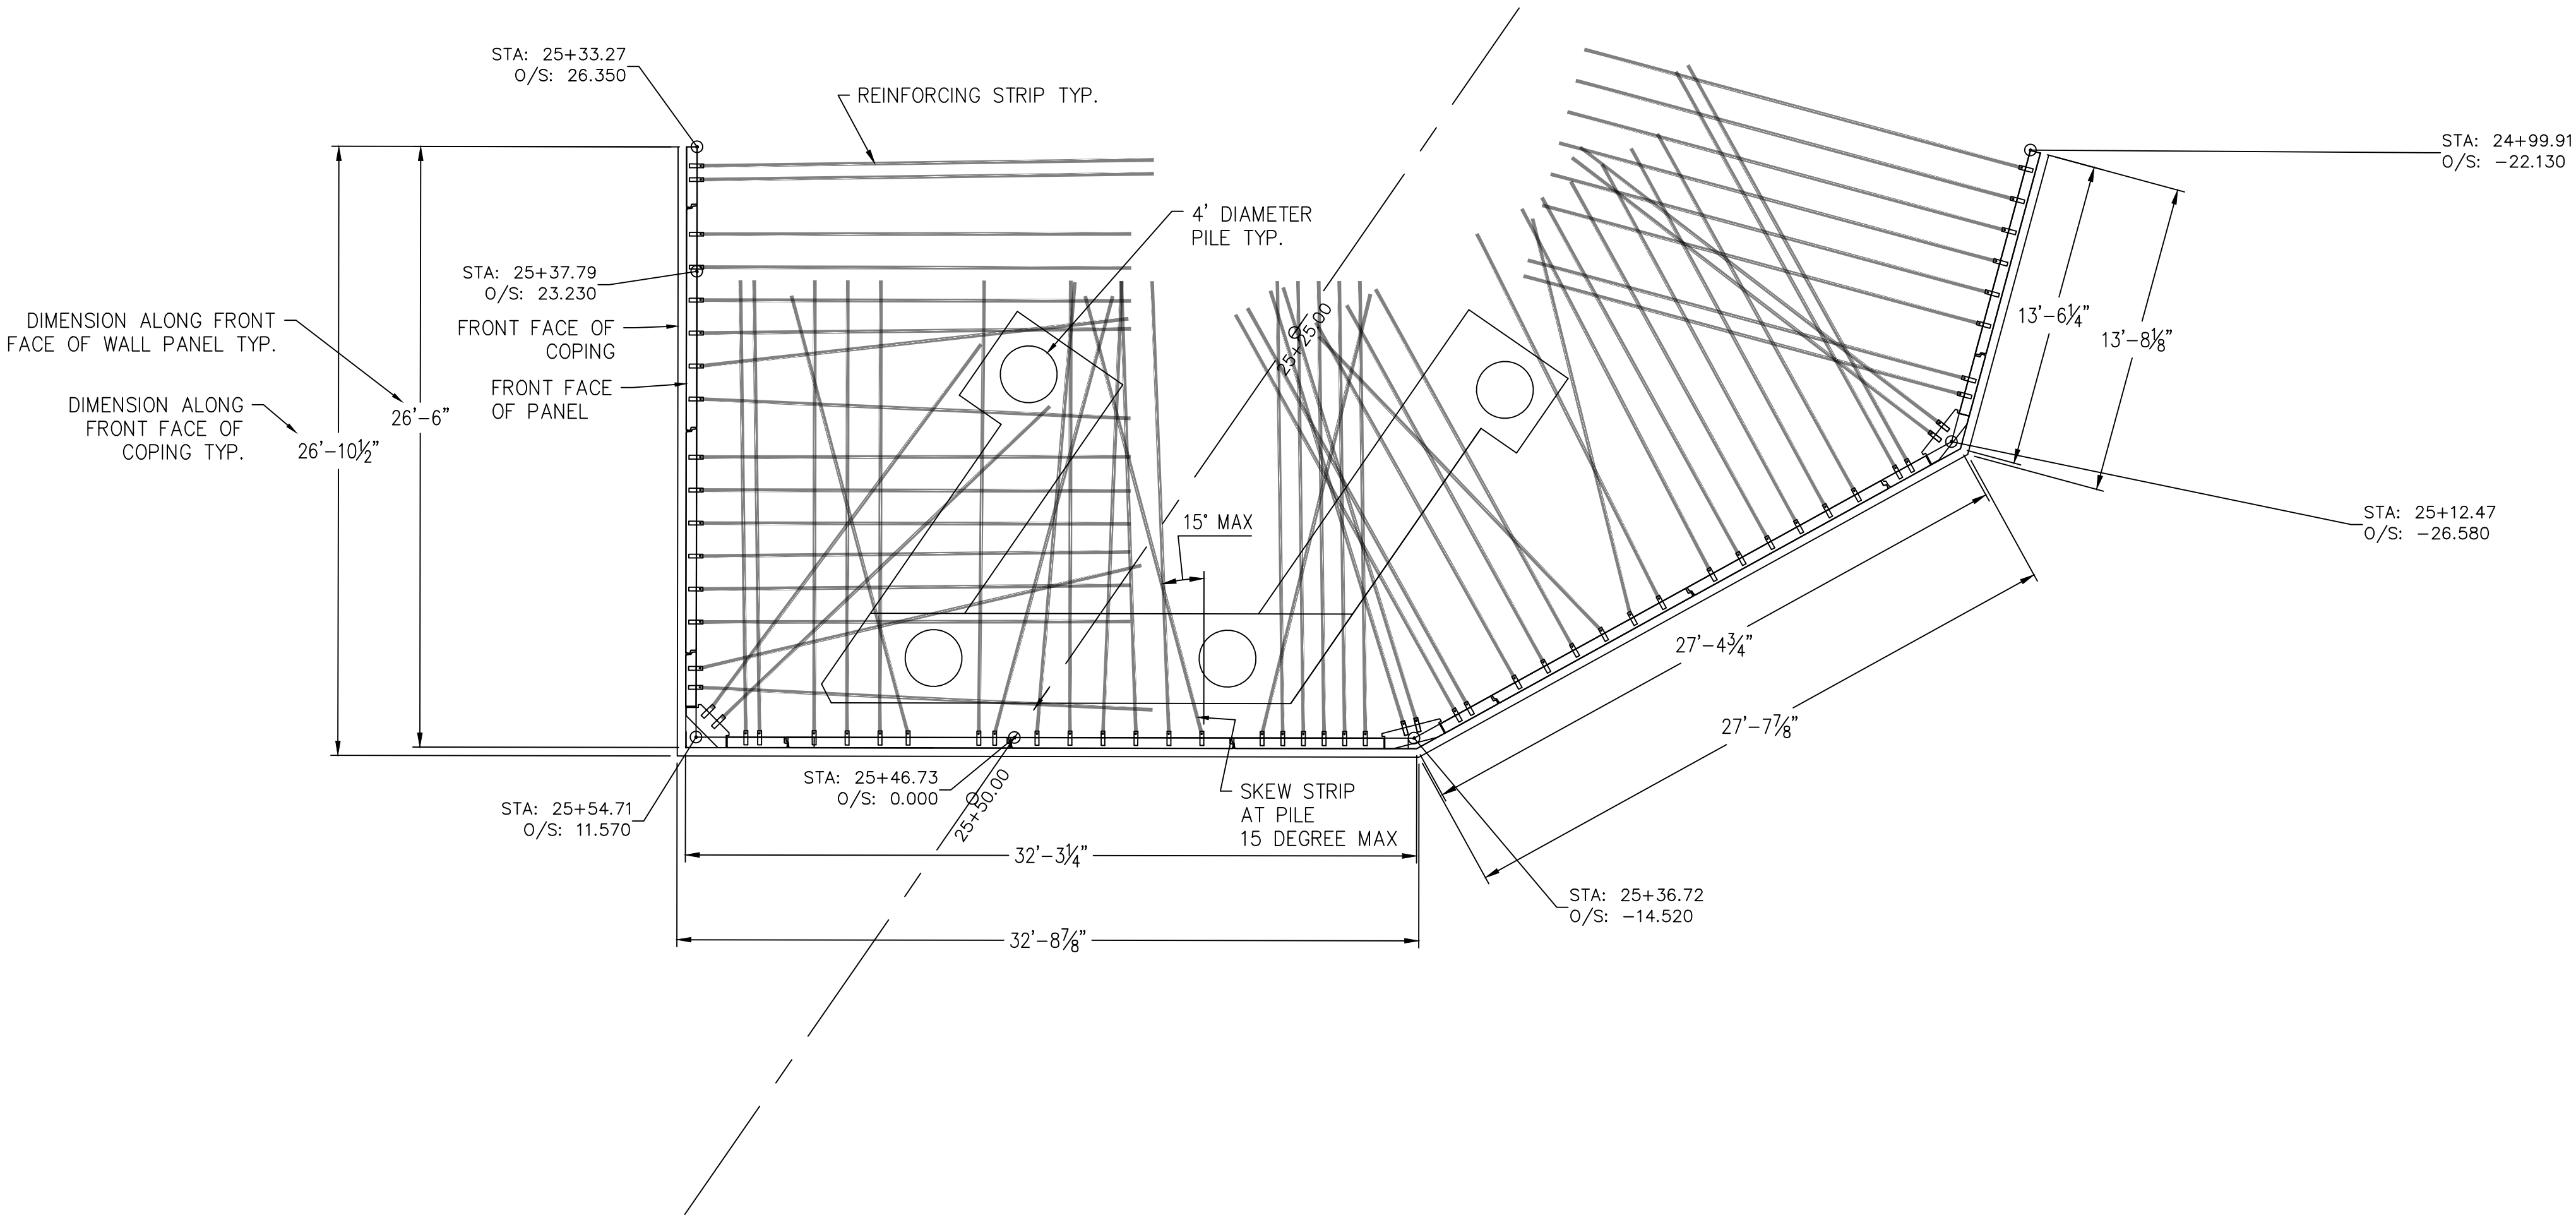


STRIP SKEW PLAN VIEW
SCALE: 1" = 10'

This drawing contains information proprietary to The Reinforced Earth Company, and is being furnished for the use of The Ohio Department of Transportation only in connection with this project, and the information contained is not to be transmitted to any other organization unless specifically authorized in writing by The Reinforced Earth Company. The Reinforced Earth Company is the exclusive licensee in the United States under patents held by our affiliated companies, and the furnishing of this drawing does not constitute an expressed or implied license under any applicable patents.

The design contained on these drawings is based on information provided by the Owner. On the basis of this information, The Reinforced Earth Company has designed, and is responsible for the internal stability of the structure only. External stability, including foundation (bearing capacity and settlement) and global stability (including sliding and rotation), is the responsibility of the Owner.


CERTIFIED WITH RESPECT TO INTERNAL STABILITY
OF REINFORCED EARTH STRUCTURES ONLY.

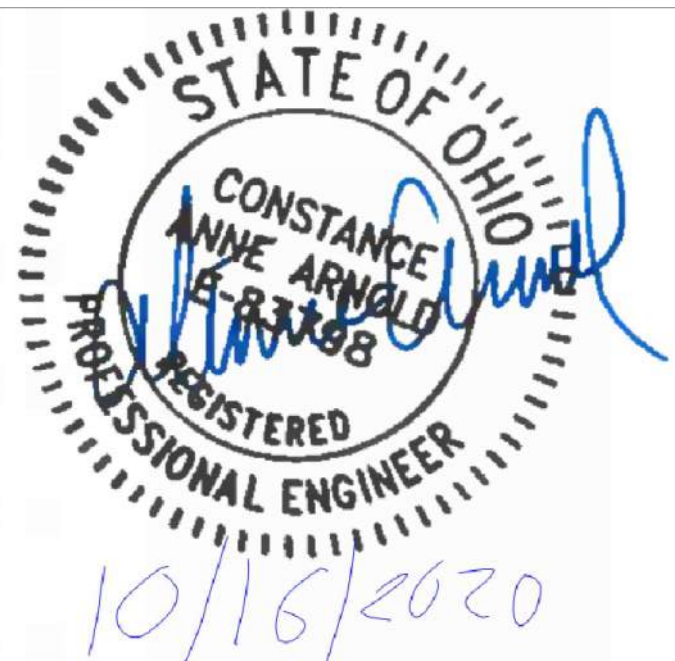

GENERAL NOTES
CUY-IR490/SR010-2.09/19.28
CITY OF CLEVELAND, CUYAHOGA COUNTY, OHIO
OHIO DEPARTMENT OF TRANSPORTATION

CUY-IR490
SR010-2.09/19.28


03A OF 6

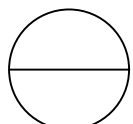

18631

DESIGNED:	DRAWN:	REVIEWED:	DATE:
MS	MS	CA	04/27/2020
CHECKED:	REVISED:	PID No:	
CA		96833	


10/15/20	REVISED PER ODOT COMMENT	

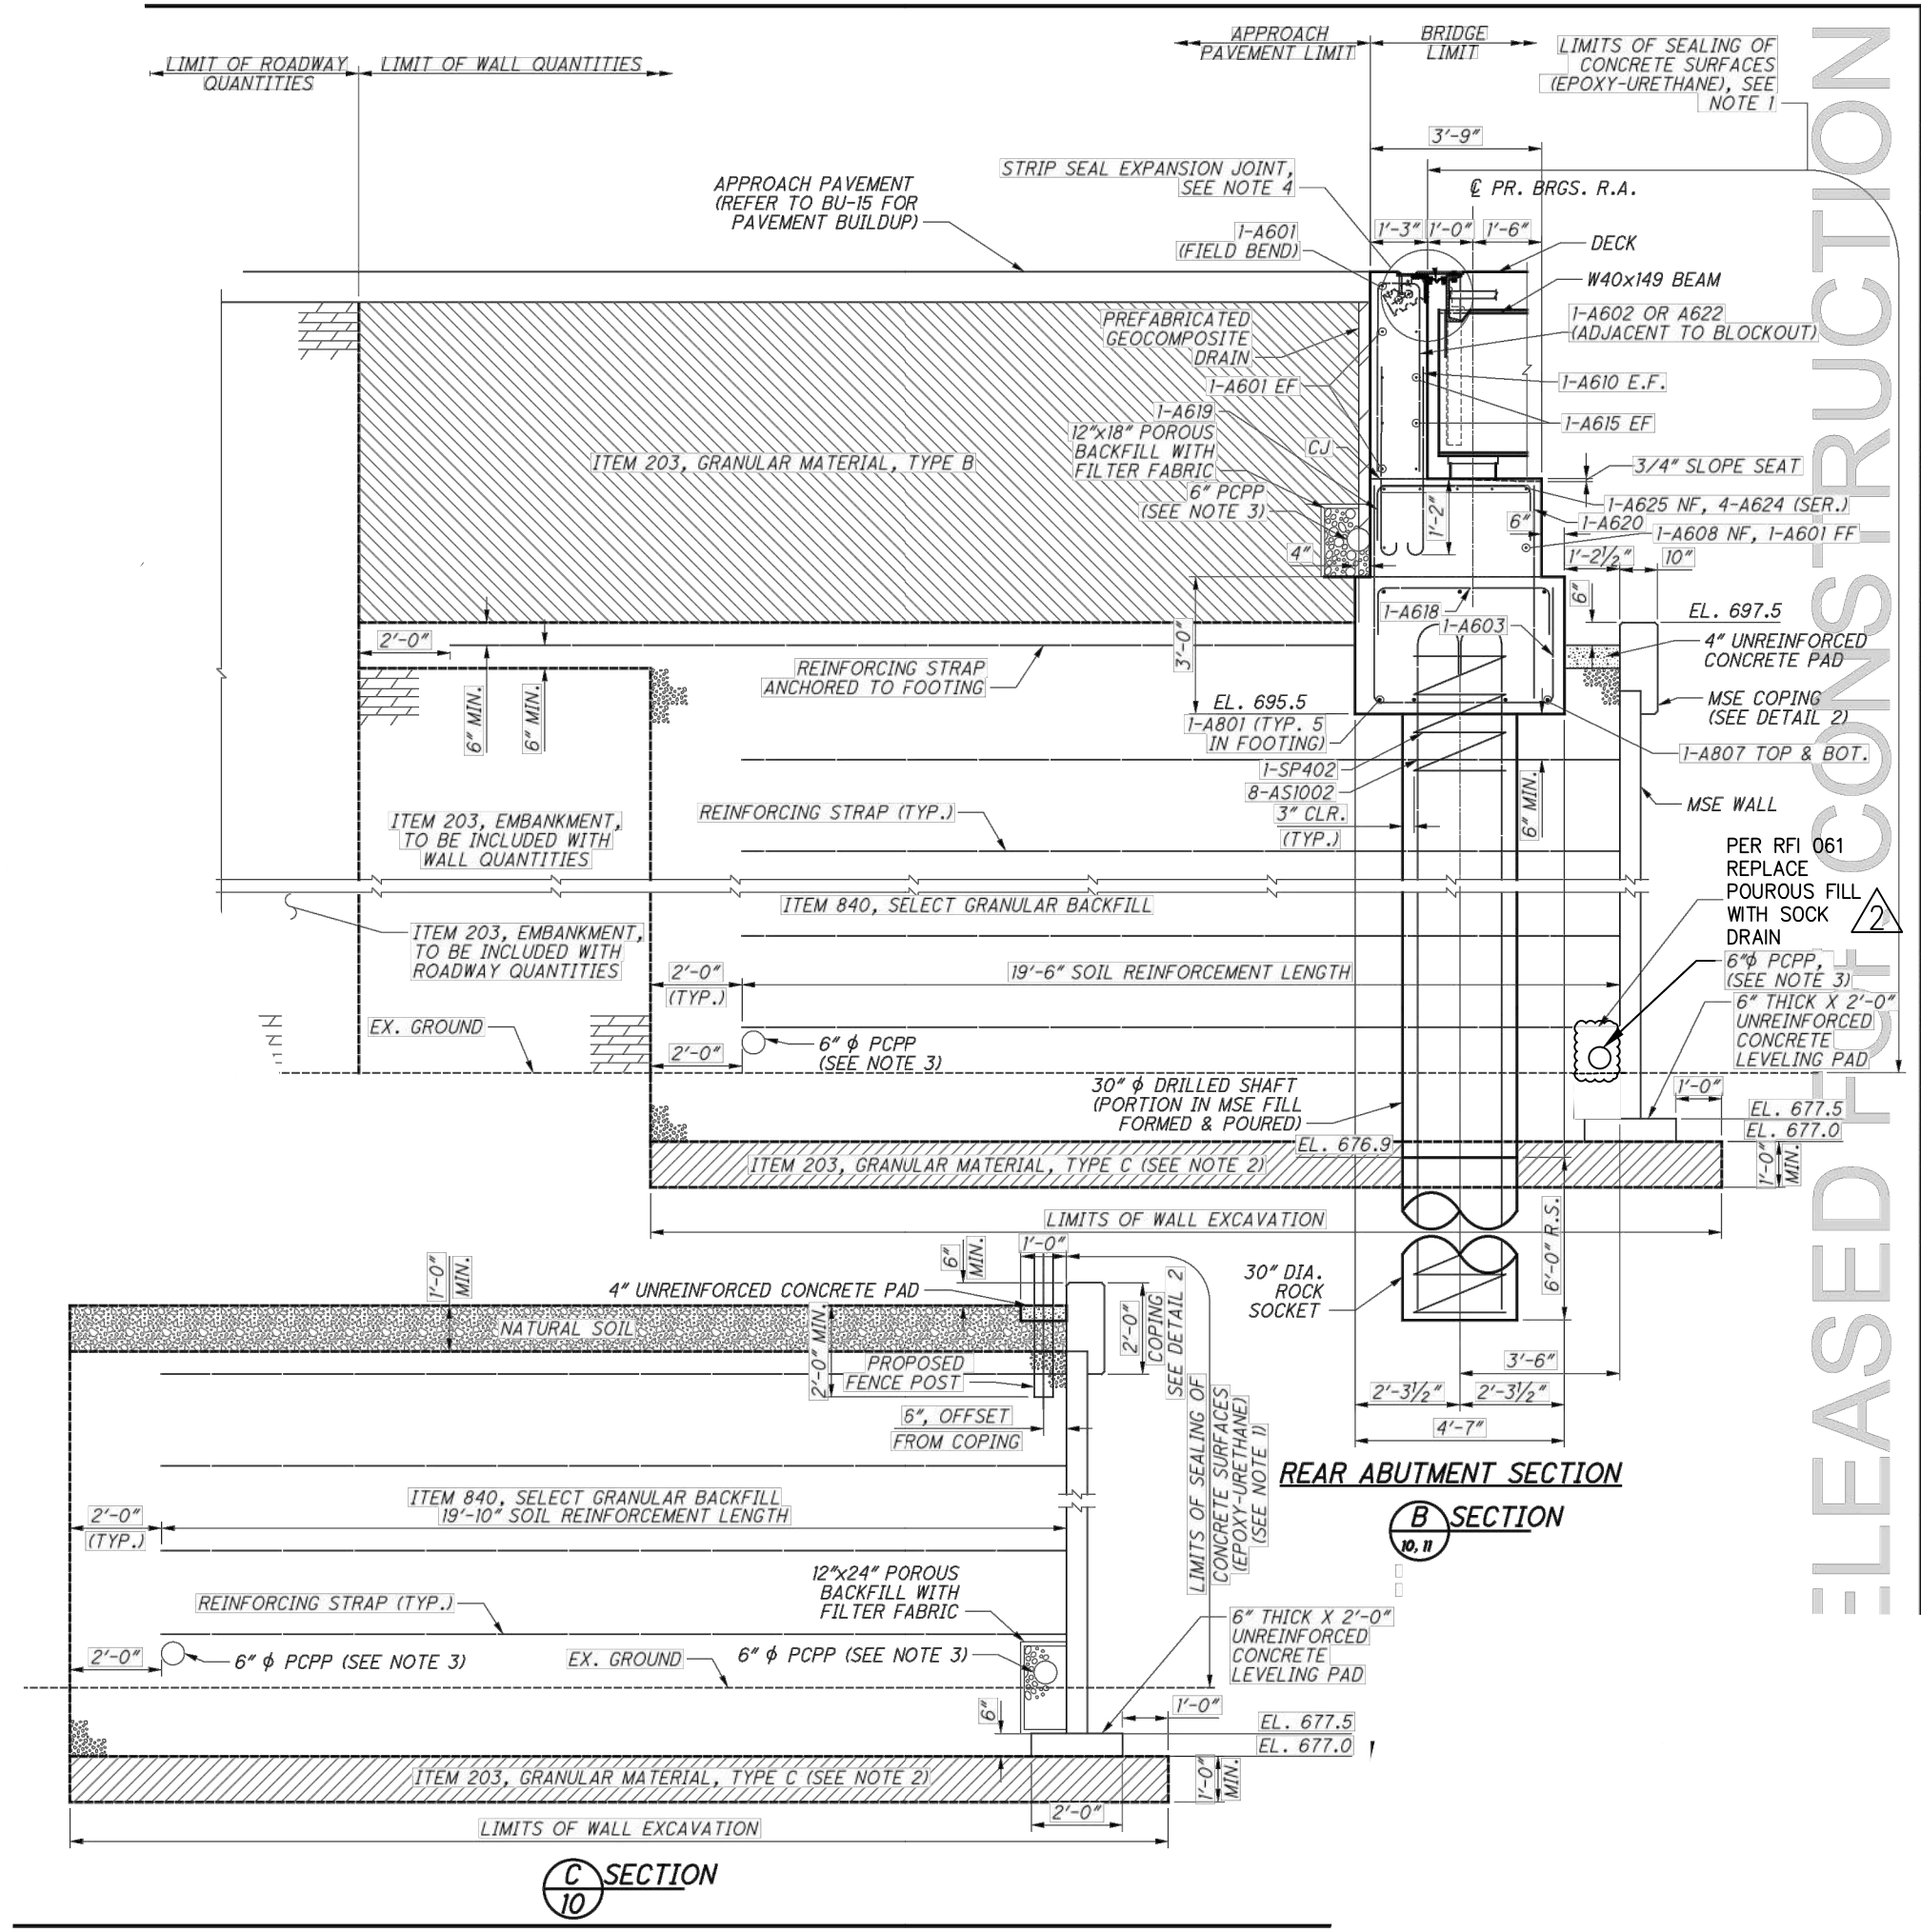



NEW ABUTMENT STRAP
CONFIGURATION DUE TO
CONFLICT WITH ABUTMENT
WING WALLS - REVISED -
12/23/20

PLAN VIEW NOTE:

- THE SECTION VIEWS SHOWN ON THIS SHEET WERE COPIED FROM THE CONTRACT PLANS AND WERE ATTACHED ON THE REINFORCED EARTH COMPANY DRAWINGS FOR INFORMATION ONLY. THIS INFORMATION WAS DESIGNED, DETAILED, AND SEALED BY 2LMN, INC. THE REINFORCED EARTH COMPANY IS RESPONSIBLE FOR INTERNAL STABILITY OF THE STRUCTURE ONLY.

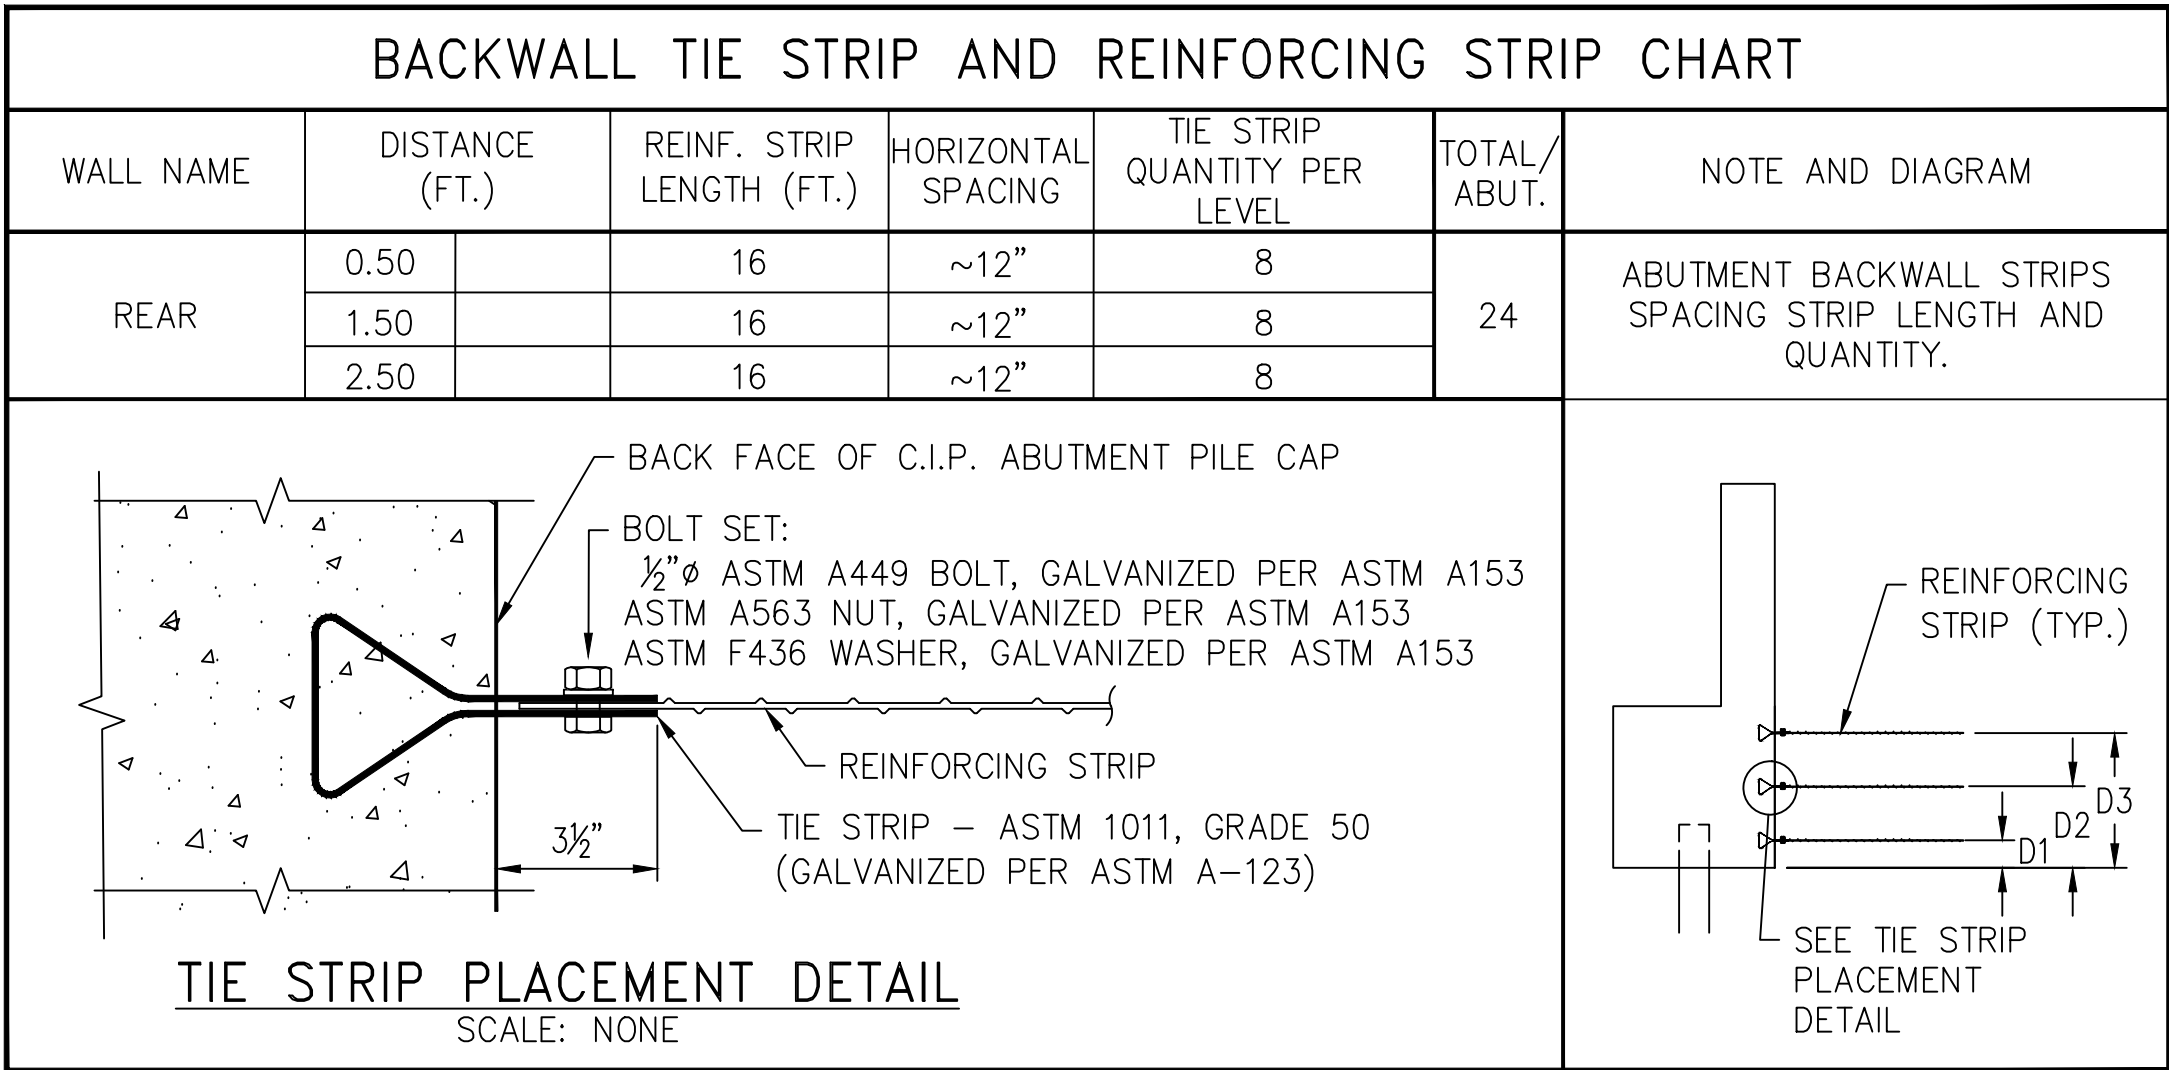

NOTE: - THE FIRST AND LAST TIE STRIP SHALL BE PLACED 6" MIN. FROM EDGE OF BACKWALL.

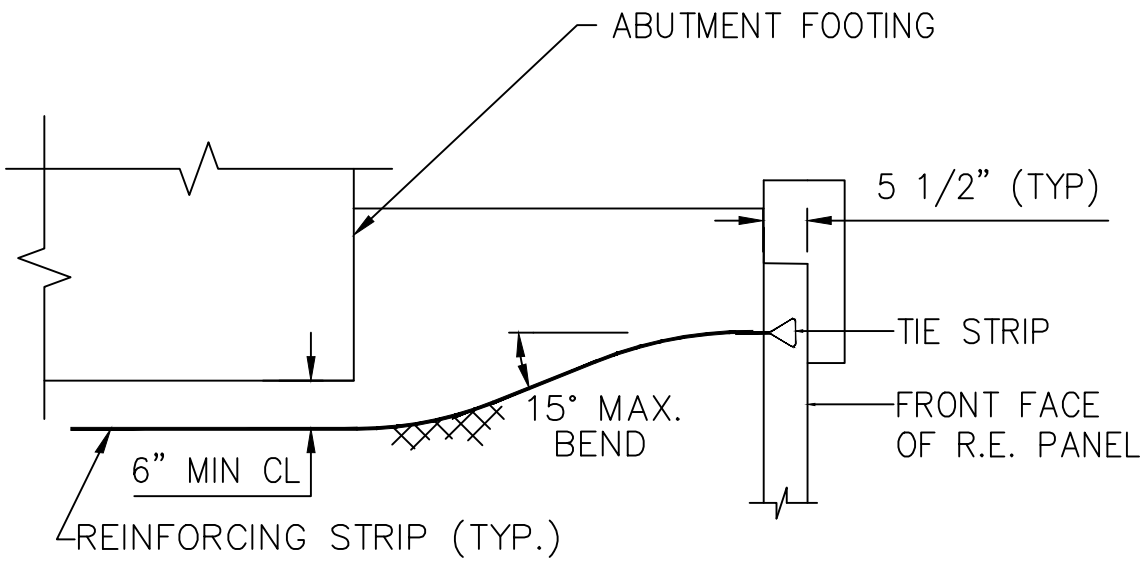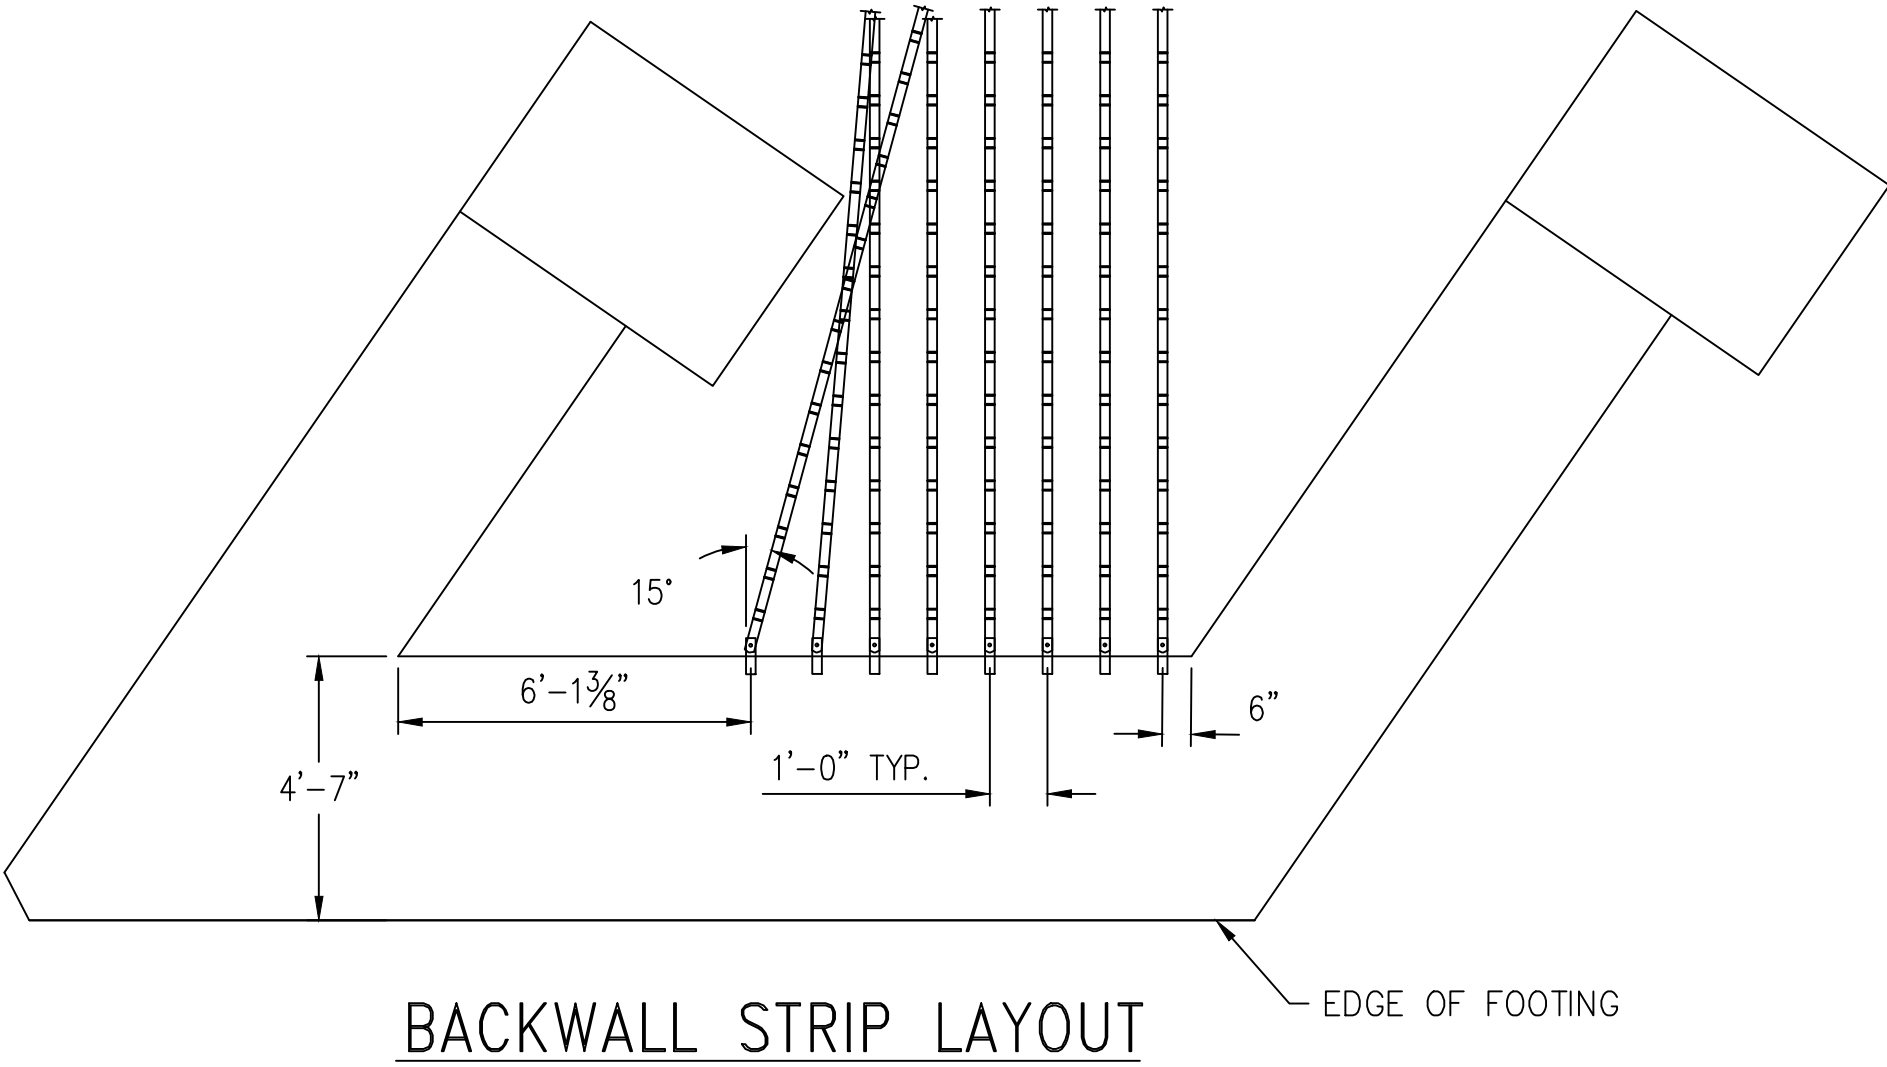

TYPICAL REINFORCING STRIP BENDING DETAIL


SCALE: 1/2" = 1'-0"

NOTE: DEFLECT STRIP GRADUALLY (15° MAX) WHERE REQUIRED TO ACHIEVE 6" MIN CLEARANCE FROM BOTTOM OF ABUTMENT

This drawing contains information proprietary to The Reinforced Earth Company, and is being furnished for the use of The Ohio Department of Transportation only in connection with this project, and the information contained is not to be transmitted to any other organization unless specifically authorized in writing by The Reinforced Earth Company. The Reinforced Earth Company is the exclusive licensee in the United States under patents held by our affiliated companies, and the furnishing of this drawing does not constitute an expressed or implied license under any applicable patents.


The design contained on these drawings is based on information provided by the Owner. On the basis of this information, The Reinforced Earth Company has designed, and is responsible for the internal stability of the structure only. External stability, including foundation (bearing capacity and settlement) and global stability (including sliding and rotation), is the responsibility of the Owner.

CERTIFIED WITH RESPECT TO INTERNAL STABILITY OF REINFORCED EARTH STRUCTURES ONLY.

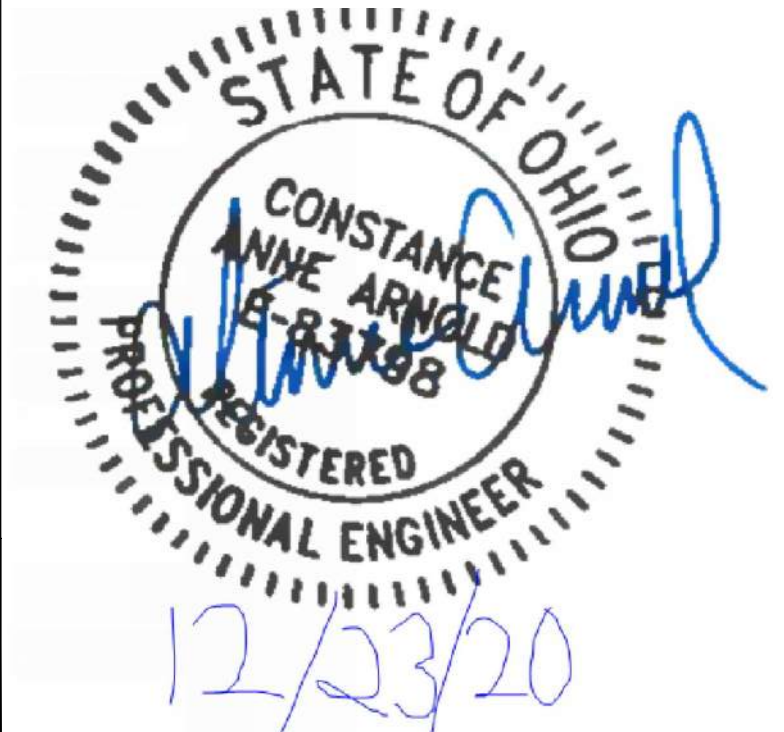


REINFORCED EARTH®
45610 Woodland Rd., Suite 200, Sterling, VA 20166
*REINFORCED EARTH® AND THE REINFORCED EARTH LOGO ARE REGISTERED TRADEMARKS OF THE REINFORCED EARTH COMPANY.

DATE: 04/27/2020	PID No: 96833
REVIEWED: CA	CHECKED: CA
DRAWN: MS	DESIGNED: MS
TYPICAL MSE SECTION(S) & DETAILS CUY-IR490/SR010-2.09/19.28 CITY OF CLEVELAND, CUYAHOGA COUNTY, OHIO OHIO DEPARTMENT OF TRANSPORTATION	
CUY-IR490 SR010-2.09/19.28	
04 OF 6	
18631	

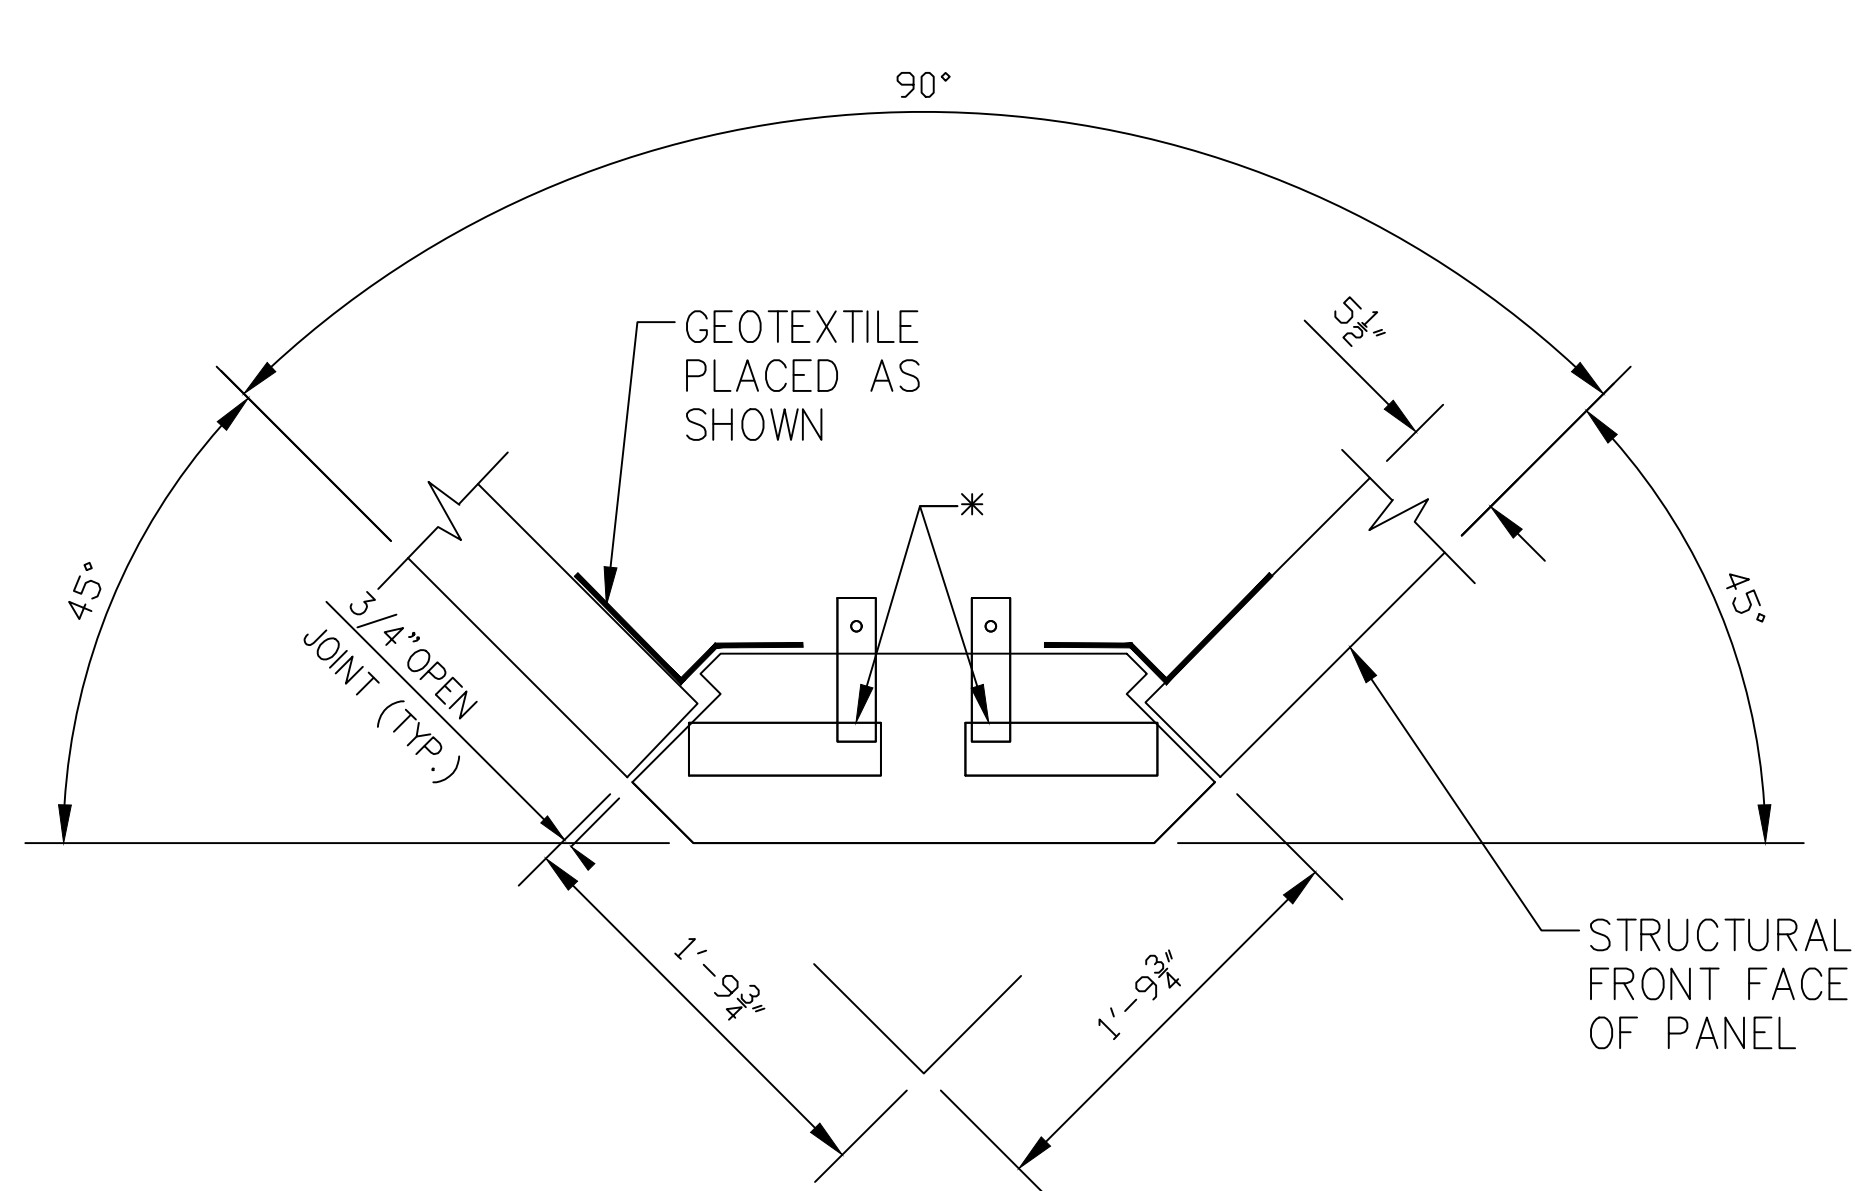


90° WALL BEND PLAN DETAIL

N.T.S.
* NOTE: PLACE BEARING PADS AS SHOWN
COLUMN 5

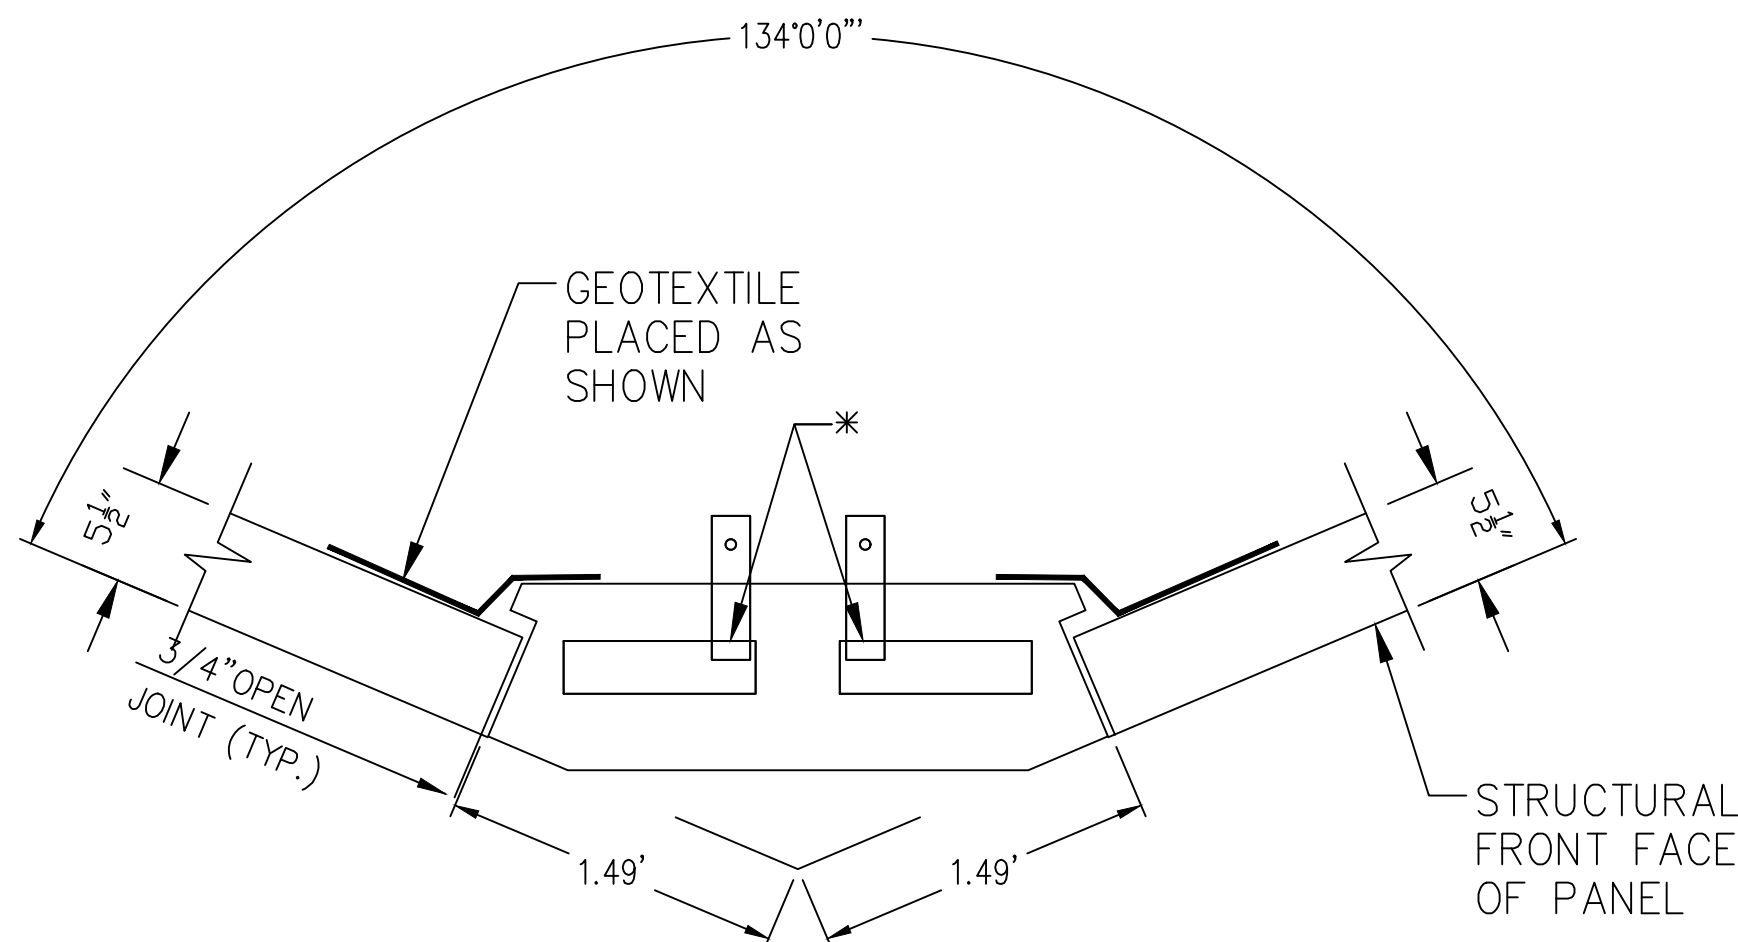

134° WALL BEND PLAN DETAIL


N.T.S.
* NOTE: PLACE BEARING PADS AS SHOWN
COLUMN 15

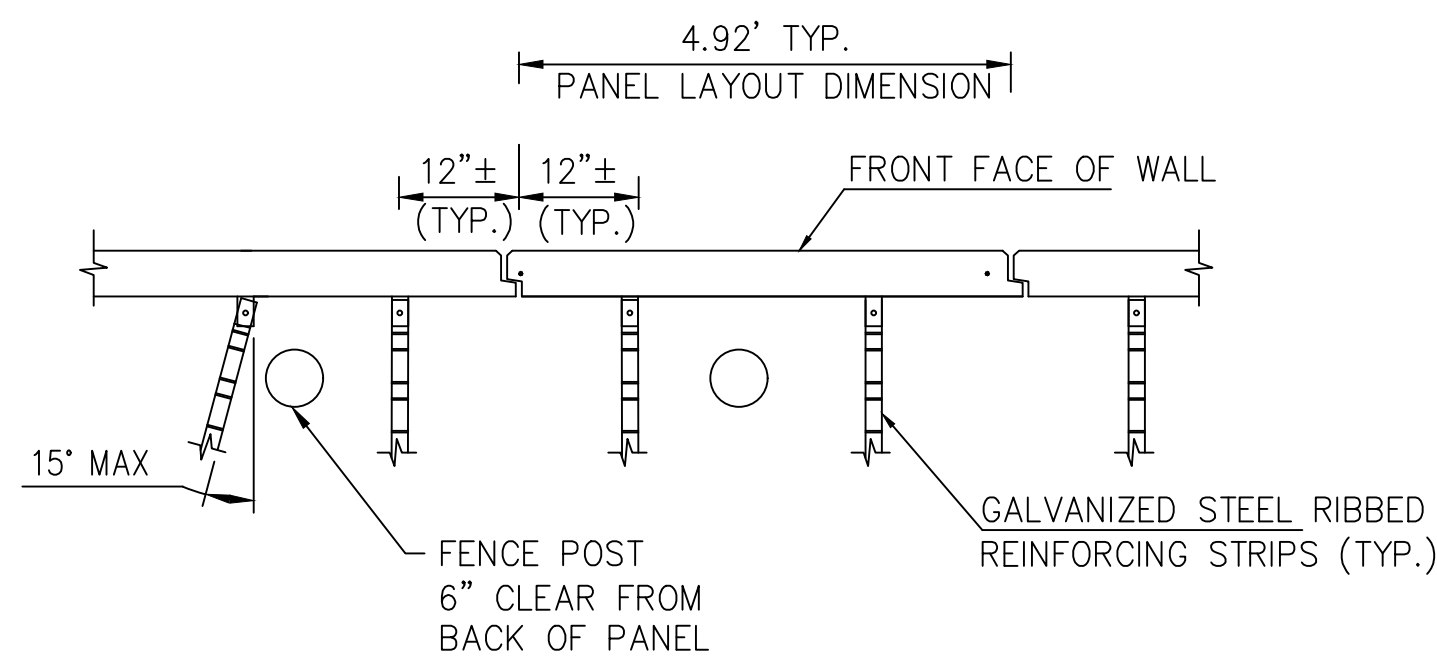

FENCE POST BEHIND WALL


SCALE 1/2" = 1'-0"

NOTE:
PRIOR TO PLACING FENCE POST FOUNDATIONS, CONTRACTOR SHALL MARK LOCATION ON BACK-FACE OF WALL AND SKEW REINFORCING STRIPS TO AVOID THE OBSTRUCTION. OR PLACE SONOTUBE/PVC PIPE FOR FUTURE GUIDERAIL PLACEMENT, SUCH THAT PLACEMENT OF REINFORCING STRIPS IS NOT OBSTRUCTED.
IT IS THE CONTRACTOR'S RESPONSIBILITY TO DETERMINE THE LOCATION OF FENCE POSTS BEHIND THE REINFORCED EARTH PANELS PRIOR TO PLACEMENT OF THE TOP TWO LEVELS OF REINFORCING STRIPS. ANY DAMAGE DONE TO THE REINFORCING STRIPS DUE TO THE INSTALLATION OF FENCE POSTS SHALL BE REPAIRED BY THE CONTRACTOR AT THE CONTRACTOR'S EXPENSE.

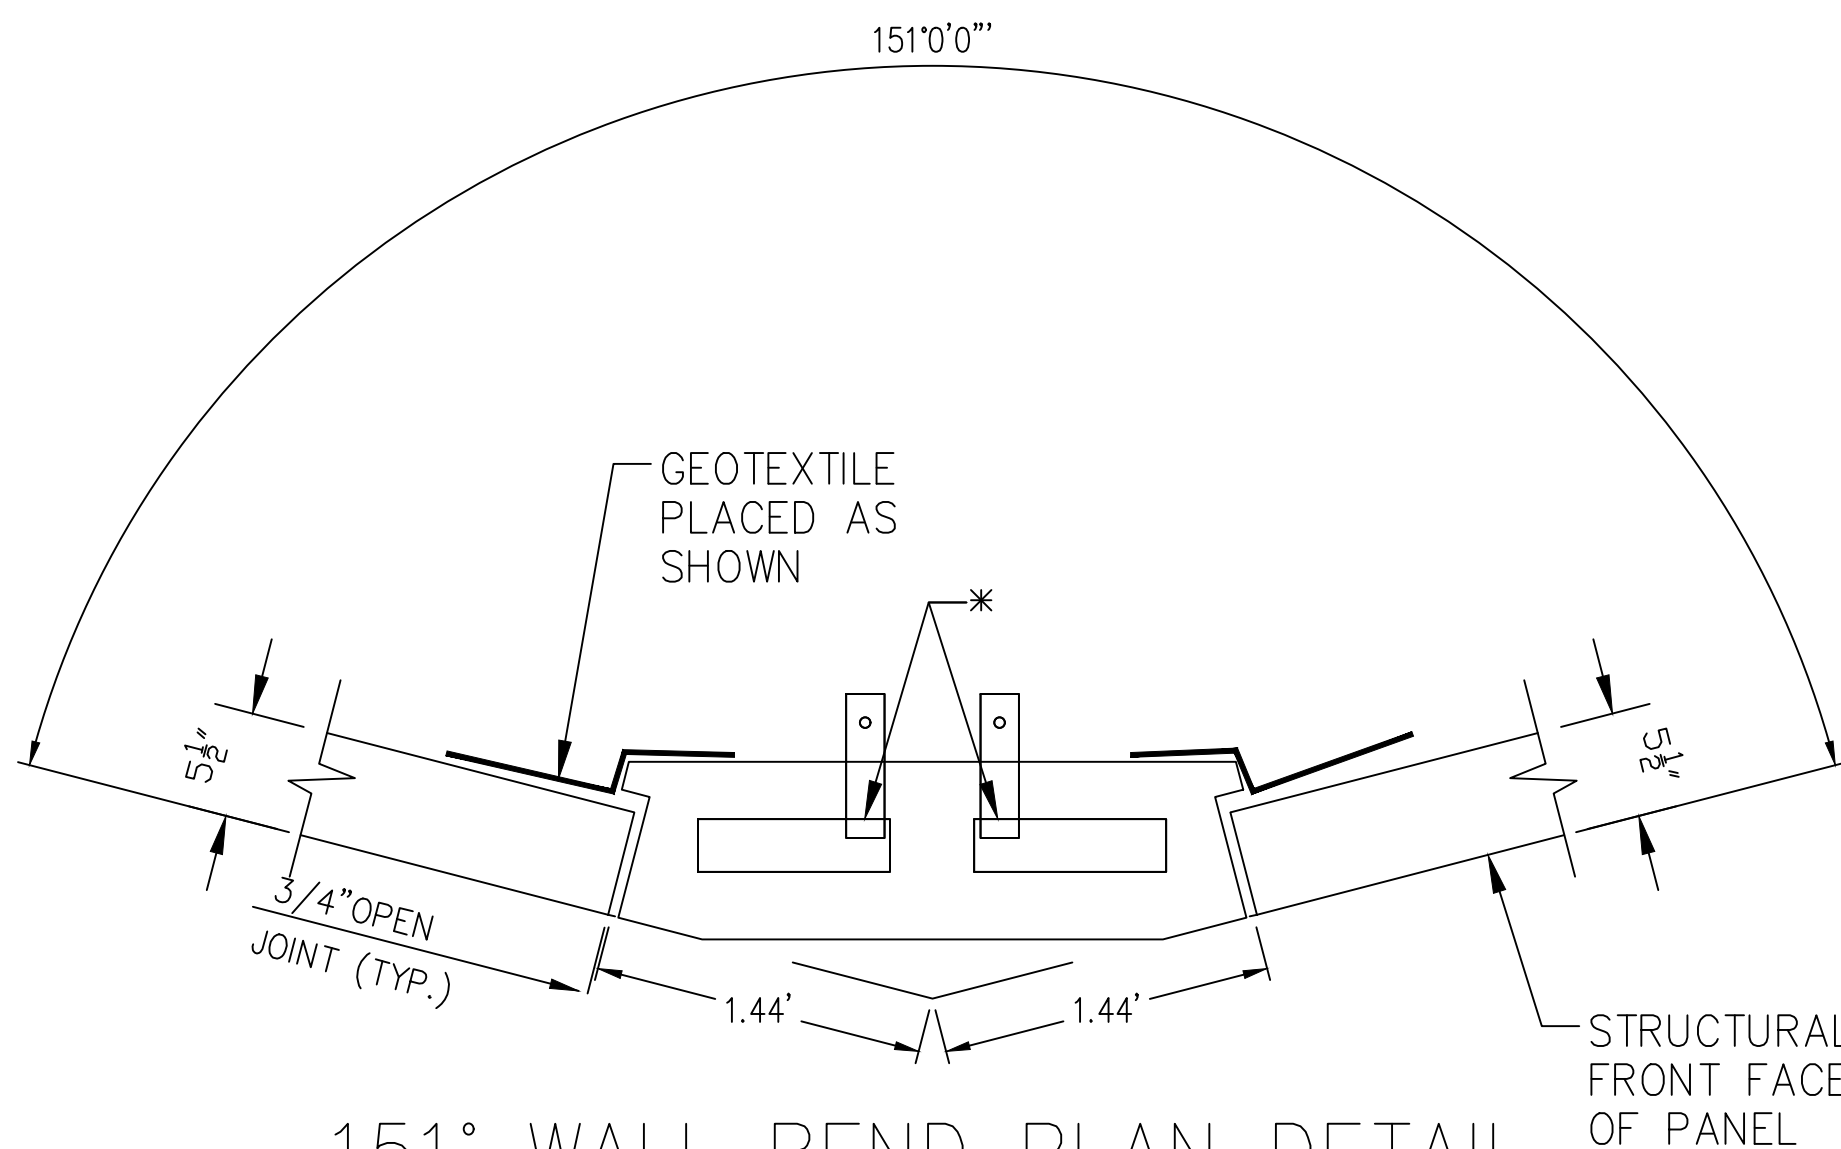


151° WALL BEND PLAN DETAIL

N.T.S.
* NOTE: PLACE BEARING PADS AS SHOWN
COLUMN 10

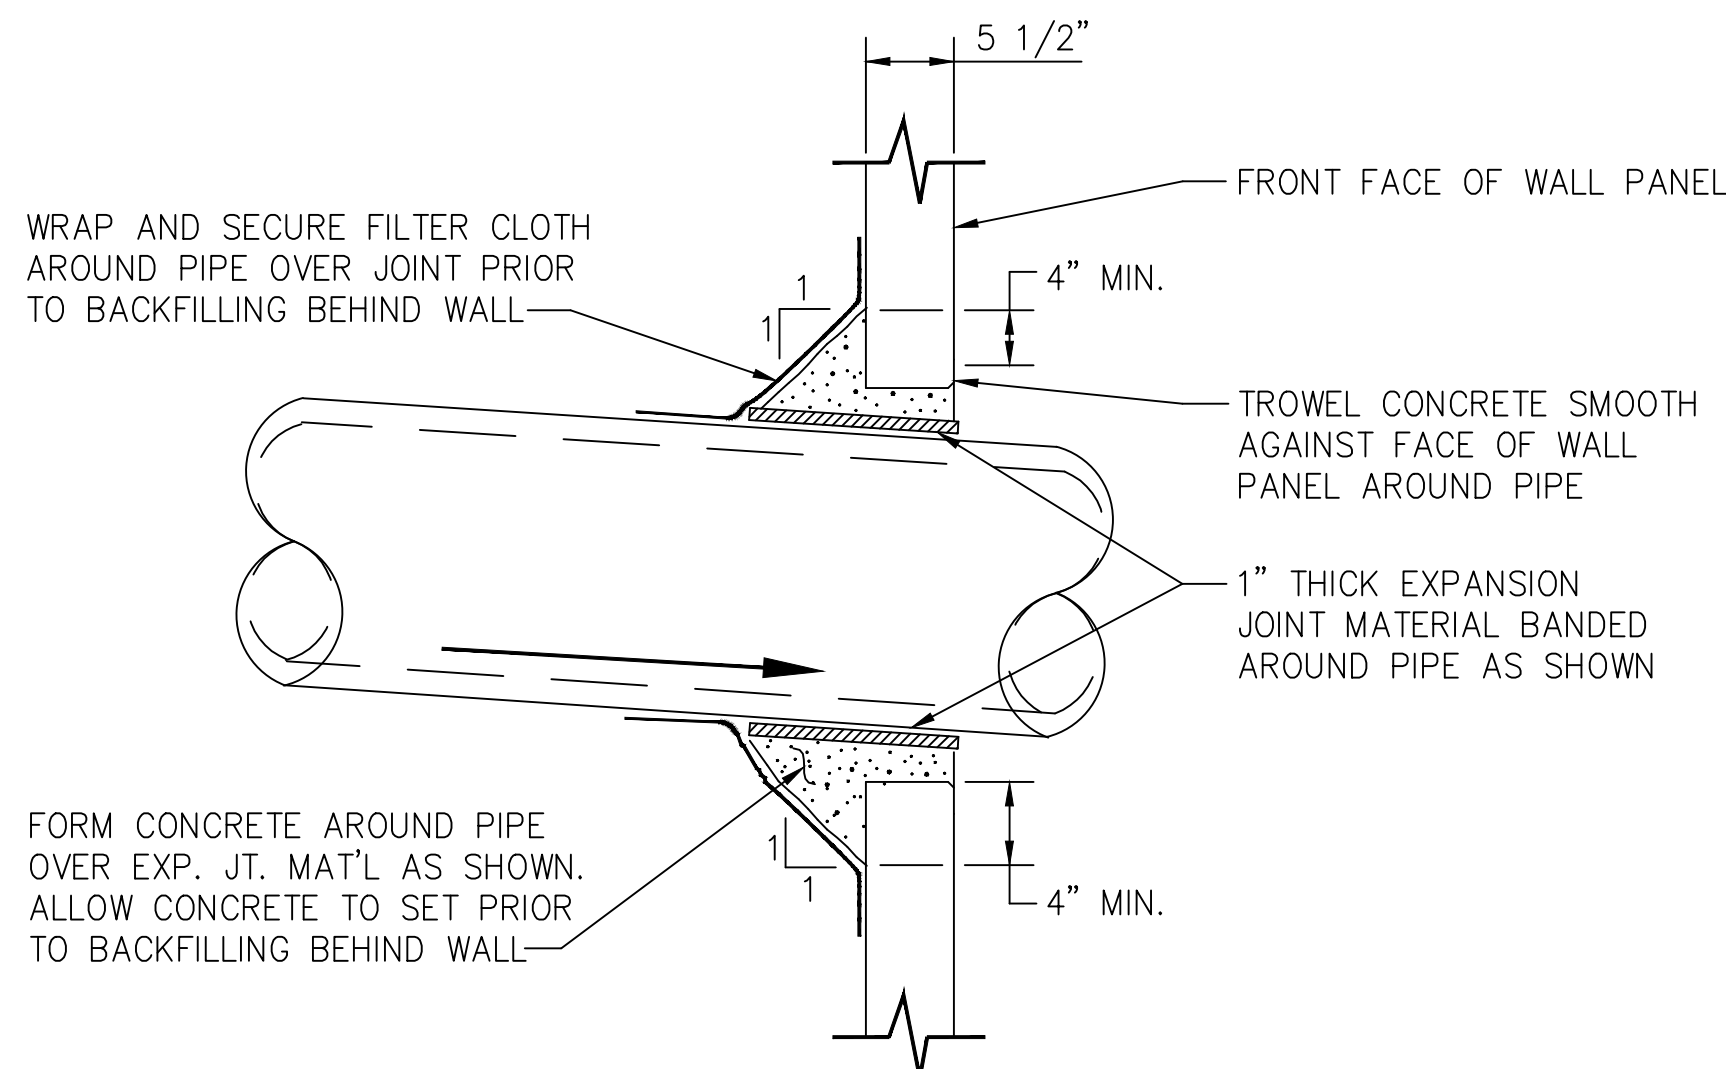


PIPE PENETRATION AT WALL FACE DETAIL


SCALE: 1" = 1'-0"

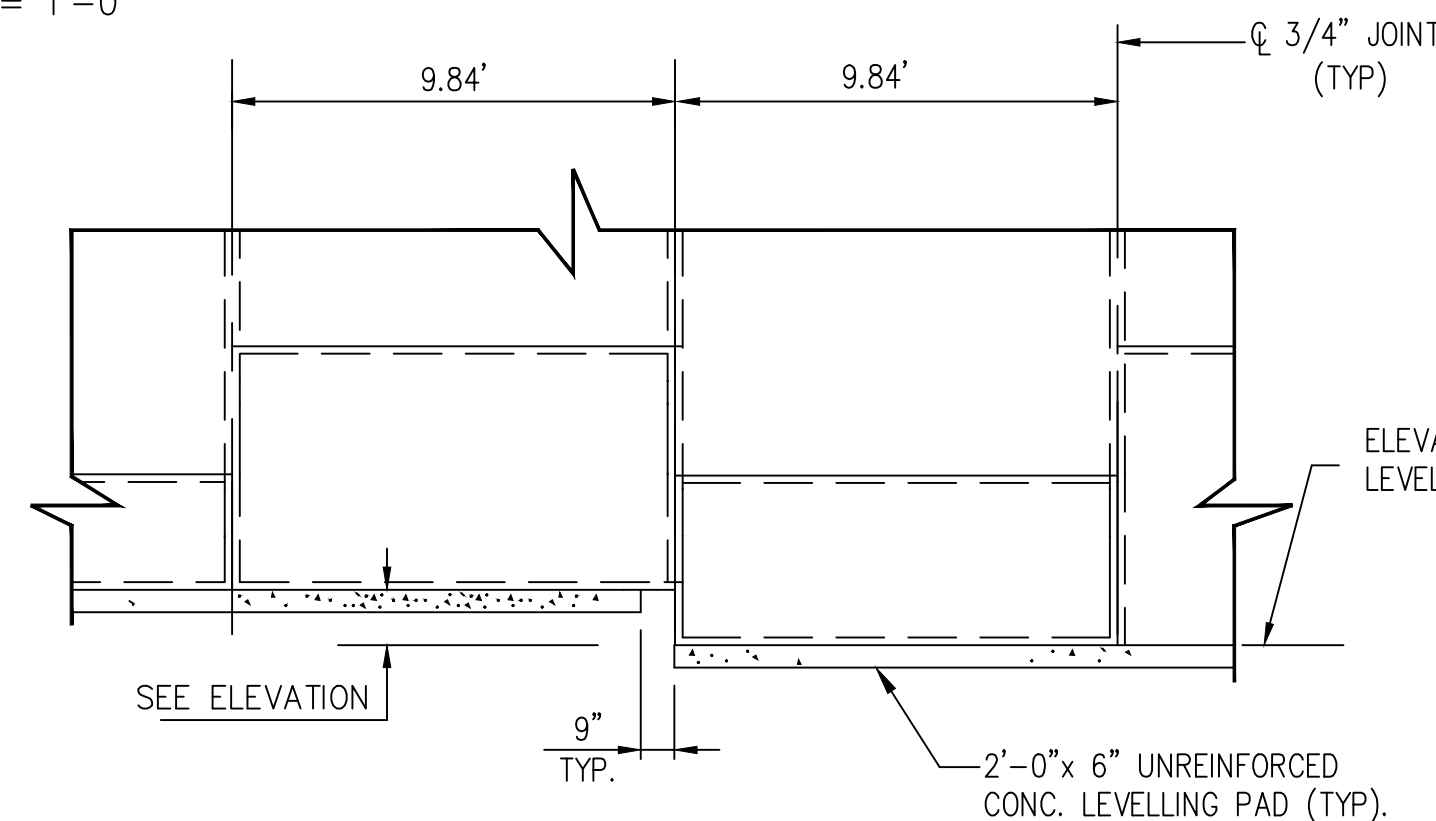

TYPICAL LEVELING PAD STEP DETAIL

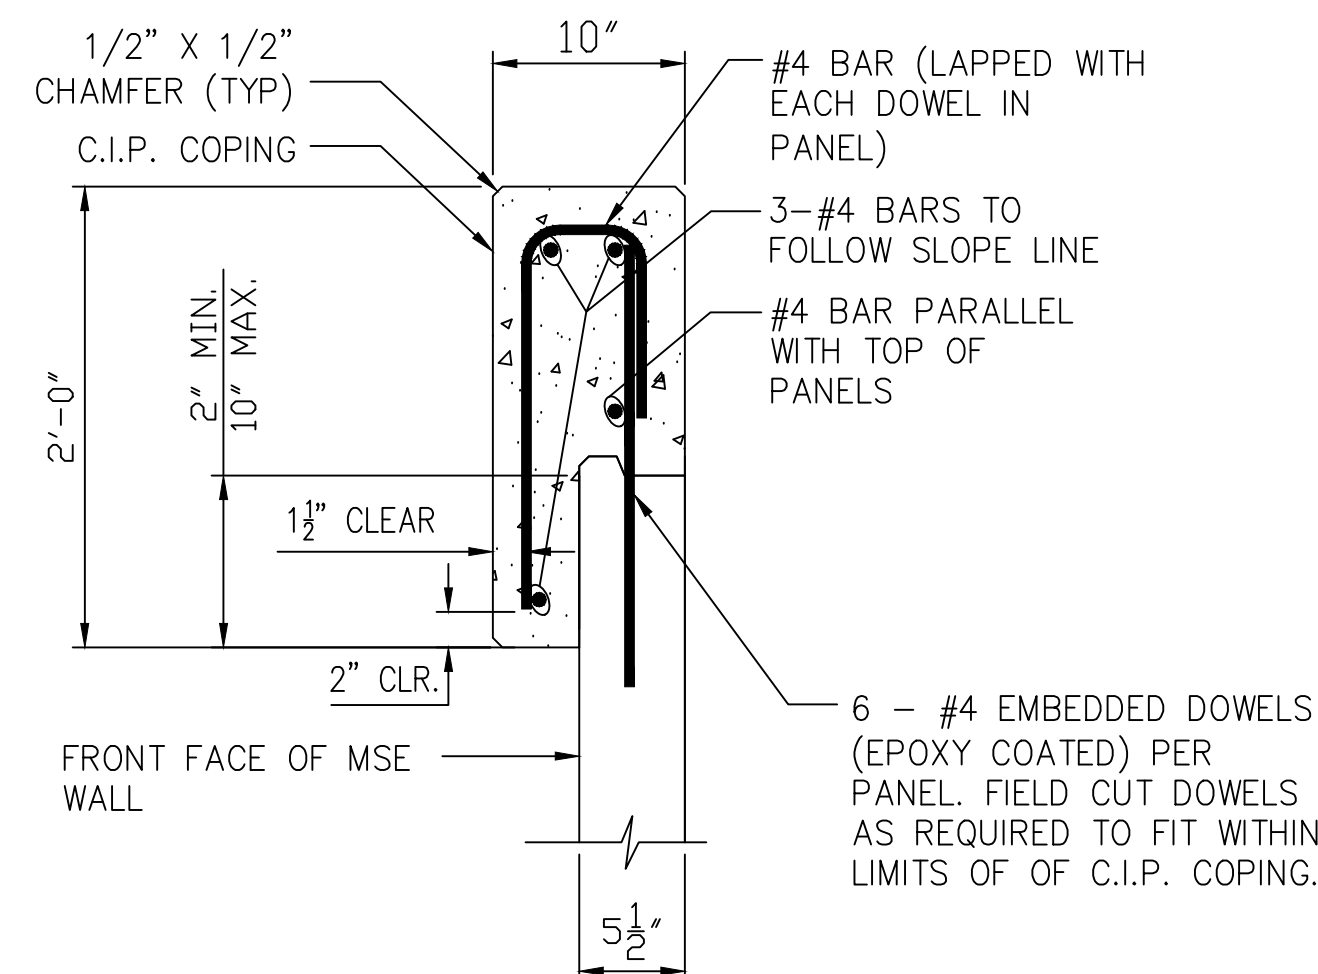


C.I.P. COPING DETAIL

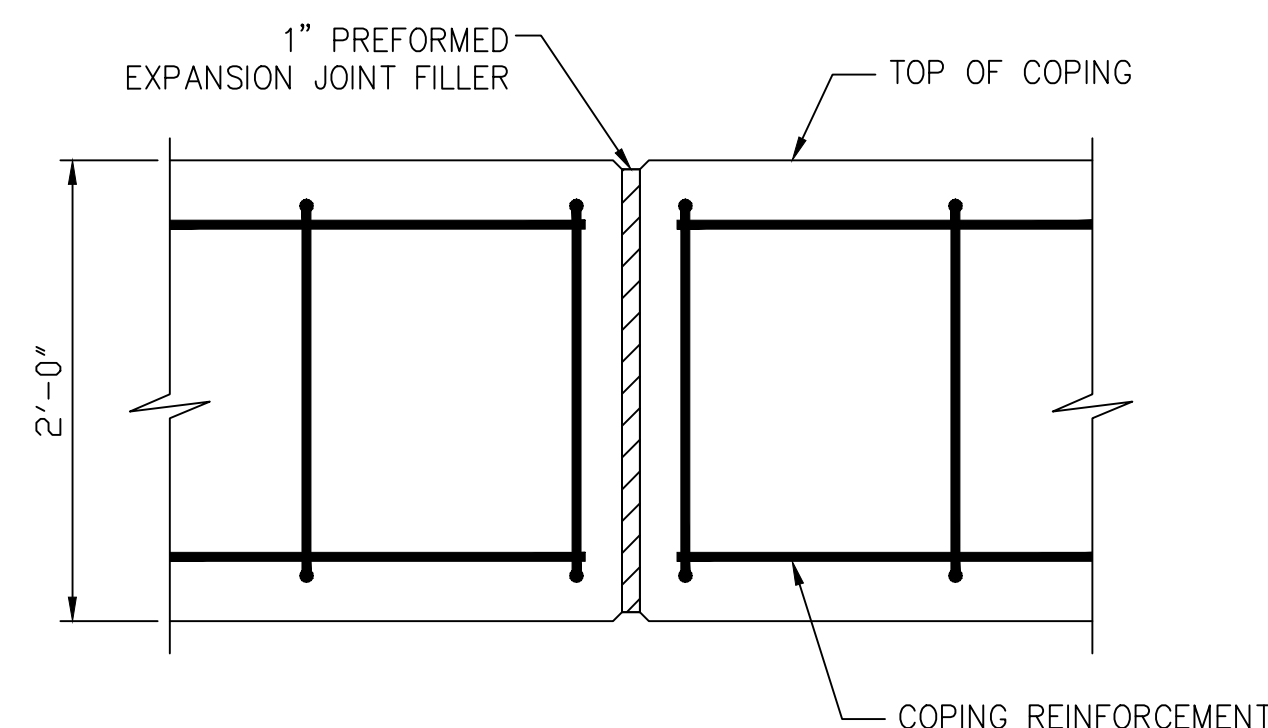

COPING EXPANSION JOINT - ELEVATION

COPING JOINTS SHALL ALIGN WITH JOINTS BETWEEN MSE WALL PANELS. COPING JOINTS SHALL NOT BE LOCATED MORE THAN 20 FEET APART. THE CONTRACTOR SHALL COORDINATE JOINT LAYOUT WITH DETAILS OF ACTUAL PROPRIETARY WALL CONSTRUCTED.

CERTIFIED WITH RESPECT TO INTERNAL STABILITY OF REINFORCED EARTH STRUCTURES ONLY.






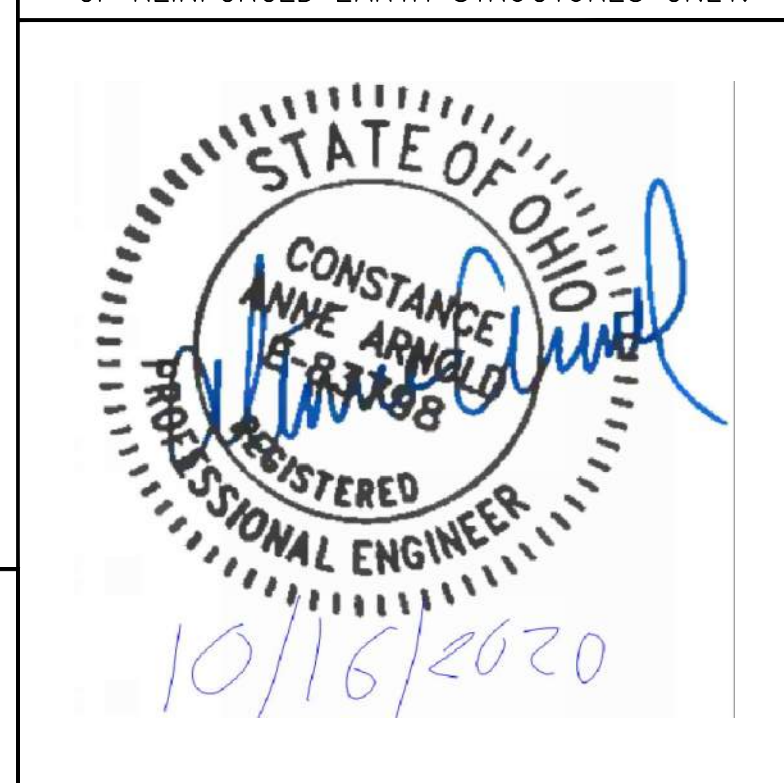


This drawing contains information proprietary to The Reinforced Earth Company, and is being furnished for the use of The Ohio Department of Transportation only in connection with this project, and the information contained is not to be transmitted to any other organization unless specifically authorized in writing by The Reinforced Earth Company. The Reinforced Earth Company is the exclusive licensee in the United States under patents held by our affiliated companies, and the furnishing of this drawing does not constitute an expressed or implied license under any applicable patents.



The design contained on these drawings is based on information provided by the Owner. On the basis of this information, The Reinforced Earth Company has designed, and is responsible for the internal stability of the structure only. External stability, including foundation (bearing capacity and settlement) and global stability (including sliding and rotation), is the responsibility of the Owner.



- PANEL GEOTEXTILE SHALL BE FIRMLY AFFIXED TO BACK OF PANEL AS SHOWN USING ADHESIVE SUPPLIED BY THE REINFORCED EARTH CO. APPLY ADHESIVE ON BACK FACE OF PANELS AND NOT ON GEOTEXTILE. DO NOT APPLY ADHESIVE WITHIN 2" OF PANEL JOINTS.
- PANEL GEOTEXTILE SHALL BE APPROXIMATELY CENTERED ON JOINTS.
- PANEL GEOTEXTILE SHALL HAVE A 12" MIN. OVERLAP. VERTICAL GEOTEXTILE SHALL OVERLAP HORIZONTAL GEOTEXTILE. WHEN TWO VERTICAL GEOTEXTILES OVERLAP, THE UPPER PIECE SHALL OVERLAP THE LOWER. PANEL GEOTEXTILE IS NOT REQUIRED AT THE INTERFACE BETWEEN PANEL AND LEVELING PAD UNLESS OTHERWISE NOTED IN THE DESIGN DRAWINGS.

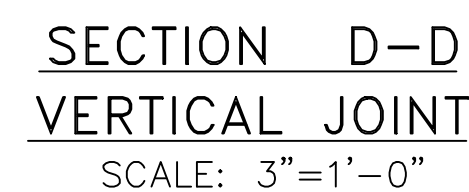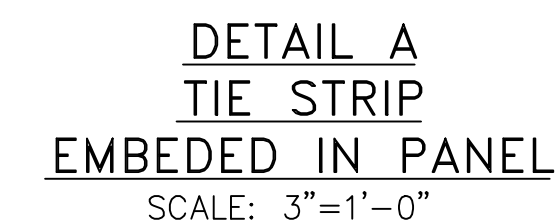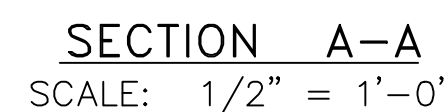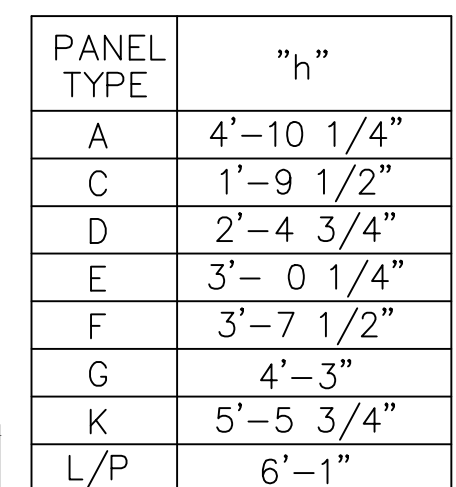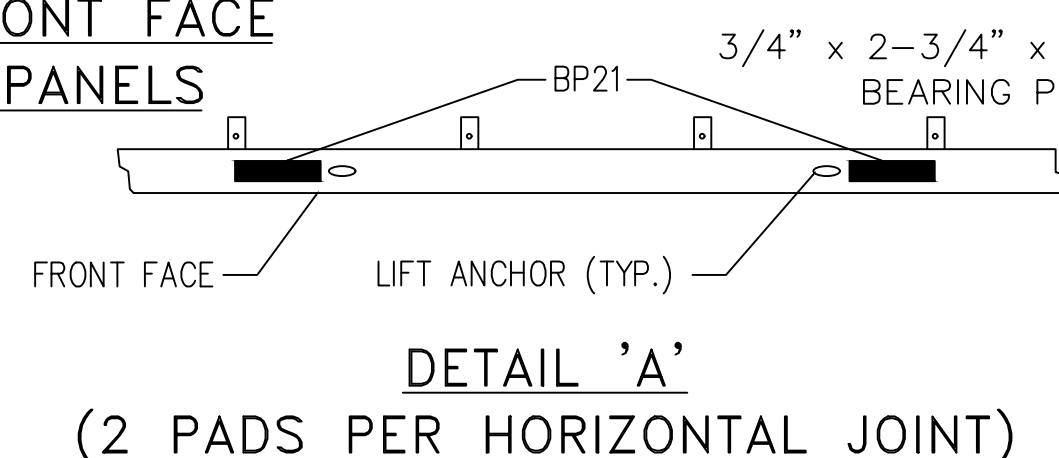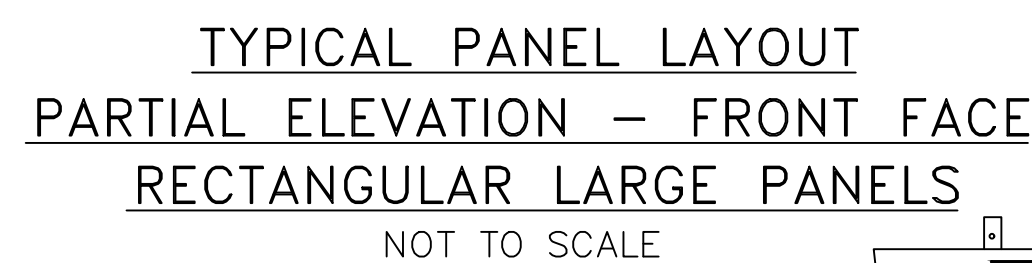

1. REINFORCING STEEL TO BE ASTM 615, GRADE 60, EPOXY COATED PER ASTM A 775.
2. ALL PANEL TYPES AND OTHER RELATED ELEMENTS WILL BE DETAILED ON SHOP DRAWINGS.
3. ALL PANELS SHALL HAVE TWO LIFTING INSERTS OF MINIMUM TWO TON CAPACITY EACH.
4. PANEL DESIGN THICKNESS IS 5 1/2" THICKNESS OF CONCRETE.
5. CONCRETE COVER OVER ALL REINFORCEMENT TO BE 1 1/2" MINIMUM.

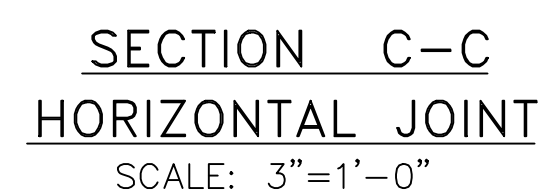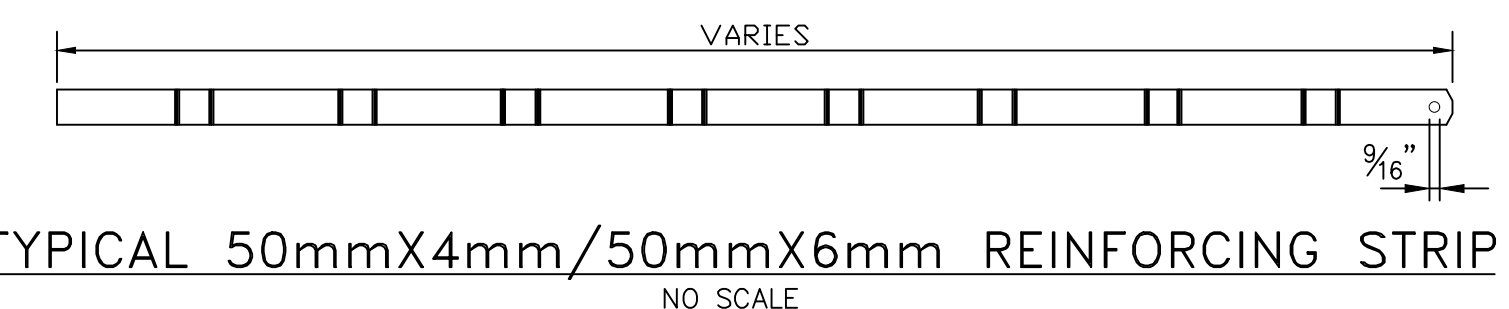


This drawing contains information proprietary to The Reinforced Earth Company, and is being furnished for the use of The Ohio Department of Transportation only in connection with this project, and the information contained is not to be transmitted to any other organization unless specifically authorized in writing by The Reinforced Earth Company. The Reinforced Earth Company is the exclusive licensee in the United States under patents held by our affiliated companies, and the furnishing of this drawing does not constitute an expressed or implied license under any applicable patents.

The design contained on these drawings is based on information provided by the Owner. On the basis of this information, The Reinforced Earth Company has designed, and is responsible for the internal stability of the structure only. External stability, including foundation (bearing capacity and settlement) and global stability (including sliding and rotation), is the responsibility of the Owner.

CERTIFIED WITH RESPECT TO INTERNAL STABILITY
OF REINFORCED EARTH STRUCTURES ONLY.




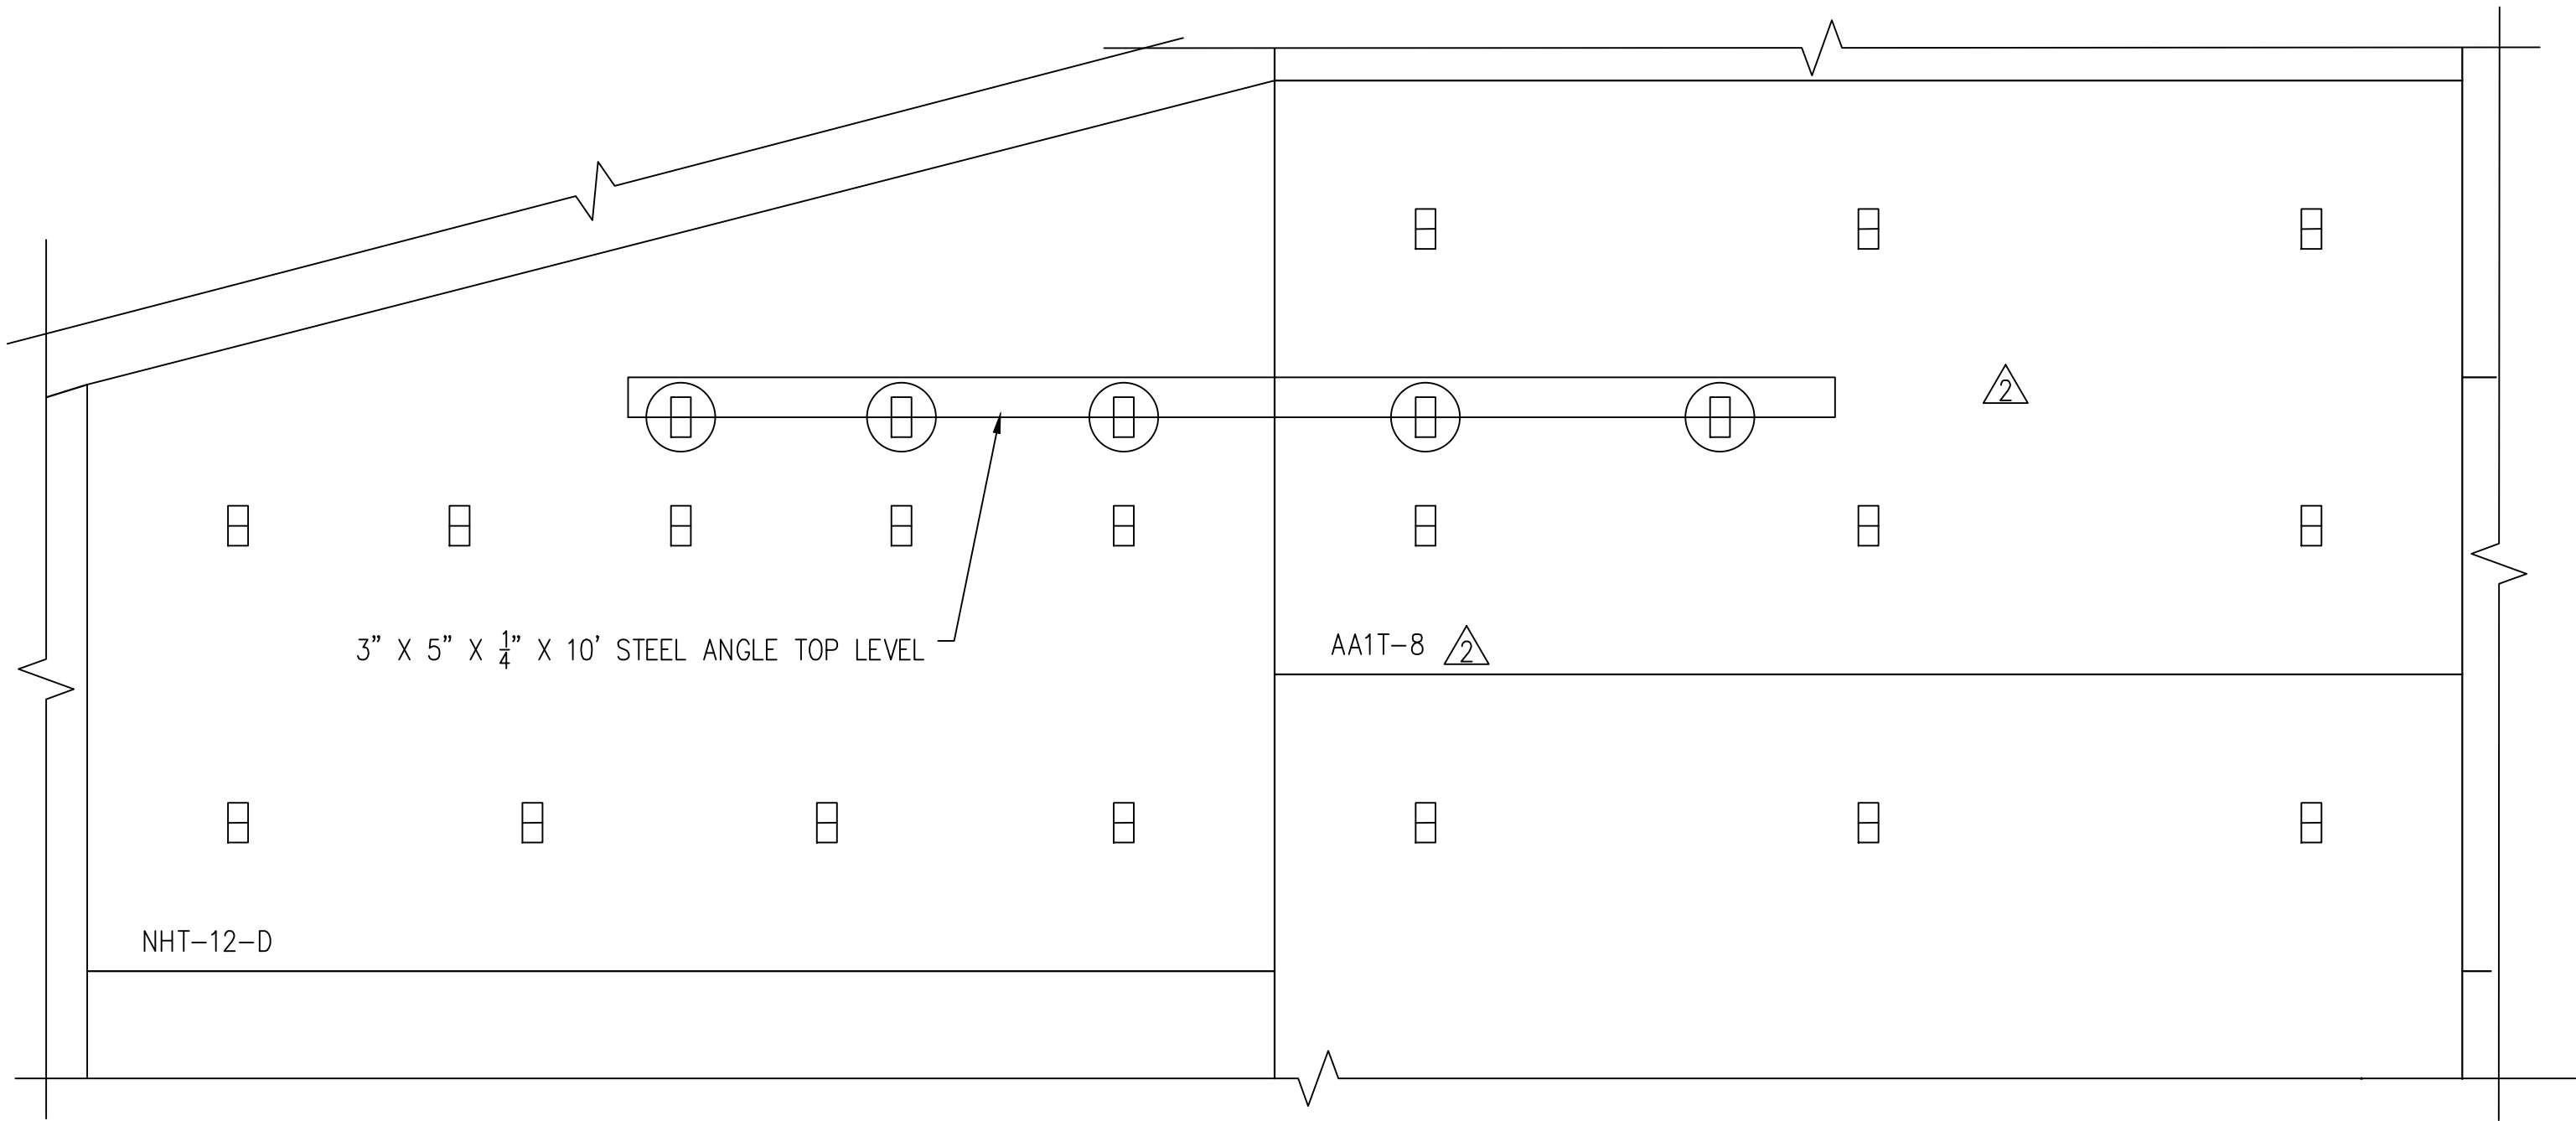

PARTIAL ELEVATION – STEEL ANGLE AT TOP STRIP LEVEL COLUMN 3
SCALE: 3/4" = 1'-0"


- TIE STRIP WITH NO REINFORCING STRIP CONNECTED
- TIE STRIP WITH REINFORCING STRIP CONNECTED

IMPORTANT NOTE: ONLY THE TIE STRIP LEVEL AT THE ANGLE DOES NOT HAVE REINFORCING STRIPS ATTACHED. CONTRACTOR SHALL ATTACH REINFORCING STRIP TO TIE STRIP AT ALL OTHER LOCATION.

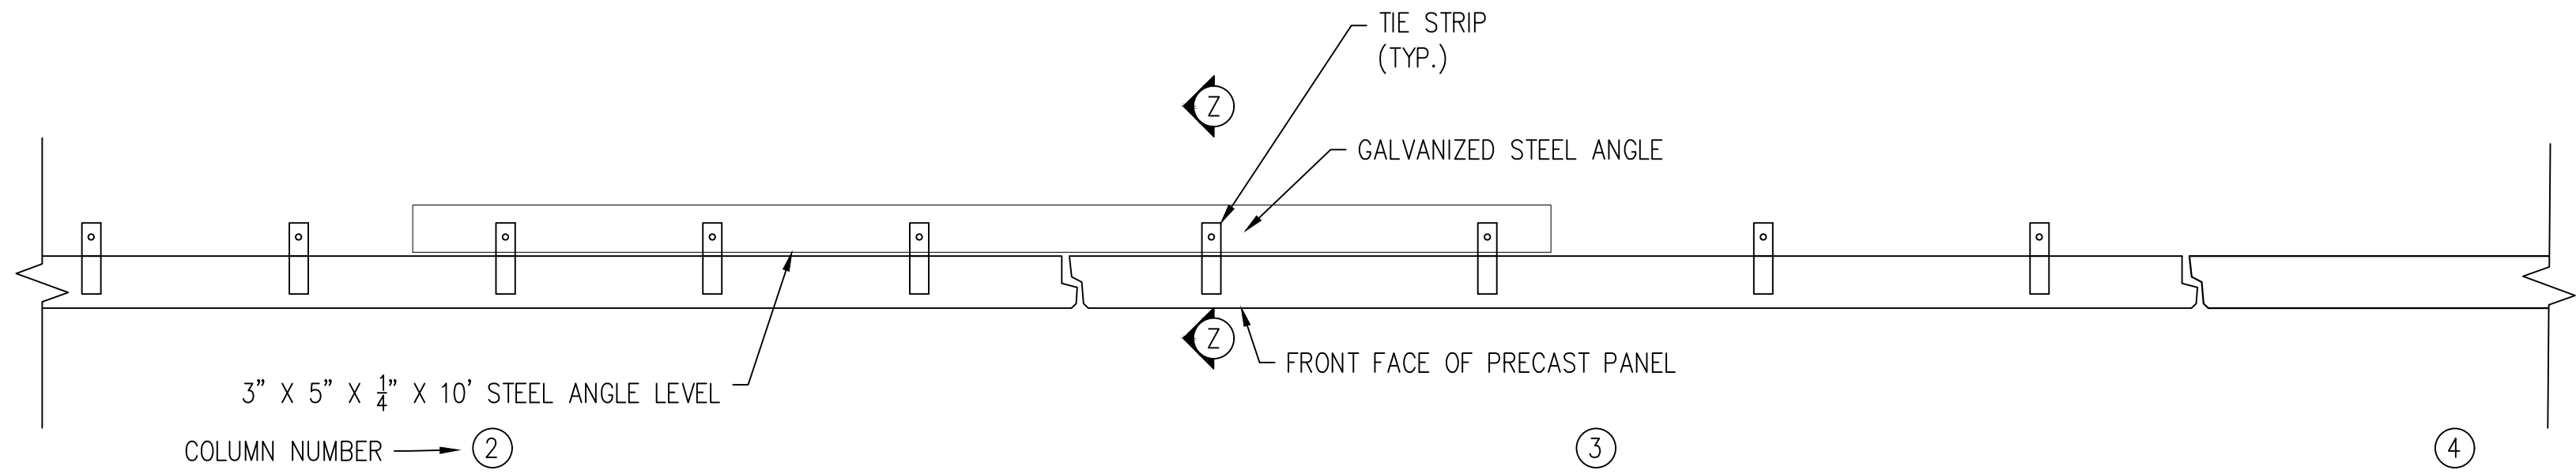

PARTIAL PLAN – STEEL ANGLE AT TOP STRIP LEVEL COLUMN 3
SCALE: 3/4" = 1'-0"

NOTES:
1. DETAIL SHOWN SCHEMATICALLY, FIELD CONDITIONS MAY VARY.

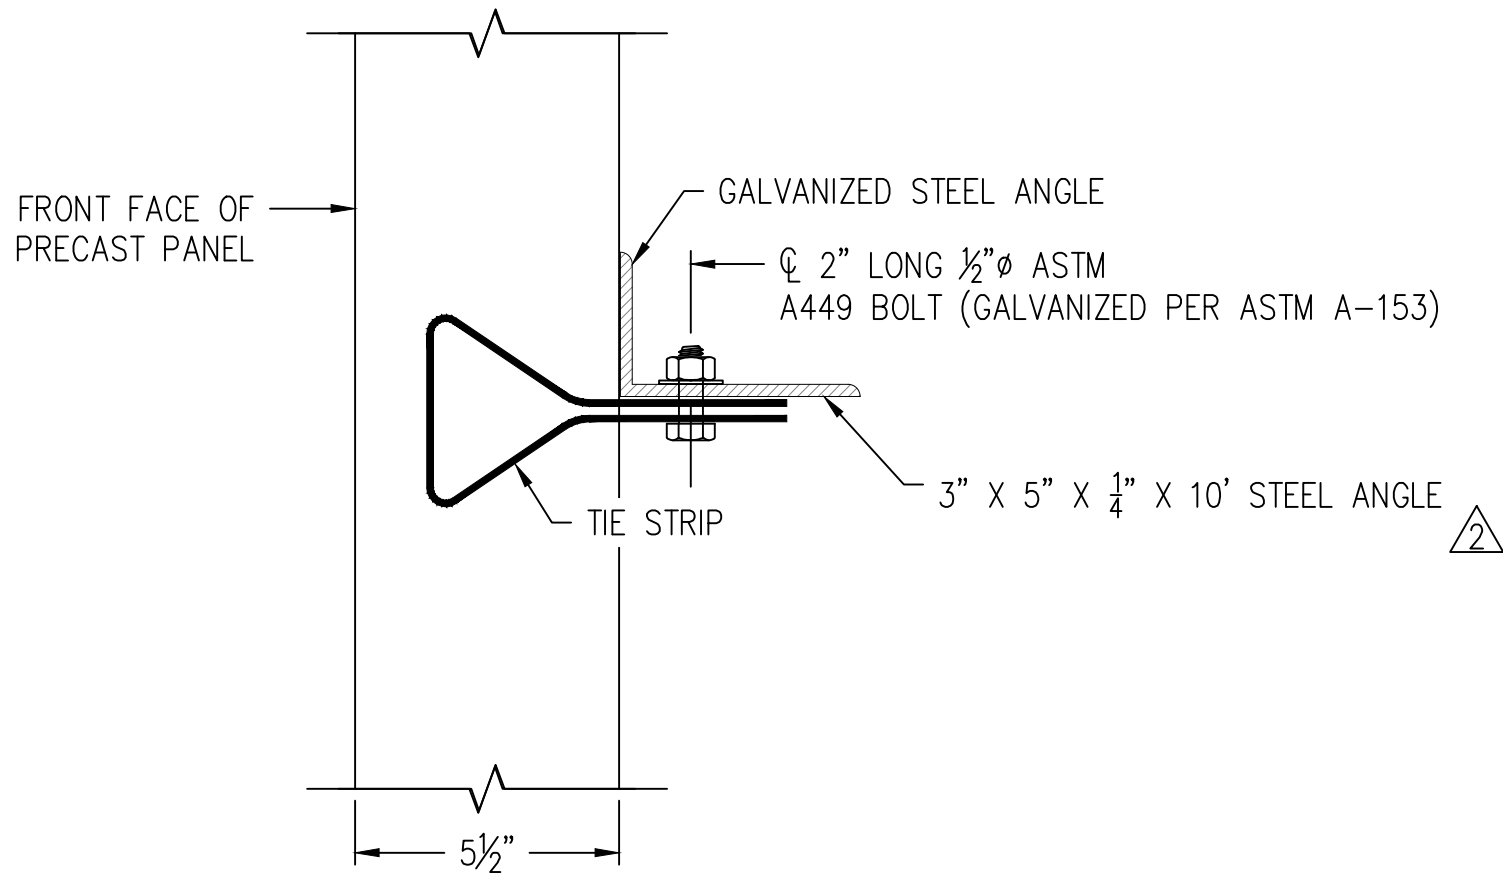


SECTION Z-Z (ANGLE BOLTED TO TIE STRIP WITHOUT REINFORCING STRIP)
SCALE: 3" = 1'-0"

NOTE: ARCHITECTURAL FINISH NOT SHOWN IN ABOVE SECTIONS AND PLAN

This drawing contains information proprietary to The Reinforced Earth Company, and is being furnished for the use of The Ohio Department of Transportation only in connection with this project, and the information contained is not to be transmitted to any other organization unless specifically authorized in writing by The Reinforced Earth Company. The Reinforced Earth Company is the exclusive licensee in the United States under patents held by our affiliated companies, and the furnishing of this drawing does not constitute an expressed or implied license under any applicable patents.

The design contained on these drawings is based on information provided by the Owner. On the basis of this information, The Reinforced Earth Company has designed, and is responsible for the internal stability of the structure only. External stability, including foundation (bearing capacity and settlement) and global stability (including sliding and rotation), is the responsibility of the Owner.

CERTIFIED WITH RESPECT TO INTERNAL STABILITY OF REINFORCED EARTH STRUCTURES ONLY.

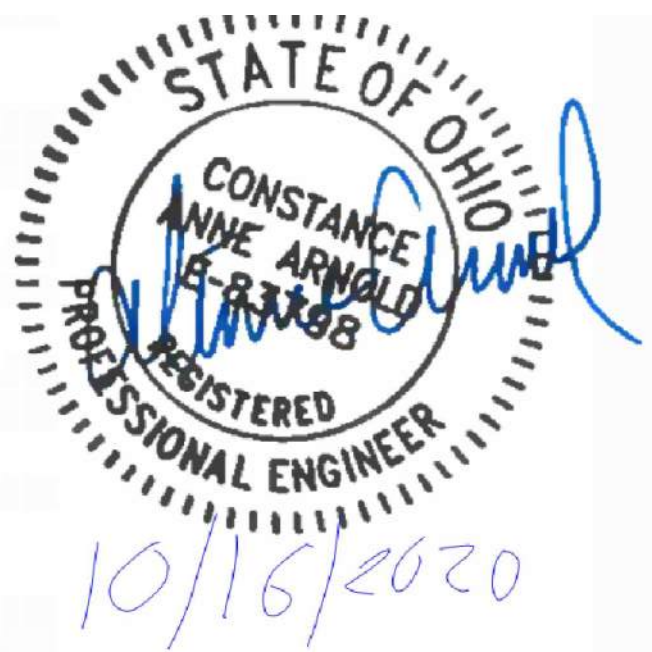

△	10/15/20	REVISED PER ODOT COMMENT
△	6/4/20	REVISED PER 2LMN COMMENT

The Reinforced Earth Company
45610 Woodland Rd., Suite 200, Sterling, VA 20166

Reinforced Earth is a Trademark of the Reinforced Earth Co.

Reinforced Earth Project No.: 18631
Designed by: MS Checked by: CA 4/27/2020

18631
CUY-IR490/SR010-2.09/19.28
CITY OF CLEVELAND, CUYAHOGA COUNTY, OHIO

Rev 3 12/23/2020

TITLE: MSE Wall Design Submittal

Corrosion Design	2
Design Parameters	3
MSE Calculations	4-8

REVISED CALCULATIONS DUE TO
CHANGE IN ABUTMENT STRAP LAYOUT
- REVISED 12/23/20

CERTIFIED WITH RESPECT TO THE
INTERNAL STABILITY OF REINFORCED
EARTH STRUCTURES ONLY





Appendix A

MSE Wall Acceptance Letter

Project No.	PID 96833
Wall No.	REAR ABUTMENT
Name of Accredited MSE Wall System	REINFORCED EARTH

Design Data	
Design Life	100 years
Angle of Internal Friction – Reinforced Soil Zone	34 degrees
Actual Bearing Pressure at base of reinforced soil mass	4.6 KSF
Allowable Bearing Pressure at base of reinforced soil mass (Reproduced from project plans)	18.46 KSF

I hereby certify that the design calculations for the internal stability of the mechanically stabilized earth retaining structure and the detail drawings included in this construction submission are in complete conformance with the MSE wall Supplemental Specification 840 and either the AASHTO Standard Specifications for Highway Bridges, 17th Edition, 2002 or the AASHTO LRFD Bridge Design Specifications, that were used to develop the project plans. I further certify that the design data provided above and data assumed for the design calculation submitted herein is accurate for the above referenced wall.

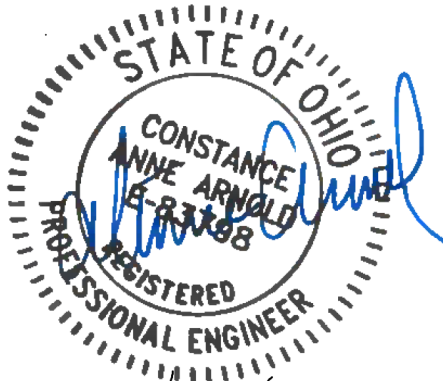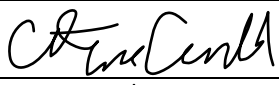Engineer's Seal

Signature: 
Date: 4/30/20


(Provide an MSE Wall Acceptance Letter for each wall designated in the project plans.)

JOB NUMBER: 18631
 JOB NAME: OC3
 DESIGNED BY: MS

Galvanization and Carbon Steel Loss Rates:

Design Life of Structure = 100 yrs
 Zinc (first 2 years): **15** $\mu\text{m/yr}$
 Zinc (subsequent years): **4** $\mu\text{m/yr}$
 Carbon Steel: **12** $\mu\text{m/yr}$

Carbon Steel (75 - 100 yrs) **12** $\mu\text{m/yr}$

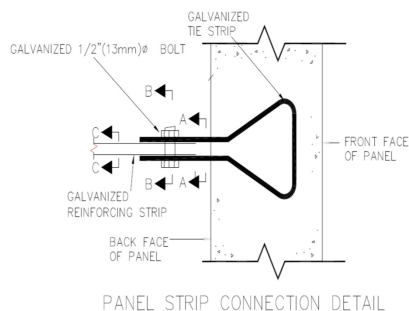

Mechanical Properties of Reinforcement Hardware

	<u>HA Strip</u>	<u>Tie Strips</u>		<u>Thickness of Zinc Coat.</u>
Thickness t (mm)=	4	3.42	Zinc coat t_z =	86 $\mu\text{m/yr}$
Width w (mm)=	50	50	Life of Zinc:	16 yrs
A (mm^2) =	200	171	<u>Bolt Set.</u>	
Fu (Ksi) =	80	65	$\varnothing = d =$	12.7 mm = 0.50 in.
Fy (Ksi) =	65	50	Fu =	120 Ksi

TENSILE RESISTANCE OF REINFORCING STRIP & CONNECTORS. LRFD METHOD

Tensile Resistance Resistance Factor for Metallic Reinforcement and connectors= $\Phi = 0.75$

Section A-A (Tie Strip Only), 2 Tie Strip plates

At end of design life, carbon steel loss : 1.008mm/side, Remaining Thickness (1 plate) = $3.420 - 2 \times 1.008 = 1.404\text{mm}$

As (2 plates) = $1.404 \times 2 \times 50 = 140.400\text{mm}^2$ or 0.218in², Factored Tensile Resistance= $\Phi F_y A_s = 8.16\text{Kips}$

Section B-B (Reinforcing Strip at Bolt Holes)

At end of design life, carbon steel loss : 0mm/side, Thickness = 4.00mm

As = $4.00 \times (50.000 - 14.3) = 142.80\text{mm}^2$ or 0.22 in²

Factored Tensile Resistance= $\Phi F_u A_s = 13.28\text{Kips}$

Factored Bearing Resistance at bolt hole= $\Phi R_n = \Phi(2.4 d t F_u) = 11.34\text{Kips}$

Section B-B (Tie Strip at Bolt Holes), 2 tie strip plates with 14.3mm bolt holes.

At end of design life, carbon steel loss : 1.008mm/side, Remaining Thickness (1 plate, corrosion on 1 side) = $3.420 - 1.008 = 2.412$

A (2 plates) = $2.412 \times 2 \times [50 - 14.3] = 172.217\text{mm}^2$ or 0.267in²

Factored Tensile Resistance= $\Phi F_u A_s = 13.01\text{Kips}$

Factored Bearing Resistance at bolt hole= $\Phi R_n = \Phi(2.4 d t F_u) = 11.11\text{Kips}$

Section B-B (Shear Resistance of Bolt)

At end of design life, carbon steel loss : 0mm/side, Area of Bolt = $126.68\text{mm}^2 = 0.1963\text{in}^2$

Factored Shear Resistance = $\Phi R_n = \Phi(0.48 F_u A_b N_s) = 16.96\text{Kips}$

Section C-C (Reinforcing Strip)

At end of design life, carbon steel loss : 1.008mm/side, Remaining Thickness = $4.000 - 2 \times 1.008 = 1.984\text{mm}$

As = $1.984 \times 50 = 99.200\text{mm}^2$ or 0.154in², Factored Tensile Resistance= $\Phi F_y A_s = 7.50\text{Kips}$

RESULTS:

Section A-A (Tie Strip)= 8.16Kips

Section B-B (TS at bolt hole), a) Factored Tensile Resistance= 13.01Kips

b) Factored Bearing Resistance @ bolt hole= 11.11Kips

Section B-B (RS at bolt hole), a) Factored Tensile Resistance= 13.28Kips

b) Factored Bearing Resistance @ bolt hole= 11.34Kips

Section B-B (Bolt)= 16.96Kips

Section C-C (Reinf. Strip)= 7.50Kips, CONTROLS

JOB NUMBER :18631
 Job Name : OC3
 Designed By : MS

04/28/20

Reinforced Earth Design Calculations

LRFD METHOD - AASHTO, 2015

Material Properties

REINFORCING STRIPS and/or LADDER REINFORCING STRIPS $F_y = 65\text{Ksi}$

Wall Geometry

HEIGHT OF WALL = H ft

SOIL REINFORCEMENT LENGTH = B ft

Soils Properties

	Unit Weight - Kcf	$\Phi(\text{deg})$	Cohesion -Ksf	K_a (Rankine)	K_o	$f^*_{\text{max@ground surface, Steel Strips}}$
Select Material	0.120	34.00	-	0.28	0.44	2.000
Random fill	0.120	30.00	0.00	0.33	-	
Foundation	-	30.00	0.00			

$f^* = \text{Apparent Coefficient Of Friction (Bond)} = 2.000 \text{ @ top, } f^*_{\text{min at 20ft depth}} = 0.675$

Load and Resistance Factors

	BEARING PRESSURE & REINFORCEMENT TENSION & PULL-OUT	Strength I (Static)	Extreme Event I (Seismic)
Vertical Dead Load (MSE Backfil-) -Tension & Pull-Out force in Internal Stability		1.35	1.35
Vertical Dead Load, Pull-Out Resisting force.		1.00	1.00
Horizontal Earthpressure due to Random Backfill		1.50	1.00
Horizontal Earthpressure due to Live Load surcharge		1.75	0.50
Live Load Weight		1.75	0.50
Dynamic Earthpressure and RE mass Dynamic Inertia Force (Extreme Event I)		----	1.00
Tensile Resistance of soil reinforcements		0.75	1.00
Resistance Factor for Pull Out of Strips (Internal Stability).		0.90	1.20
<u>SLIDING & OVERTURNING</u>			
Vertical Dead Load		1.00	1.00
Horizontal Earthpressure due to Random Backfill		1.50	1.00
Horizontal Earthpressure due to Live Load surcharge		1.75	0.50
Dynamic Earthpressure and RE mass Dynamic Inertia Force (Extreme Event I)		----	1.00
Resistance Factor for Base Sliding (Mass Stability)		1.00	1.00

Wind on Structures (Strength III), Load Factor = 1.40, AASHTO 2015 and before

Vehicular Collision Force (Extreme Event II) Load Factor = 1.00

Equivalent Height For Traffic Surcharge (Where Applicable)=2.08ft or 0.25Ksf

Coefficient Of Friction At Foundation Level (Sliding) = 0.58

Tributary Panel Width = 9.84ft, Vertical spacing of reinforcement =2.46ft

Horizontal Stress @ Facing= 100% Of Maximum Stress @ Line Of Active Zone. .

Factored Maximum Reinforcement Tension = 7.50Kips / strip

These calculations are furnished exclusively for the use in connection with this project. These calculations contain information proprietary to the Reinforced Earth Company. Except as specifically authorized in writing by the Reinforced Earth Co., possession of these calculations does not authorize use of proprietary information contained therein, nor transmission to any other organization of the calculations or of information contained therein.

MASS STABILITY AND MAXIMUM BEARING PRESSURE - LRFD STATIC , RANKINE'S THEORY

$$H = 26.62\text{ft}, H(\text{active zone}) = 26.62\text{ft}, B = 19.00\text{ft}$$

OHIO -LRFD
DESIGN TYPE : LEVEL SURCHARGE


Equiv. height Traffic Live Load Surcharge= 2.08ft or 0.25Ksf. Equiv. height Train/Crane Surch. 0.00ft or 0.00Ksf @ 0.00ft clear from panel & over 0.00ft width

Coeff. Active Earthpressure= $K_a = 0.3333$

Foundation, Coeff. of friction @ bott/wall=0.58, Cohesion=0.00Ksf, Tributary width= 9.84ft

$f^* =$ Coefficient of apparent friction @ finished grade = 2.00

Select Fill $\gamma = 0.120\text{Kcf}$, $\Phi = 34.00^\circ$, Rand. Fill $\gamma = 0.120\text{Kcf}$, $\Phi = 30.00^\circ$, Rand. Cohes=0.00Ksf -

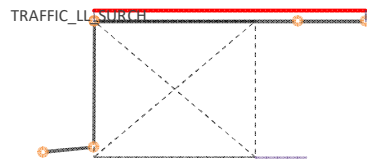
STATIC MASS STABILITY -FACTORED

VERTICAL LOADS (Kips)	Arm (ft)	Moment (Kip-ft)
60.69	9.50	576.6
0.00	19.00	0.0
0.00	19.00	0.0
0.00	0.00	0.0
0.00 Crane/Footg weight	9.50	0.0
0.00 VertComp.Pa	19.00	0.0
0.00 VertComp.Ps	19.00	0.0
0.00 VertComp.Ppsv	19.00	0.00
60.69		576.59

FACTORED HORIZONTAL LOADS, RANKINE'S THEORY

21.26 HorizCompontPa	8.87	188.6	Soil
3.88 HorizCompontPs	13.31	51.6	Traffic LiveLoad
0.00 HorizComp.Ppsv	13.31	0.0	Train/Crane Surch
25.13		240.22	

CAPACITY/DEMAND RATIO (CDR)

- 1) OVERTURNING 2.40 ≥ 1.0 , OK
2) SLIDING 1.39 ≥ 1.0 , OK

Bearing Pressure

STATIC MASS STABILITY -FACTORED VERTICAL LOAI			Arm (ft)	MOMENT (Kip-ft)		
1.35DL	1.00DL	1DL +0.0LL		1.35DL	1.00DL	1DL +0.0LL
81.94	60.69	60.69	9.50	778.4	576.6	576.6
0.00	0.00	0.00	19.00	0.0	0.0	0.0
0.00	0.00	0.00	19.00	0.0	0.0	0.0
8.30	8.30	0.00	9.50	78.8	78.8	0.0
90.24	68.99	60.69		857.2	655.4	576.6

HORIZONTAL LOADS (SAME AS FOR MASS STABILITY, static case)

1.35DL factor, Eccent. = 2.66ft $\leq B/3.00 = 6.33\text{ft}$, OK, Factored Bearing Pressure = 6.60Ksf

1.00DL, Eccent. = 3.48ft $\leq B/3.00 = 6.33\text{ft}$, Factored BP = 5.73Ksf

1.00DL+0.0 LL, Eccent. = 3.96ft $\leq B/3.00 = 6.33\text{ft}$, OK, Factored BP = 5.48Ksf

Unfactored Bearing Pressure @ toe of wall = 4.59Ksf

REINFORCED EARTH INTERNAL STABILITY SUMMARY - Coherent Gravity Method LargeRectangPanel
Steel Strips

LEVEL	Factored Horiz. Stress σ_h @ Fac'g -Ksf	Density Strips 50x4mm	Factored Tension $\leq 7.50\text{Kips}$	Factored Stress σ_h (Bond)-Ksf	Effective Length CDR ≥ 1.0	Reinforc. Length	Minimum Density Req'd
2.000	0.32	3	2.62	0.14	1.30	19.00ft	(2.30)
5.710	0.55	4	4.16	0.38	1.27	19.00ft	(3.16)
8.170	0.68	3	5.52	0.52	1.11	19.00ft	(2.71)
10.630	0.81	3	6.56	0.66	1.01	19.00ft	(2.96)
13.090	0.93	4	5.65	0.79	1.21	19.00ft	(3.29)
15.550	1.05	4	6.34	0.91	1.20	19.00ft	(3.38)
18.010	1.16	4	7.01	1.03	1.14	19.00ft	(3.74)
20.470	1.28	5	6.20	1.16	1.33	19.00ft	(4.14)
22.930	1.49	5	7.21	1.38	1.38	19.00ft	(4.81)
25.390	1.73	6	6.98	1.62	1.69	19.00ft	(5.59)

COMMENTS:Case 02


DESIGNED : MS

JOB NUMBER :18631

JOB NAME :OC3

4/28/20

(H = 18.00ft , H' = 26.94ft, B = 20.00ft)

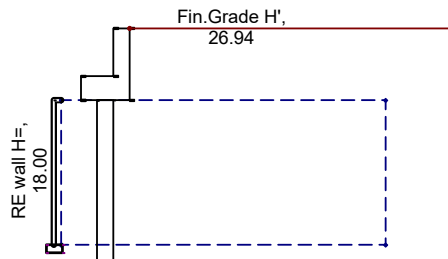STATIC, STRENGTH I - - OHIO -LRFD
LRFD-MASS STABILITY AND MAXIMUM BEARING PRESSURE -STATIC CASE, RANKINE'S THEORY

FACTORED VERTICAL FORCES

	V - Kips	Arm - ft	MOMENT
1. R.E. mass =V1	43.20	10.00	432.00
2. Soil mass behind backwall =V2 =	15.24	12.90	196.58
3. Vertical component of Earthpressure =	0.00	20.00	0.00
4. Vertical component of Surcharge Earthpressure =	0.00	20.00	0.00
5. Vertical component of Seismic Earthpressure Pae =	0.00	20.00	0.00
Σ VERT. FORCES, static case=	58.44		628.58
Σ VERT. FORCES, seismic case=	58.44		628.58

FACTORED HORIZONTAL FORCES

	H	Arm	MOMENT
1. Earthpressure Pa	21.77	8.98	195.52
2. Earthpressure due to surcharge=Ps	3.92	13.47	52.84
3. Seismic forces a) Inertia forces($P_{ir1}+P_{ir2}+P_{irPanel}$)	0.00		0.00
b) Dynamic earthpressure Pae	0.00		0.00
STATIC ΣH =SUM HORIZ. FORCES= P_a+P_s =	25.70		248.36

CAPACITY/DEMAND RATIO (CDR)

STATIC CASE

 SLIDING = 1.31 ≥ 1.0 O.K.
 OVERTURNING = 2.53 ≥ 1.0 O.K.

LRFD METHOD - Mass Bearing Pressure
FACTORED VERTICAL FORCES

	V Kips	Arm ft	MOMENT Kip-ft
1. V1	58.32		583.20
2. Soil mass behind backwall =V2 =	20.58	12.90	265.38
3. Surcharge	6.21		80.04
SUM VERT. FORCES=	85.11		928.62

 Horizontal Forces and Overturning moment, see STATIC ΣH =SUM HORIZ. FORCES= P_a+P_s = above

Eccentricity from soil loads and surcharge = 2.01ft

Factored Vertical pressure from soil loads and surcharge = 5.32Ksf

Unfactored Vertical pressure from soil loads and surcharge = 3.74Ksf

STUB ABUTMENT ON PILE, ABUTMENT WIDTH= 4.58ft

HEIGHT FROM TOP OF FINISHED GRADE TO BOTTOM OF ABUTMENT= 8.94ft

DISTANCE FROM BACK FACE OF PANEL TO ABUTMENT= 1.21ft

 Select Fill $\gamma=0.120$ Kcf, $\Phi=34.00^\circ$, Rand. Fill $\gamma=0.120$ Kcf, $\Phi=30.00^\circ$, Rand. Cohes=0.00Ksf -

 Coefficient of Active Earthpressure = $K_a = 0.3333$

Foundation, Coeff. of friction@ bott/wall=0.58, Cohesion=0.00Ksf, Tributary width= 9.84ft

EQUIVALENT. HEIGHT LIVE LOAD SURCHARGE = 2.08ft



COMMENTS: Case 02
JOB NUMBER : 18631

JOB NAME : OC3

DESIGNED : MS

4/28/20

REINFORCED EARTH INTERNAL STABILITY SUMMARY - Coherent Gravity Method Large Rectang Panel -
OHIO -LRFD , RANKINE'S THEORY
(H = 18.00ft , H' = 26.94ft, B = 20.00ft)

HEIGHT FROM TOP OF FINISHED GRADE TO BOTTOM OF ABUTMENT= 8.94ft
DISTANCE FROM BACK FACE OF PANEL TO ABUTMENT= 1.21ft

Select Fill $\gamma=0.120$ Kcf, $\Phi=34.00^\circ$, Rand. Fill $\gamma=0.120$ Kcf, $\Phi=30.00^\circ$, Rand. Cohes=0.00Ksf - ,
Coefficient of Active Earth pressure = $K_a = 0.3333$
 f^* = Coefficient of apparent friction @finished grade = 2.00
ANGLE OF SKEW OF REINFORCING STRIPS : 15.00DEG.
STUB ABUTMENT ON PILE, ABUTMENT WIDTH= 4.58ft

Level	Fact'd σ_h (tension) Ksf	Density Strips 50x4mm,	Factored Reinf. Tension ≤ 7.50 Kips	Fact'd σ_h (Bond) Ksf	Effect. Length CDR ≥ 1.0	Strip Length (ft)
0.75	0.64	3	5.31	0.50	1.30	20.00
2.01	0.71	3	5.91	0.58	1.20	20.00
4.47	0.84	3	6.99	0.71	1.03	20.00
6.93	0.95	4	5.95	0.83	1.34	20.00
9.39	1.06	4	6.67	0.99	1.21	20.00
11.85	1.21	5	6.08	1.14	1.41	20.00
14.31	1.36	5	6.82	1.30	1.50	20.00
16.77	1.51	6	6.32	1.46	1.87	20.00

MASS STABILITY AND MAXIMUM BEARING PRESSURE - LRFD STATIC , RANKINE'S THEORY

$$H = 24.76\text{ft}, H(\text{active zone}) = 24.76\text{ft}, B = 18.00\text{ft}$$

OHIO -LRFD
DESIGN TYPE : LEVEL SURCHARGE


Equiv. height Traffic Live Load Surcharge= 2.08ft or 0.25Ksf. Equiv. height Train/Crane Surch. 0.00ft or 0.00Ksf @ 0.00ft clear from panel & over 0.00ft width

Coeff. Active Earthpressure= $K_a = 0.3333$

Foundation, Coeff. of friction @ bott/wall=0.58, Cohesion=0.00Ksf, Tributary width= 9.84ft

$f^* =$ Coefficient of apparent friction @ finished grade = 2.00

Select Fill $\gamma = 0.120\text{Kcf}$, $\Phi = 34.00^\circ$, Rand. Fill $\gamma = 0.120\text{Kcf}$, $\Phi = 30.00^\circ$, Rand. Cohes=0.00Ksf -

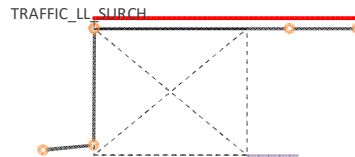
STATIC MASS STABILITY -FACTORED

VERTICAL LOADS (Kips)	Arm (ft)	Moment (Kip-ft)
53.48	9.00	481.3
0.00	18.00	0.0
0.00	18.00	0.0
0.00	0.00	0.0
0.00 Crane/Footg weight	9.00	0.0
0.00 VertComp.Pa	18.00	0.0
0.00 VertComp.Ps	18.00	0.0
0.00 VertComp.Ppsv	18.00	0.00
53.48		481.33

FACTORED HORIZONTAL LOADS, RANKINE'S THEORY

18.39 HorizCompontPa	8.25	151.8 Soil
3.61 HorizCompontPs	12.38	44.6 Traffic LiveLoad
0.00 HorizComp. Ppsv	12.38	0.0 Train/Crane Surch
22.00		196.42

CAPACITY/DEMAND RATIO (CDR)

- 1) OVERTURNING 2.45 ≥ 1.0 , OK
2) SLIDING 1.40 ≥ 1.0 , OK

Bearing Pressure

STATIC MASS STABILITY -FACTORED VERTICAL LOAI	Arm (ft)	MOMENT (Kip-ft)
1.35DL 1.00DL 1DL +0.0LL		1.35DL 1.00DL 1DL +0.0LL
72.20 53.48 53.48	9.00	649.8 481.3 481.3
0.00 0.00 0.00	18.00	0.0 0.0 0.0
0.00 0.00 0.00	18.00	0.0 0.0 0.0
7.86 7.86 0.00	9.00	70.8 70.8 0.0
80.06 61.34 53.48		720.6 552.1 481.3

HORIZONTAL LOADS (SAME AS FOR MASS STABILITY, static case)

1.35DL factor, Eccent. = 2.45ft $\leq B/3.00 = 6.00\text{ft}$, OK, Factored Bearing Pressure = 6.11Ksf

1.00DL, Eccent. = 3.20ft $\leq B/3.00 = 6.00\text{ft}$, Factored BP = 5.29Ksf

1.00DL+0.0 LL, Eccent. = 3.67ft $\leq B/3.00 = 6.00\text{ft}$, OK, Factored BP = 5.02Ksf

Unfactored Bearing Pressure @ toe of wall = 4.25Ksf

REINFORCED EARTH INTERNAL STABILITY SUMMARY - Coherent Gravity Method LargeRectangPanel
Steel Strips



LEVEL	Factored Horiz. Stress σ_h @ Fac'g -Ksf	Density Strips 50x4mm	Factored Tension $\leq 7.50\text{Kips}$	Factored Stress σ_h (Bond)-Ksf	Effective Length CDR ≥ 1.0	Reinforc. Length	Minimum Density Req'd
2.000	0.32	3	2.62	0.14	1.25	18.00ft	(2.40)
3.850	0.44	3	3.55	0.26	1.20	18.00ft	(2.50)
6.310	0.58	3	4.71	0.41	1.12	18.00ft	(2.68)
8.770	0.72	3	5.81	0.56	1.04	18.00ft	(2.90)
11.230	0.85	4	5.13	0.70	1.25	18.00ft	(3.19)
13.690	0.97	4	5.88	0.83	1.20	18.00ft	(3.33)
16.150	1.09	4	6.60	0.96	1.18	18.00ft	(3.52)
18.610	1.21	4	7.31	1.08	1.10	18.00ft	(3.90)
21.070	1.36	5	6.60	1.25	1.31	18.00ft	(4.40)
23.530	1.60	6	6.44	1.49	1.62	18.00ft	(5.16)

JOB NUMBER :18631
 JOB NAME : OC3
 COMMENTS : Rear Abutment



DESIGNED : MS
 DATE : 12/23/2020

LRFD Method - STRENGTH I

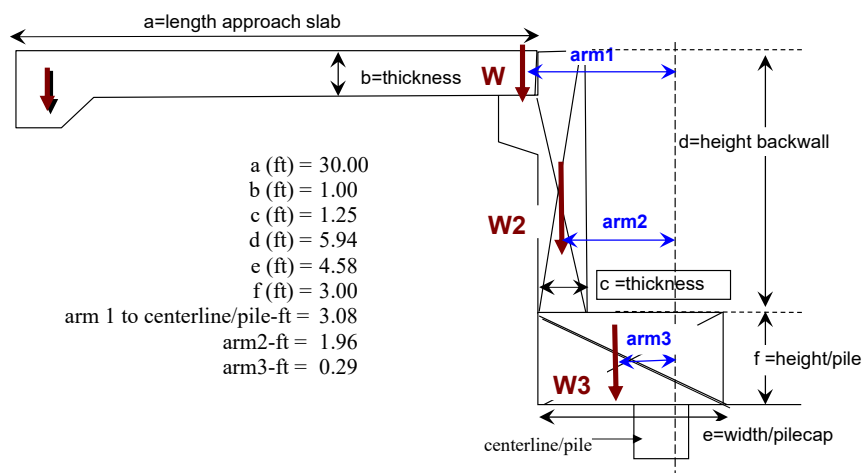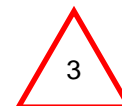

Select Backfl = 0.120Kcf, $\phi_{sel} = 34.00\text{deg.}$, $K_a = 0.283$

Equivalent height of LL Surcharge = 2.08ft

Height Of Abutment = 8.94, Abutment Length = 18.83ft, Strip Skew Angle = 0.0 deg

Height Of Pile Cap = 3.00, Height Of Bearing Pad = 0.10ft

Steel Strips, $f^* =$ Apparent Coefficient Of Friction (Bond)=2.000 @ top, f^*_{min} at 20ft depth = 0.675

FACTORED VERTICAL FORCES (Kips per ft)

	ARM	STABILIZING MOMENT
W1=	3.08	6.93
W2=	1.96	2.18
W3=	0.29	0.60
		9.71 Kip-ft/ft

FACTORED HORIZONTAL FORCES (Kips per ft)

	ARM	OVERTURNING MOMENT
HORIZONTAL FORCE FROM BRIDGE	3.10	11.84
EARTH PRESSURE P_s	3.97	3.89
EARTH PRESSURE P_a	2.65	4.25
SUM H=	6.41	19.98

LOCATION/RESULTANT OF HORIZONTAL FORCES FROM BOTTOM/ABUTM.SEAT = 3.12 f

TOTAL HORIZONTAL FORCE ON BRIDGE ABUTMENT = 120.61 Kips

TOTAL NET OVERTURNING MOMENT = 193.51Kip-ft

STATIC

Steel Strips, $f^* =$ Apparent Coefficient Of Friction (Bond)=2.000 @ top, f^*_{min} at 20ft depth = 0.675

	Level 1 (Bottom)	2	3
Distance to Bottom/Pile Cap - ft =	0.50	1.50	2.50
f^* @ Reinf.Strip Level =	1.44	1.51	1.57
Number of Strips requ'd(pcs) =	8 @ 2.55ft O.C.	8 @ 2.55ft O.C.	8 @ 2.55ft O.C.
Strip Length (ft) =	16.000 ft	16.000 ft	16.000 ft
Leff. =	15.71 ft	15.13 ft	14.56 ft
FACTORED RESISTANCE IN FRICTION =	54.14 Kips	48.08 Kips	41.79 Kips
CDR PULL OUT =	1.35 ≥ 1.0 , O.K.	1.20 ≥ 1.0 , O.K.	1.04 ≥ 1.0 , O.K.

FACTORED Tension in Reinforcing Strip= 5.03 Kips ≤ 7.50 Kips, OK

RESISTING MOMENT STRENGTH = 27.07 Kip-ft

Total Resisting Moment STRENGTH = 203.68 Kip-ft, O.K.


5.03 Kips ≤ 7.50 Kips, ok

72.13 Kip-ft

5.03 Kips ≤ 7.50 Kips, ok

104.49 Kip-ft

LOCATION/RESULTANT OF STRAP FORCES FROM BOTTOM/ABUTM.SEAT = 1.41ft

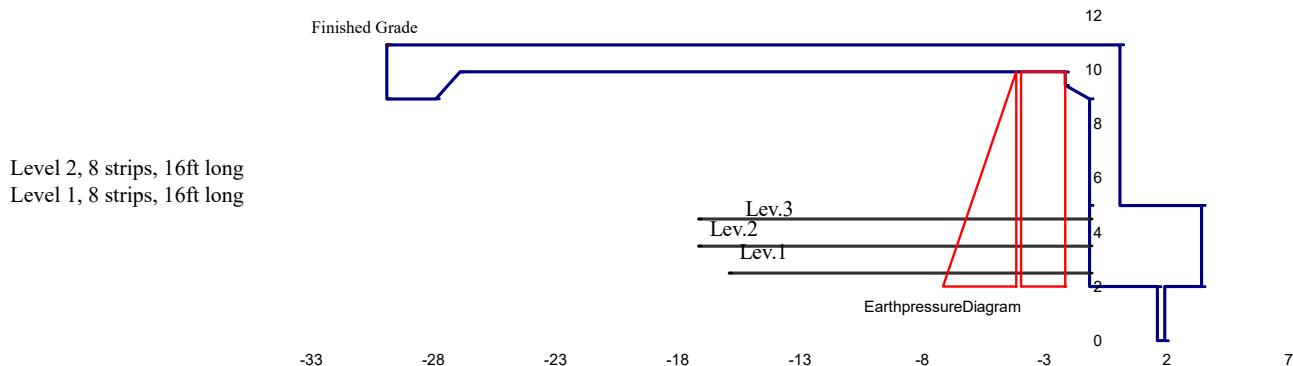

Level 2, 8 strips, 16ft long
 Level 1, 8 strips, 16ft long


KOKOSING CONSTRUCTION

- ☐ NO EXCEPTIONS TAKEN
- ☒ MAKE CORRECTIONS AS NOTED
- ☐ REVISE AND RESUBMIT
- ☐ REJECTED
- ☐ FOR INFORMATION ONLY

REVIEW IS FOR GENERAL COMPLIANCE WITH CONTRACT DOCUMENTS
NO RESPONSIBILITY ASSUMED FOR CORRECTNESS OF DIMENSIONS OR DETAILS

BY obluestone

DATE 6/18/2020

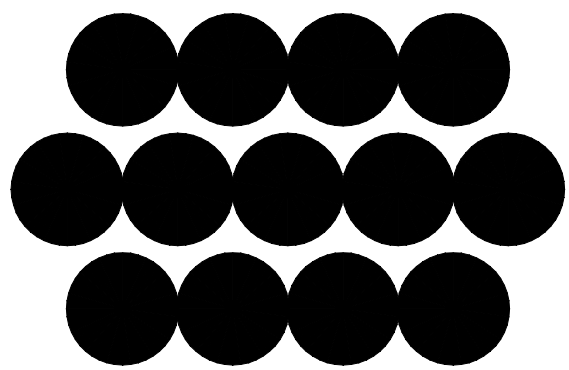

Reinforced eARTH®

45610 Woodland Road, Suite 200, Sterling VA 20166 (703) 547-8797
www.reinforcedearth.com


THE PRECASTER SHALL BE: NORWALK CONCRETE INDUSTRIES,
NORWALK, OH

PANEL GENERAL NOTES

- 1) REINFORCING BARS SHALL BE ASTM A615 GRADE 60, EPOXY COATED PER ASTM A775.
- 2) CONCRETE FOR PRECAST PANELS SHALL HAVE A MINIMUM COMPRESSIVE STRENGTH AFTER 28 DAYS OF 4000 p.s.i., OR AS REQUIRED BY THE PROJECT SPECIAL PROVISIONS.
- 3) TIE STRIPS SHALL BE STEEL ASTM 1011, GRADE 50 (GALVANIZED PER ASTM A-123).
- 4) ALL FRONT EDGES OF PANELS SHALL HAVE A 1/2" CHAMFER.
- 5) TIE STRIPS SHALL BE PLACED WITHIN 1" OF THE DIMENSION SHOWN ON THE FABRICATION DRAWINGS.
- 6) PANEL DESIGN THICKNESS IS 5 1/2". THE QUANTITY OF CONCRETE WILL INCREASE TO ACCOMMODATE ANY ARCHITECTURAL SURFACE FINISH THAT MAY BE SPECIFIED.
- 7) VERTICAL REINFORCING BARS SHALL BE PLACED 1 1/2" (MIN.) CLEAR FROM THE BACK FACE OF THE PANEL.
- 8) ALL REINFORCING BARS SHALL BE STOPPED 1 1/2" (MIN.) CLEAR FROM ANY EDGE OF PANEL UNLESS NOTED ON INDIVIDUAL FABRICATION DRAWING.
- 9) ALL INDIVIDUAL FABRICATION DRAWINGS ARE SHOWN BACK FACE.

- 10) IF COPING DOWELS ARE REQUIRED, USE 2'-0" LONG, SIX (6) PER FULL-WIDTH PANEL.

- 11) KEY TO PIECE MARK:

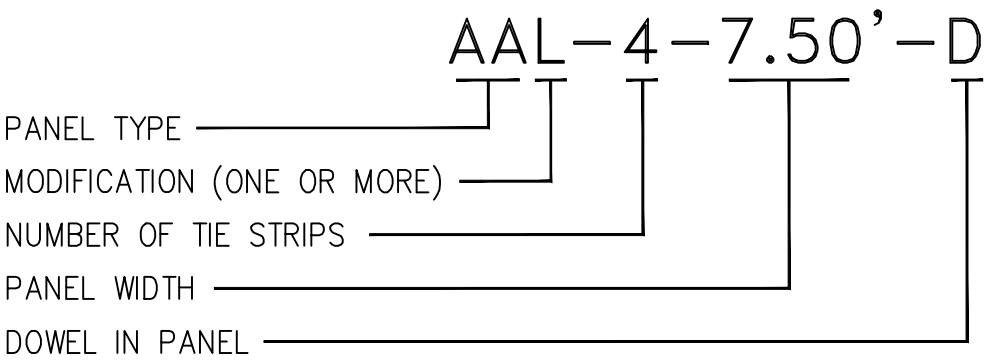

SHEET INDEX	
SHEET NO.	DRAWING NAME
1	GENERAL NOTES
2	STANDARD PRECAST PANEL SHOP DRAWING "DETAILS"
3	STANDARD HORIZONTAL SECTIONS
4	STANDARD VERTICAL SECTIONS
5	STANDARD PANEL REINFORCEMENTS
6	PRECAST PANEL SHOP DRAWINGS
7	PRECAST PANEL SHOP DRAWINGS
8	PRECAST PANEL SHOP DRAWINGS
9	PRECAST PANEL SHOP DRAWINGS "CE5"

PANEL TOLERANCES	
PANEL DIMENSIONS	± 1/8 INCH (3mm)
PANEL SQUARENESS (DIFFERENCE BETWEEN TWO DIAGONALS)	± 1/4 INCH (6mm)
PANEL THICKNESS	± 1/8 INCH (3mm)
LOCATION OF SOIL REINFORCEMENT CONNECTION DEVICE	± 1/4 INCH (6mm)
PANEL SURFACE (SIZE OF SURFACE DEFECT MEASURED OVER A LENGTH OF 5 FT (1.5 M))	
SMOOTH FORMED FINISH	± 1/8 INCH (3mm)
TEXTURED FINISH	± 5/16 INCH (8mm)
POSITION OF REINFORCING STEEL	± 1/8 INCH (3mm)

REAR ABUTMENT MSE
WALL AT EAST 89TH ST.

This drawing contains information proprietary to The Reinforced Earth Company, and is being furnished for the use of The Ohio Department of Transportation only in connection with this project, and the information contained is not to be transmitted to any other organization unless specifically authorized in writing by The Reinforced Earth Company. The Reinforced Earth Company is the exclusive licensee in the United States under patents held by our affiliated companies, and the furnishing of this drawing does not constitute an expressed or implied license under any applicable patents.

The design contained on these drawings is based on information provided by the Owner. On the basis of this information, The Reinforced Earth Company has designed, and is responsible for the internal stability of the structure only. External stability, including foundation (bearing capacity and settlement) and global stability (including sliding and rotation), is the responsibility of the Owner.

CERTIFIED WITH RESPECT TO INTERNAL STABILITY
OF REINFORCED EARTH STRUCTURES ONLY.




GENERAL NOTES

CUY-IR490/SR010-2.09/19.28
CITY OF CLEVELAND, CUYAHOGA COUNTY, OHIO
OHIO DEPARTMENT OF TRANSPORTATION













CUY-IR490
SR010-2.09/19.28

01 OF 9

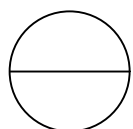


18631

DESIGNED:	MS	CHECKED:	MS
DRAWN:	NR	REVISED:	
REVIEWED:	MS	PID No:	96833
DATE:	04/27/2020		

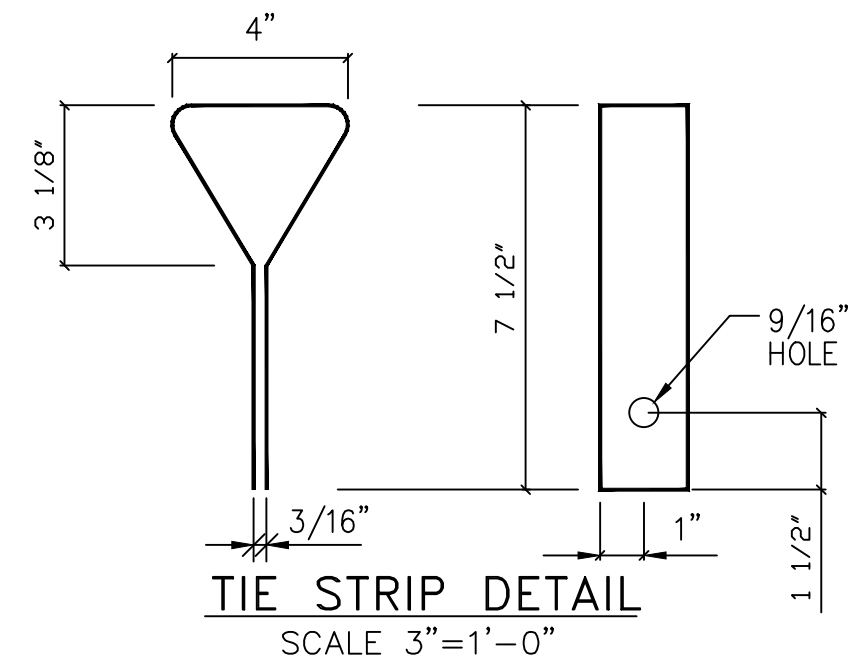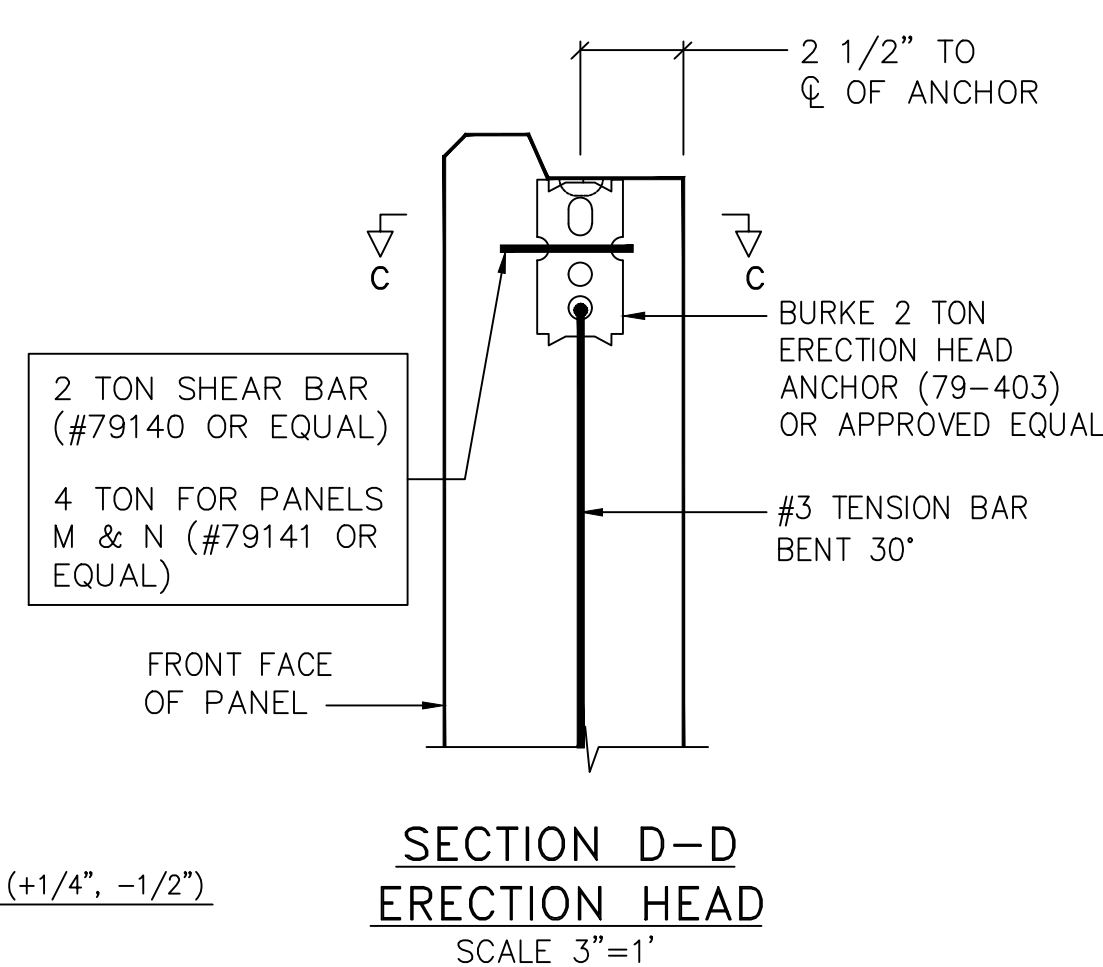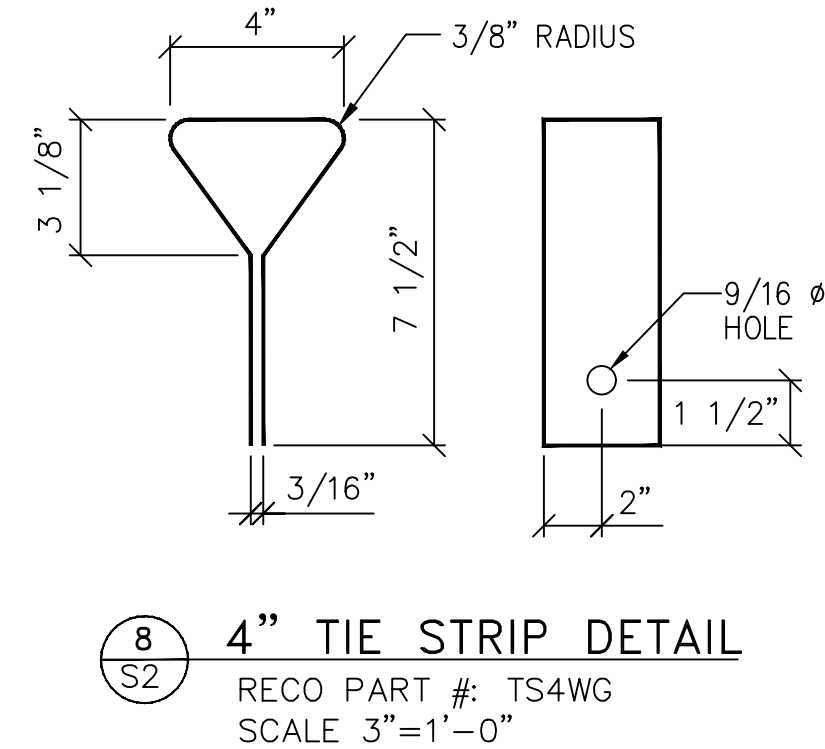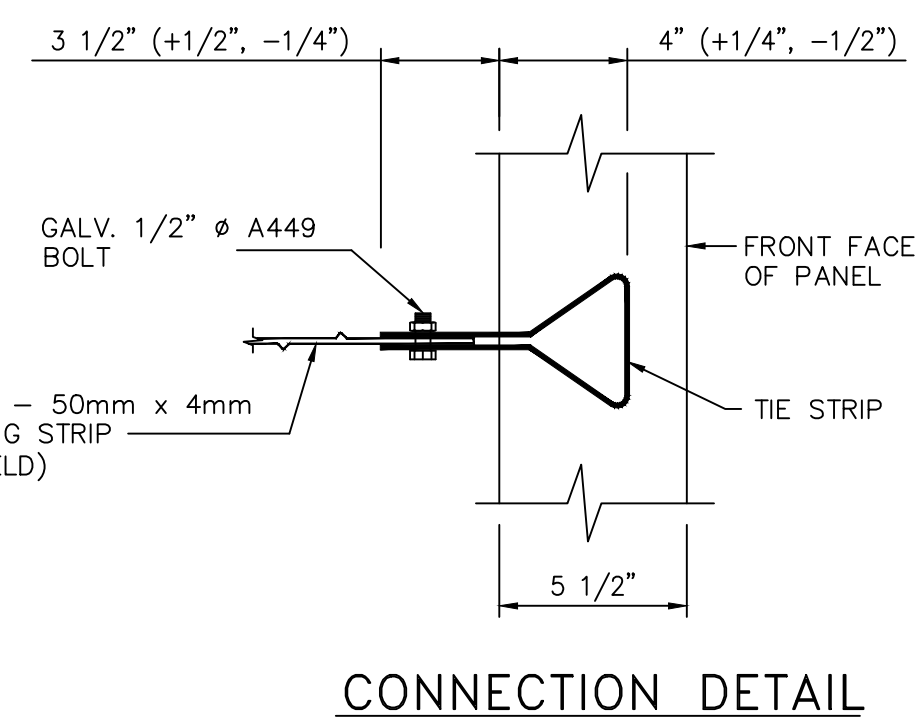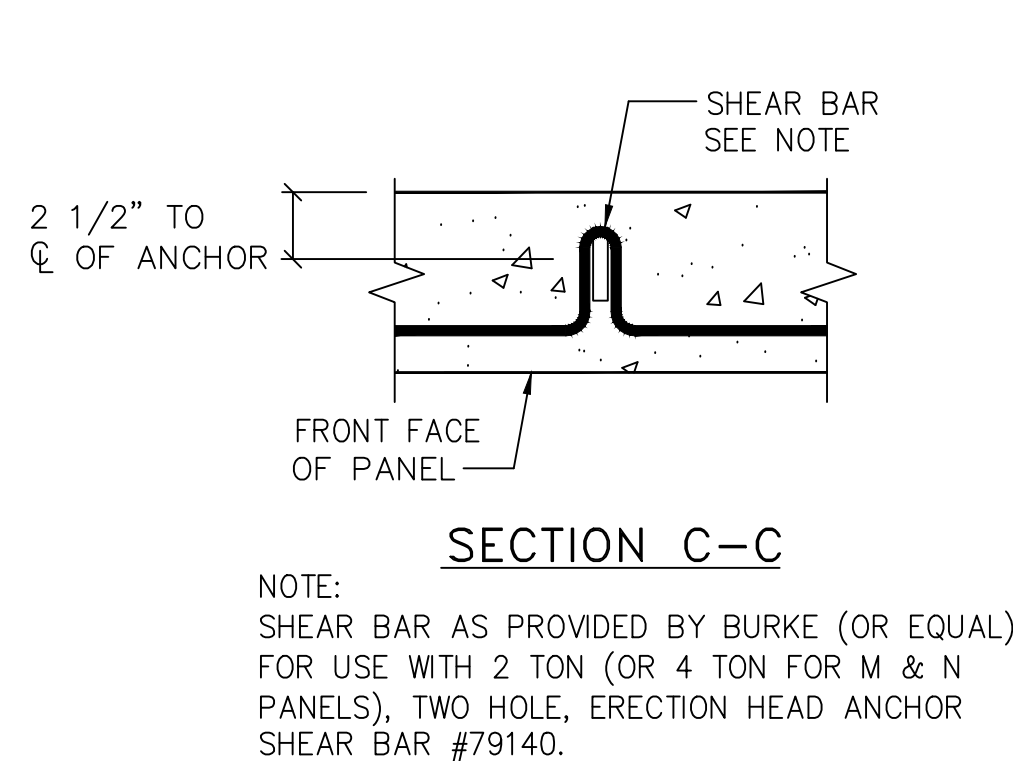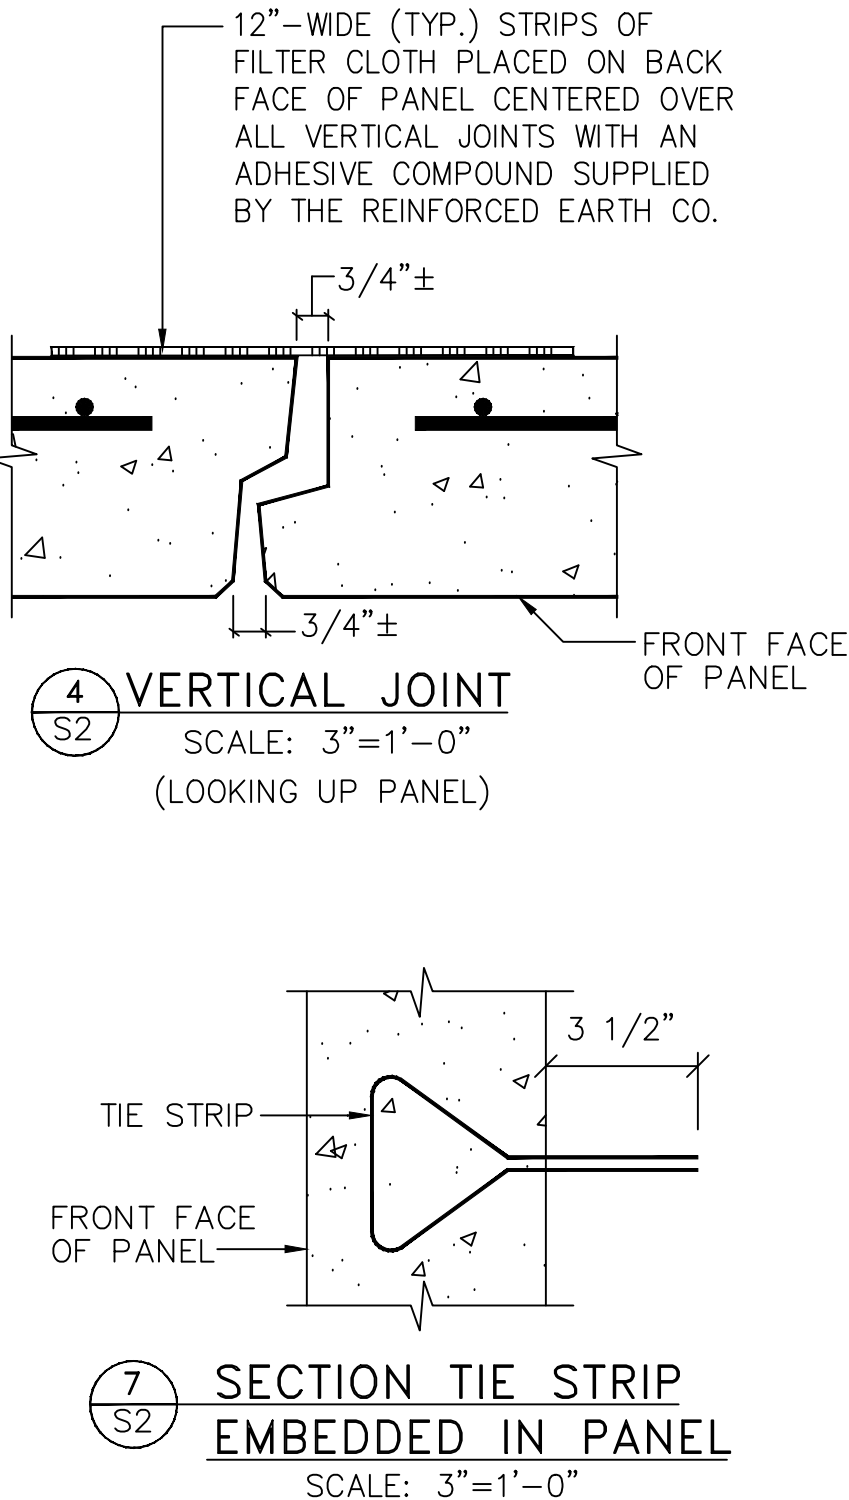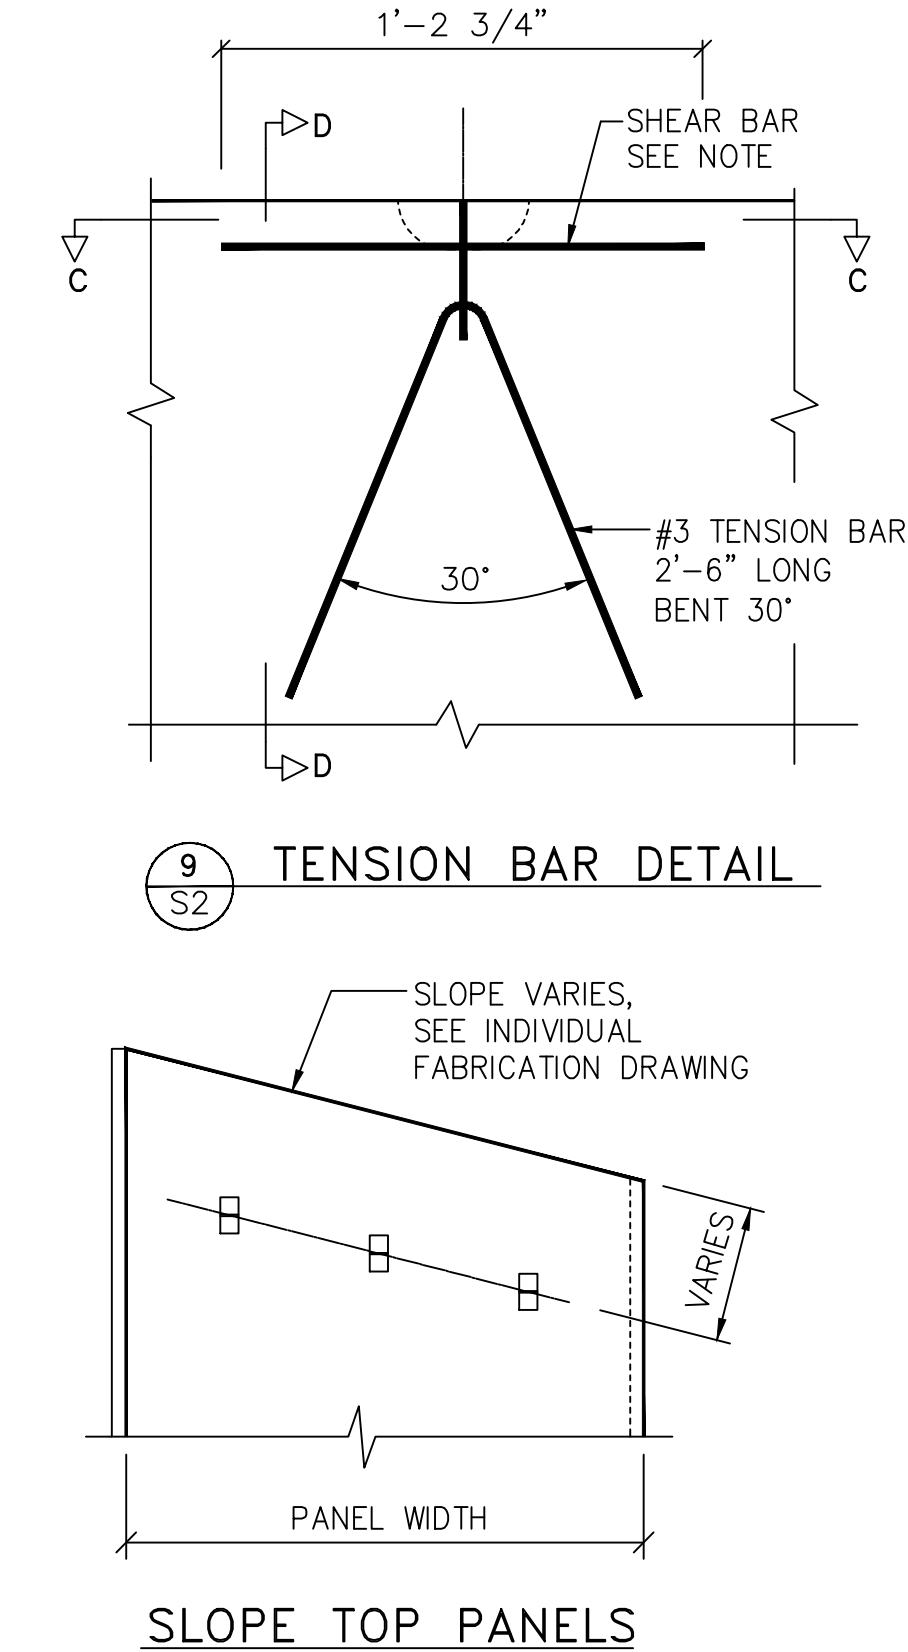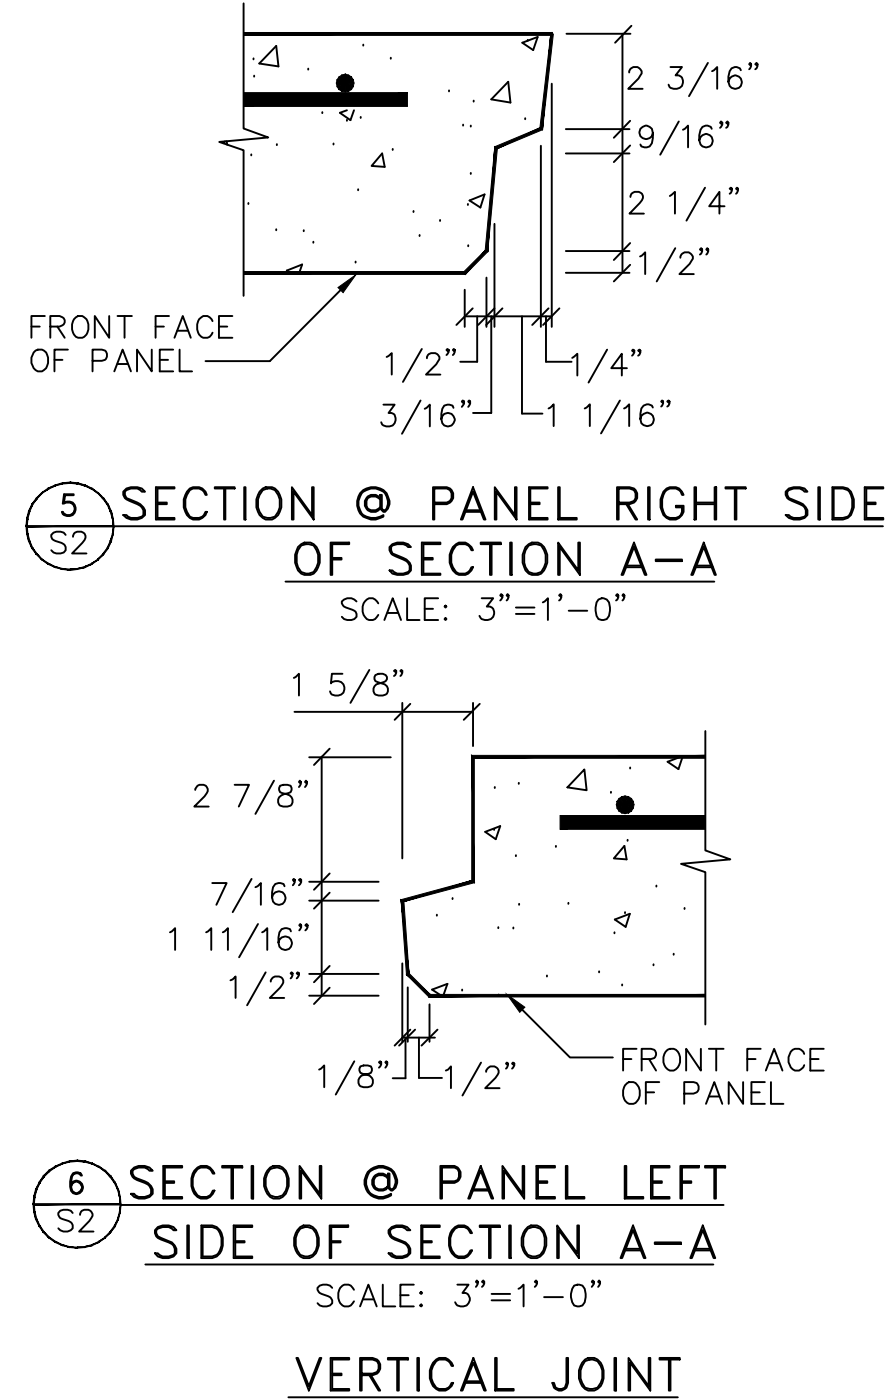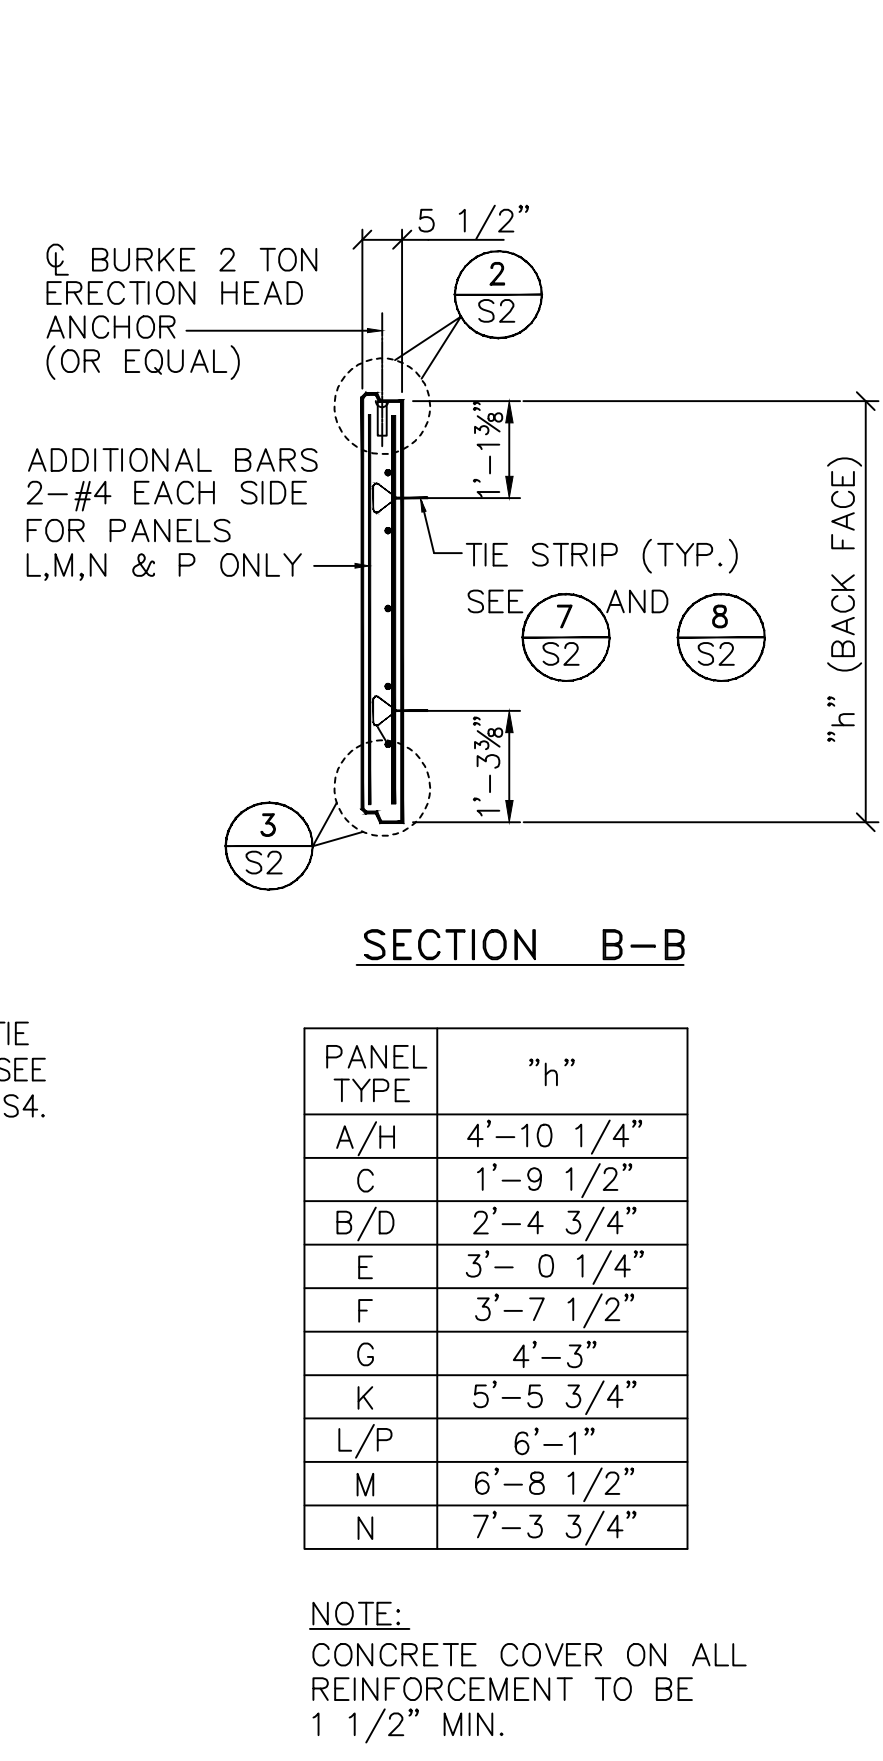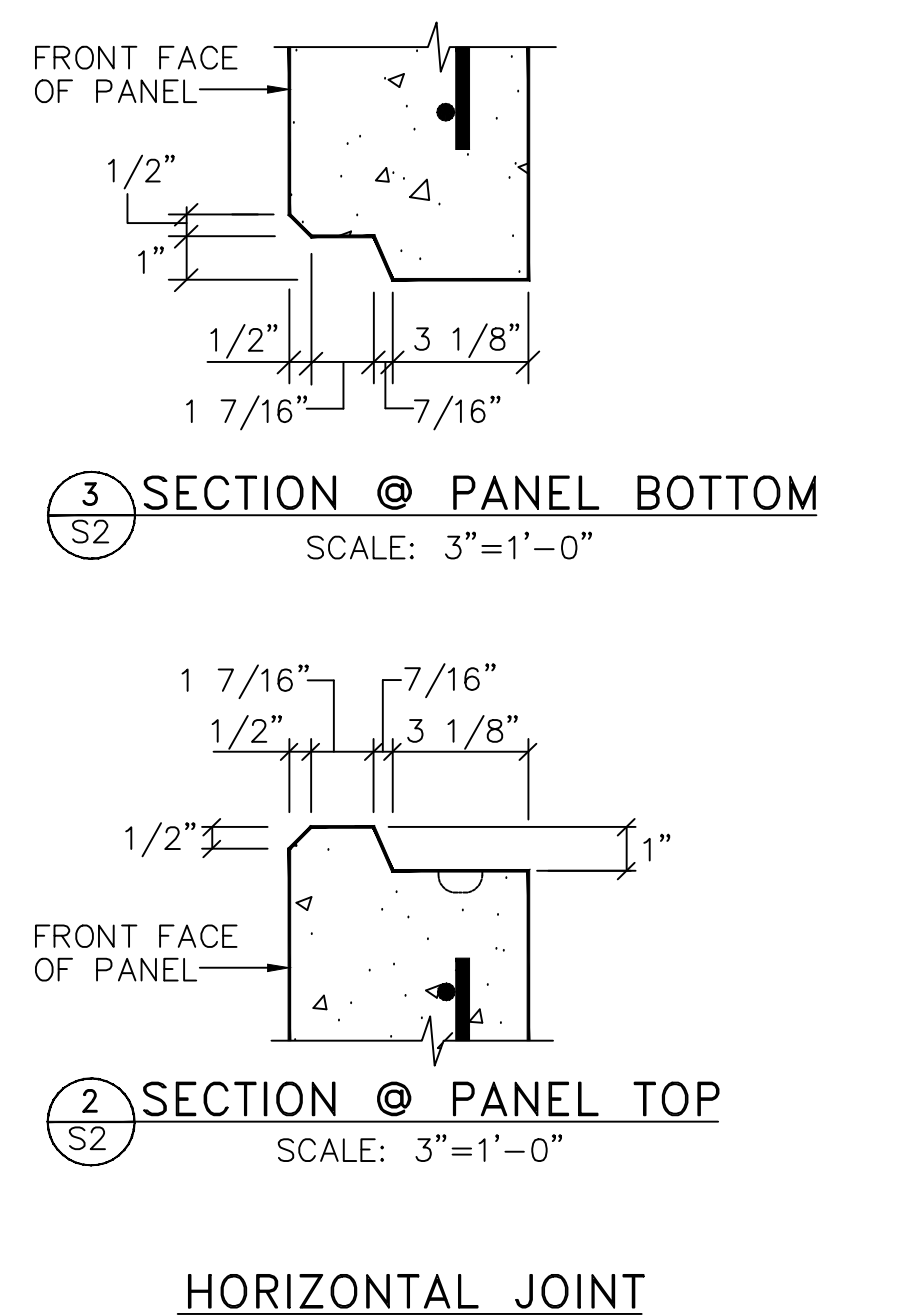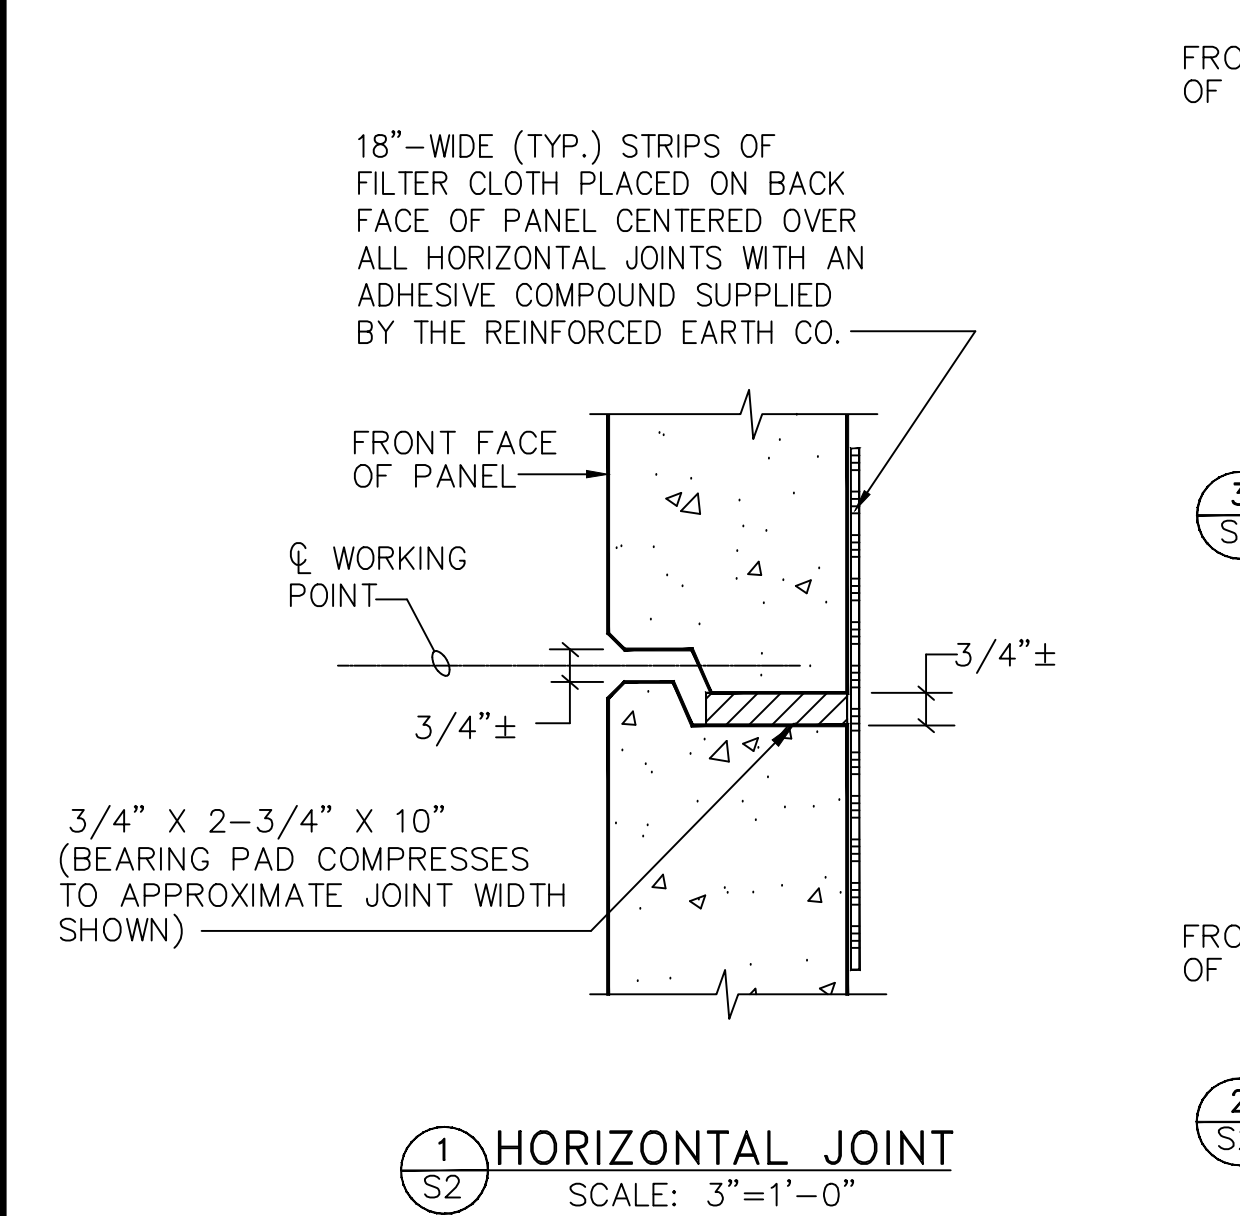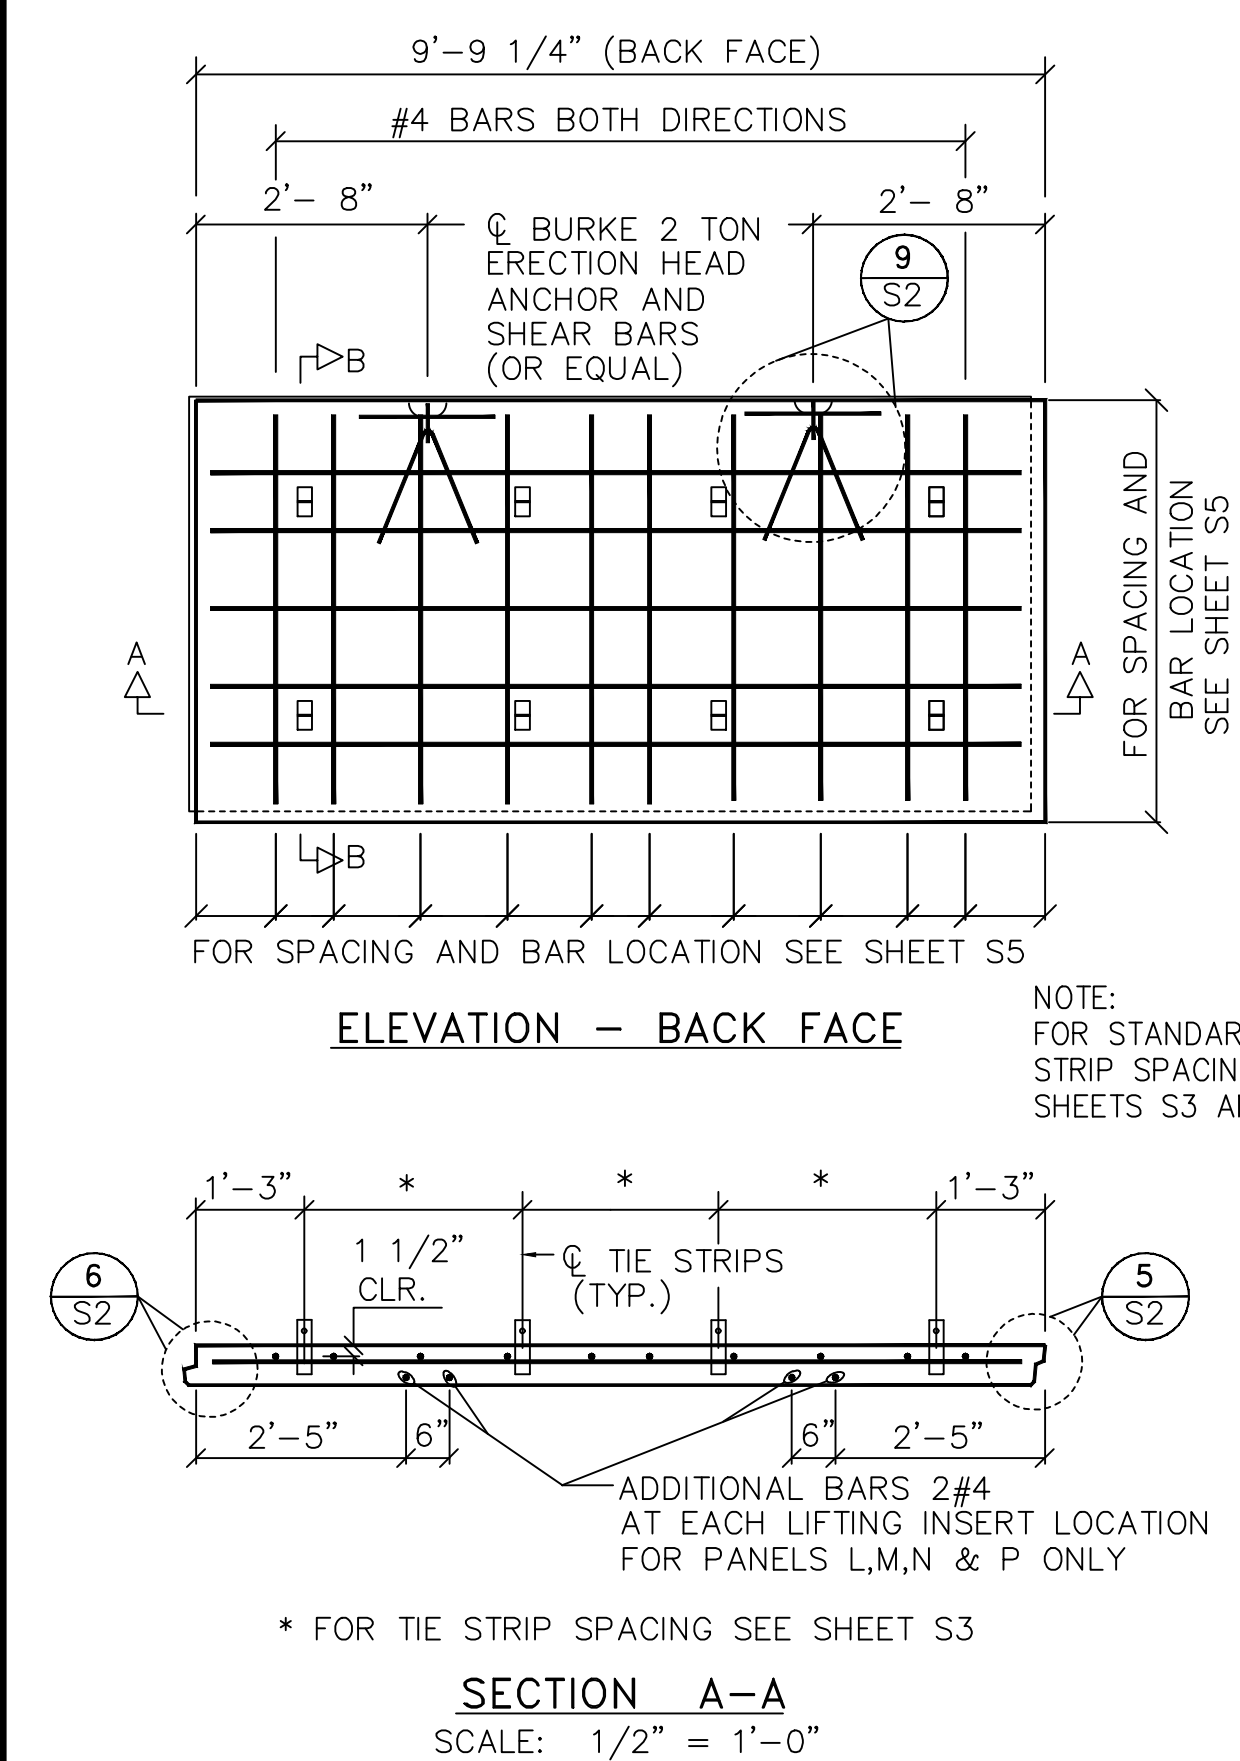

CERTIFIED WITH RESPECT TO INTERNAL STABILITY OF REINFORCED EARTH STRUCTURES ONLY.



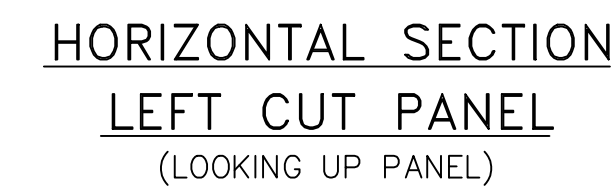

NOTE:
USE EITHER STANDARD PANEL WITH LIP
(AS SHOWN) OR FLAT TOP WITH FORM HEADER
WHEN USING COPING DOWELS.



NOTE:

1) ALL HORIZONTAL AND VERTICAL REBAR SHOWN IS #4, UNLESS OTHERWISE NOTED ON THE INDIVIDUAL PANEL DETAILS.




Bearing Recess
necessary? Bearings
called out to be flat
3/4" X 2 - 3/4" X 10"
pads




This drawing contains information proprietary to The Reinforced Earth Company, and is being furnished for the use of The Ohio Department of Transportation only in connection with this project, and the information contained is not to be transmitted to any other organization unless specifically authorized in writing by The Reinforced Earth Company. The Reinforced Earth Company is the exclusive licensee in the United States under patents held by our affiliated companies, and the furnishing of this drawing does not constitute an expressed or implied license under any applicable patents.


The design contained on these drawings is based on information provided by the Owner. On the basis of this information, The Reinforced Earth Company has designed, and is responsible for the internal stability of the structure only. External stability, including foundation (bearing capacity and settlement) and global stability (including sliding and rotation), is the responsibility of the Owner.

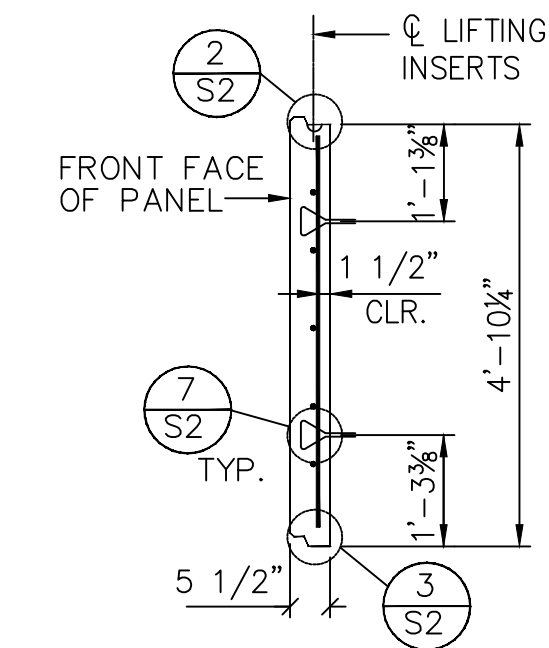


1 SECTION B-B PANEL "A/H"
S4

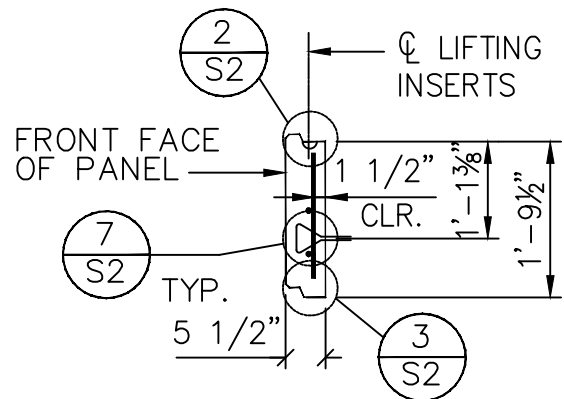


3 SECTION B-B PANEL "C"
S4

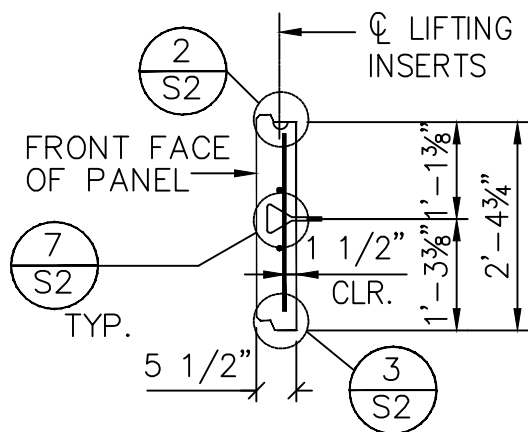


2 SECTION B-B PANEL "D/B"
S4

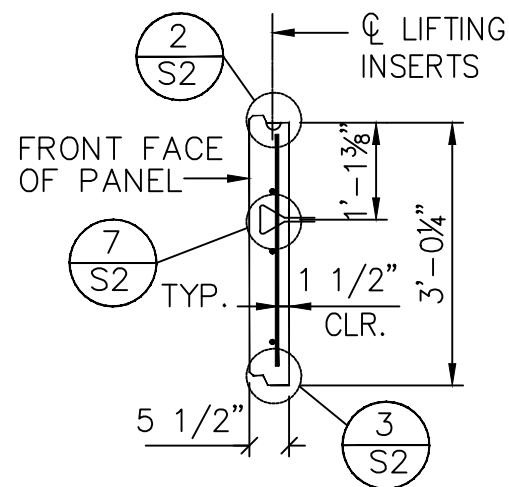


4 SECTION B-B PANEL "E"
S4 "TOP PANEL ONLY"

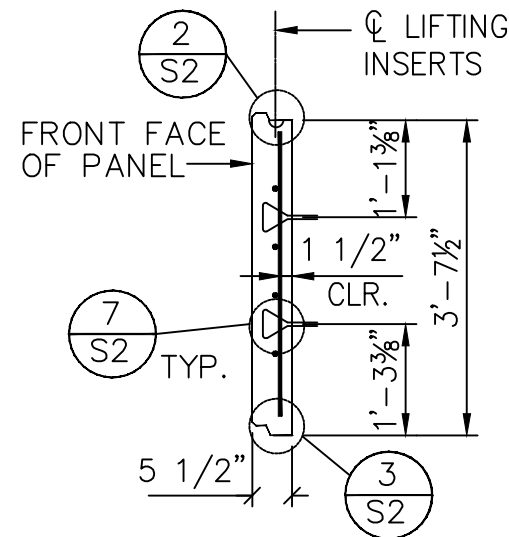


5 SECTION B-B PANEL "F"
S4

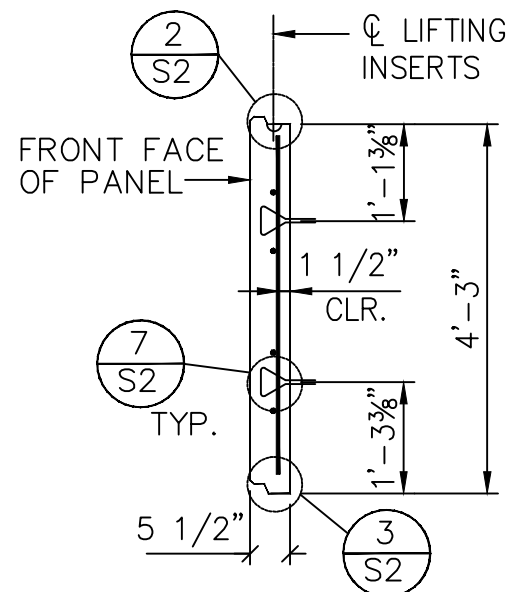


6 SECTION B-B PANEL "G"
S4

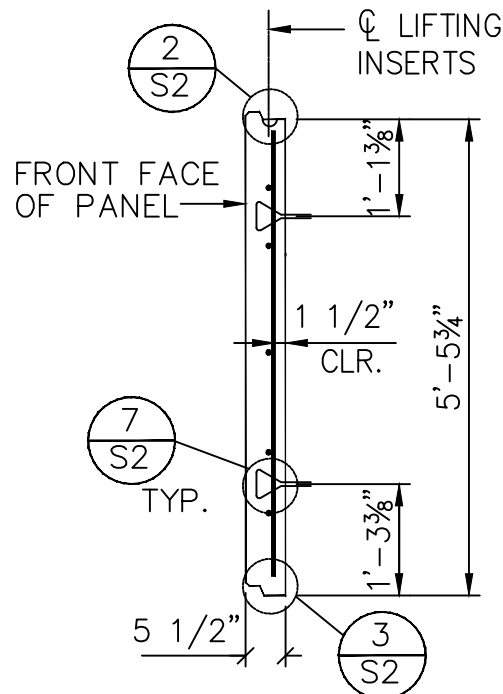


7 SECTION B-B PANEL "K"
S4

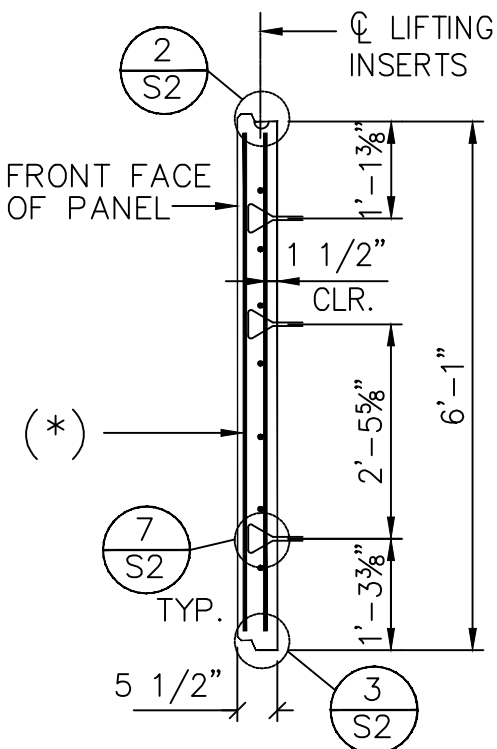


8 SECTION B-B PANEL "L"
S4 * ADDITIONAL BARS 2#4 AT EACH LIFTING INSERT LOCATION

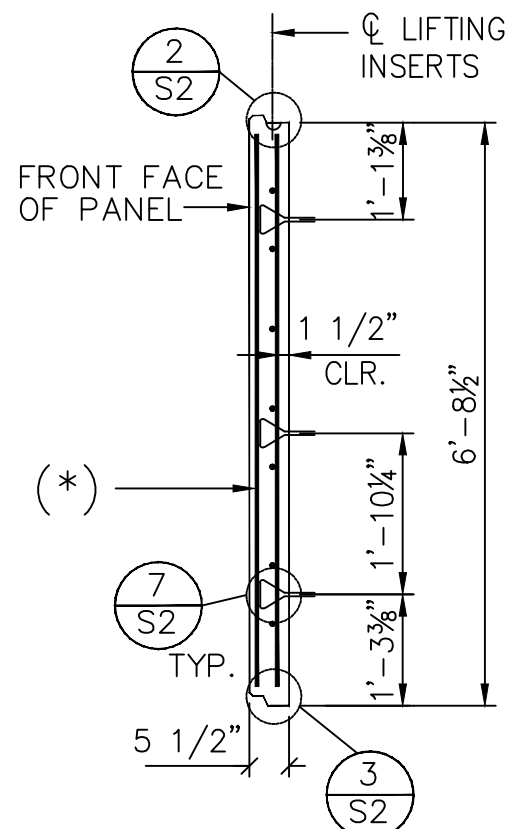

9 SECTION B-B PANEL "M"
S4 * ADDITIONAL BARS 2#4 AT EACH LIFTING INSERT LOCATION

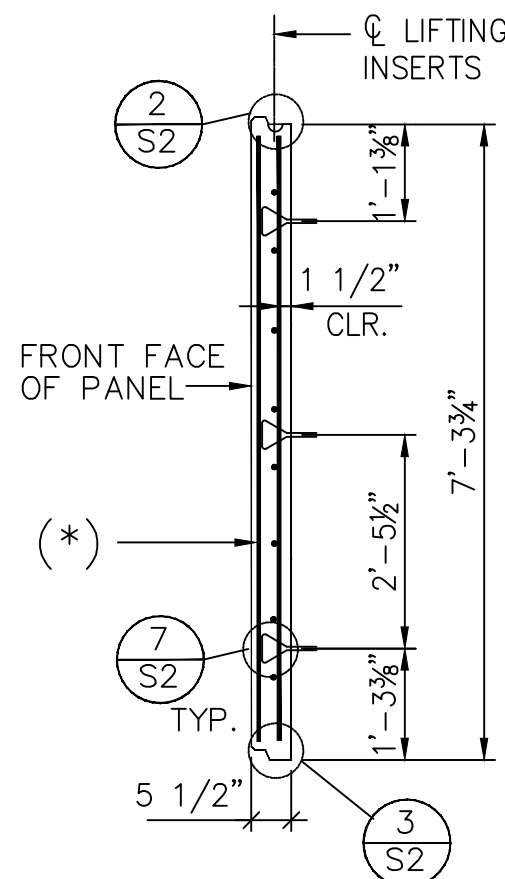

10 SECTION B-B PANEL "N"
S4 * ADDITIONAL BARS 2#4 AT EACH LIFTING INSERT LOCATION

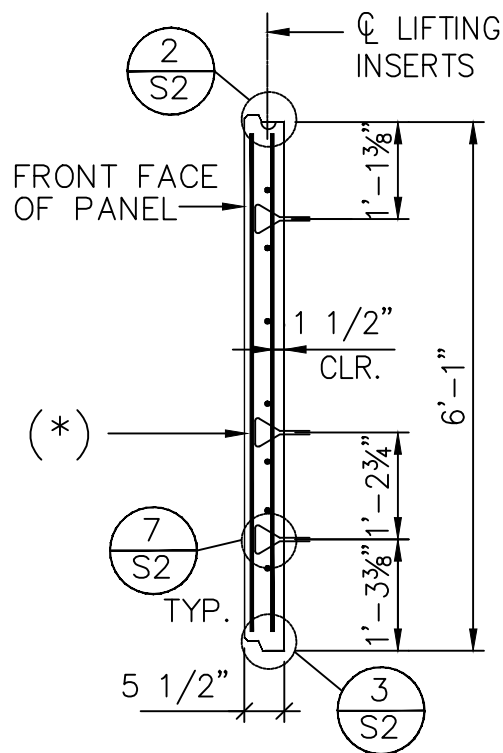


11 SECTION B-B PANEL "P"
S4 "BOTTOM PANEL ONLY" * ADDITIONAL BARS 2#4 AT EACH LIFTING INSERT LOCATION

This drawing contains information proprietary to The Reinforced Earth Company, and is being furnished for the use of The Ohio Department of Transportation only in connection with this project, and the information contained is not to be transmitted to any other organization unless specifically authorized in writing by The Reinforced Earth Company. The Reinforced Earth Company is the exclusive licensee in the United States under patents held by our affiliated companies, and the furnishing of this drawing does not constitute an expressed or implied license under any applicable patents.

The design contained on these drawings is based on information provided by the Owner. On the basis of this information, The Reinforced Earth Company has designed, and is responsible for the internal stability of the structure only. External stability, including foundation (bearing capacity and settlement) and global stability (including sliding and rotation), is the responsibility of the Owner.


CERTIFIED WITH RESPECT TO INTERNAL STABILITY OF REINFORCED EARTH STRUCTURES ONLY.

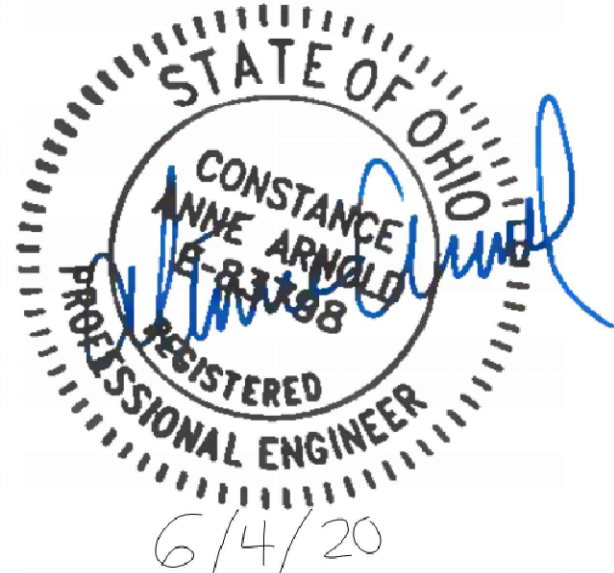

STANDARD VERTICAL SECTIONS
CUY-IR490/SR010-2.09/19.28
CITY OF CLEVELAND, CUYAHOGA COUNTY, OHIO
OHIO DEPARTMENT OF TRANSPORTATION


CUY-IR490
SR010-2.09/19.28

04 OF 9

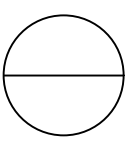


18631


DESIGNED: MS
CHECKED: MS
DRAWN: NR
REVIEWED: MS
DATE: 04/27/2020
PID No: 96833

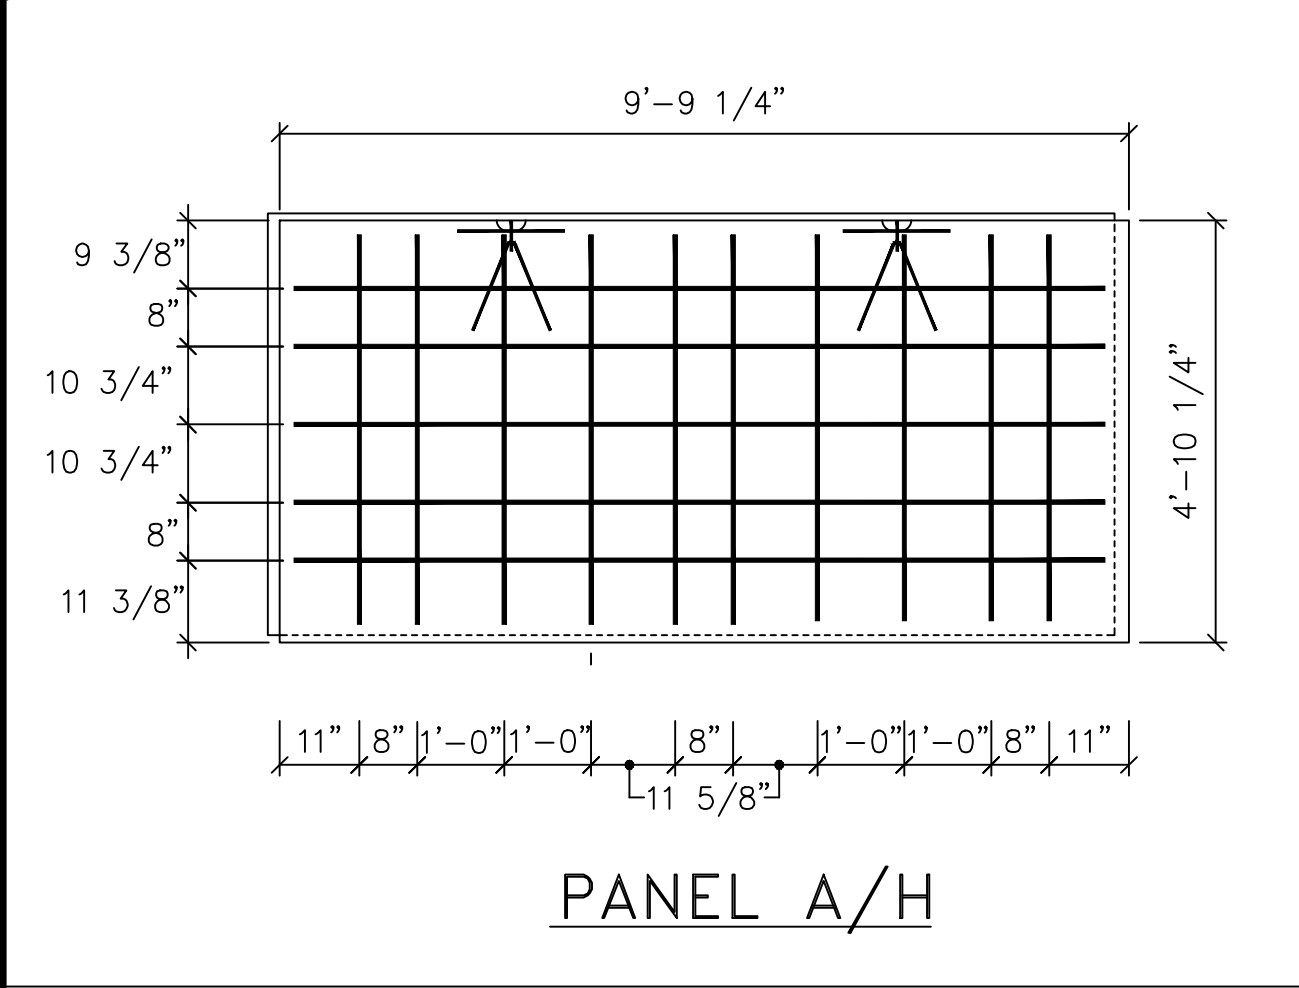


PANEL A/H

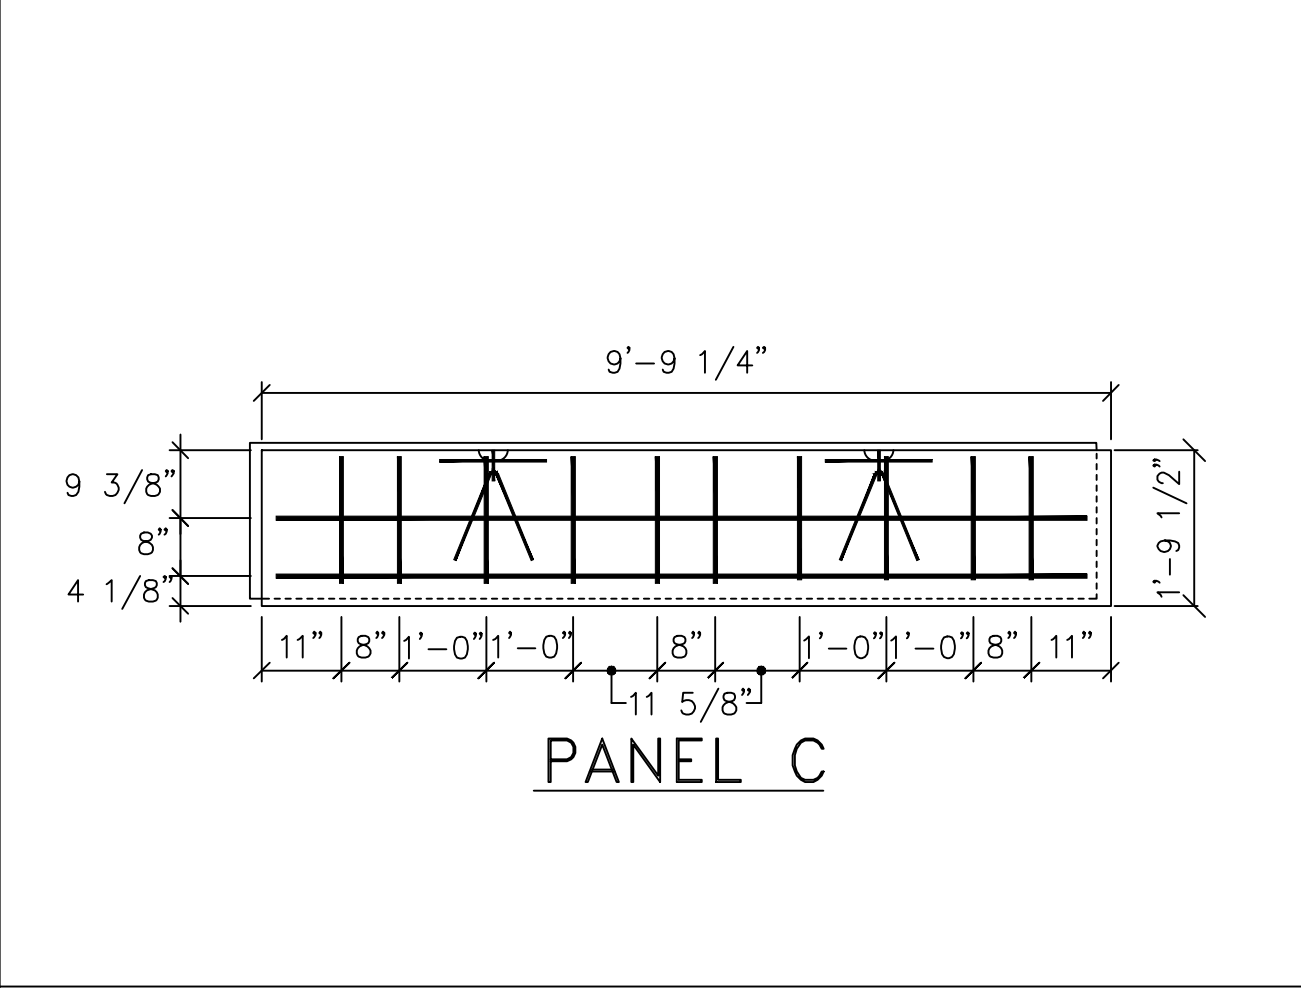


PANEL C

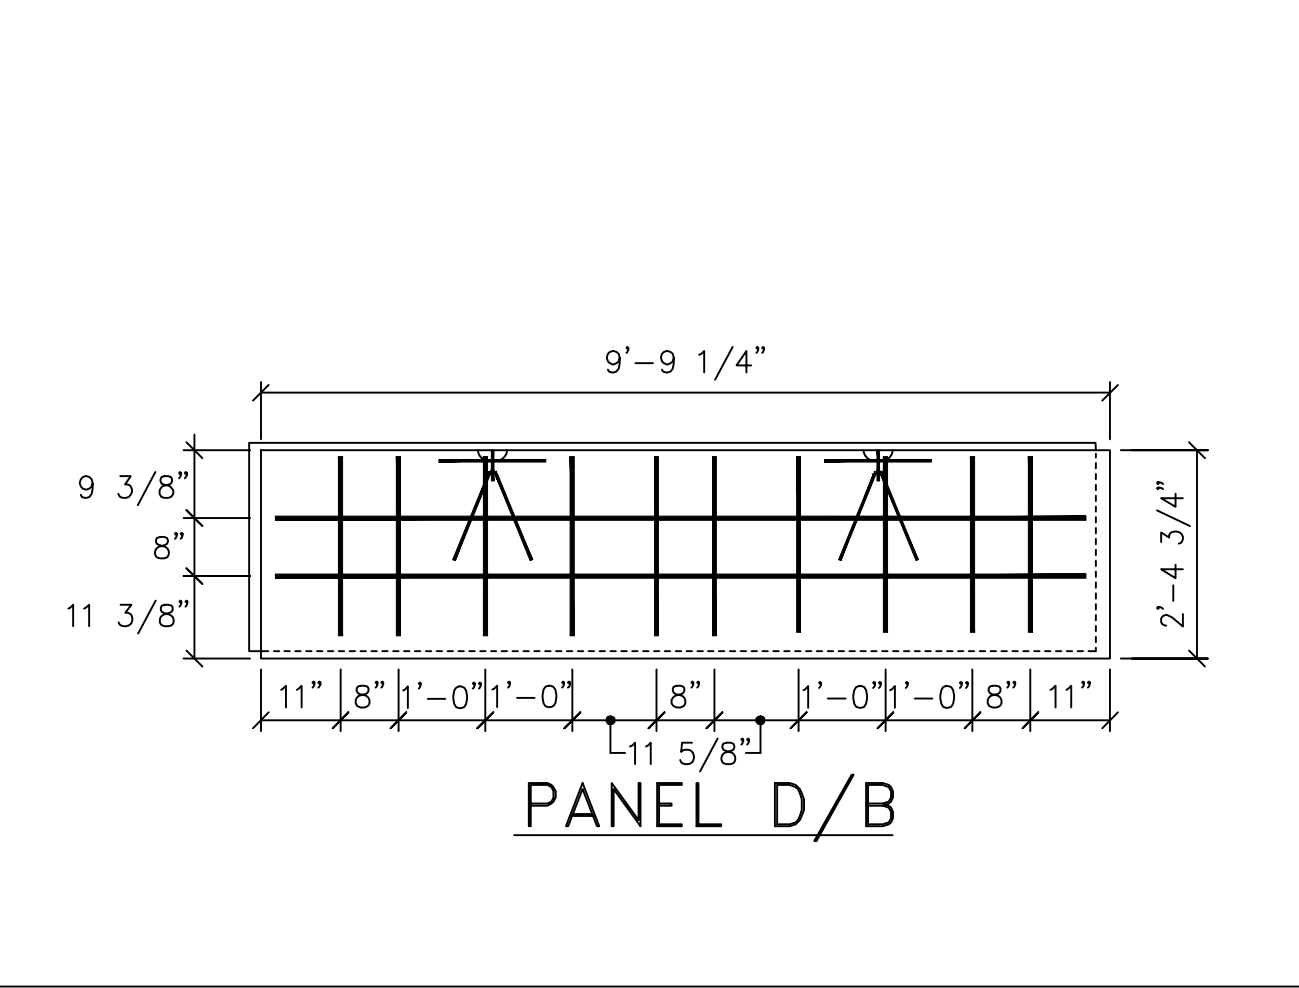


PANEL D/B

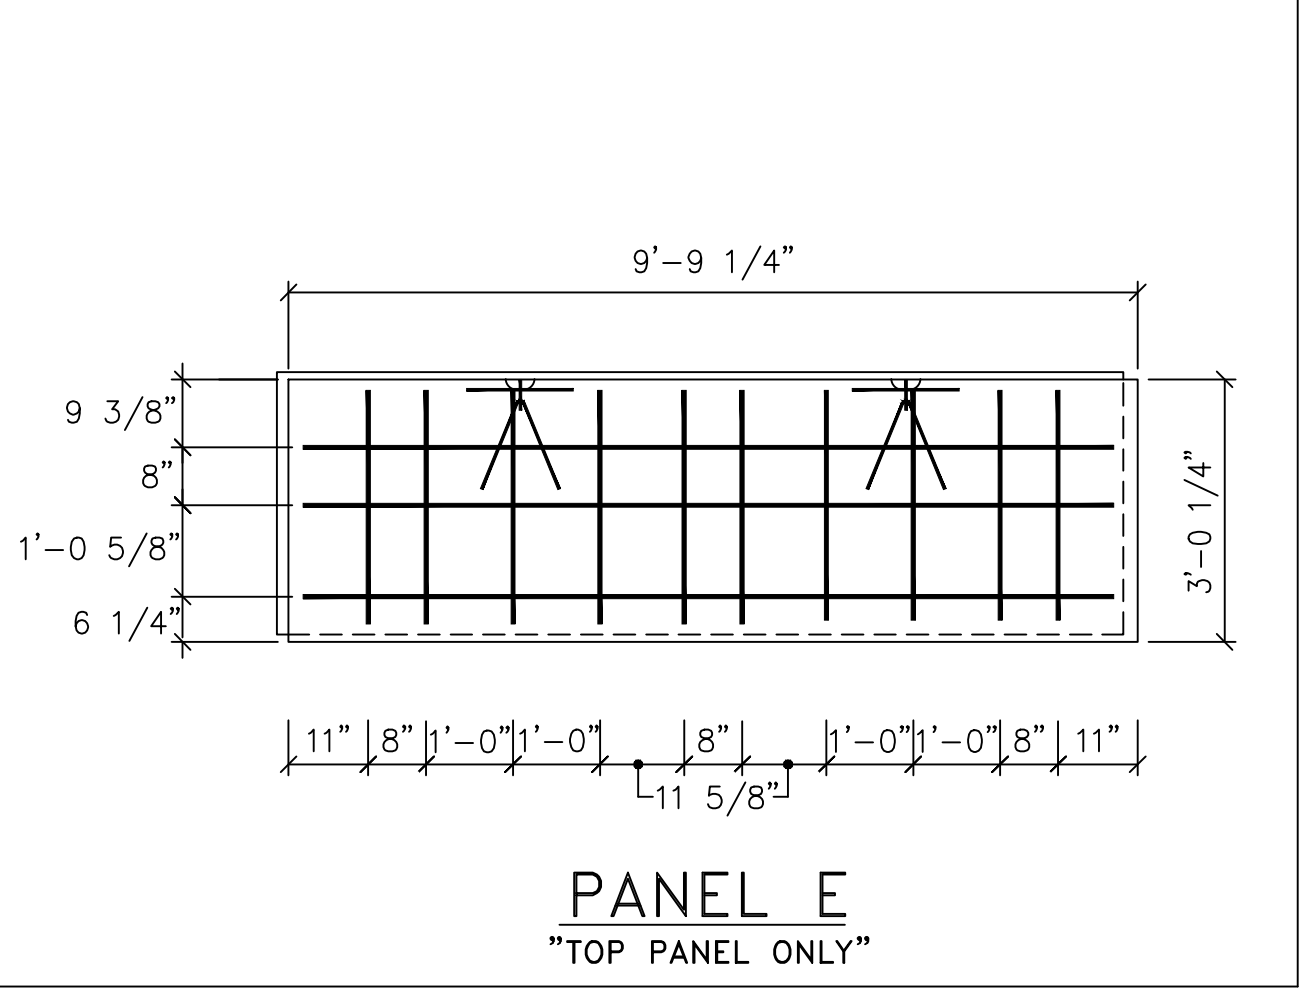


PANEL E
"TOP PANEL ONLY"

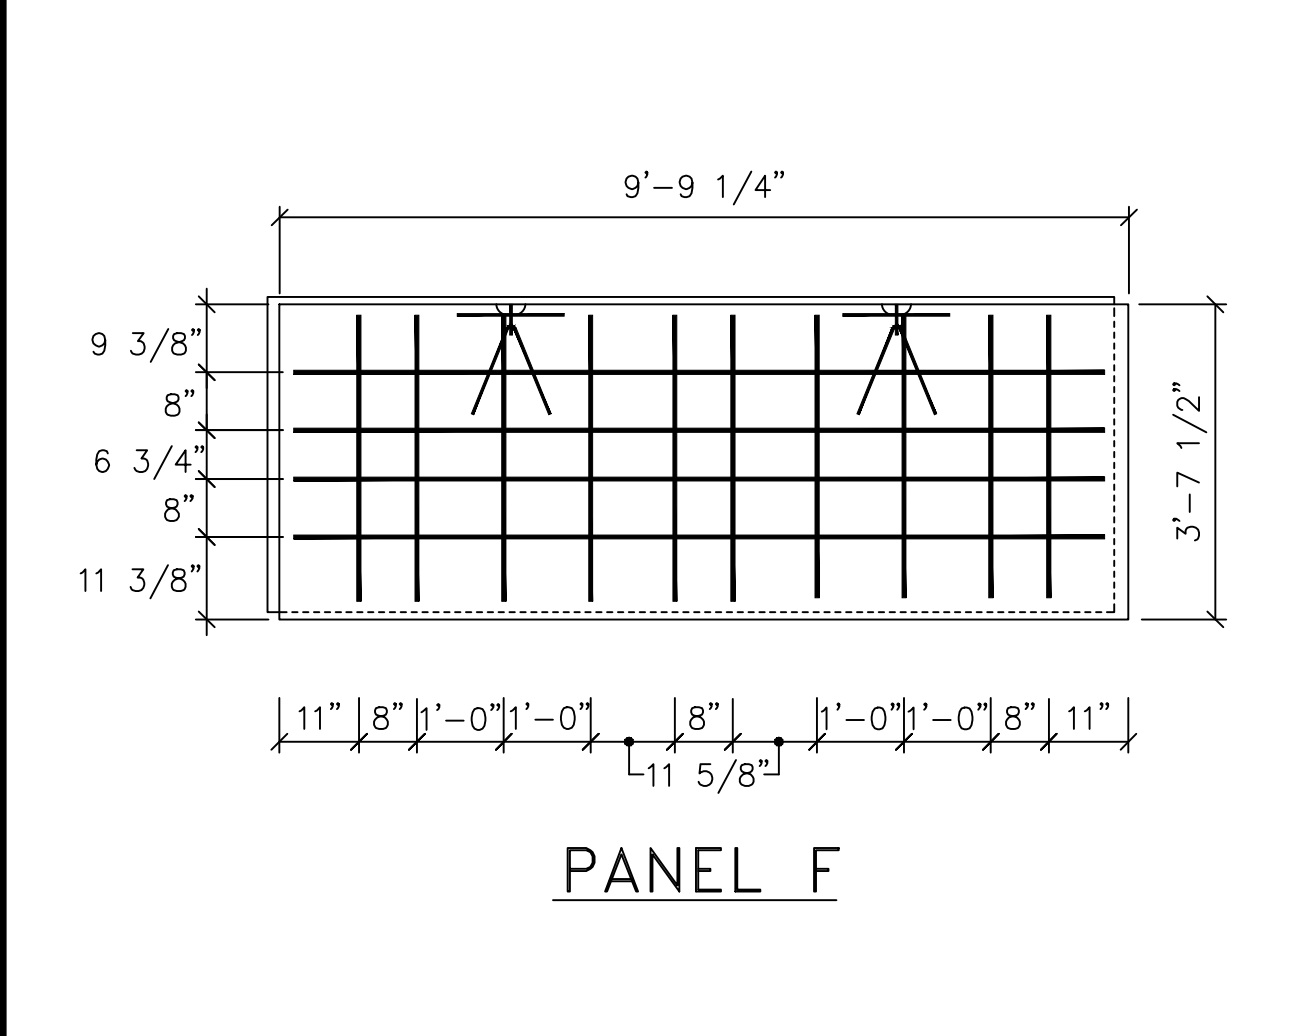


PANEL F

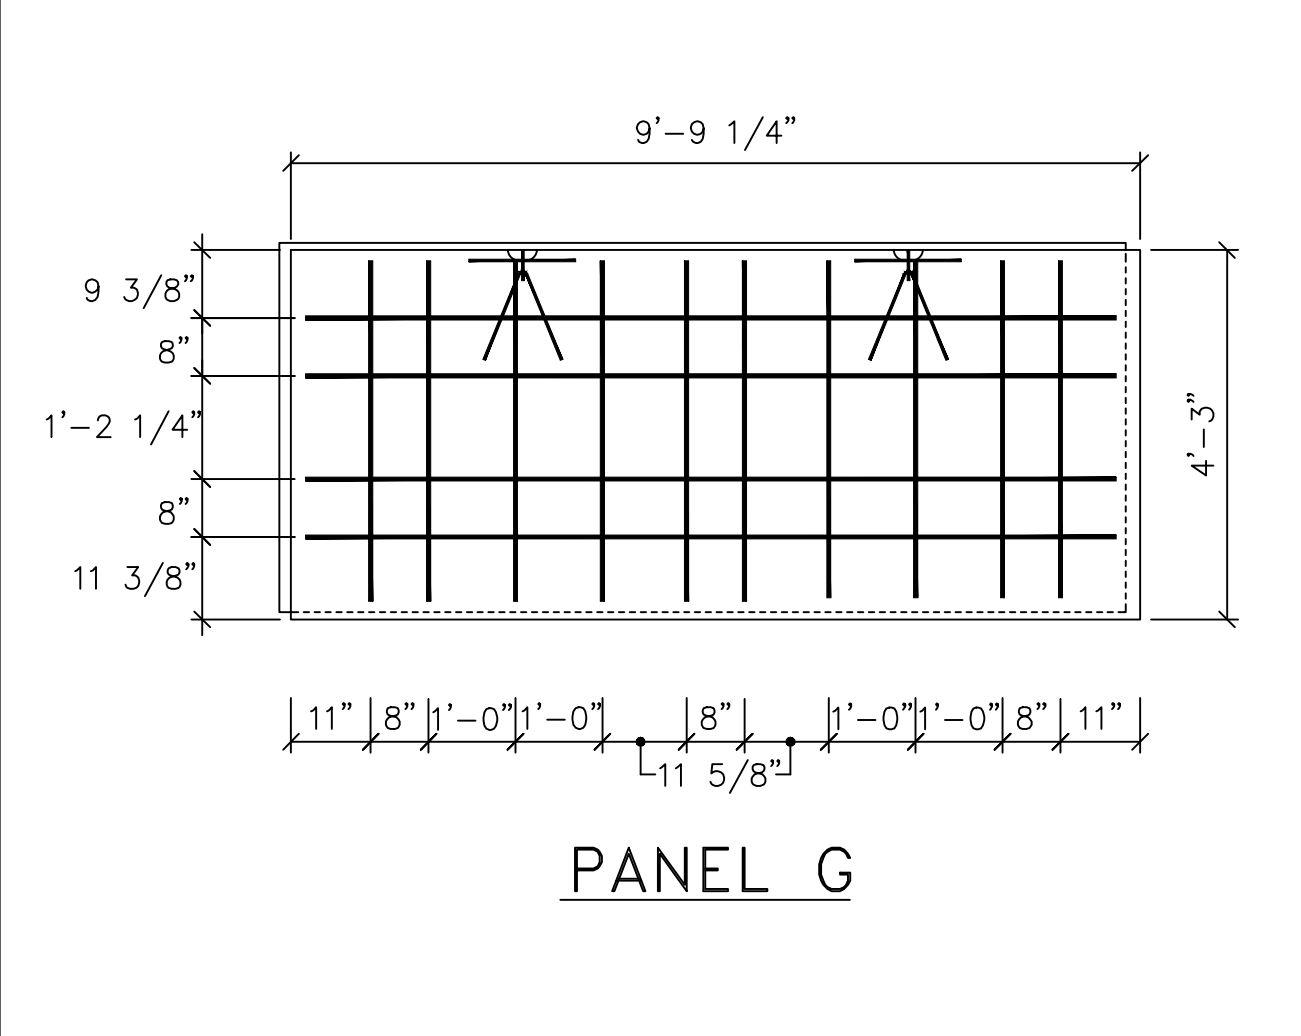

PANEL G

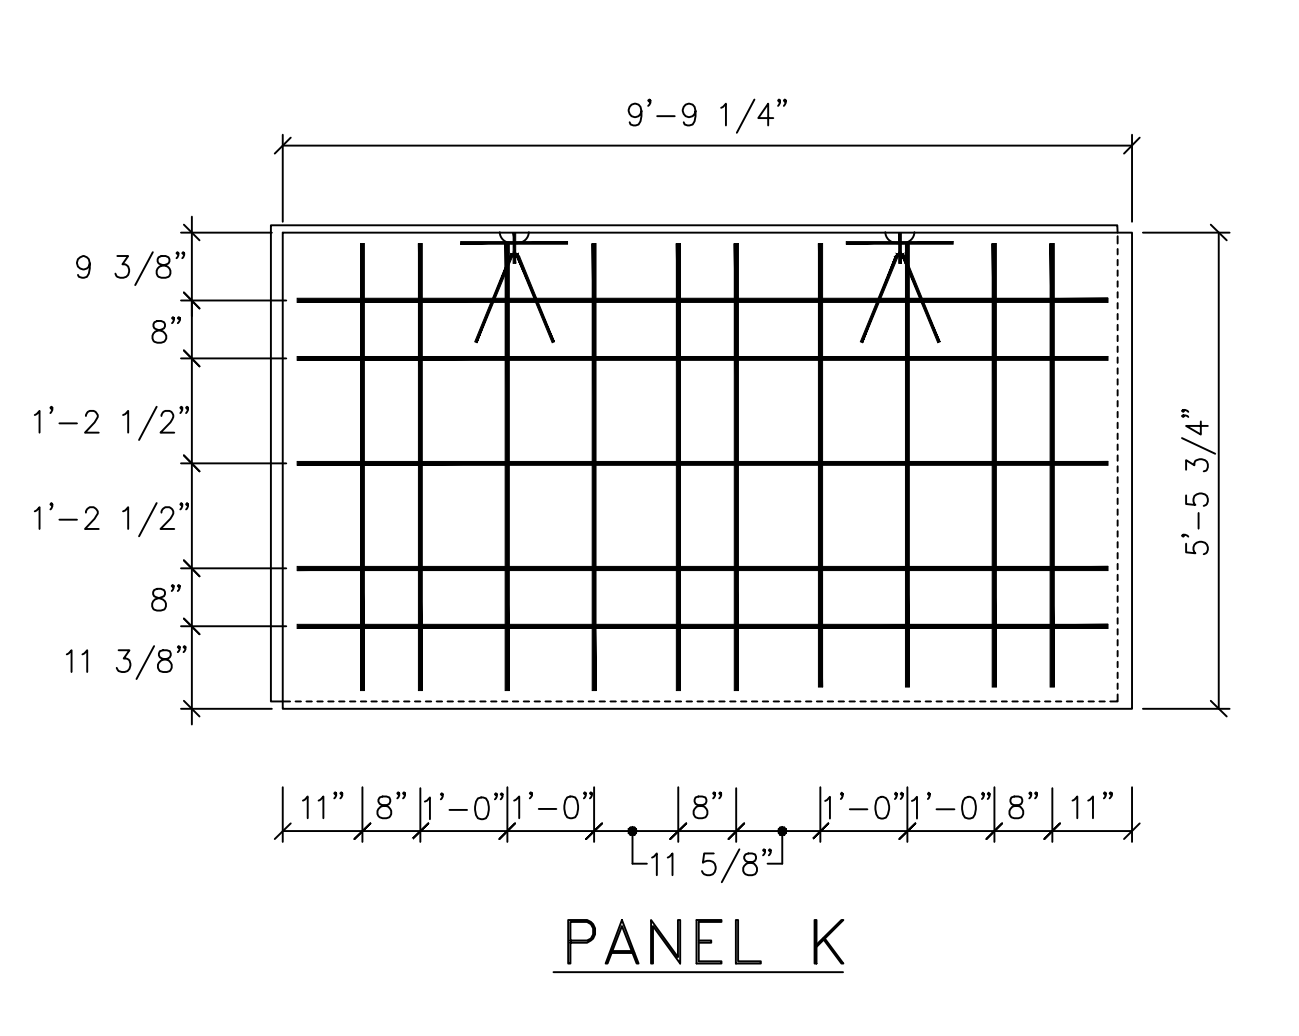


PANEL K

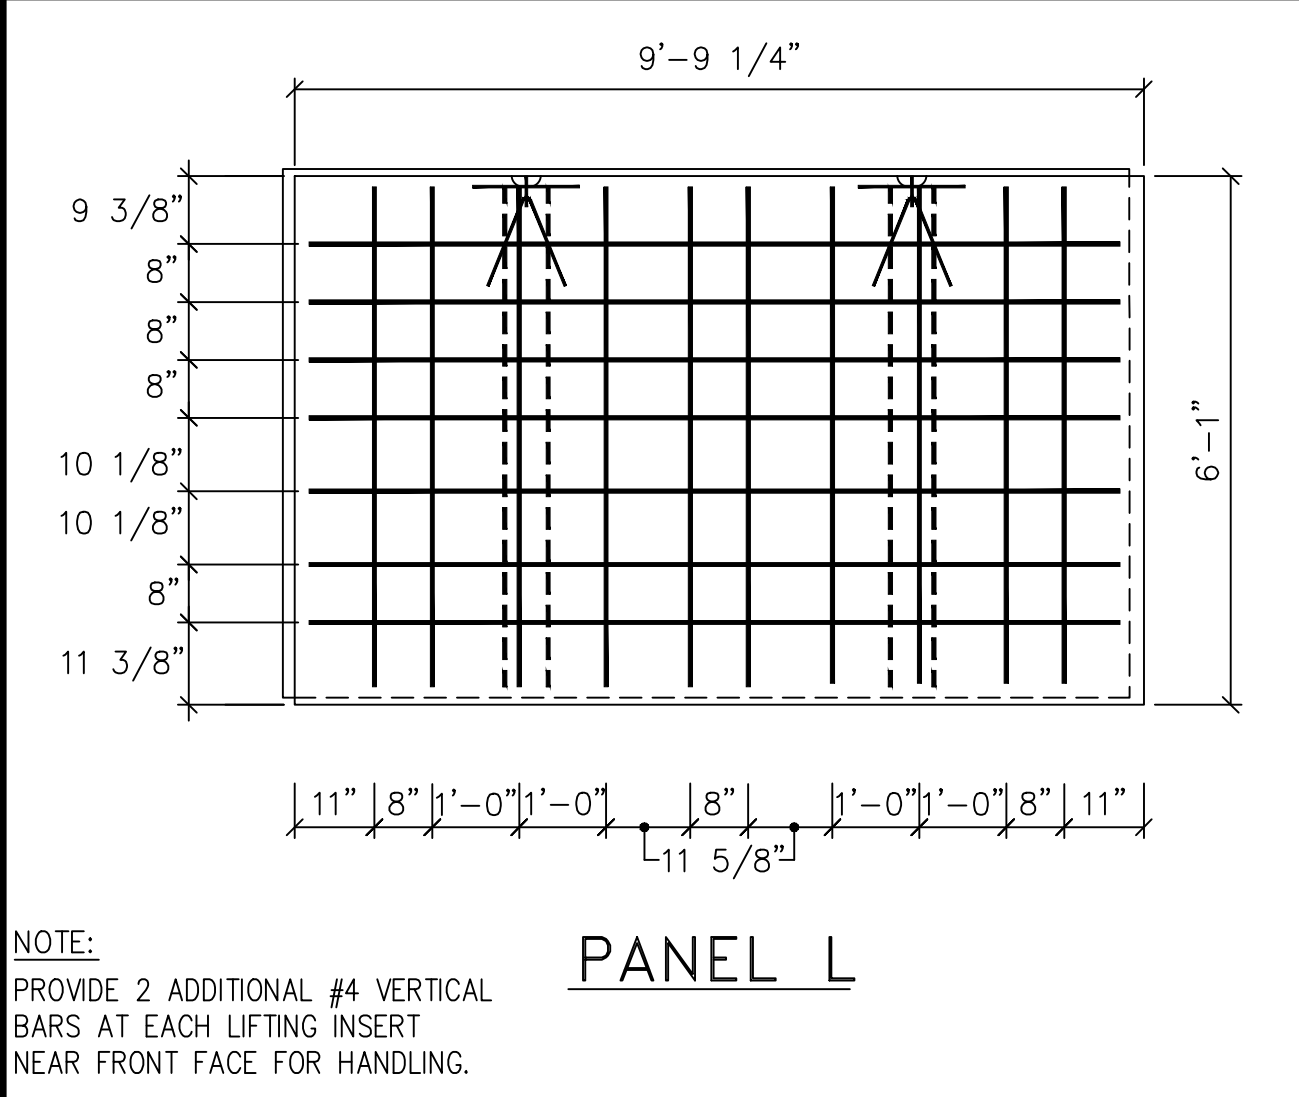


PANEL L

NOTE:
PROVIDE 2 ADDITIONAL #4 VERTICAL
BARS AT EACH LIFTING INSERT
NEAR FRONT FACE FOR HANDLING.

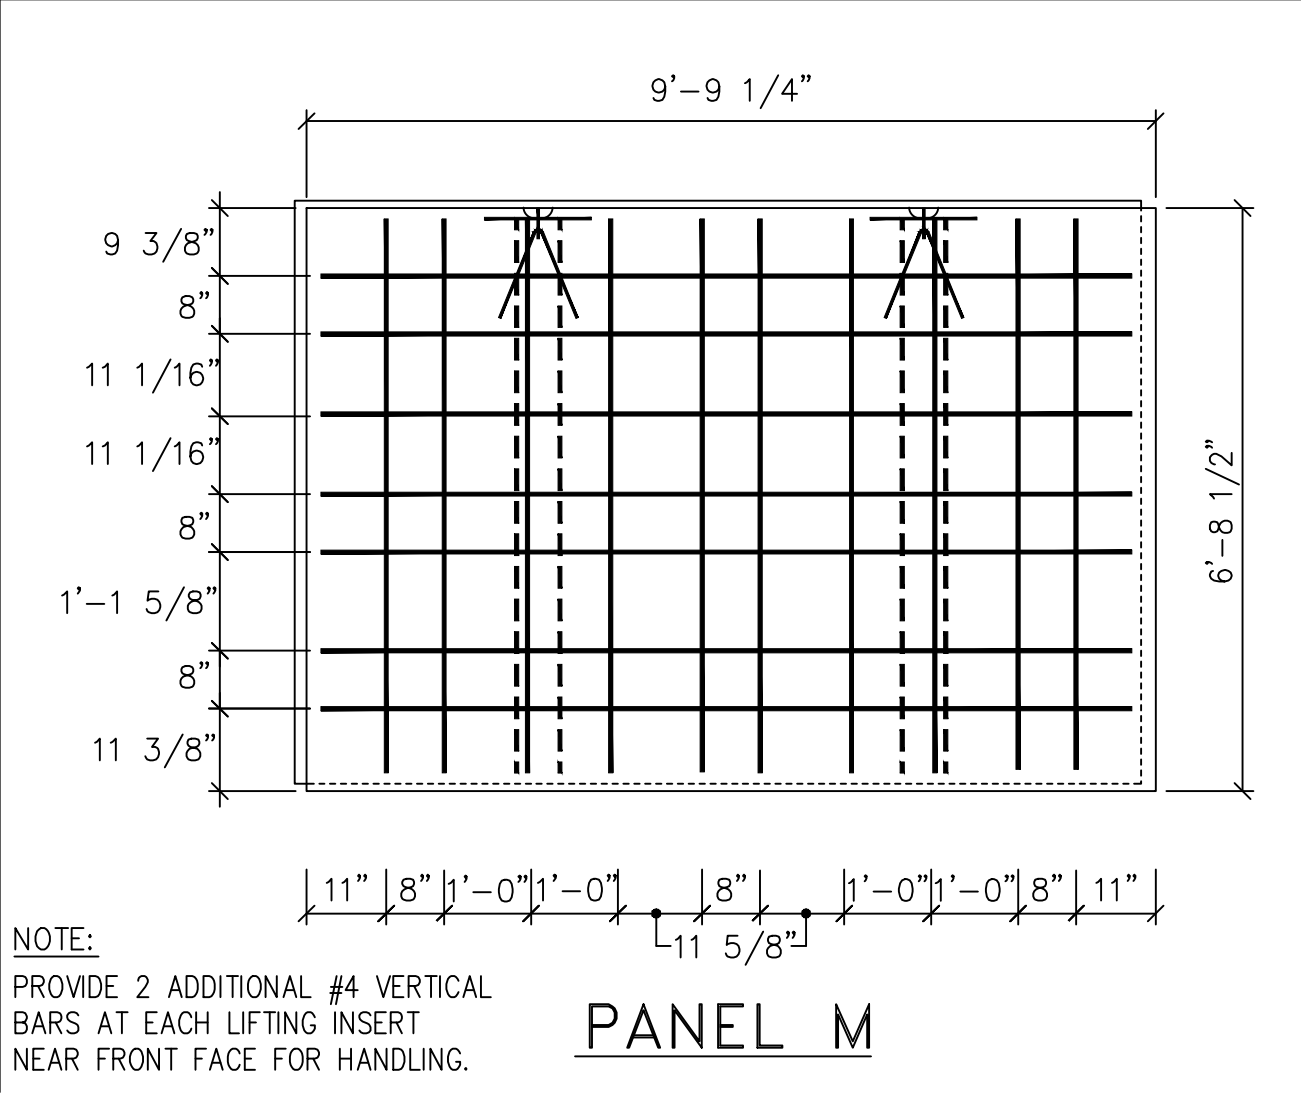

PANEL M

NOTE:
PROVIDE 2 ADDITIONAL #4 VERTICAL
BARS AT EACH LIFTING INSERT
NEAR FRONT FACE FOR HANDLING.

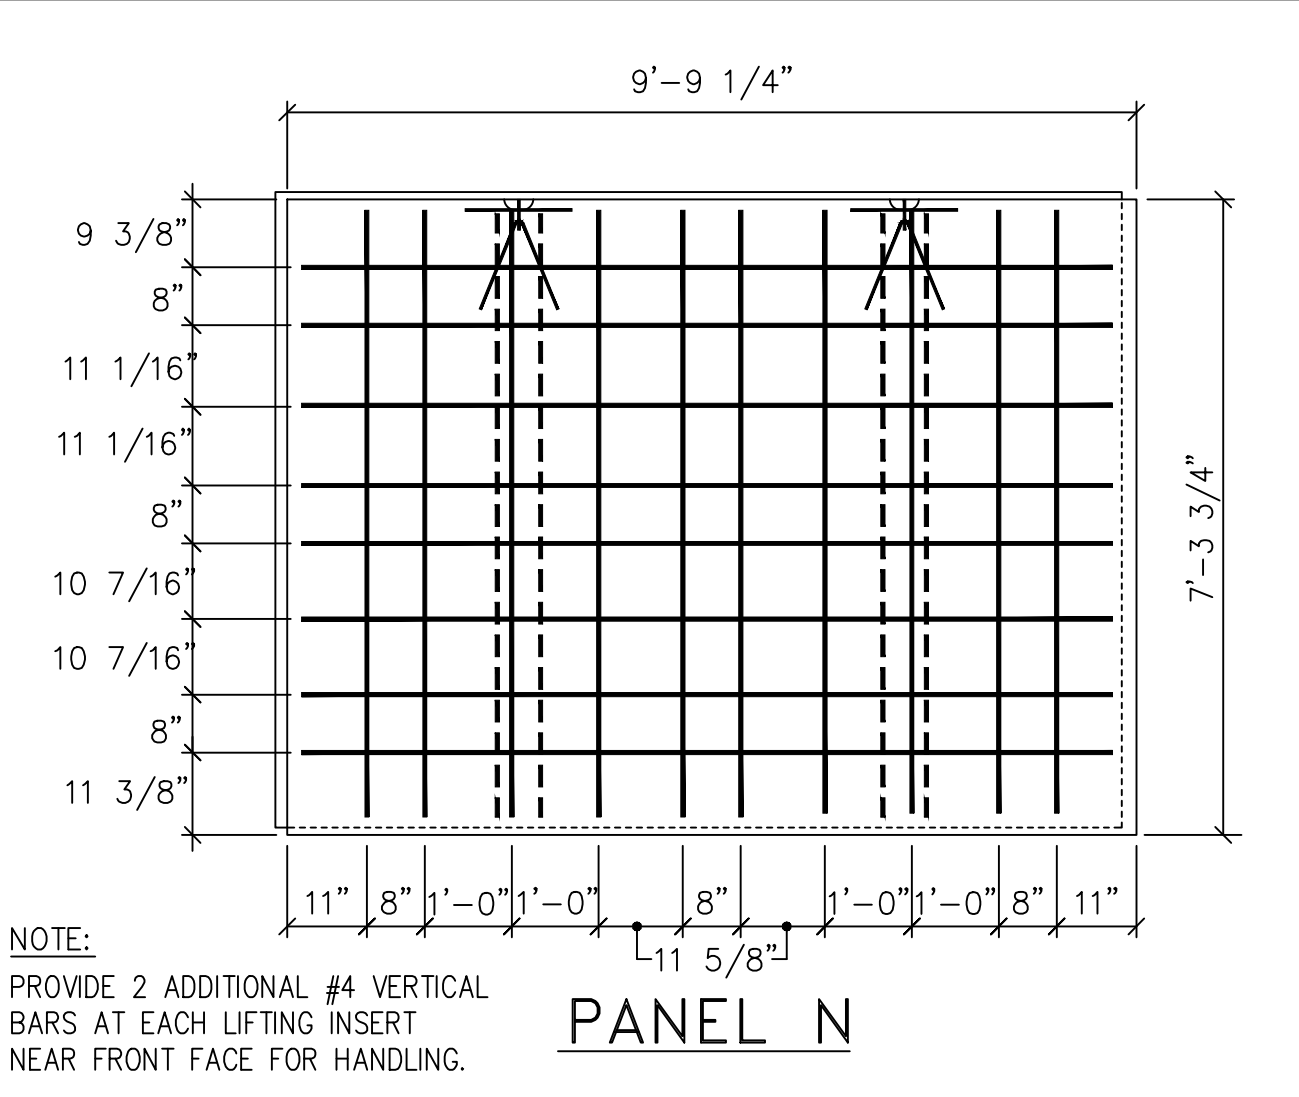

PANEL N


NOTE:
PROVIDE 2 ADDITIONAL #4 VERTICAL
BARS AT EACH LIFTING INSERT
NEAR FRONT FACE FOR HANDLING.

This drawing contains information proprietary to The Reinforced Earth Company, and is being furnished for the use of The Ohio Department of Transportation only in connection with this project, and the information contained is not to be transmitted to any other organization unless specifically authorized in writing by The Reinforced Earth Company. The Reinforced Earth Company is the exclusive licensee in the United States under patents held by our affiliated companies, and the furnishing of this drawing does not constitute an expressed or implied license under any applicable patents.

The design contained on these drawings is based on information provided by the Owner. On the basis of this information, The Reinforced Earth Company has designed, and is responsible for the internal stability of the structure only. External stability, including foundation (bearing capacity and settlement) and global stability (including sliding and rotation), is the responsibility of the Owner.

CERTIFIED WITH RESPECT TO INTERNAL STABILITY
OF REINFORCED EARTH STRUCTURES ONLY.



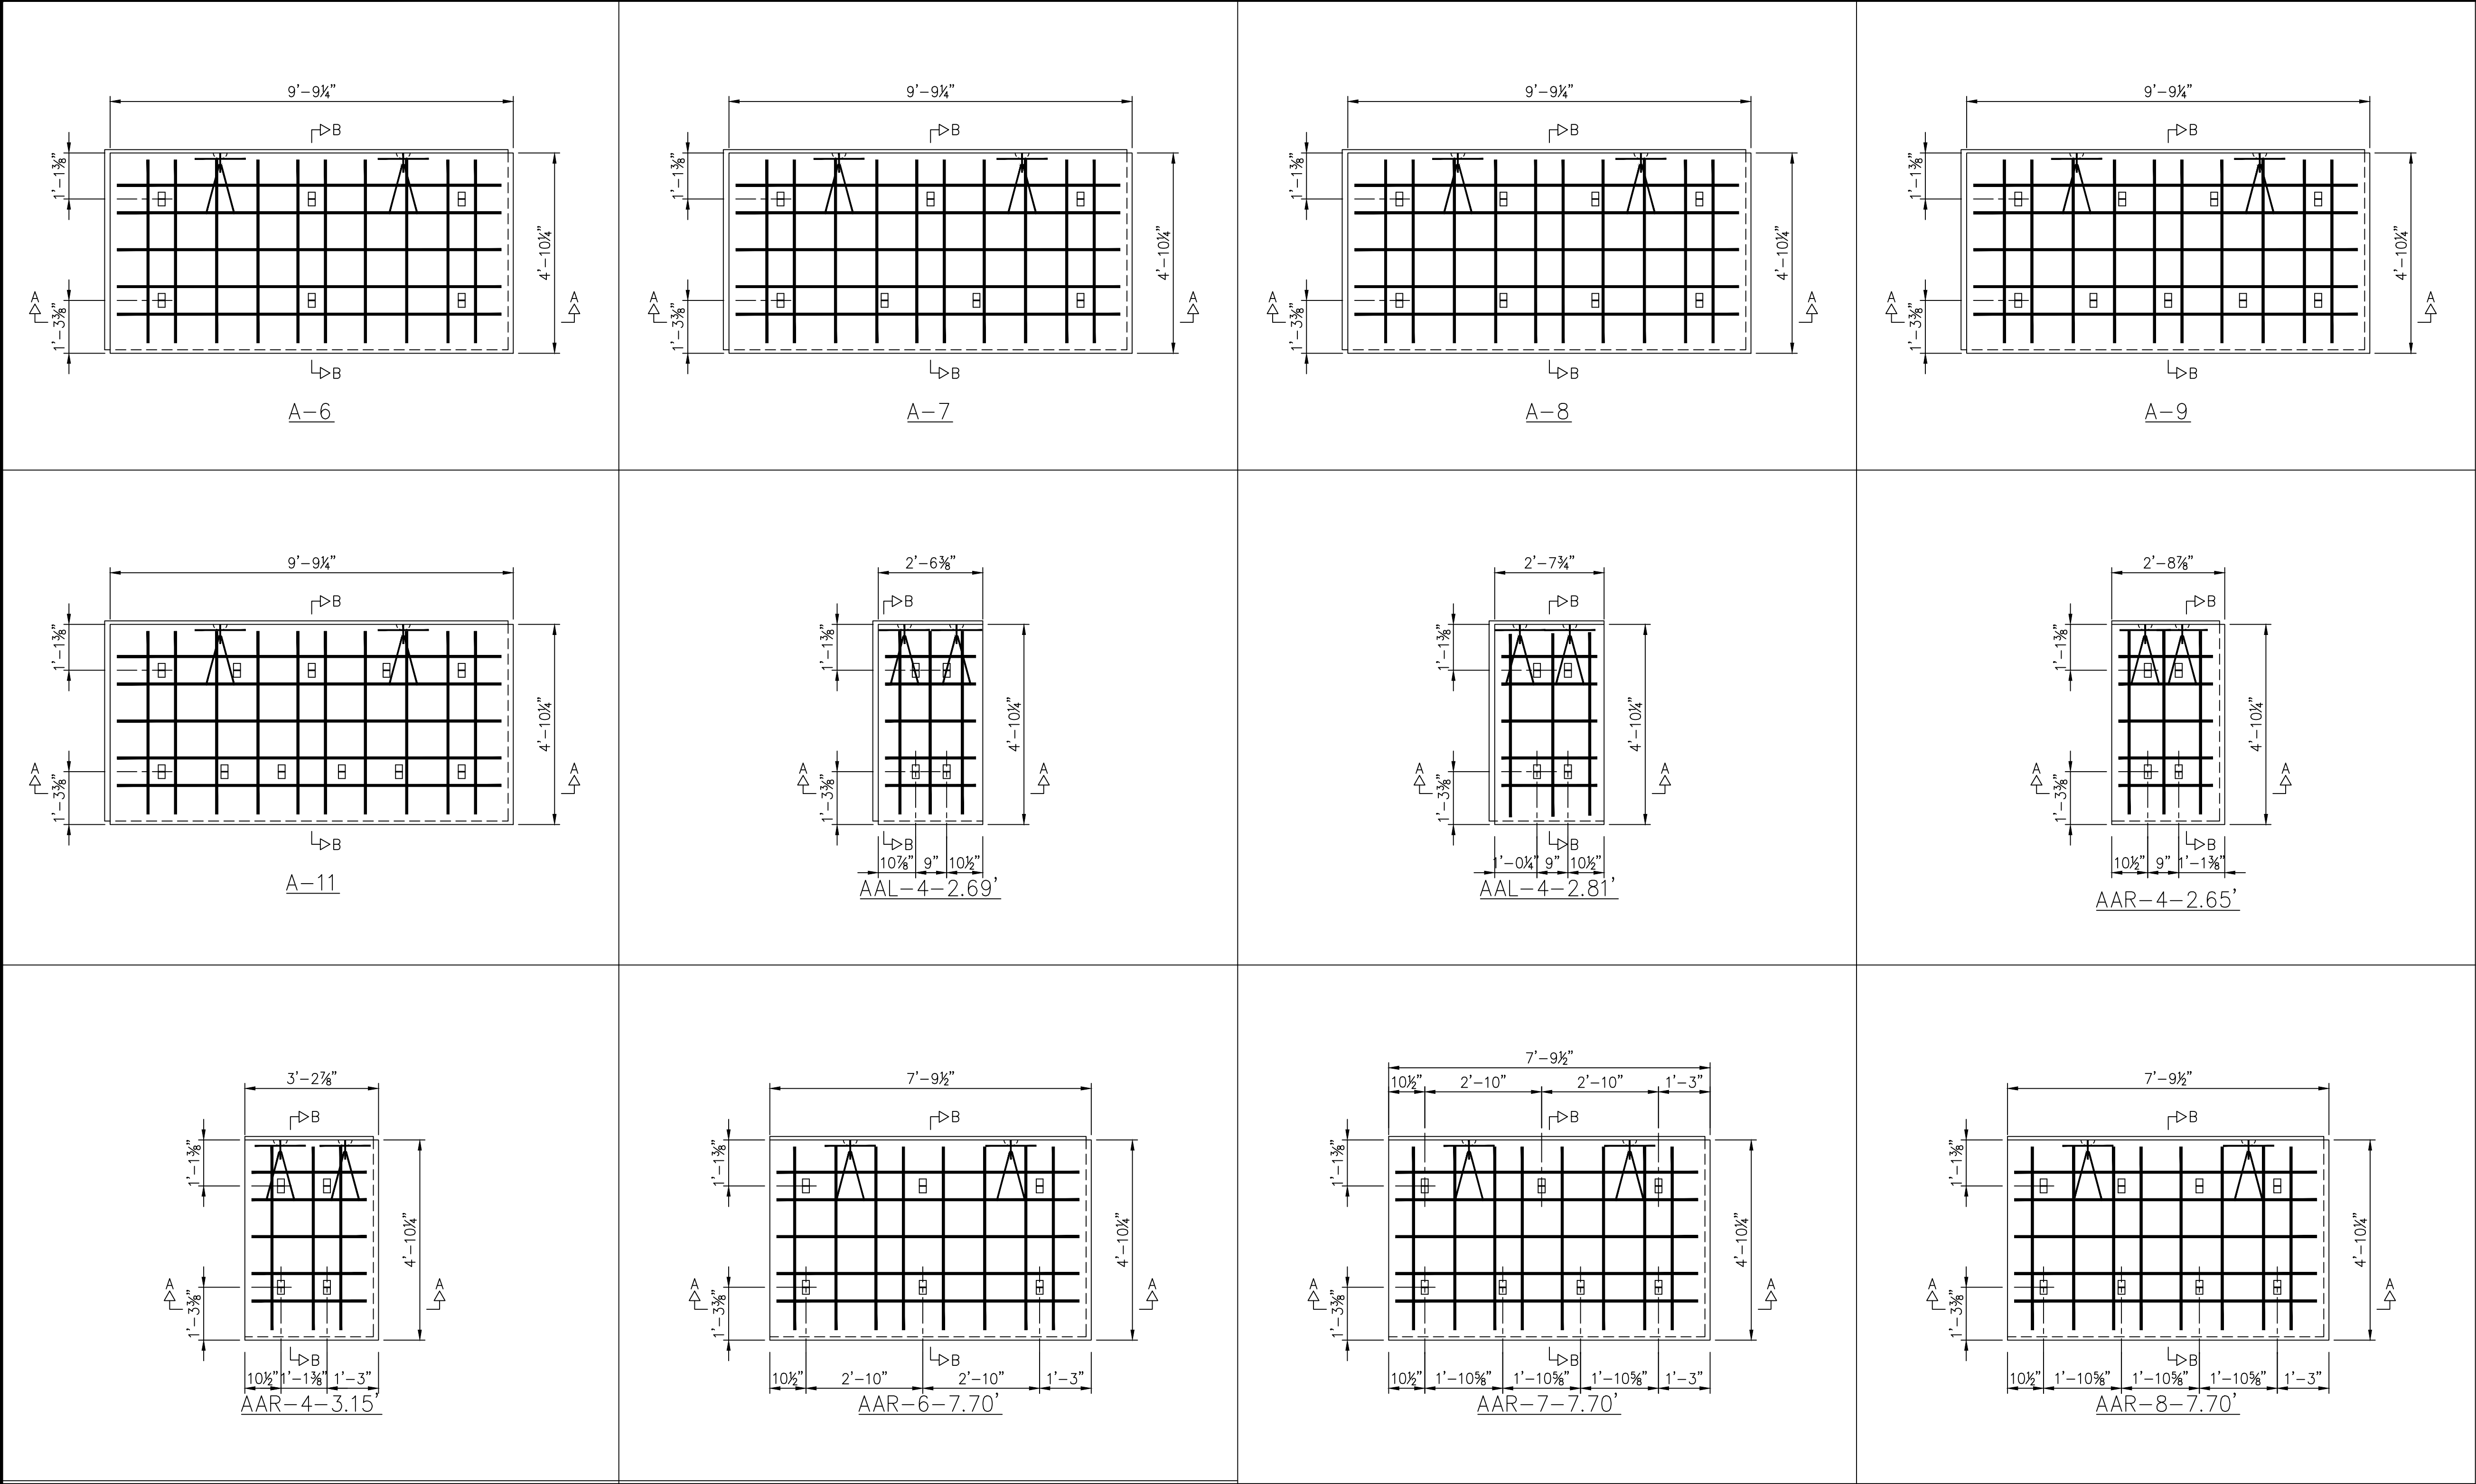


This drawing contains information proprietary to The Reinforced Earth Company, and is being furnished for the use of The Ohio Department of Transportation only in connection with this project, and the information contained is not to be transmitted to any other organization unless specifically authorized in writing by The Reinforced Earth Company. The Reinforced Earth Company is the exclusive licensee in the United States under patents held by our affiliated companies, and the furnishing of this drawing does not constitute an expressed or implied license under any applicable patents.

The design contained on these drawings is based on information provided by the Owner. On the basis of this information, The Reinforced Earth Company has designed, and is responsible for the internal stability of the structure only. External stability, including foundation (bearing capacity and settlement) and global stability (including sliding and rotation), is the responsibility of the Owner.


NOTE: FOR SECTIONS A-A AND B-B REFER TO SHEETS S2, S3 AND S4.

CERTIFIED WITH RESPECT TO INTERNAL STABILITY
OF REINFORCED EARTH STRUCTURES ONLY.

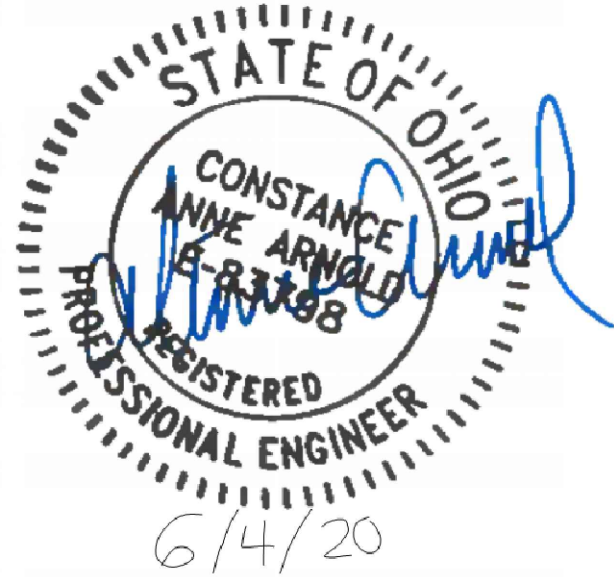

CUY-IR490
SR010-2.09/19.28












06 OF 9

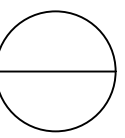

18631

PRECAST PANEL SHOP DRAWINGS
CUY-IR490/SR010-2.09/19.28
CITY OF CLEVELAND, CUYAHOGA COUNTY, OHIO
OHIO DEPARTMENT OF TRANSPORTATION

DESIGNED: MS	DRAWN: NR	REVIEWED: MS	DATE: 04/27/2020
CHECKED: MS	REVISED:	PID No: 96833	

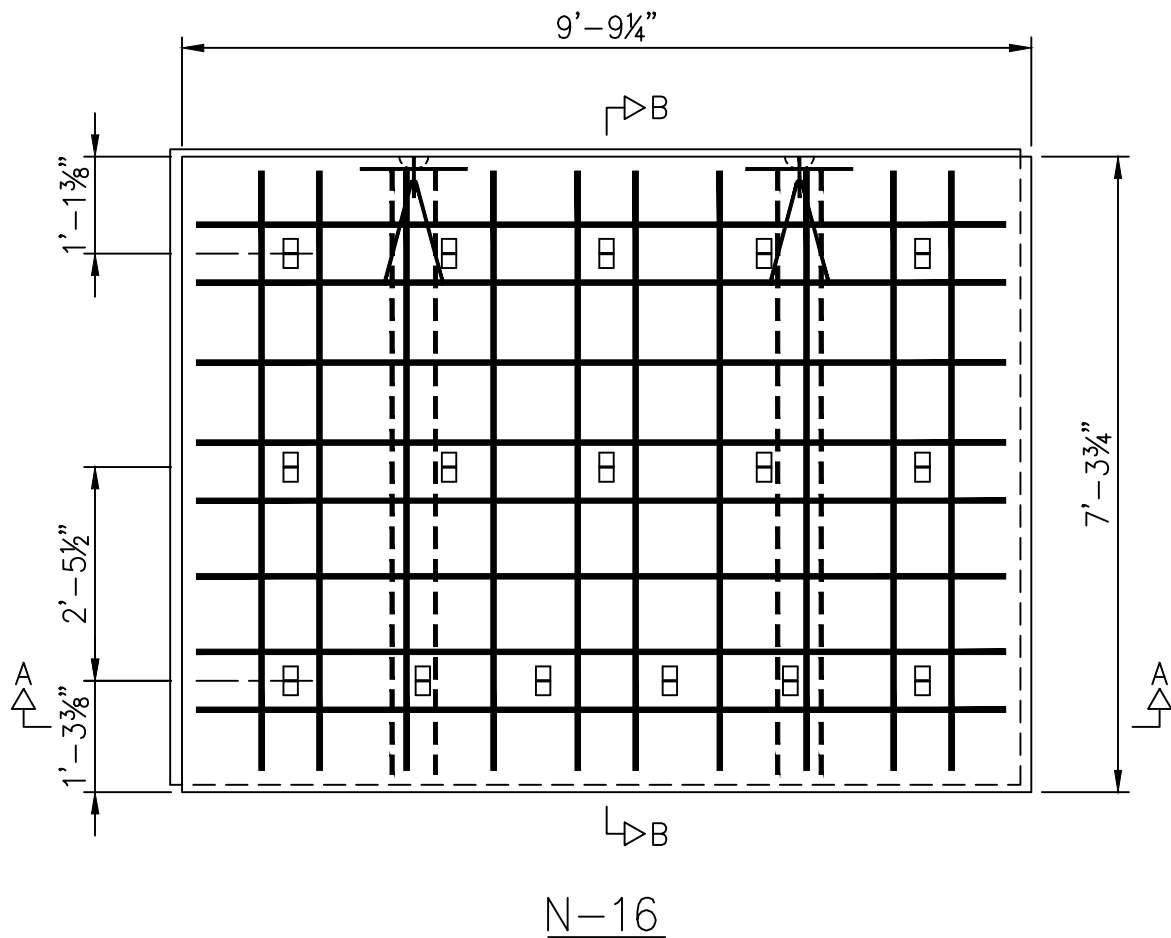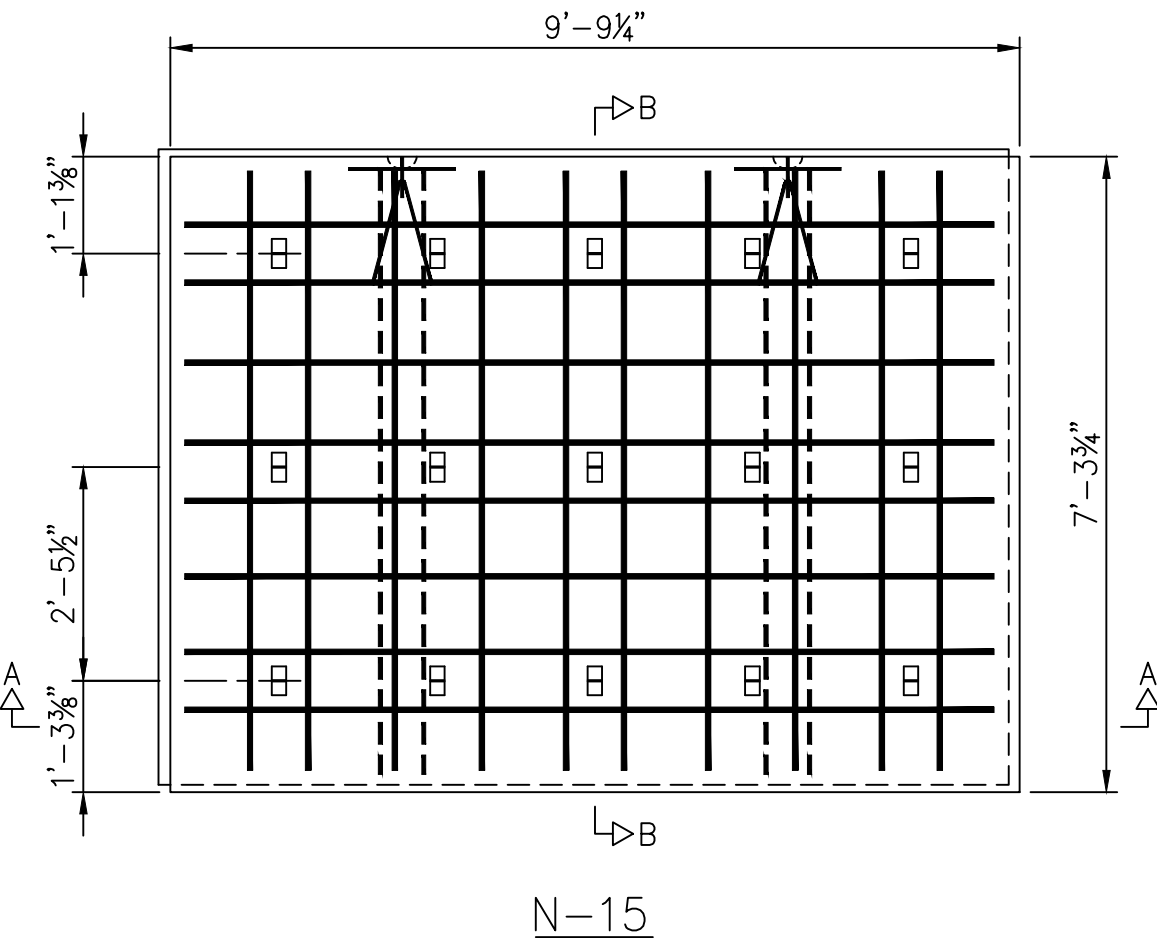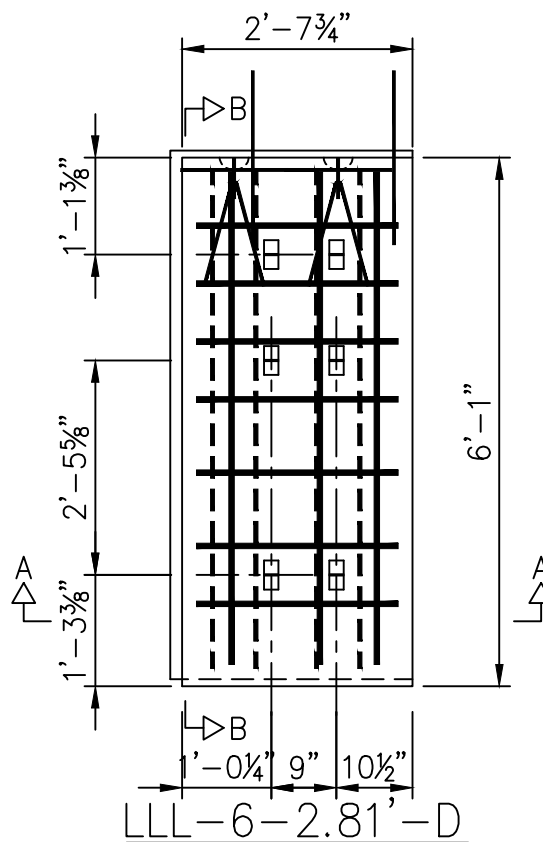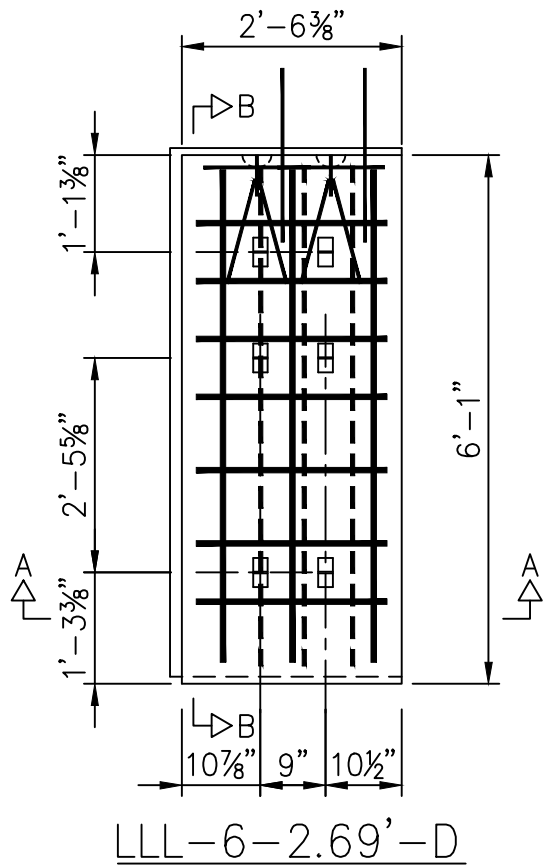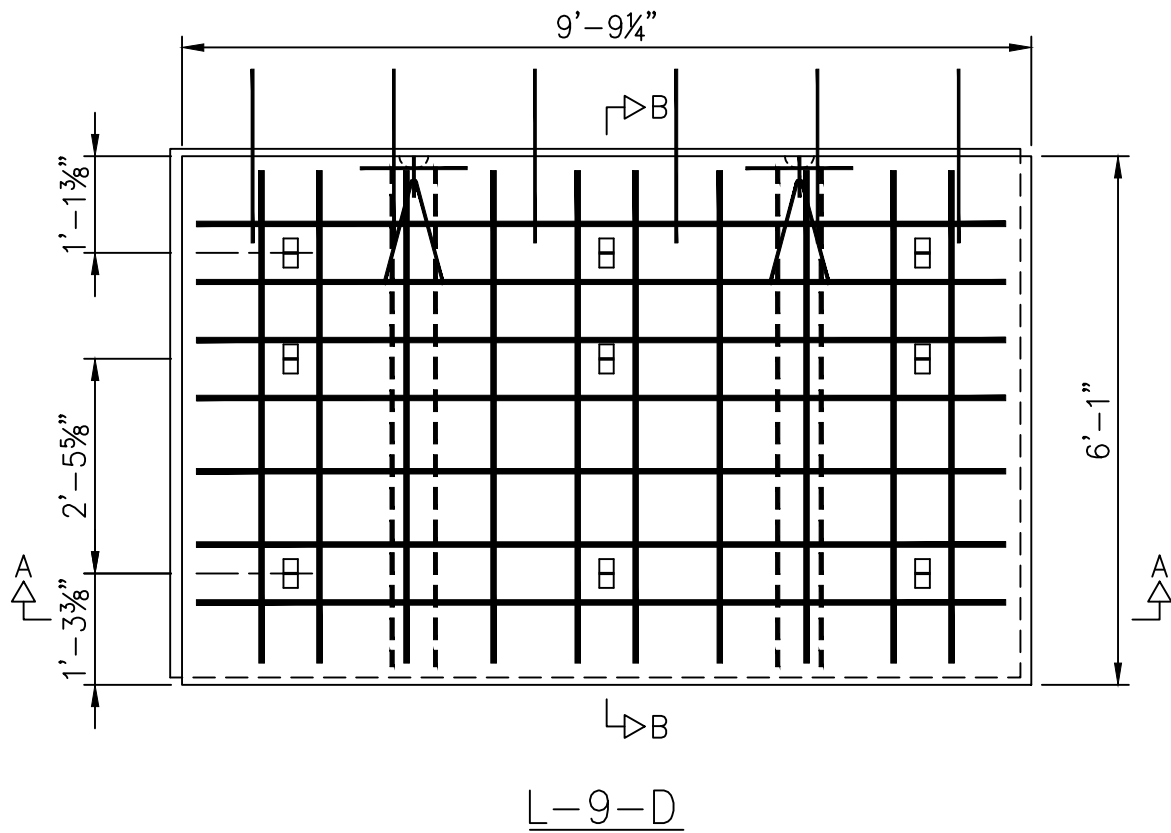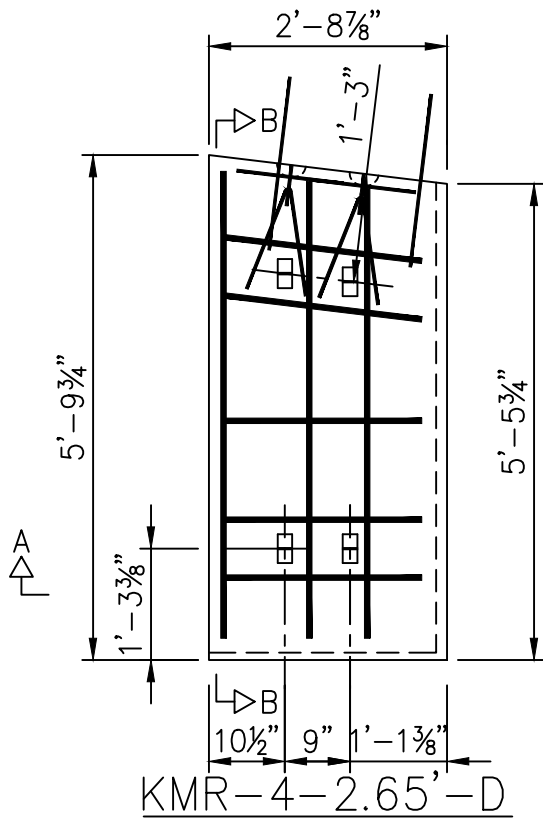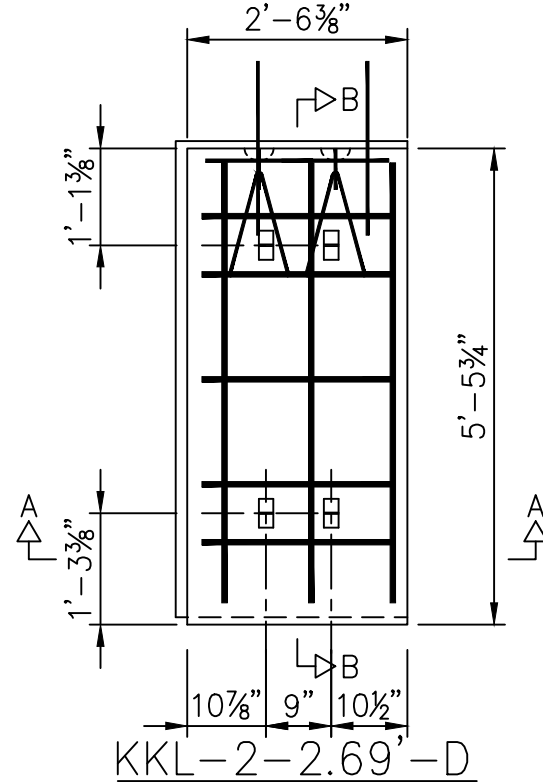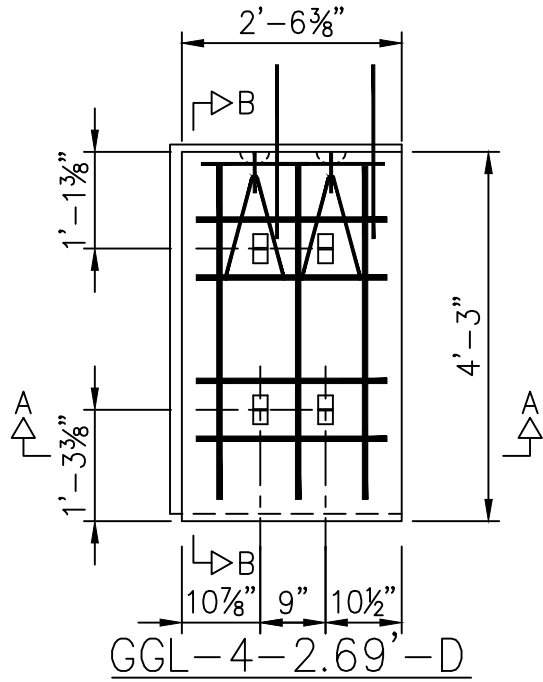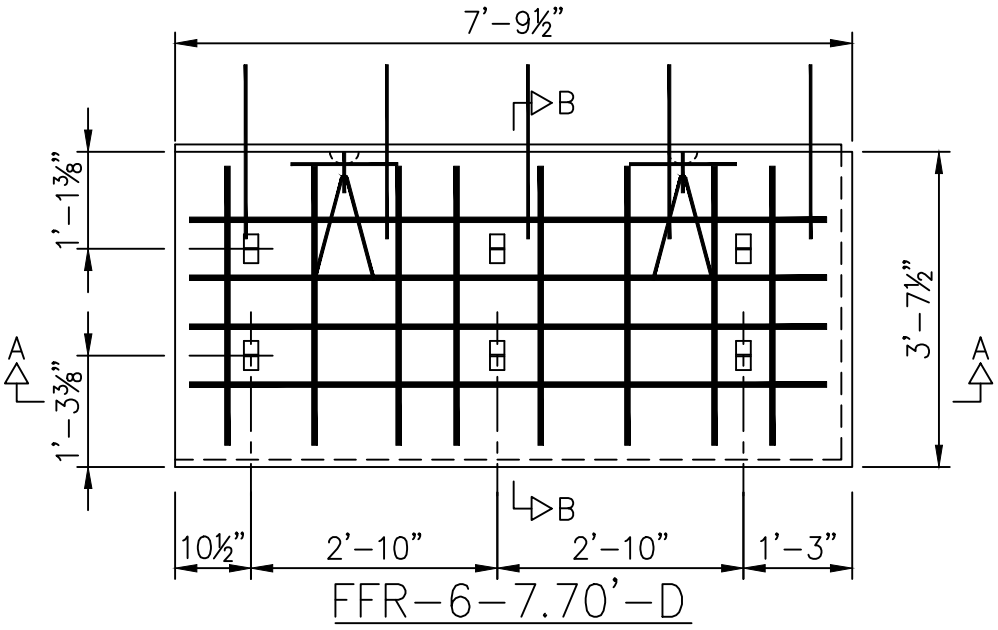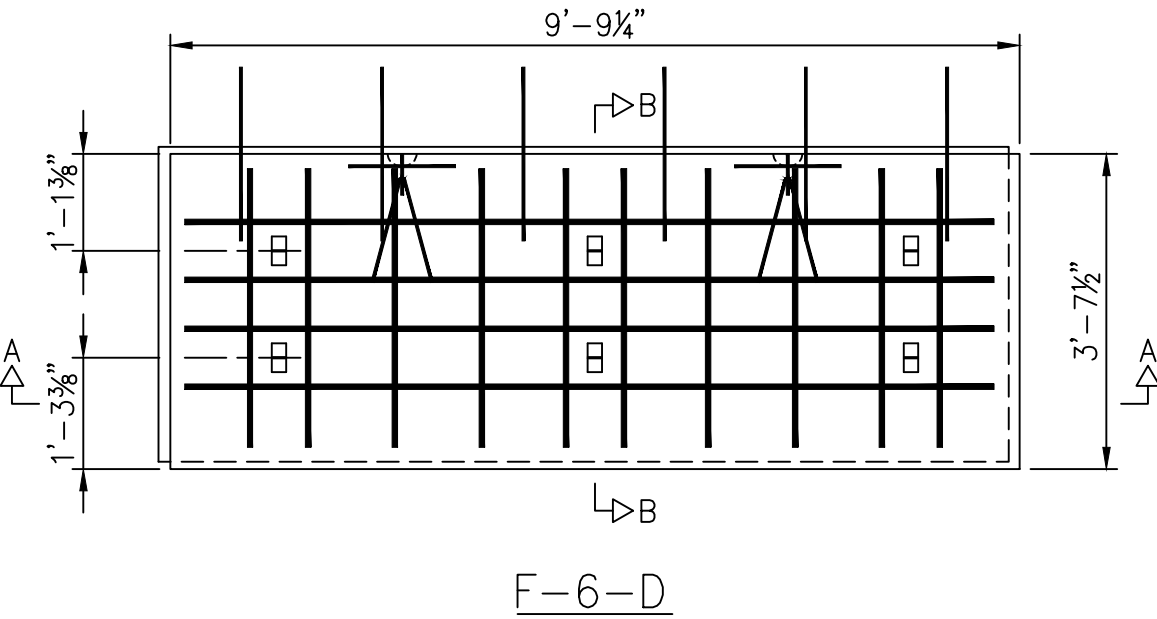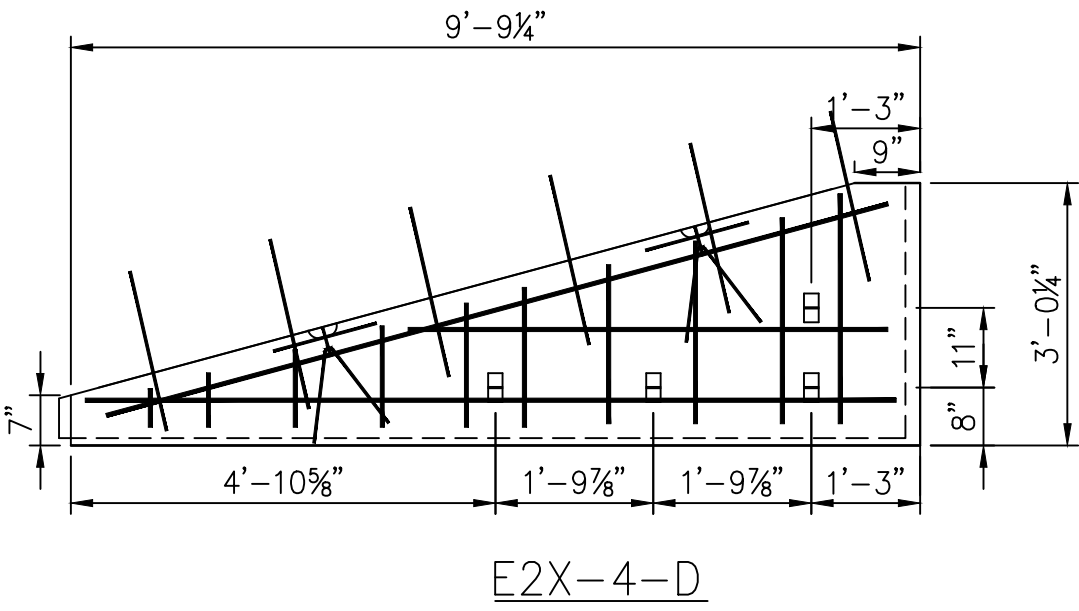


NOTE: FOR SECTIONS A-A AND B-B REFER TO SHEETS S2, S3 AND S4.

This drawing contains information proprietary to The Reinforced Earth Company, and is being furnished for the use of The Ohio Department of Transportation only in connection with this project, and the information contained is not to be transmitted to any other organization unless specifically authorized in writing by The Reinforced Earth Company. The Reinforced Earth Company is the exclusive licensee in the United States under patents held by our affiliated companies, and the furnishing of this drawing does not constitute an expressed or implied license under any applicable patents.

The design contained on these drawings is based on information provided by the Owner. On the basis of this information, The Reinforced Earth Company has designed, and is responsible for the internal stability of the structure only. External stability, including foundation (bearing capacity and settlement) and global stability (including sliding and rotation), is the responsibility of the Owner.

CERTIFIED WITH RESPECT TO INTERNAL STABILITY
OF REINFORCED EARTH STRUCTURES ONLY.

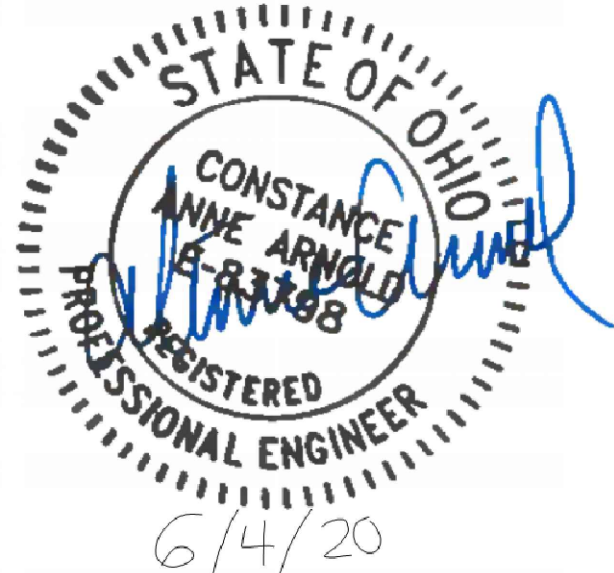

PRECAST PANEL SHOP DRAWINGS
CUY-IR490/SR010-2.09/19.28
CITY OF CLEVELAND, CUYAHOGA COUNTY, OHIO
OHIO DEPARTMENT OF TRANSPORTATION

CUY-IR490
SR010-2.09/19.28

07 OF 9

18631

DATE:
04/27/2020

REVIEWED:
MS













DRAWN:
NR

DESIGNED:
MS

PID No:
96833

REVISED:

CHECKED:
MS

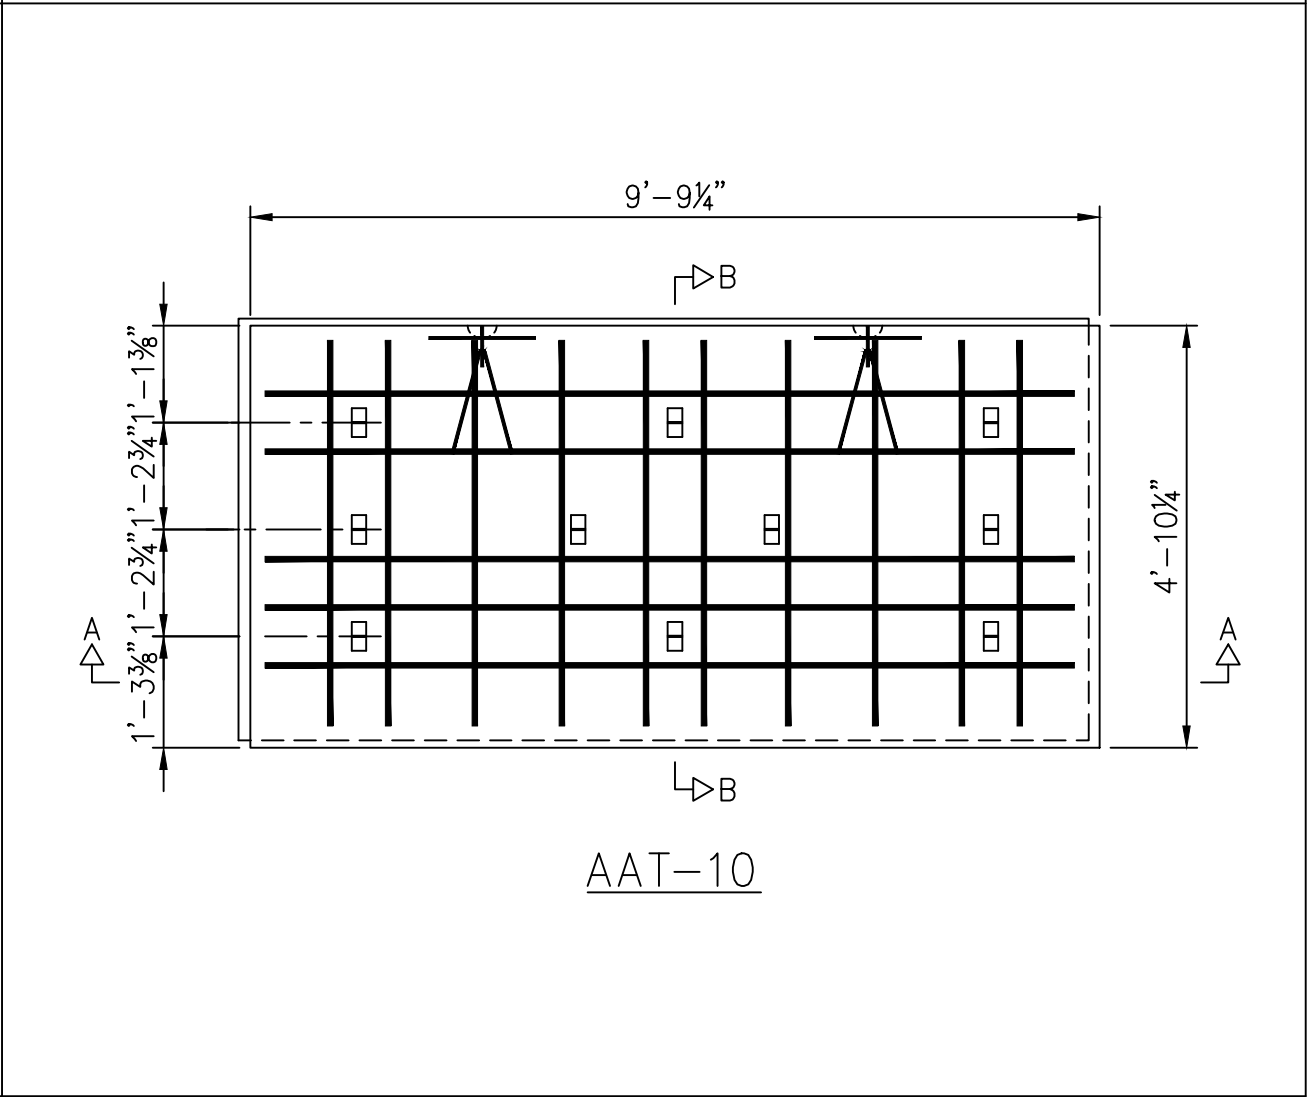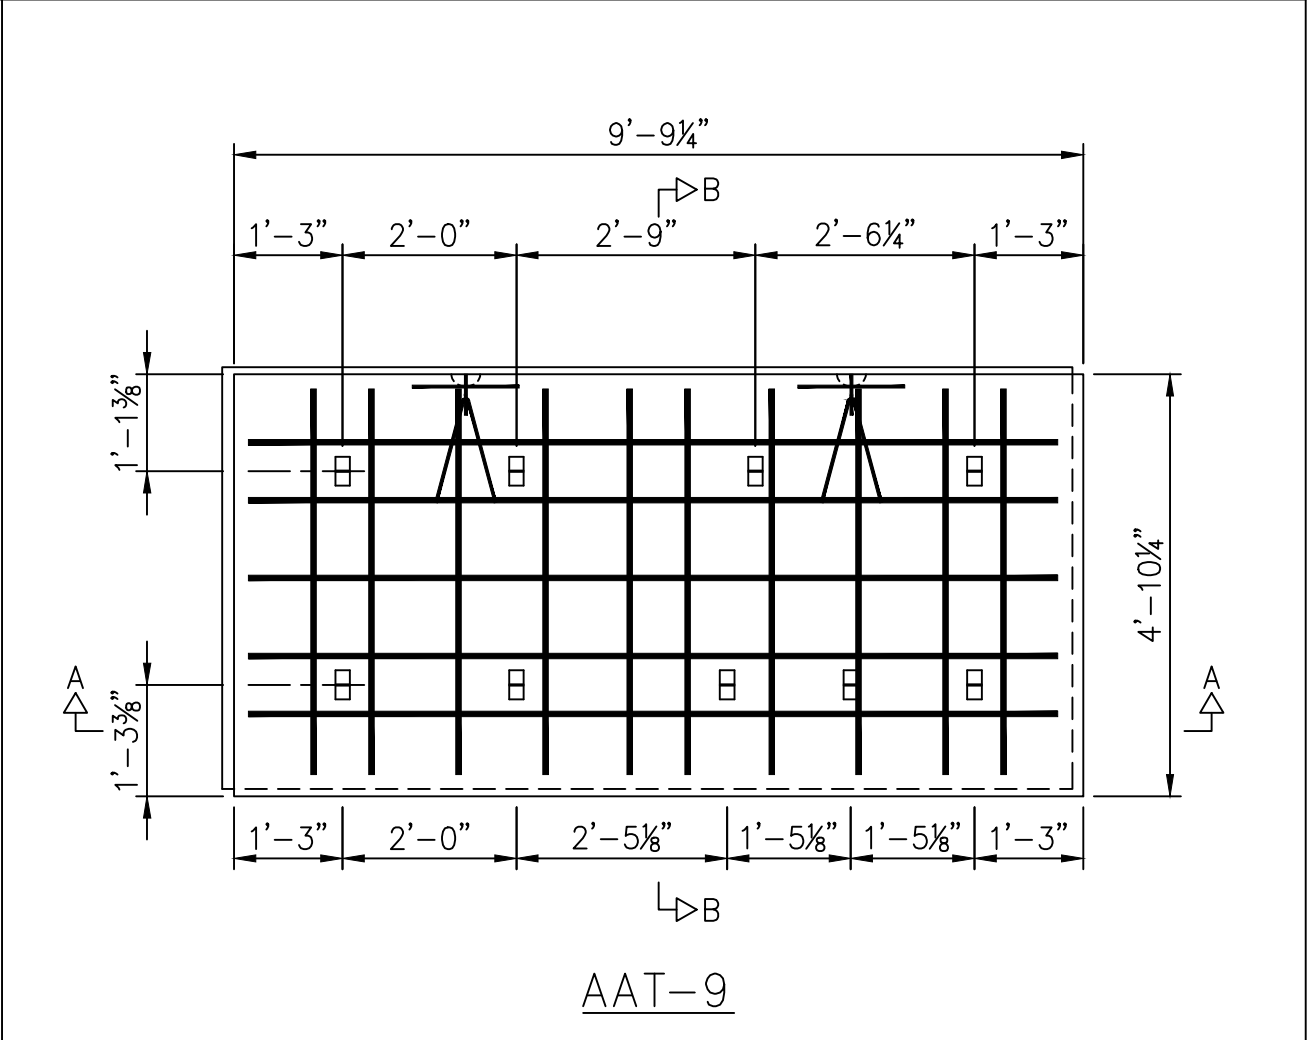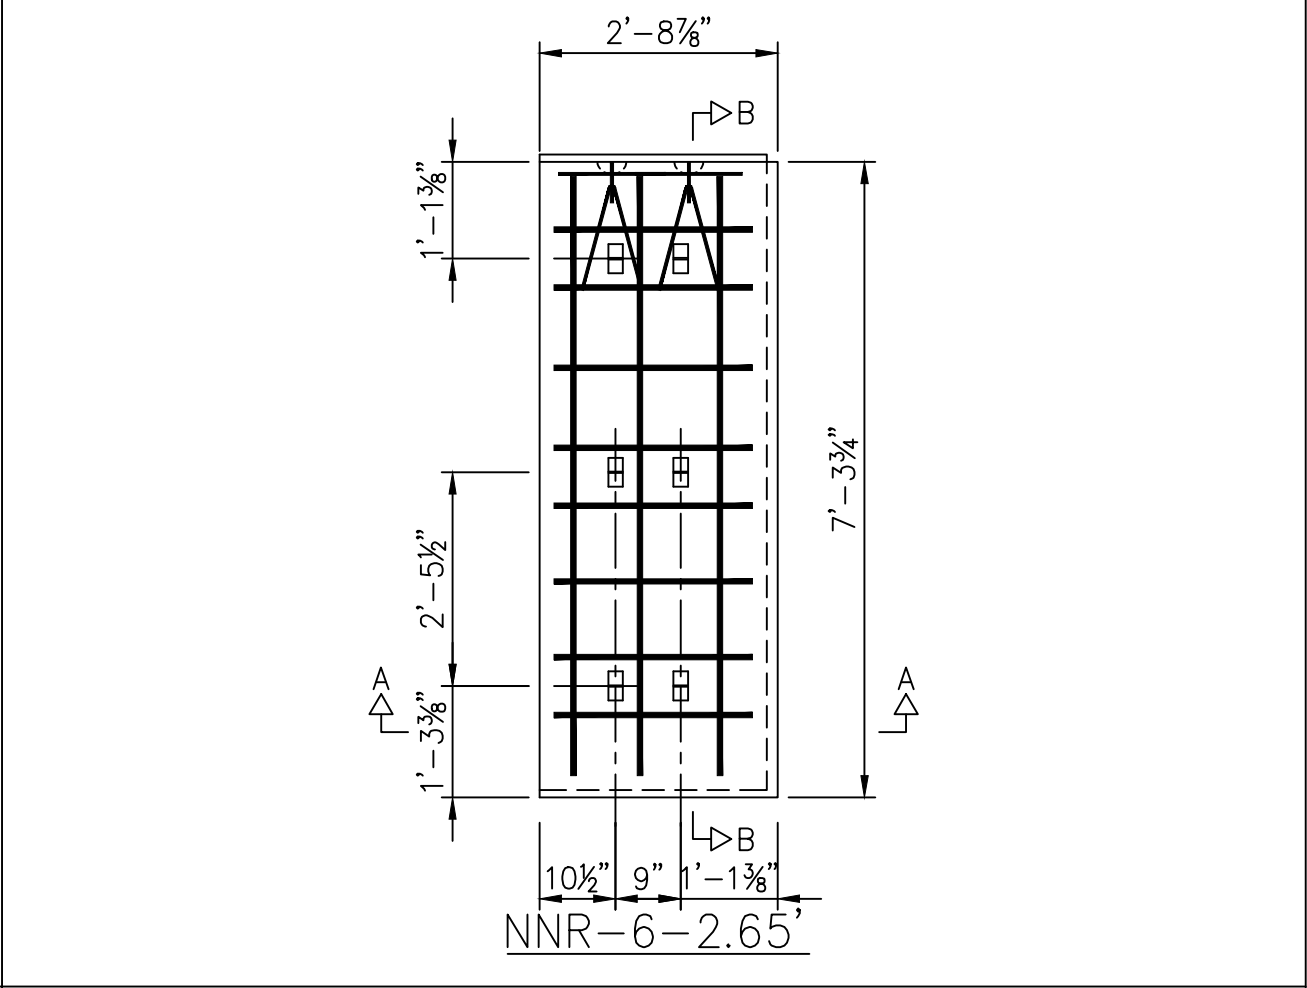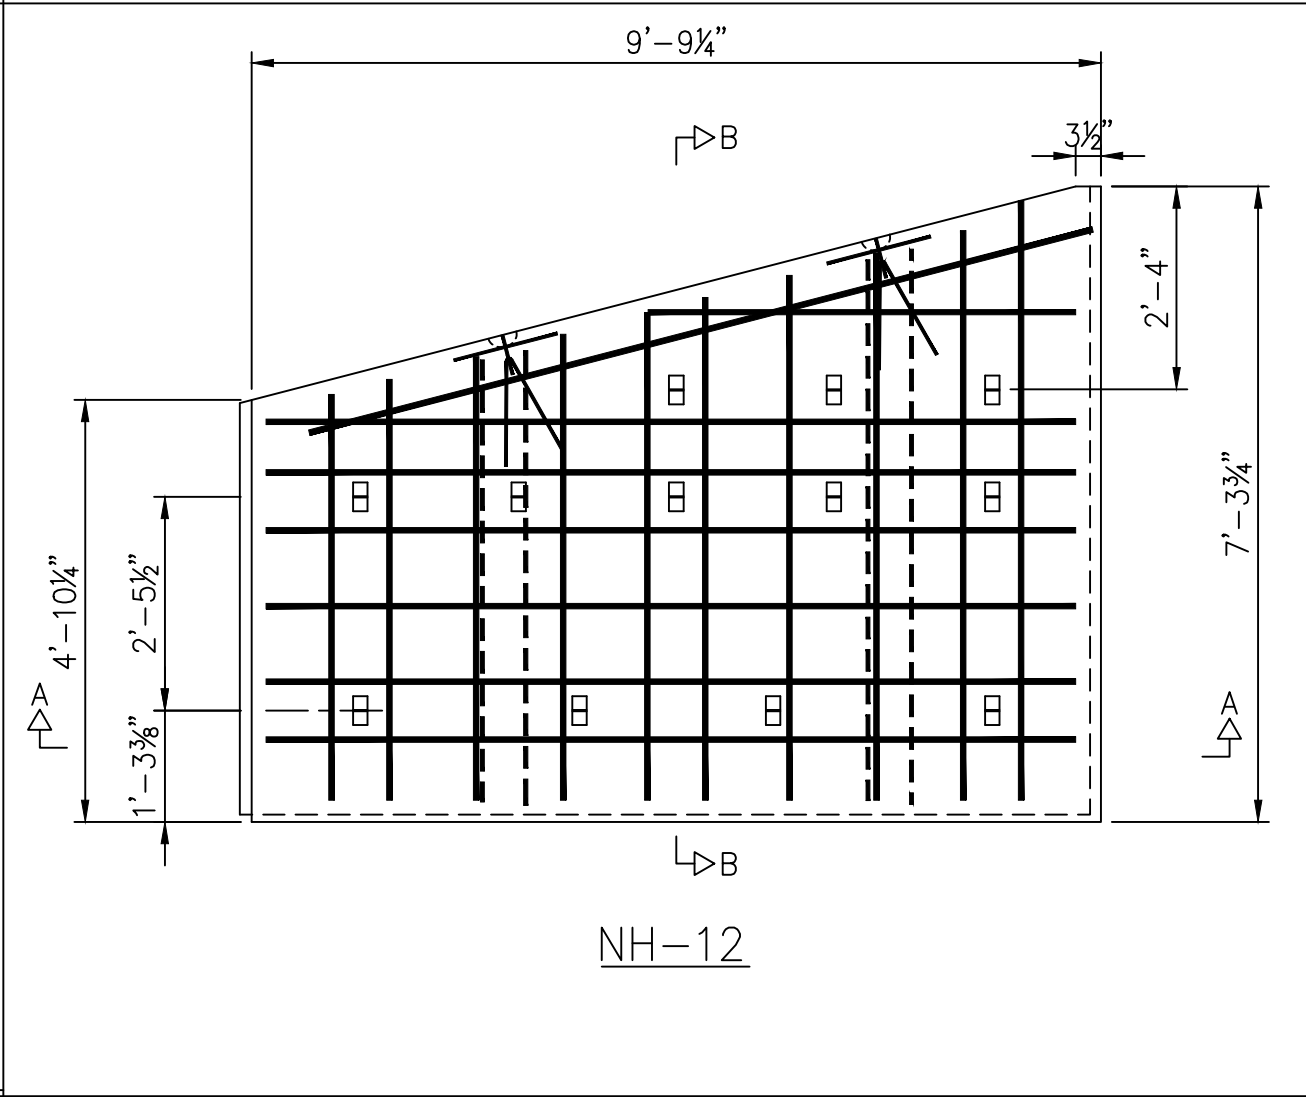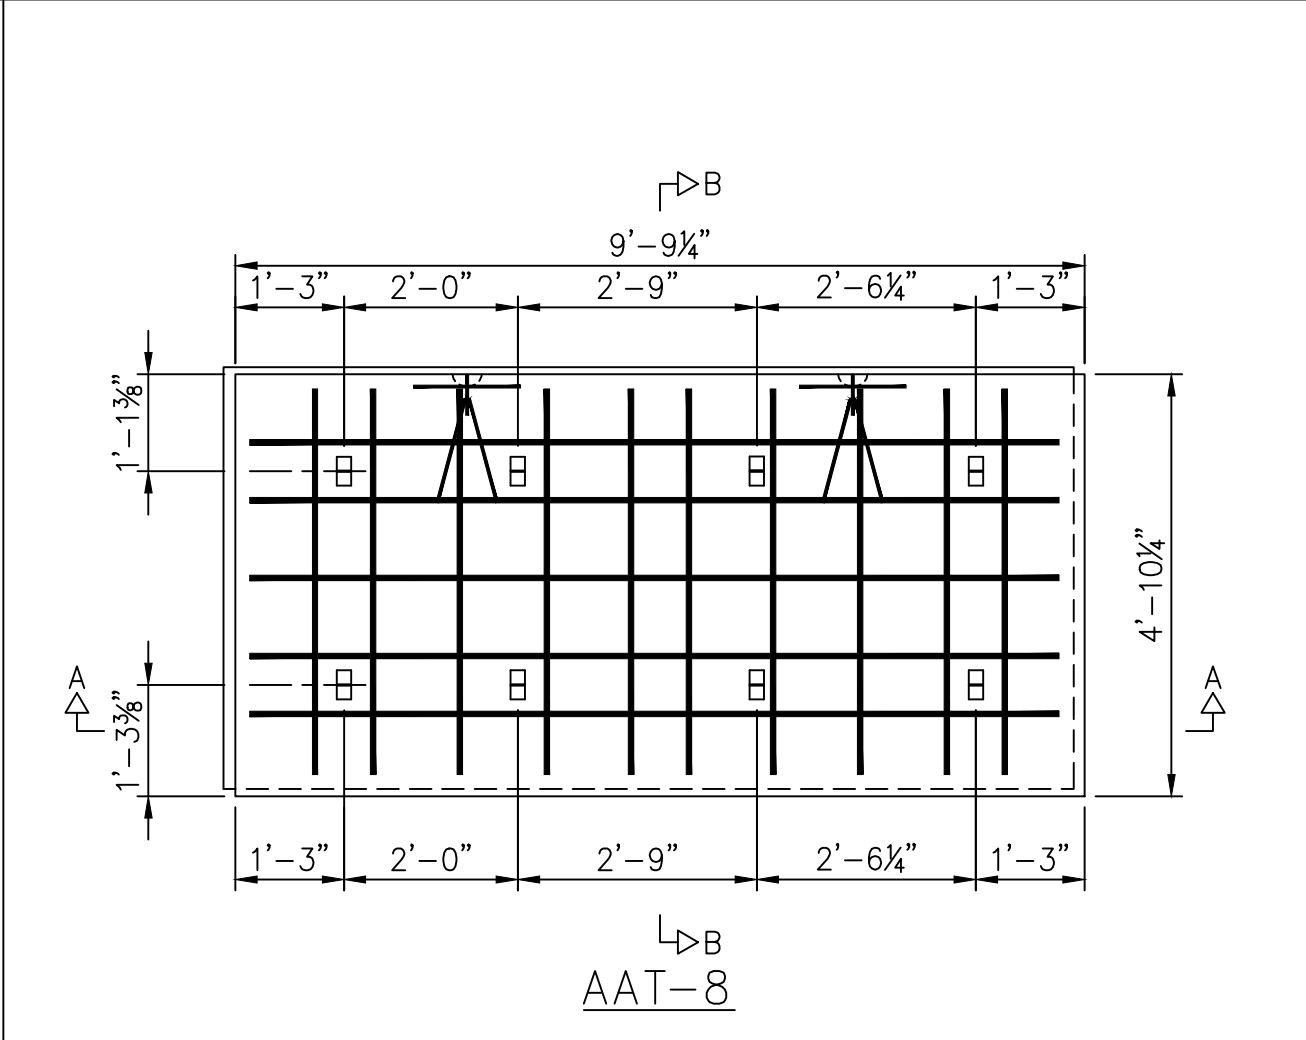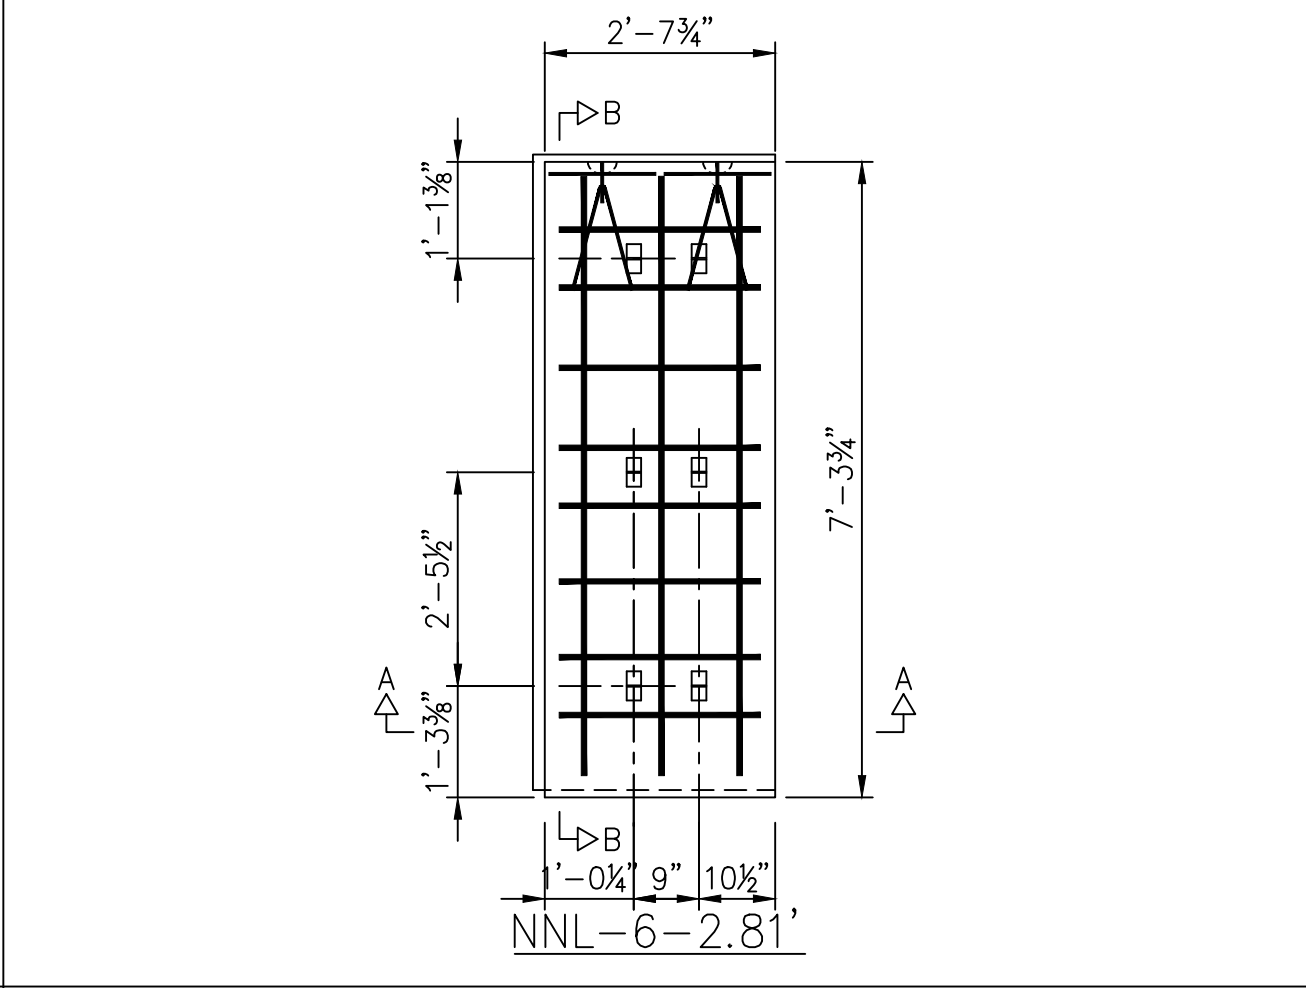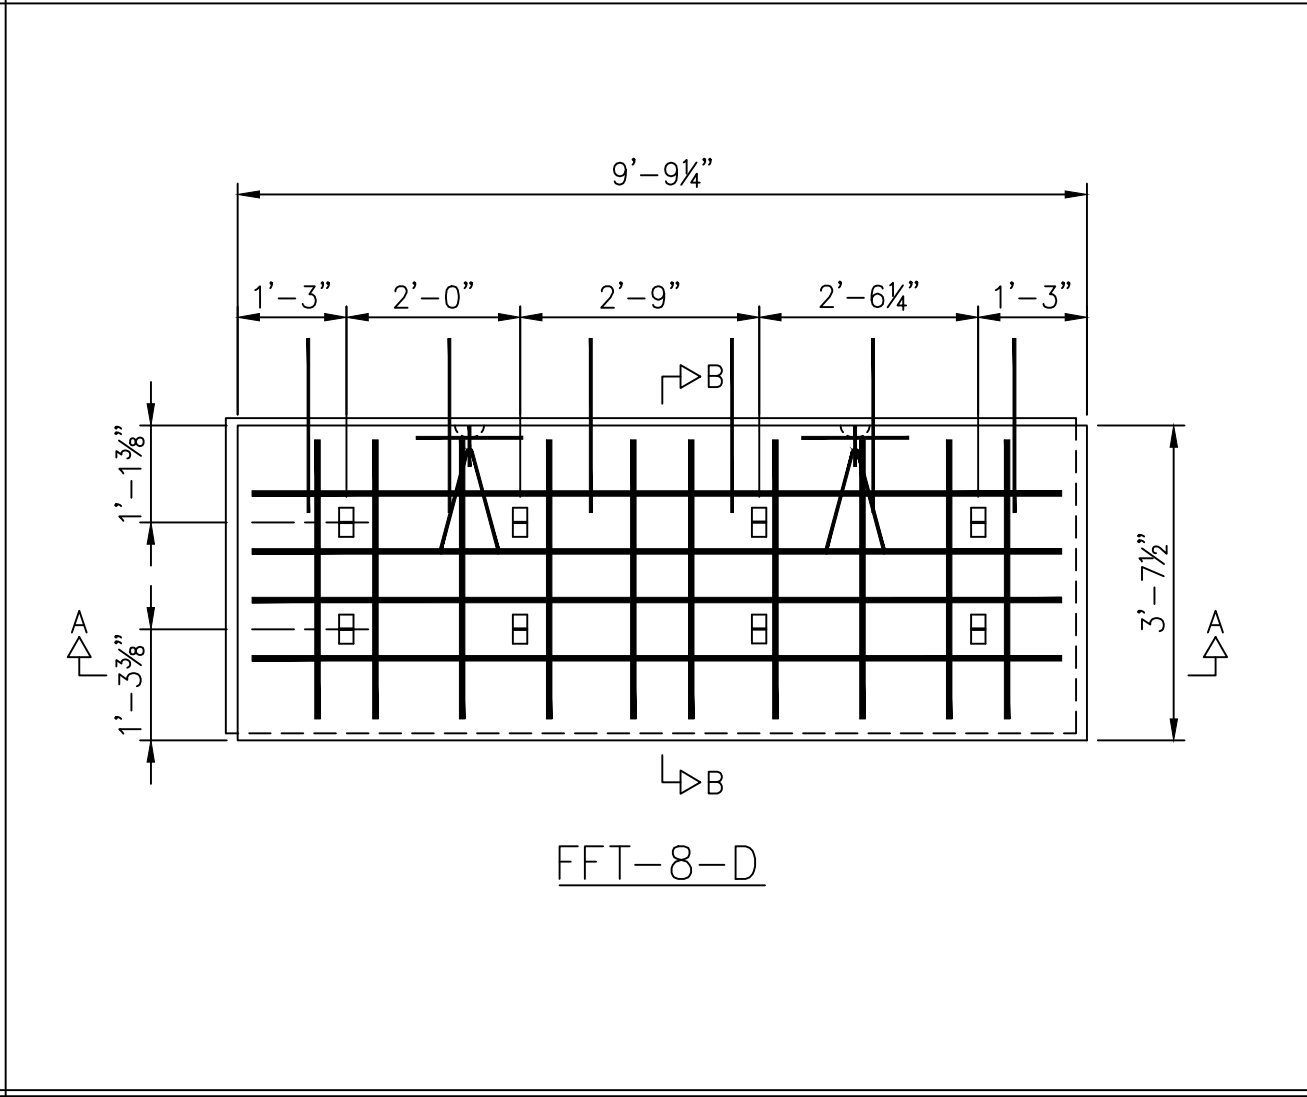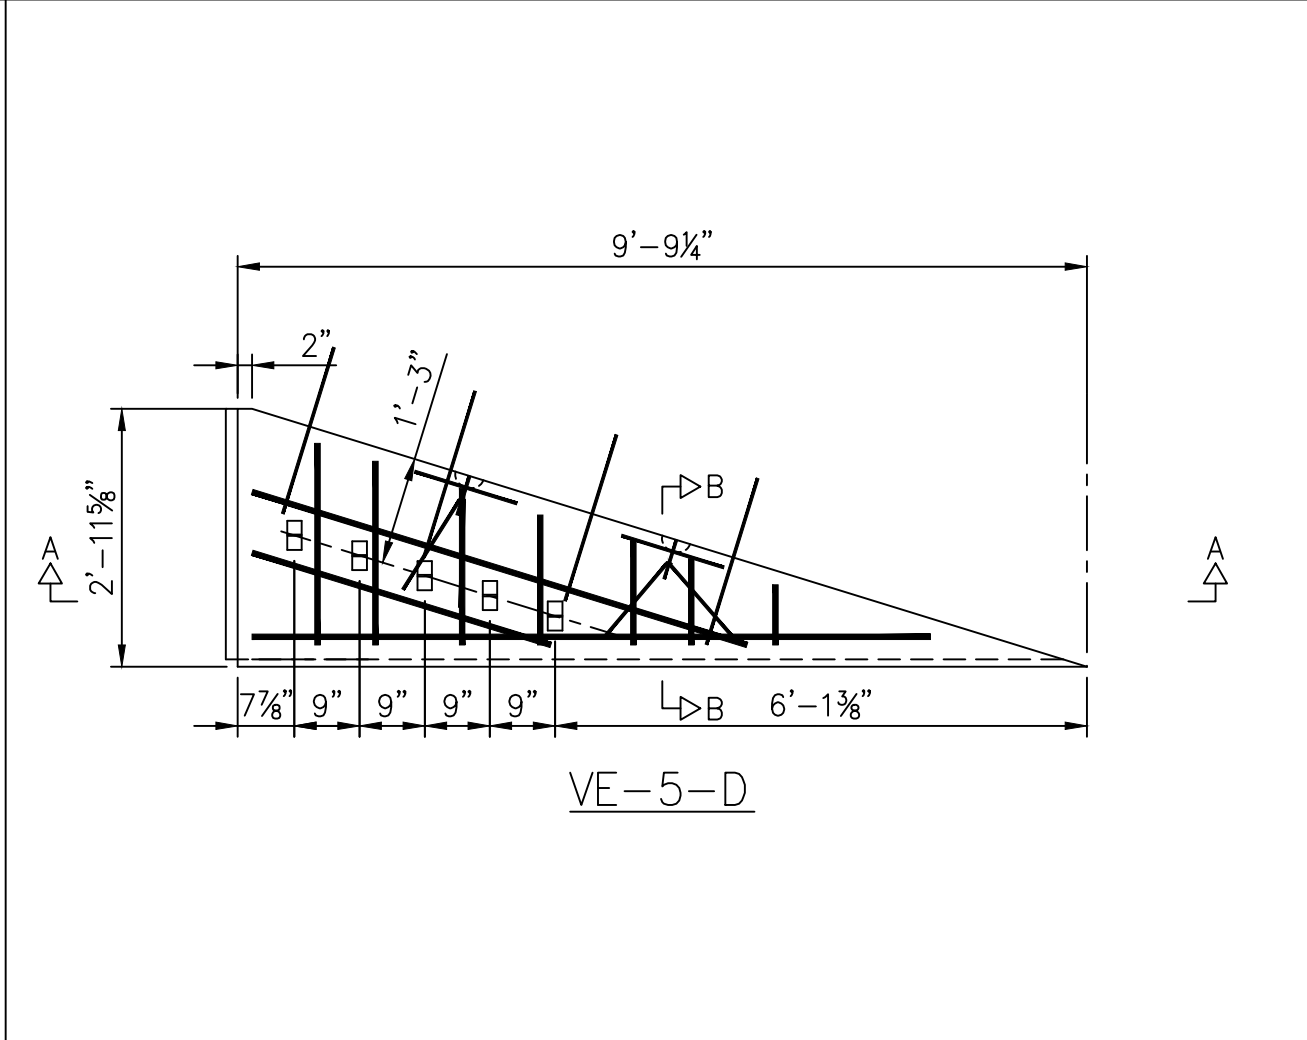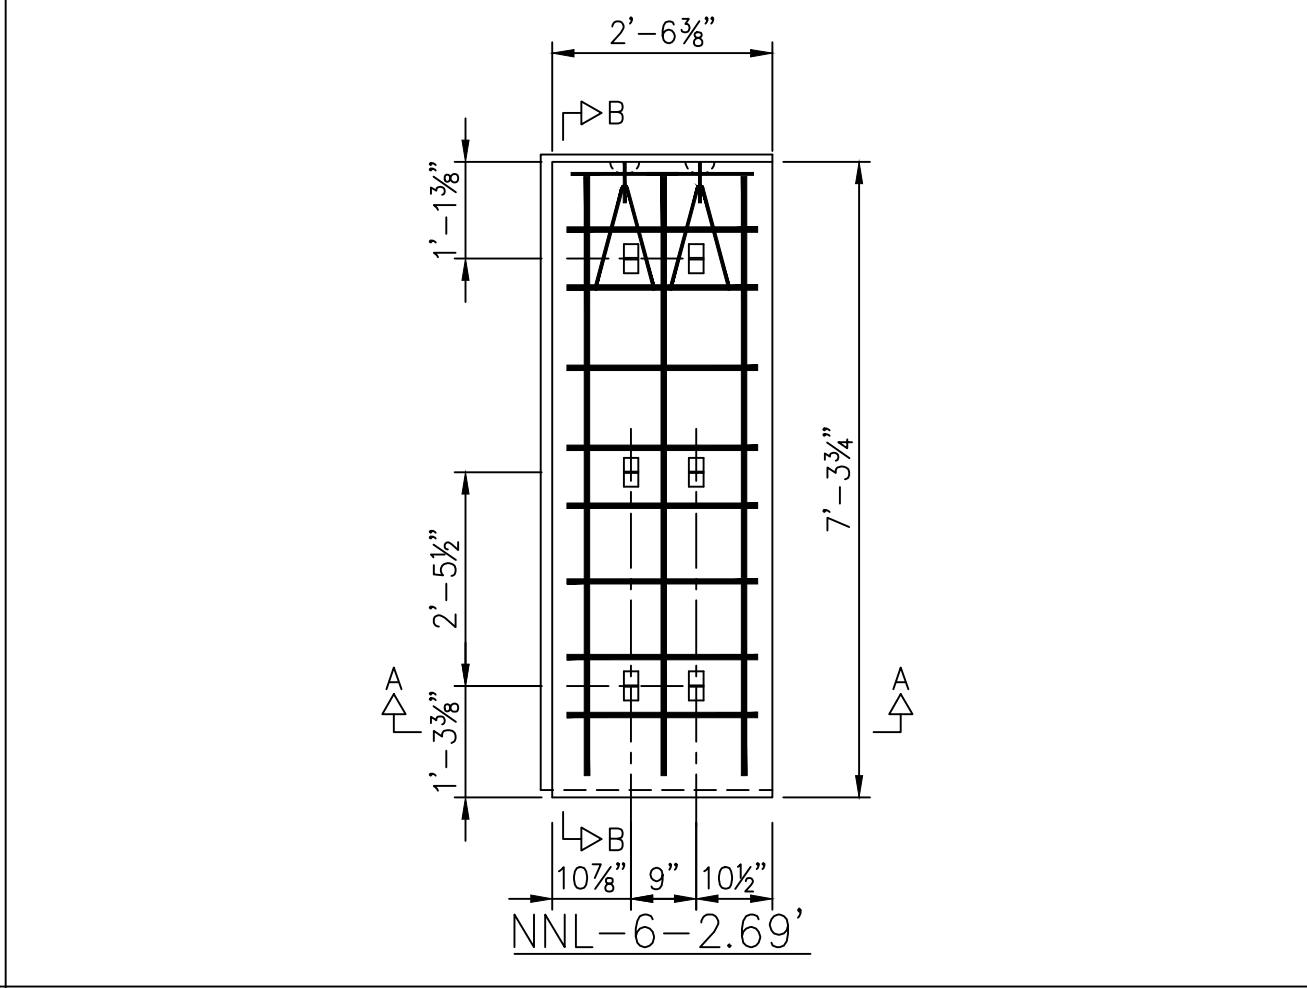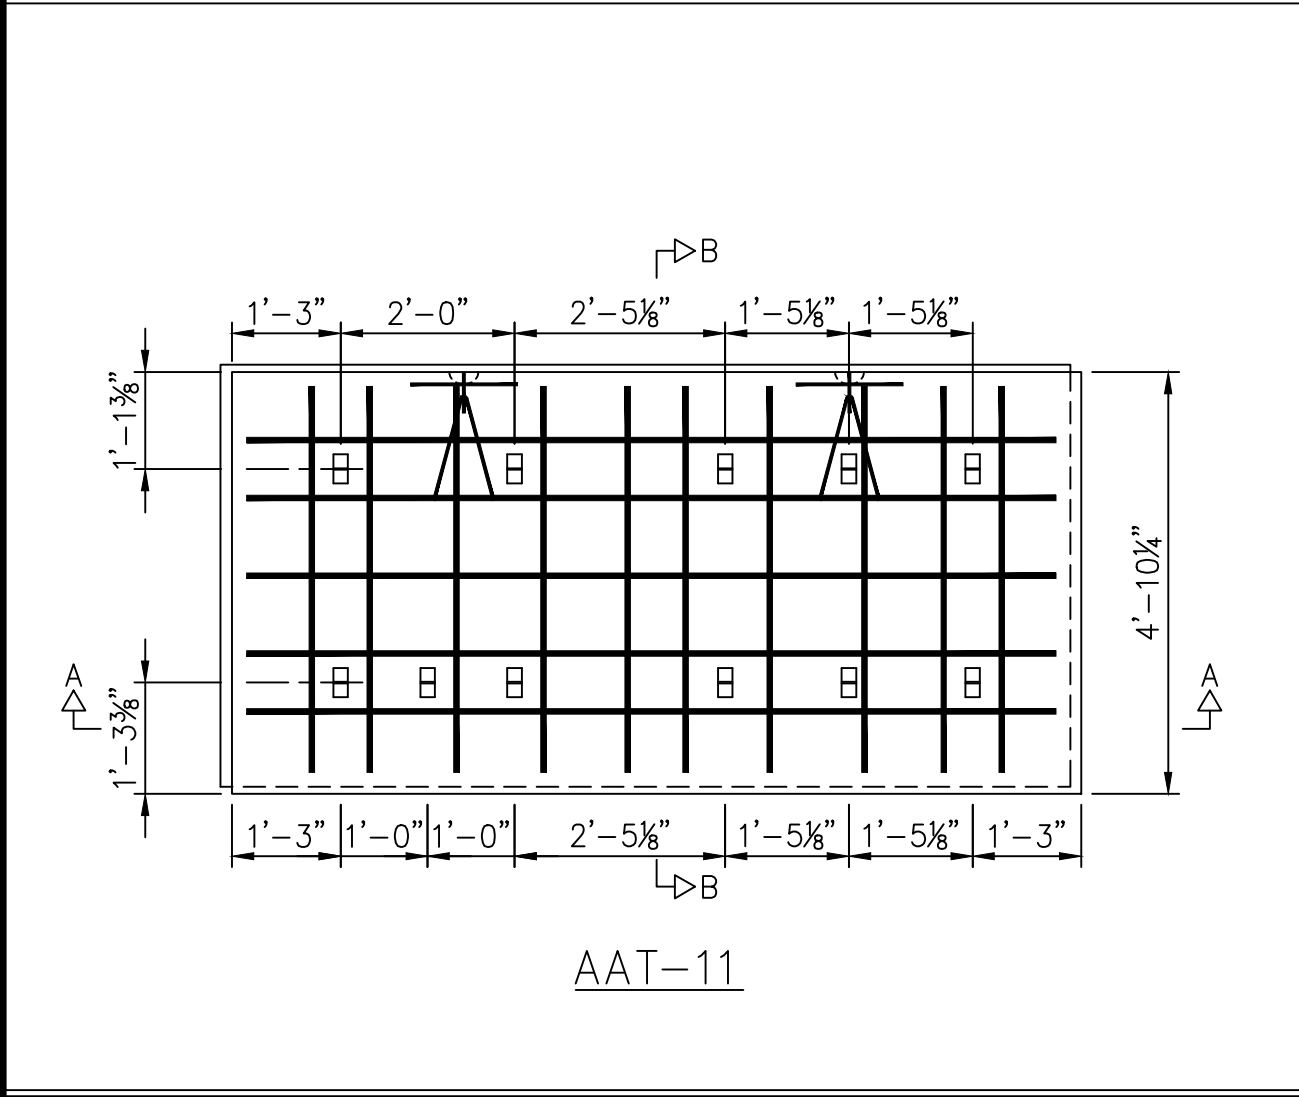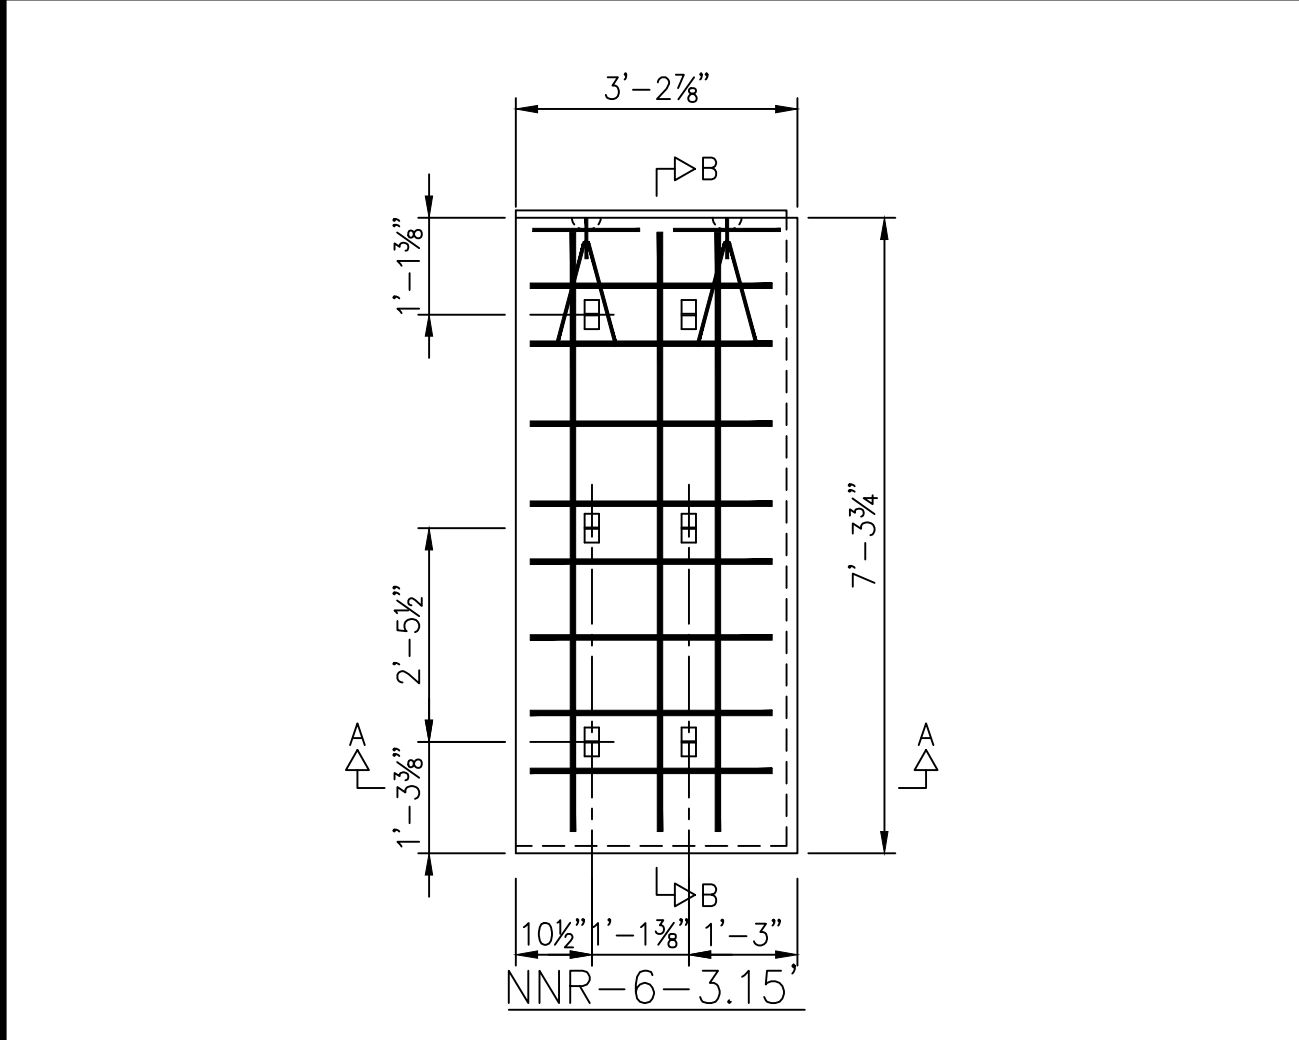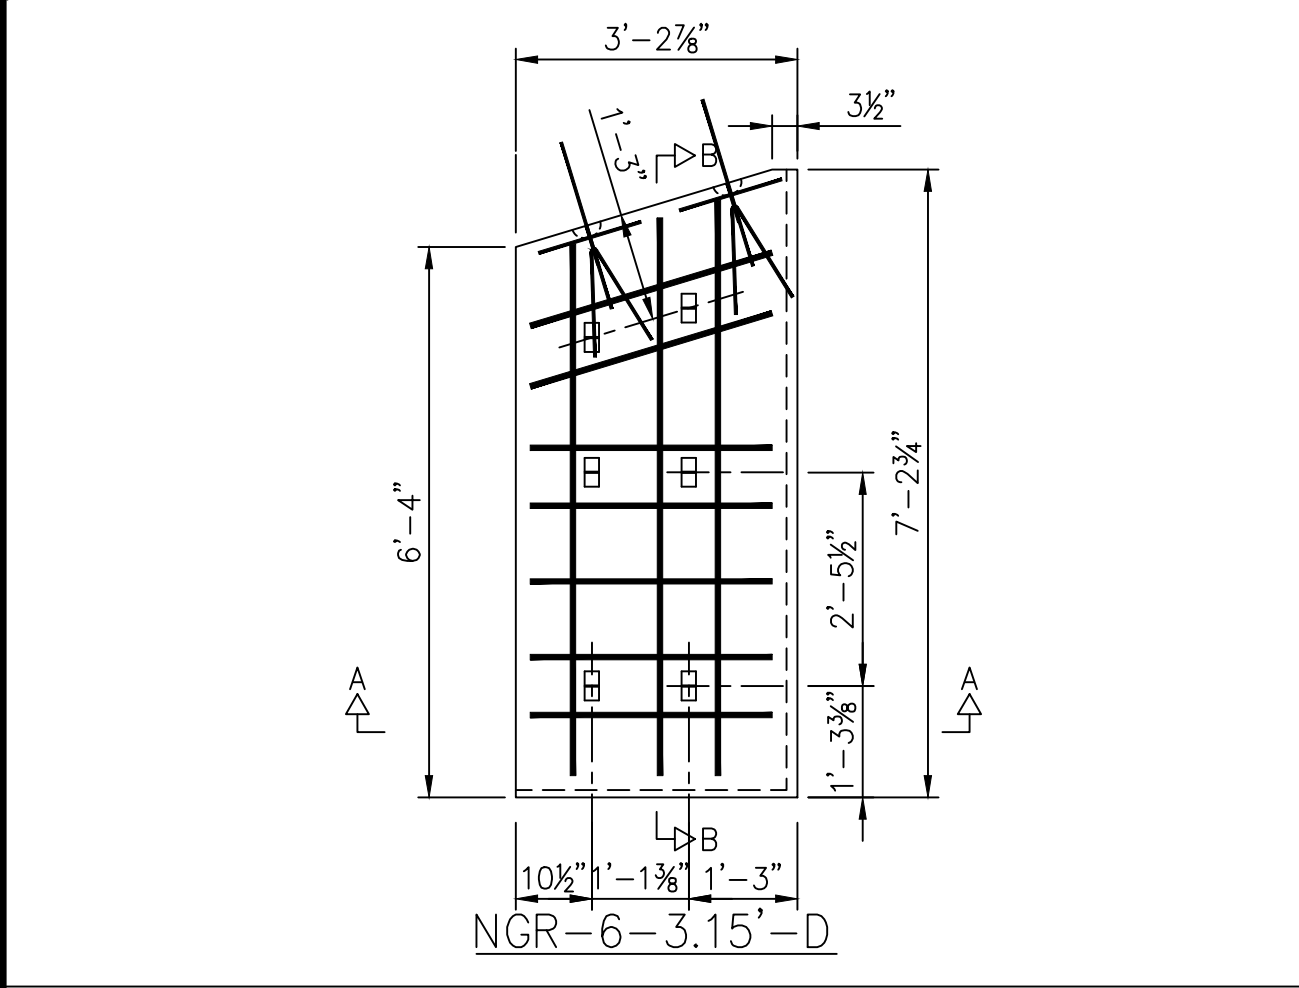

NOTE: FOR SECTIONS A-A AND B-B REFER TO SHEETS S2, S3 AND S4.

This drawing contains information proprietary to The Reinforced Earth Company, and is being furnished for the use of The Ohio Department of Transportation only in connection with this project, and the information contained is not to be transmitted to any other organization unless specifically authorized in writing by The Reinforced Earth Company. The Reinforced Earth Company is the exclusive licensee in the United States under patents held by our affiliated companies, and the furnishing of this drawing does not constitute an expressed or implied license under any applicable patents.

The design contained on these drawings is based on information provided by the Owner. On the basis of this information, The Reinforced Earth Company has designed, and is responsible for the internal stability of the structure only. External stability, including foundation (bearing capacity and settlement) and global stability (including sliding and rotation), is the responsibility of the Owner.

CERTIFIED WITH RESPECT TO INTERNAL STABILITY
OF REINFORCED EARTH STRUCTURES ONLY.



PRECAST PANEL SHOP DRAWINGS
CUY-IR490/SR010-2.09/19.28
CITY OF CLEVELAND, CUYAHOGA COUNTY, OHIO
OHIO DEPARTMENT OF TRANSPORTATION

CUY-IR490
SR010-2.09/19.28

08 OF 9

18631

DATE:
04/27/2020

REVIEWED:
MS

DRAWN:
NR

DESIGNED:
MS

CHECKED:
MS

PID No:
96833

REVIEWED:
MS

DRAWN:
NR

DESIGNED:
MS

CHECKED:
MS

DATE:
04/27/2020

REVIEWED:
MS

DRAWN:
NR

DESIGNED:
MS

CHECKED:
MS

DATE:
04/27/2020

REVIEWED:
MS

DRAWN:
NR

DESIGNED:
MS

CHECKED:
MS

DATE:
04/27/2020

REVIEWED:
MS


DRAWN:
NR

DESIGNED:
MS


CHECKED:
MS

DATE:
04/27/2020


REVIEW

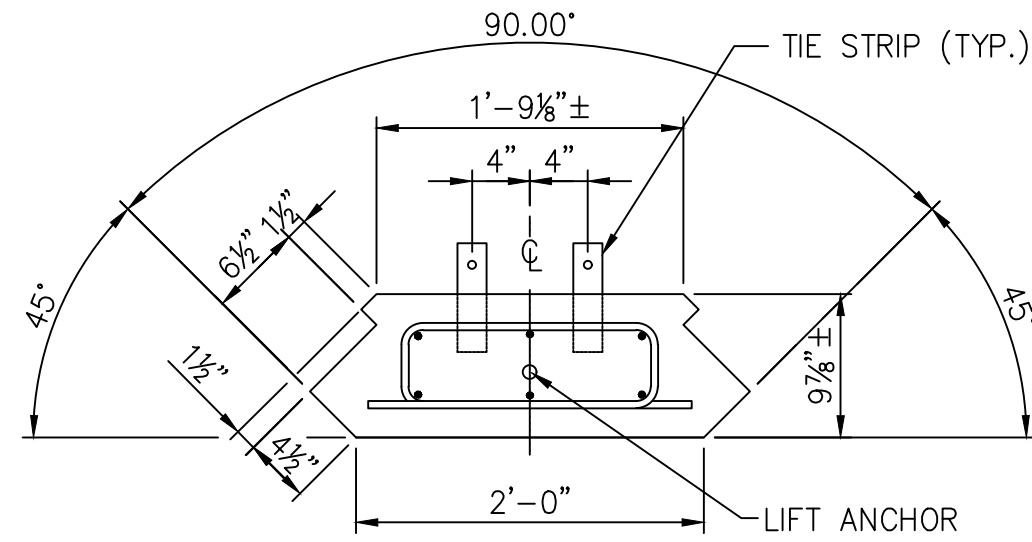


SECTION A-A

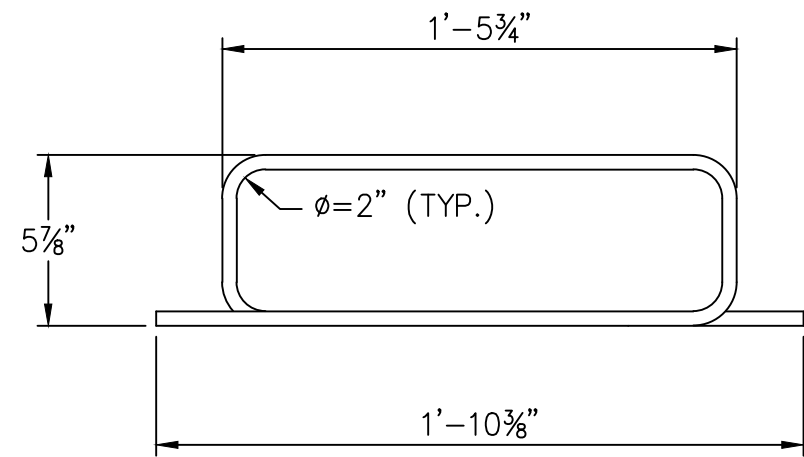


STIRRUP DETAIL
(DIMENSIONS SHOWN ARE OUT TO OUT)

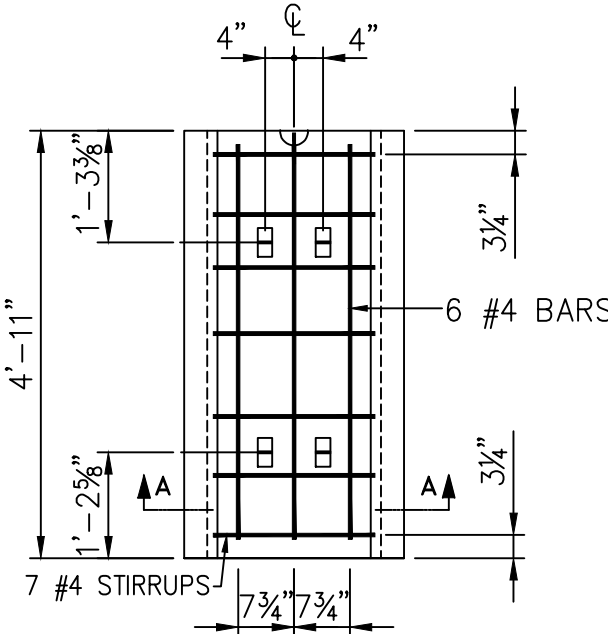


CE5X90-4-R3
BACK FACE VIEW

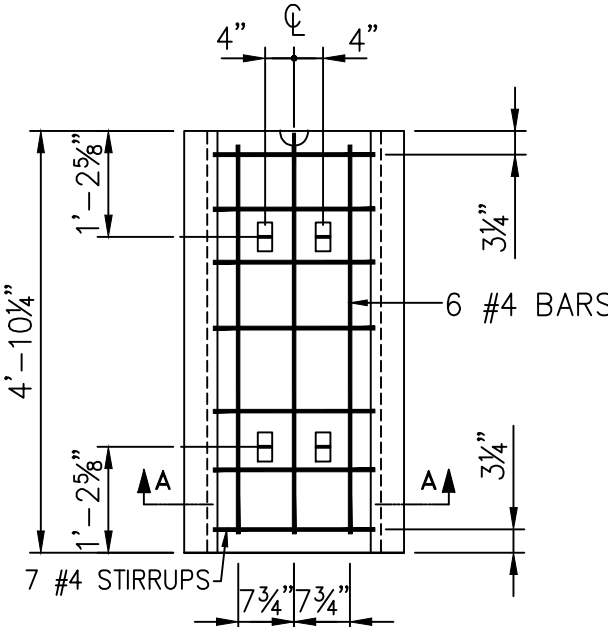


CE5A90-4-R3
BACK FACE VIEW

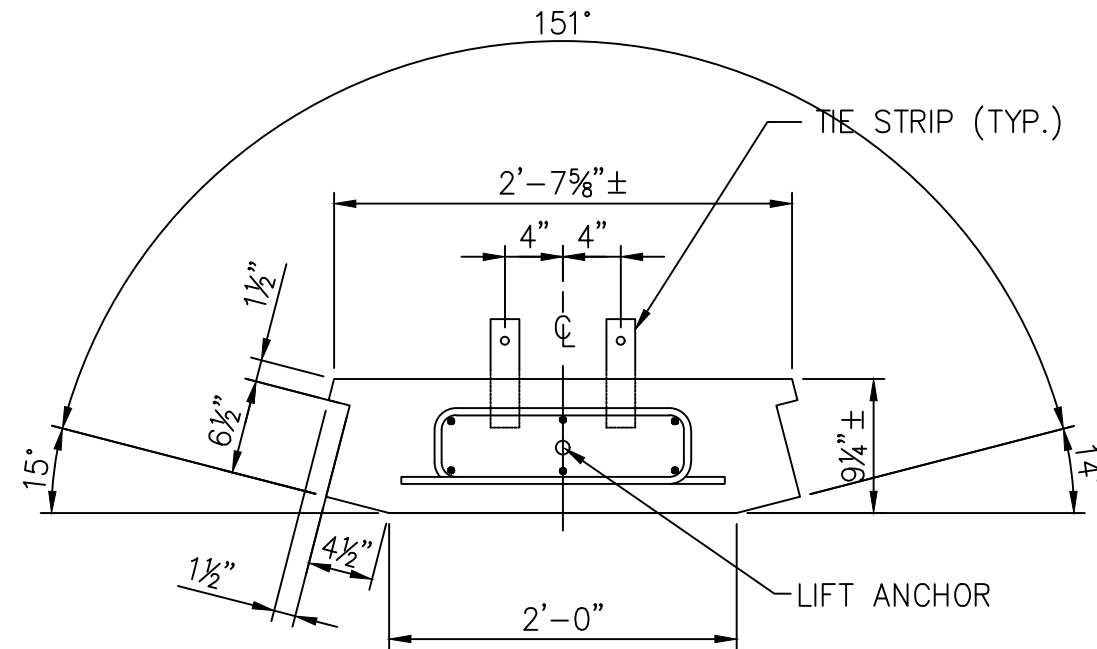


SECTION A-A

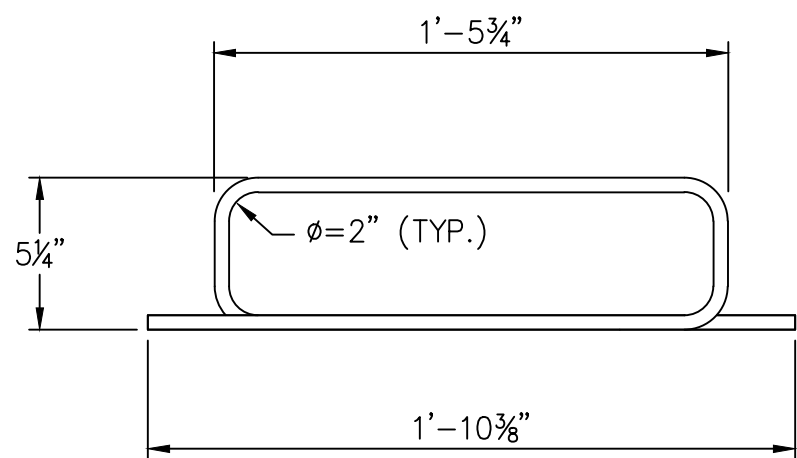


STIRRUP DETAIL
(DIMENSIONS SHOWN ARE OUT TO OUT)

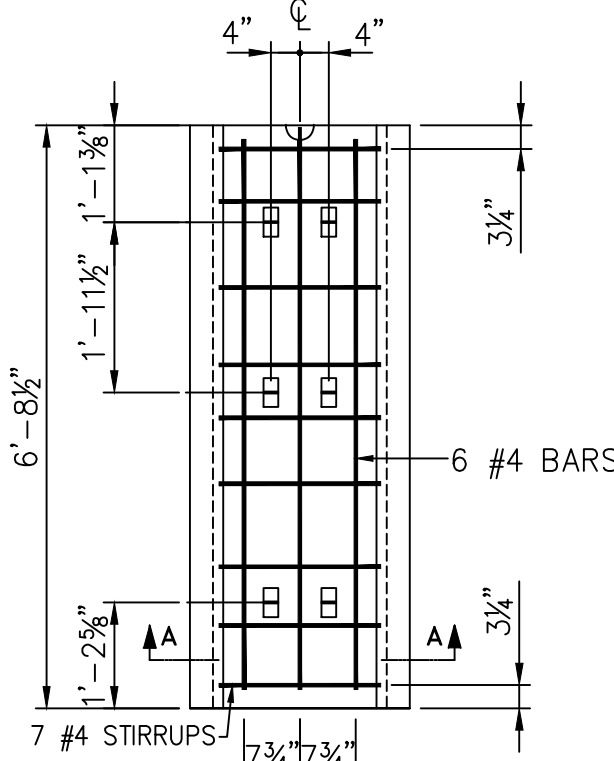


CE4M151-4-R3
BACK FACE VIEW

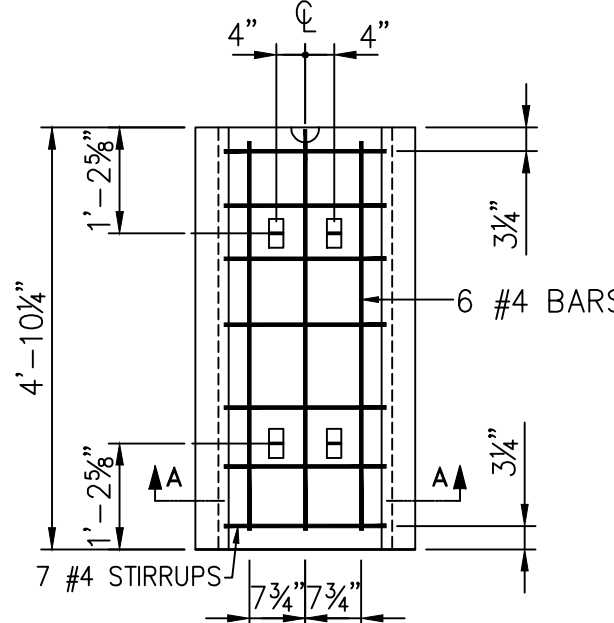


CE4A151-4-R3
BACK FACE VIEW

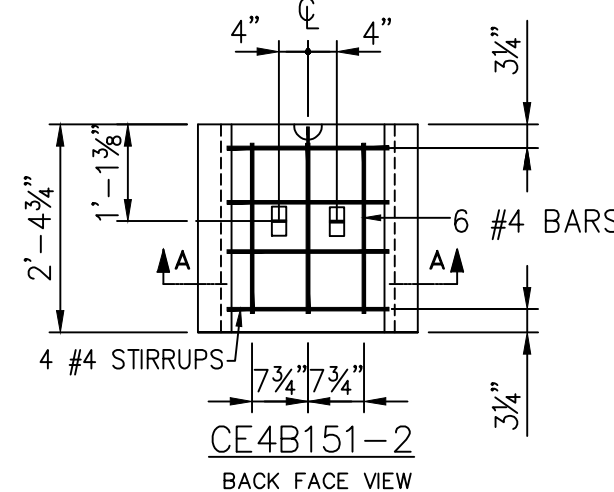


CE4B151-2
BACK FACE VIEW

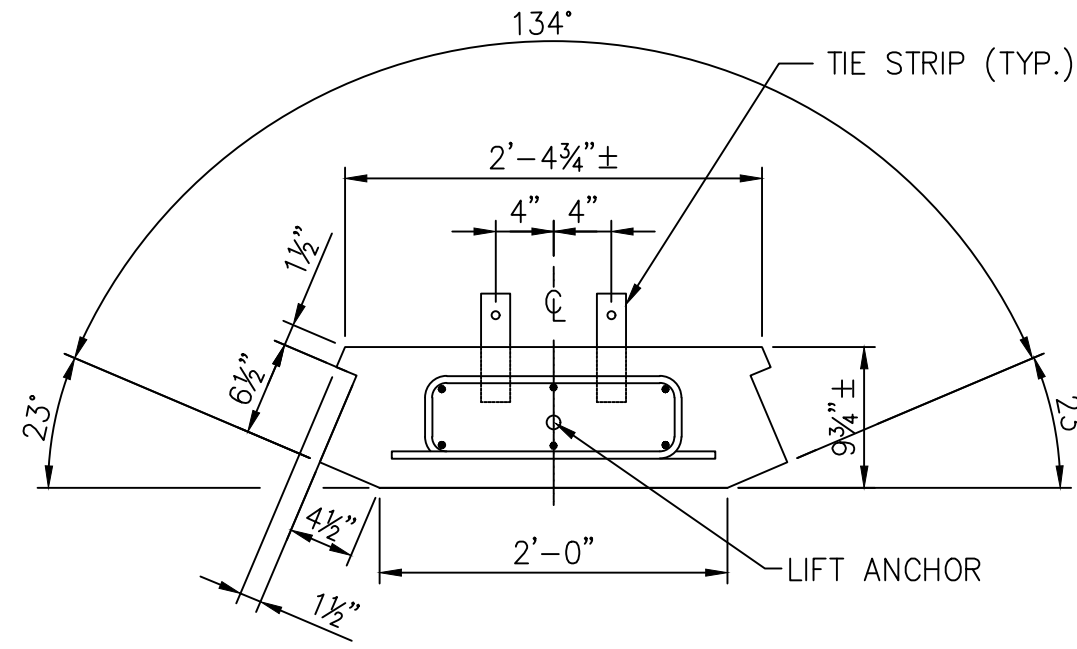


SECTION A-A

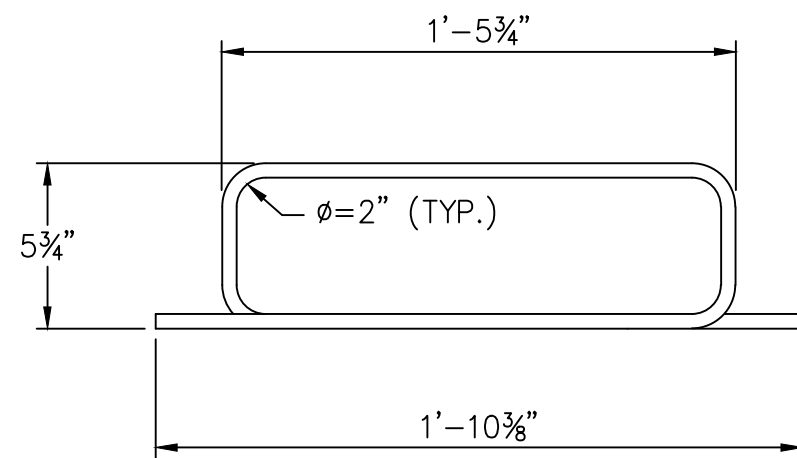

STIRRUP DETAIL
(DIMENSIONS SHOWN ARE OUT TO OUT)

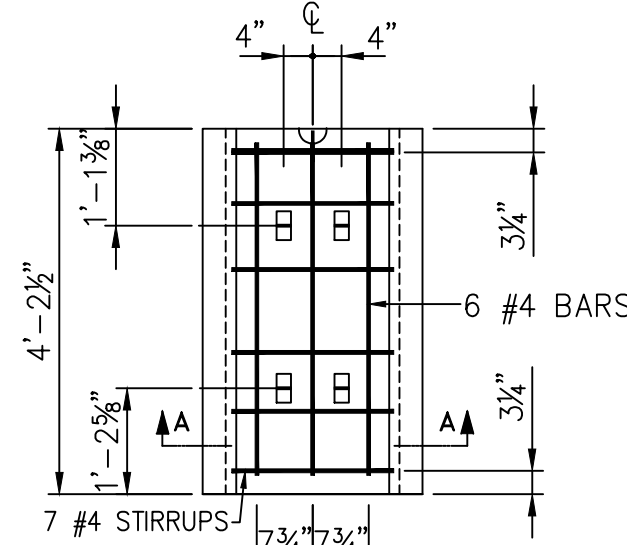


CE5X134-4-R3
BACK FACE VIEW

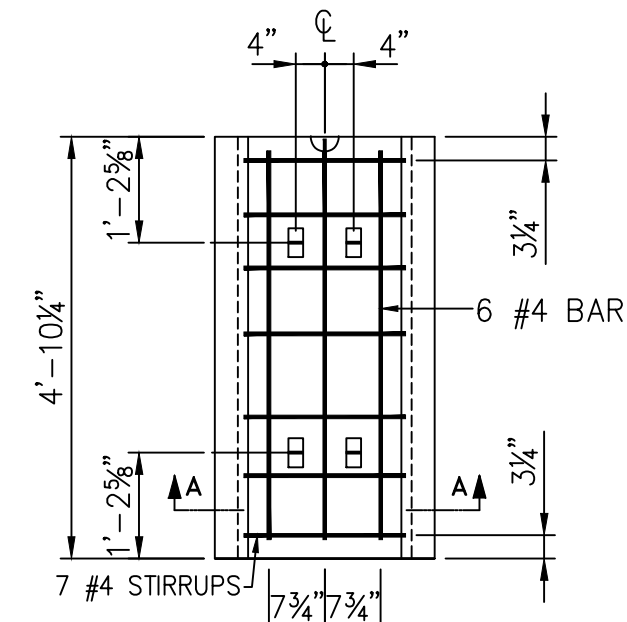

CE5A134-4-R3
BACK FACE VIEW

CERTIFIED WITH RESPECT TO INTERNAL STABILITY
OF REINFORCED EARTH STRUCTURES ONLY.


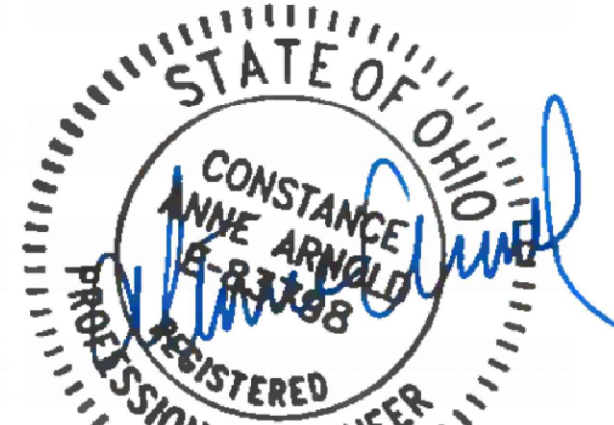


6/4/20



This drawing contains information proprietary to The Reinforced Earth Company, and is being furnished for the use of The Ohio Department of Transportation only in connection with this project, and the information contained is not to be transmitted to any other organization unless specifically authorized in writing by The Reinforced Earth Company. The Reinforced Earth Company is the exclusive licensee in the United States under patents held by our affiliated companies, and the furnishing of this drawing does not constitute an expressed or implied license under any applicable patents.

The design contained on these drawings is based on information provided by the Owner. On the basis of this information, The Reinforced Earth Company has designed, and is responsible for the internal stability of the structure only. External stability, including foundation (bearing capacity and settlement) and global stability (including sliding and rotation), is the responsibility of the Owner.

Checked By:	NS
Drawn By:	BS

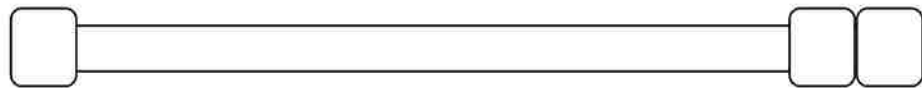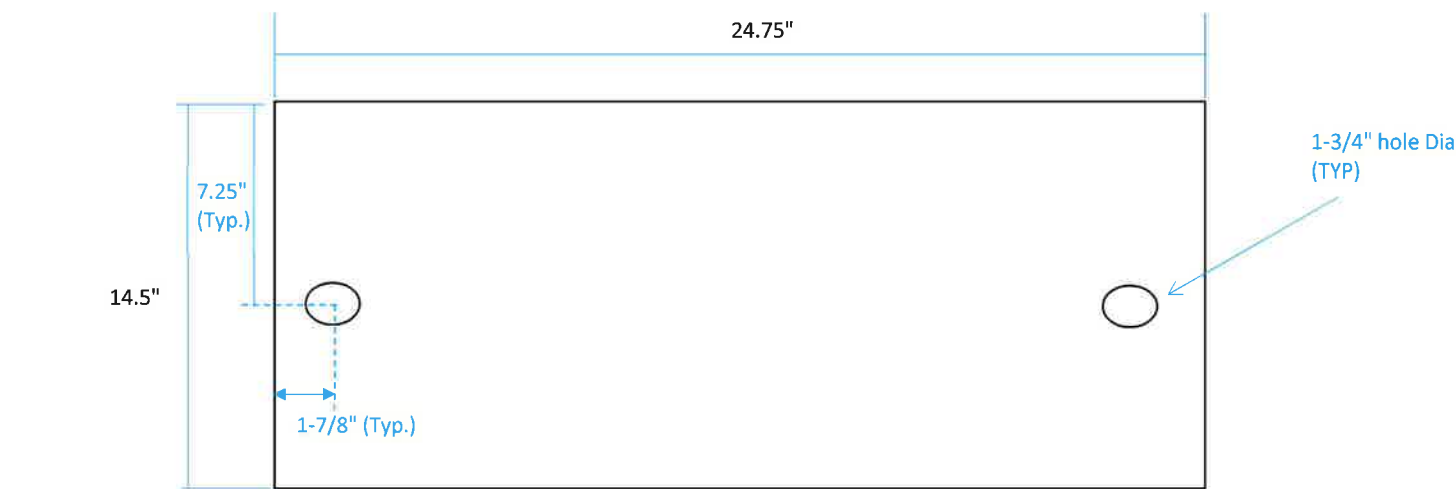

2'-2" long 1-1/2" threaded anchor rod galv. with three ASTM A563 Nuts and washers. ASTM F1554 Grade 105

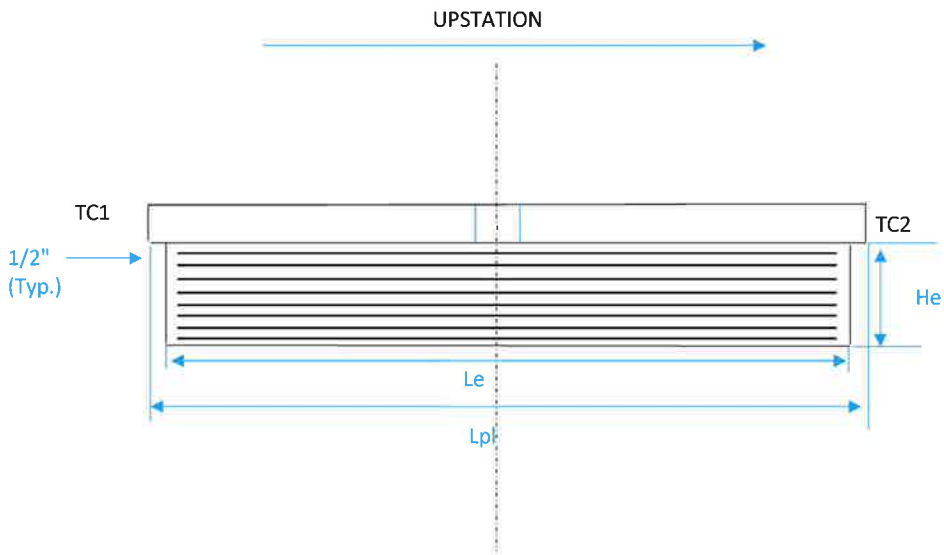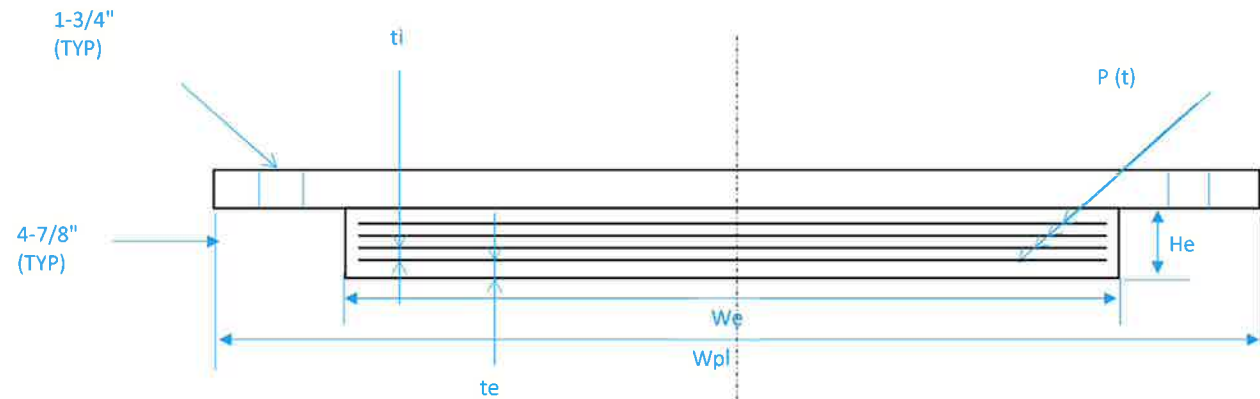



Contractor to verify dimensions.
Steel load plate shall be ASTM A709 grade 50W steel and shall have the same protective coating as the main structural steel. Sherwin Williams Zinc Clad Plus 2 system to be used in prime paint.
Elastomeric bearings: The elastomer shall have a hardness of 50 durometer. The bearings were designed under section 14.7.6 (Method A) of the AASHTO LRFD design specifications.
All bearings shall be marked prior to shipping. The marks shall include the bearing location on the bridge and a direction arrow that points up-station. All marks shall be permanent and shall be visible after the bearing is installed.
Anchor rods shall be ASTM F1554, Grade 105. Nuts shall conform to ASTM A563 for appropriate grade and size of anchor bolt. washer shall conform to ASTM F436.

P = Number of Steel Laminates per Bearing
 t = steel laminate thickness = 0.0747"
 t_e = external elastomer layer thickness (1 ea.)
 t_i = internal elastomer layer thickness (4 ea.)

BEARING LOCATION	NO. REQ'D	L_e	W_e	H_e	t_e	t_i	P	L_{pl}	W_{pl}	T_s	TC1	TC2
Pier 1	3	13.5"	15"	2.65"	.35"	.50"	4	14.5"	24.75"	1.5"	1.2912"	1.7088"

BRIDGE COMPONENTS INDUSTRIES, LLC	
CONTRACTOR:	SHS
COUNTY:	Cuyahoga
Bridge #:	BU-25
PROJECT:	ODOT 3000-17
Date:	10/21/2020
Drawing Number	BU25 Bro
Page	1 of 2

Checked By	Neil Spears
Drawn By	Brodie Spears

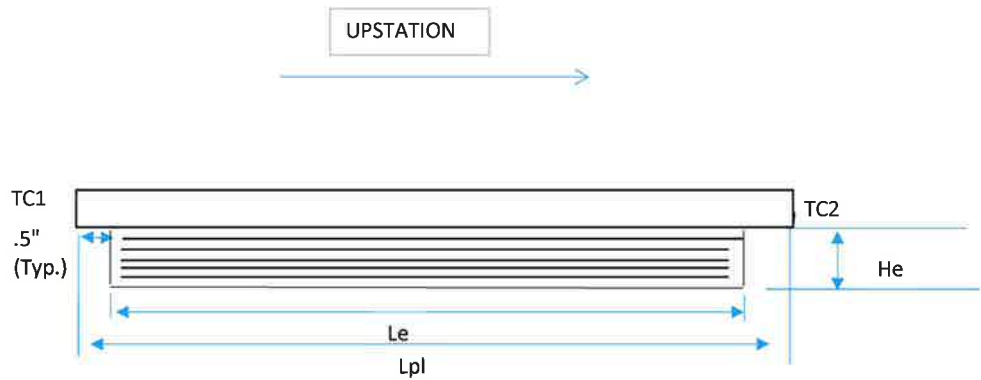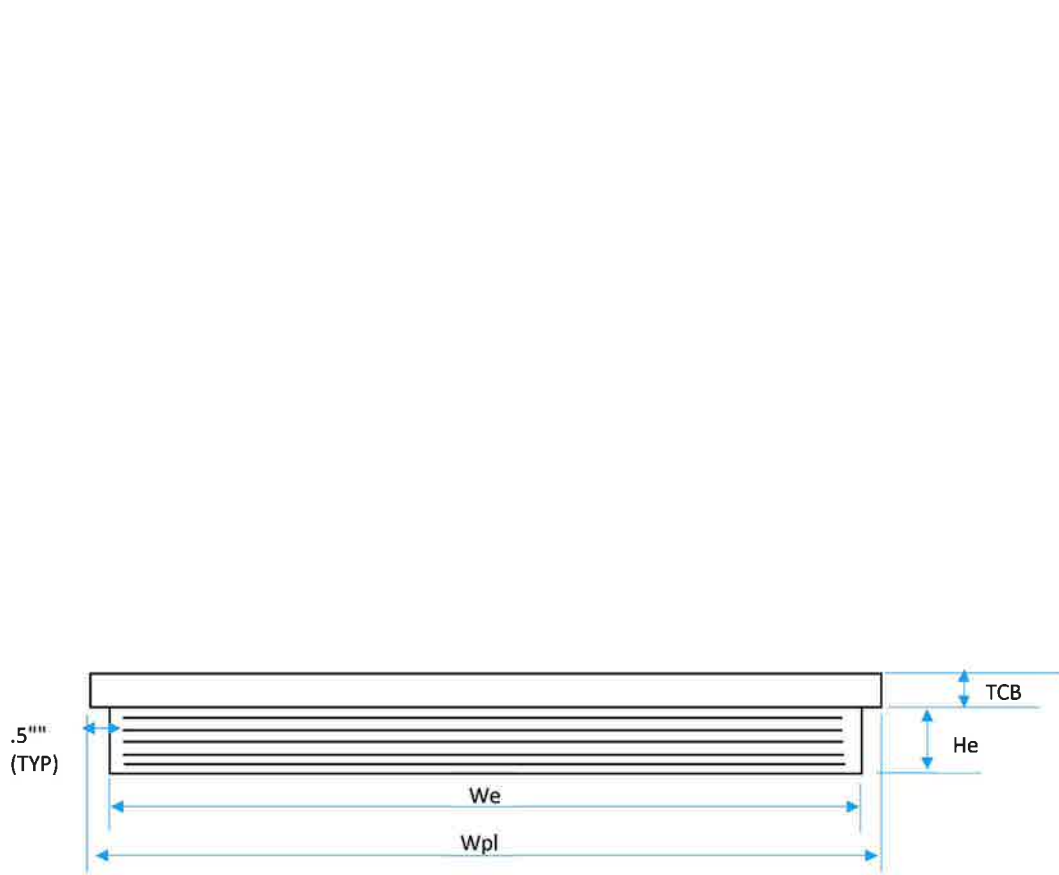

Contractor to verify dimensions.
Steel load plate shall be ASTM A709 grade 50W steel and shall have the same protective coating as the main structural steel. Sherwin Williams Zinc Clad Plus 2 system to be used in Prime Paint
Elastomeric bearings: The elastomer shall have a hardness of 50 durometer. The bearings were designed under section 14.7.6 (Method A) of the AASHTO LRFD design specifications.
All bearings shall be marked prior to shipping. The marks shall include the bearing location on the bridge and a direction arrow that points up-station. All marks shall be permanent and shall be visible after the bearing is installed.
Anchor rods shall be ASTM F1554, Grade 105. Nuts shall conform to ASTM A563 for appropriate grade and size of anchor bolt. washer shall conform to ASTM F436.

P = Number of Steel Laminates per Bearing
t= steel laminate thickness = 0.0747"
te = external elastomer layer thickness (1 ea.)
ti = internal elastomer layer thickness (4 ea.)

BEARING LOCATION	NO. REQ'D	Le	We	He	te	ti	P	Lpl	Wpl	Ts	TC1	TC2			
RA	3	11"	11"	2.07"	.35"	.5"	3	12"	12"	1-1/2"	1.3272"	1.6728"			
FA	3	11"	11"	3.22"	.35"	.5"	5	12"	12"	1-1/2"	1.7772"	1.2228"			
Pier 2	3	13.5"	15"	2.65"	.35"	.5"	4	14.5"	16"	1-1/2"	1.7660"	1.2339"			

BRIDGE COMPONENTS INDUSTRIES, LLC

CONTRACTOR:	SHS
COUNTY:	Cuyahoga
Bridge #:	BU-25
PROJECT:	ODOT 3000-17
Date:	10/21/2020
Drawing Number	BU25 Bro
Page	2 of 2

GENERAL SHOP NOTES

SPECIFICATIONS:

ALL MATERIAL AND WORKMANSHIP SHALL BE IN ACCORDANCE WITH THE STATE OF OHIO DEPARTMENT OF TRANSPORTATION CONSTRUCTION AND MATERIAL SPECIFICATION (CMS) DATED 2016, CONTRACT DWGS AND SPECIAL PROVISIONS.

THIS STRUCTURE CONFORMS TO THE "LRFD BRIDGE DESIGN SPECIFICATIONS" ADOPTED BY THE AMERICAN ASSOCIATION OF STATE HIGHWAY AND TRANSPORTATION OFFICIALS, 7TH EDITION, INCLUDING THE 2016 INTERIM SPECIFICATIONS AND THE ODOT BRIDGE DESIGN MANUAL, 2007.

MATERIALS:

ALL MATERIAL (EXCEPT HARDWARE) SHALL BE ASTM A709 GR 50W.

BEAMS AND FIELD SPLICE PLATES REQUIRE CHARPY V-NOTCH (CVN) TESTING PER CMS 711.01.

"DOR" DENOTES DIRECTION OF ROLLING

PROCEDURE FOR CAMBERING:

- CHECK FOR NATURAL CAMBER WITHIN THE ROLLED STRUCTURAL BEAM AS RECEIVED FROM THE MILL.
- LAY THE ROLLED STRUCTURAL BEAM INTO THE CAMBERING MACHINE WITH THE WEB HORIZONTAL AND PUSH ON THE NATURAL CAMBER SIDE (CONCAVE SIDE).
- STARTING AT THE MID-POINT OF THE STRUCTURAL BEAM, PUSH APPROXIMATELY $\frac{1}{4}" - \frac{1}{2}"$ CAMBER INTO THE BEAM. THEN MOVE TO THE QUARTER POINT OF THE STRUCTURAL BEAM AND PUSH APPROXIMATELY $\frac{1}{4}" - \frac{3}{8}"$ CAMBER INTO THE BEAM. NEXT MOVE TO THE EIGHTH POINTS AS NEEDED AND PUSH $\frac{1}{8}" - \frac{3}{16}"$ ADDITIONAL CAMBER INTO THE BEAM UNTIL THE DESIRED CAMBER IS REACHED. THIS ALTERNATING PUSHING METHOD WILL ASSURE A CAMBER CURVATURE AS REQUIRED AND WILL NOT KINK THE STRUCTURAL ROLLED BEAM.
- CHECK THE STRUCTURAL ROLLED BEAMS TO SEE IF THE REQUIRED CAMBER IS OBTAINED WHILE THE BEAM IS LAYING WITH THE WEB IN A RELAXED HORIZONTAL POSITION.

WORKMANSHIP:

ALL CORNERS OF OXYGEN CUT EDGES OF MAIN STRESS-CARRYING MEMBERS AND "ALL" OTHER CORNERS EITHER OXYGEN CUT, SHEARED OR SAW CUT (EXPOSED AFTER FIT-UP & WELDING), SHALL HAVE A 1/16" RADIUS OR EQUIVALENT FLAT SURFACE AT A SUITABLE ANGLE PER AWS D1.5-2002 SECTION 3.2.9 AND CMS 513.12.

SHOP STRAIGHTEN AS NECESSARY BOTTOM FLANGE IN "BRG AREA" TO PROVIDE A UNIFORM CONTACT BETWEEN THE BEAM FLANGE AND THE BRG AT THE BRIDGE SEAT (SEE BEAM DETAILS FOR LOCATION OF "BRG AREA").

WELDING:

IN ACCORDANCE WITH AASHTO/AWS BRIDGE WELDING CODE (D1.5 2010) AS AMENDED BY CMS 513.21 AND SUPPLEMENT 1011.

WELD PROCEDURE SPECS: CONN PL TO BEAM WEB WPS 10 - 3
CONN PL TO BEAM FLG WPS 10 - 4
CROSSFRAME CENTER PL WPS 10 - 10

NON DESTRUCTIVE TESTING:

NONE.

BOLTS:

ASTM F3125 GR. A325 TYPE 3 BOLTS IN UNPAINTED AREAS, TYPE 1 HOT-DIP GALV. IN PAINTED AREAS PER CMS 711.02 & 711.09

ROTATIONAL-CAPACITY TESTS ARE REQUIRED.

BOLTS SHALL BE 1"Ø H.S.B. (W/ $1\frac{1}{16}"$ Ø HOLE) FOR FIELD SPLICE PLATES AND $\frac{5}{8}"$ Ø H.S.B. WITH $\frac{13}{16}"$ Ø HOLES IN THE CROSS FRAME ANGLES AND $\frac{11}{16}"$ Ø HOLES IN THE CONNECTION PLATES.

STUDS:

FIELD APPLIED (BY OTHERS)

CLEANING:

PAINTED STEEL:
ABRASIVE BLAST ALL STEEL TO BE PAINTED ACCORDING TO SSPC-SP10 AND AS SHOWN ON THE PICTORIAL SURFACE PREPARATION STANDARDS FOR PAINTING STEEL SURFACES SHOWN IN SSPC-VIS 1. BEFORE ABRASIVE BLASTING, STEEL SHALL BE SOLVENT CLEANED PER SSPC-SP1 AND EXPOSED EDGES OF THE BEAMS SHALL BE ROUNDED TO A RADIUS OF 1/8 ± 1/16 INCH. (PER CMS 514.13)

UNPAINTED STEEL:
SHOP BLAST UNPAINTED STEEL TO SSPC-SP6, COMMERCIAL BLAST. BEFORE SHOP BLAST SOLVENT CLEAN WHERE NECESSARY. (PER CMS 513.28)


PAINTING:

NO PAINT UNLESS NOTED "PAINT" ON DRAWINGS.

PAINTED MEMBERS AND AREAS TO RECEIVE INORGANIC ZINC SILICATE PRIMER PAINT ONLY PER CMS 514.17. PRIMER SHALL CONFORM TO 708.01.

APPLY "MIST COAT PRIMER ONLY" (0.5 TO 1.5 MILS) WHERE SHOWN ON DETAILS.

PRIMER PAINT: CARBOLINE 11HS GREEN

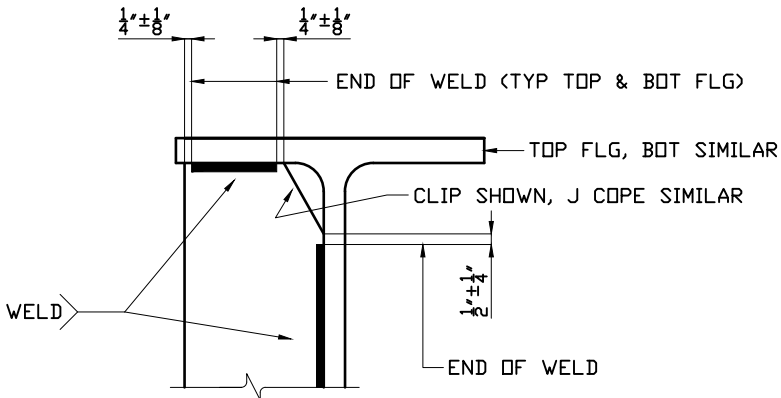


DETAIL A



GENERAL CONTRACTOR: KOKOSING D&B		
TOTAL WEIGHT		
NOTES: ____ DIA. HOLES UNLESS NOTED ____ DIA. BOLTS UNLESS NOTED		
PAINT SPECS: CLEANING		_____
PRIMER		_____
INTERMEDIATE		_____
FINISH		_____
TO SHOP:		
<div><div><div>SFI</div><div>SHANE FELTER INDUSTRIES</div><div>P.O. BOX 2022 • ROUTE 51 • UNIONTOWN PENNSYLVANIA 15401</div></div></div>		
GENERAL NOTES		
BU-25 E 89TH ST PEDESTRIAN BRIDGE CUY-IR490/SR010-2.09/19.28		
CITY OF CLEVELAND, CONSTRUCTION PROJECT #17-3000 PID #96833		
FED. PROJ.# E140 (249) CUYAHOGA COUNTY, OHIO		
REVISIONS	1	DR. CCD-MC DATE 2/20
	2	CH. CCD-JB DATE 2/20
	3	APP. _____ DATE _____
	4	
DWG. NO. GN1AB		CONT. NO. 19-782

GENERAL SHOP NOTES

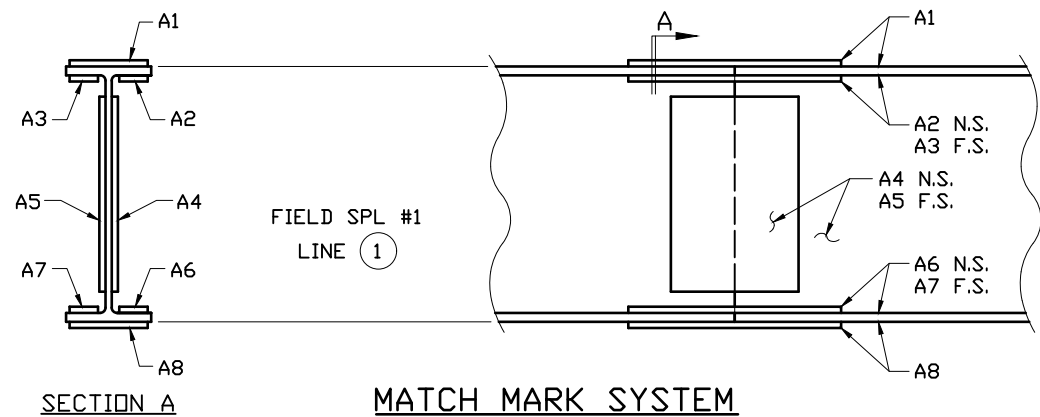

FS#1	FS#2
LINE - ①, FIELD SPL #1, USE - A	LINE - ①, FIELD SPL #2, USE - B
LINE - ②, FIELD SPL #1, USE - C	LINE - ②, FIELD SPL #2, USE - D
LINE - ③, FIELD SPL #1, ETC.	LINE - ③, FIELD SPL #2, ETC.

FIELD SPLICES:

HOLES MARKED [RA] SHALL BE SUBPUNCHED/SUBDRILLED 1/4"Ø UNDERSIZE AND REAMED TO FULL SIZE OR DRILLED FULL SIZE FROM THE SOLID, WITH STRINGER AND SPLICE PLATES ASSEMBLED AND MATCH MARKED USING MIN. STRESS STAMPS PER CMS 513.19 & 513.24.

SFI FIELD SPLICE PROCEDURE:

SPLICE PL'S SHALL HAVE THE FOUR CORNER HOLES SUBPUNCHED 13/16"Ø IN MATERIAL UP TO AND INCLUDING 5/8" THICK, SUB-DRILL 13/16"Ø HOLES IN MATERIAL OVER 5/8" THICK. BALANCE OF ALL HOLES IN THE N.S. WEB PLATE AND OUTER FLANGE SPLICE PLATES SHALL BE DRILLED FULL SIZE. ONCE ALL SPLICE PLATES ARE INSTALLED ON THE BEAMS IN LAYDOWN, USE THE PREVIOUS FULL SIZE HOLES FOR TEMPLATE AND DRILL BALANCE OF PLIES AT SPLICE FULL SIZE USING AN END CUTTER HOGAN BIT. THE PREVIOUS CORNER SUB-SIZED HOLE TO BE REAMED FULL SIZE.






GENERAL CONTRACTOR: KOKOSING D&B	
TOTAL WEIGHT	
NOTES: ____ DIA. HOLES UNLESS NOTED ____ DIA. BOLTS UNLESS NOTED	
PAINT SPECS: CLEANING _____	
PRIMER _____	
INTERMEDIATE _____	
FINISH _____	
TO SHOP:	
 SHANE FELTER INDUSTRIES	
P.O. BOX 2022 • ROUTE 51 • UNIONTOWN PENNSYLVANIA 15401	
GENERAL NOTES	
BU-25 E 89TH ST PEDESTRIAN BRIDGE CUY-IR490/SR010-2.09/19.28	
CITY OF CLEVELAND, CONSTRUCTION PROJECT #17-3000 PID #96833	
FED. PROJ.# E140 (249) CUYAHOGA COUNTY, OHIO	
REVISIONS	
1	DR. CCD-MC DATE 2/20
2	CH. CCD-JB DATE 2/20
3	APP. _____ DATE _____
4	
DWG. NO. GN1B	CONT. NO. 19-782




ERECTOR NOTES:

- ALL HORIZONTAL DIMENSIONS SHOWN DO NOT REFLECT GRADE.
- ALL BEAMS ARE W40x149.
- WORK THIS DWG. WITH DWG'S E2 THRU E5 FOR CROSS FRAME DETAILS AND MARKS NOT SHOWN HERE.
- SEE DWG.'S GNIAB/B FOR GENERAL NOTES.
- SEE DWG. E5 FOR FIELD BOLT SIZES & LOCATIONS.
- SHEAR CONNECTORS, BEARING ITEMS, CONDUITS AND FIELD WELDING ARE NOT BY SFI.

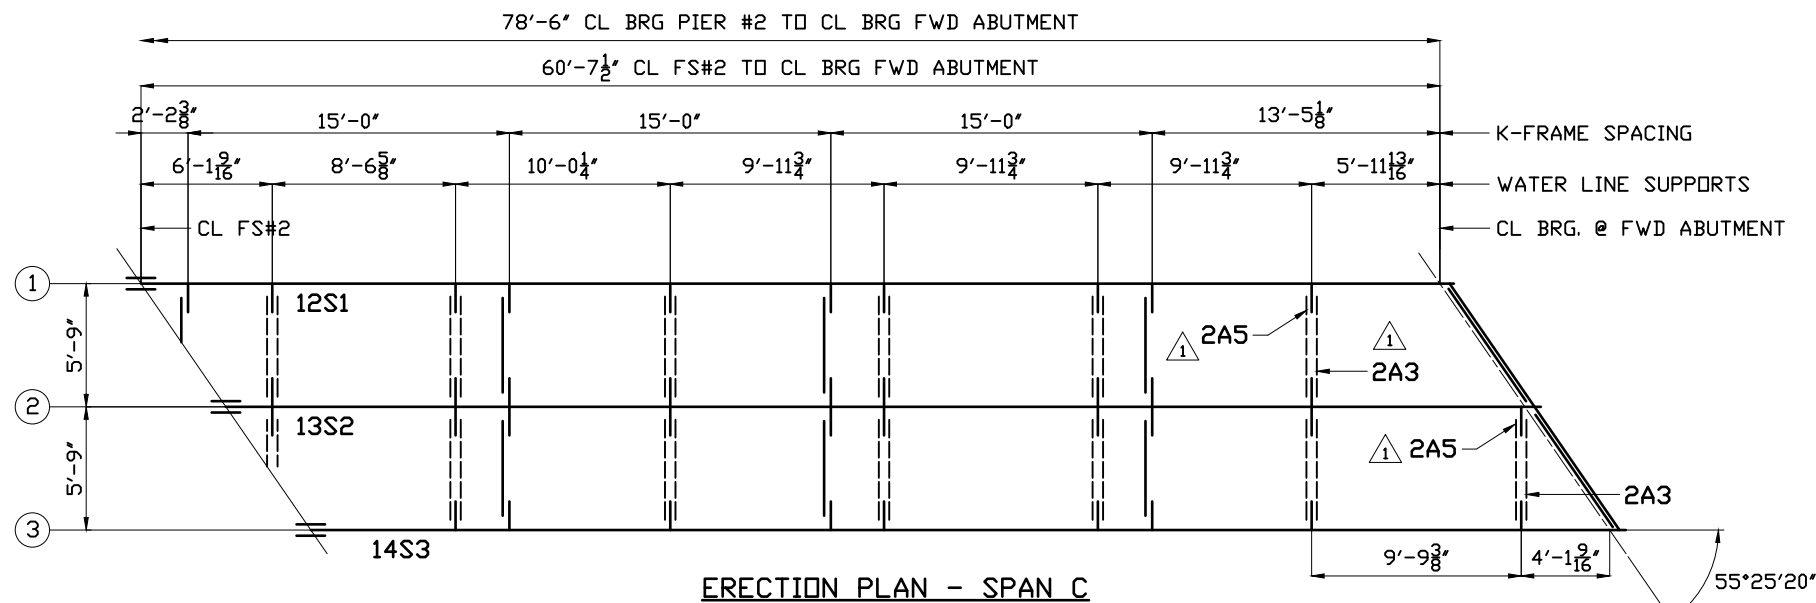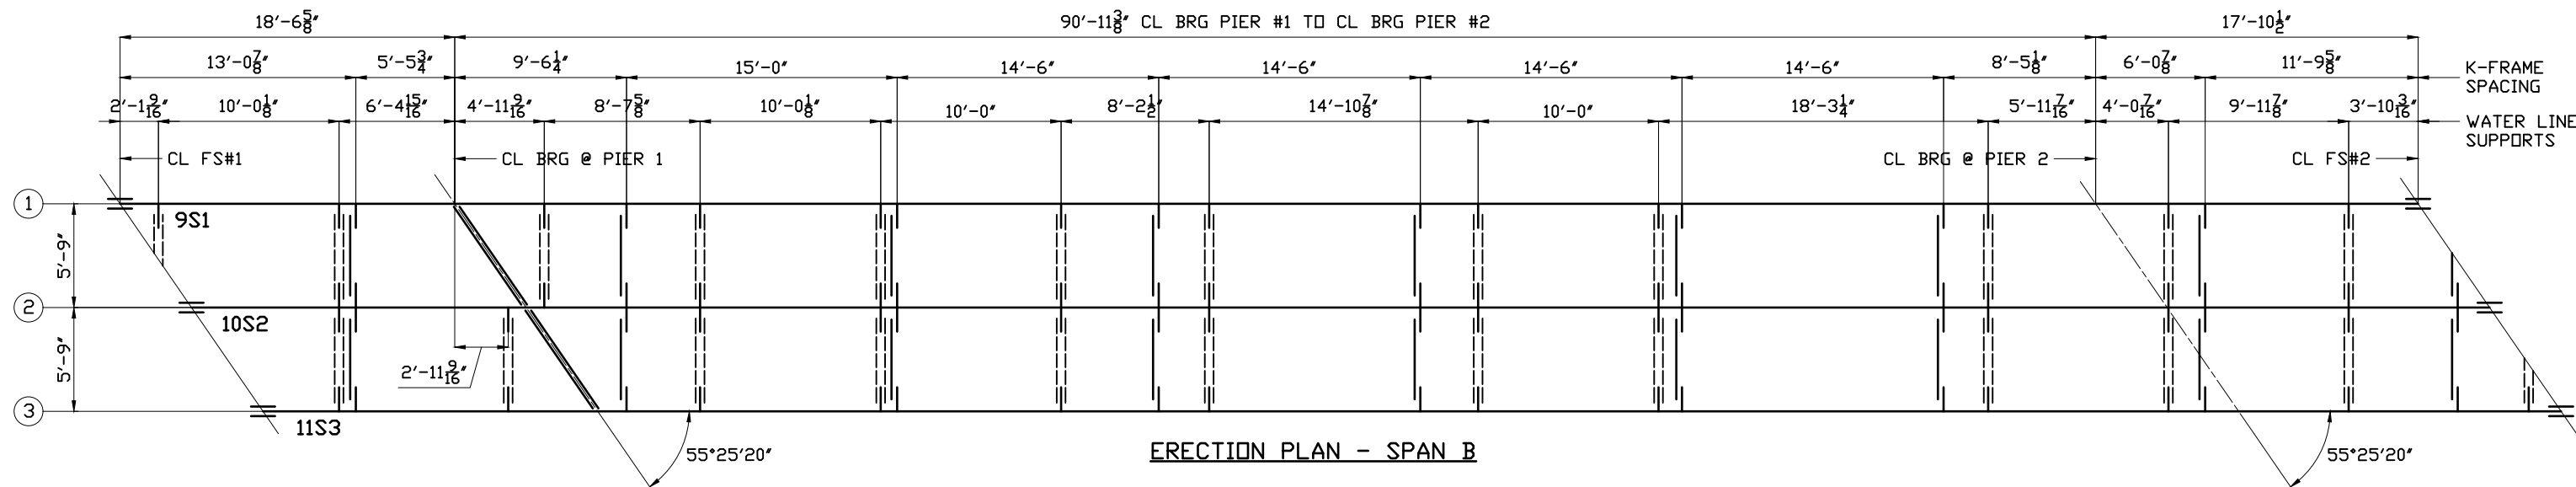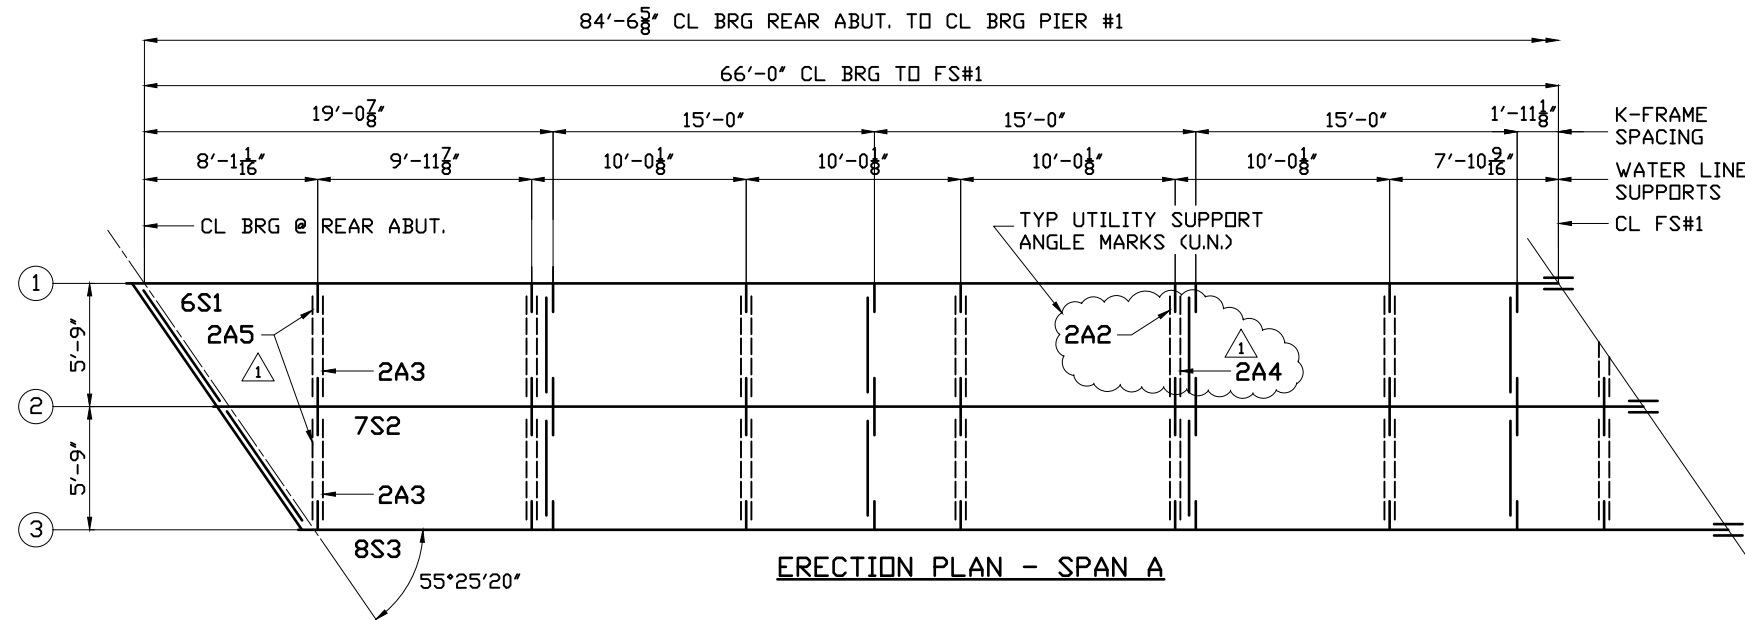


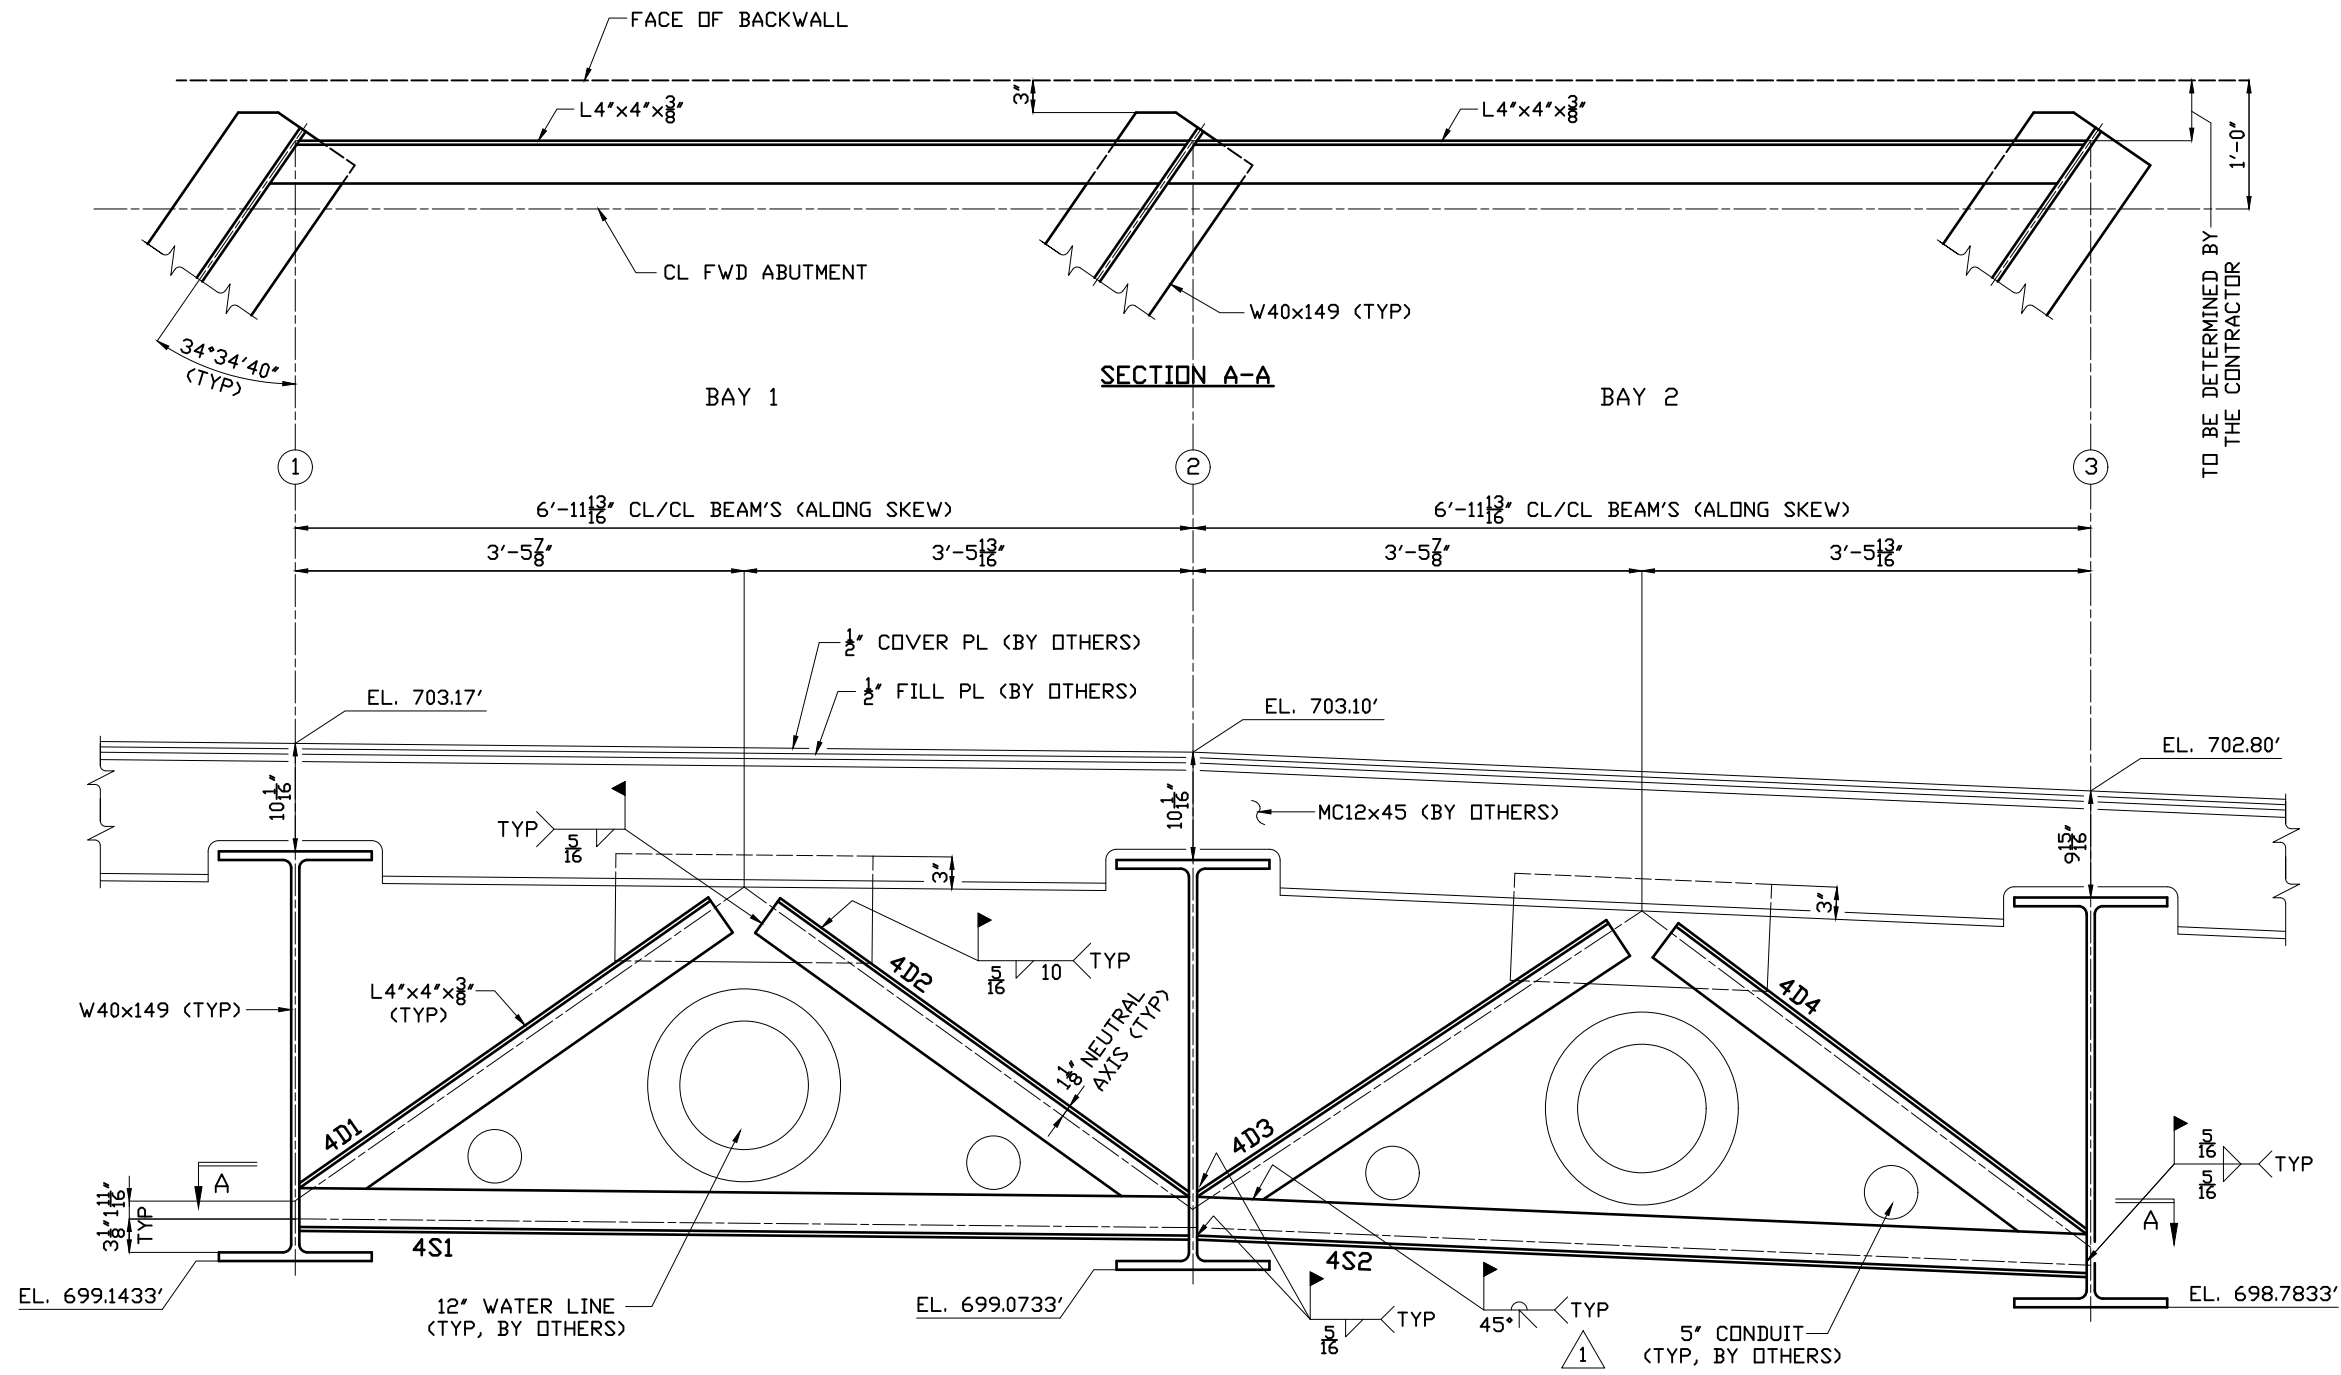
GENERAL CONTRACTOR: KOKOSING D&B	
TOTAL WEIGHT	
NOTES: ____ DIA. HOLES UNLESS NOTED ____ DIA. BOLTS UNLESS NOTED	
PAINT SPECS: CLEANING _____	
PRIMER _____	
INTERMEDIATE _____	
FINISH _____	
TO SHOP:	
 SHANE FELTER INDUSTRIES	
P.O. BOX 2022 • ROUTE 51 • UNIONTOWN PENNSYLVANIA 15401	
ERECTION PLAN	
BU-25 E 89TH ST PEDESTRIAN BRIDGE CUY-IR490/SR010-2.09/19.28	
CITY OF CLEVELAND, CONSTRUCTION PROJECT #17-3000 PID #96833	
FED. PROJ.# E140 (249) CUYAHOGA COUNTY, OHIO	
REVISIONS	
1	REVISED MARKS 6/17/20
2	
3	
4	
DWG. NO.	E1
DR.	CCD-MC DATE 2/20
CH.	CCD-JB DATE 2/20
APP.	DATE
CONT. NO.	19-782

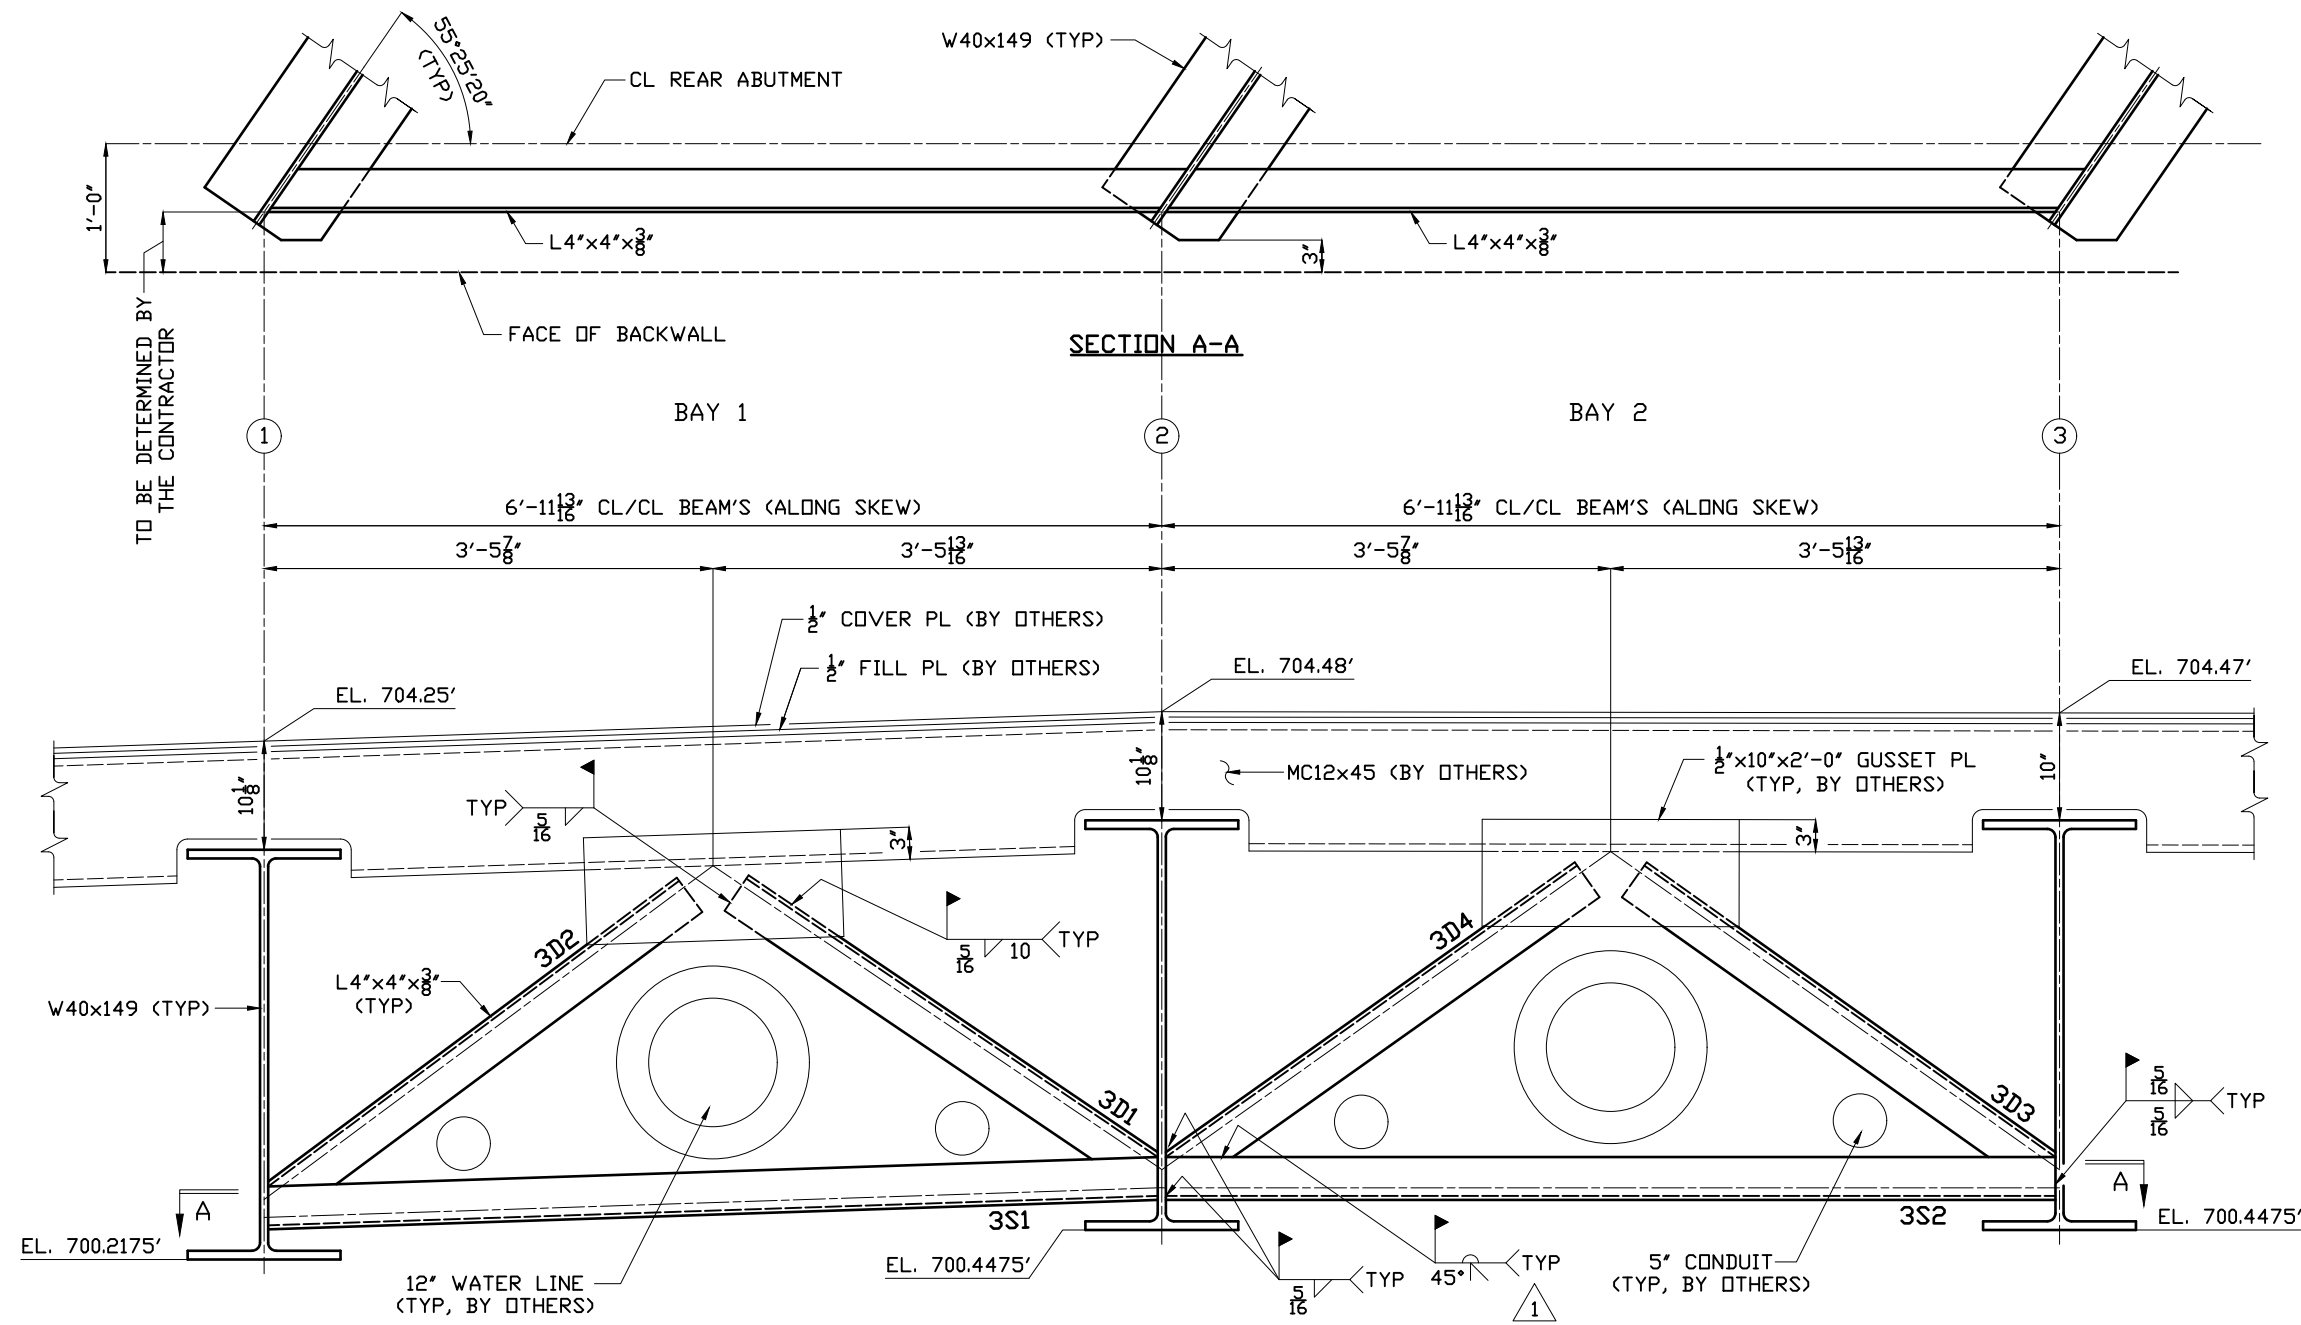

REAR ABUTMENT CROSSFRAME
LOOKING AHEAD STATIONS
WATERLINE OR ELECTRICAL CONDUITS
NOT SHOWN FOR CLARITY AND ARE
NOT BY SFI



GENERAL CONTRACTOR: KOKOSING D&B	
TOTAL WEIGHT	
NOTES: ____ DIA. HOLES UNLESS NOTED ____ DIA. BOLTS UNLESS NOTED	
PAINT SPECS: CLEANING _____	
PRIMER _____	
INTERMEDIATE _____	
FINISH _____	
TO SHOP: _____	
 SHANE FELTER INDUSTRIES <small>P.O. BOX 2022 • ROUTE 51 • UNIONTOWN PENNSYLVANIA 15401</small>	
ERECTION DETAILS - REAR ABUTMENT CROSS FRAME DETAILS BU-25 E 89TH ST PEDESTRIAN BRIDGE CUY-IR490/SR010-2.09/19.28 CITY OF CLEVELAND, CONSTRUCTION PROJECT #17-3000 PID #96833 FED. PROJ.# E140 (249) CUYAHOGA COUNTY, OHIO	
REVISIONS 1 2 3 4	DR. <u>CCD-MC</u> DATE <u>2/20</u> CH. <u>CCD-JB</u> DATE <u>2/20</u> APP. _____ DATE _____
DWG. NO. E2	CONT. NO. 19-782



FWD ABUTMENT CROSSFRAME
LOOKING AHEAD STATIONS

WATERLINE OR ELECTRICAL CONDUITS
NOT SHOWN FOR CLARITY AND ARE
NOT BY SFI



GENERAL CONTRACTOR: KOKOSING D&B

TOTAL WEIGHT

NOTES: ___ DIA. HOLES UNLESS NOTED ___ DIA. BOLTS UNLESS NOTED

PAINT SPECS: CLEANING

PRIMER

INTERMEDIATE

FINISH

TO SHOP:



SHANE FELTER INDUSTRIES

P.O. BOX 2022 • ROUTE 51 • UNIONTOWN PENNSYLVANIA 15401

ERECTION DETAILS - FWD ABUTMENT CROSS FRAME DETAILS

BU-25 E 89TH ST PEDESTRIAN BRIDGE CUY-IR490/SR010-2.09/19.28


CITY OF CLEVELAND, CONSTRUCTION PROJECT #17-3000 PID #96833

FED. PROJ.# E140 (249) CUYAHOGA COUNTY, OHIO

1	ADDED FIELD WELD SYMBOL	6/17/20	DR.	CCD-MC	DATE	2/20
2			CH.	CCD-JB	DATE	2/20
3			APP.		DATE	
4						

DWG. NO. E3

CONT. NO. 19-782

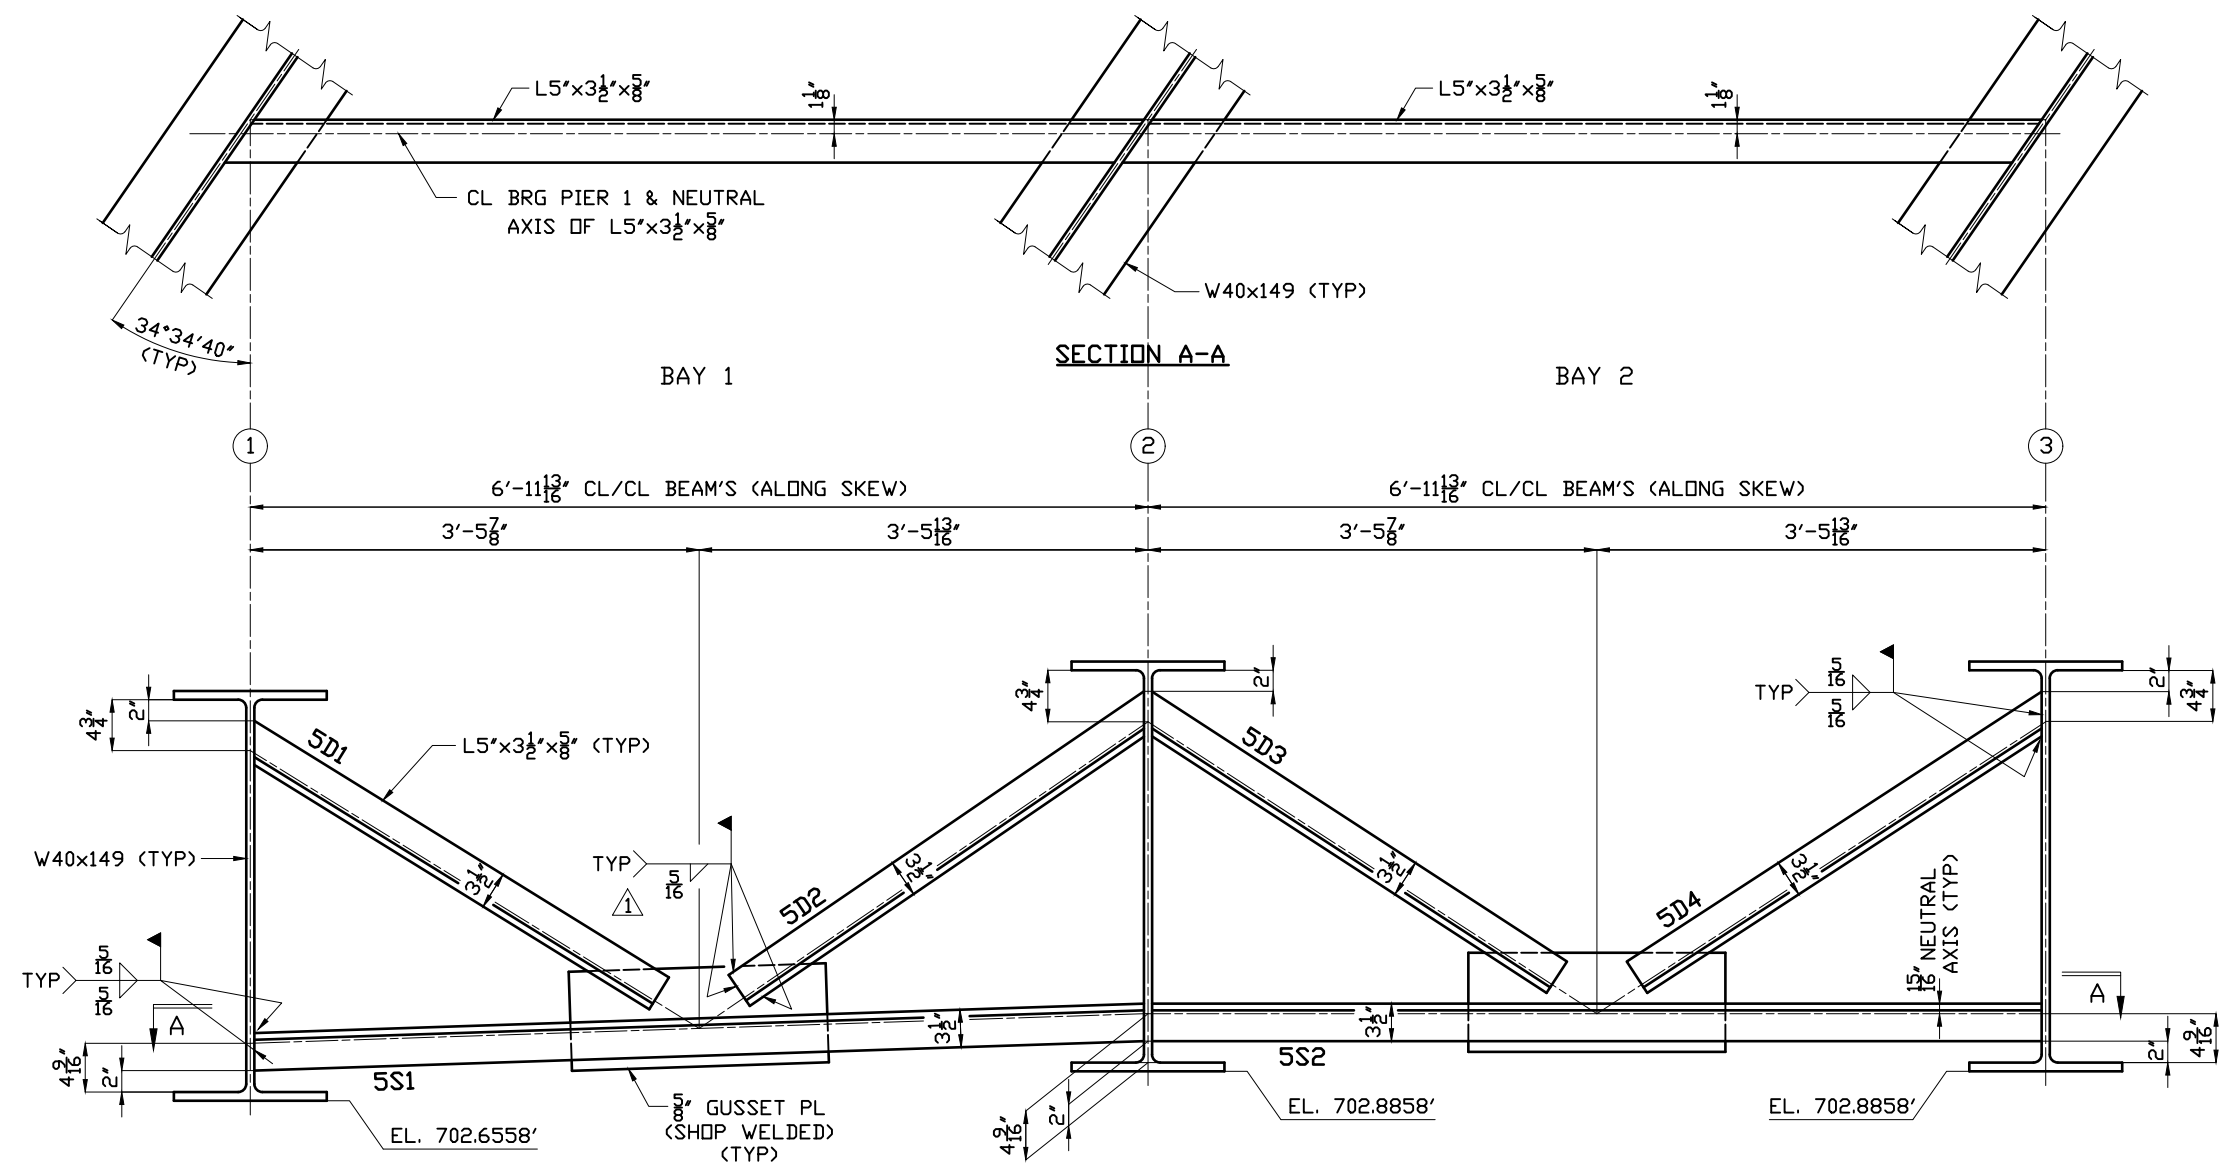


PIER 1 CROSSFRAME
LOOKING AHEAD STATIONS
WATERLINE OR ELECTRICAL CONDUITS
NOT SHOWN FOR CLARITY AND ARE
NOT BY SFI



GENERAL CONTRACTOR: KOKOSING D&B



TOTAL WEIGHT		
NOTES: ___ DIA. HOLES UNLESS NOTED ___ DIA. BOLTS UNLESS NOTED		
PAINT SPECS: CLEANING		
PRIMER		
INTERMEDIATE		
FINISH		
TO SHOP:		



SHANE FELTER INDUSTRIES
P.O. BOX 2022 • ROUTE 51 • UNIONTOWN PENNSYLVANIA 15401

ERECTION DETAILS
BU-25 E 89TH ST PEDESTRIAN BRIDGE CUY-IR490/SR010-2.09/19.28
CITY OF CLEVELAND, CONSTRUCTION PROJECT #17-3000 PID #96833
FED. PROJ.# E140 (249) CUYAHOGA COUNTY, OHIO


REVISIONS	1. REMOVED APPROVER NOTE 6/17/20	DR. CCD-MC DATE 2/20
2.		CH. CCD-JB DATE 2/20
3.		APP. _____ DATE _____
4.		
DWG. NO. E4	CONT. NO. 19-782	

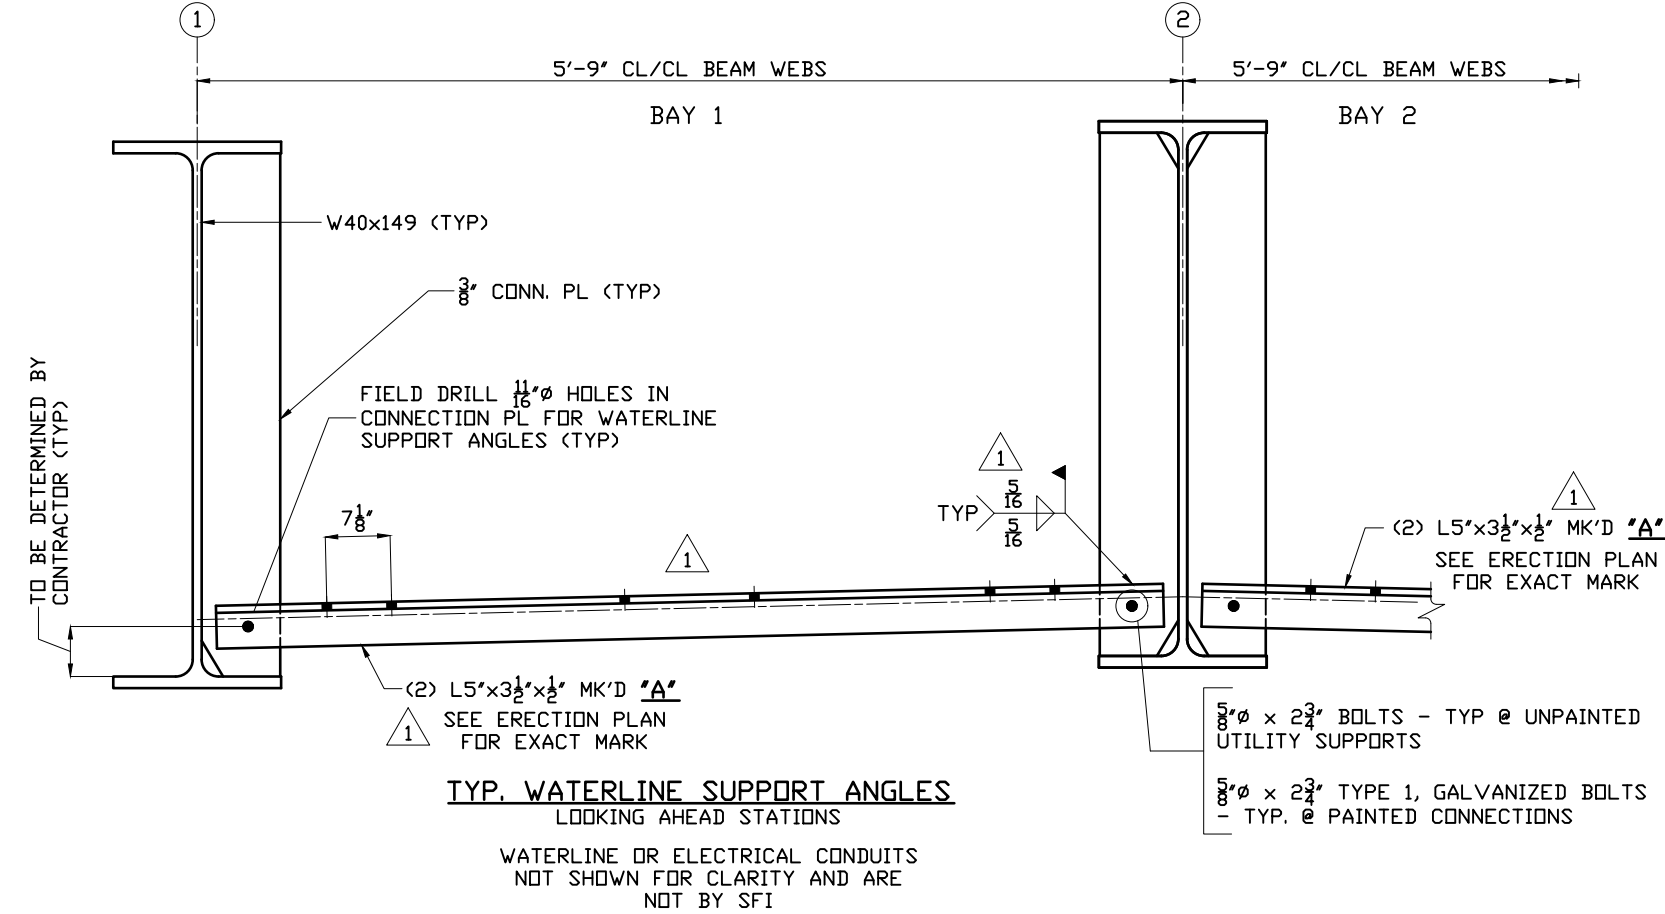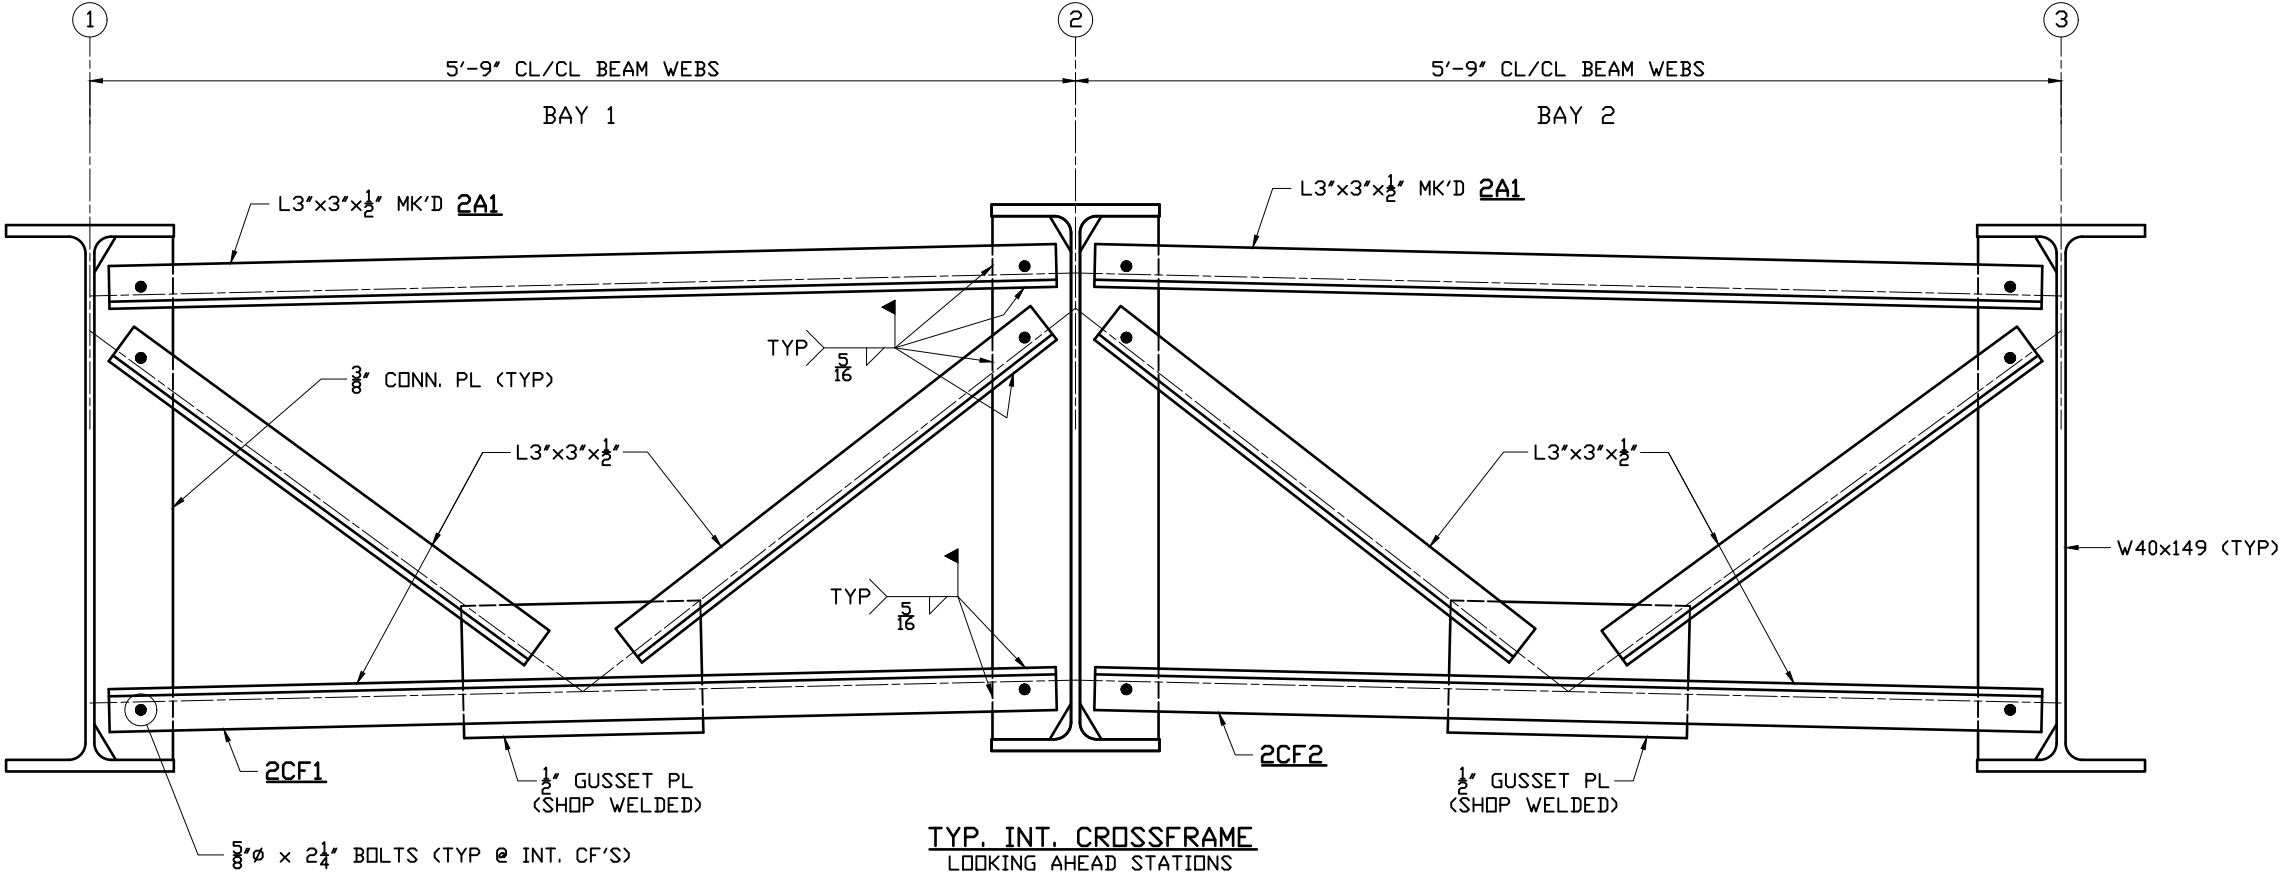


BOLT NOTE:

1 -ALL BOLTS FOR CROSSFRAMES AND UTILITY SUPPORTS ARE TYPE 1 OR TYPE 3 HIGH STRENGTHS BOLTS WITH ONE HVY. HEX NUT AND TWO HARDENED WASHERS.

-ALL FIELD SPLICE BOLTS ARE TYPE 3 WEATHERING HIGH STRENGTH BOLTS WITH ONE HVY. HEX NUT AND ONE HARDENED WASHER. PLACE WASHER UNDER TURNED ELEMENT (NUT).

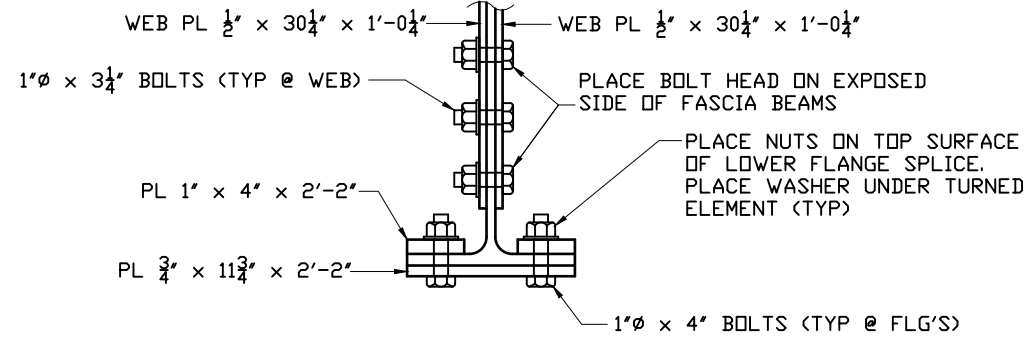


GENERAL CONTRACTOR: KOKOSING D&B	
TOTAL WEIGHT	
NOTES: ____ DIA. HOLES UNLESS NOTED ____ DIA. BOLTS UNLESS NOTED	
PAINT SPECS: CLEANING _____	
PRIMER _____	
INTERMEDIATE _____	
FINISH _____	
TO SHOP:	
SFI SHANE FELTER INDUSTRIES	
P.O. BOX 2022 • ROUTE 51 • UNIONTOWN PENNSYLVANIA 15401	
ERECTION DETAILS	
BU-25 E 89TH ST PEDESTRIAN BRIDGE CUY-IR490/SR010-2.09/19.28	
CITY OF CLEVELAND, CONSTRUCTION PROJECT #17-3000 PID #96833	
FED. PROJ.# E140 (249) CUYAHOGA COUNTY, OHIO	
REVISIONS	1 APPROVER COMMENTS 6/17/20
2	DR. CCD-MC DATE 2/20
3	CH. CCD-JB DATE 2/20
4	APP. _____ DATE _____
DWG. NO. E5	CONT. NO. 19-782

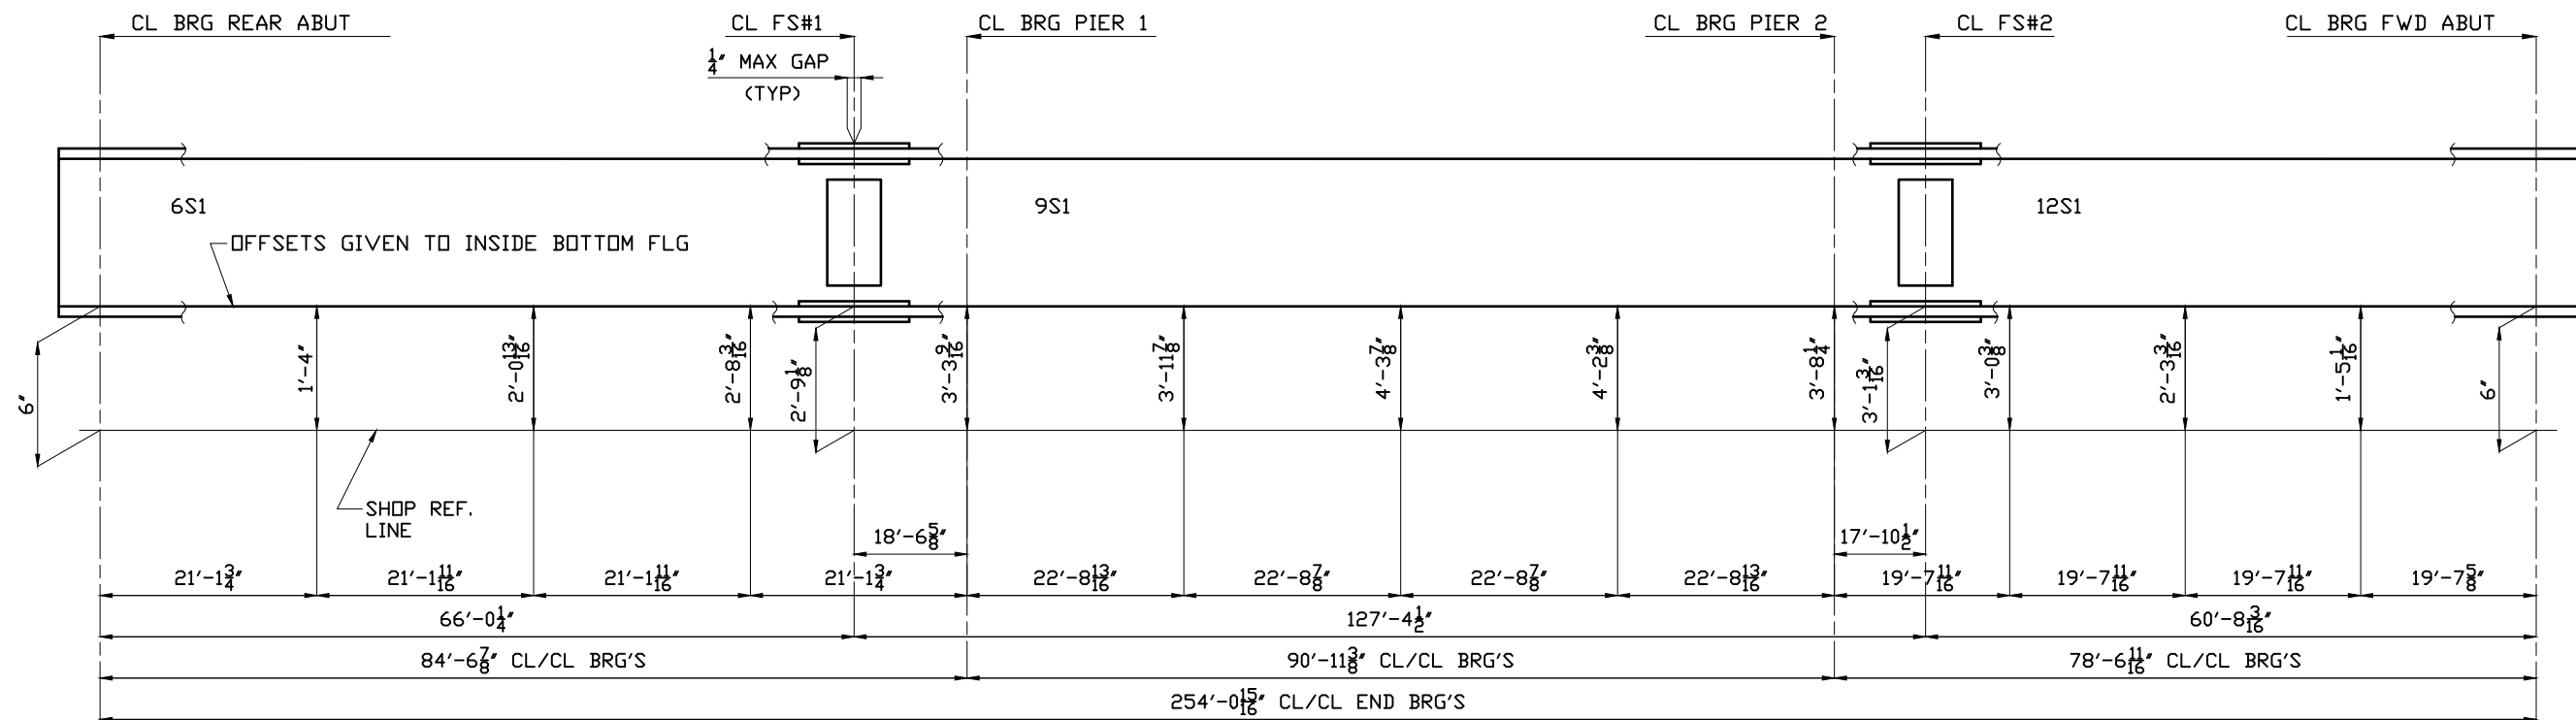


BLOCKING DIAGRAM ~ LINE 1

⚠ BLOCKING DIAGRAM DIMENSIONS THIS SHEET ARE DERIVED FROM THE BLOCKING DIAGRAM DIMENSIONS SHOWN IN THE CONTRACT DRAWINGS +6".

FOR SHOP NOTES SEE DWG. GN1AB/B
ALL STEEL SHALL BE ASTM A709 GR 50W

GENERAL CONTRACTOR: KOKOSING D&B	
TOTAL WEIGHT	
NOTES: ____ DIA. HOLES UNLESS NOTED ____ DIA. BOLTS UNLESS NOTED	
PAINT SPECS: CLEANING _____	
PRIMER _____	
INTERMEDIATE _____	
FINISH _____	
TO SHOP:	
 SHANE FELTER INDUSTRIES <small>P.O. BOX 2022 • ROUTE 51 • UNIONTOWN PENNSYLVANIA 15401</small>	
SHOP BLOCKING DIAGRAM - LINE 1 BU-25 E 89TH ST PEDESTRIAN BRIDGE CUY-IR490/SR010-2.09/19.28 CITY OF CLEVELAND, CONSTRUCTION PROJECT #17-3000 PID #96833 FED. PROJ.# E140 (249) CUYAHOGA COUNTY, OHIO	
REVISIONS	1 ADDED NOTE 6/17/20
2	
3	
4	
DWG. NO. BD1	DR. CCD-MC DATE 2/20 CH. CCD-JB DATE 2/20 APP. _____ DATE _____
CONT. NO. 19-782	



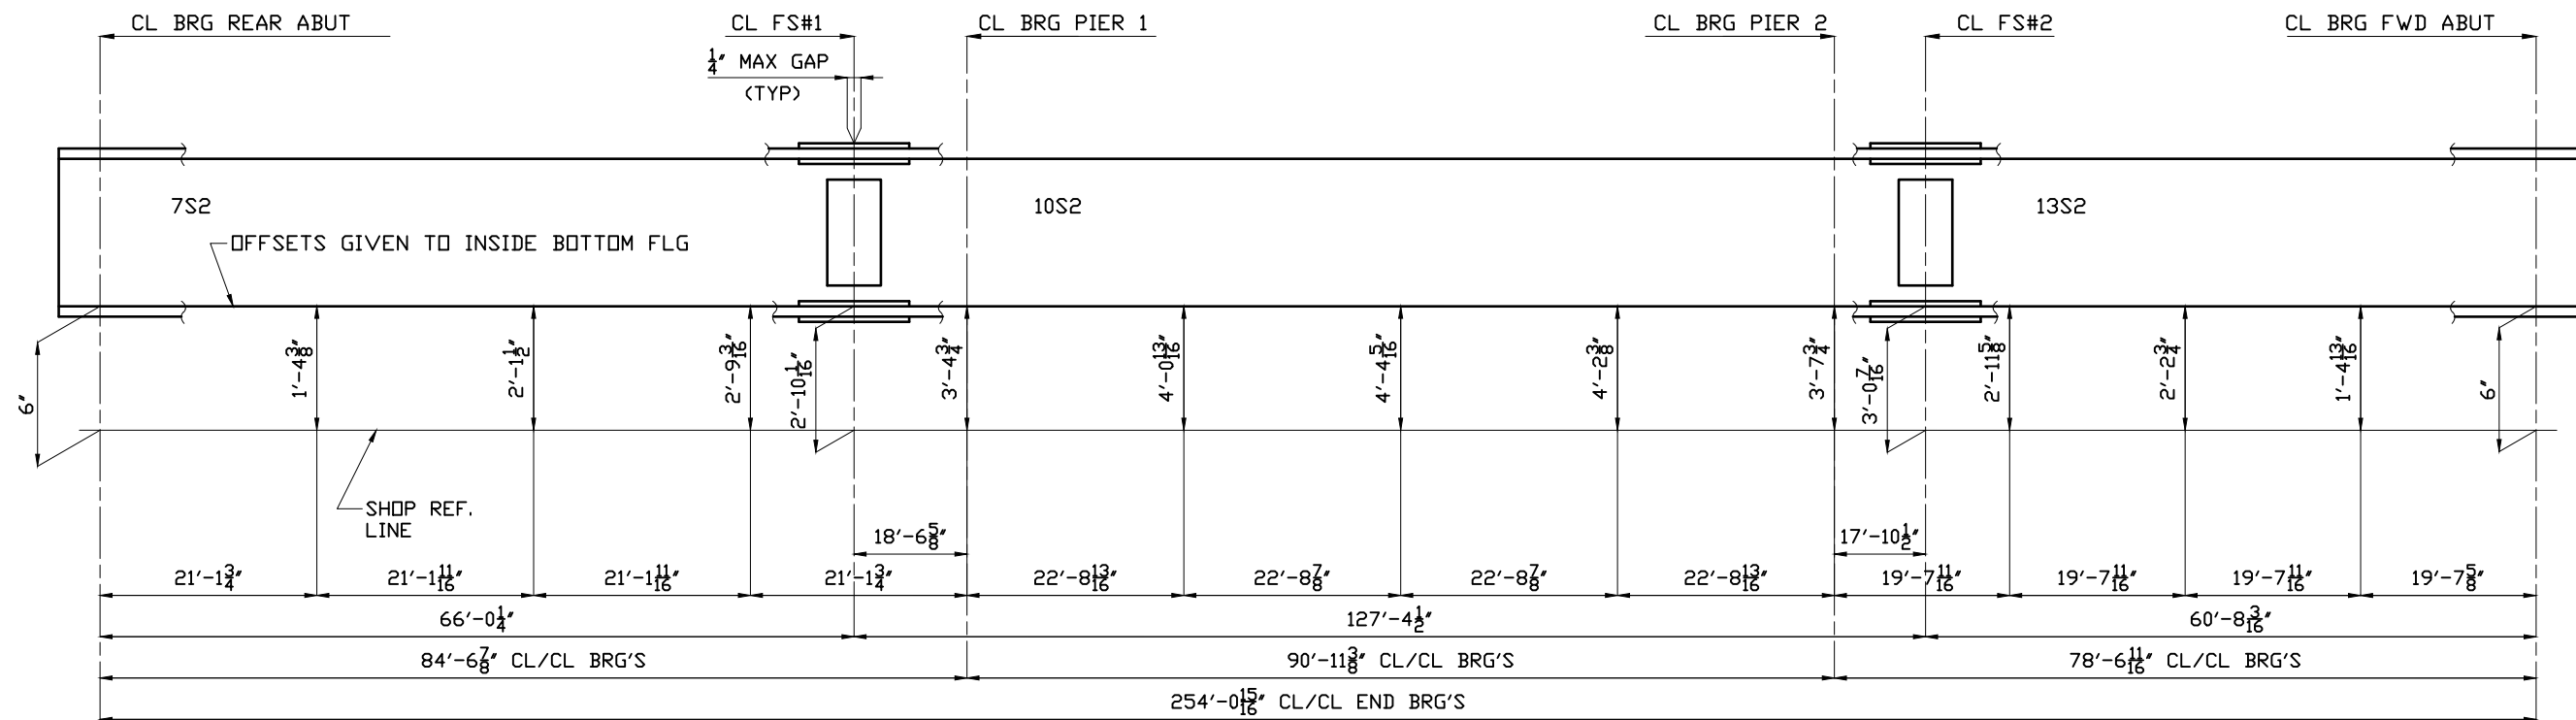


BLOCKING DIAGRAM ~ LINE 2
⚠ BLOCKING DIAGRAM DIMENSIONS THIS SHEET ARE DERIVED FROM THE BLOCKING DIAGRAM DIMENSIONS SHOWN IN THE CONTRACT DRAWINGS +6".

FOR SHOP NOTES SEE DWG. GN1AB/B
ALL STEEL SHALL BE ASTM A709 GR 50W




GENERAL CONTRACTOR: KOKOSING D&B	
TOTAL WEIGHT	
NOTES: ____ DIA. HOLES UNLESS NOTED ____ DIA. BOLTS UNLESS NOTED	
PAINT SPECS: CLEANING _____	
PRIMER _____	
INTERMEDIATE _____	
FINISH _____	
TO SHOP:	
 SHANE FELTER INDUSTRIES <small>P.O. BOX 2022 • ROUTE 51 • UNIONTOWN PENNSYLVANIA 15401</small>	
SHOP BLOCKING DIAGRAM - LINE 2 BU-25 E 89TH ST PEDESTRIAN BRIDGE CUY-IR490/SR010-2.09/19.28 CITY OF CLEVELAND, CONSTRUCTION PROJECT #17-3000 PID #96833 FED. PROJ.# E140 (249) CUYAHOGA COUNTY, OHIO	
REVISIONS	1 ADDED NOTE 6/17/20 2 3 4
DWG. NO. BD2	DR. CCD-MC DATE 2/20 CH. CCD-JB DATE 2/20 APP. _____ DATE _____
CONT. NO. 19-782	

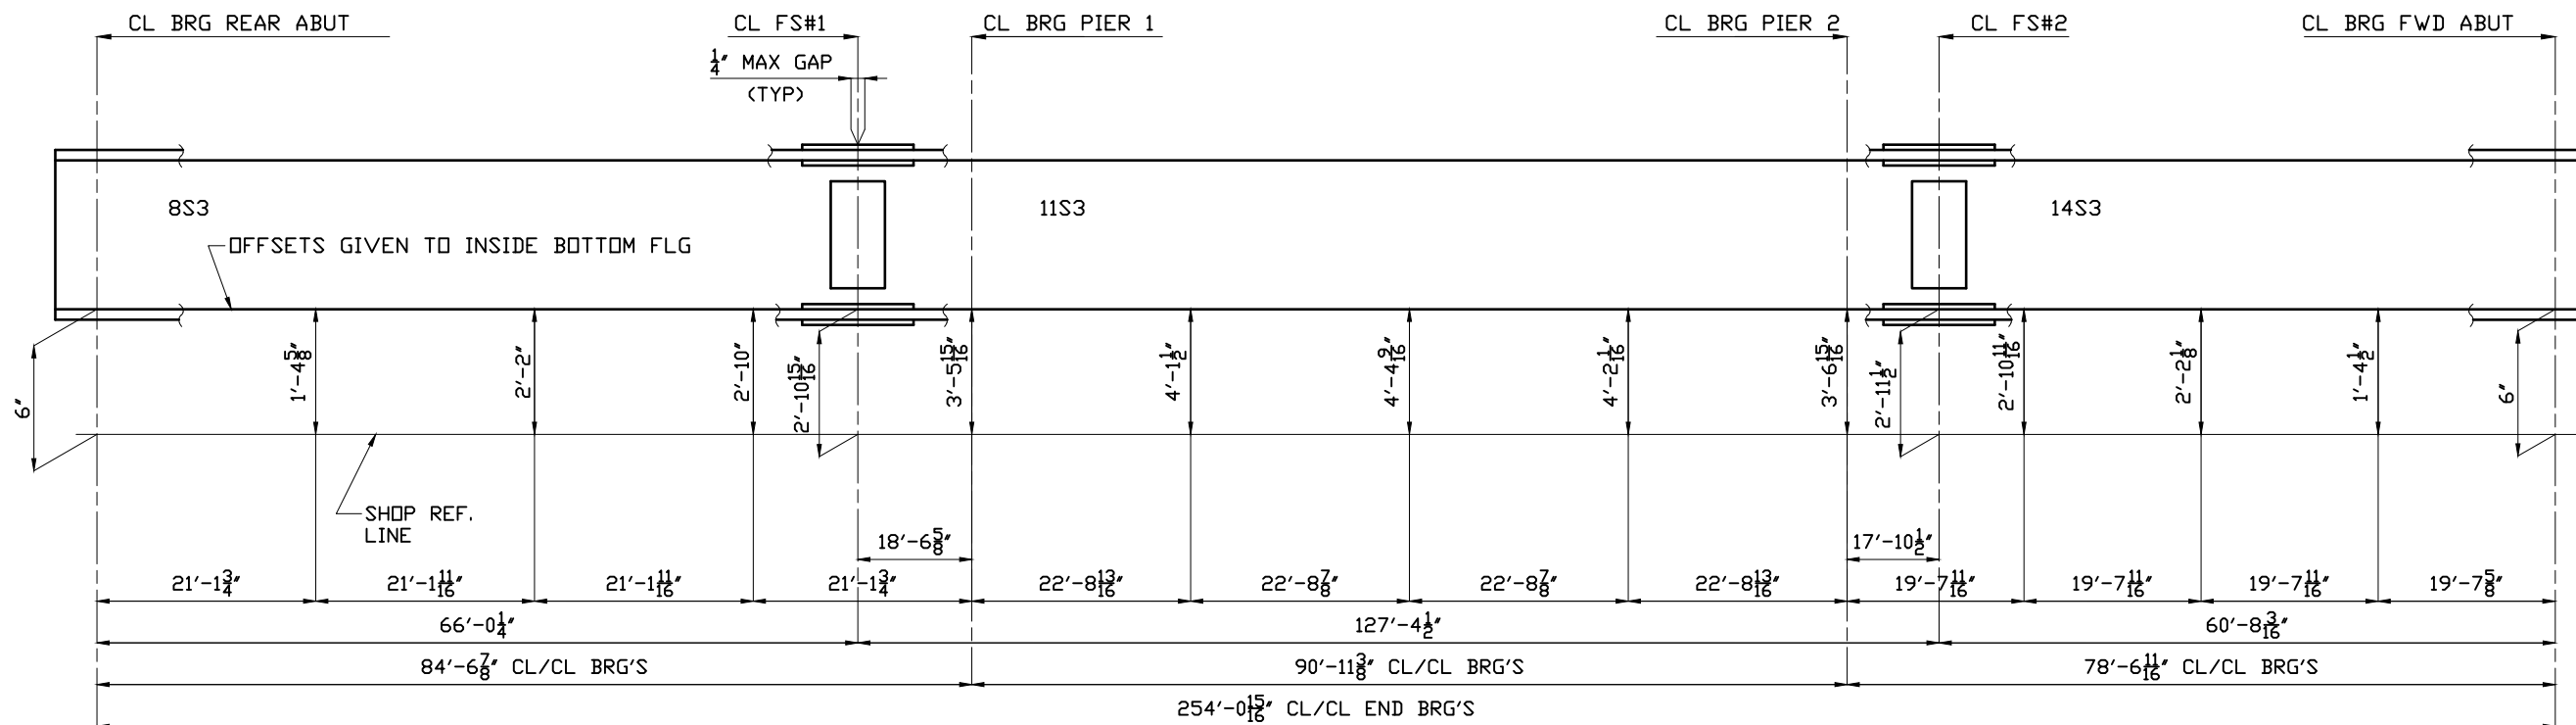


BLOCKING DIAGRAM ~ LINE 3
⚠ BLOCKING DIAGRAM DIMENSIONS THIS SHEET ARE DERIVED FROM THE BLOCKING DIAGRAM DIMENSIONS SHOWN IN THE CONTRACT DRAWINGS +6".


FOR SHOP NOTES SEE DWG. GN1AB/B
ALL STEEL SHALL BE ASTM A709 GR 50W




GENERAL CONTRACTOR: KOKOSING D&B	
TOTAL WEIGHT	
NOTES: ____ DIA. HOLES UNLESS NOTED ____ DIA. BOLTS UNLESS NOTED	
PAINT SPECS: CLEANING _____	
PRIMER _____	
INTERMEDIATE _____	
FINISH _____	
TO SHOP:	
 SHANE FELTER INDUSTRIES <small>P.O. BOX 2022 • ROUTE 51 • UNIONTOWN PENNSYLVANIA 15401</small>	
SHOP BLOCKING DIAGRAM - LINE 3 BU-25 E 89TH ST PEDESTRIAN BRIDGE CUY-IR490/SR010-2.09/19.28 CITY OF CLEVELAND, CONSTRUCTION PROJECT #17-3000 PID #96833 FED. PROJ.# E140 (249) CUYAHOGA COUNTY, OHIO	
REVISIONS	1 ADDED NOTE 6/17/20 2 3 4
DWG. NO. BD3	DR. CCD-MC DATE 2/20 CH. CCD-JB DATE 2/20 APP. _____ DATE _____
CONT. NO. 19-782	

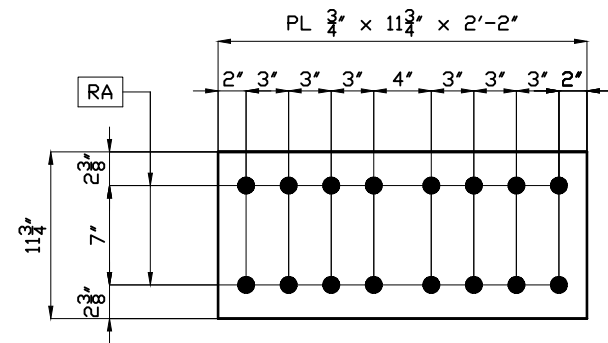


12 ~TOP OR BOT FLG SPLICE PLS~ a1 ~CVN

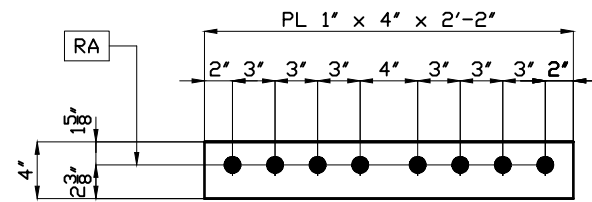


24 ~TOP OR BOT FLG SPLICE PLS~ b1 ~CVN

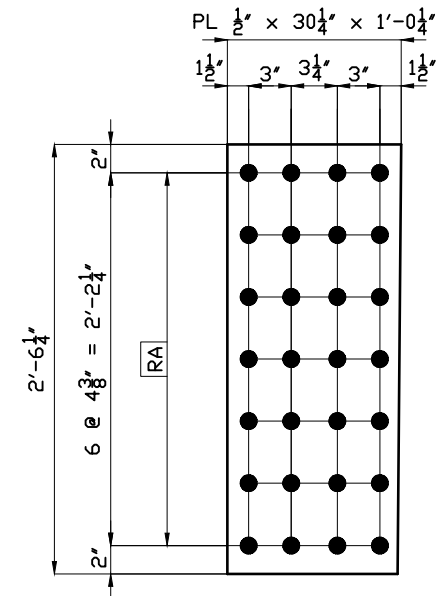


12 ~WEB SPLICE PLS~ c1 ~CVN

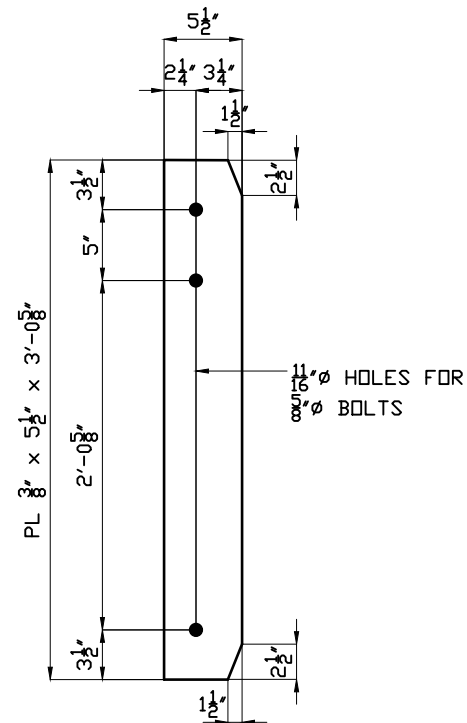

64 ~CONN. PL'S~ d1

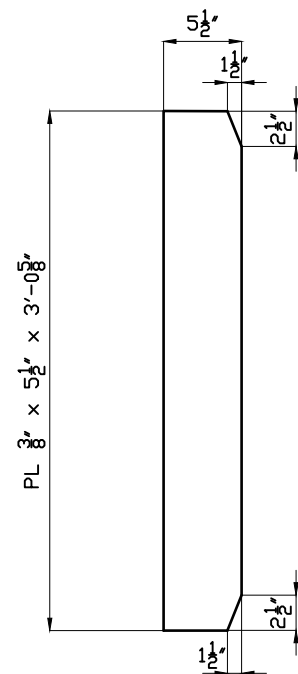


90 ~UTILITY CONN. PL'S~ e1

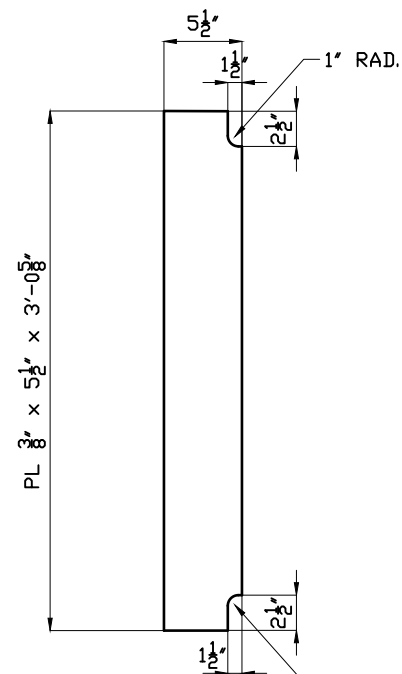


8 ~UTILITY CONN. PL'S~ f1
(PAINTED)



FOR SHOP NOTES SEE DWG. GN1AB/B
ALL STEEL SHALL BE ASTM A709 GR 50W


GENERAL CONTRACTOR: KOKOSING D&B	
TOTAL WEIGHT	
NOTES: 1 1/16" DIA. HOLES UNLESS NOTED 1" DIA. BOLTS UNLESS NOTED	
PAINT SPECS: CLEANING	PER GNIAB
PRIMER	AS NOTED PER GNIAB
INTERMEDIATE	N/A
FINISH	N/A
TO SHOP:	
 SHANE FELTER INDUSTRIES <small>P.O. BOX 2022 • ROUTE 51 • UNIONTOWN PENNSYLVANIA 15401</small>	
JOB STANDARD DETAILS BU-25 E 89TH ST PEDESTRIAN BRIDGE CUY-IR490/SR010-2.09/19.28 CITY OF CLEVELAND, CONSTRUCTION PROJECT #17-3000 PID #96833 FED. PROJ.# E140 (249) CUYAHOGA COUNTY, OHIO	
REVISIONS 1 REVISED QUANTITIES 6/17/20 2 3 4	DR. CCD-MC DATE 2/20 CH. CCD-JB DATE 2/20 APP. DATE
DWG. NO. 1	CONT. NO. 19-782

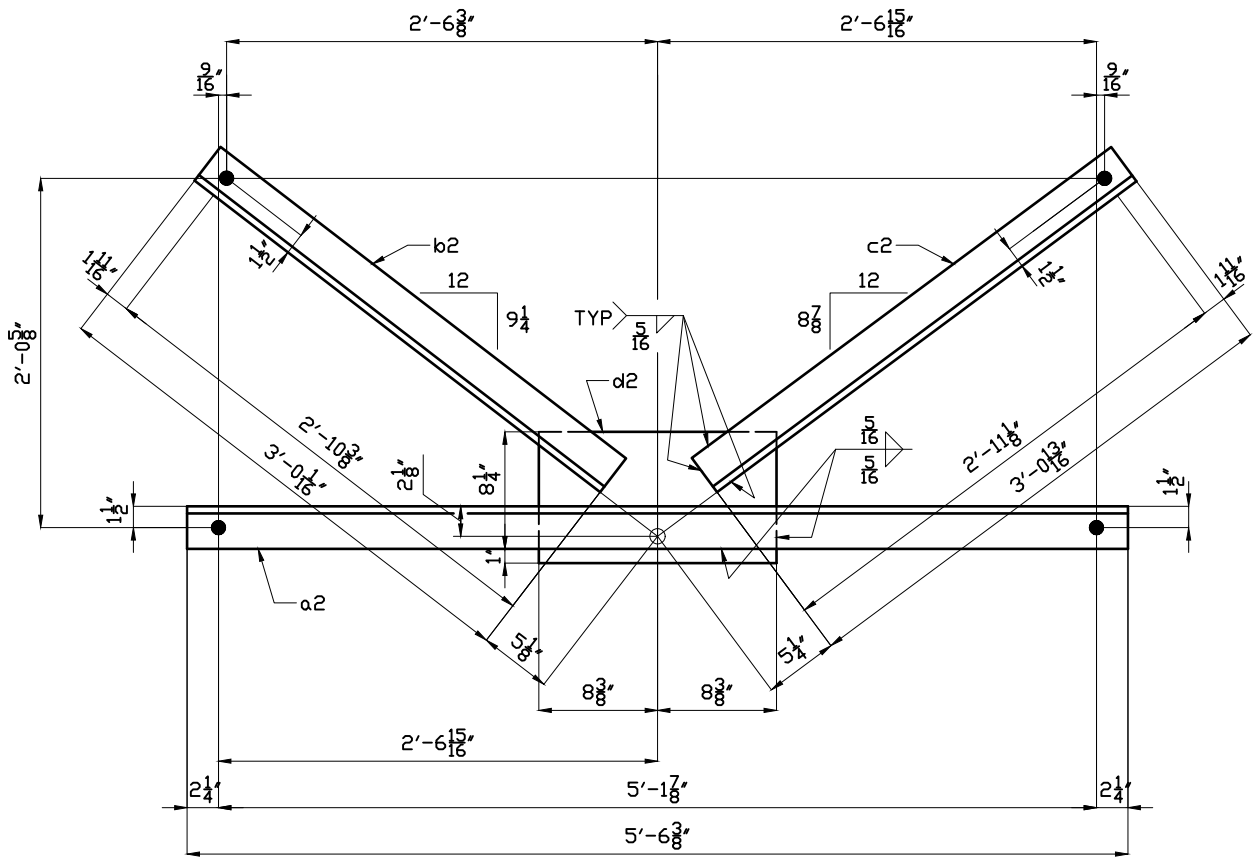

16 ~CROSS FRAMES~ 2CF1

a2, b2, c2 - L3"x3"x $\frac{1}{2}$ "


d2 - PL $\frac{1}{2}$ " x 9 $\frac{1}{4}$ " x 1'-4 $\frac{3}{4}$ "

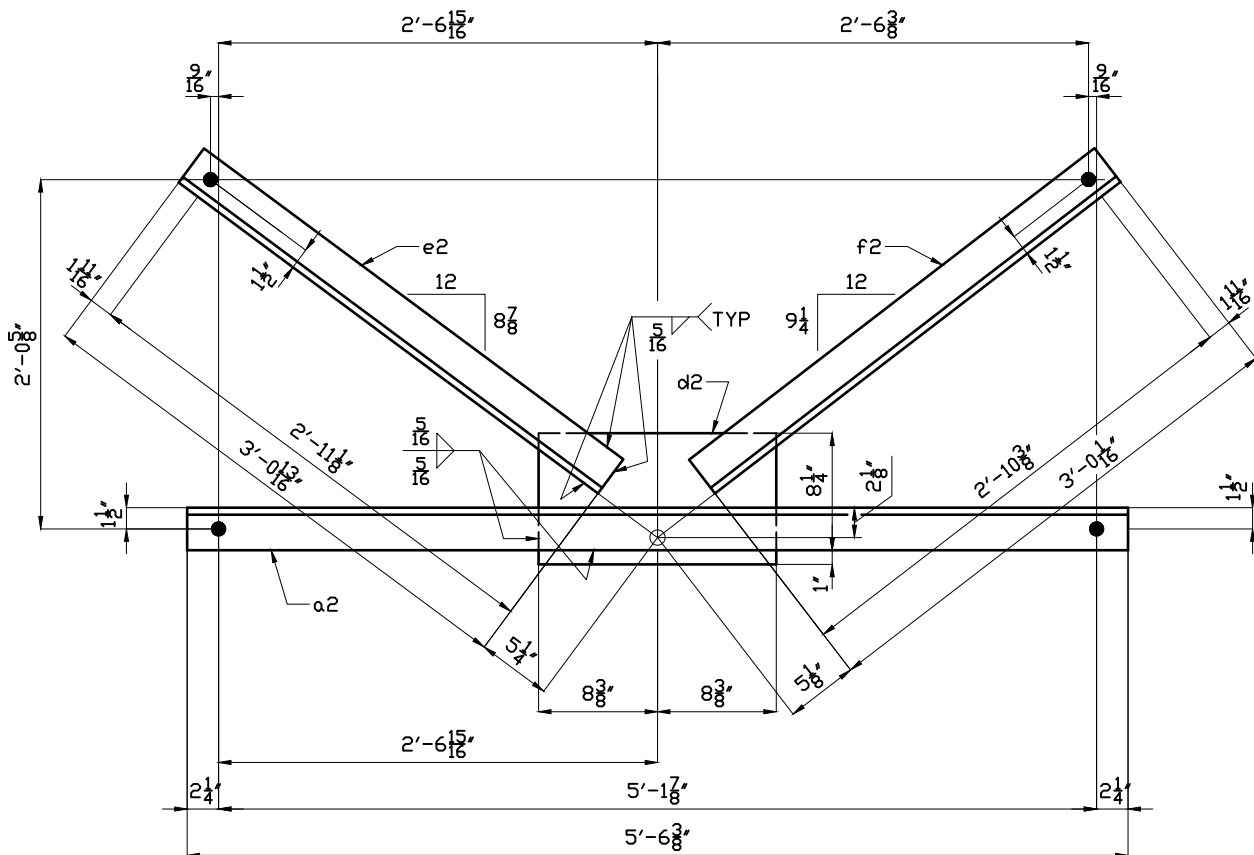


16 ~CROSS FRAMES~ 2CF2

a2, e2, f2 - L3"x3"x $\frac{1}{2}$ "


d2 - PL $\frac{1}{2}$ " x 9 $\frac{1}{4}$ " x 1'-4 $\frac{3}{4}$ "

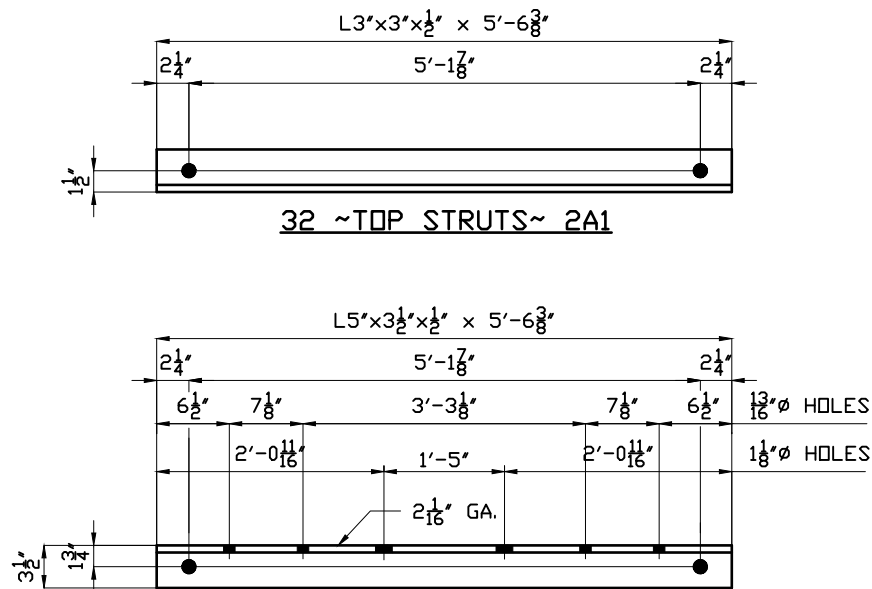

32 ~TOP STRUTS~ 2A1

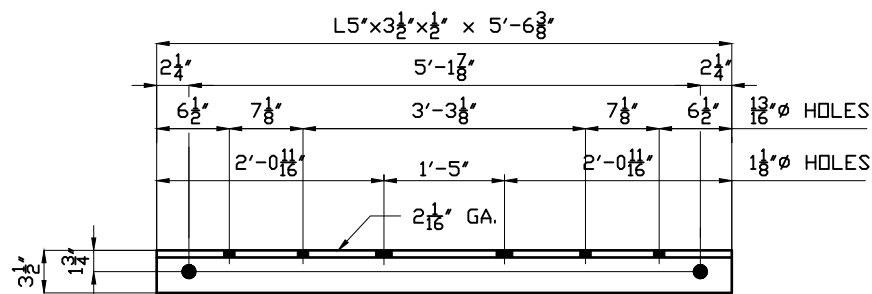


45 ~UTILITY SUPPORT~ 2A2

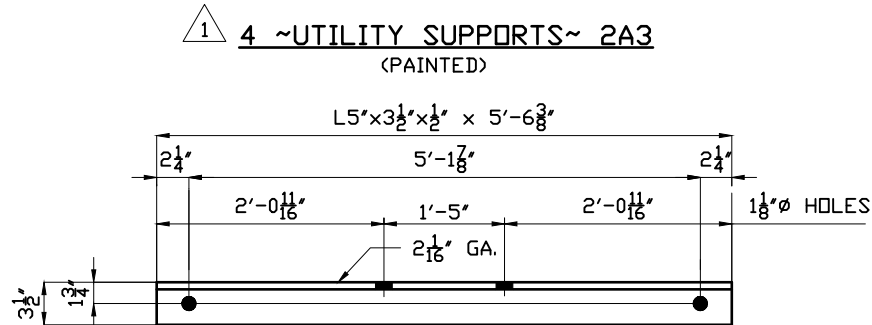

4 ~UTILITY SUPPORTS~ 2A3

(PAINTED)

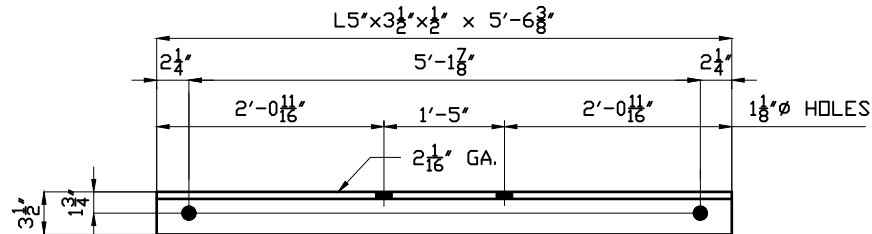

45 ~UTILITY SUPPORTS~ 2A4



4 ~UTILITY SUPPORTS~ 2A5

(PAINTED)



BILL OF MATERIAL

PHASE 1	PHASE 2	ASS'Y MARK	NO. REQ'D	DESCRIPTION	WEIGHT	NOTES
		2A1	32	L3"x3"x $\frac{1}{2}$ " x 5'-6 $\frac{3}{8}$ "		
		2A2	45	L5"x3 $\frac{1}{2}$ "x $\frac{1}{2}$ " x 5'-6 $\frac{3}{8}$ "		
		2A3	4	L5"x3 $\frac{1}{2}$ "x $\frac{1}{2}$ " x 5'-6 $\frac{3}{8}$ "		PAINT
		2A4	45	L5"x3 $\frac{1}{2}$ "x $\frac{1}{2}$ " x 5'-6 $\frac{3}{8}$ "		PAINT
		2A5	4	L5"x3 $\frac{1}{2}$ "x $\frac{1}{2}$ " x 5'-6 $\frac{3}{8}$ "		PAINT
		2CF1	16	CROSS FRAMES		
		a2	16	L3"x3"x $\frac{1}{2}$ " x 5'-6 $\frac{3}{8}$ "		
		b2	16	L3"x3"x $\frac{1}{2}$ " x 3'-0 $\frac{13}{16}$ "		
		c2	16	L3"x3"x $\frac{1}{2}$ " x 3'-0 $\frac{13}{16}$ "		
		d2	16	PL $\frac{1}{2}$ " x 9 $\frac{1}{4}$ " x 1'-4 $\frac{3}{4}$ "		
		2CF2	16	CROSS FRAMES		
		a2	16	L3"x3"x $\frac{1}{2}$ " x 5'-6 $\frac{3}{8}$ "		
		e2	16	L3"x3"x $\frac{1}{2}$ " x 3'-0 $\frac{13}{16}$ "		
		f2	16	L3"x3"x $\frac{1}{2}$ " x 3'-0 $\frac{13}{16}$ "		
		d2	16	PL $\frac{1}{2}$ " x 9 $\frac{1}{4}$ " x 1'-4 $\frac{3}{4}$ "		

FOR SHOP NOTES SEE DWG. GNIAB/B

ALL STEEL SHALL BE ASTM A709 GR 50W

GENERAL CONTRACTOR: KOKOSING D&B

TOTAL WEIGHT	
NOTES:	13" DIA. HOLES UNLESS NOTED 5" DIA. BOLTS UNLESS NOTED
PAIN SPEC:	CLEANING PER GNIAB
PRIMER	AS NOTED PER GNIAB
INTERMEDIATE	N/A
FINISH	N/A
TO SHOP:	



SHANE FELTER INDUSTRIES


P.O. BOX 2022 • ROUTE 51 • UNIONTOWN PENNSYLVANIA 15401

INTERMEDIATE CROSS FRAME DETAILS
BU-25 E 89TH ST PEDESTRIAN BRIDGE CUY-IR490/SR010-2.09/19.28
CITY OF CLEVELAND, CONSTRUCTION PROJECT #17-3000 PID #96833
FED. PROJ.# E140 (249) CUYAHOGA COUNTY, OHIO


REVISIONS	1 REM. PAINT NOTES/FIX. HOLES 6/17/20	DR. CCD-MC DATE 2/20
2		CH. CCD-JB DATE 2/20
3		APP. DATE
4		

DWG. NO. 2


CONT. NO. 19-782

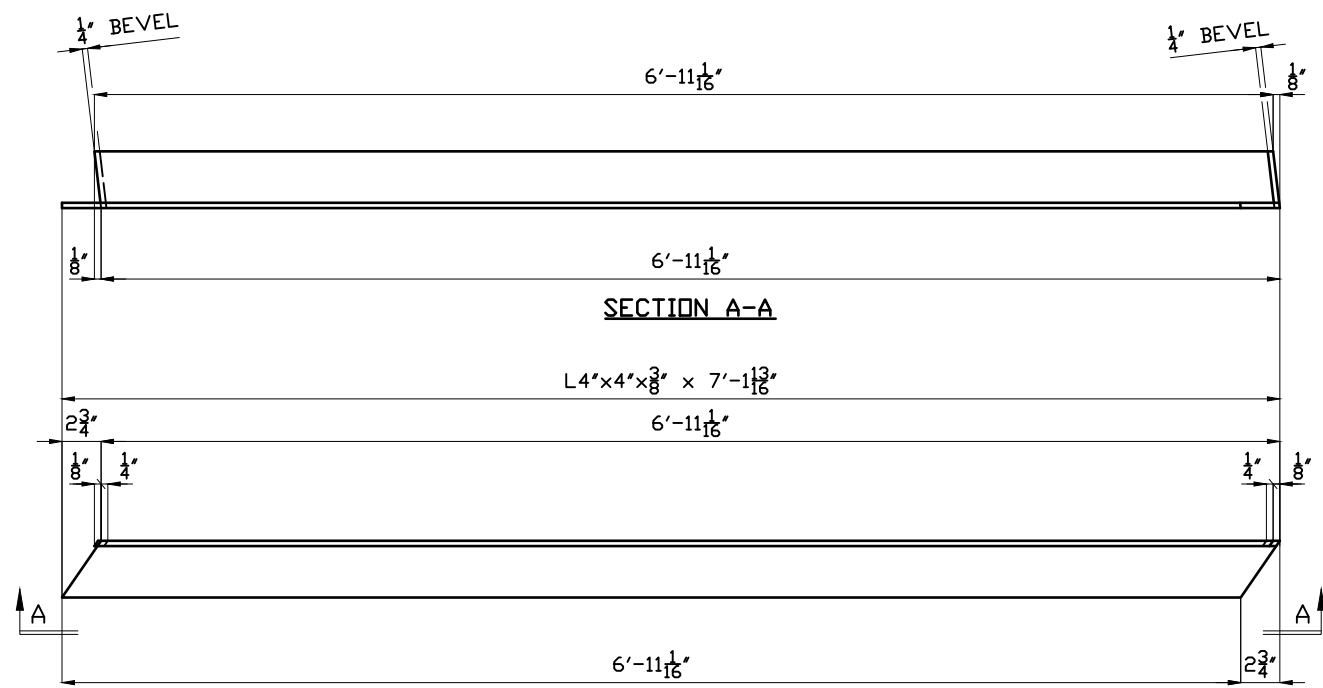


ONE ~REAR ABUT STRUT~ 3S1
BAY 1

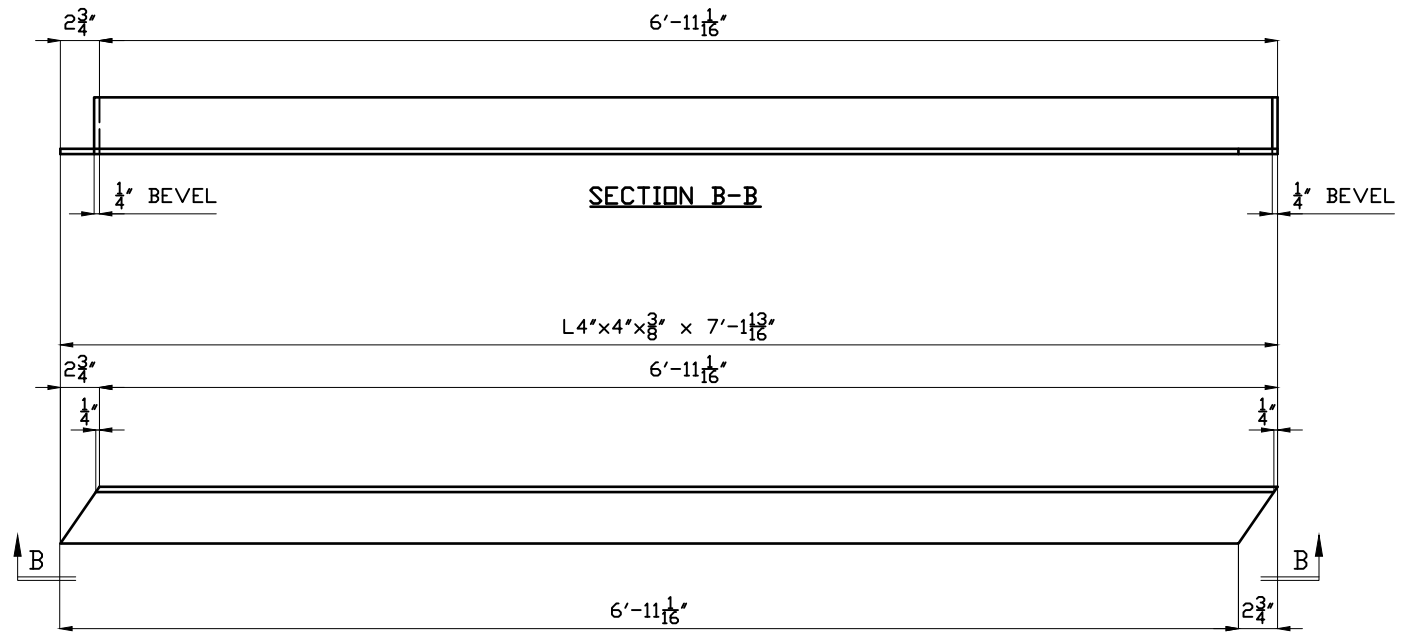

ONE ~REAR ABUT STRUT~ 3S2
BAY 2

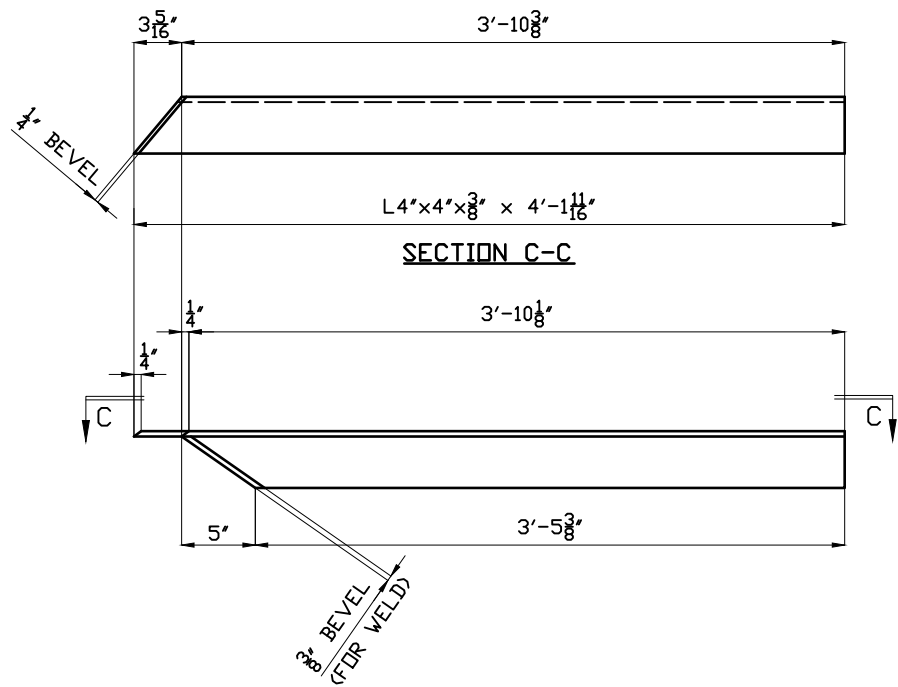


ONE ~REAR ABUT DIAG.~ 3D1
BAY 1

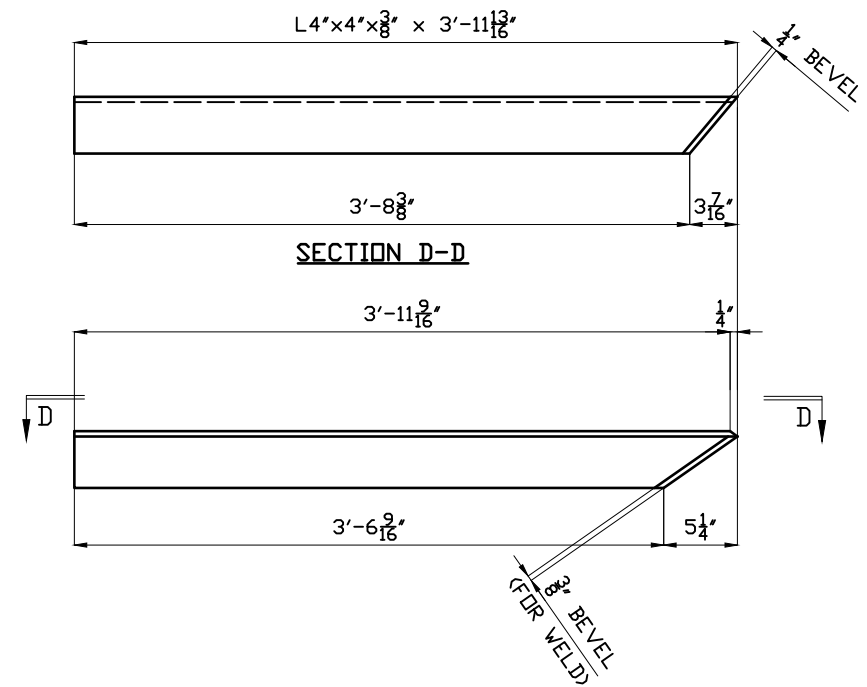


ONE ~REAR ABUT DIAG.~ 3D2
BAY 1




WORK THIS DWG. WITH DWG. 3B
FOR SHOP NOTES SEE DWG. GN1AB/B
ALL STEEL SHALL BE ASTM A709 GR 50W

GENERAL CONTRACTOR: KOKOSING D&B	
TOTAL WEIGHT	
NOTES: ____ DIA. HOLES UNLESS NOTED ____ DIA. BOLTS UNLESS NOTED	
PAINT SPECS: CLEANING	PER GNIAB
PRIMER	AS NOTED PER GNIAB
INTERMEDIATE	N/A
FINISH	N/A
TO SHOP:	
 SHANE FELTER INDUSTRIES <small>P.O. BOX 2022 • ROUTE 51 • UNIONTOWN PENNSYLVANIA 15401</small>	
REAR ABUTMENT CROSS FRAME DETAILS BU-25 E 89TH ST PEDESTRIAN BRIDGE CUY-IR490/SR010-2.09/19.28 CITY OF CLEVELAND, CONSTRUCTION PROJECT #17-3000 PID #96833 FED. PROJ.# E140 (249) CUYAHOGA COUNTY, OHIO	
REVISIONS	DR. CCD-MC DATE 2/20 CH. CCD-JB DATE 2/20 APP. _____ DATE _____
DWG. NO. 3AB	CONT. NO. 19-782

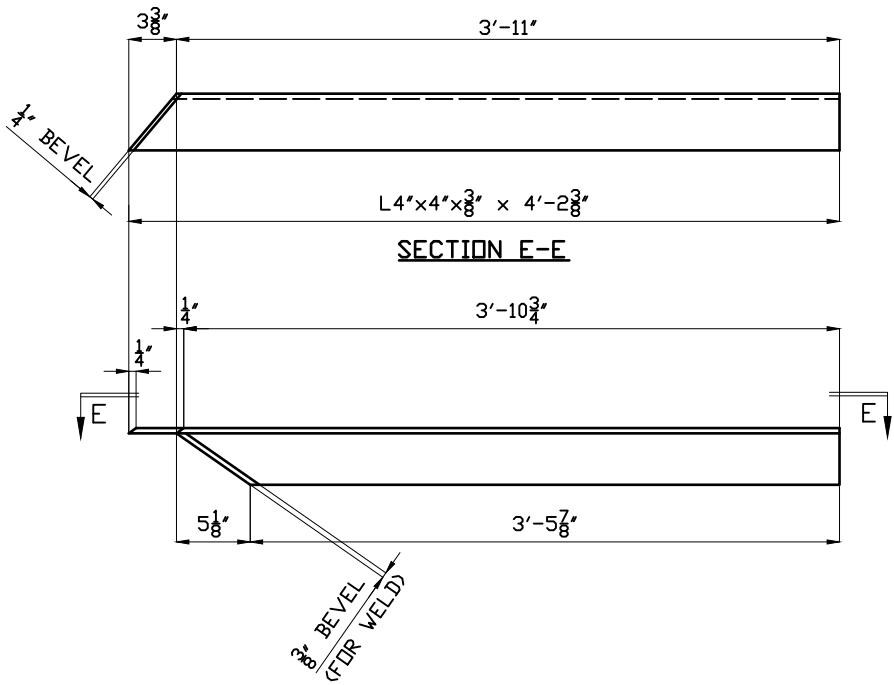

ONE ~REAR ABUT DIAG.~ 3D3
BAY 2

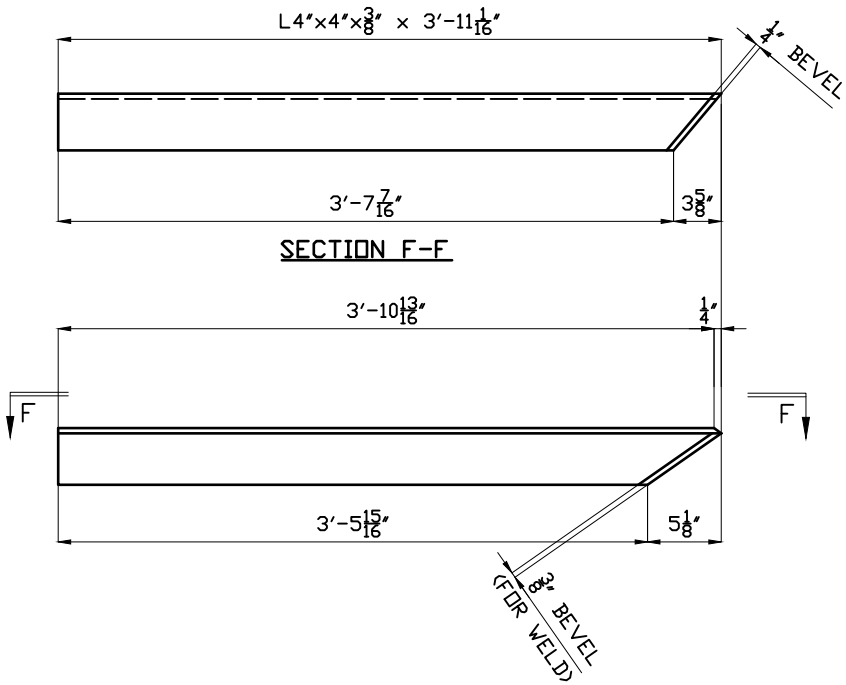

ONE ~REAR ABUT DIAG.~ 3D4
BAY 2




BILL OF MATERIAL						
PHASE 1	PHASE 2	ASS'Y MARK	NO. REQ'D	DESCRIPTION	WEIGHT	NOTES
		3S1	1	L4'x4'x3/8' x 7'-11 13/16'		PAINT
		3S2	1	L4'x4'x3/8' x 7'-11 3/8'		PAINT
		3D1	1	L4'x4'x3/8' x 4'-11 11/16'		PAINT
		3D2	1	L4'x4'x3/8' x 3'-11 13/16'		
		3D3	1	L4'x4'x3/8' x 4'-2 3/8'		
		3D4	1	L4'x4'x3/8' x 3'-11 1/16'		
				FIELD BOLTS W/ HVY HEX NUT AND HARD WASHER (A325-3, A563 GR DH3, F436-3) EXACT COUNT		
		NET				
		192		H.S.B. 1"Ø x 4"		FLG SPL
		168		H.S.B. 1"Ø x 3 1/4"		WEB SPL
		360		H.W. 1"Ø		
				FIELD BOLTS W/ HVY HEX NUT AND TWO HARD WASHER (A325-3, A563 GR DH3, F436-3) EXACT COUNT		
		NET				
		192		H.S.B. 5/8"Ø x 2 1/4"		INT. CF
	1	90		H.S.B. 5/8"Ø x 2 3/4"		UT ANGLE
		564		H.W. 5/8"Ø		
				FIELD BOLTS W/ HVY HEX NUT AND TWO HARD WASHER (A325-1, A563 GR DH, F436-1) EXACT COUNT		
		NET				
	1	8		H.S.B. 5/8"Ø x 2 3/4" HOT DIP GALV		UT ANGLE
		16		H.W. 5/8"Ø HOT DIP GALV		
				SUMMARY OF PARTIALLY THREADED SAFETY STUDS		
	1	NET				
		60		STUD 3/4-10 x 2 1/2" UNC NELSON #101017428		


WORK THIS DWG. WITH DWG. 3AB
FOR SHOP NOTES SEE DWG. GN1AB/B
ALL STEEL SHALL BE ASTM A709 GR 50W

GENERAL CONTRACTOR: KOKOSING D&B


TOTAL WEIGHT			
NOTES: ____ DIA. HOLES UNLESS NOTED ____ DIA. BOLTS UNLESS NOTED			
PAINT SPECS: CLEANING		PER GN1AB	
PRIMER		AS NOTED PER GN1AB	
INTERMEDIATE		N/A	
FINISH		N/A	
TO SHOP:			
		SHANE FELTER INDUSTRIES	
P.O. BOX 2022 • ROUTE 51 • UNIONTOWN PENNSYLVANIA 15401			
REAR ABUTMENT CROSS FRAME DETAILS			
BU-25 E 89TH ST PEDESTRIAN BRIDGE CUY-IR490/SR010-2.09/19.28			
CITY OF CLEVELAND, CONSTRUCTION PROJECT #17-3000 PID #96833			
FED. PROJ.# E140 (249) CUYAHOGA COUNTY, OHIO			
REVISIONS	1	BOLT QTY. & STUD SUMMARY	6/17/20
	2		
	3		
	4		
DWG. NO. 3B		DR. CCD-MC DATE 2/20	CH. CCD-JB DATE 2/20
		APP. _____ DATE _____	
CONT. NO. 19-782			

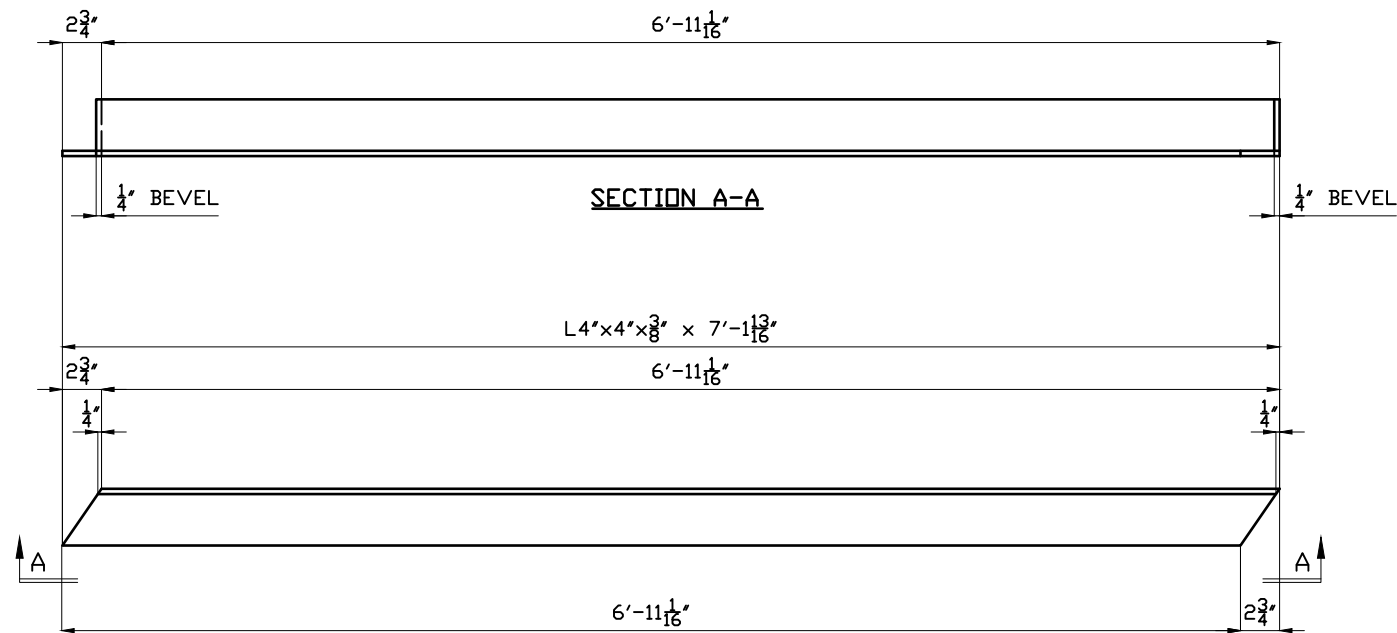


ONE ~FWD ABUT STRUT~ 4S1
BAY 1

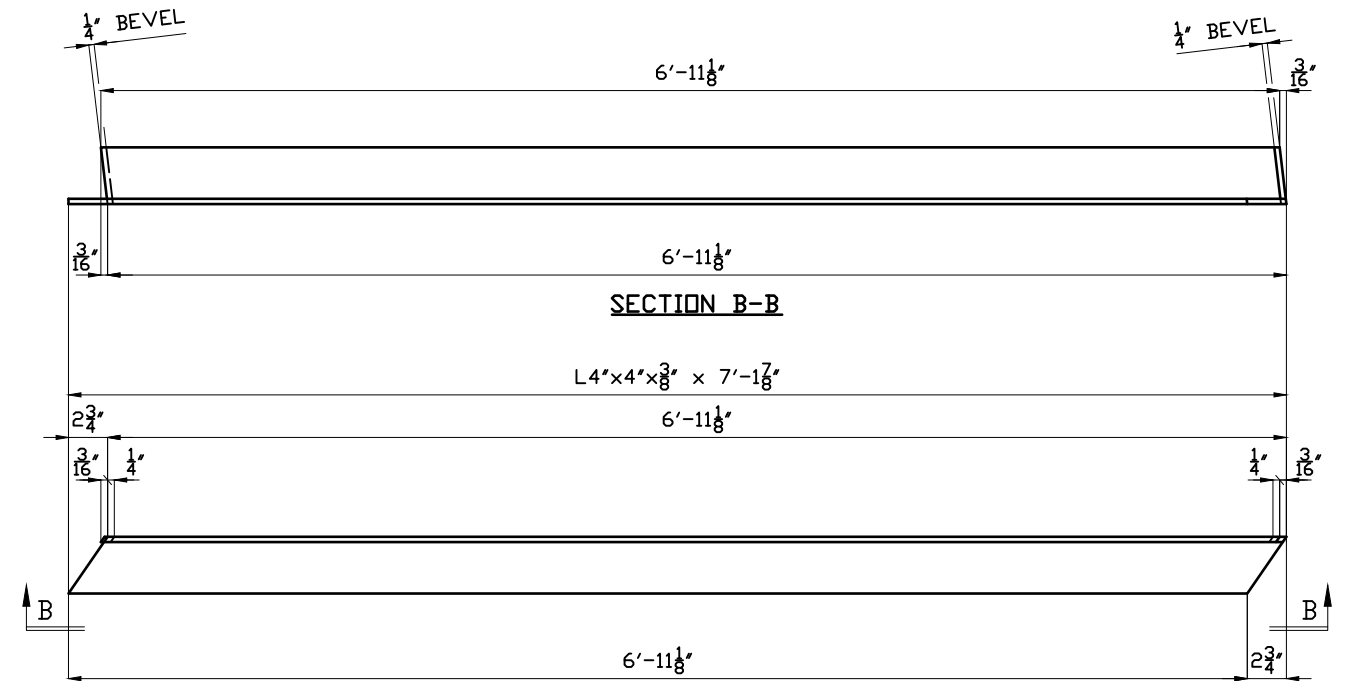

ONE ~FWD ABUT STRUT~ 4S2
BAY 2

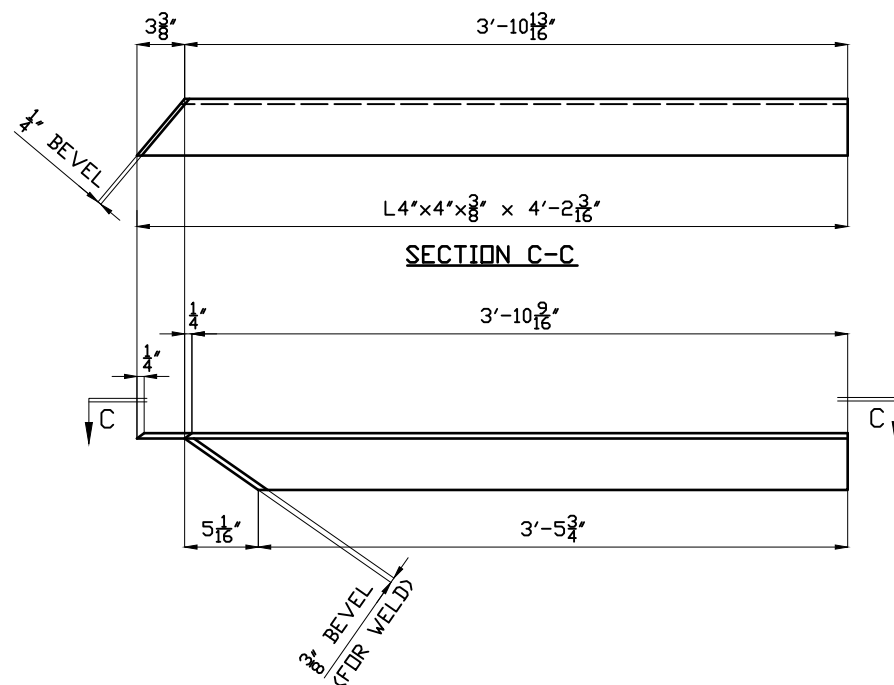

ONE ~FWD ABUT DIAG.~ 4D1
BAY 1

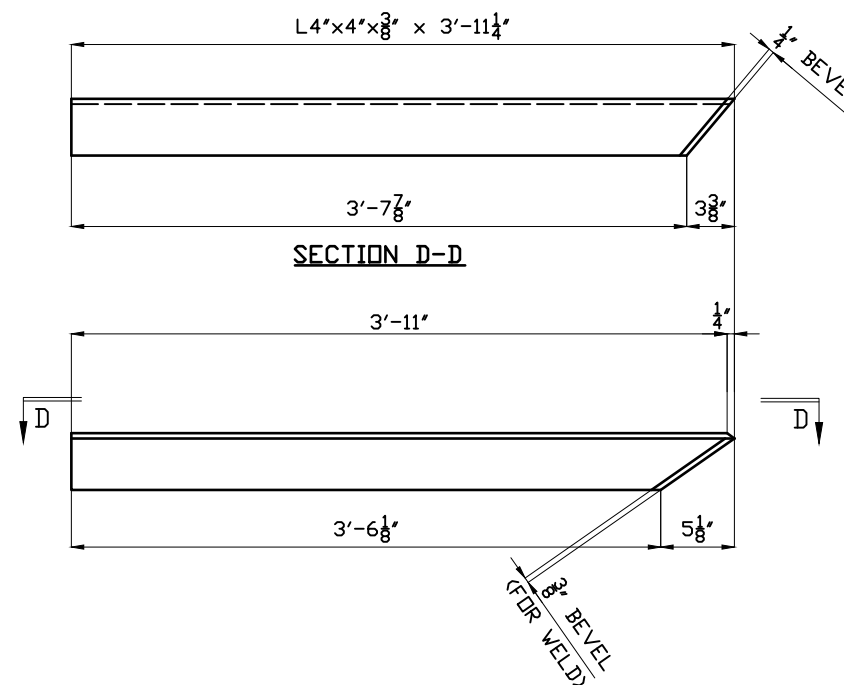


ONE ~FWD ABUT DIAG.~ 4D2
BAY 1




WORK THIS DWG. WITH DWG. 4B
FOR SHOP NOTES SEE DWG. GN1AB/B
ALL STEEL SHALL BE ASTM A709 GR 50W

GENERAL CONTRACTOR: KOKOSING D&B	
TOTAL WEIGHT	
NOTES: ____ DIA. HOLES UNLESS NOTED ____ DIA. BOLTS UNLESS NOTED	
PAINT SPECS: CLEANING	PER GNIAB
PRIMER	AS NOTED PER GNIAB
INTERMEDIATE	N/A
FINISH	N/A
TO SHOP:	
<div><div><div>SFI</div></div><div><div>SHANE FELTER INDUSTRIES</div><div>P.O. BOX 2022 • ROUTE 51 • UNIONTOWN PENNSYLVANIA 15401</div></div></div>	
REAR ABUTMENT CROSS FRAME DETAILS	
BU-25 E 89TH ST PEDESTRIAN BRIDGE CUY-IR490/SR010-2.09/19.28	
CITY OF CLEVELAND, CONSTRUCTION PROJECT #17-3000 PID #96833	
FED. PROJ.# E140 (249) CUYAHOGA COUNTY, OHIO	
REVISIONS	DR. CCD-MC DATE 2/20
1	CH. CCD-JB DATE 2/20
2	APP. _____ DATE _____
3	
4	
DWG. NO. 4AB	CONT. NO. 19-782

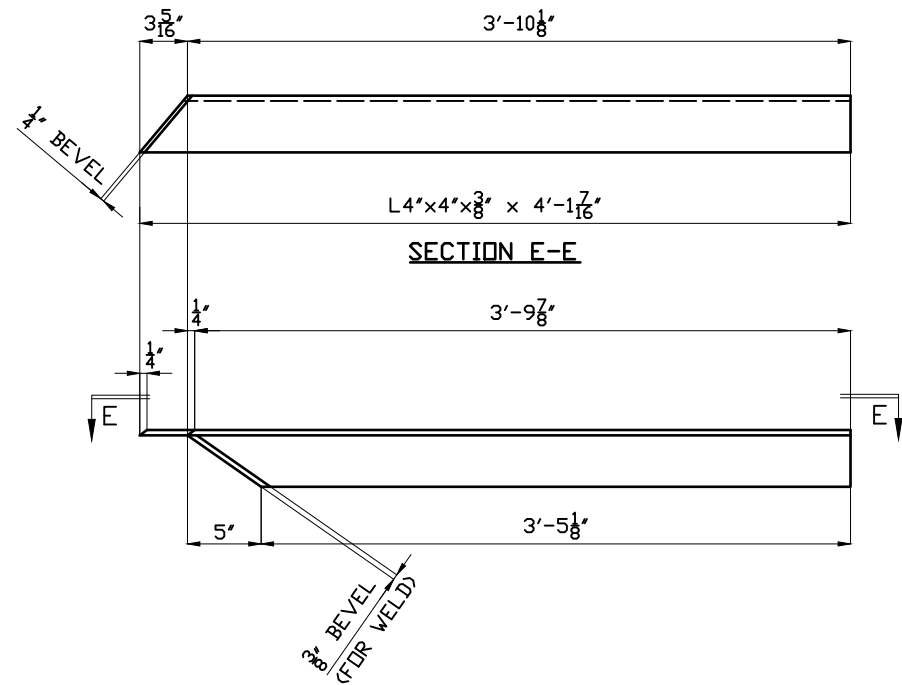

ONE ~FWD ABUT DIAG.~ 4D3
BAY 2

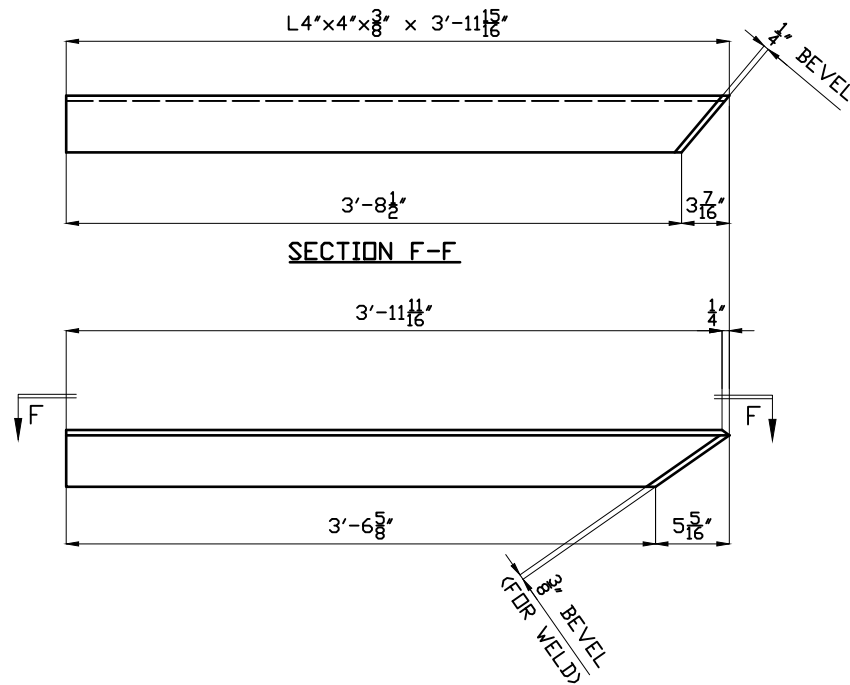

ONE ~FWD ABUT DIAG.~ 4D4
BAY 2



BILL OF MATERIAL						
PHASE 1	PHASE 2	ASS'Y MARK	NO. REQ'D	DESCRIPTION	WEIGHT	NOTES
		4S1	1	L4"x4"x3/8" x 7'-11 13/16"		PAINT
		4S2	1	L4"x4"x3/8" x 7'-1 7/8"		PAINT
		4D1	1	L4"x4"x3/8" x 4'-2 3/16"		PAINT
		4D2	1	L4"x4"x3/8" x 3'-11 1/4"		
		4D3	1	L4"x4"x3/8" x 4'-1 7/16"		
		4D4	1	L4"x4"x3/8" x 3'-11 5/16"		

WORK THIS DWG. WITH DWG. 4AB
FOR SHOP NOTES SEE DWG. GN1AB/B
ALL STEEL SHALL BE ASTM A709 GR 50W

GENERAL CONTRACTOR: KOKOSING D&B

TOTAL WEIGHT			
NOTES: ____ DIA. HOLES UNLESS NOTED ____ DIA. BOLTS UNLESS NOTED			
PAINT SPECS: CLEANING		PER GN1AB	
PRIMER		AS NOTED PER GN1AB	
INTERMEDIATE		N/A	
FINISH		N/A	
TO SHOP:			




SHANE FELTER INDUSTRIES

P.O. BOX 2022 • ROUTE 51 • UNIONTOWN PENNSYLVANIA 15401


FWD ABUTMENT CROSS FRAME DETAILS
BU-25 E 89TH ST PEDESTRIAN BRIDGE CUY-IR490/SR010-2.09/19.28
CITY OF CLEVELAND, CONSTRUCTION PROJECT #17-3000 PID #96833
FED. PROJ.# E140 (249) CUYAHOGA COUNTY, OHIO

REVISIONS	1	_____	DR.	CCD-MC	DATE	2/20
	2	_____	CH.	CCD-JB	DATE	2/20
	3	_____	APP.	_____	DATE	_____
	4	_____				


DWG. NO.	4B	CONT. NO.	19-782
----------	----	-----------	--------

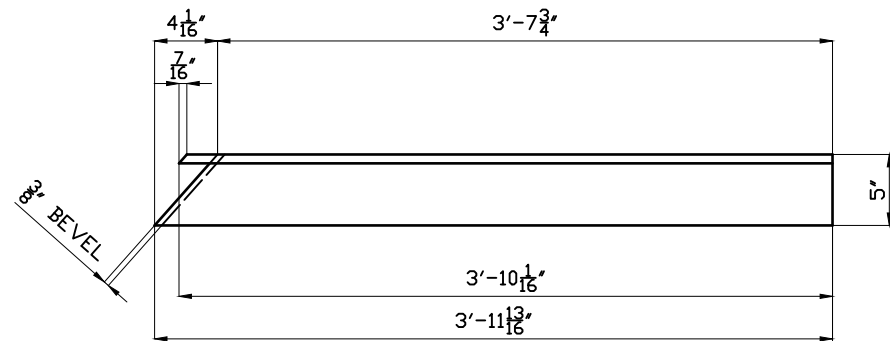


SECTION A-A

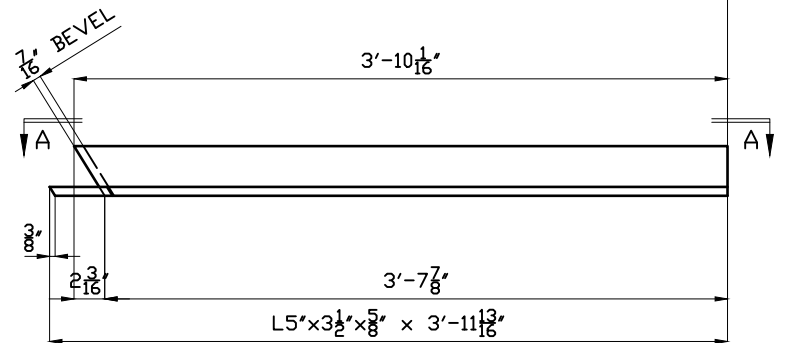


ONE ~PIER DIAG.~ 5D1
PIER 1, BAY 1

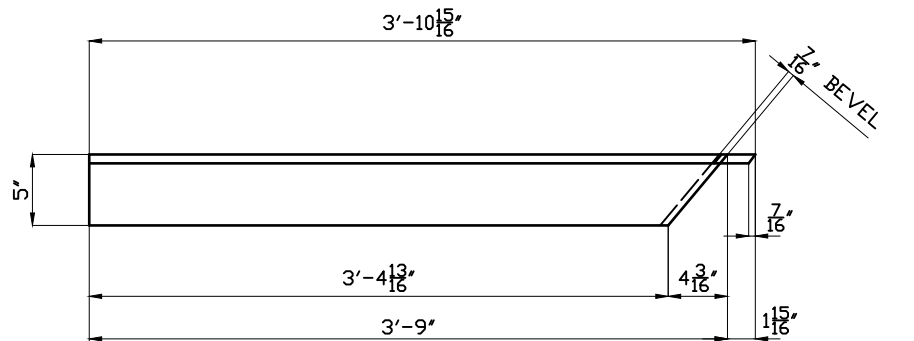


SECTION B-B

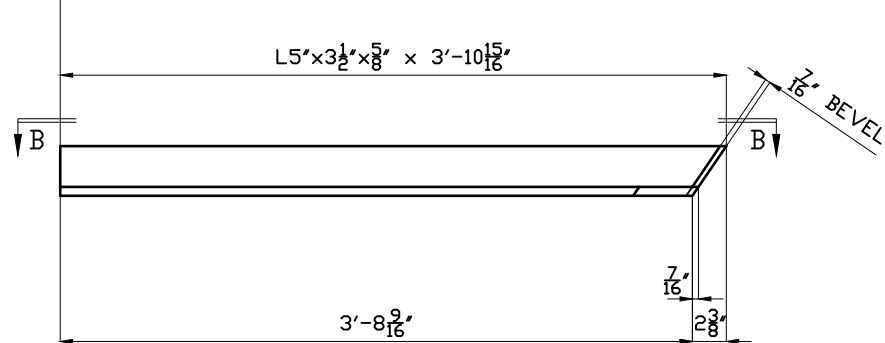


ONE ~PIER DIAG.~ 5D2
PIER 1, BAY 1

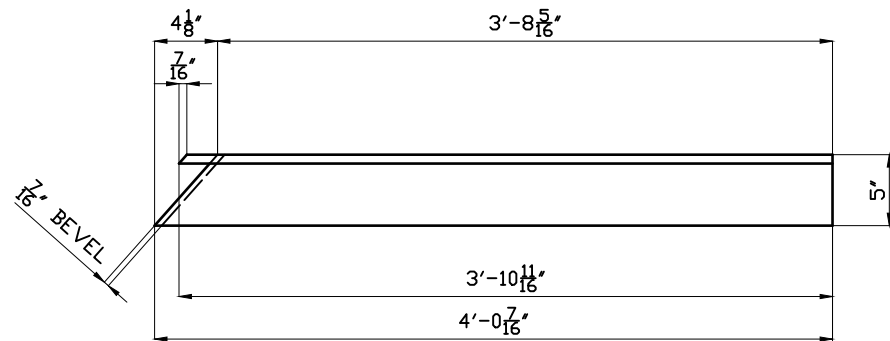


SECTION C-C

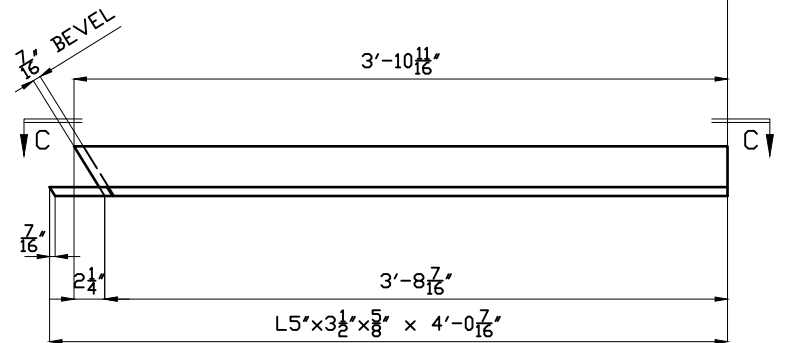

ONE ~PIER DIAG.~ 5D3
PIER 1, BAY 2

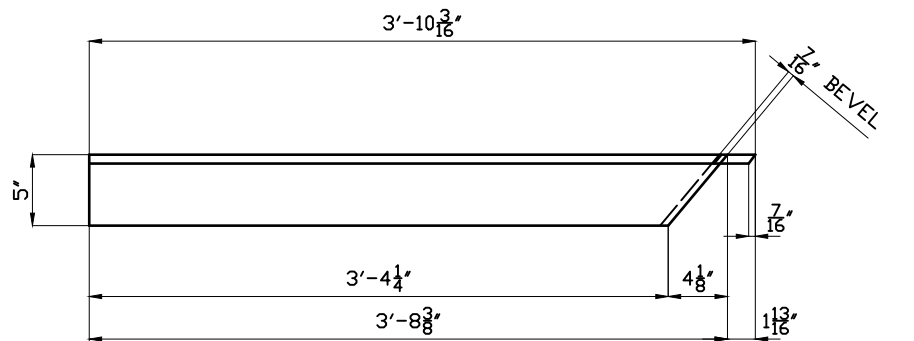


SECTION D-D


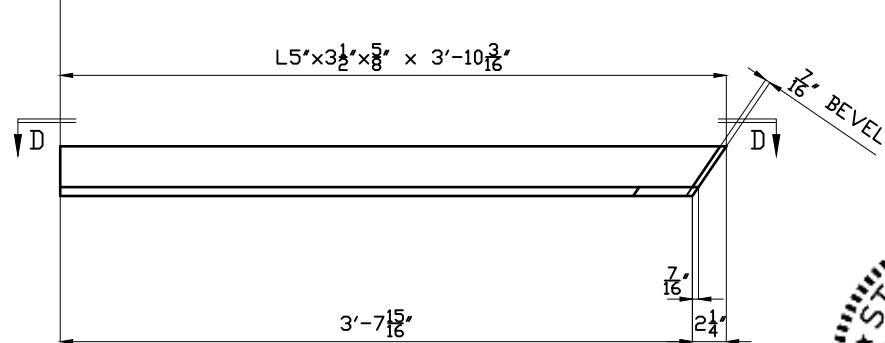


ONE ~PIER DIAG.~ 5D4
PIER 1, BAY 2



WORK THIS DWG. WITH DWG. 5B
FOR SHOP NOTES SEE DWG. GN1AB/B
ALL STEEL SHALL BE ASTM A709 GR 50W

GENERAL CONTRACTOR: KOKOSING D&B	
TOTAL WEIGHT	
NOTES: ____ DIA. HOLES UNLESS NOTED ____ DIA. BOLTS UNLESS NOTED	
PAIN T SPECS: CLEANING	PER GN1AB
PRIMER	N/A
INTERMEDIATE	N/A
FINISH	N/A
TO SHOP:	
 SHANE FELTER INDUSTRIES <small>P.O. BOX 2022 • ROUTE 51 • UNIONTOWN PENNSYLVANIA 15401</small>	
PIER 1 CROSS FRAME DETAILS BU-25 E 89TH ST PEDESTRIAN BRIDGE CUY-IR490/SR010-2.09/19.28 CITY OF CLEVELAND, CONSTRUCTION PROJECT #17-3000 PID #96833 FED. PROJ.# E140 (249) CUYAHOGA COUNTY, OHIO	
REVISIONS	DR. CCD-MC DATE 2/20
1	CH. CCD-JB DATE 2/20
2	APP. _____ DATE _____
3	
4	
DWG. NO. 5AB	CONT. NO. 19-782

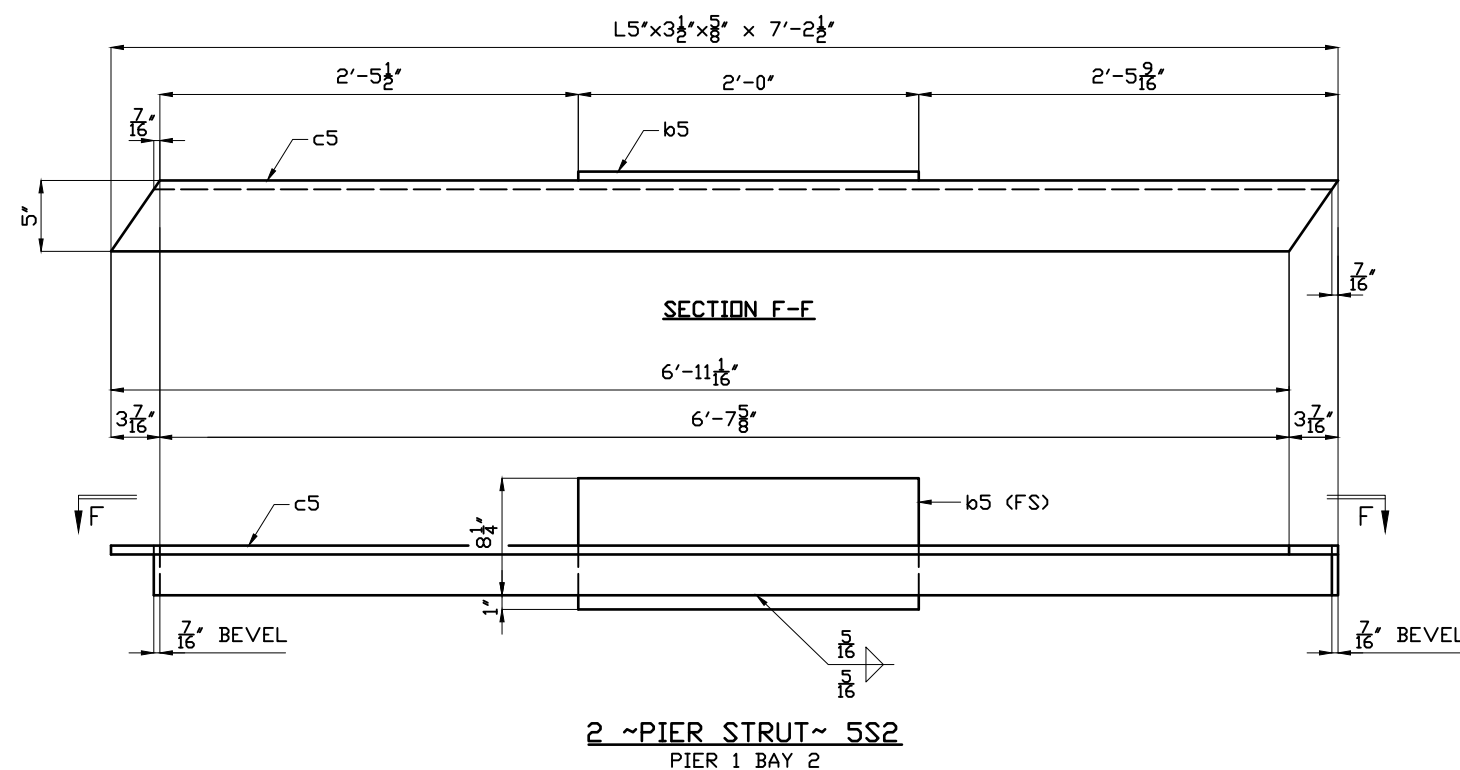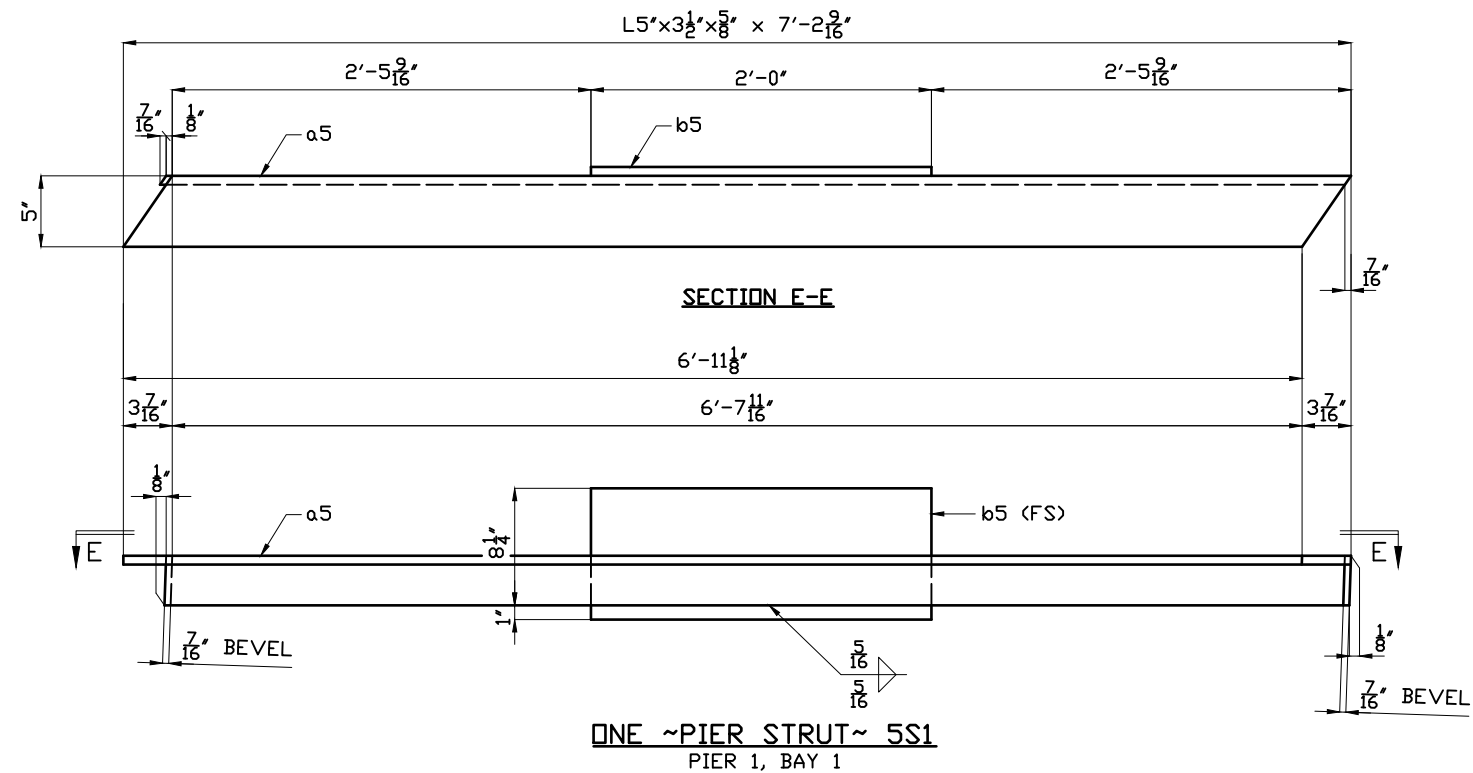[illegible]

WORK THIS DWG. WITH DWG. 5AB
FOR SHOP NOTES SEE DWG. GN1AB/B
ALL STEEL SHALL BE ASTM A709 GR 50W

GENERAL CONTRACTOR: KOKOSING D&B

GENERAL CONTRACTOR/ERECTING D&B		TOTAL WEIGHT		TO SHOP:	
NOTES: ___ DIA. HOLE UNLESS NOTED ___ DIA. BOLTS UNLESS NOTED					
PAINT SPECS: CLEANING		PER GNIAB			
PRIMER		N/A			
INTERMEDIATE		N/A			
FINISH		N/A			
TO SHOP:					
 <div style="display: inline-block; vertical-align: middle; margin-left: 20px;"> <h1 style="margin: 0;">SHANE FELTER INDUSTRIES</h1> <p style="margin: 5px 0 0 0;">P.O. BOX 2022 • ROUTE 51 • UNIONTOWN PENNSYLVANIA 15406</p> </div>					
PIER 1 CROSS FRAME DETAILS					
BU-25 E 89TH ST PEDESTRIAN BRIDGE CUY-IR490/SR010-2.09/19.28					
CITY OF CLEVELAND, CONSTRUCTION PROJECT #17-3000 PID #96833					
FED. PROJ.# E140 (249)			CUYAHOGA COUNTY, OHIO		
REVISIONS	<div style="border-bottom: 1px solid black; margin-bottom: 5px;">1 _____</div> <div style="border-bottom: 1px solid black; margin-bottom: 5px;">2 _____</div> <div style="border-bottom: 1px solid black; margin-bottom: 5px;">3 _____</div> <div style="border-bottom: 1px solid black; margin-bottom: 5px;">4 _____</div>	DR. <u>CCD-MC</u> DATE <u>2/20</u> CH. <u>CCD-JB</u> DATE <u>2/20</u> APP. _____ DATE _____			
DWG. NO. 5B		CONT. NO. 19-782			







SHANE FELTER
INDUSTRIES


P.O. BOX 2022 • ROUTE 51 • UNIONTOWN PENNSYLVANIA 15401


PIER 1 CROSS FRAME DETAILS	
BU-25 E 89TH ST PEDESTRIAN BRIDGE CUY-IR490/SR010-2.09/19.28	
CITY OF CLEVELAND, CONSTRUCTION PROJECT #17-3000 PID #96833	
FED. PROJ.# E140 (249)	CUYAHOGA COUNTY, OHIO

REVISIONS 1 _____ 2 _____ 3 _____ 4 _____	DR. <u>CCD-MC</u> DATE <u>2/20</u>
	CH. <u>CCD-JB</u> DATE <u>2/20</u>
	APP. _____ DATE _____

DWG. NO. 5B	CONT. NO. 19-782
-------------	------------------

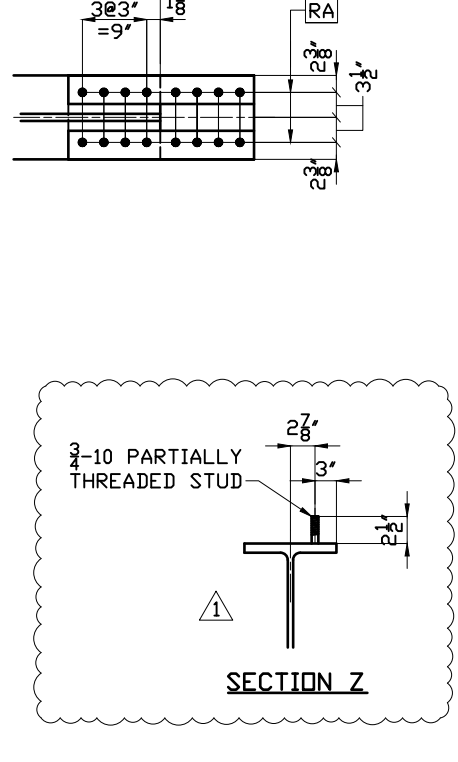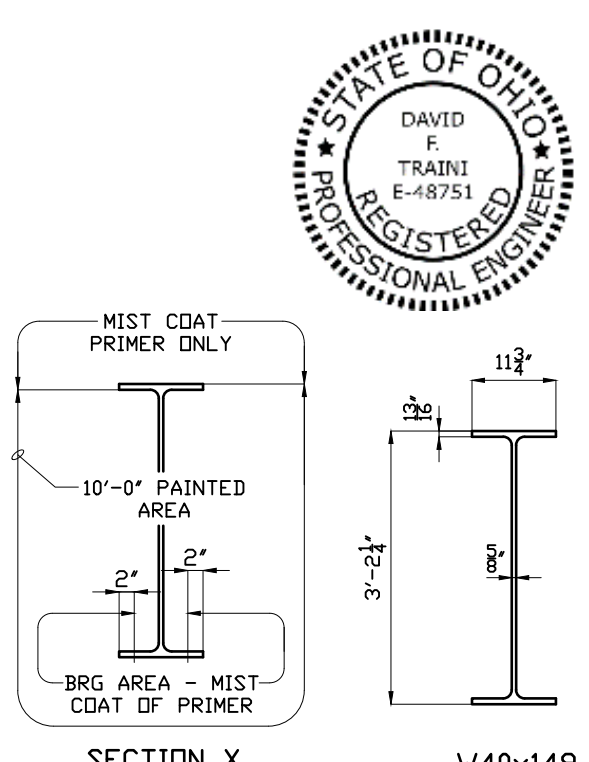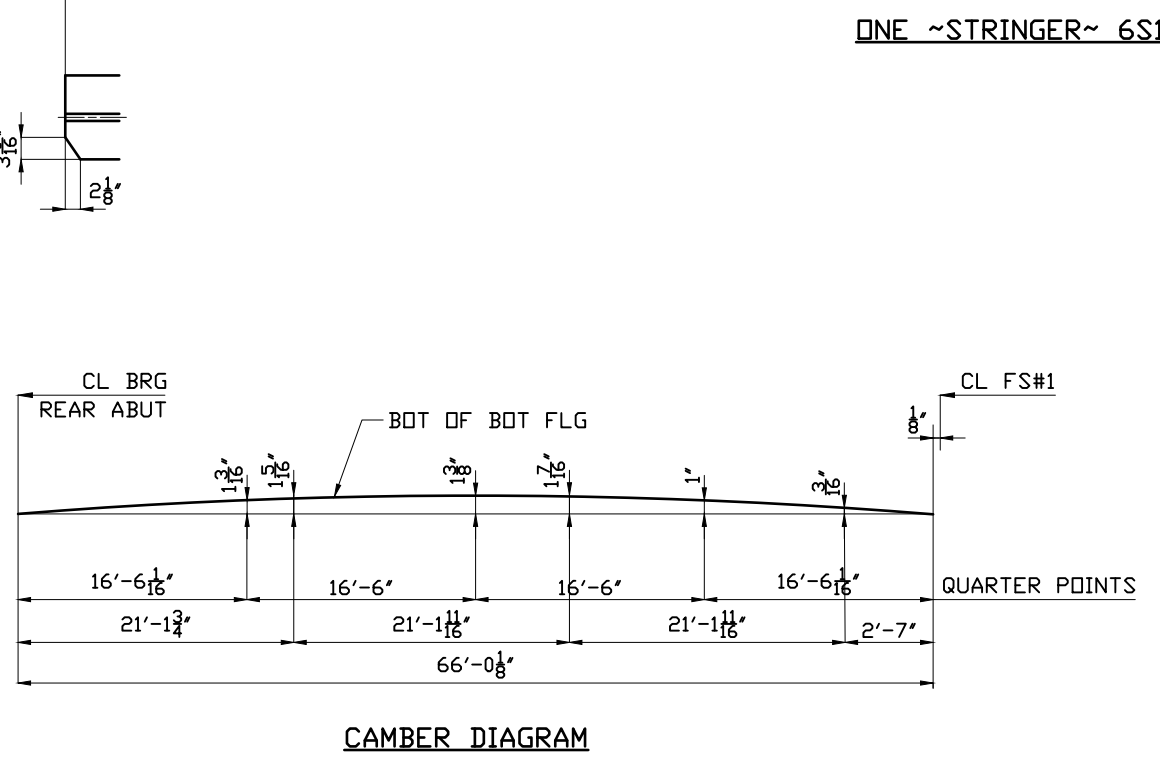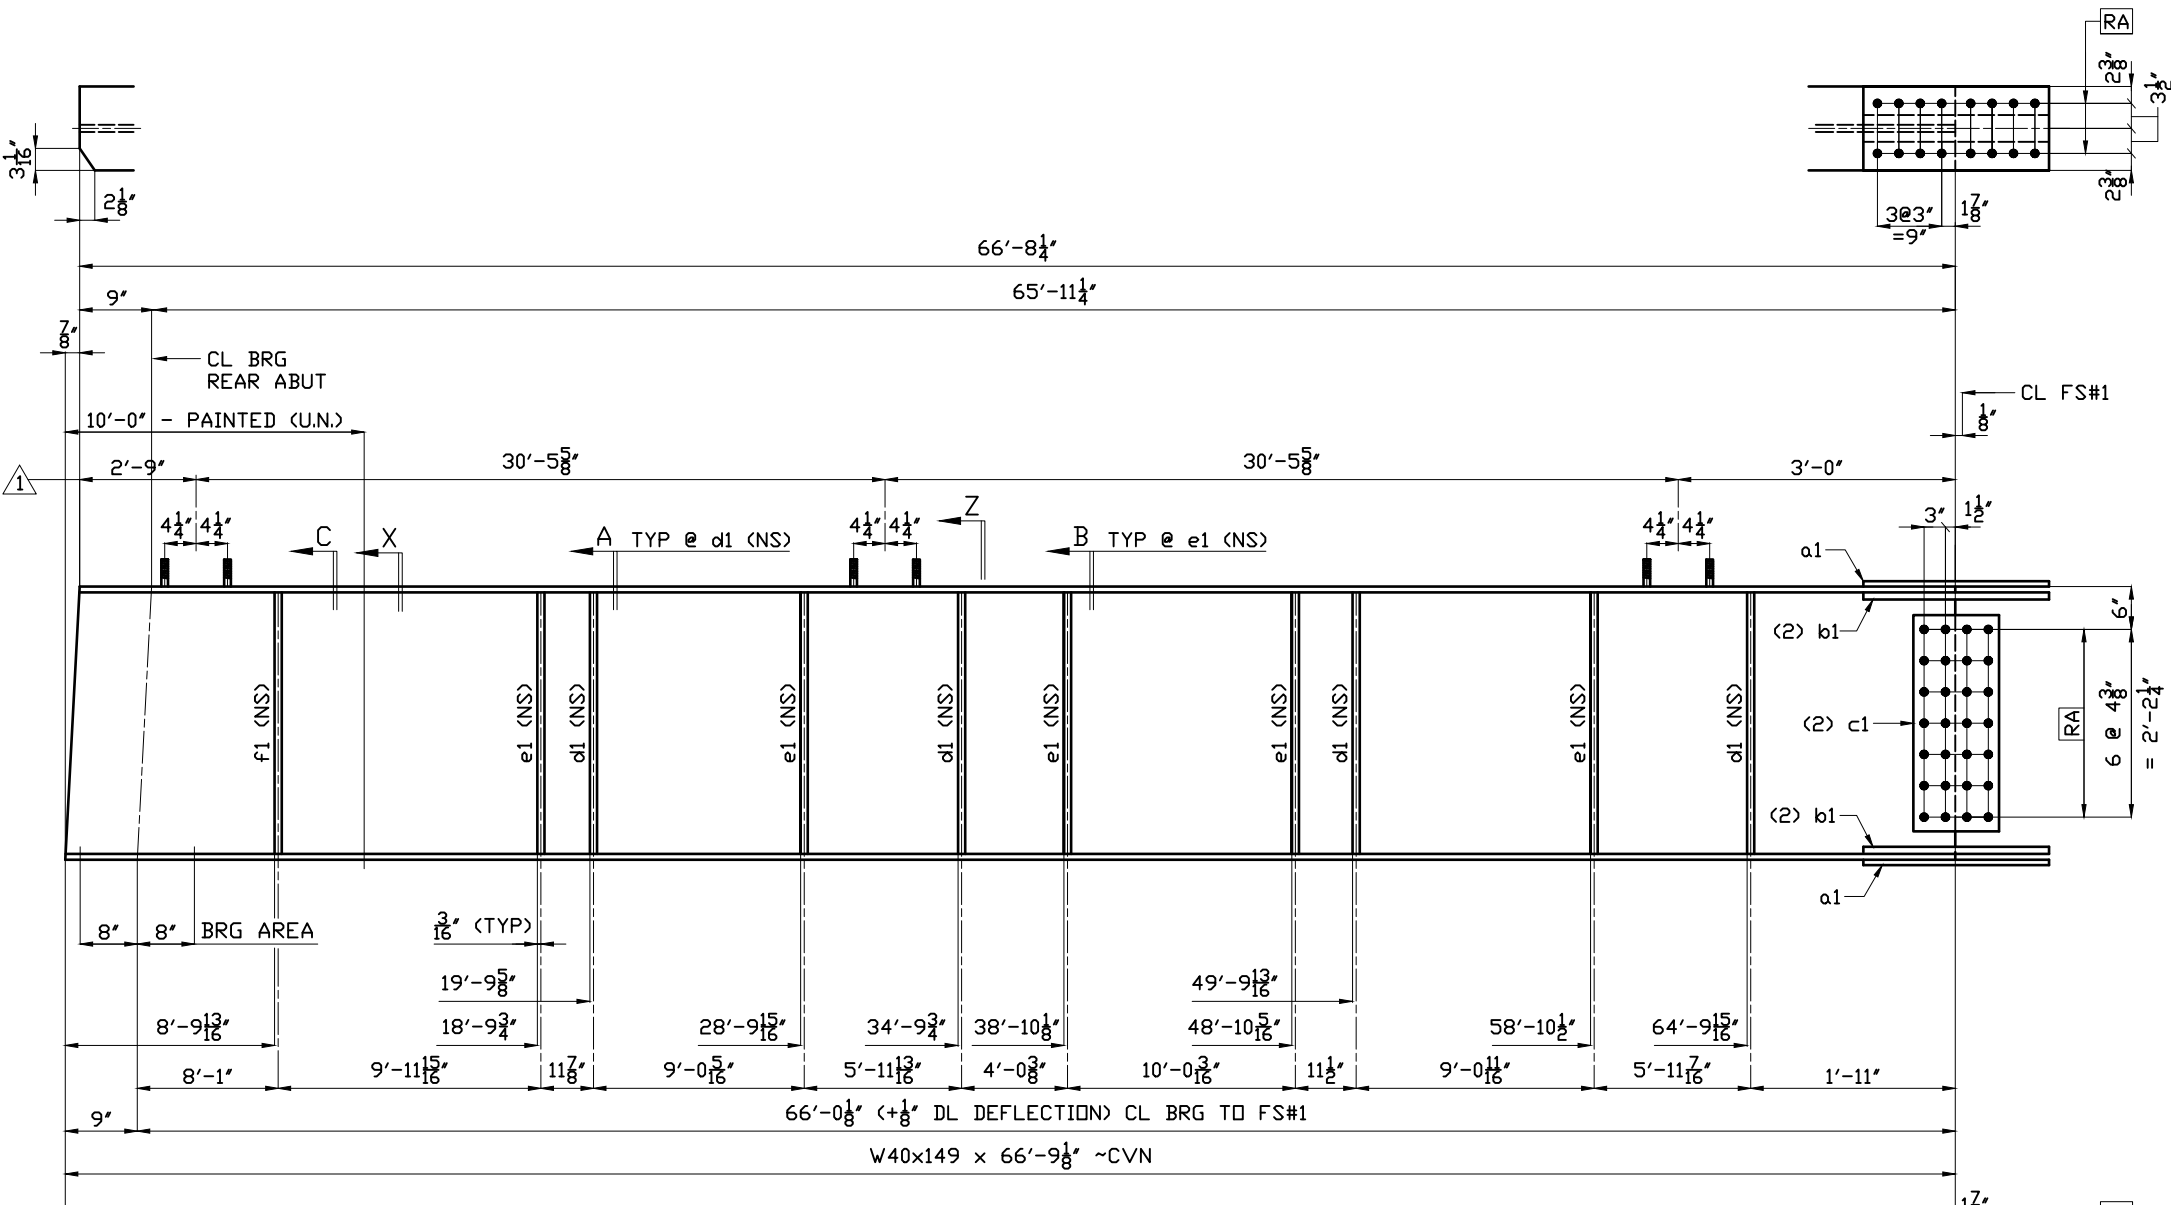

BILL OF MATERIAL							
PHASE 1	PHASE 2	ASS'Y MARK	NO. REQ'D	DESCRIPTION		WEIGHT	NOTES
		6S1	1	STRINGER			PAINT
		a1	2	W40x149 x 66'-9 $\frac{1}{8}$ " CVN			
		b1	4	PL $\frac{3}{4}$ " x 11 $\frac{1}{2}$ " x 2'-2 CVN			
		c1	4	PL 1" x 4" x 2'-2" CVN			
		d1	2	PL $\frac{1}{2}$ " x 30 $\frac{1}{4}$ " x 1'-0 $\frac{1}{4}$ " CVN			
		e1	4	PL $\frac{3}{8}$ " x 5 $\frac{1}{2}$ " x 3'-0 $\frac{5}{8}$ "			
		f1	5	PL $\frac{3}{8}$ " x 5 $\frac{1}{2}$ " x 3'-0 $\frac{5}{8}$ "			
			1	PL $\frac{3}{8}$ " x 5 $\frac{1}{2}$ " x 3'-0 $\frac{5}{8}$ "			
			6	STUD $\frac{3}{4}$ -10 x 2 $\frac{1}{2}$ " UNC NELSON #101017428			

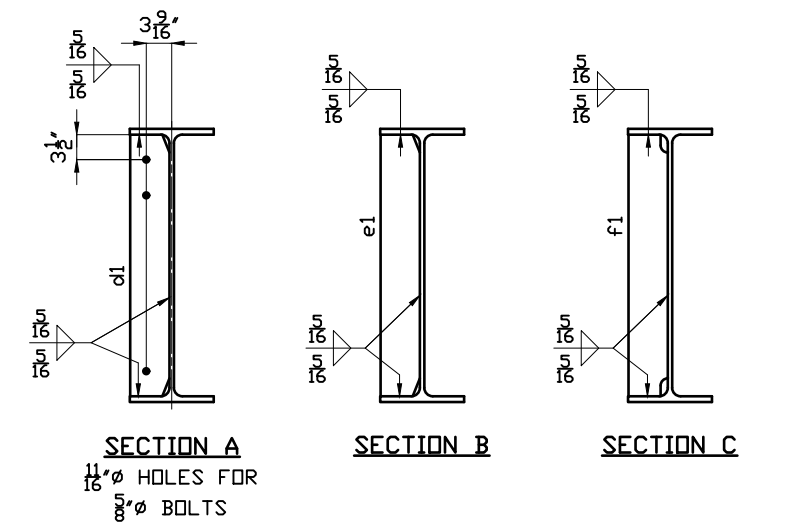

FOR SHOP NOTES SEE DWG. GN1AB/B.
ALL STEEL SHALL BE AASHTO M270 GR 50W

GENERAL CONTRACTOR: KOKOSING D&B

TOTAL WEIGHT		
--------------	--	--

NOTES: 1/16\"/>

PAINT SPECS: CLEANING	SEE GNIAB
PRIMER	SEE GNIAB
INTERMEDIATE FINISH	NONE
FINISH	NONE

TO SHOP:

SFI

SHANE FELTER INDUSTRIES





P.O. BOX 2022 • ROUTE 51 • UNIONTOWN PENNSYLVANIA 15401

DETAIL OF STRINGER 6S1
BU-25 E 89TH ST PEDESTRIAN BRIDGE CUY-IR490/SR010-2.09/19.28
CITY OF CLEVELAND, CONSTRUCTION PROJECT #17-3000 PID #96833
FED. PROJ.# E140 (249) CUYAHOGA COUNTY, OHIO


1	ADDED STUDS	6/18/20	DR. CCD-MC	DATE 2/20
2			CH. CCD-JB	DATE 2/20
3			APP.	DATE
4				

DWG. NO. 6

CONT. NO. 19-782

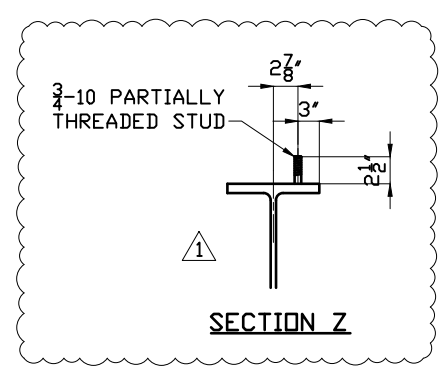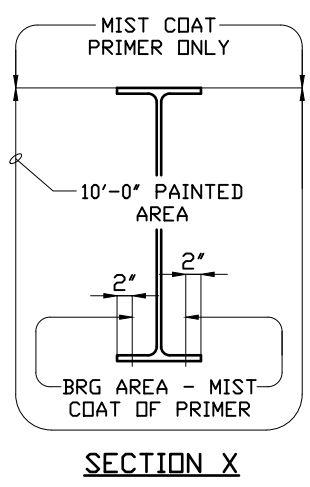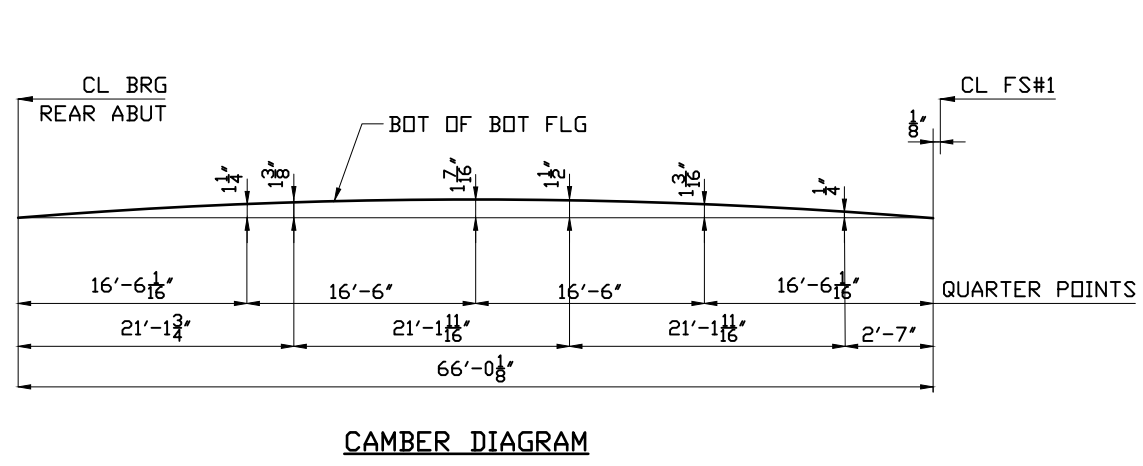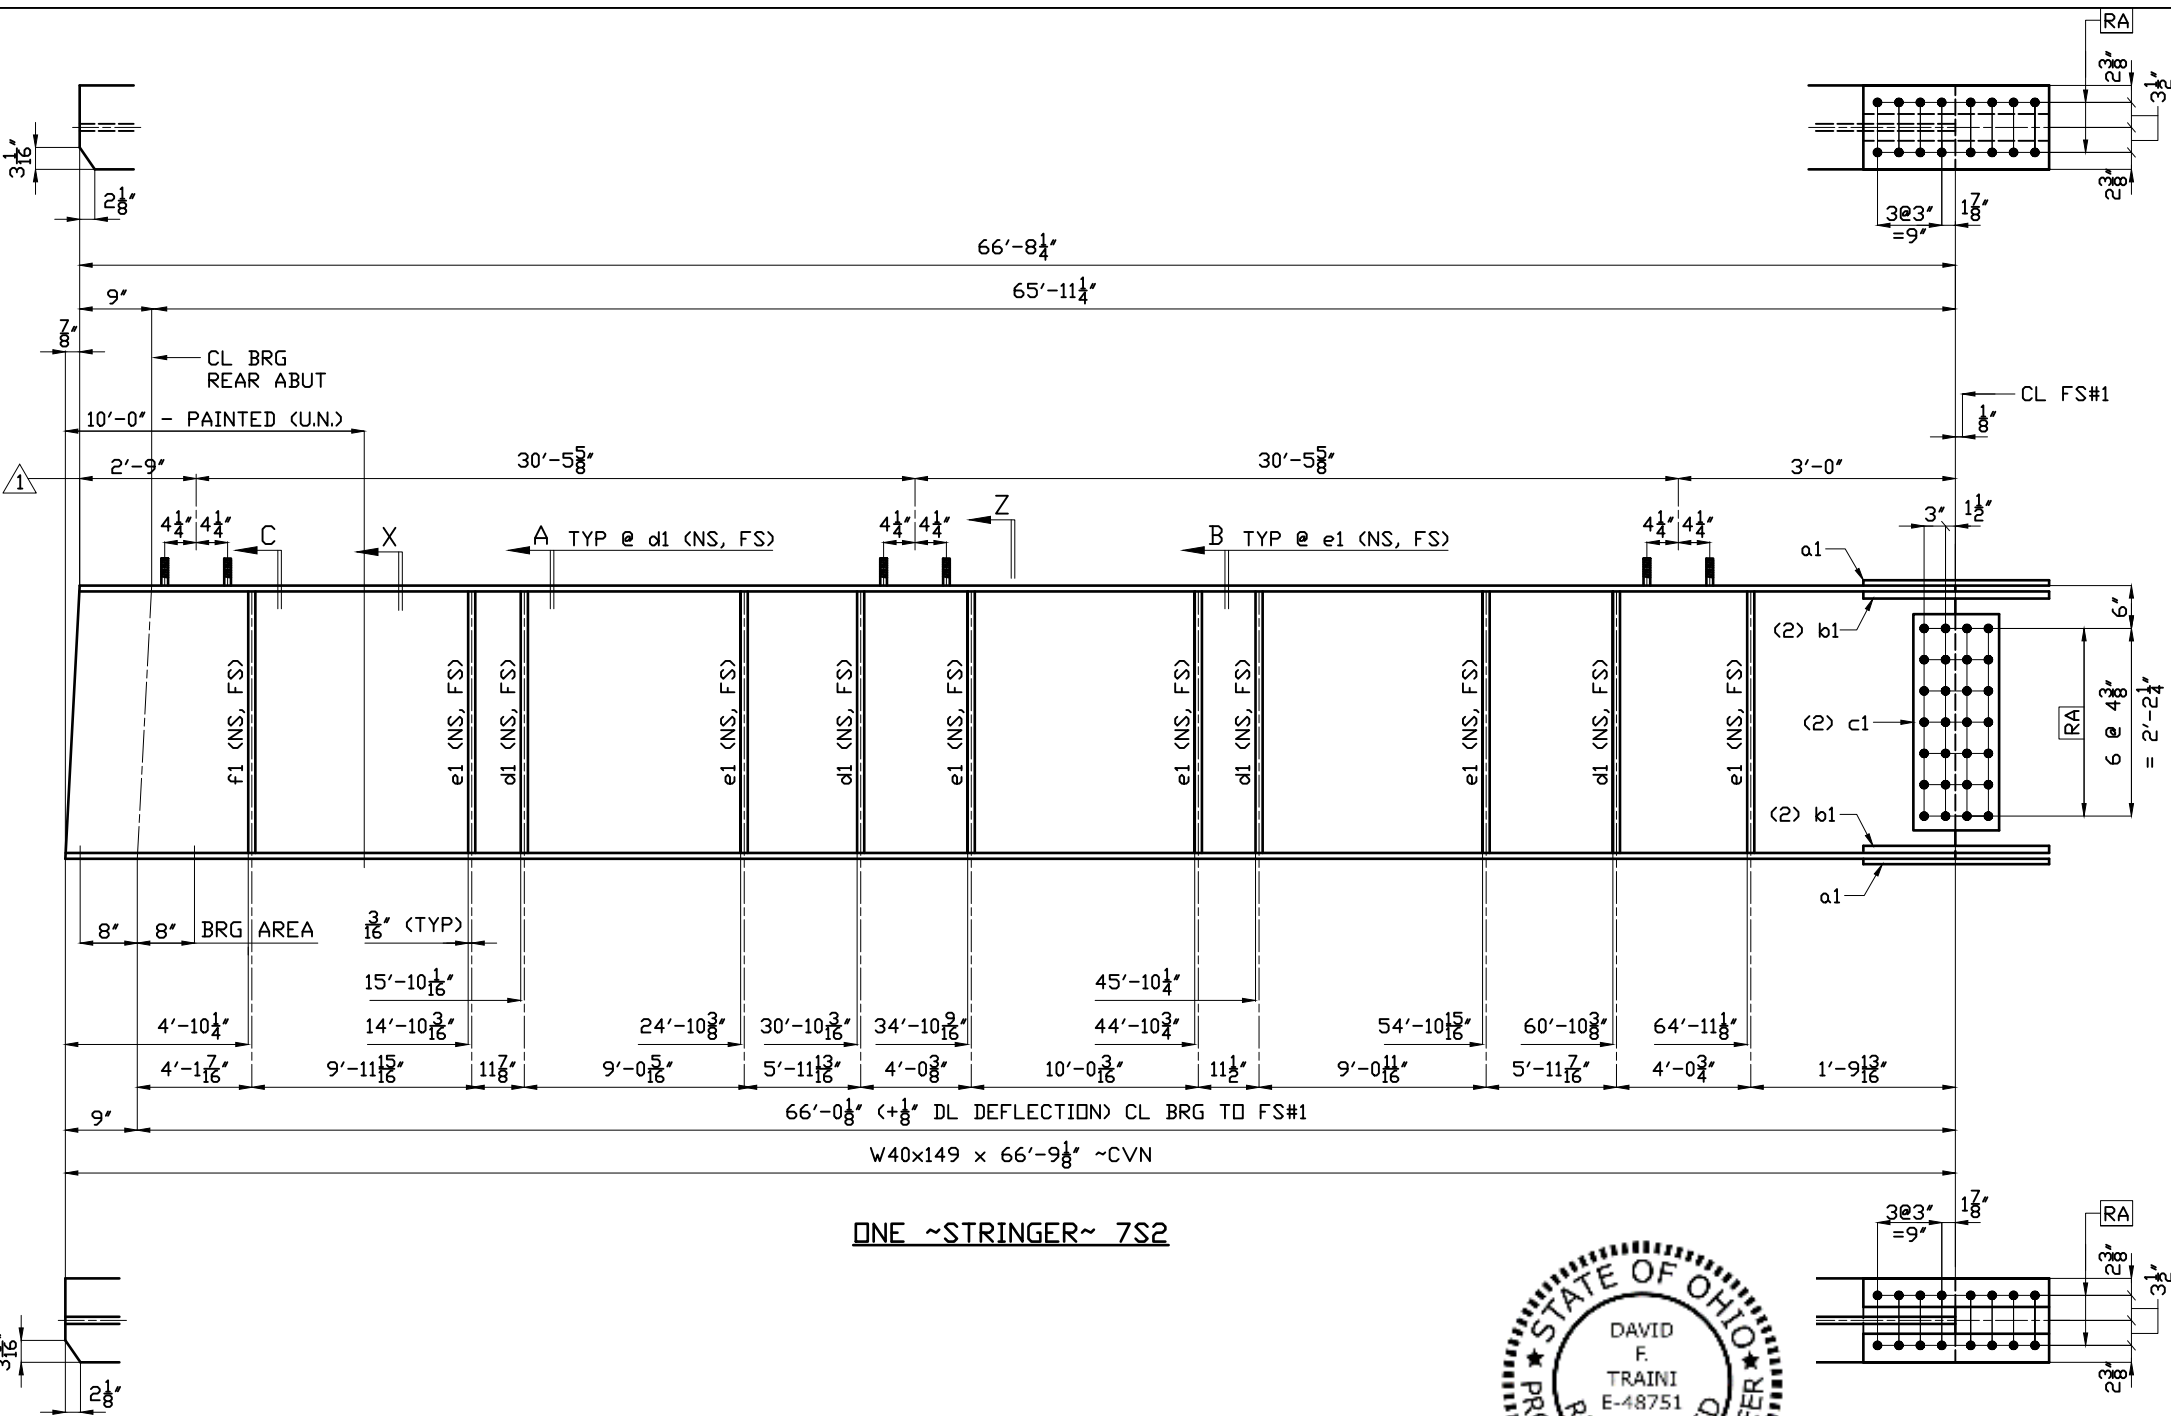

BILL OF MATERIAL						
PHASE 1	PHASE 2	ASS'Y MARK	NO. REQ'D	DESCRIPTION	WEIGHT	NOTES
		7S2	1	STRINGER		PAINT
		a1	2	W40x149 x 66'-9 1/8\"	CVN	
		b1	4	PL 3/4\"	CVN	
		c1	2	PL 1/2\"	CVN	
		d1	8	PL 3/8\"	CVN	
		e1	12	PL 3/8\"	CVN	
		f1	2	PL 3/8\"	CVN	
			6	STUD 3/4-10 x 2 1/2\"	UNC NELSON #101017428	

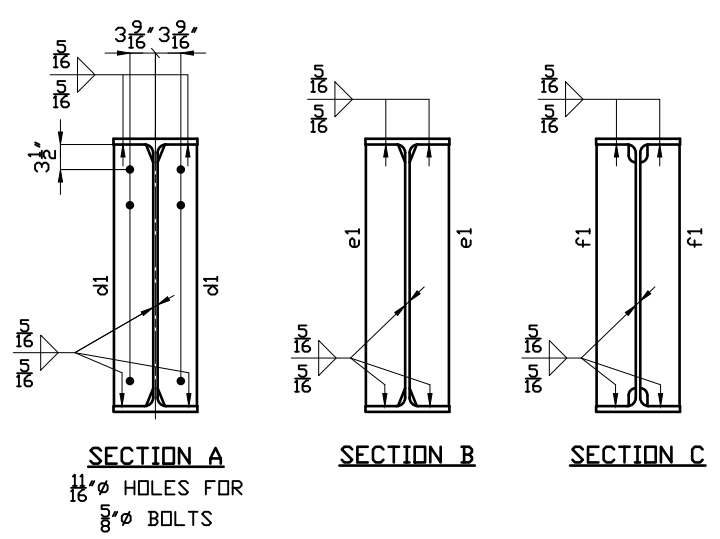

FOR SHOP NOTES SEE DWG. GN1AB/B
ALL STEEL SHALL BE AASHTO M270 GR 50W


GENERAL CONTRACTOR: KOKOSING D&B

TOTAL WEIGHT		
--------------	--	--

NOTES: 1 1/16\" DIA. HOLES UNLESS NOTED 1\" DIA. BOLTS UNLESS NOTED

PAIN	SPEC	CLEANING	SEE GNIAB
	PRIMER	SEE GNIAB	
	INTERMEDIATE	NONE	
	FINISH	NONE	





TO SHOP:

**SHANE FELTER INDUSTRIES**
P.O. BOX 2022 • ROUTE 51 • UNIONTOWN PENNSYLVANIA 15401


DETAIL OF STRINGER 7S2	
BU-25 E 89TH ST PEDESTRIAN BRIDGE CUY-IR490/SR010-2.09/19.28	
CITY OF CLEVELAND, CONSTRUCTION PROJECT #17-3000 PID #96833	
FED. PROJ.# E140 (249)	
CUYAHOGA COUNTY, OHIO	

REVISIONS	1 ADDED STUDS	6/18/20	DR. CCD-MC	DATE 2/20
2			CH. CCD-JB	DATE 2/20
3			APP.	DATE
4				

DWG. NO. 7	CONT. NO. 19-782
------------	------------------

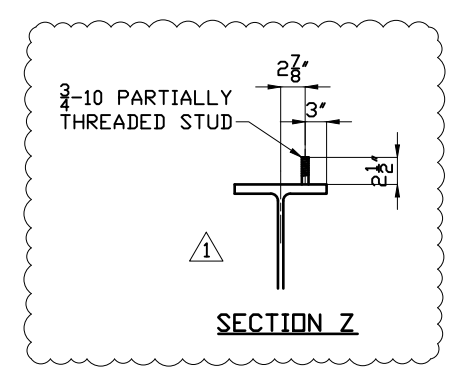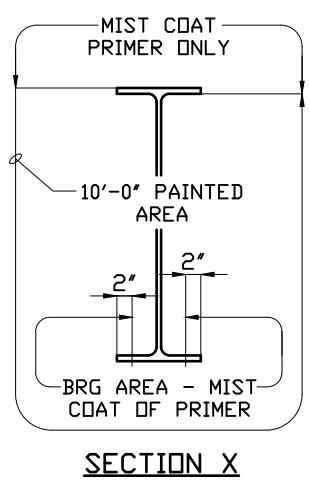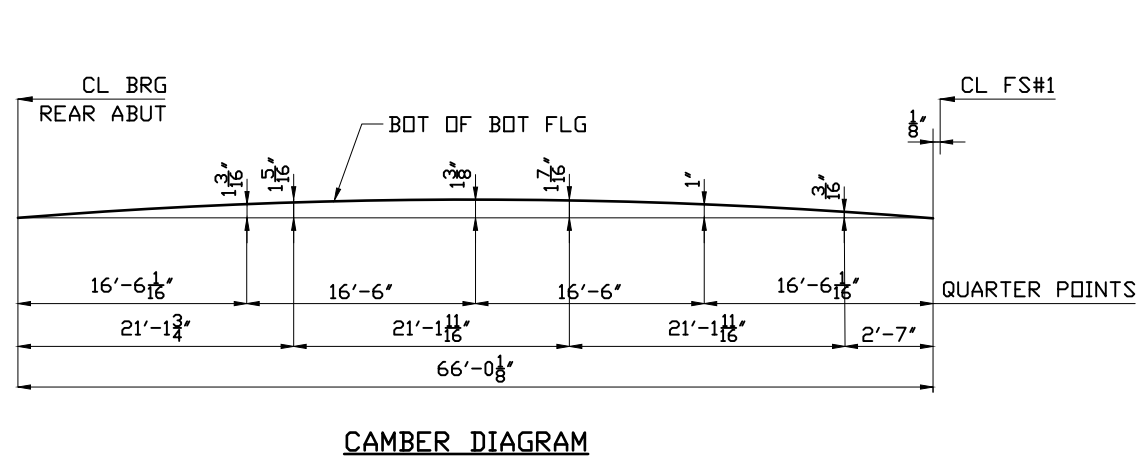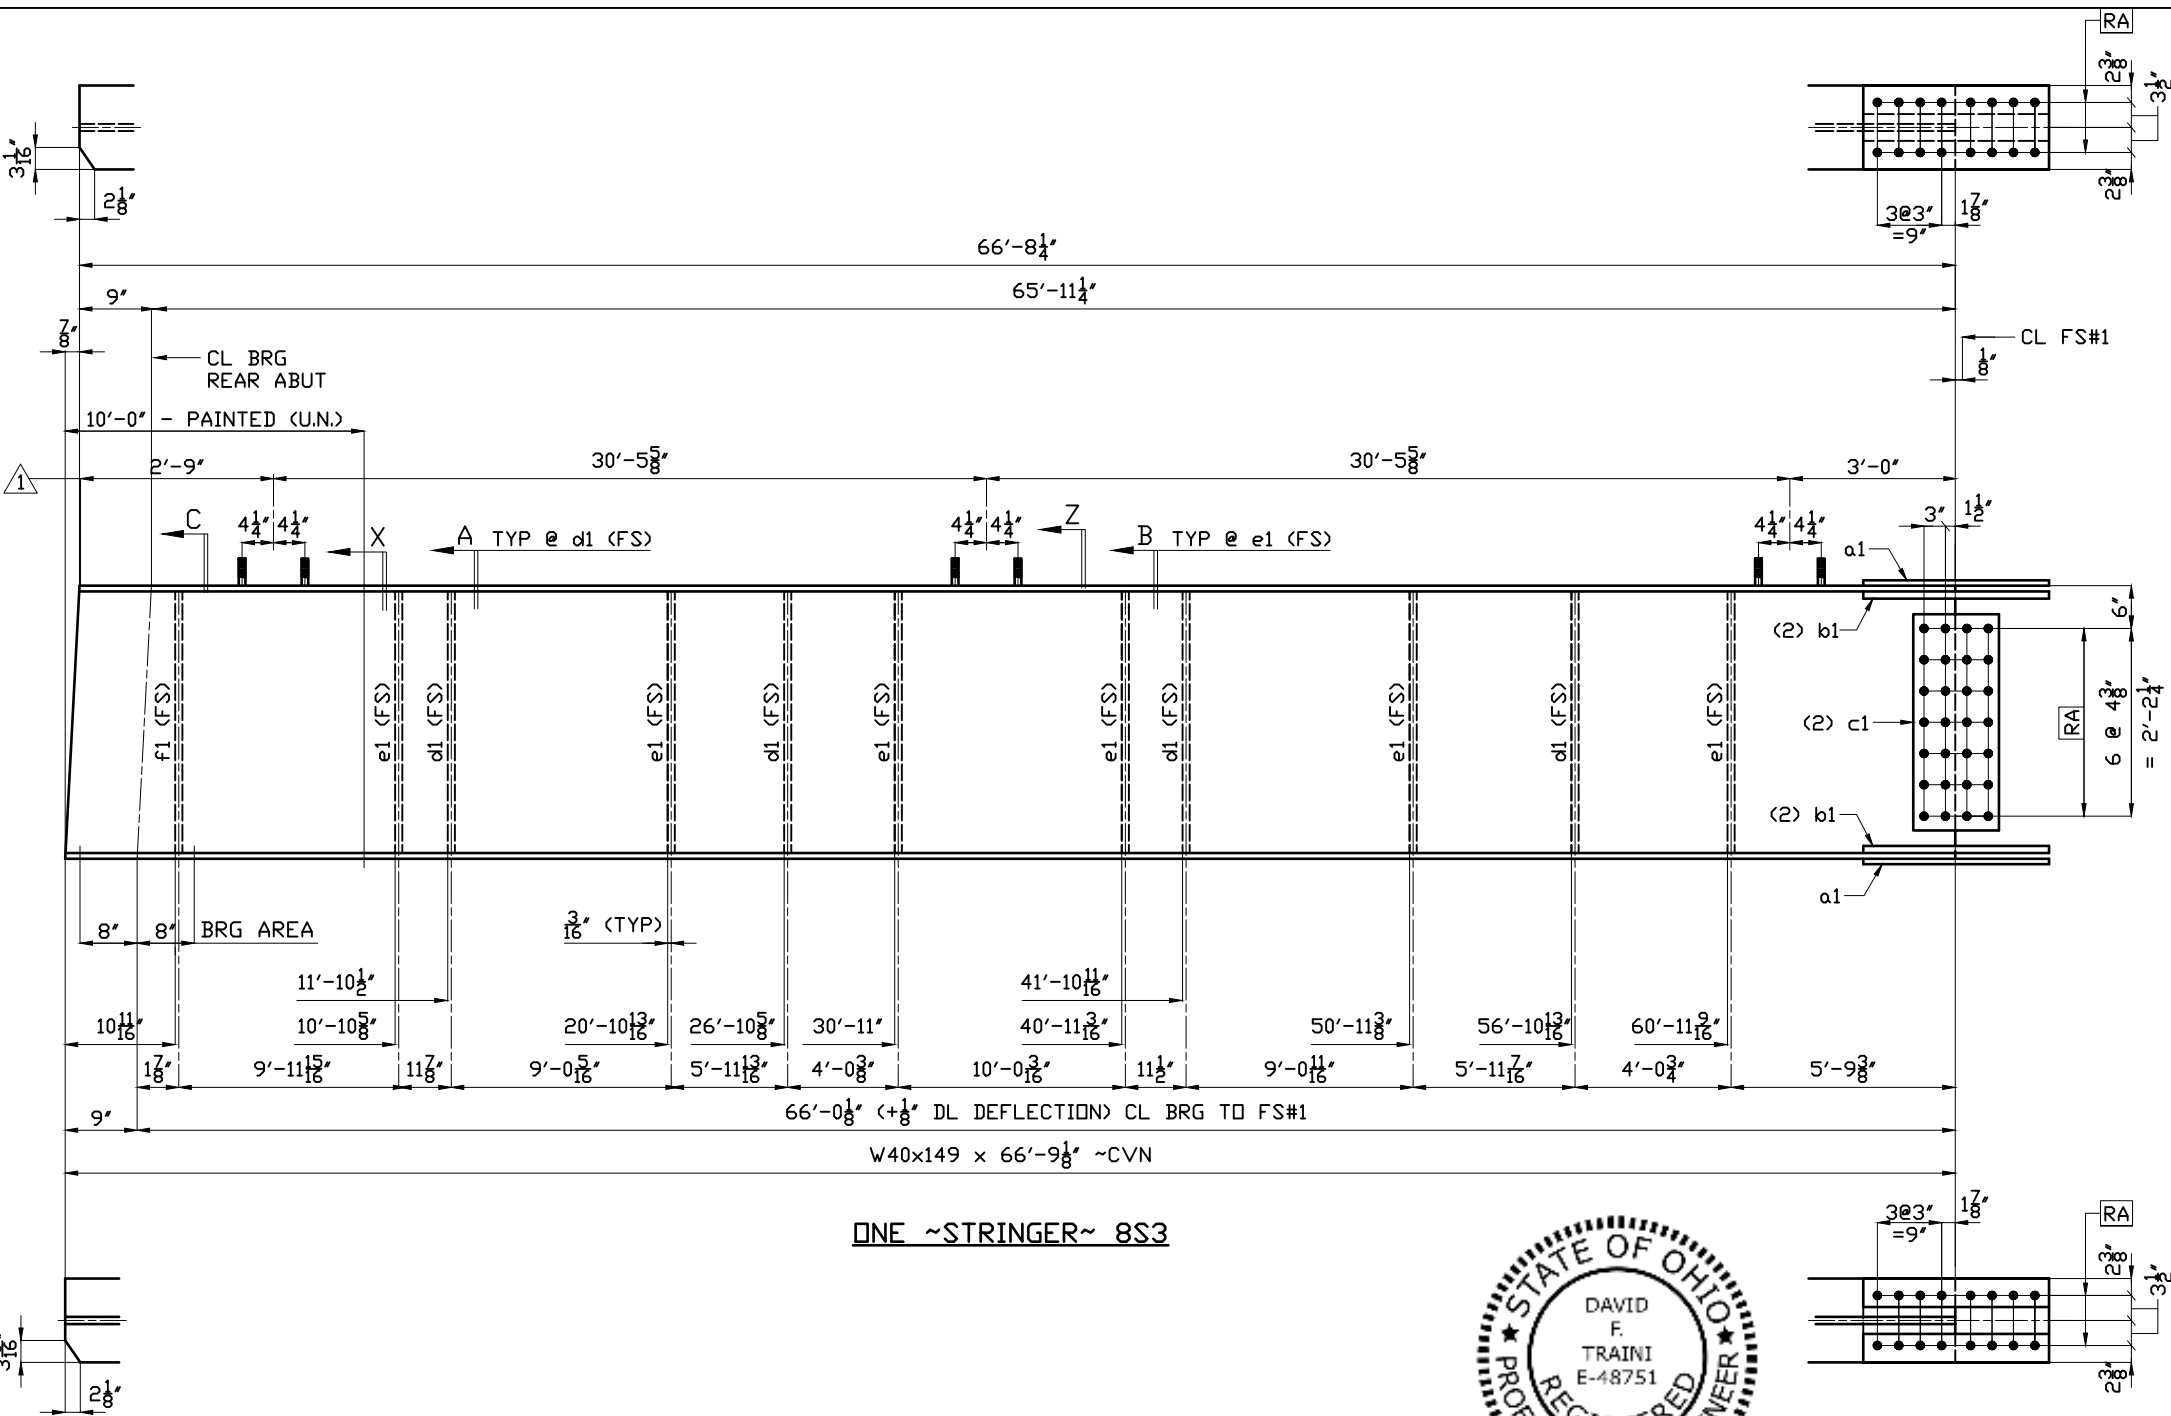

BILL OF MATERIAL						
PHASE 1	PHASE 2	ASS'Y MARK	NO. REQ'D	DESCRIPTION	WEIGHT	NOTES
		8S3	1	STRINGER		PAINT
		a1	2	W40x149 x 66'-9 1/8\"	CVN	
		b1	4	PL 3/4\"	CVN	
		c1	2	PL 1/2\"	CVN	
		d1	4	PL 3/8\"	CVN	
		e1	6	PL 3/8\"	CVN	
		f1	1	PL 3/8\"	CVN	
			6	STUD 3/4-10 x 2 1/2\" UNC NELSON #101017428		

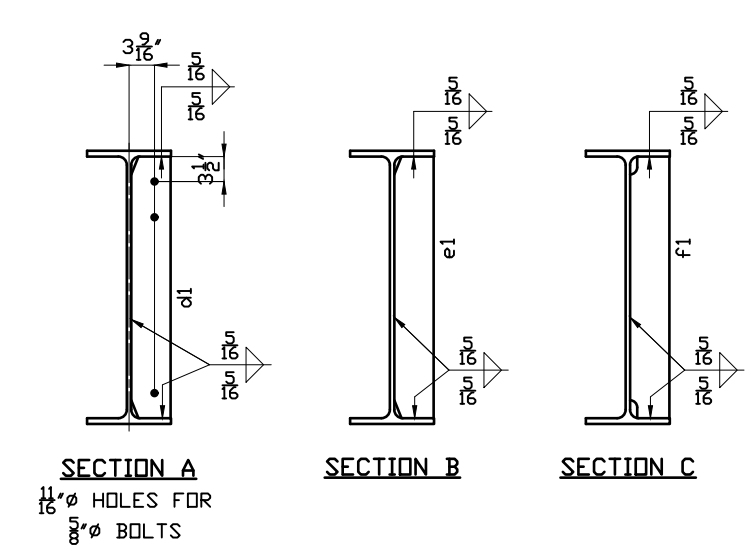

FOR SHOP NOTES SEE DWG. GN1AB/B

ALL STEEL SHALL BE AASHTO M270 GR 50W

GENERAL CONTRACTOR: KOKOSING D&B

TOTAL WEIGHT

NOTES: 1 1/16\"/>

PAINT SPECS: CLEANING SEE GNIAB
PRIMER SEE GNIAB
INTERMEDIATE NONE
FINISH NONE

TO SHOP:

SHANE FELTER INDUSTRIES

P.O. BOX 2022 • ROUTE 51 • UNIONTOWN PENNSYLVANIA 15401

DETAIL OF STRINGER 8S3

BU-25 E 89TH ST PEDESTRIAN BRIDGE CUY-IR490/SR010-2.09/19.28

CITY OF CLEVELAND, CONSTRUCTION PROJECT #17-3000 PID #96833

FED. PROJ.# E140 (249) CUYAHOGA COUNTY, OHIO

REVISIONS

1 ADDED STUDS 6/18/20

2

3

4


DR. CCD-MC DATE 2/20

CH. CCD-JB DATE 2/20

APP. DATE

DWG. NO. 8

CONT. NO. 19-782

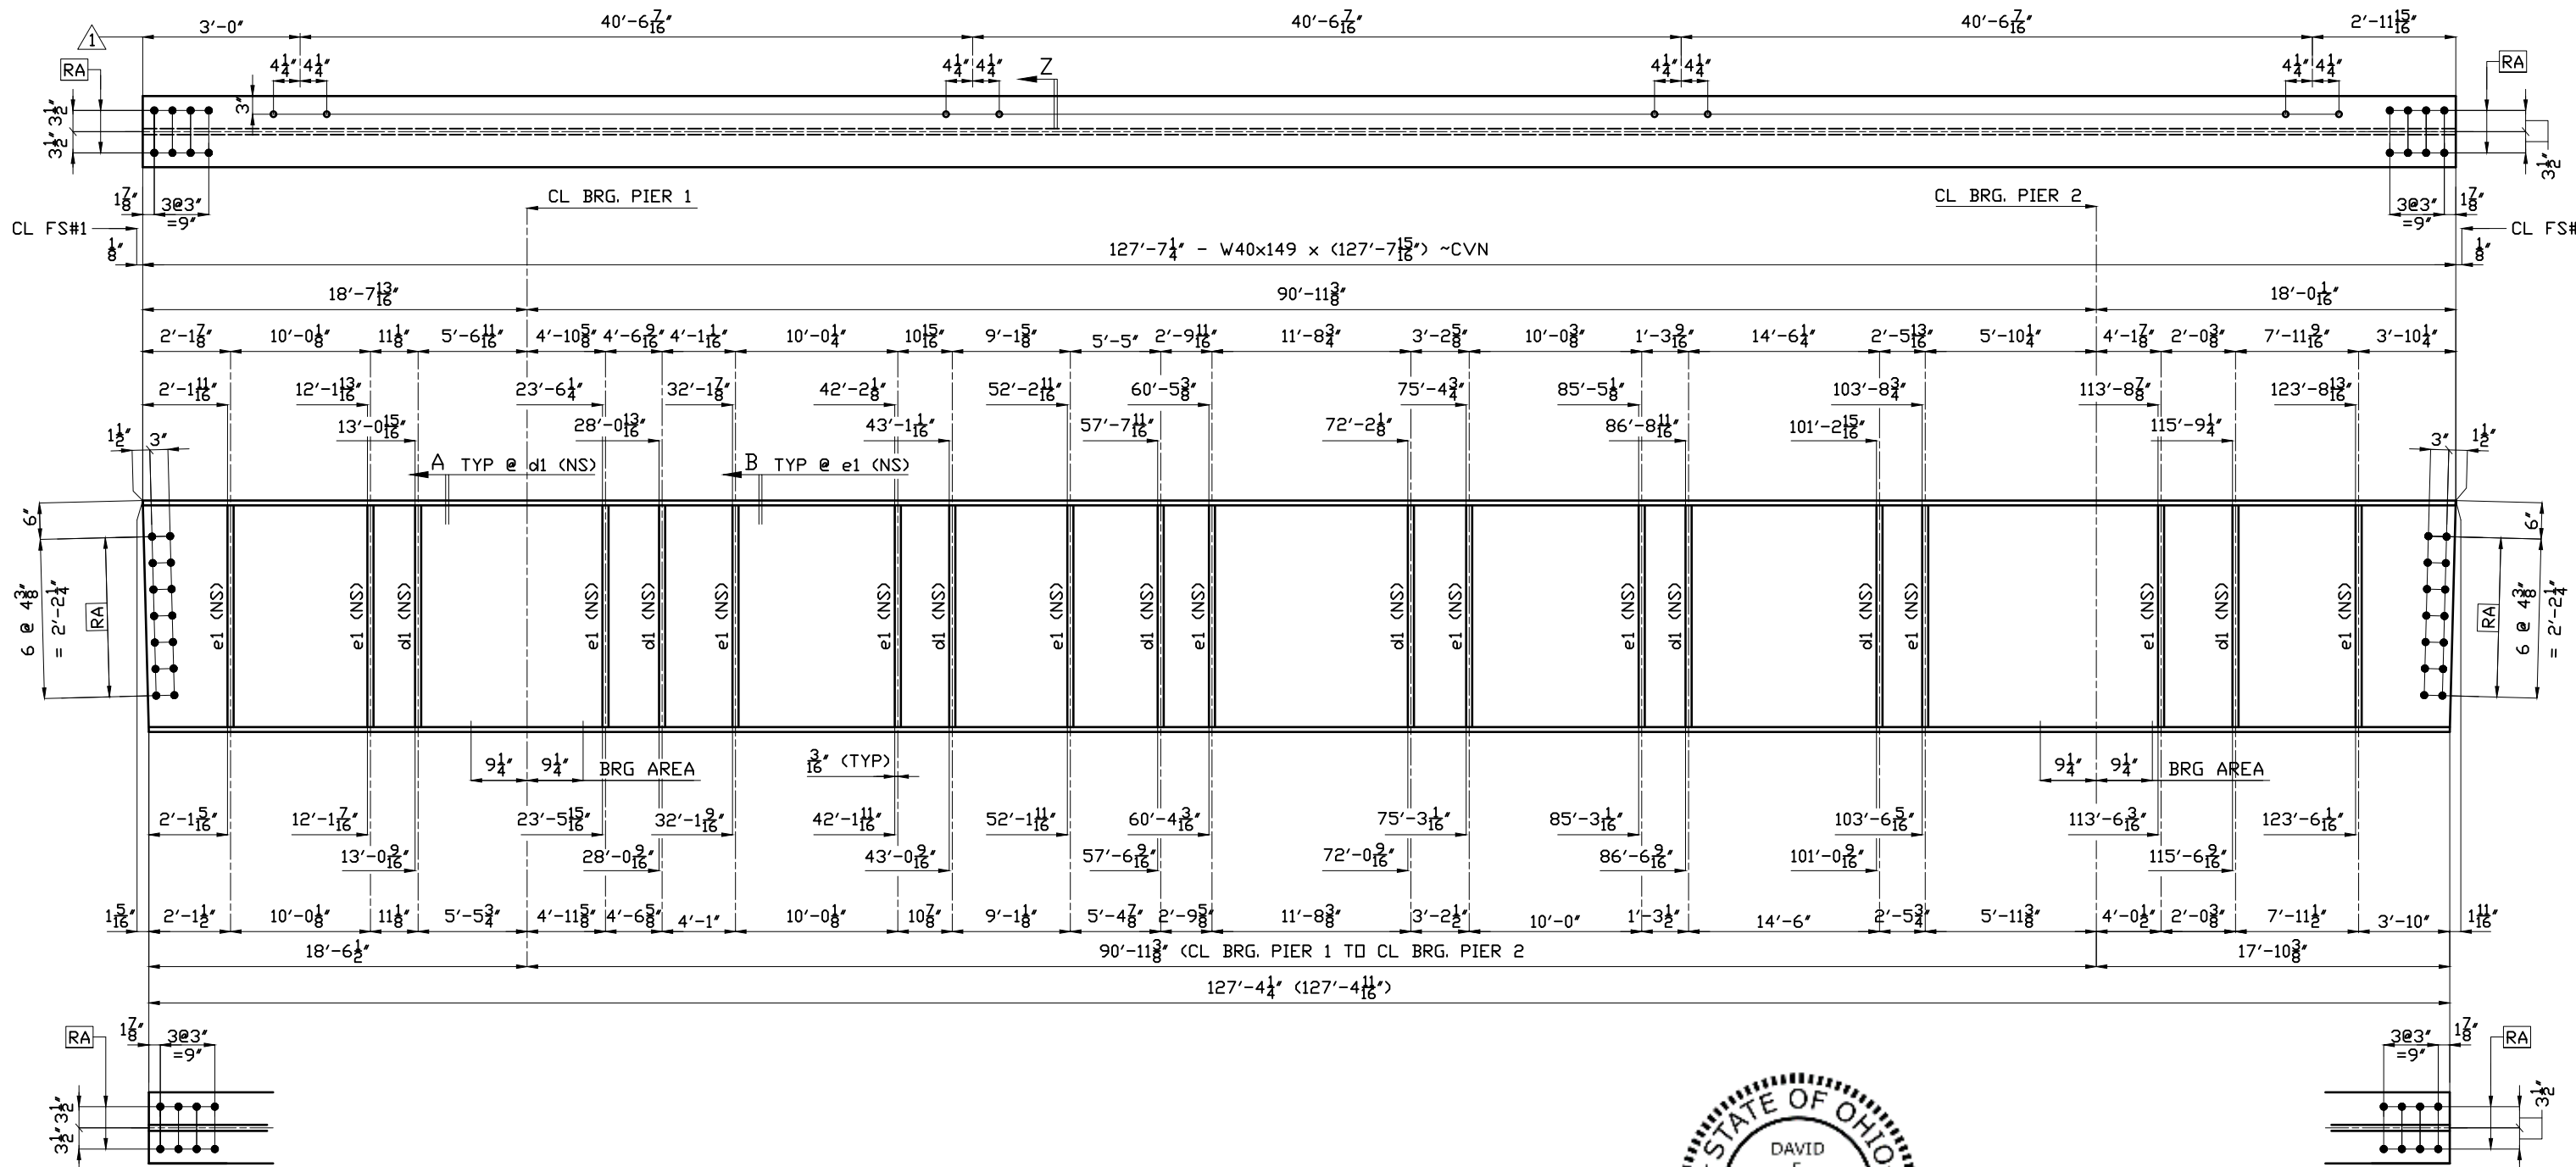

ONE ~STRINGER~ 9S1


WORK THIS DWG. WITH DWG. 9B

FOR SHOP NOTES SEE DWG. GN1AB/B

ALL STEEL SHALL BE AASHTO M270 GR 50W


HORIZONTAL DIMENSIONS ARE ALL CHORD DIMENSION
AND NOT ALONG BEAM CAMBER ARC

DIMENSIONS NOTED THUS: (127'-4 1/16\") ARE BOT & TOP
FLG LENGTHS ALONG THE CAMBER ARC

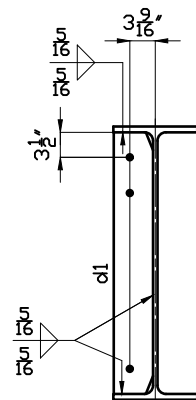


SECTION A

1 1/16\"/>

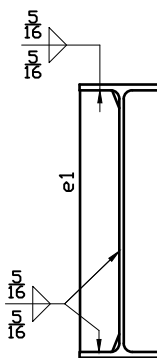

SECTION B

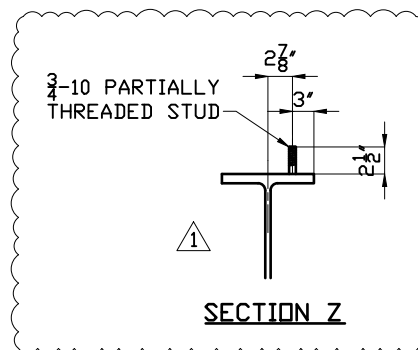

SECTION Z

GENERAL CONTRACTOR: KOKOSING D&B

TOTAL WEIGHT

NOTES: 1 1/16\"/>

PAINT SPECS: CLEANING SEE GNIAB

PRIMER NONE

INTERMEDIATE NONE

FINISH NONE

TO SHOP:



**SHANE FELTER
INDUSTRIES**

P.O. BOX 2022 • ROUTE 51 • UNIONTOWN PENNSYLVANIA 15401

DETAIL OF STRINGER 9S1

BU-25 E 89TH ST PEDESTRIAN BRIDGE CUY-IR490/SR010-2.09/19.28


CITY OF CLEVELAND, CONSTRUCTION PROJECT #17-3000 PID #96833

FED. PROJ.# E140 (249) CUYAHOGA COUNTY, OHIO

1	ADDED STUDS	6/18/20	DR.	CCD-MC	DATE 2/20
2			CH.	CCD-JB	DATE 2/20
3			APP.		DATE
4					

DWG. NO. 9AB

CONT. NO. 19-782

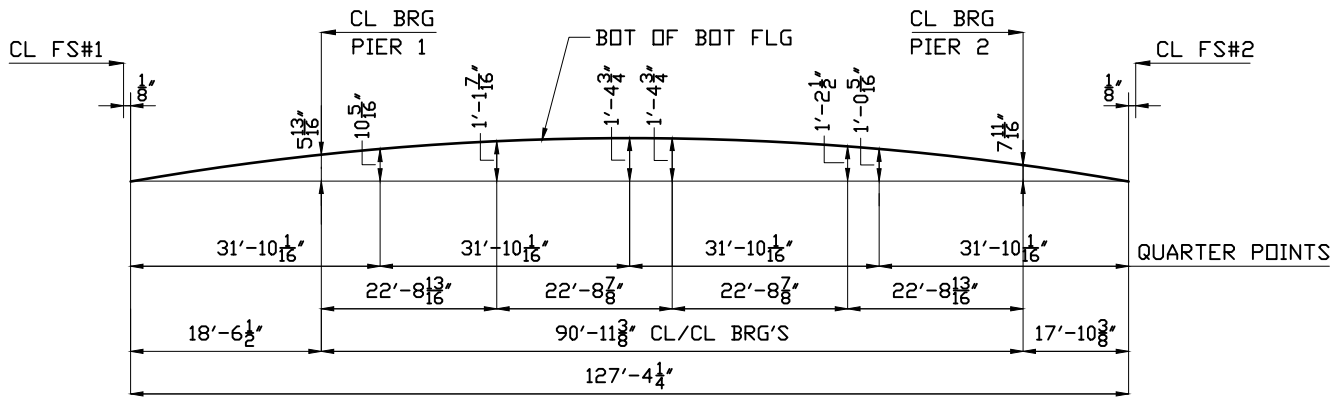

CAMBER DIAGRAM

BILL OF MATERIAL						
PHASE 1	PHASE 2	ASS'Y MARK	NO. REQ'D	DESCRIPTION	WEIGHT	NOTES
		9S1	1	STRINGER		
				W40x149 x 127'-7 $\frac{13}{16}"$ CVN		
		d1	8	PL $\frac{3}{8}"$ x $5\frac{1}{2}"$ x 3'-0 $\frac{5}{8}"$		
		e1	12	PL $\frac{3}{8}"$ x $5\frac{1}{2}"$ x 3'-0 $\frac{5}{8}"$		
			8	STUD $\frac{3}{4}$ -10 x 2 $\frac{1}{2}"$ UNC NELSON #101017428		

WORK THIS DWG. WITH DWG. 9AB
FOR SHOP NOTES SEE DWG. GN1AB/B
ALL STEEL SHALL BE AASHTO M270 GR 50W



GENERAL CONTRACTOR: KOKOSING D&B

TOTAL WEIGHT			
NOTES: $\frac{1}{16}"$ DIA. HOLES UNLESS NOTED <u>1"</u> DIA. BOLTS UNLESS NOTED			
PAINT SPECS: CLEANING		SEE GN1AB	
PRIMER		NONE	
INTERMEDIATE		NONE	
FINISH		NONE	
TO SHOP:			




SHANE FELTER INDUSTRIES



P.O. BOX 2022 • ROUTE 51 • UNIONTOWN PENNSYLVANIA 15401

DETAIL OF STRINGER 9S1
BU-25 E 89TH ST PEDESTRIAN BRIDGE CUY-IR490/SR010-2.09/19.28
CITY OF CLEVELAND, CONSTRUCTION PROJECT #17-3000 PID #96833
FED. PROJ.# E140 (249) CUYAHOGA COUNTY, OHIO


REVISIONS	1	ADDED STUDS	6/18/20	DR.	CCD-MC	DATE	2/20
	2			CH.	CCD-JB	DATE	2/20
	3			APP.		DATE	
	4						
DWG. NO. 9B				CONT. NO. 19-782			

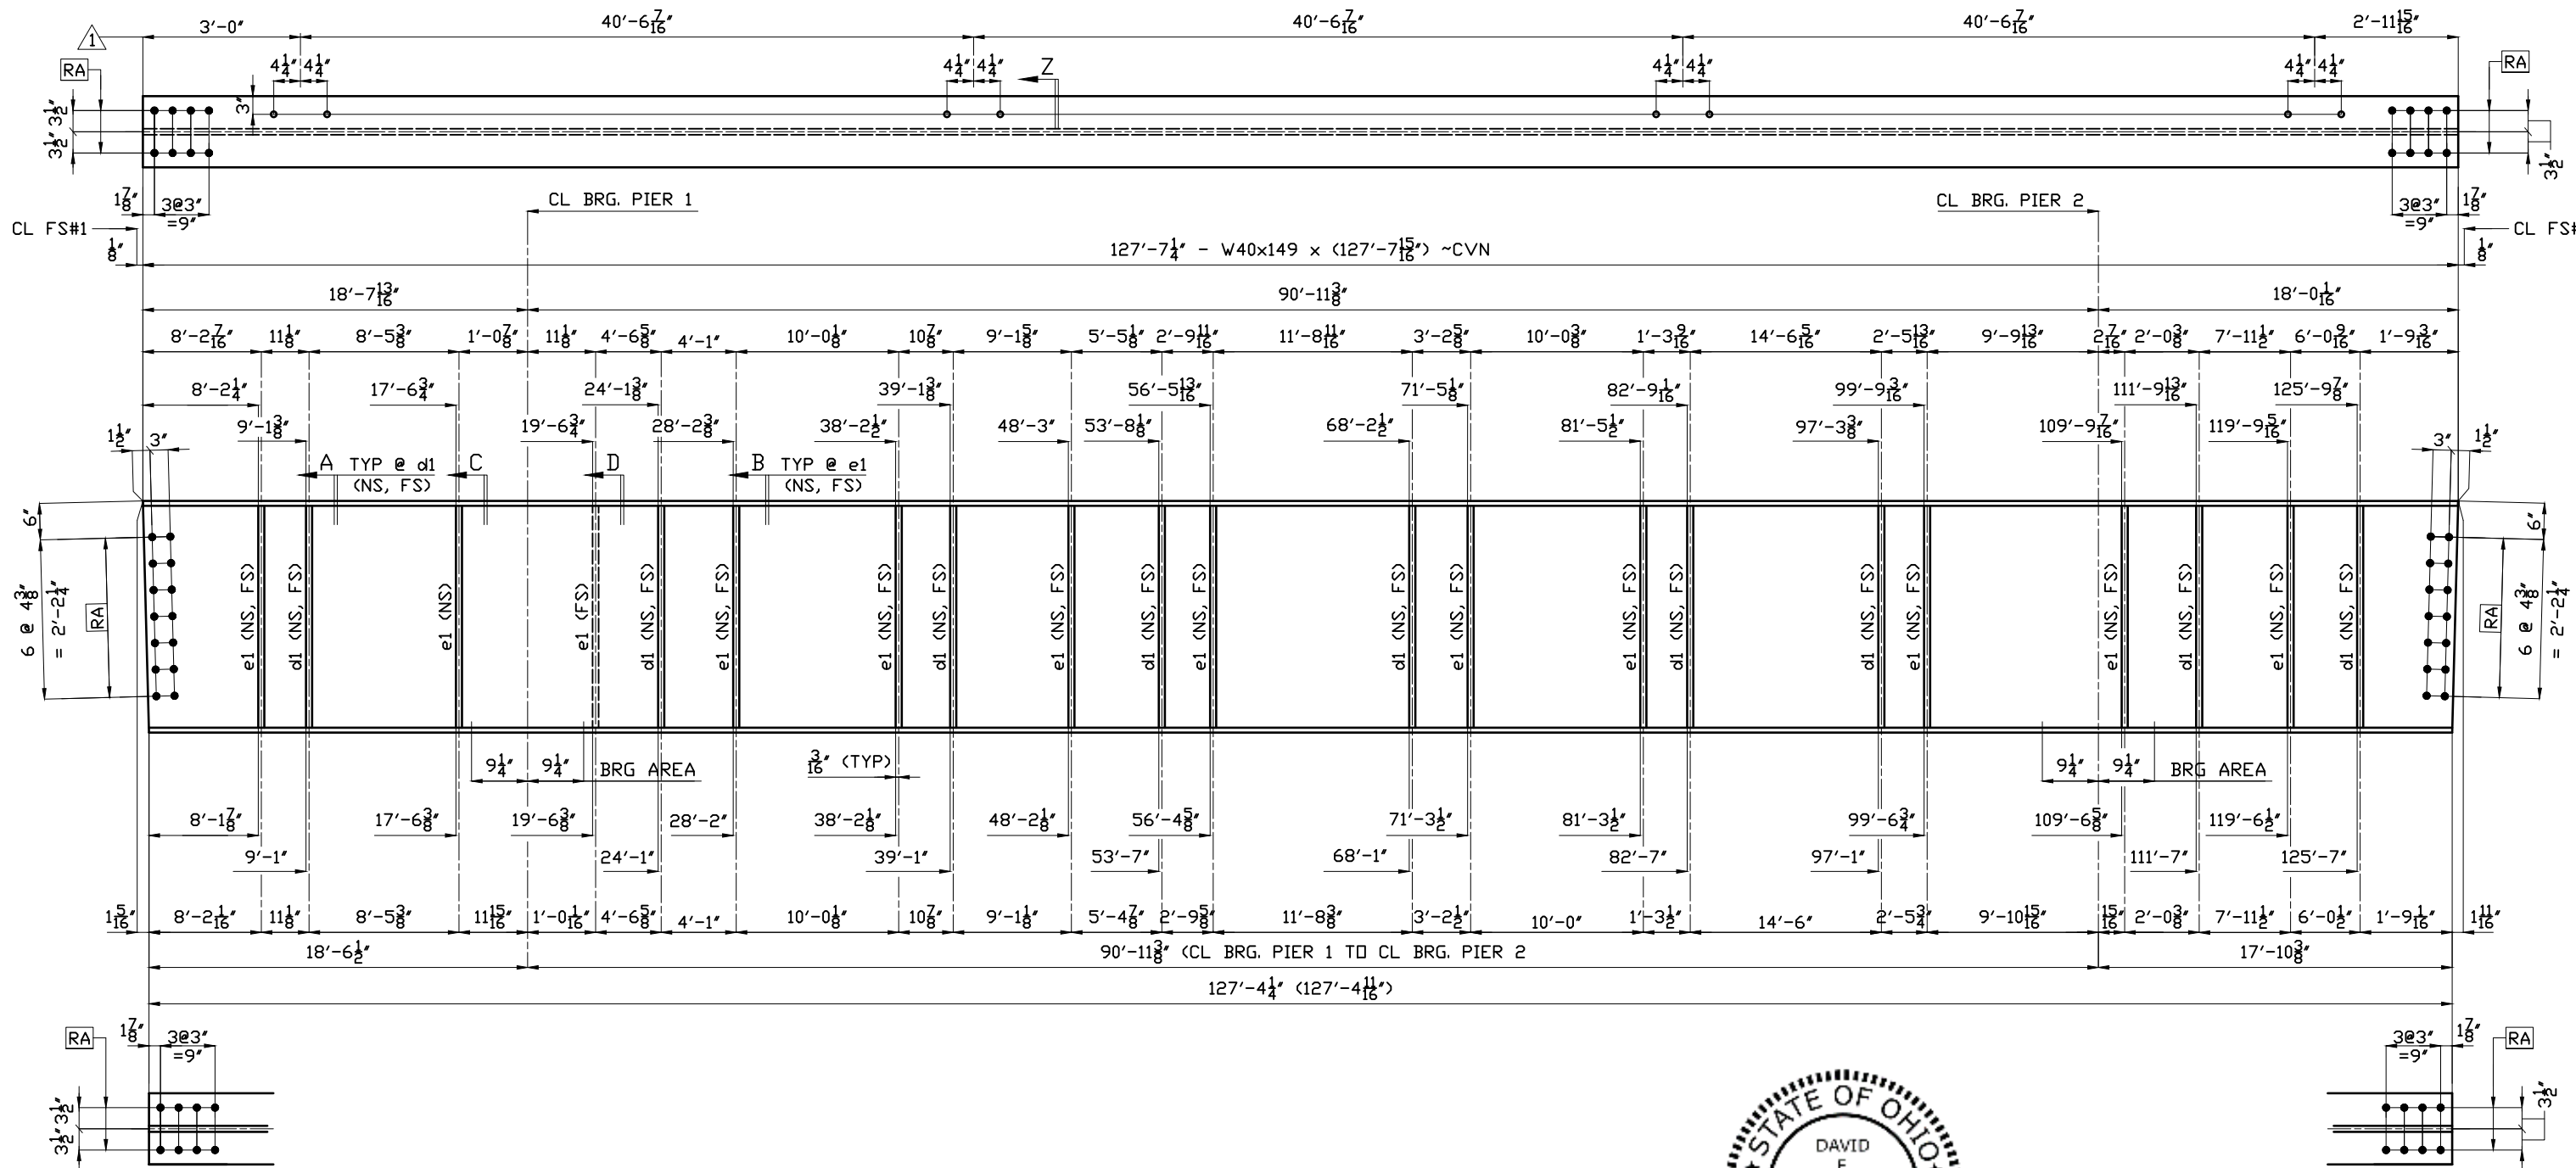

ONE ~STRINGER~ 10S2
WORK THIS DWG. WITH DWG. 10B
FOR SHOP NOTES SEE DWG. GN1AB/B
ALL STEEL SHALL BE AASHTO M270 GR 50W
HORIZONTAL DIMENSIONS ARE ALL CHORD DIMENSION
AND NOT ALONG BEAM CAMBER ARC
DIMENSIONS NOTED THUS: (127'-4 1/4\") ARE BOT & TOP
FLG LENGTHS ALONG THE CAMBER ARC

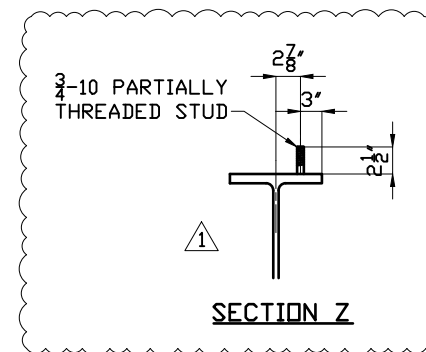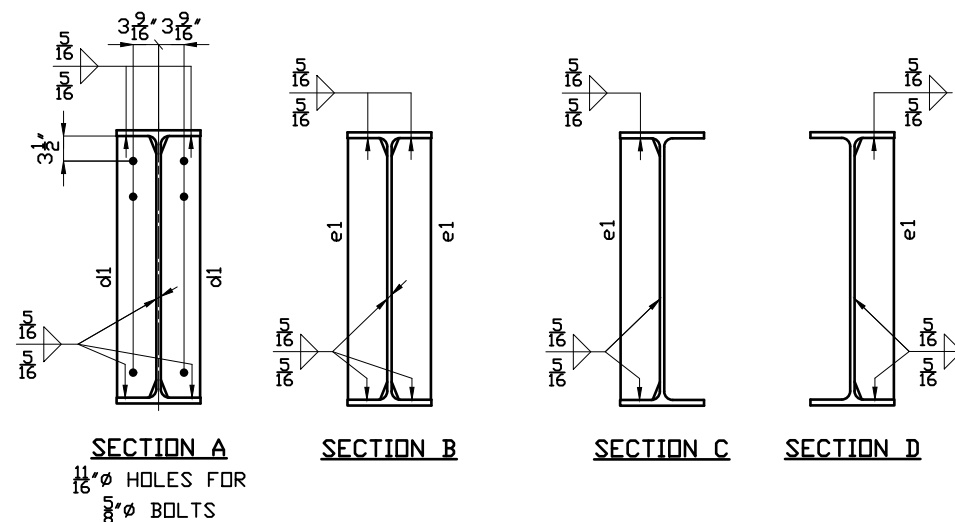


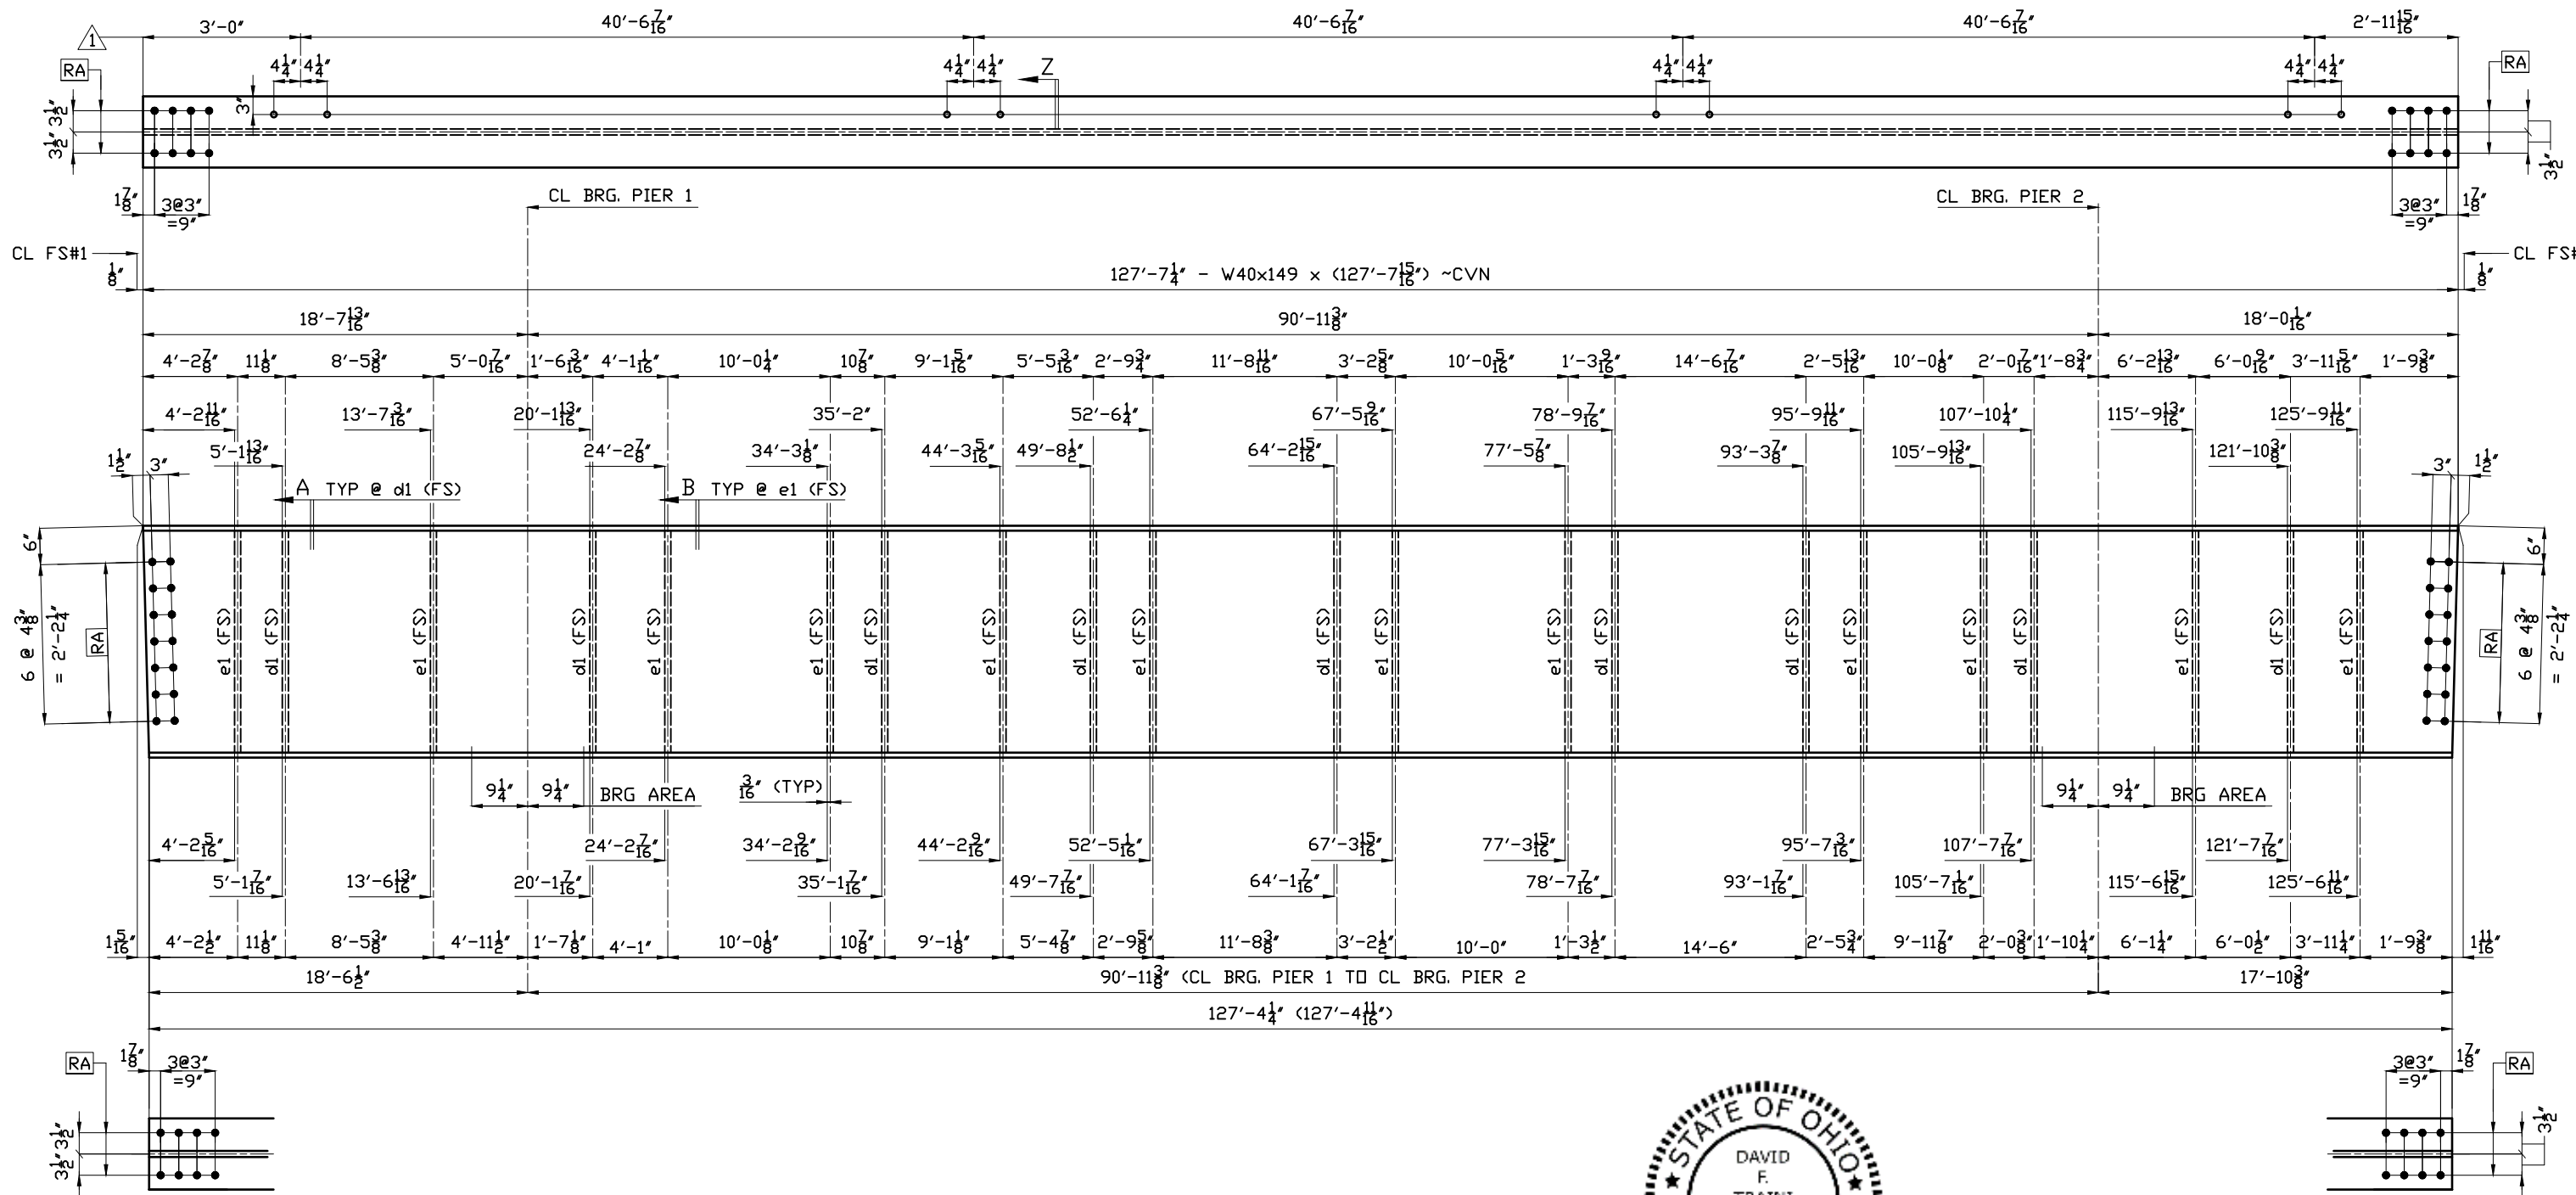
GENERAL CONTRACTOR: KOKOSING D&B	
TOTAL WEIGHT	
NOTES: 1 1/8\"/>	
PAINT SPECS: CLEANING SEE GNIAB	
PRIMER NONE	
INTERMEDIATE NONE	
FINISH NONE	
TO SHOP:	
 SHANE FELTER INDUSTRIES P.O. BOX 2022 • ROUTE 51 • UNIONTOWN PENNSYLVANIA 15401	
DETAIL OF STRINGER 10S2	
BU-25 E 89TH ST PEDESTRIAN BRIDGE CUY-IR490/SR010-2.09/19.28	
CITY OF CLEVELAND, CONSTRUCTION PROJECT #17-3000 PID #96833	
FED. PROJ.# E140 (249) CUYAHOGA COUNTY, OHIO	
REVISIONS	DR. CCD-MC DATE 2/20
1 ADDED STUDS 6/18/20	CH. CCD-JB DATE 2/20
2	APP. DATE
3	
4	
DWG. NO. 10AB	CONT. NO. 19-782

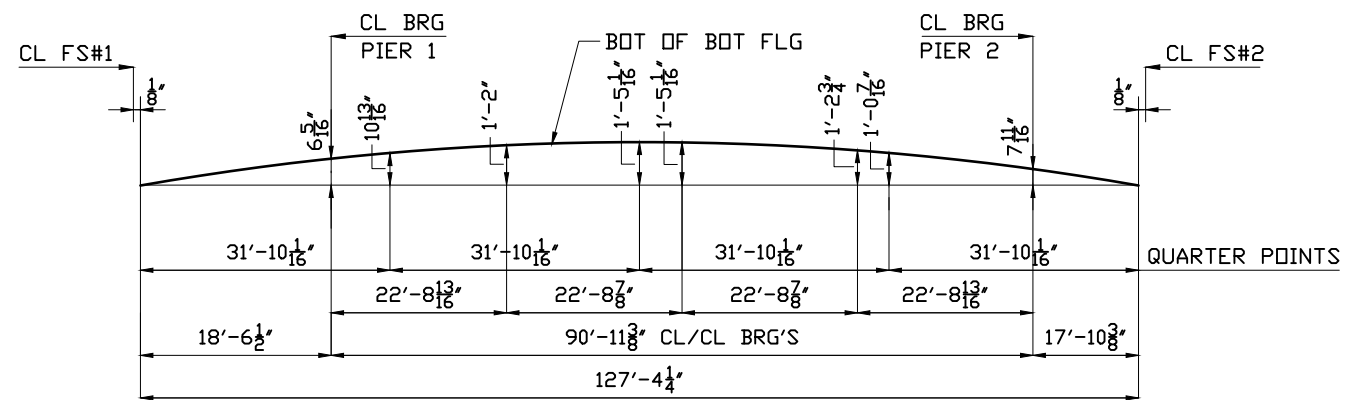[illegible]

WORK THIS DWG. WITH DWG. 10AB
FOR SHOP NOTES SEE DWG. GN1AB/B
ALL STEEL SHALL BE AASHTO M270 GR 50W



GENERAL CONTRACTOR: KOKOSING D&B	
TOTAL WEIGHT	
NOTES: <u>1 1/16"</u> DIA. HOLES UNLESS NOTED <u>1"</u> DIA. BOLTS UNLESS NOTED	
PAINT SPECS: CLEANING	SEE GNIAB
PRIMER	NONE
INTERMEDIATE	NONE
FINISH	NONE
TO SHOP:	
 <div> <h1>SHANE FELTER INDUSTRIES</h1> <p>P.O. BOX 2022 • ROUTE 51 • UNIONTOWN PENNSYLVANIA 15401</p> </div>	
DETAIL OF STRINGER 10S2	
BU-25 E 89TH ST PEDESTRIAN BRIDGE CUY-IR490/SR010-2.09/19.28	
CITY OF CLEVELAND, CONSTRUCTION PROJECT #17-3000 PID #96833	
FED. PROJ.# E140 (249) CUYAHOGA COUNTY, OHIO	
REVISIONS 1 ADDED STUDS 6/18/20 2 3 4	DR. <u>CCD-MC</u> DATE <u>2/20</u> CH. <u>CCD-JB</u> DATE <u>2/20</u> APP. _____ DATE _____
DWG. NO. 10B	CONT. NO. 19-782



ONE ~STRINGER~ 11S3


WORK THIS DWG. WITH DWG. 11B

FOR SHOP NOTES SEE DWG. GN1AB/B


ALL STEEL SHALL BE AASHTO M270 GR 50W

HORIZONTAL DIMENSIONS ARE ALL CHORD DIMENSION
AND NOT ALONG BEAM CAMBER ARC


DIMENSIONS NOTED THUS: (127'-4 1/16\") ARE BOT & TOP
FLG LENGTHS ALONG THE CAMBER ARC

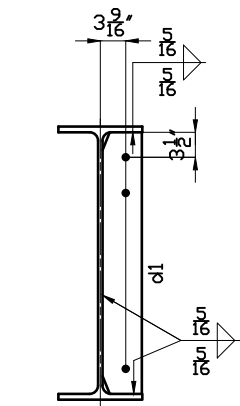

SECTION A
11/16\"/>

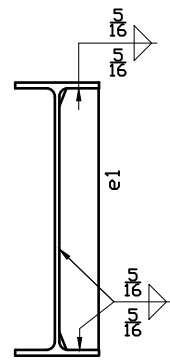

SECTION B

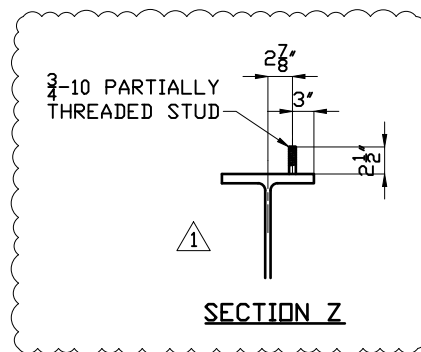

SECTION Z

GENERAL CONTRACTOR: KOKOSING D&B

TOTAL WEIGHT

NOTES: 1/16\"/>

PAINT SPECS: CLEANING SEE GNIAB

PRIMER NONE

INTERMEDIATE NONE

FINISH NONE

TO SHOP:



**SHANE FELTER
INDUSTRIES**

P.O. BOX 2022 • ROUTE 51 • UNIONTOWN PENNSYLVANIA 15401

DETAIL OF STRINGER 11S3
BU-25 E 89TH ST PEDESTRIAN BRIDGE CUY-IR490/SR010-2.09/19.28
CITY OF CLEVELAND, CONSTRUCTION PROJECT #17-3000 PID #96833
FED. PROJ.# E140 (249) CUYAHOGA COUNTY, OHIO

1	ADDED STUDS	6/18/20	DR.	CCD-MC	DATE 2/20
2			CH.	CCD-JB	DATE 2/20
3			APP.		DATE
4					


DWG. NO. 11AB



CONT. NO. 19-782




WORK THIS DWG. WITH DWG. 11AB
FOR SHOP NOTES SEE DWG. GN1AB/B
ALL STEEL SHALL BE AASHTO M270 GR 50W




GENERAL CONTRACTOR: KOKOSING D&B		TOTAL WEIGHT					
NOTES: 1 1/8" DIA. HOLES UNLESS NOTED		1" DIA. BOLTS UNLESS NOTED					
PAINT SPECS: CLEANING		SEE QNAB					
PRIMER		NONE					
INTERMEDIATE		NONE					
FINISH		NONE					
				TO SHOP:			
		<h1>SHANE FELTER INDUSTRIES</h1>					
P.O. BOX 2002 • ROUTE 51 • UNIONTOWN PENNSYLVANIA 15401							
DETAIL OF STRINGER 11S3							
BU-25 E 89TH ST PEDESTRIAN BRIDGE CUY-IR490/SR010-2.09/19.28							
CITY OF CLEVELAND, CONSTRUCTION PROJECT #17-3000 PID #96833							
FED. PROJ.# E140 (249)				CUYAHOGA COUNTY, OHIO			
REVISIONS 1 2 3 4	1 ADDED STUDS			6/18/20		DR. <u>CCD-MC</u> DATE <u>2/20</u>	
	2					CH. <u>CCD-JB</u> DATE <u>2/20</u>	
	3					APP. _____ DATE _____	
	4						
DWG. NO. 11B						CONT. NO. 19-782	

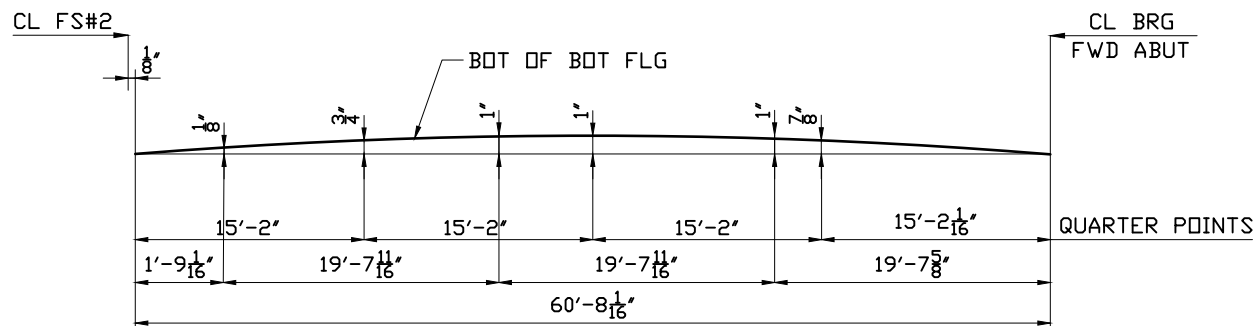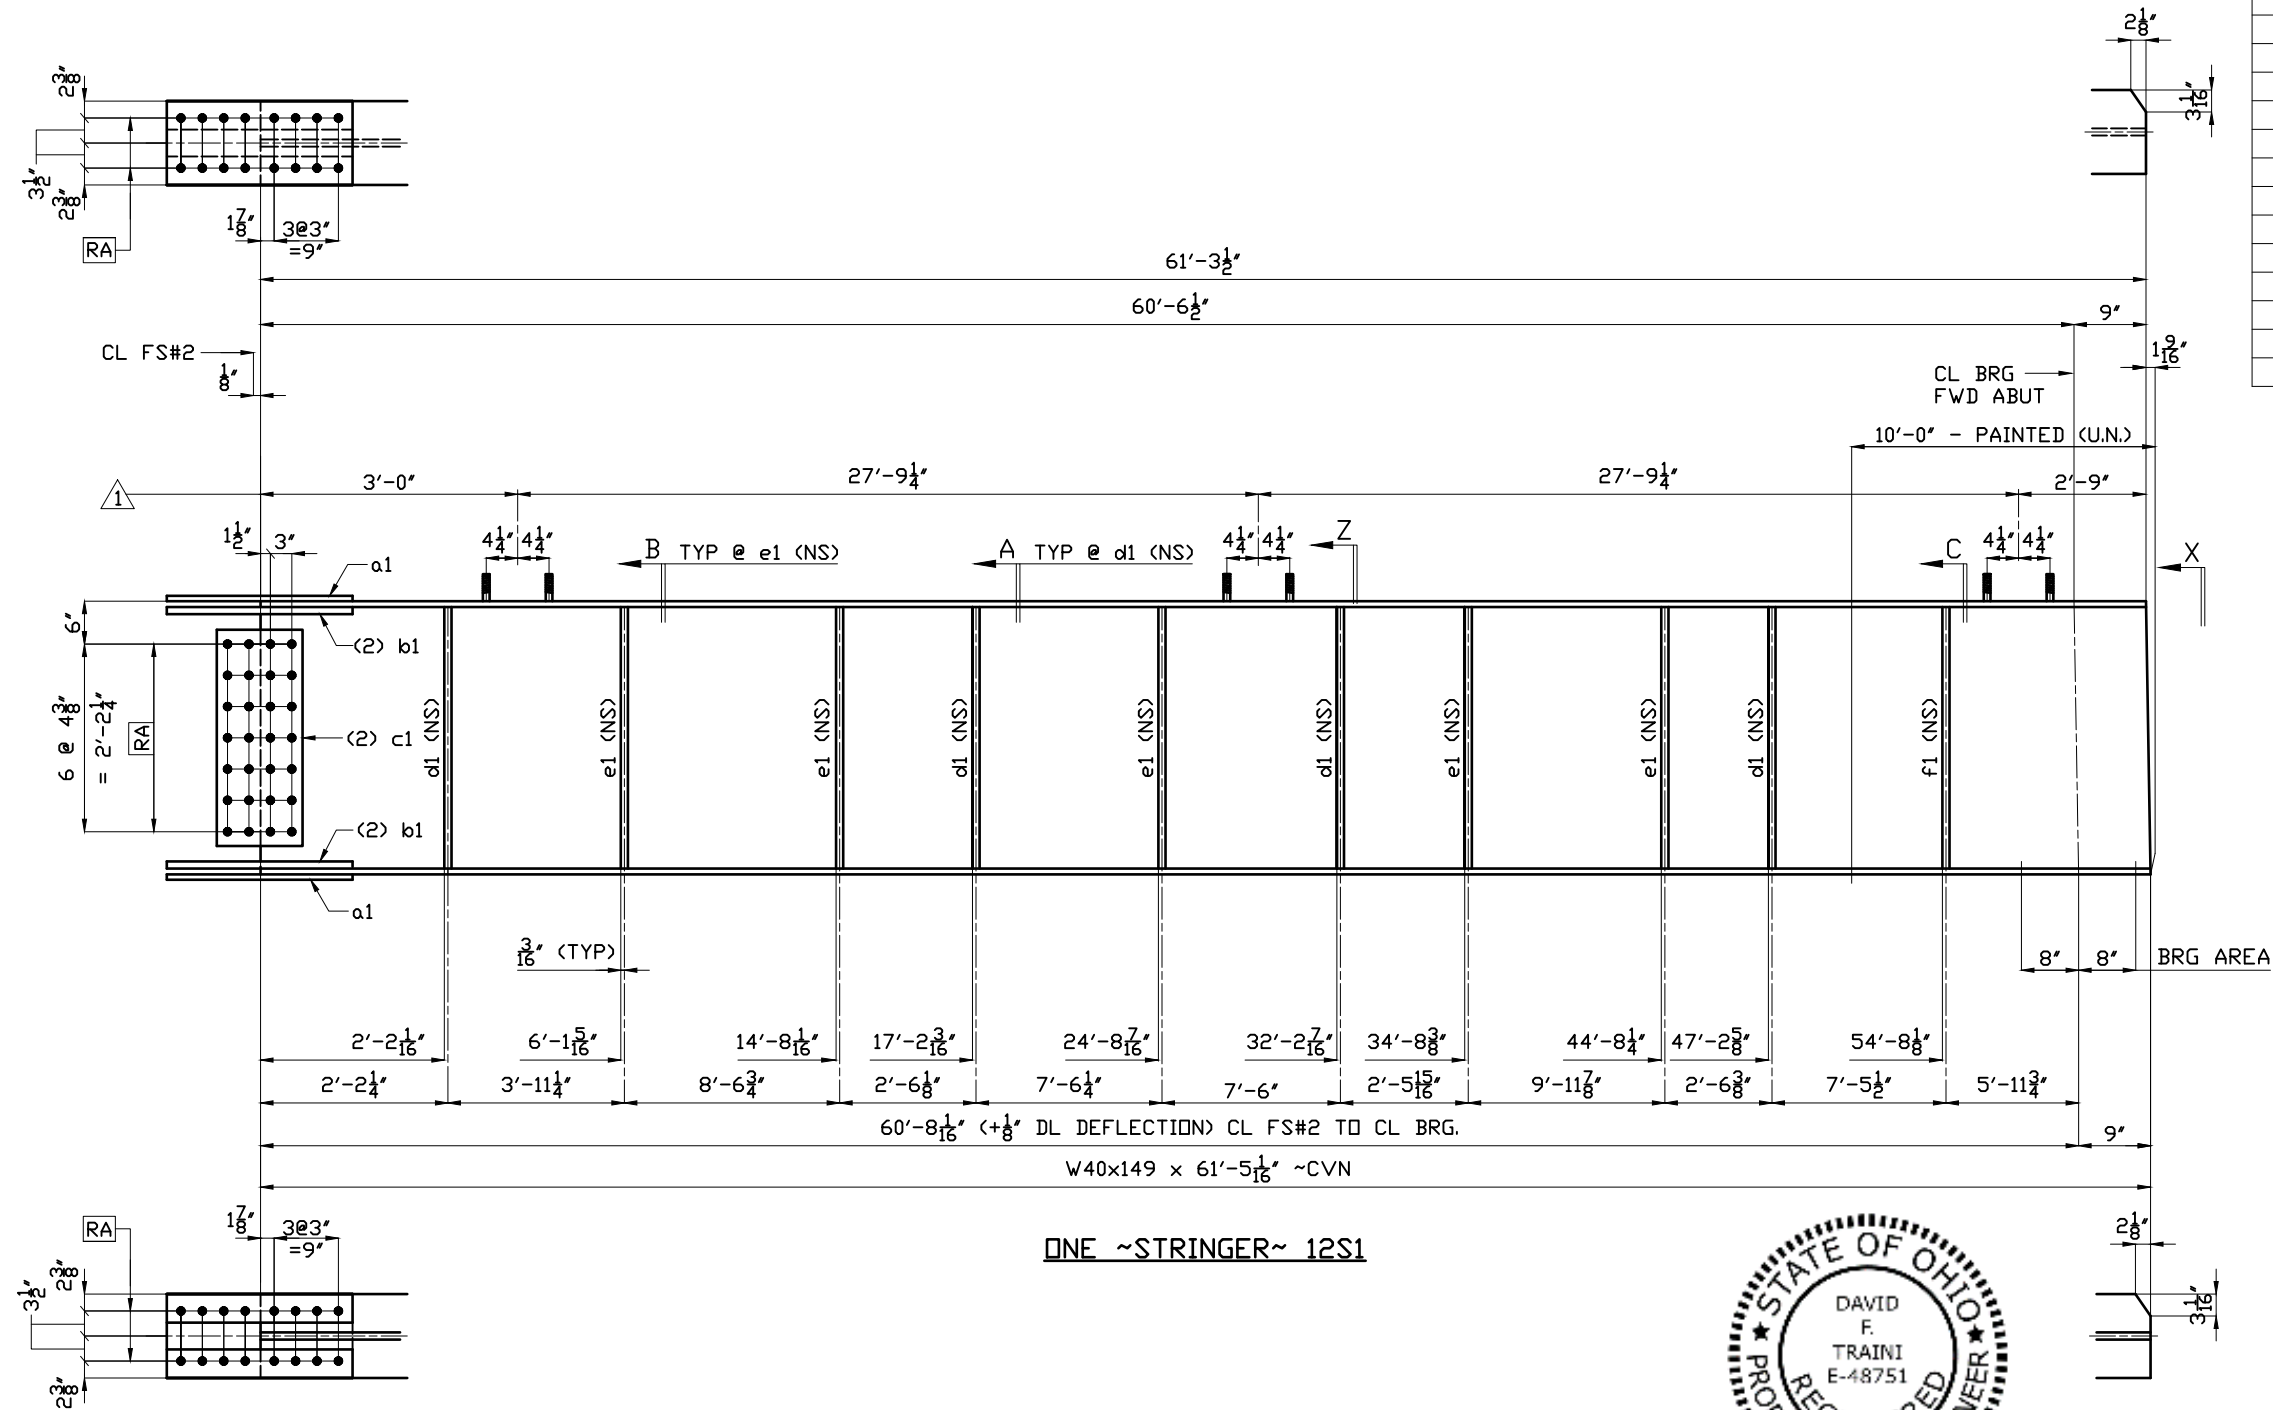

CAMBER DIAGRAM

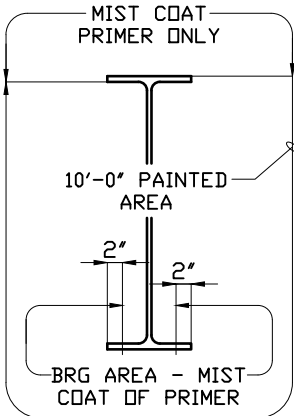


SECTION X

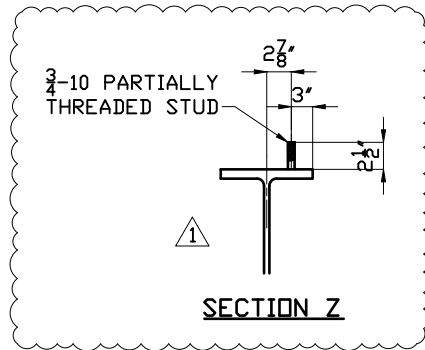

SECTION Z

BILL OF MATERIAL

PHASE 1	PHASE 2	ASS'Y MARK	NO. REQ'D	DESCRIPTION	WEIGHT	NOTES
		12S1	1	STRINGER		PAINT
		a1	2	W40x149 x 61'-5 1/16" CVN		
		b1	4	PL 3/4 x 11 3/4 x 2'-2" CVN		
		c1	2	PL 1/2 x 30 1/4 x 1'-0 1/4" CVN		
		d1	4	PL 3/8 x 5 1/2 x 3'-0 3/8"		
		e1	5	PL 3/8 x 5 1/2 x 3'-0 3/8"		
		f1	1	PL 3/8 x 5 1/2 x 3'-0 3/8"		
			6	STUD 3/4-10 x 2 1/2" UNC NELSON #101017428		

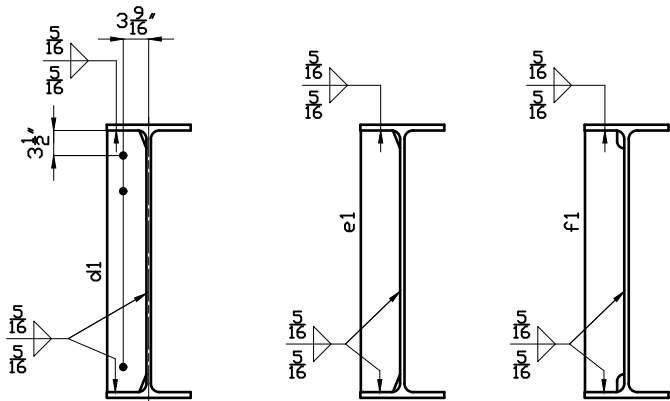

SECTION A

SECTION B

SECTION C

FOR SHOP NOTES SEE DWG. GN1AB/B

ALL STEEL SHALL BE AASHTO M270 GR 50W

GENERAL CONTRACTOR: KOKOSING D&B

TOTAL WEIGHT

NOTES: 1/16" DIA. HOLES UNLESS NOTED	1" DIA. BOLTS UNLESS NOTED
PAIN SPEC'S: CLEANING	SEE GNIAB
PRIMER	SEE GNIAB
INTERMEDIATE	NONE
FINISH	NONE

TO SHOP:



SHANE FELTER INDUSTRIES


P.O. BOX 2022 • ROUTE 51 • UNIONTOWN PENNSYLVANIA 15401

DETAIL OF STRINGER 12S1
BU-25 E 89TH ST PEDESTRIAN BRIDGE CUY-IR490/SR010-2.09/19.28
CITY OF CLEVELAND, CONSTRUCTION PROJECT #17-3000 PID #96833
FED. PROJ.# E140 (249) CUYAHOGA COUNTY, OHIO





1	ADDED STUDS	6/18/20	DR.	CCD-MC	DATE 2/20
2			CH.	CCD-JB	DATE 2/20
3			APP.		DATE
4					

DWG. NO. 12

CONT. NO. 19-782

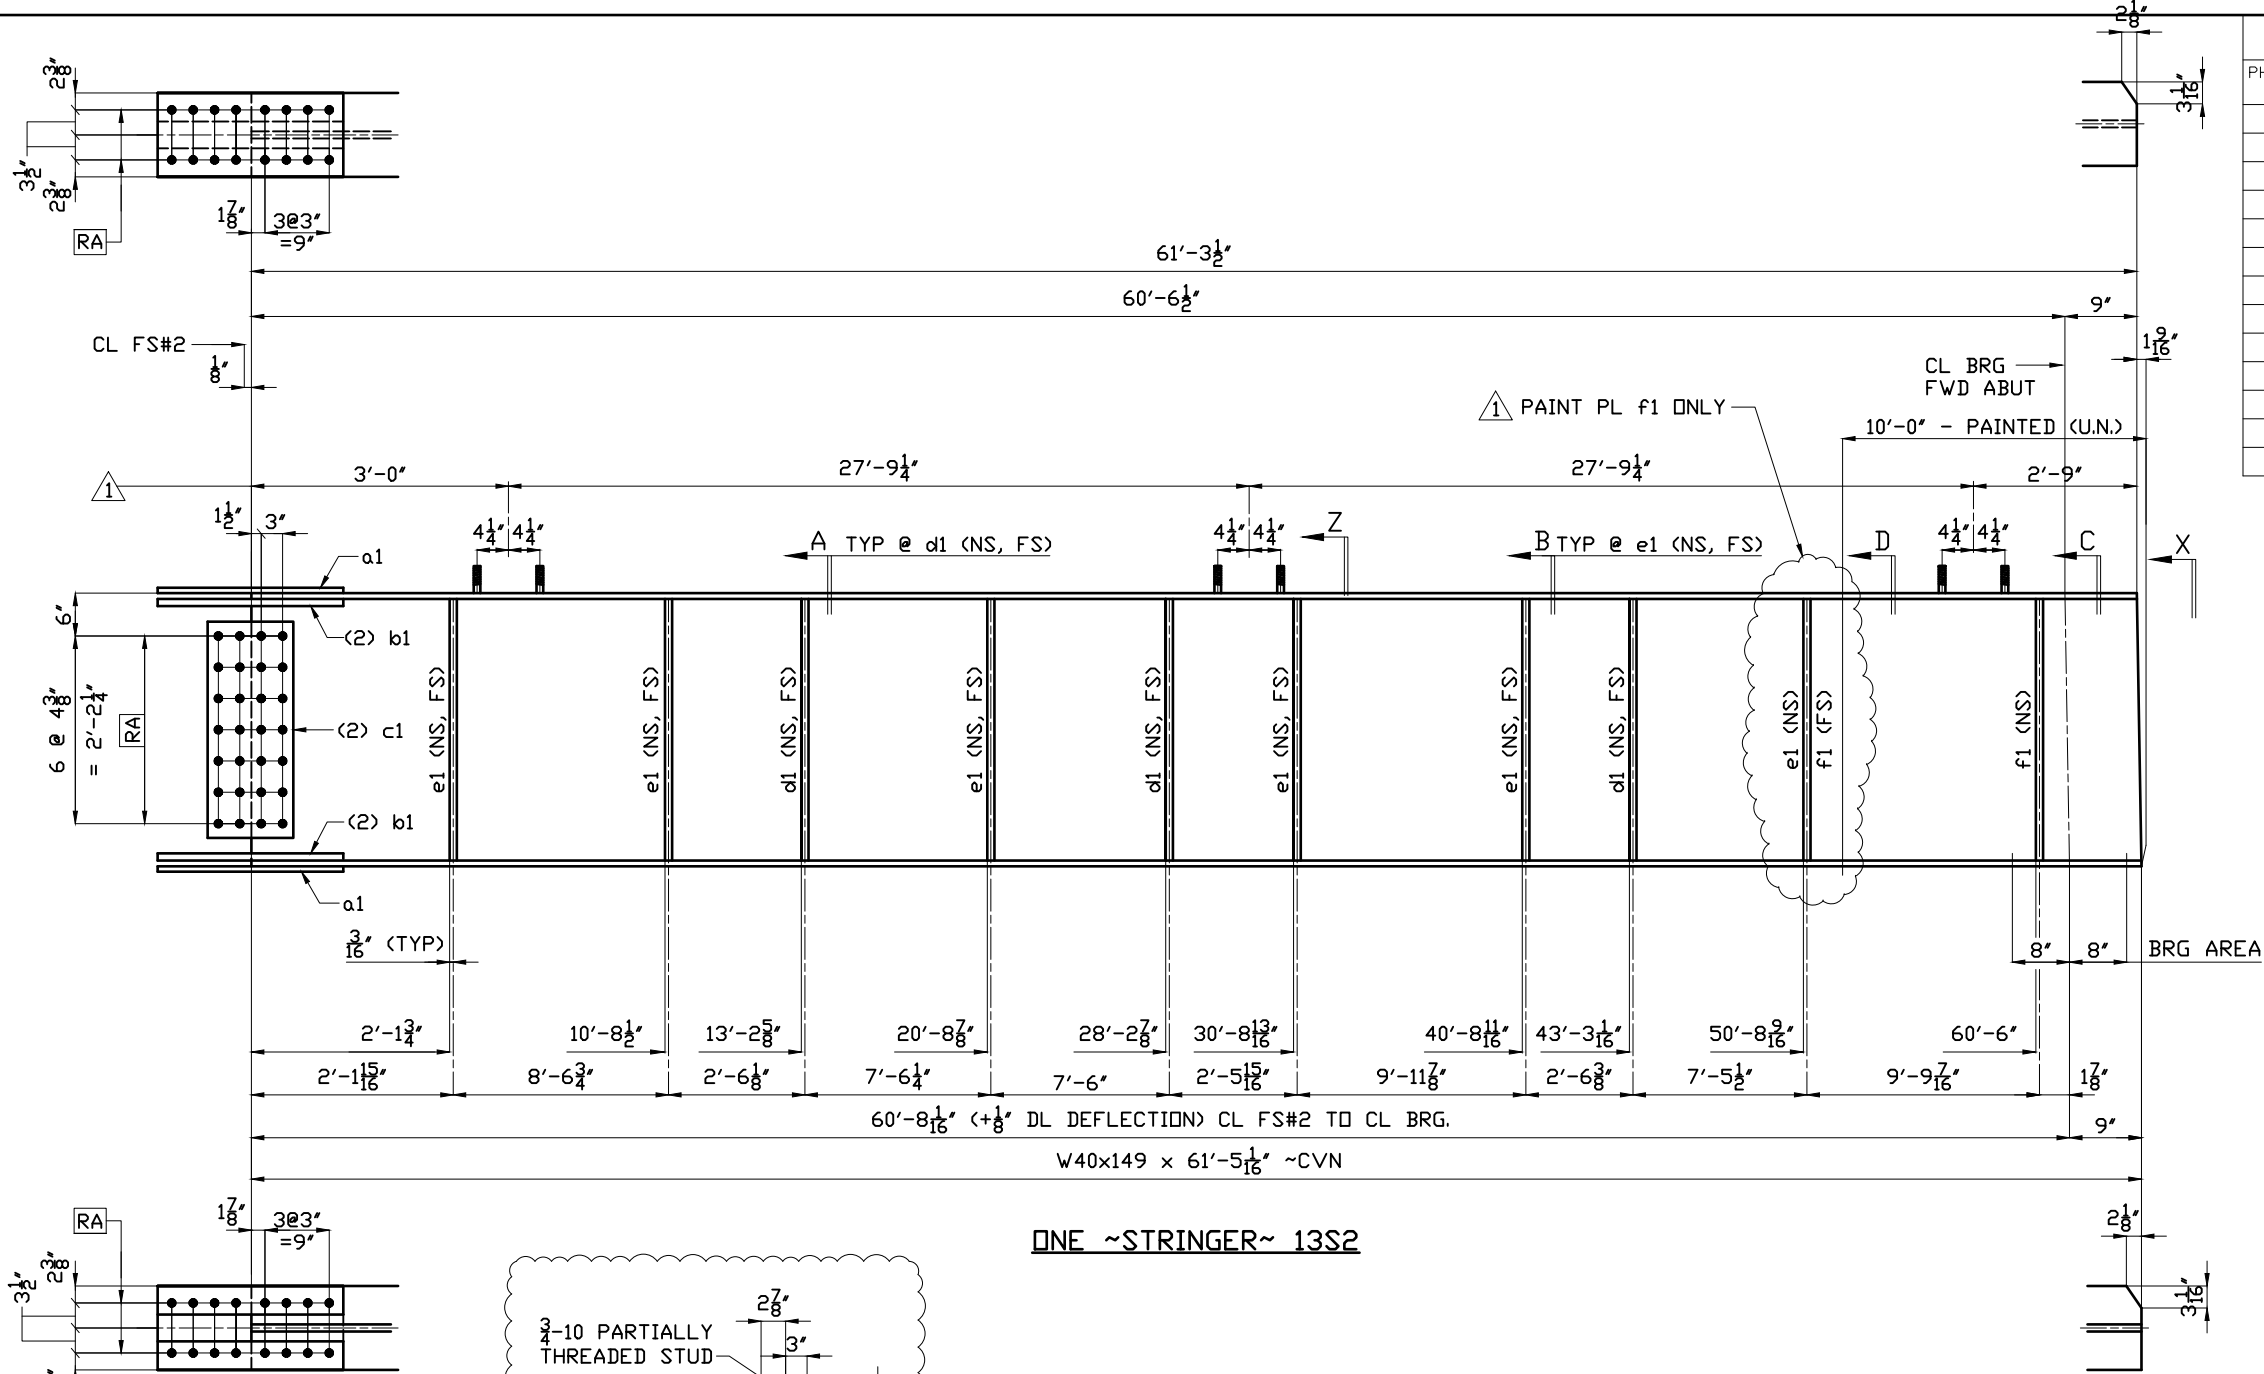

BILL OF MATERIAL						
PHASE 1	PHASE 2	ASS'Y MARK	NO. REQ'D	DESCRIPTION	WEIGHT	NOTES
		13S2	1	STRINGER		PAINT
		a1	2	W40x149 x 61'-5 1/16" CVN		
		b1	4	PL 3/4" x 11 3/4" x 2'-2" CVN		
		c1	2	PL 1/2" x 30 1/4" x 1'-0 1/4" CVN		
		d1	6	PL 3/8" x 5 1/2" x 3'-0 3/8"		
		e1	11	PL 3/8" x 5 1/2" x 3'-0 3/8"		
		f1	2	PL 3/8" x 5 1/2" x 3'-0 3/8"		
			6	STUD 3/4-10 x 2 1/2" UNC NELSON #101017428		

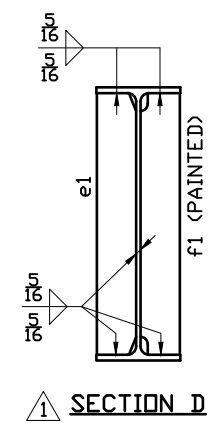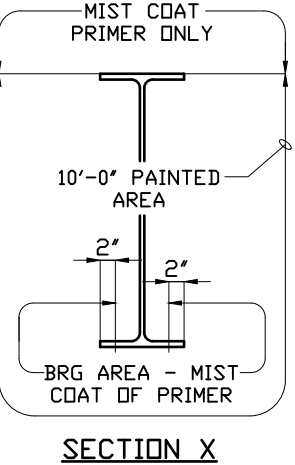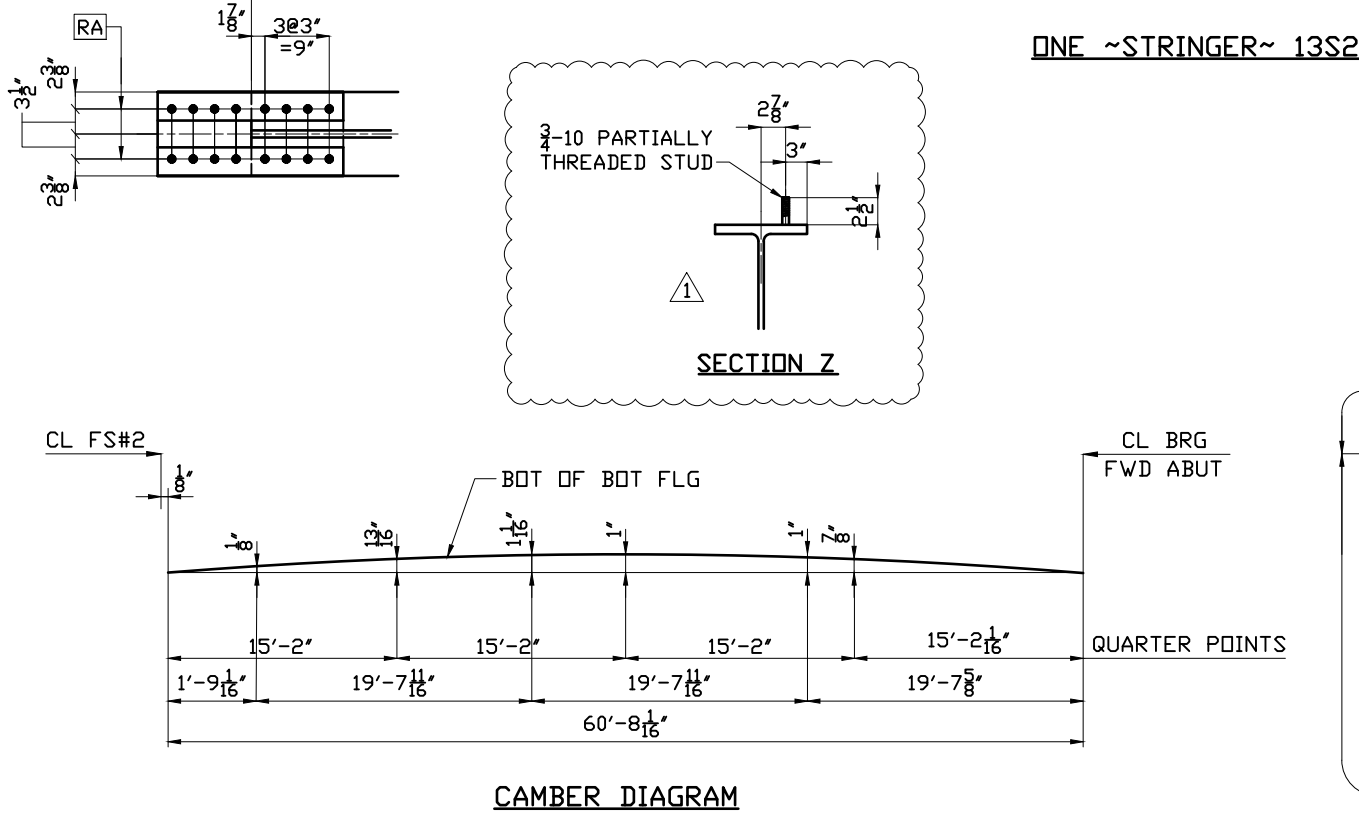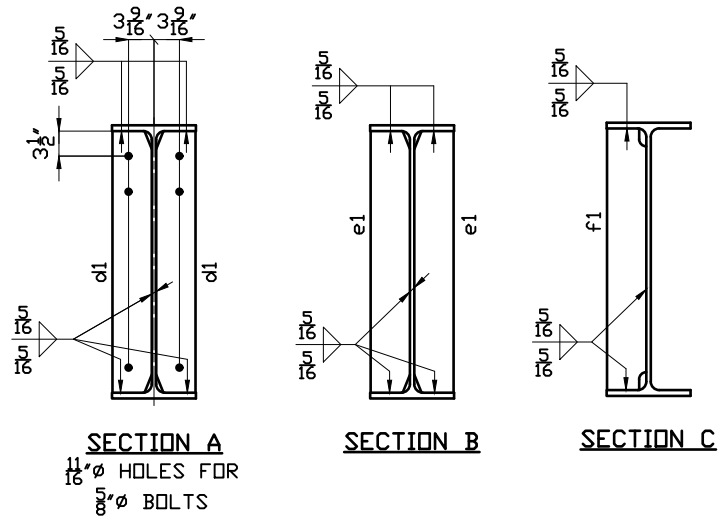

FOR SHOP NOTES SEE DWG. GNIAB/B

ALL STEEL SHALL BE AASHTO M270 GR 50W

GENERAL CONTRACTOR: KOKOSING D&B

TOTAL WEIGHT	
--------------	--

NOTES: 1 1/16" DIA. HOLES UNLESS NOTED 1" DIA. BOLTS UNLESS NOTED

PAINT SPECS: CLEANING SEE GNIAB

PRIMER SEE GNIAB

INTERMEDIATE NONE

FINISH NONE

TO SHOP:

SFI SHANE FELTER INDUSTRIES

P.O. BOX 2022 • ROUTE 51 • UNIONTOWN PENNSYLVANIA 15401

DETAIL OF STRINGER 13S2



BU-25 E 89TH ST PEDESTRIAN BRIDGE CUY-IR490/SR010-2.09/19.28

CITY OF CLEVELAND, CONSTRUCTION PROJECT #17-3000 PID #96833


FED. PROJ.# E140 (249) CUYAHOGA COUNTY, OHIO

REVISIONS	1 ADDED PAINT NOTE/STUDS 6/17/20	DR. CCD-MC DATE 2/20
2		CH. CCD-JB DATE 2/20
3		APP. DATE
4		


DWG. NO. 13 CONT. NO. 19-782

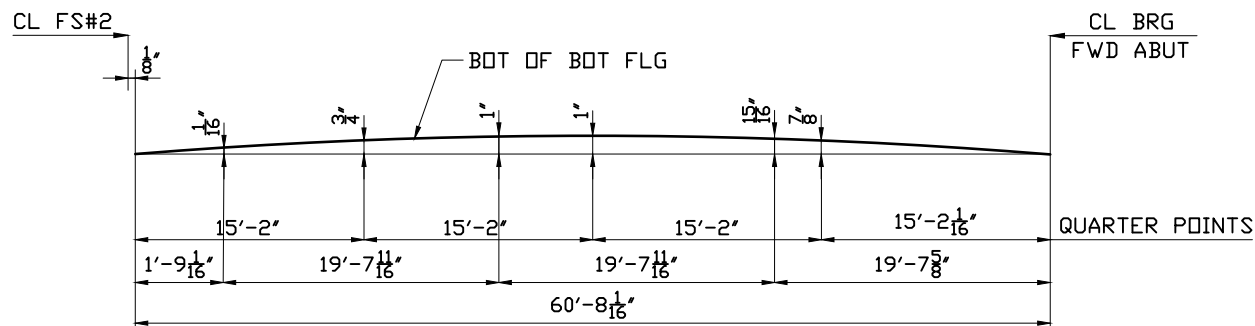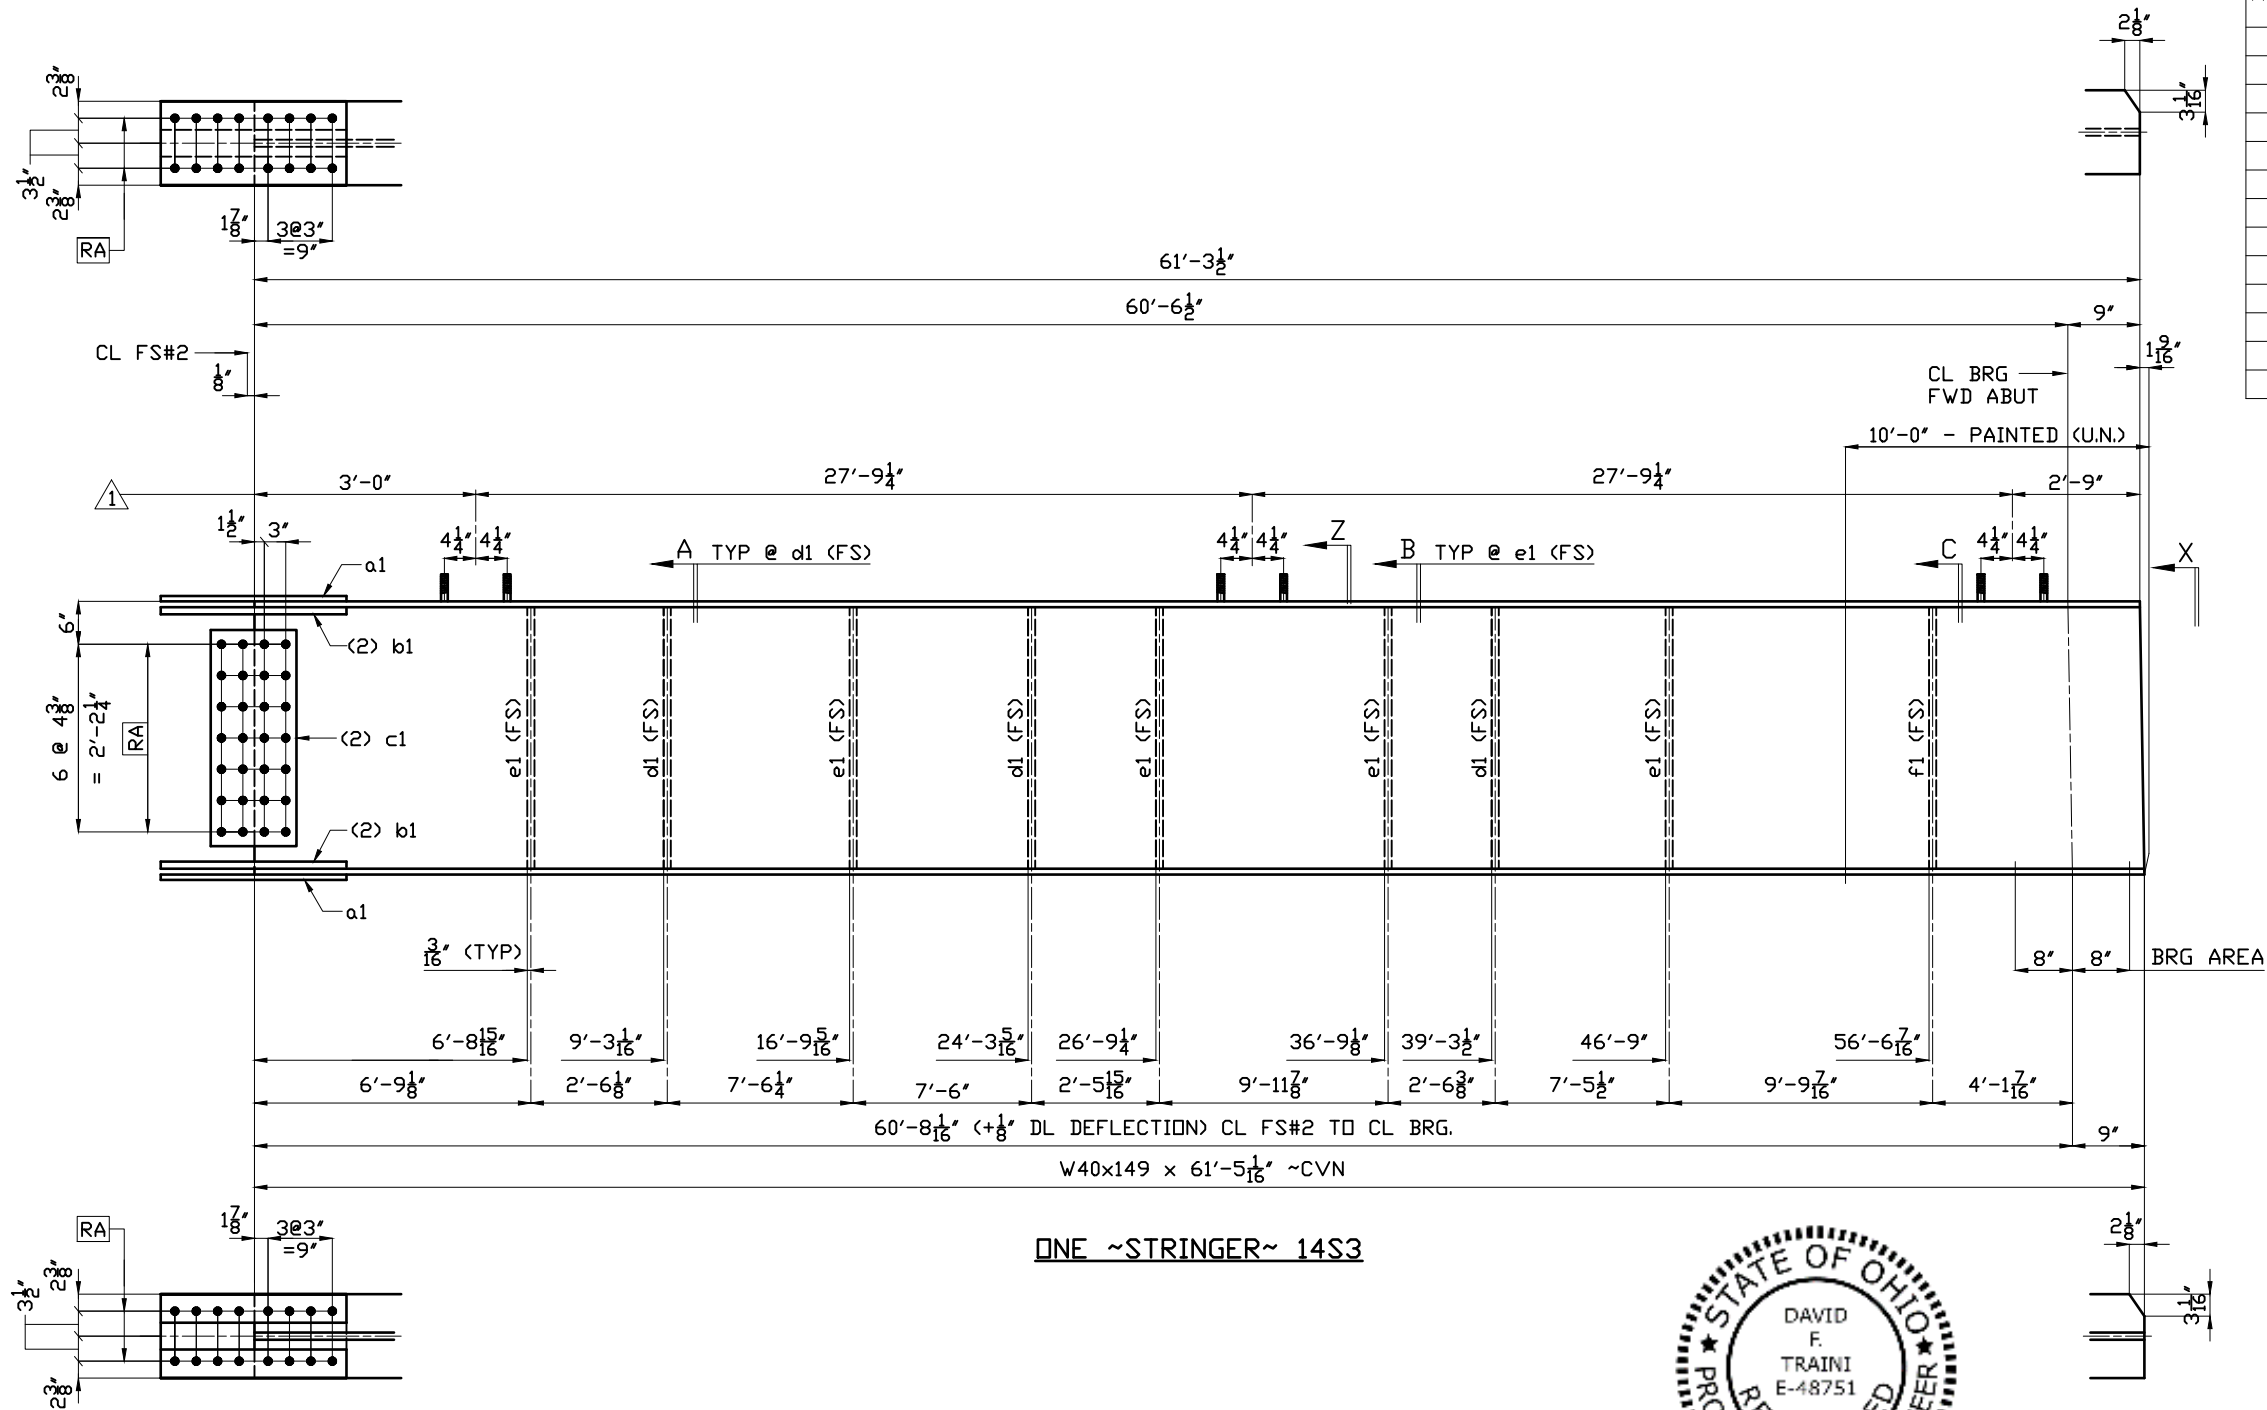

CAMBER DIAGRAM

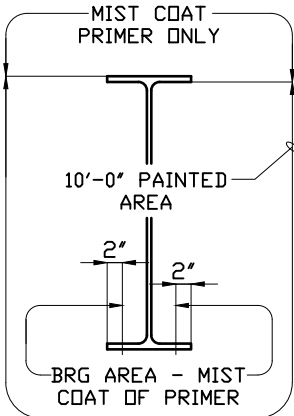


SECTION X

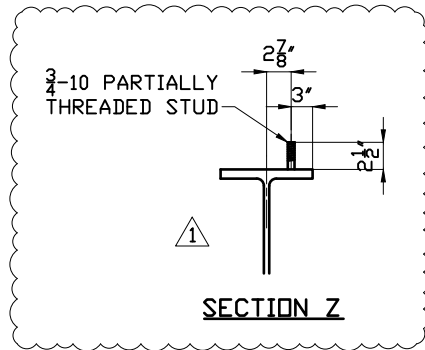

SECTION Z

BILL OF MATERIAL

PHASE 1	PHASE 2	ASS'Y MARK	NO. REQ'D	DESCRIPTION	WEIGHT	NOTES
		14S3	1	STRINGER		PAINT
				W40x149 x 61'-5 1/8" CVN		
		a1	2	PL 3/4" x 11 3/4" x 2'-2" CVN		
		b1	4	PL 1" x 4" x 2'-2" CVN		
		c1	2	PL 1/2" x 30 1/4" x 1'-0 1/4" CVN		
		d1	3	PL 3/8" x 5 1/2" x 3'-0 5/8"		
		e1	5	PL 3/8" x 5 1/2" x 3'-0 5/8"		
		f1	1	PL 3/8" x 5 1/2" x 3'-0 3/8"		
			6	STUD 3/4-10 x 2 1/2" UNC NELSON #101017428		

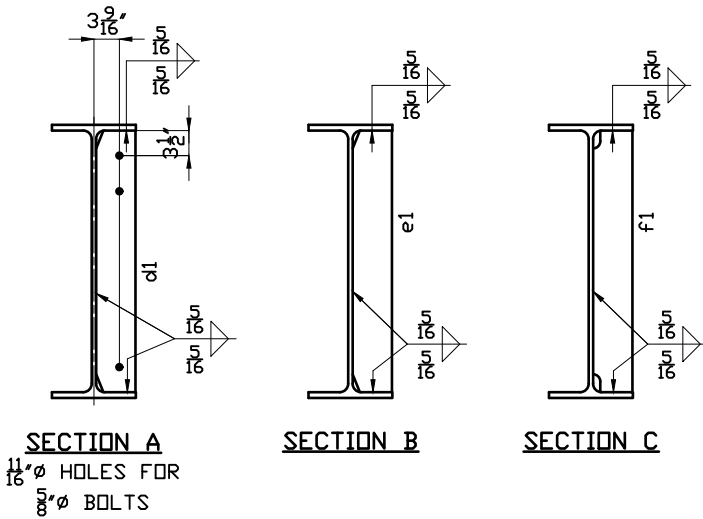

FOR SHOP NOTES SEE DWG. GNIAB/B
ALL STEEL SHALL BE AASHTO M270 GR 50W

GENERAL CONTRACTOR: KOKOSING D&B


TOTAL WEIGHT	
NOTES: 1 1/8" DIA. HOLES UNLESS NOTED 1" DIA. BOLTS UNLESS NOTED	
PAIN SPEC'S: CLEANING	SEE GNIAB
PRIMER	SEE GNIAB
INTERMEDIATE FINISH	NONE
TO SHOP:	

SFI SHANE FELTER INDUSTRIES
P.O. BOX 2022 • ROUTE 51 • UNIONTOWN PENNSYLVANIA 15401

DETAIL OF STRINGER 14S3
BU-25 E 89TH ST PEDESTRIAN BRIDGE CUY-IR490/SR010-2.09/19.28
CITY OF CLEVELAND, CONSTRUCTION PROJECT #17-3000 PID #96833
FED. PROJ.# E140 (249) CUYAHOGA COUNTY, OHIO

1 ADDED STUDS	6/18/20	DR. CCD-MC	DATE 2/20
2		CH. CCD-JB	DATE 2/20
3		APP.	DATE
4			

DWG. NO. 14 CONT. NO. 19-782

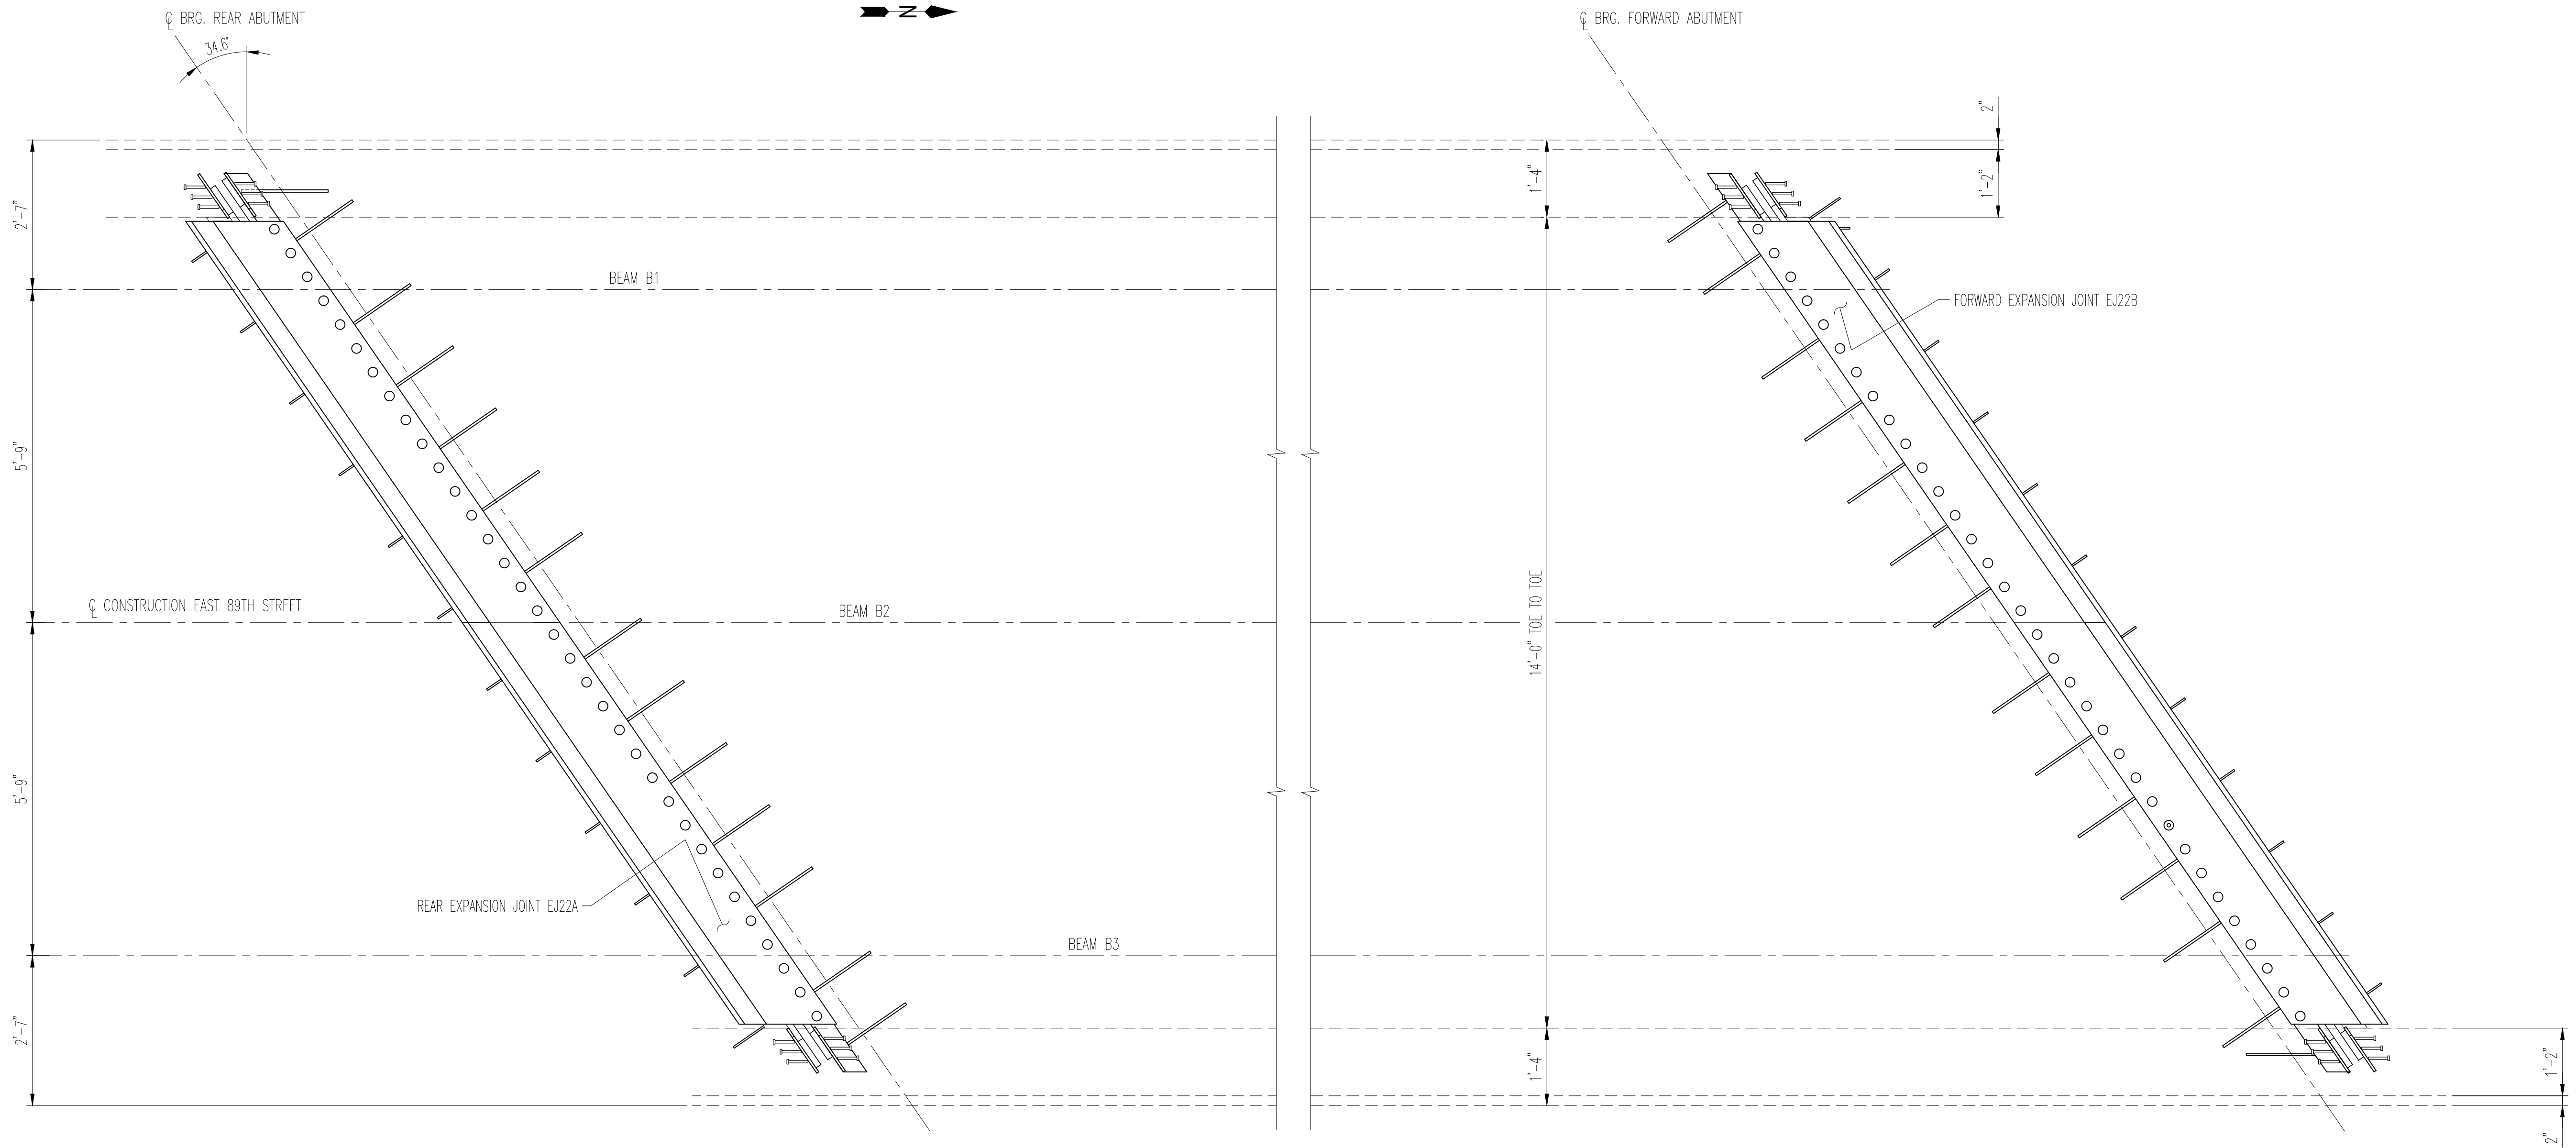

EXPANSION JOINT LOCATION PLAN

NOTES:
SEE SHEET 2 FOR DETAIL OF REAR EXPANSION JOINT EJ22A
SEE SHEET 3 FOR DETAIL OF FORWARD EXPANSION JOINT EJ22B
SEE SHEET 7 FOR EXPANSION JOINT DETAILS, GENERAL NOTES & BILL OF MATERIAL

 **AISC**
CERTIFIED
FABRICATOR

BRIDGE - INTERMEDIATE (MAJOR)
FRACTURE CRITICAL ENDORSEMENT
SOPHISTICATED PAINT ENDORSEMENT

REV. No.	REVISION
SHOP INSPECTED BY:	

APPROVAL


KOKOSING CONSTRUCTION

☒ NO EXCEPTIONS TAKEN
☐ MAKE CORRECTIONS AS NOTED
☐ REVISE AND RESUBMIT
☐ REJECTED
☐ FOR INFORMATION ONLY

REVIEW IS FOR GENERAL COMPLIANCE WITH CONTRACT DOCUMENTS
NO RESPONSIBILITY ASSUMED FOR CORRECTNESS OF DIMENSIONS OR DETAILS





BY: *mmf* DATE: 9/28/2020

TOTAL PAY LENGTH: 38.66' FT.

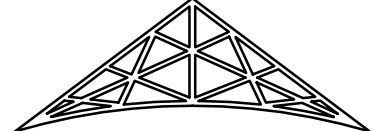 **Ohio Structures Inc.**
4030 Boardman Canfield Road, Ste. 200 D
Canfield, Ohio 44406
(330) 533-0084 Fax: (330) 533-0191





OHIO DEPARTMENT OF TRANSPORTATION
BRIDGE: CUY-E89ST-4015 (EAST 89TH STREET)
PEDESTRIAN BRIDGE OVER NORFOLK SOUTHERN & GCRTA

SCALE: N.T.S.	Kokosing Construction	DRAWN: JDC
DATE: 08/20		CHECK: MI
EXPANSION JOINT LOCATION PLAN		
REF NO.: 17 (BU25)	ITEM NO.: 516	
ODOT PROJ. NO.: 173000	CUYAHOGA COUNTY	DWG. NO.: E1
OSI PROJ. NO.: 19-22	PID NO.: 96833	SFN: TBD 1 OF 7

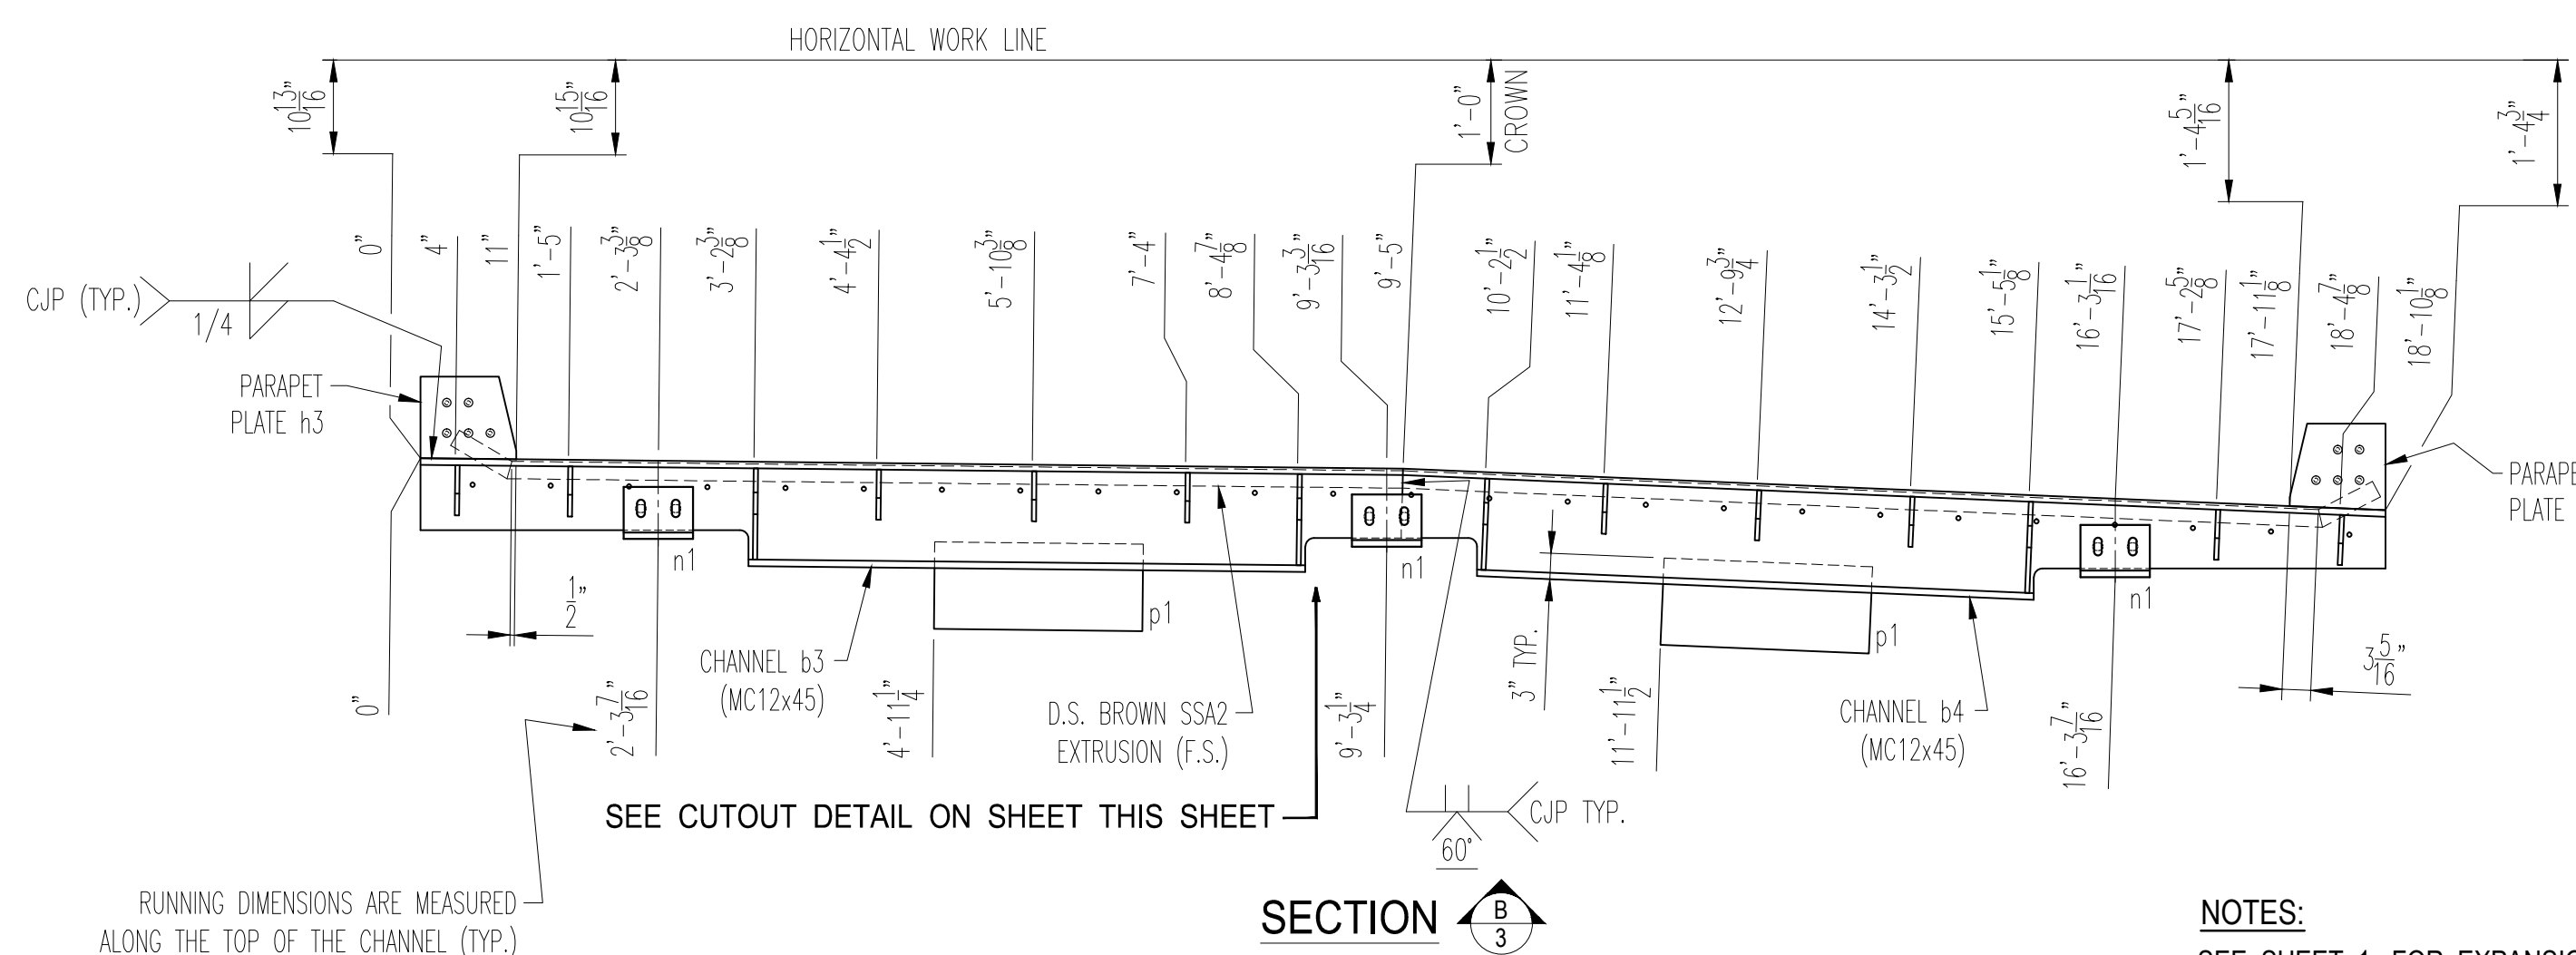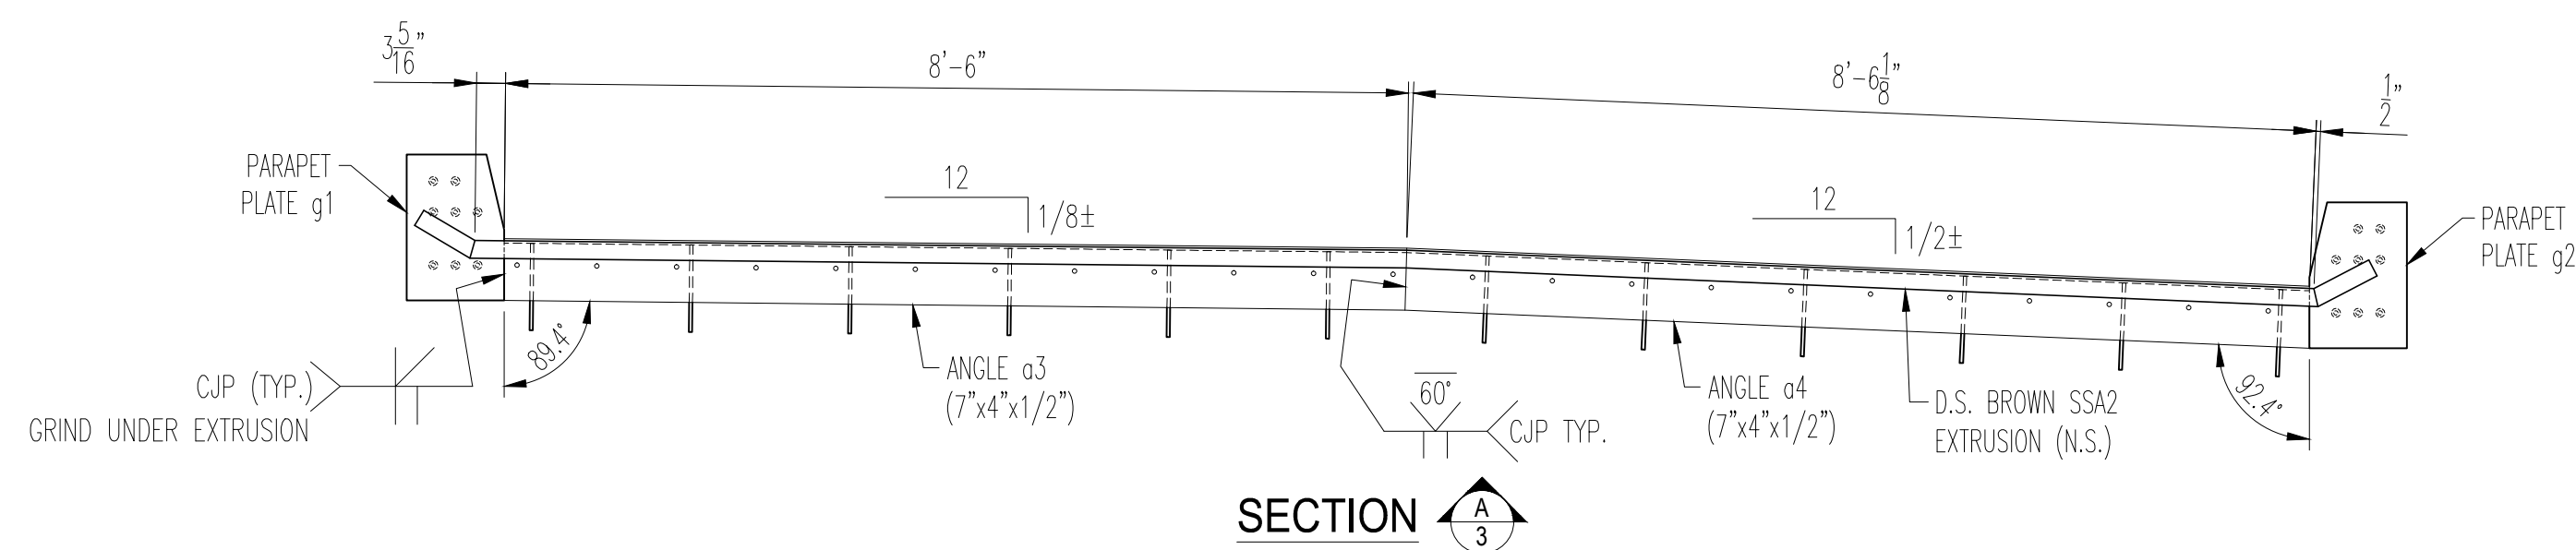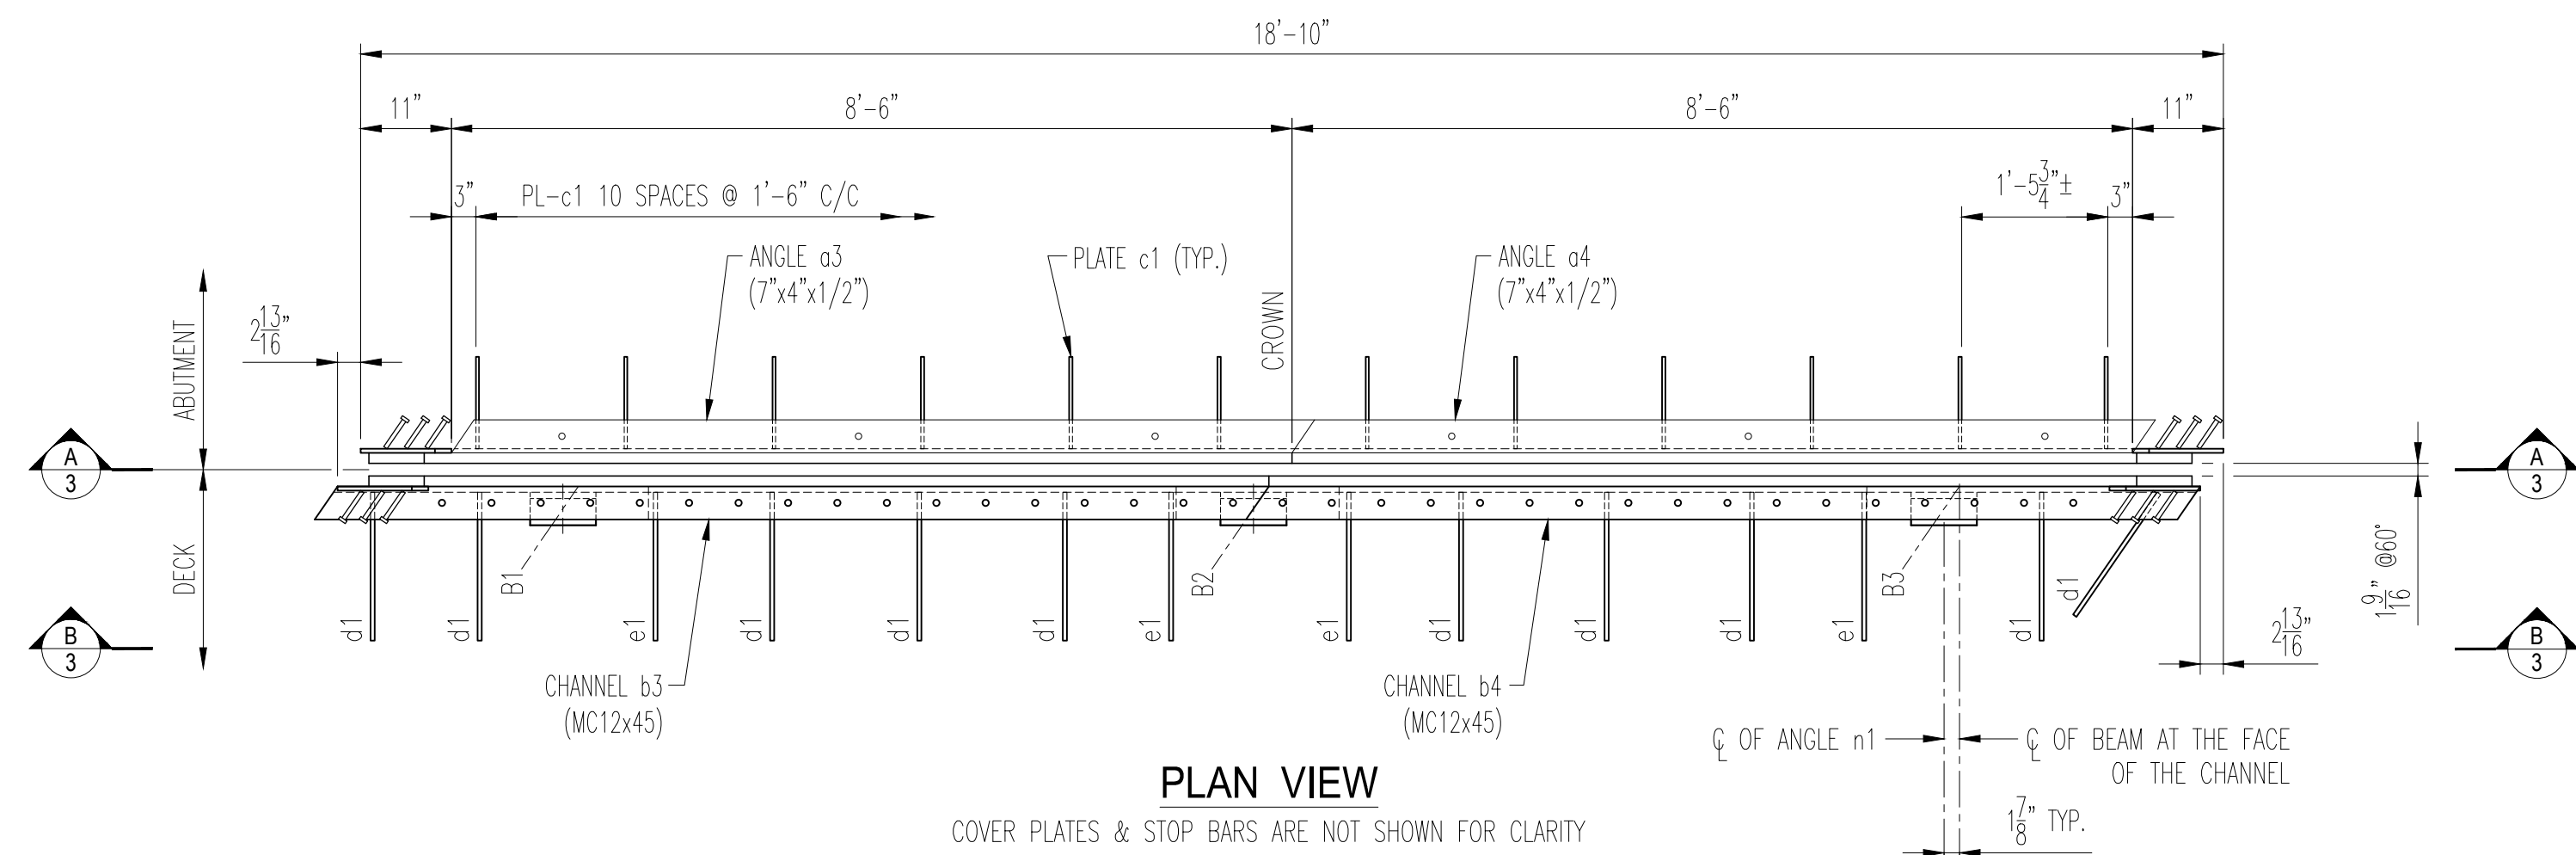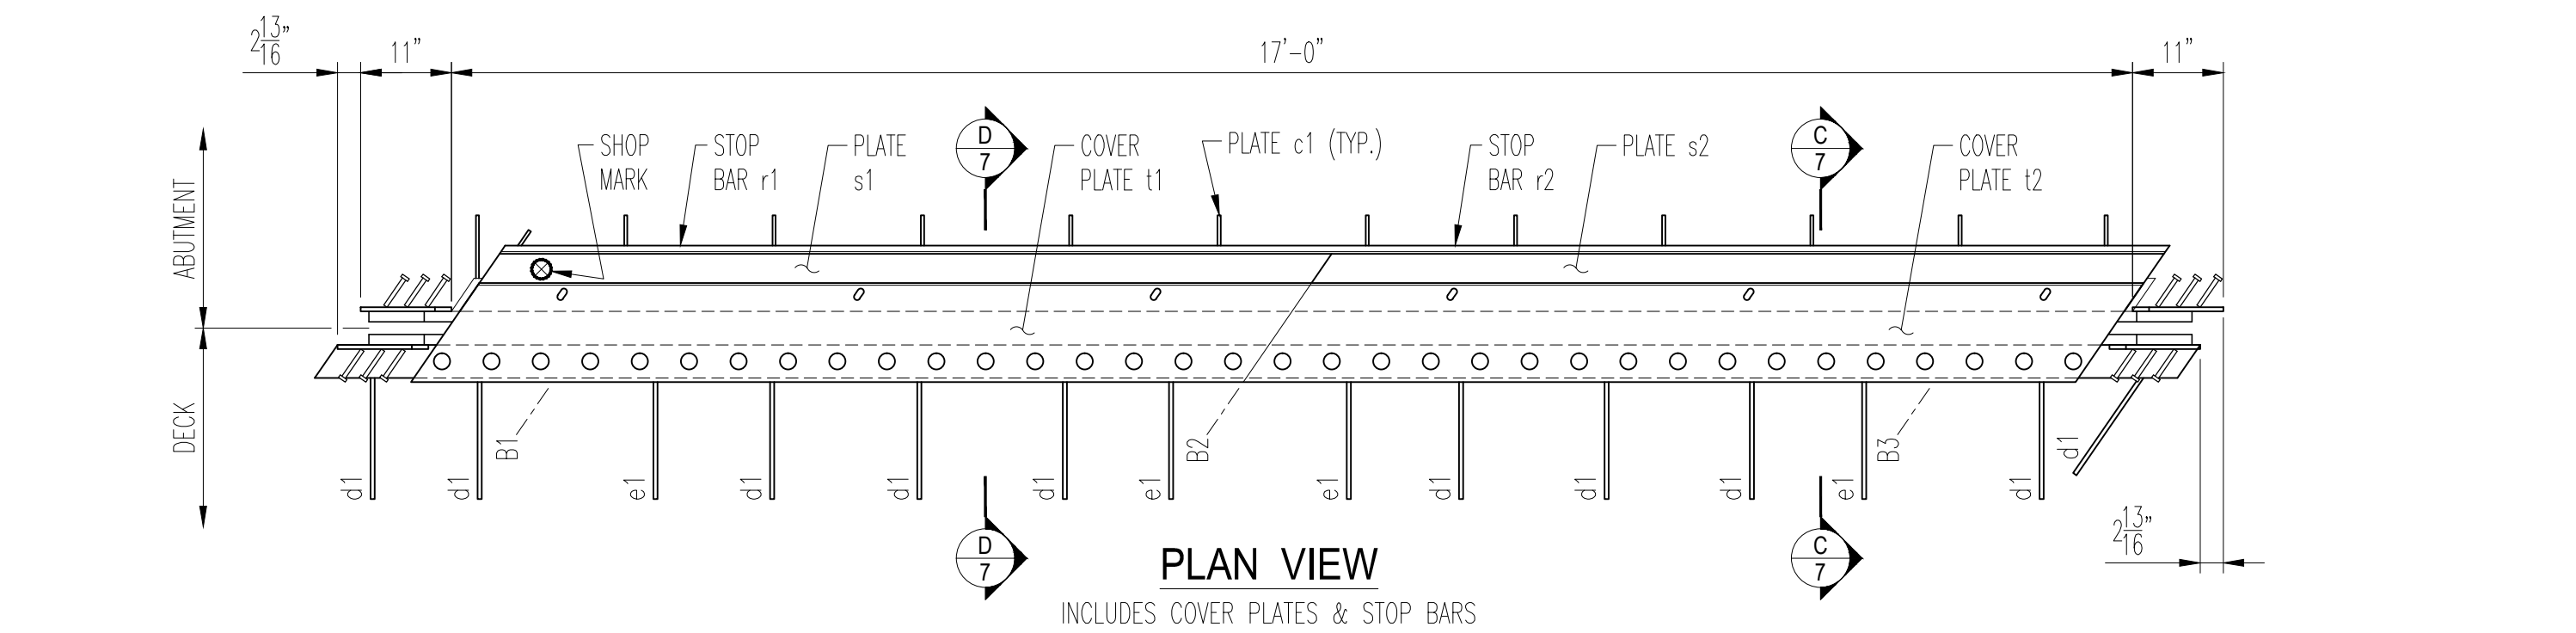

1 - FORWARD EXPANSION JOINT EJ22B

NOTES:
SEE SHEET 1 FOR EXPANSION JOINT LOCATION PLAN
SEE SHEET 5 FOR CHANNEL AND ANGLE DETAILS
SEE SHEET 6 FOR COVER PLATE DETAILS
SEE SHEET 7 FOR EXPANSION JOINT DETAILS & BILL OF MATERIAL

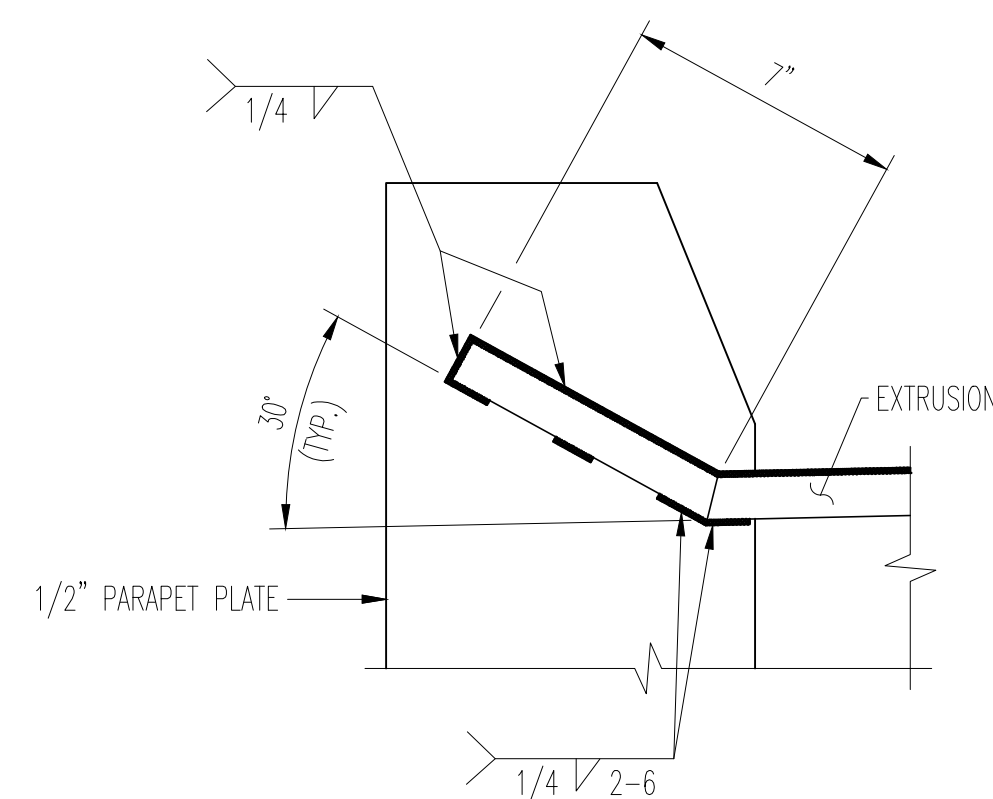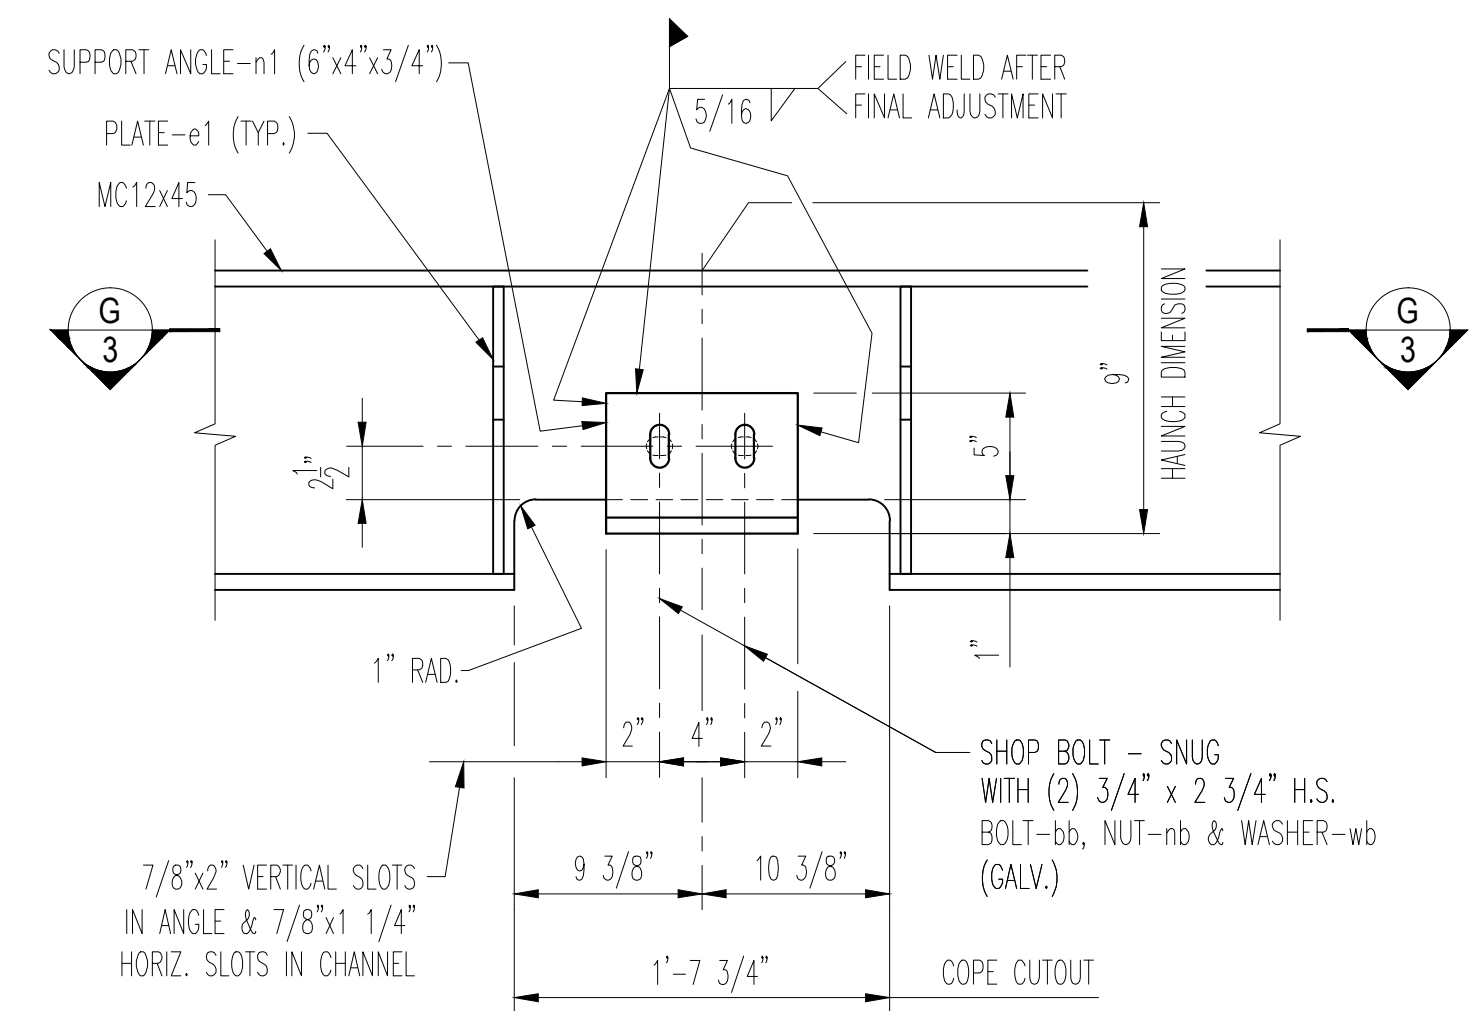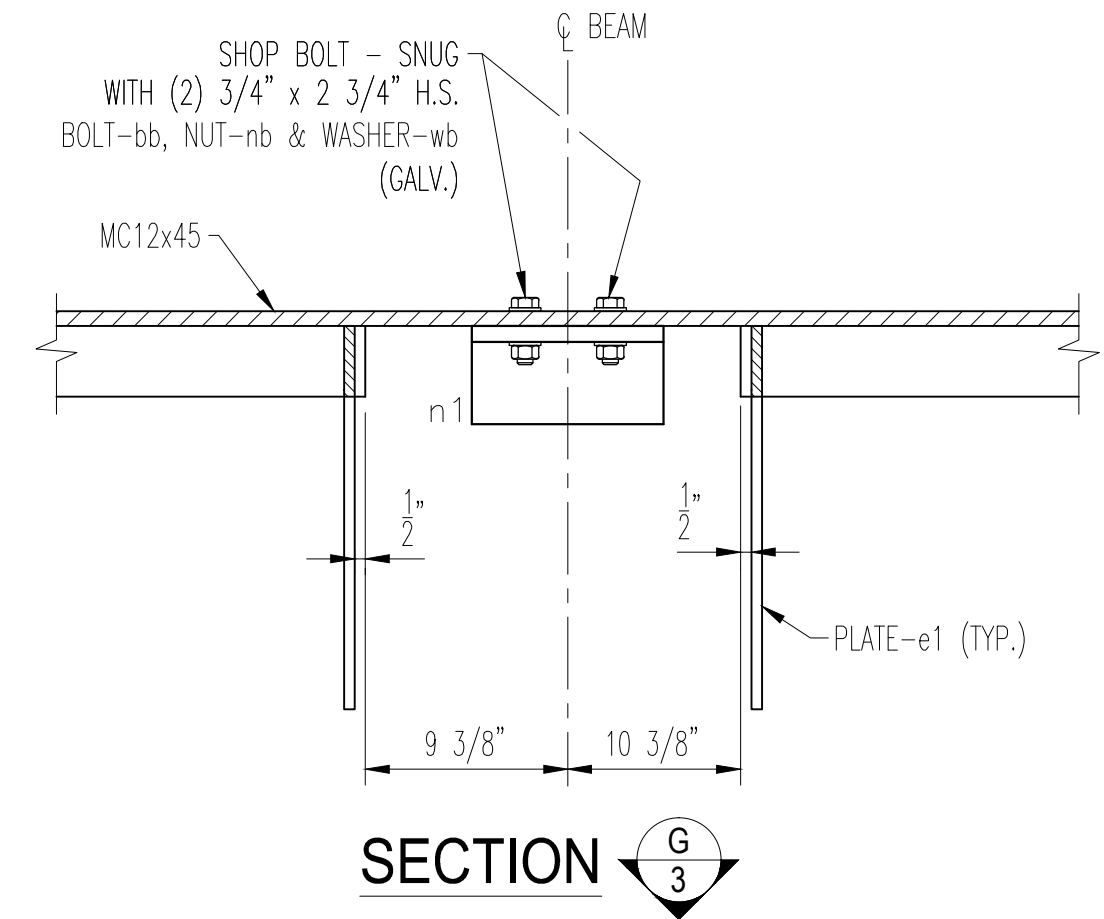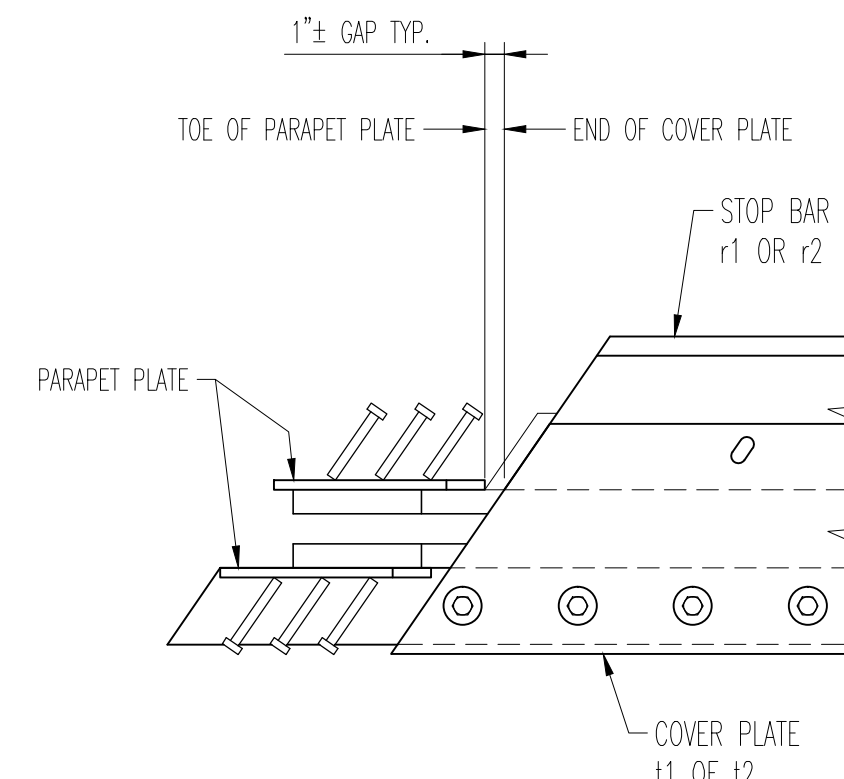

BRIDGE - INTERMEDIATE (MAJOR)
FRACTURE CRITICAL ENDORSEMENT
SOPHISTICATED PAINT ENDORSEMENT

REV. No.	REVISION

SHOP INSPECTED BY:


APPROVAL

KOKOSING CONSTRUCTION
☒ NO EXCEPTIONS TAKEN
☐ MAKE CORRECTIONS AS NOTED
☐ REVISE AND RESUBMIT
☐ REJECTED
☐ FOR INFORMATION ONLY

REVIEW IS FOR GENERAL COMPLIANCE WITH CONTRACT DOCUMENTS
NO RESPONSIBILITY ASSUMED FOR CORRECTNESS OF DIMENSIONS OR DETAILS

BY: mwf DATE: 9/28/2020


PAY LENGTH EXJ22B: 19.33 FT.

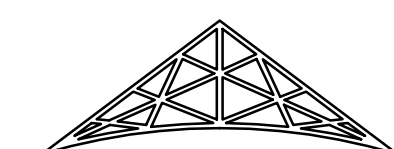


Ohio Structures Inc.
4030 Boardman Canfield Road, Ste. 200 D
Canfield, Ohio 44406
(330) 533-0084 Fax: (330) 533-0191

OHIO DEPARTMENT OF TRANSPORTATION
BRIDGE: CUY-E89ST-4015 (EAST 89TH STREET)
PEDESTRIAN BRIDGE OVER NORFOLK SOUTHERN & GCRTA

SCALE: N.T.S.	DATE: 08/20	Kokosing Construction	DRAWN: JDC
REF NO.: 17 (BU25)	ODOT PROJ. NO.: 173000	CUYAHOGA COUNTY	ITEM NO.: 516
OSI PROJ. NO.: 19-22	PID NO.: 96833	SFN: TBD	DWG. NO.: D2
			3 OF 7

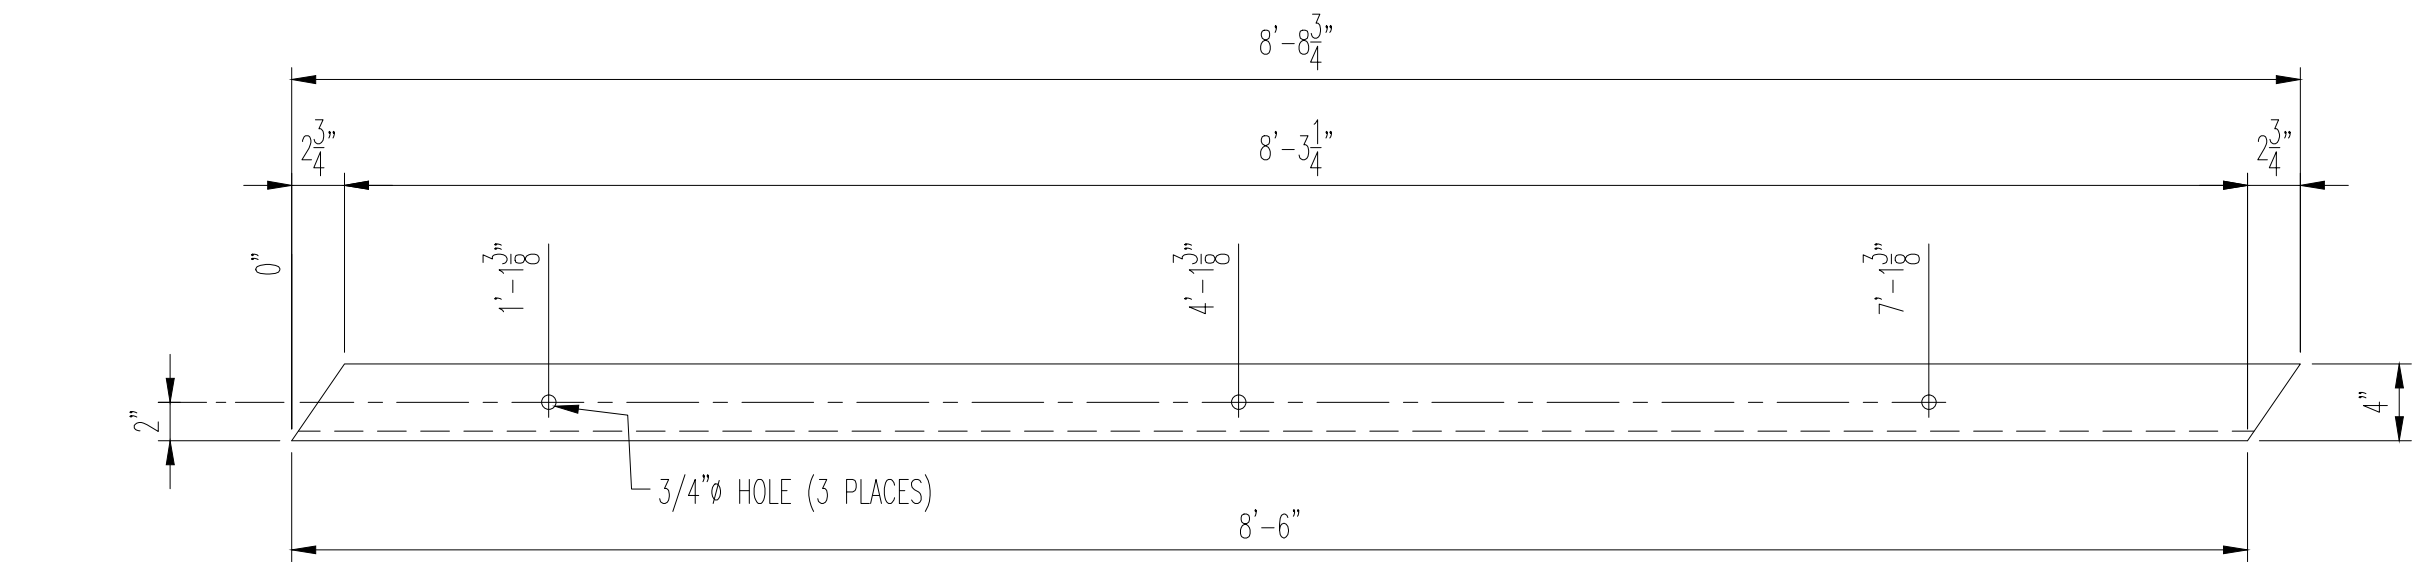


TOP VIEW

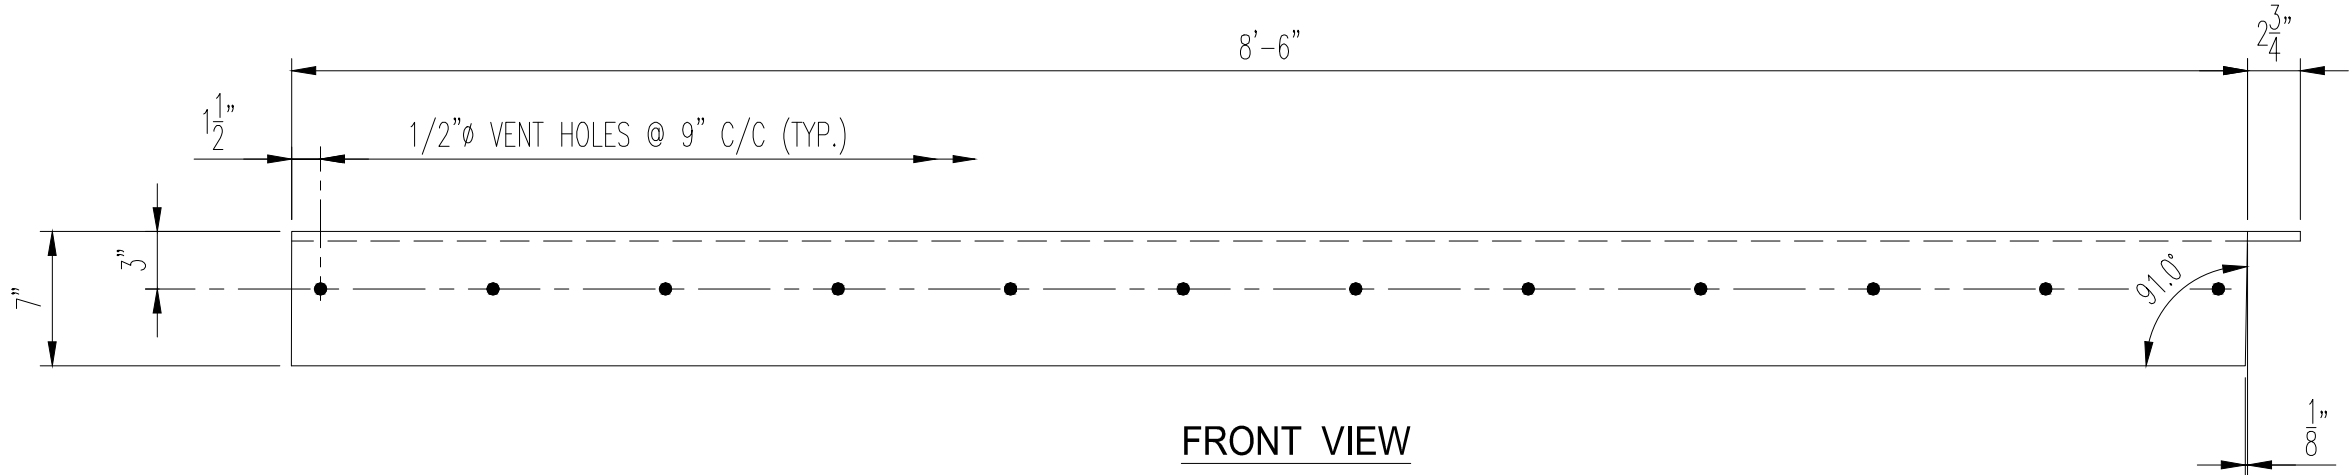


FRONT VIEW

1 - Angle a1

MATERIAL: 7"x4"x1/2" ANGLE

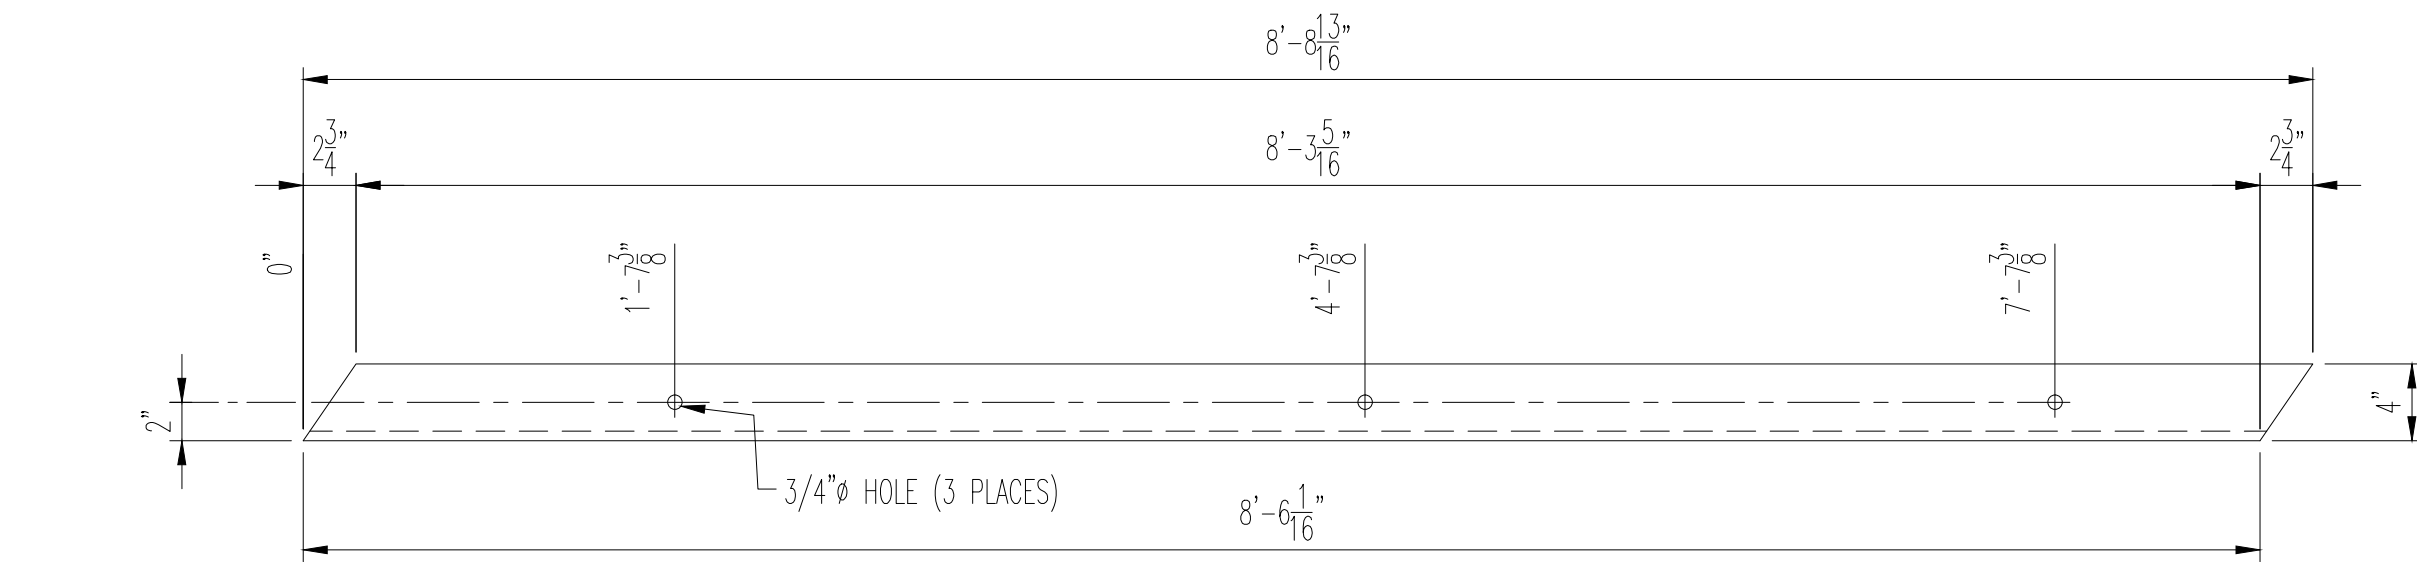

TOP VIEW

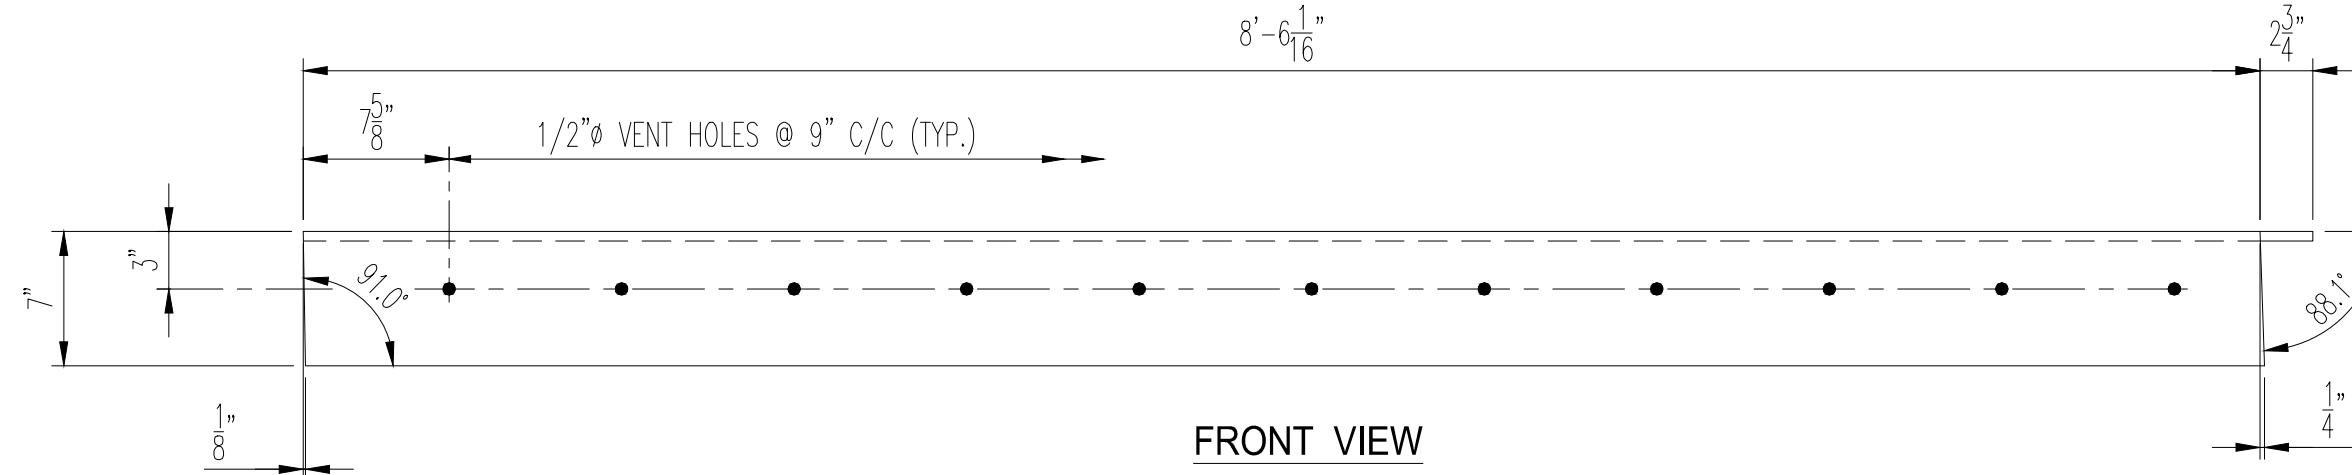


FRONT VIEW

1 - Angle a2


MATERIAL: 7"x4"x1/2" ANGLE

SHOP NOTE:

THE 3/4"Ø HOLES IN THE TOP OF THE CHANNELS & ANGLES MUST MATCH THE HOLE & SLOT LOCATIONS IN THE COVER PLATES t1 & t2 AND PLATES s1, s2, u1 & u2 ON SHEET 6. VERIFY PRIOR TO DRILLING OR MATCH MARK AND DRILL.

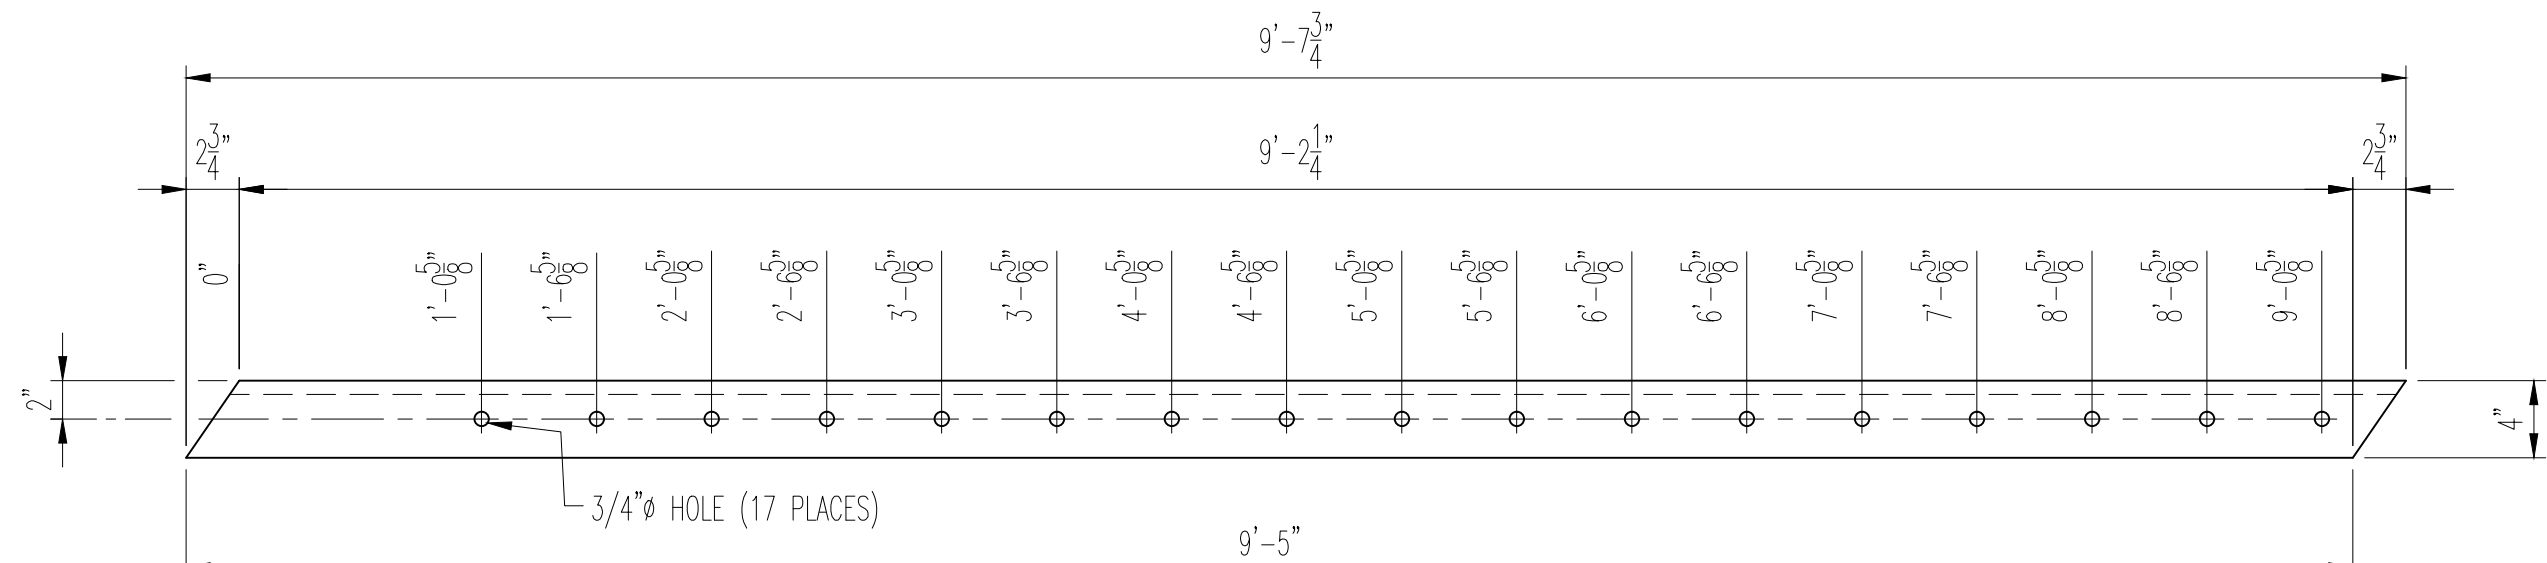


TOP VIEW

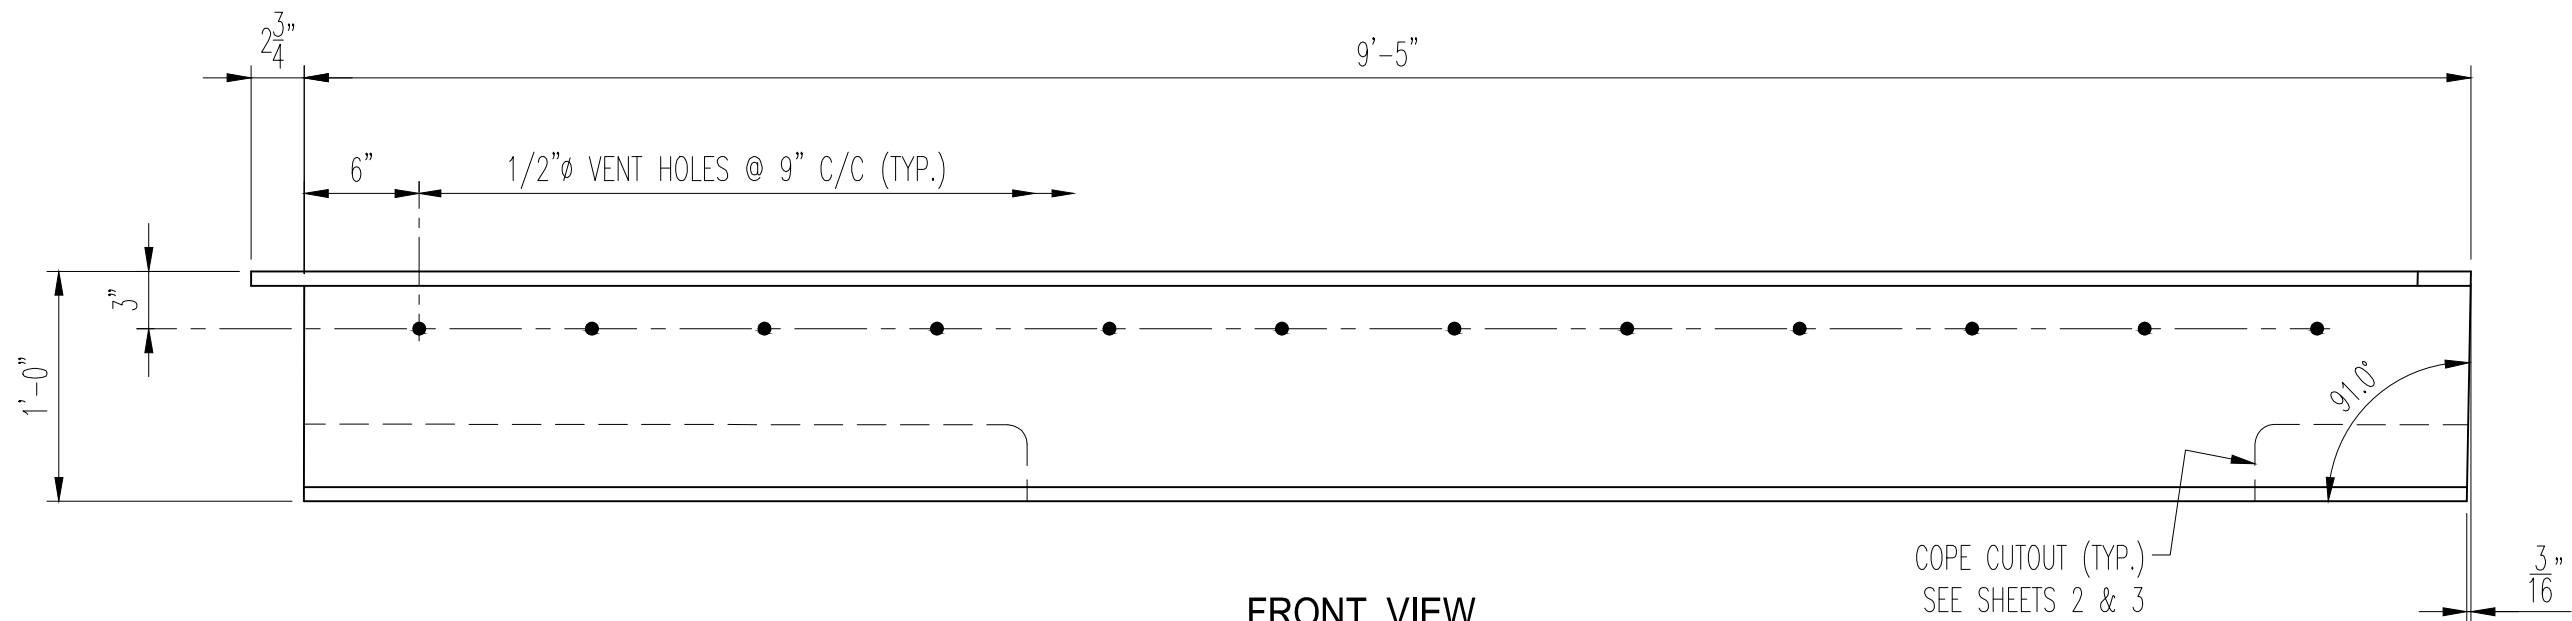


FRONT VIEW

1 - Channel b1

MATERIAL: MC12x45
THE CHANNEL IS SHOWN PRIOR TO COPING

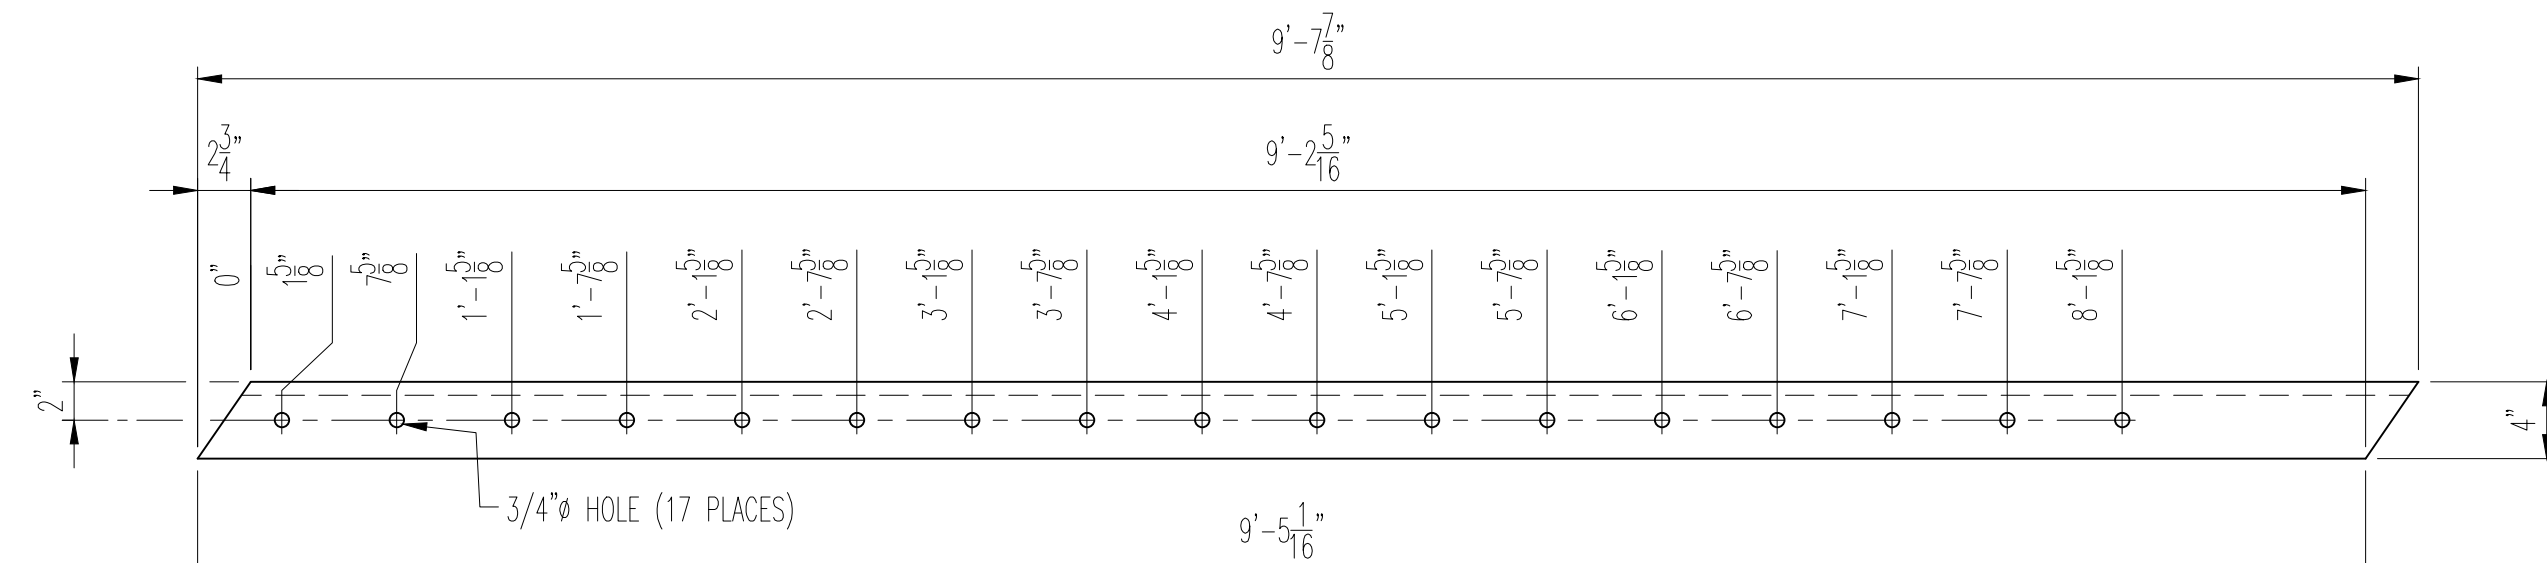

TOP VIEW

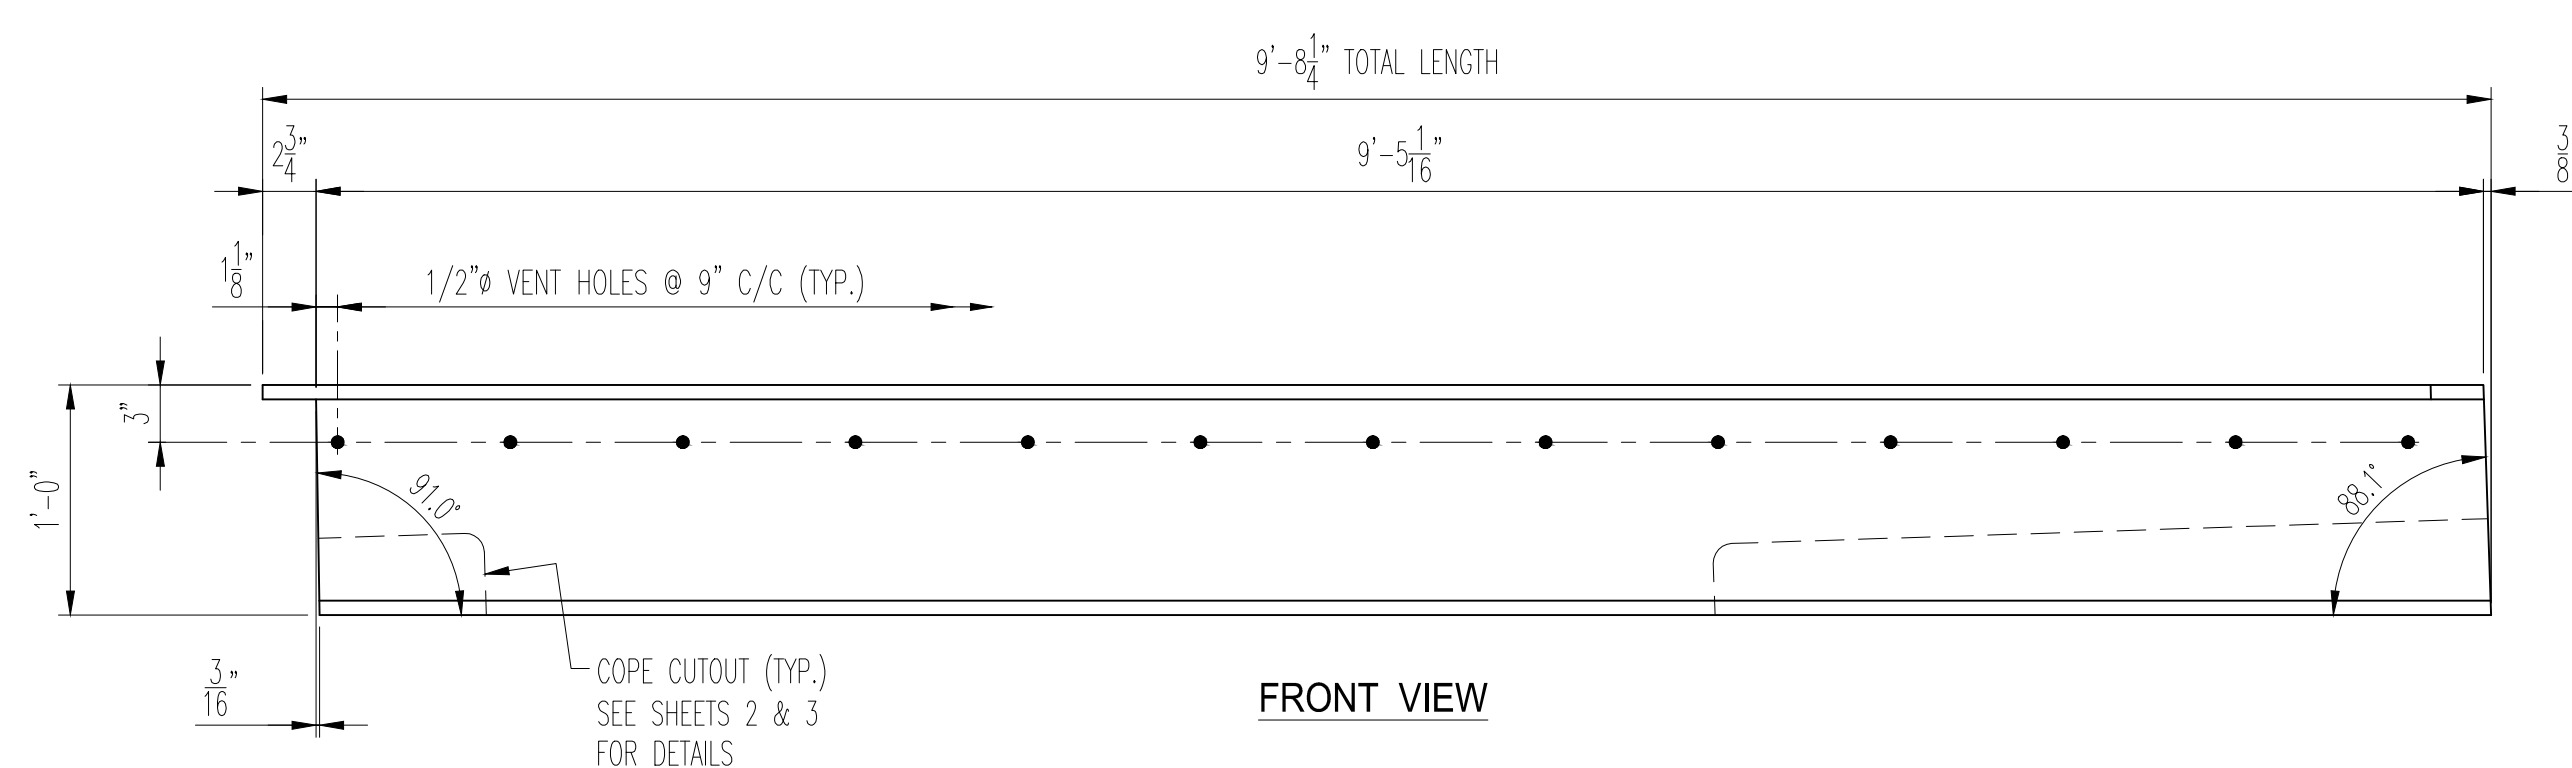

FRONT VIEW

1 - Channel b2

MATERIAL: MC12x45
THE CHANNEL IS SHOWN PRIOR TO COPING

NOTES:

SEE SHEET 2 FOR THE LOCATIONS OF THESE PARTS
SEE SHEET 7 FOR EXPANSION JOINT DETAILS, GENERAL NOTES & BILL OF MATERIAL



AISC
CERTIFIED
FABRICATOR

BRIDGE - INTERMEDIATE (MAJOR)
FRACTURE CRITICAL ENDORSEMENT
SOPHISTICATED PAINT ENDORSEMENT

REV. No.	REVISION

SHOP INSPECTED BY:


APPROVAL

KOKOSING CONSTRUCTION

- ☒ NO EXCEPTIONS TAKEN
- ☐ MAKE CORRECTIONS AS NOTED
- ☐ REVISE AND RESUBMIT
- ☐ REJECTED
- ☐ FOR INFORMATION ONLY

REVIEW IS FOR GENERAL COMPLIANCE WITH CONTRACT DOCUMENTS
NO RESPONSIBILITY ASSUMED FOR CORRECTNESS OF DIMENSIONS OR DETAILS

BY: mwf DATE: 9/28/2020

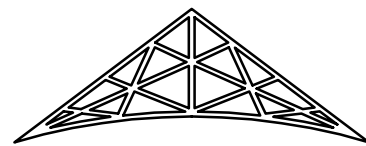


Ohio Structures Inc.


4030 Boardman Canfield Road, Ste. 200 D
Canfield, Ohio 44406
(330) 533-0084 Fax: (330) 533-0191

OHIO DEPARTMENT OF TRANSPORTATION
BRIDGE: CUY-E89ST-4015 (EAST 89TH STREET)
PEDESTRIAN BRIDGE OVER NORFOLK SOUTHERN & GCRTA

SCALE: N.T.S.	Kokosing Construction	DRAWN: JDC
DATE: 08/20	ANGLE & CHANNEL DETAILS (REAR EXPANSION JOINT EJ22A)	CHECK: MI
REF NO.: 17 (BU25)	ODOT PROJ. NO.: 173000	ITEM NO.: 516
OSI PROJ. NO.: 19-22	CUYAHOGA COUNTY	DWG. NO.: D3
PID NO.: 96833	SFN: TBD	4 OF 7

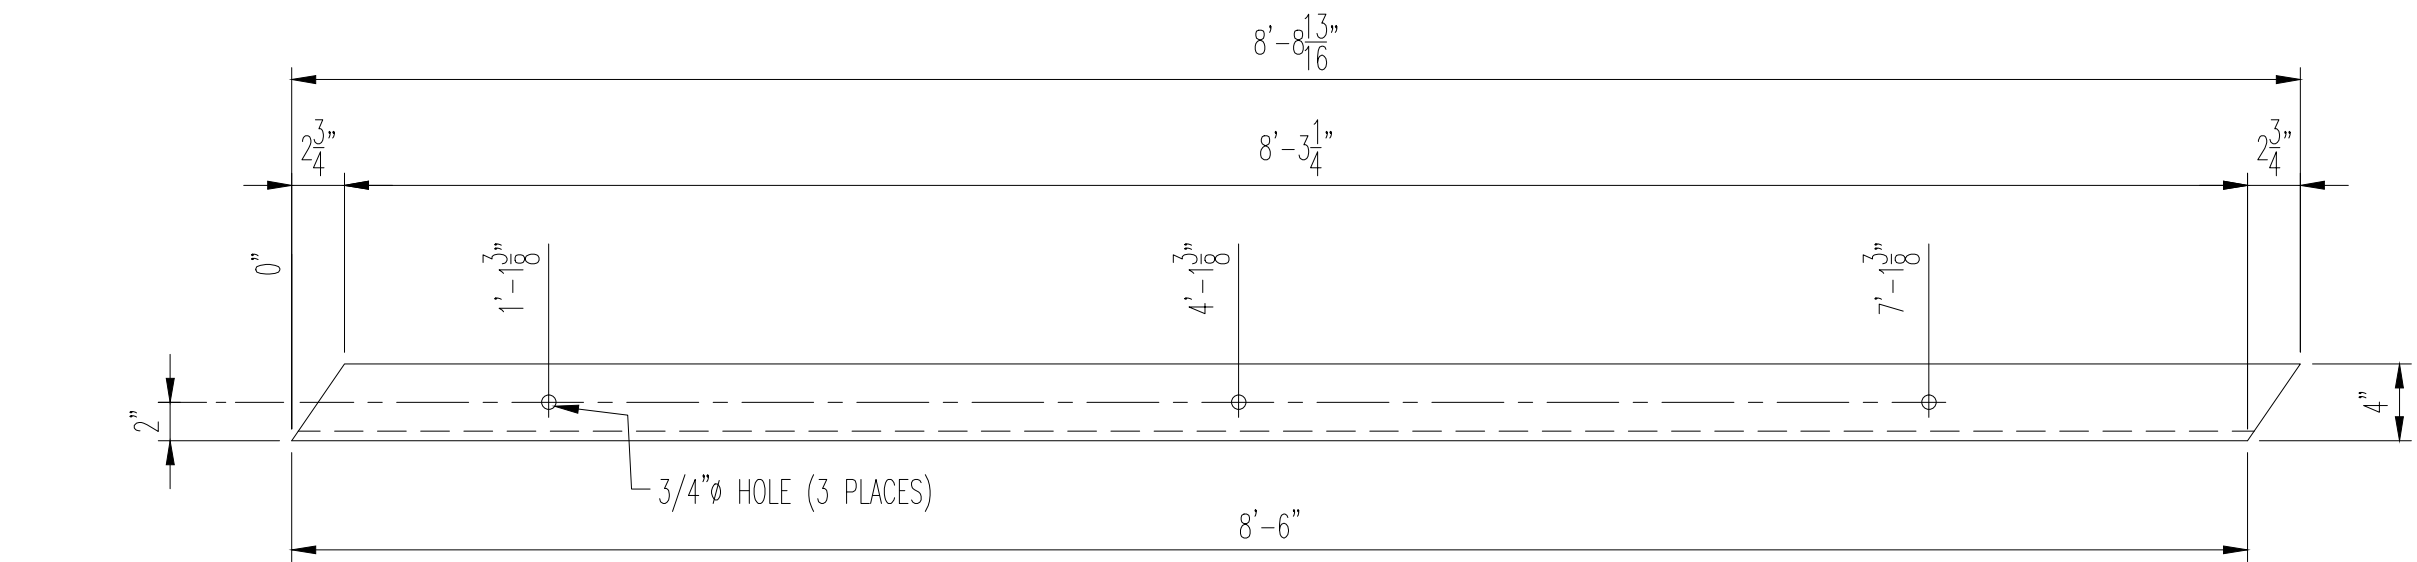


TOP VIEW

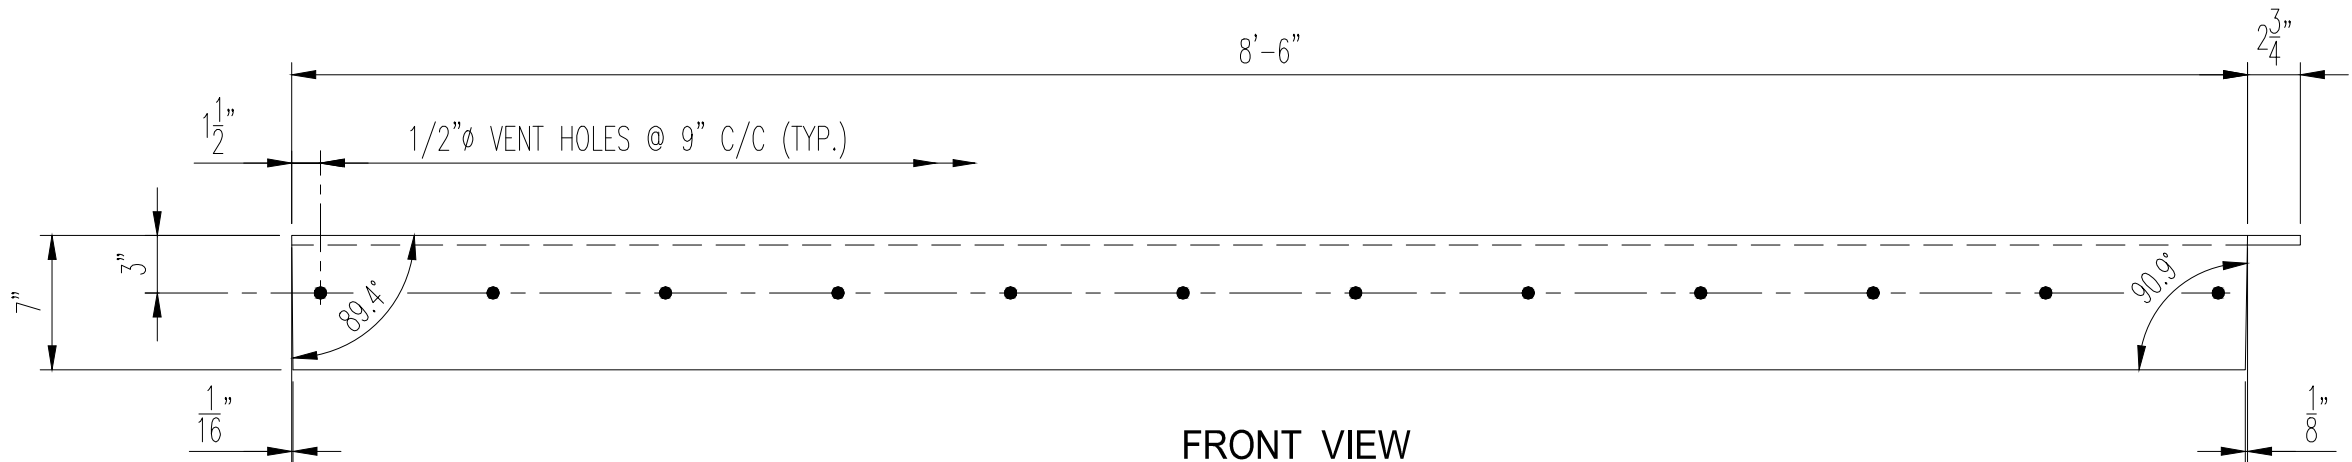


FRONT VIEW

1 - Angle a3

MATERIAL: 7"x4"x1/2" ANGLE

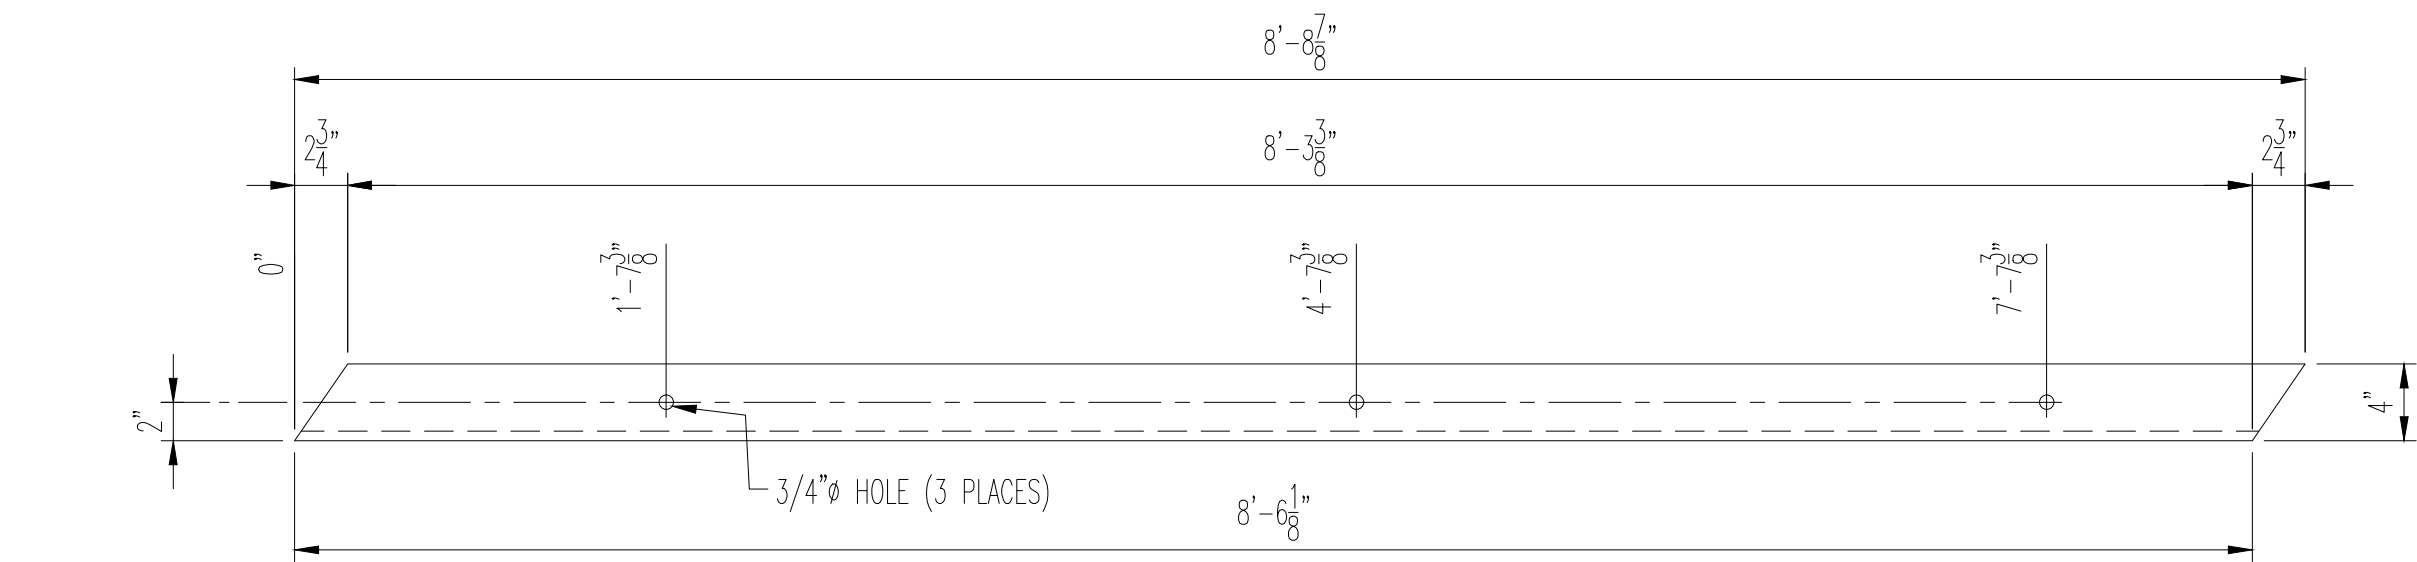

TOP VIEW

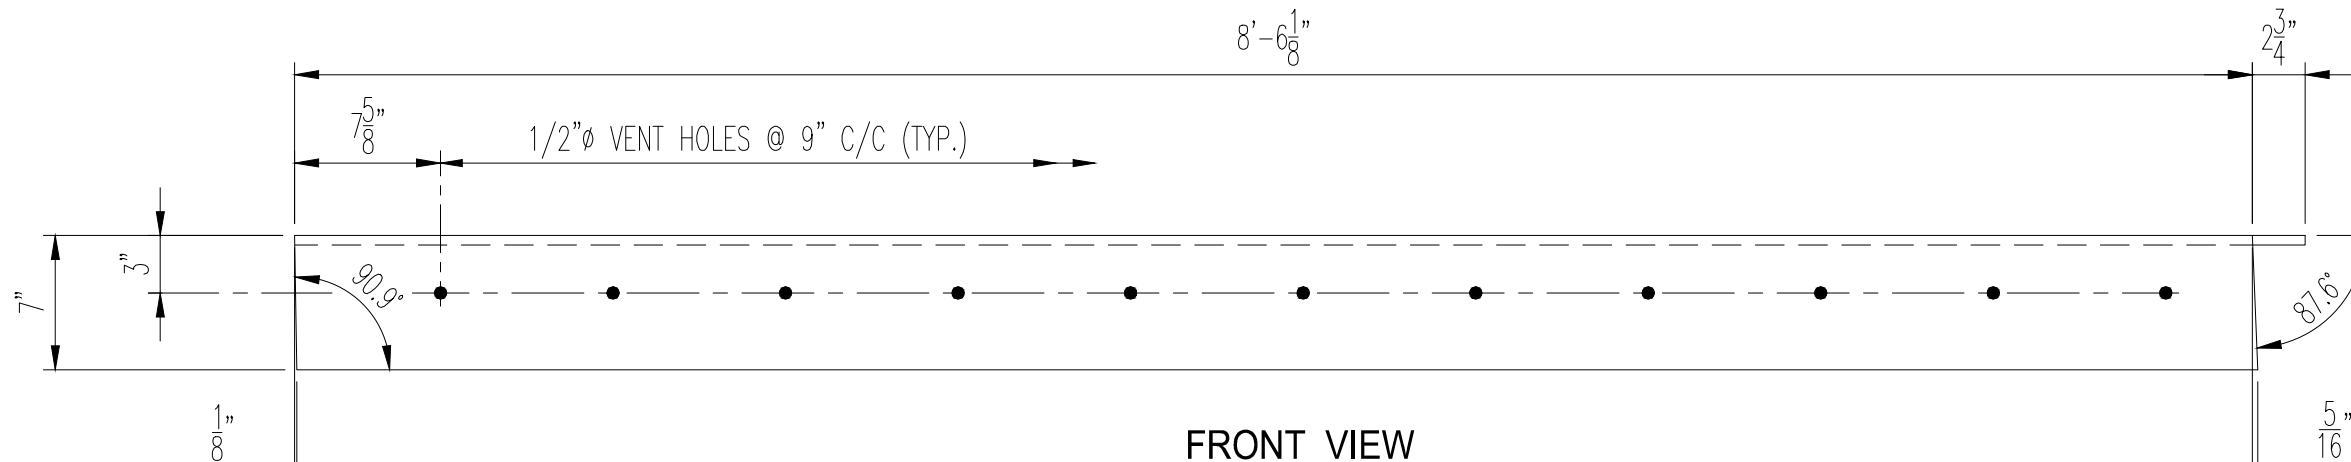


FRONT VIEW

1 - Angle a4


MATERIAL: 7"x4"x1/2" ANGLE

SHOP NOTE:

THE 3/4"Ø HOLES IN THE TOP OF THE CHANNELS & ANGLES MUST MATCH THE HOLE & SLOT LOCATIONS IN THE COVER PLATES t1 & t2 AND PLATES s1, s2, u1 & u2 ON SHEET 6. VERIFY PRIOR TO DRILLING OR MATCH MARK AND DRILL.

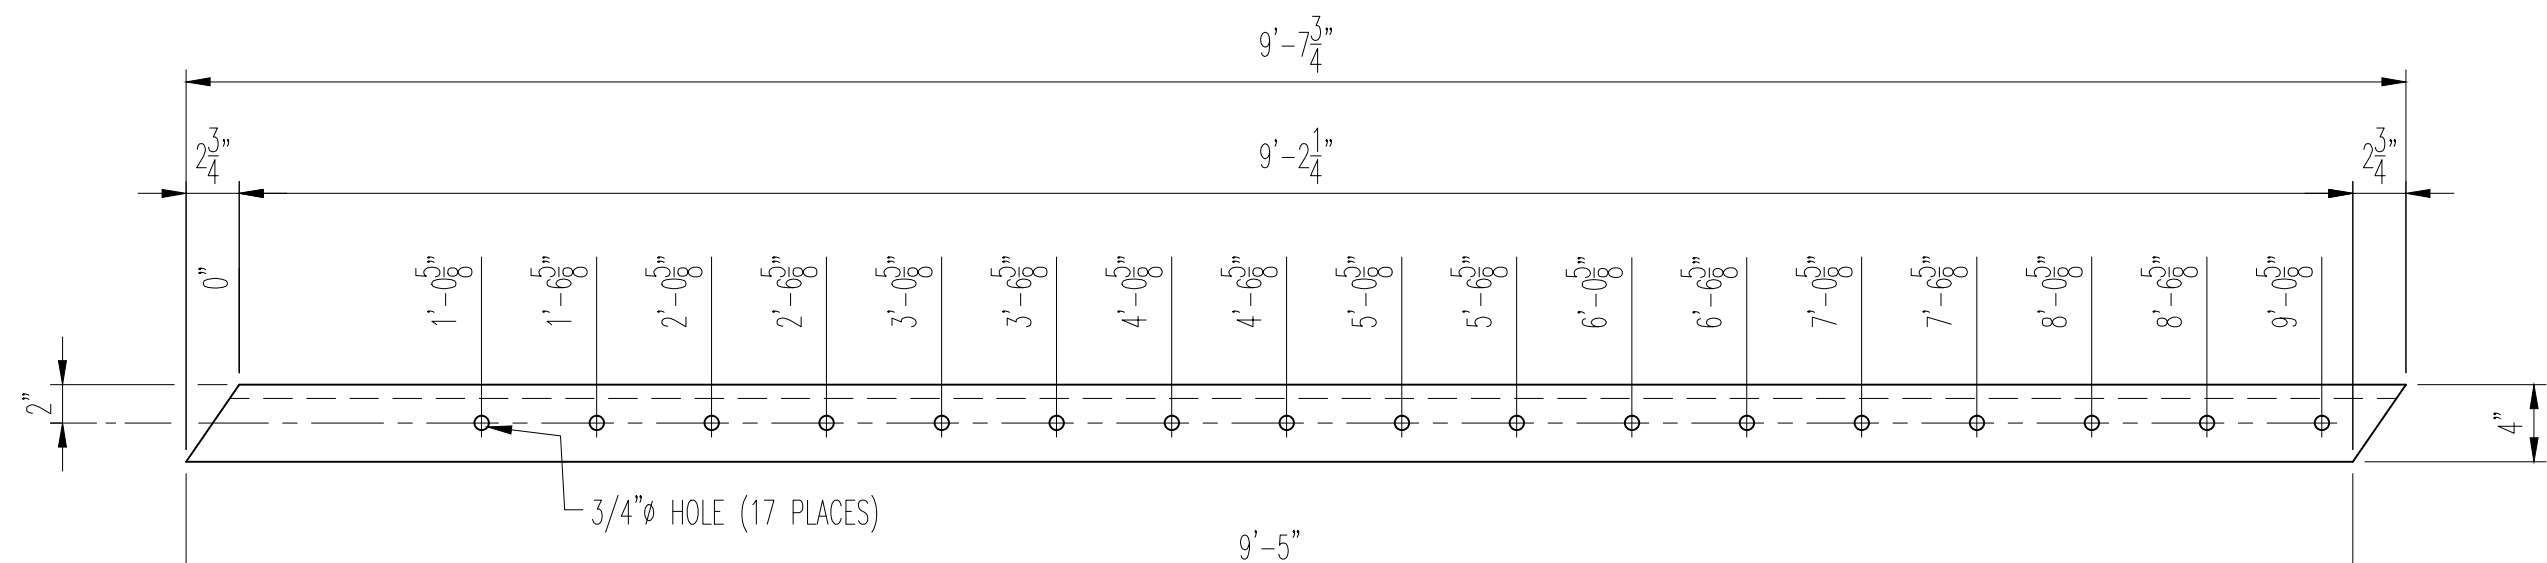


TOP VIEW

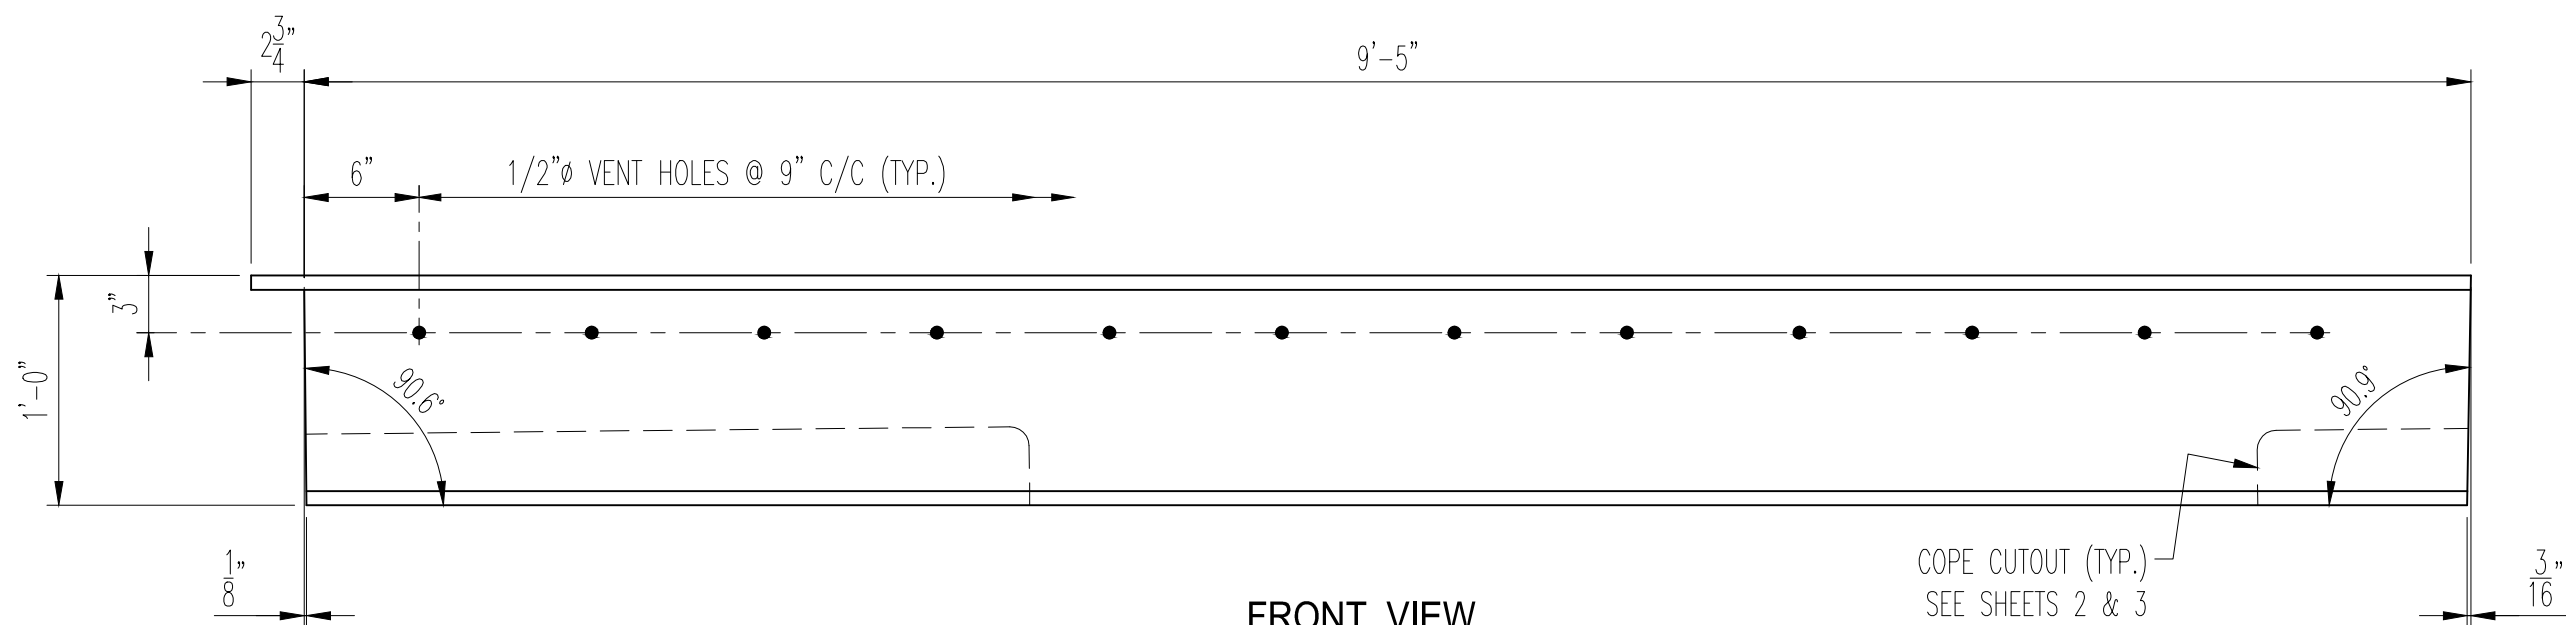


FRONT VIEW

1 - Channel b3

MATERIAL: MC12x45
THE CHANNEL IS SHOWN PRIOR TO COPING

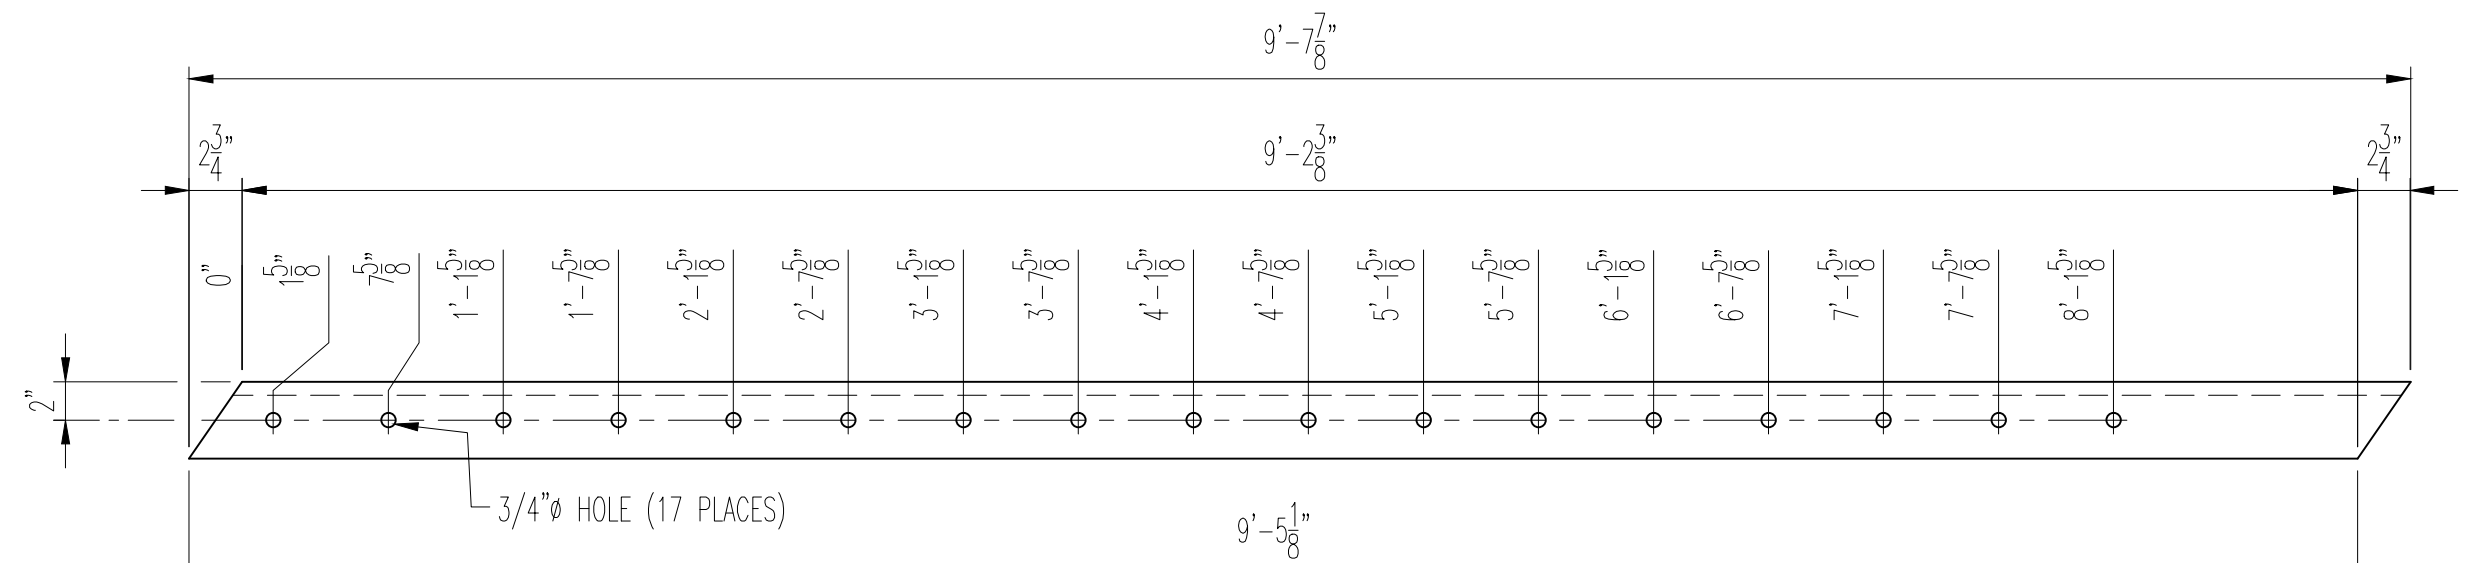

TOP VIEW

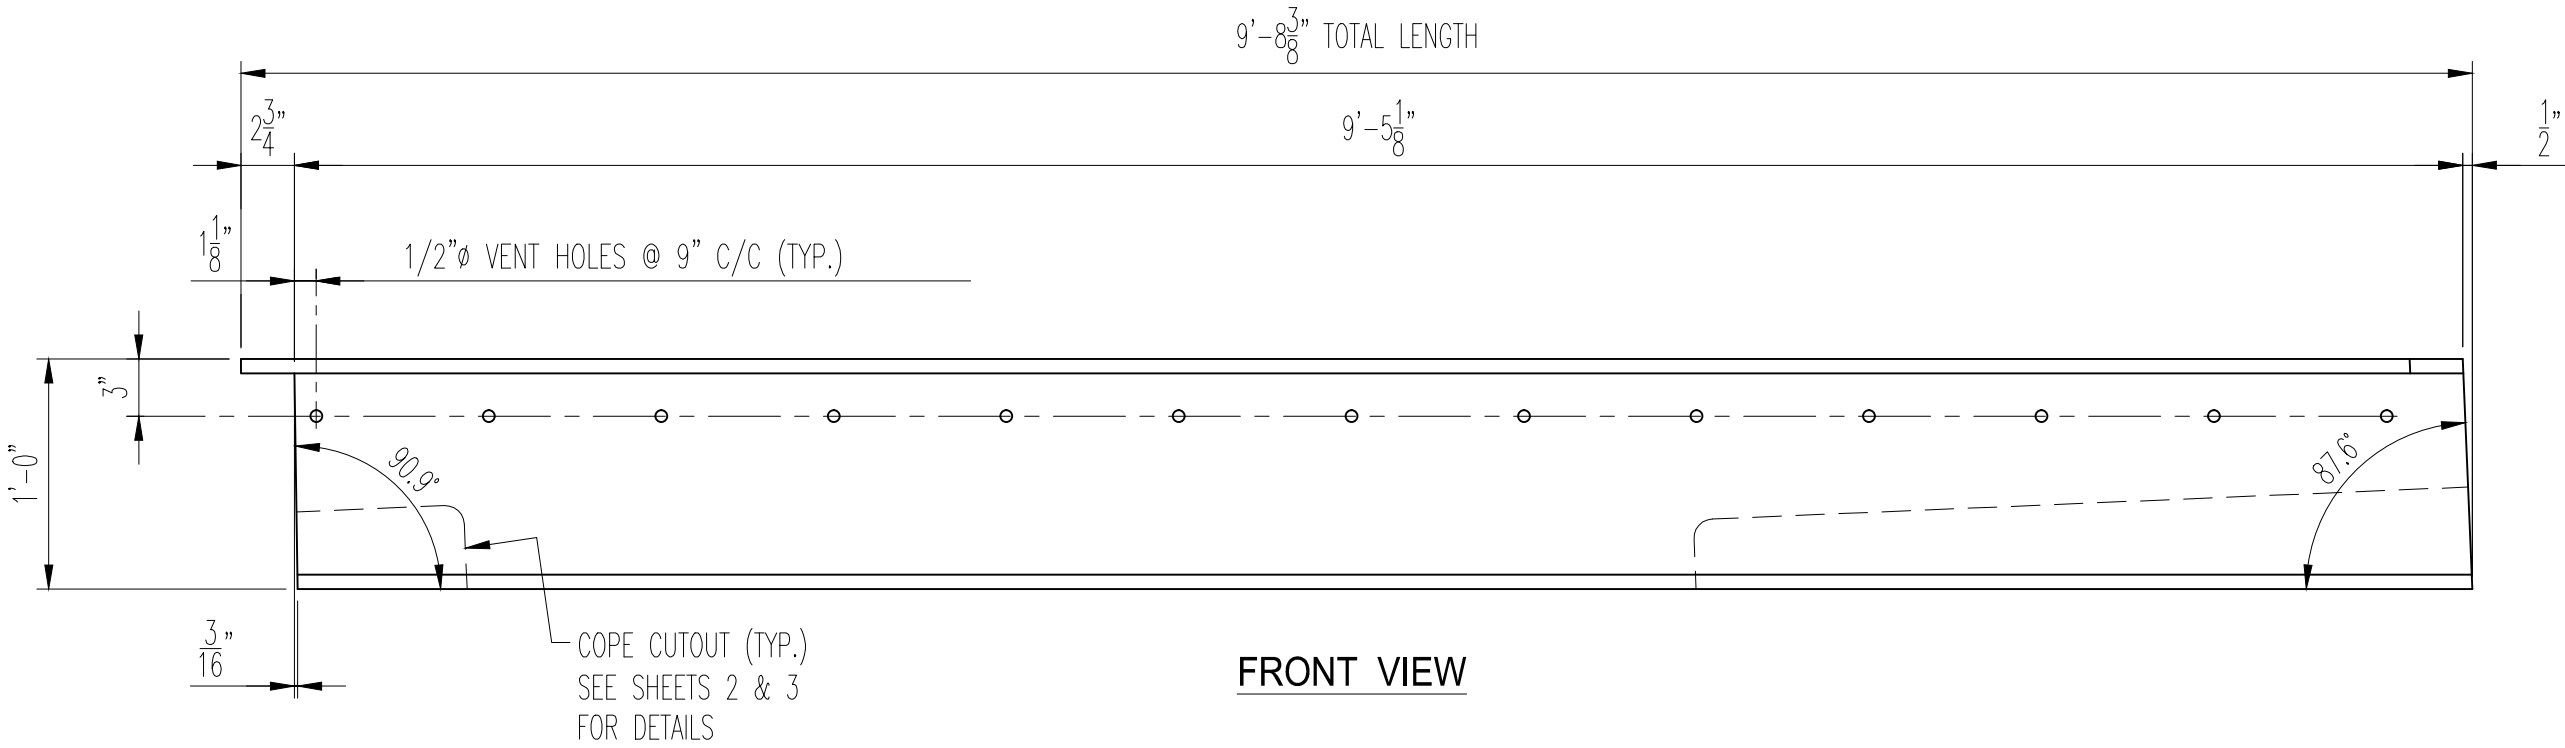

FRONT VIEW

1 - Channel b4

MATERIAL: MC12x45
THE CHANNEL IS SHOWN PRIOR TO COPING

NOTES:

SEE SHEET 3 FOR THE LOCATIONS OF THESE PARTS
SEE SHEET 7 FOR EXPANSION JOINT DETAILS, GENERAL NOTES & BILL OF MATERIAL



AISC
CERTIFIED
FABRICATOR

BRIDGE - INTERMEDIATE (MAJOR)
FRACTURE CRITICAL ENDORSEMENT
SOPHISTICATED PAINT ENDORSEMENT


REV. No.	REVISION
SHOP INSPECTED BY:	

APPROVAL

KOKOSING CONSTRUCTION
☒ NO EXCEPTIONS TAKEN
☐ MAKE CORRECTIONS AS NOTED
☐ REVISE AND RESUBMIT
☐ REJECTED
☐ FOR INFORMATION ONLY

REVIEW IS FOR GENERAL COMPLIANCE WITH CONTRACT DOCUMENTS
NO RESPONSIBILITY ASSUMED FOR CORRECTNESS OF DIMENSIONS OR DETAILS

BY: mwf DATE: 9/28/2020








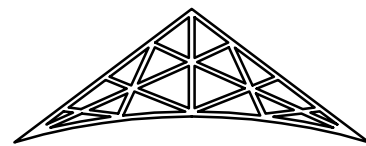


Ohio Structures Inc.

4030 Boardman Canfield Road, Ste. 200 D
Canfield, Ohio 44406
(330) 533-0084 Fax: (330) 533-0191

OHIO DEPARTMENT OF TRANSPORTATION
BRIDGE: CUY-E89ST-4015 (EAST 89TH STREET)
PEDESTRIAN BRIDGE OVER NORFOLK SOUTHERN & GCRTA

SCALE: N.T.S.	Kokosing Construction		DRAWN: JDC
DATE: 08/20	ANGLE & CHANNEL DETAILS (FORWARD EXPANSION JOINT EJ22B)		CHECK: MI
REF NO.: 17 (BU25)	ITEM NO.: 516		
ODOT PROJ. NO.: 173000	CUYAHOGA COUNTY		DWG. NO.: D4
OSI PROJ. NO.: 19-22	PID NO.: 96833	SFN: TBD	5 OF 7

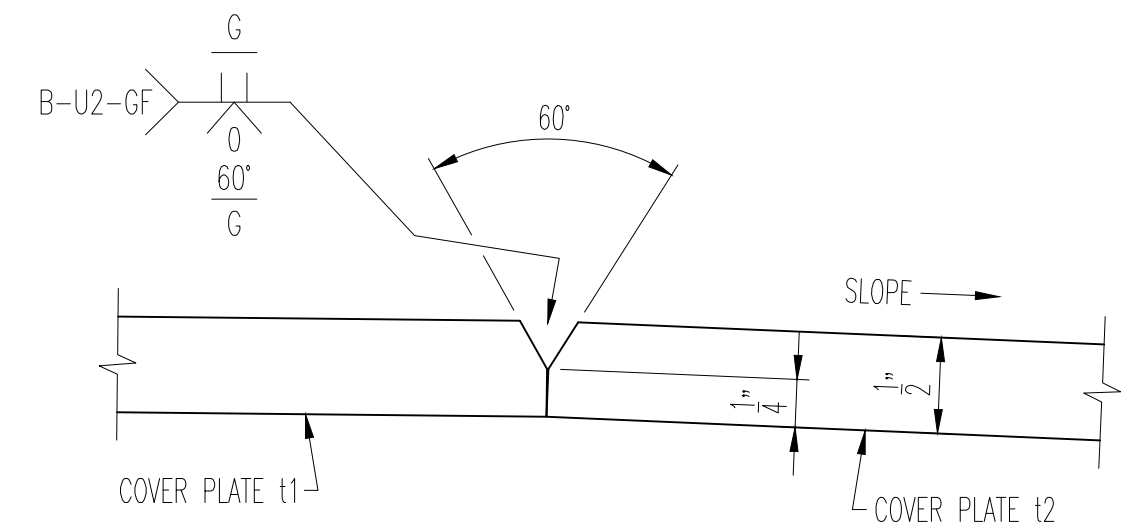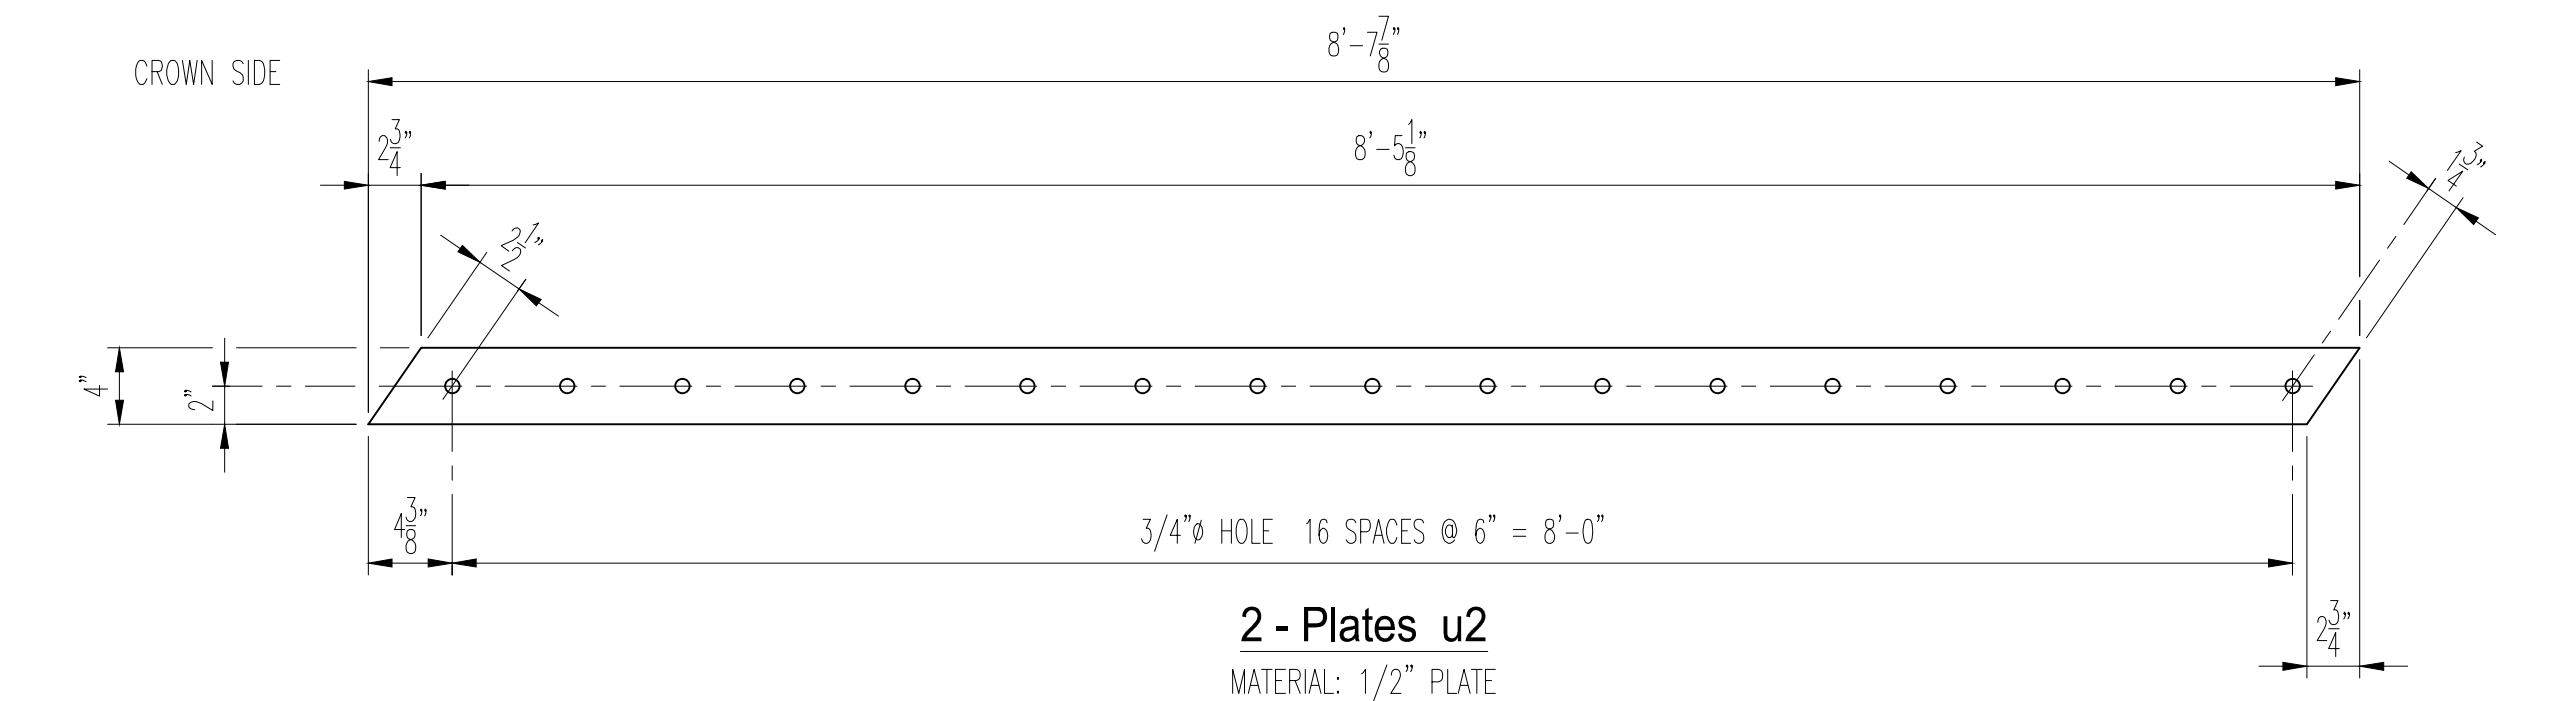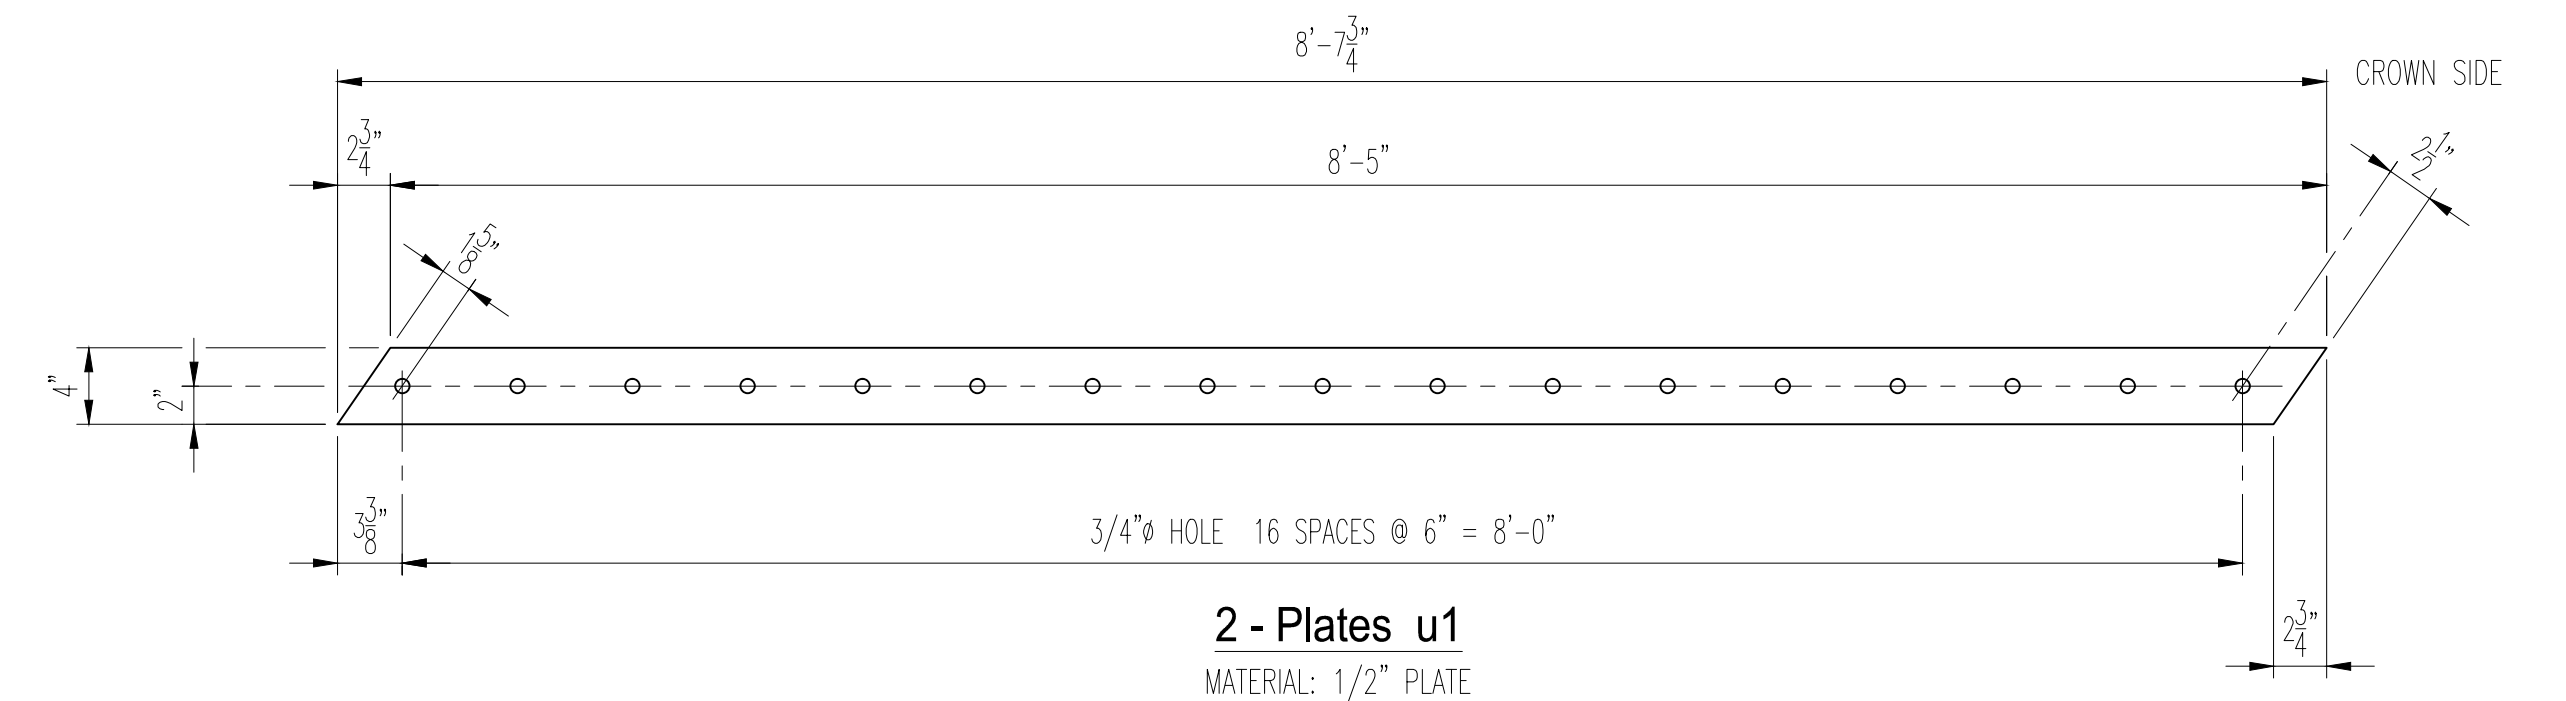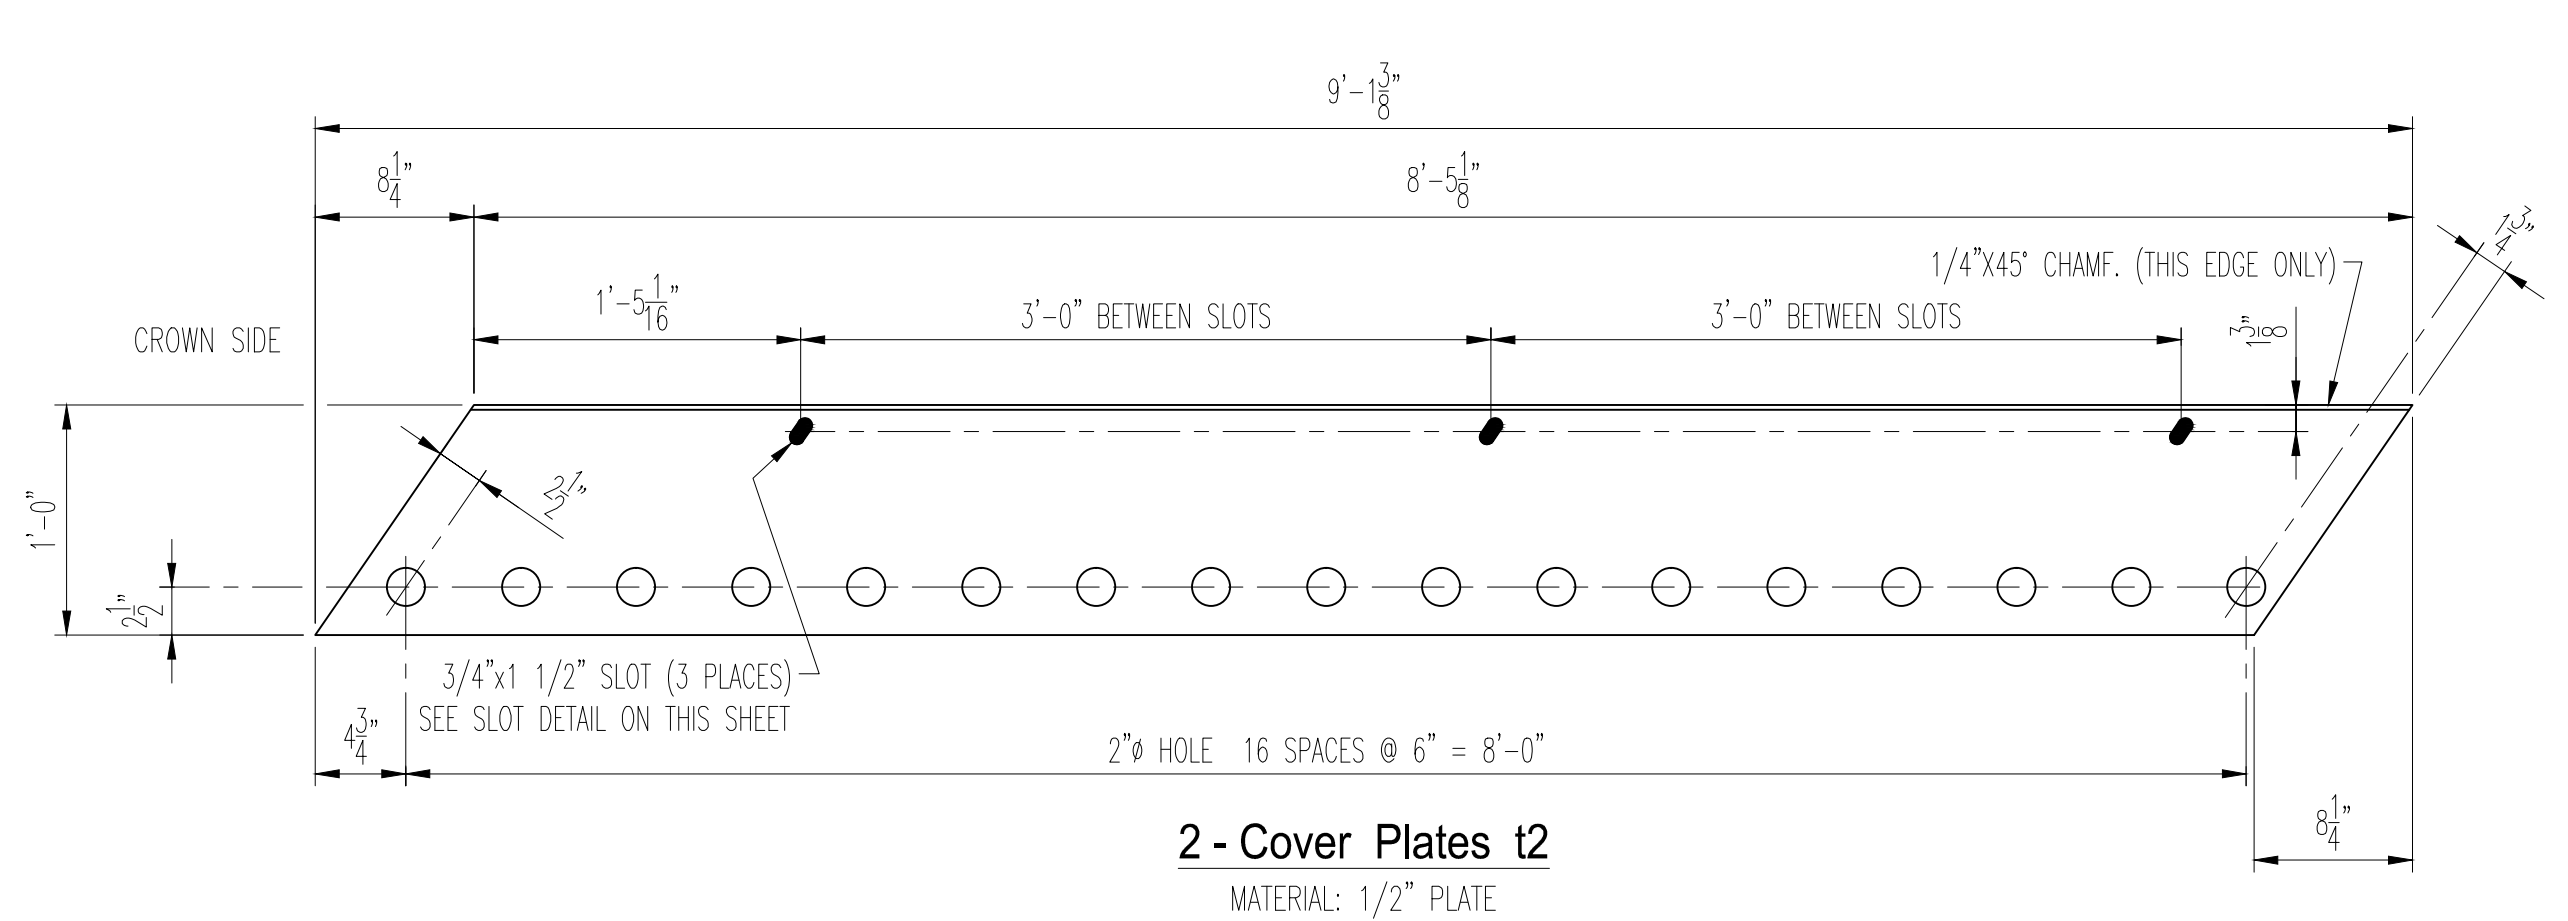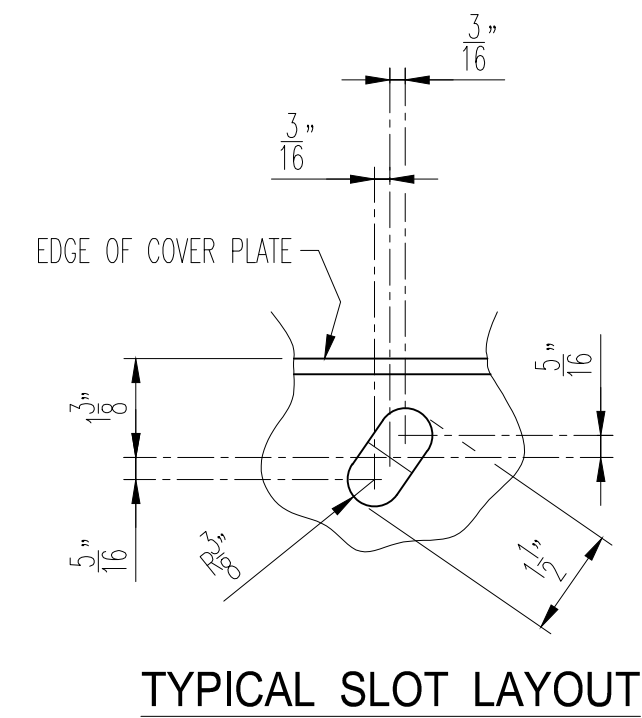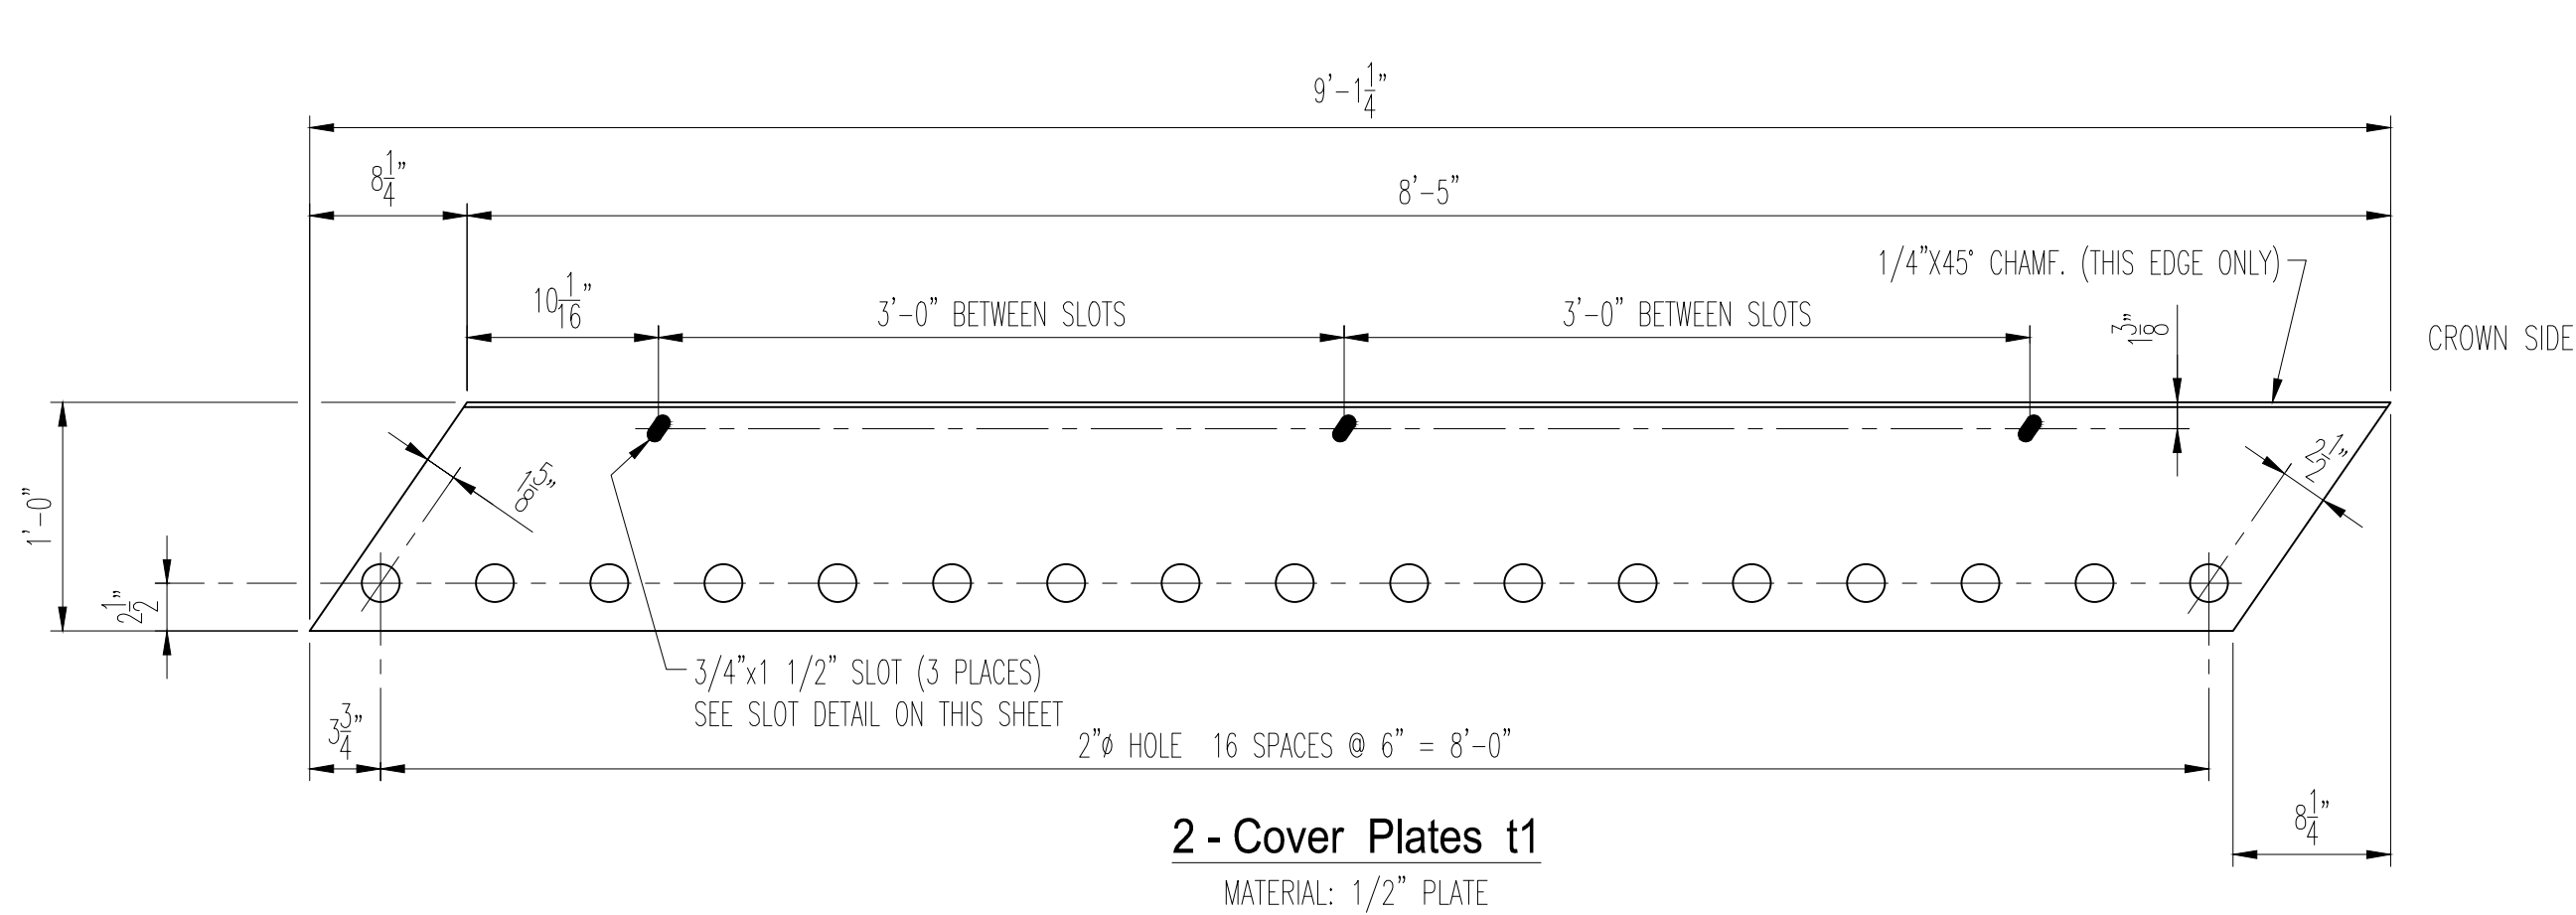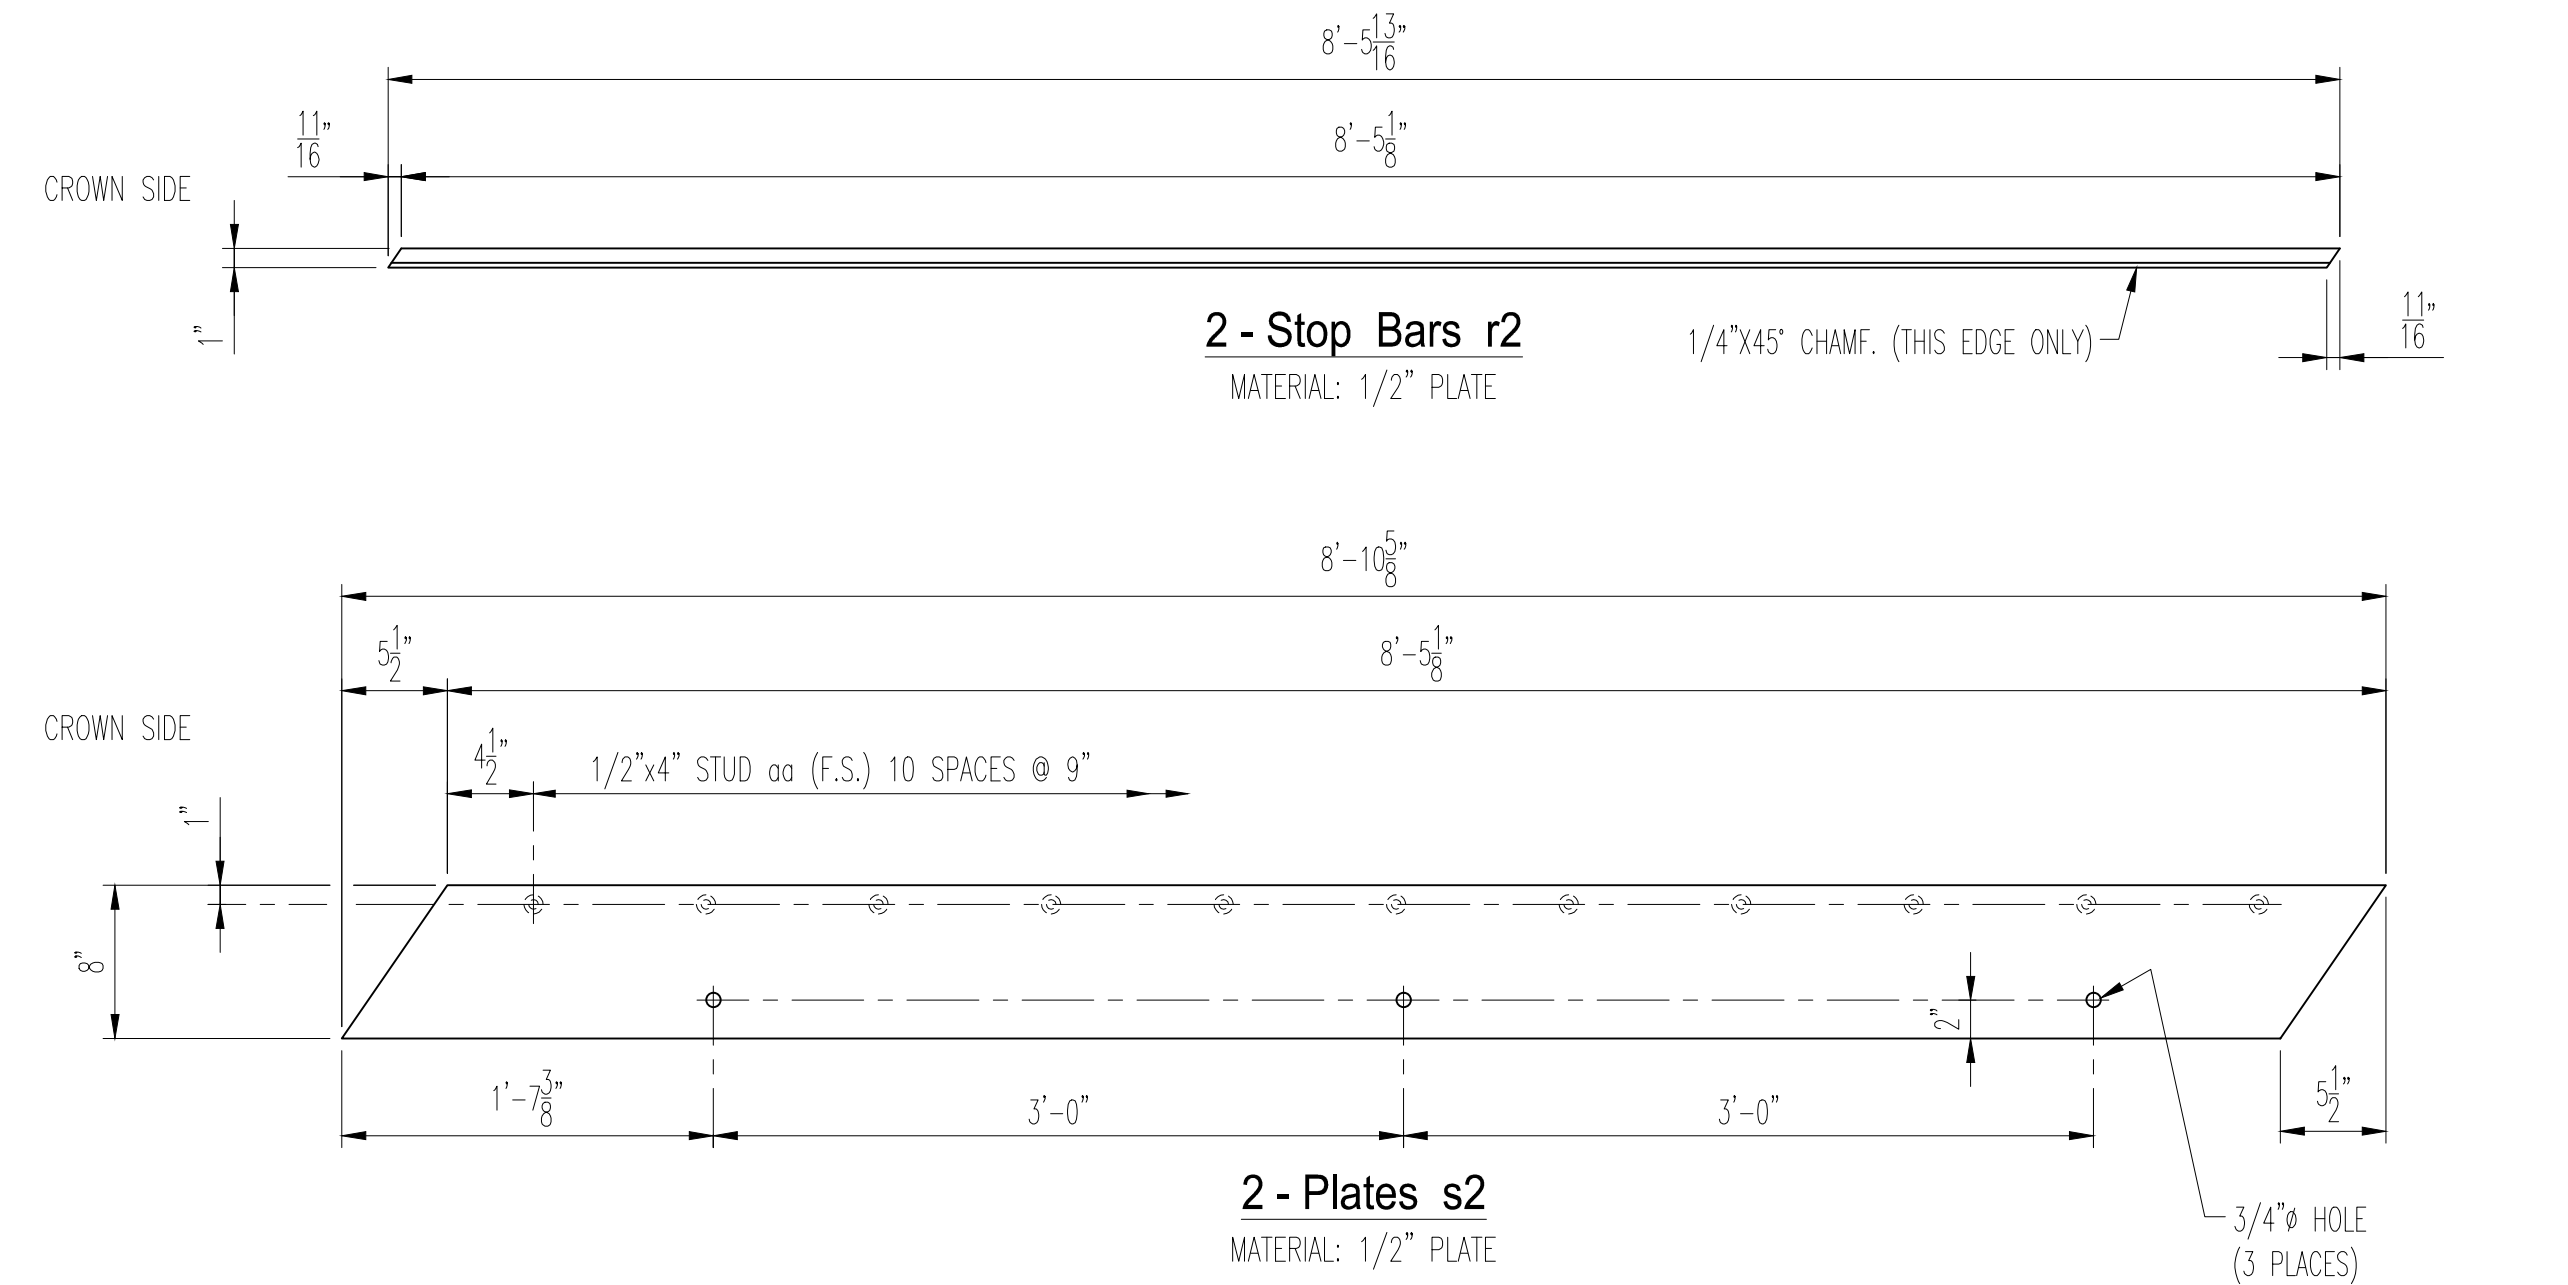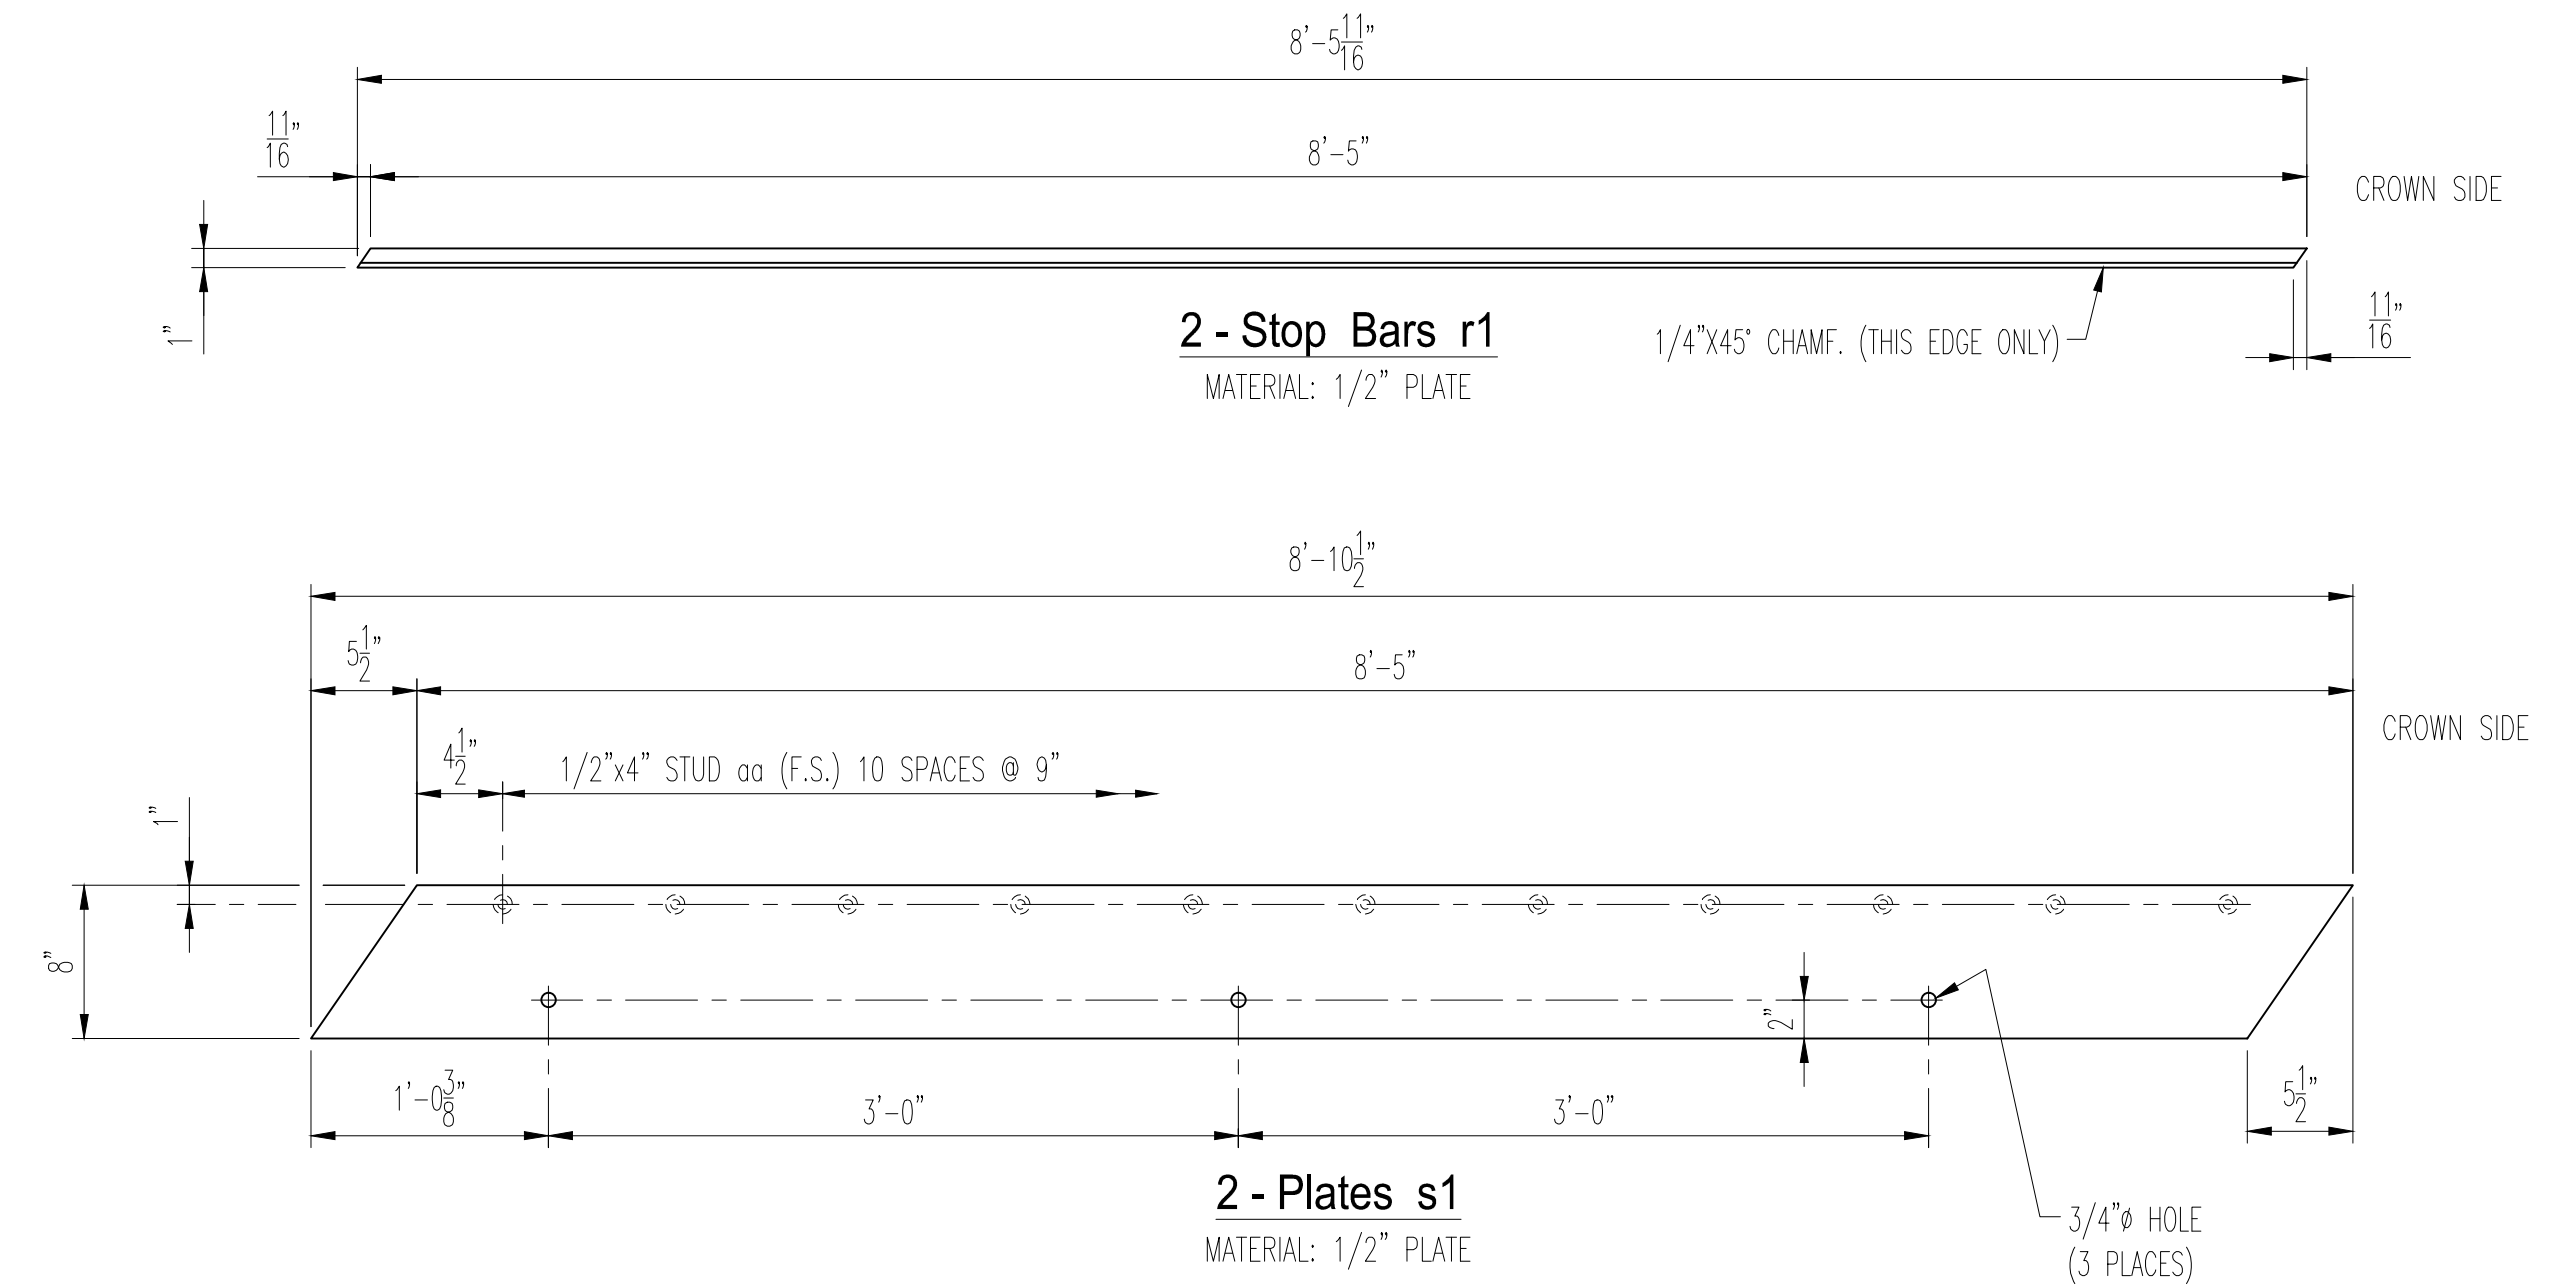

WELD AT COVER PLATES t1 & t2 IS SHOWN
THE WELD SHOWN IS TYPICAL AT r1 & r2 STOP BARS, PLATES s1 & s1 AND u1 & u2

NOTES:
SEE SHEETS 2 & 3 FOR THE LOCATIONS OF THESE PARTS



REV. No.	REVISION
SHOP INSPECTED BY:	

APPROVAL	
KOKOSING CONSTRUCTION	
<input checked="" type="checkbox"/> NO EXCEPTIONS TAKEN	
<input type="checkbox"/> MAKE CORRECTIONS AS NOTED	
<input type="checkbox"/> REVISE AND RESUBMIT	
<input type="checkbox"/> REJECTED	
<input type="checkbox"/> FOR INFORMATION ONLY	
REVIEW IS FOR GENERAL COMPLIANCE WITH CONTRACT DOCUMENTS NO RESPONSIBILITY ASSUMED FOR CORRECTNESS OF DIMENSIONS OR DETAILS	
BY mwf	DATE 9/28/2020


Ohio Structures Inc.
4030 Boardman Canfield Road, Ste. 200 D
Canfield, Ohio 44406
(330) 533-0084 Fax: (330) 533-0191

OHIO DEPARTMENT OF TRANSPORTATION
BRIDGE: CUY-E89ST-4015 (EAST 89TH STREET)
PEDESTRIAN BRIDGE OVER NORFOLK SOUTHERN & GCRTA

SCALE: N.T.S.	Kokosing Construction	DRAWN: JDC
DATE: 08/20		CHECK: MI


PLATE DETAILS

REF NO.: 17 (BU25)	ITEM NO.: 516
ODOT PROJ. NO.: 173000	CUYAHOGA COUNTY DWG. NO.: D5
OSI PROJ. NO.: 19-22	PID NO.: 96833 SFN: TBD 6 OF 7

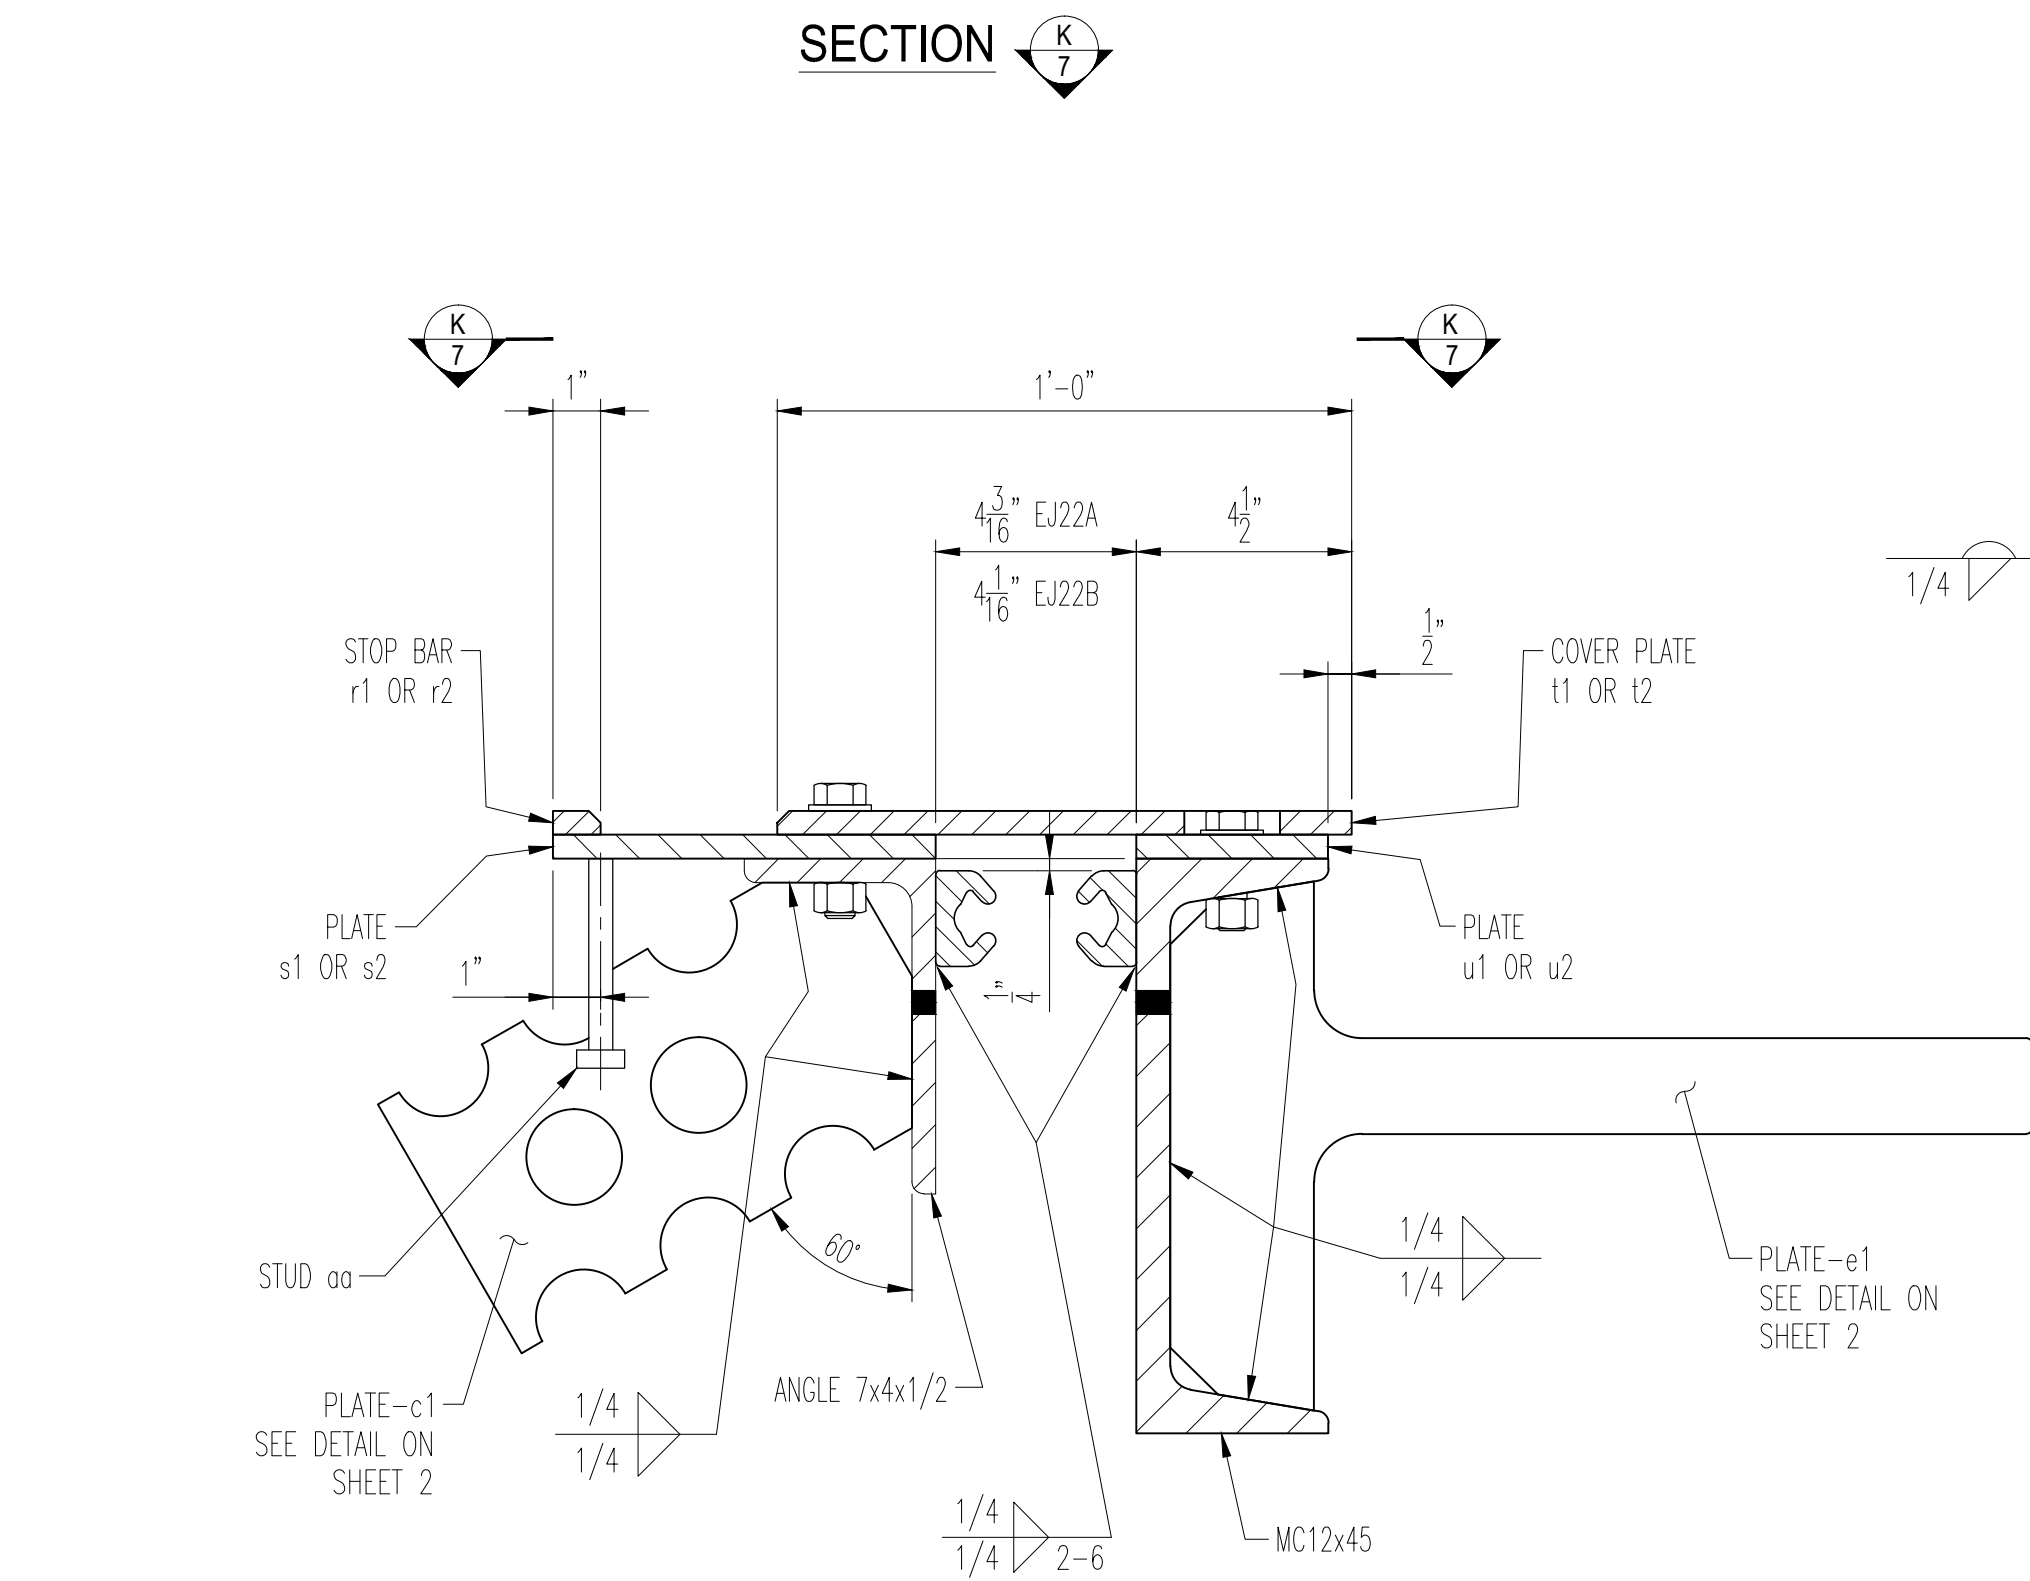


SEE SECTION D/2 & 3 FOR ADDITIONAL DETAILS

- * ALL MATERIAL SHALL BE ASTM A709 GR50/36.
- * MATERIAL AND WORKMANSHIP SHALL BE IN ACCORDANCE WITH ODOT-CMS-2016.
- * WELDING SHALL BE IN ACCORDANCE WITH AWS/AASHTO D1.5-15 AND ODOT 1011.
- * ALL MATERIAL TO BE METALIZED IN CONFORMANCE WITH O.D.O.T. STANDARD DRAWING EXJ-4-87 DATED 7/19/02.
- * ALL INFORMATION & DIMENSIONS ARE TO BE APPROVED BY THE CONTRACTOR PRIOR TO COMMENCING FABRICATION.

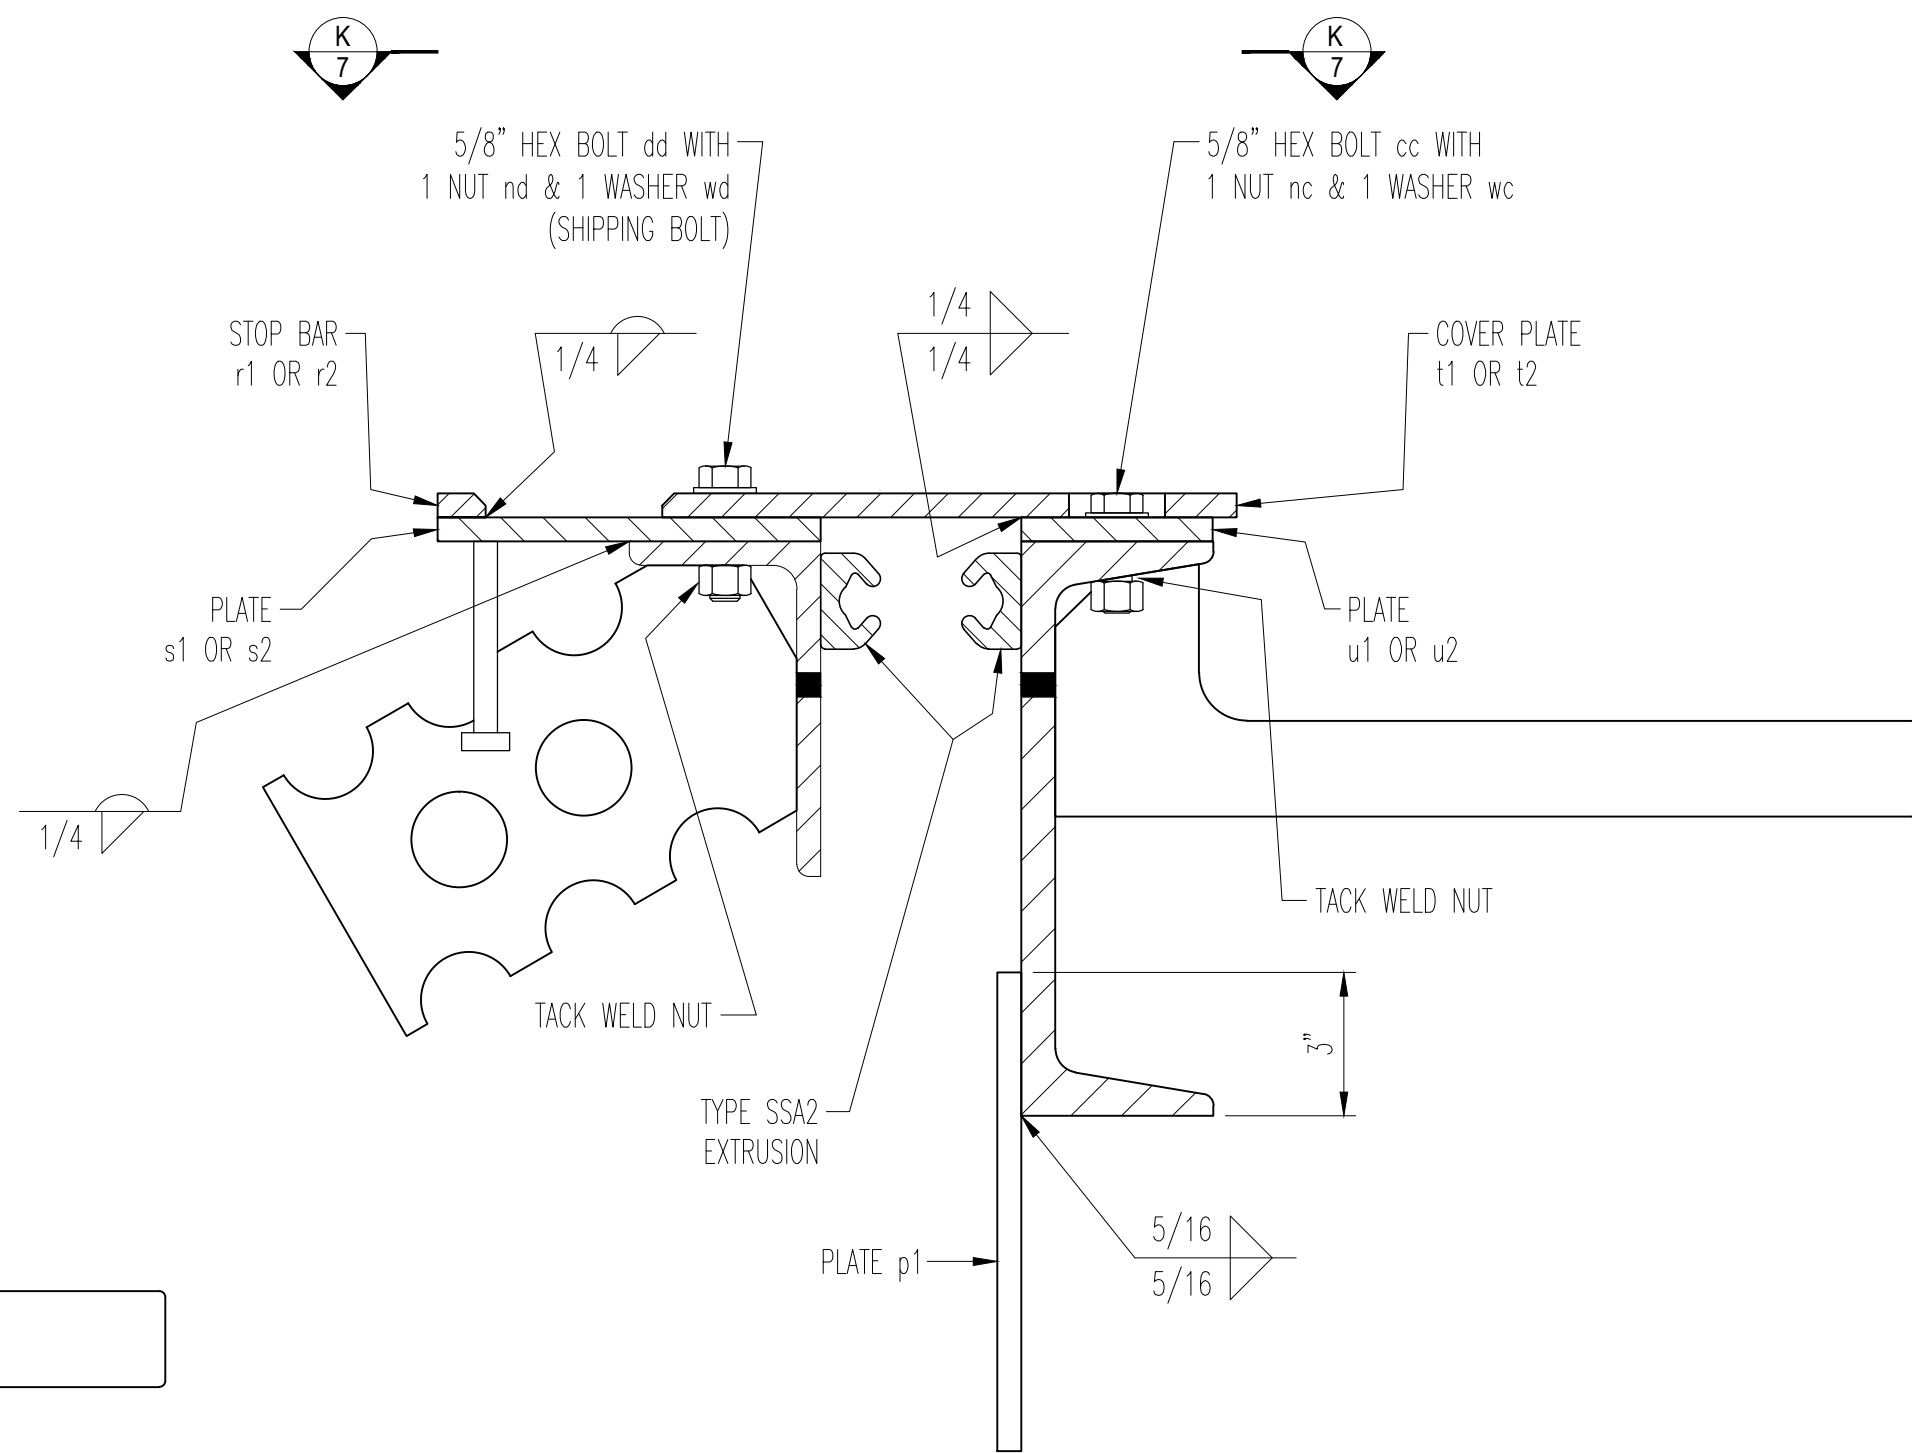


SEE SECTION C/2 & 3 FOR ADDITIONAL DETAILS

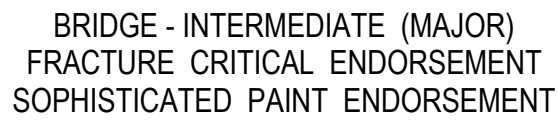

REV. No.	REVISION
SHOP INSPECTED BY:	

BY mwf **DATE** 9/28/2020

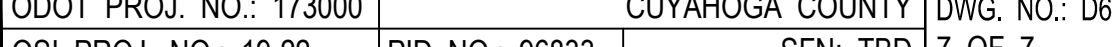

ODOT PROJECT : 173000				PID NO.: 96833				OSI PROJECT NO.: 19-22				REF NO.: 19-27	
EXPANSION JOINTS EJ22A & EJ22B													
MATERIALS ONLY:													
LINE	PO#	QTY	MARK	SECTION	LENGTH (FEET)	LENGTH (INCHES)	STL SPEC	PC WT (IN LBS)	NET WT (IN LBS)	HEAT #	REMARK		
1		1	a1	ANGLE 7x4x1/2	8	8 3/4	A709-50	156.25	156.25				
2		1	a2	ANGLE 7x4x1/2	8	8 13/16	A709-50	156.35	156.35				
3		1	a3	ANGLE 7x4x1/2	8	8 13/16	A709-50	156.35	156.35				
4		1	a4	ANGLE 7x4x1/2	8	8 7/8	A709-50	156.44	156.44				
5		1	b1	MC12x45.0	9	7 3/4	A709-50	434.06	434.06				
6		1	b2	MC12x45.0	9	8 1/4	A709-50	435.94	435.94				
7		1	b3	MC12x45.0	9	7 3/4	A709-50	434.06	434.06				
8		1	b4	MC12x45.0	9	8 3/8	A709-50	436.41	436.41				
9		6	n1	ANGLE 6x4x3/4	0	8	A709-50	15.73	94.40				
10		24	c1	PLATE 3/8 x 6	0	11	A709-36	4.92	118.08				
11		20	d1	PLATE 1/2 x 5 1/4	1	6	A709-36	6.36	127.20				
12		8	e1	PLATE 1/2 x 11 1/16	1	6	A709-36	8.69	69.52				
13		2	g1	PLATE 1/2 x 11	1	4 1/2	A709-36	24.53	49.06				
14		2	g2	PLATE 1/2 x 11	1	4 1/2	A709-36	24.53	49.06				
15		1	h1	PLATE 1/2 x 9 1/2	0	11	A709-36	13.62	13.62				
16		1	h2	PLATE 1/2 x 9 7/8	0	11	A709-36	13.90	13.90				
17		1	h3	PLATE 1/2 x 9 1/2	0	11	A709-36	13.52	13.52				
18		1	h4	PLATE 1/2 x 9 15/16	0	11	A709-36	13.98	13.98				
19		4	p1	PLATE 1/2 x 10	2	0	A709-50	34.03	136.12				
20		2	r1	PLATE 1/2 x 1	8	5 11/16	A709-36	14.32	28.64		BEVEL		
21		2	r2	PLATE 1/2 x 1	8	5 13/16	A709-36	14.34	28.68		BEVEL		
22		2	s1	PLATE 1/2 x 8	8	10 1/2	A709-36	114.58	229.16				
23		2	s2	PLATE 1/2 x 8	8	10 5/8	A709-36	114.72	229.44				
24		2	t1	PLATE 1/2 x 12	9	1 1/4	A709-36	171.87	343.74		BEVEL		
25		2	t2	PLATE 1/2 x 12	9	1 3/8	A709-36	172.08	344.16		BEVEL		
26		2	u1	PLATE 1/2 x 4	8	7 3/4	A709-36	57.29	114.58				
27		2	u2	PLATE 1/2 x 4	8	7 7/8	A709-36	57.36	114.72				
								SUB TOTAL	4,497.43				

LINE		QTY	MARK	DESCRIPTION	STL SPEC	WT PER (IN LBS)	NET WT (IN LBS)	HEAT #	REMARKS
28		96	aa	1/2"x4" STUD	A108	0.29	27.84		
29		12	bb	3/4x2-1/4 HEX HEAD BOLT	A325 Galv	0.42	5.04		@ n1 ANGLES
30		12	nb	3/4 HEAVY HEX NUT	A563 Galv	0.20	2.40		@ n1 ANGLES
31		12	wb	3/4 FLAT WASHER	F436 Galv	0.04	0.49		@ n1 ANGLES
32		68	cc	5/8x2 HEX HEAD BOLT	A307 Galv	0.26	17.41		@ COVER PLATES
33		68	nc	5/8 HEAVY HEX NUT	A563 Galv	0.12	8.16		@ COVER PLATES
34		68	wc	5/8 FLAT WASHER	F436 Galv	0.03	2.24		@ COVER PLATES
35		12	dd	5/8x2-1/4 HEX HEAD BOLT	A307	0.28	3.32		SHIPPING
36		12	nd	5/8 HEAVY HEX NUT	A307	0.12	1.44		SHIPPING
37		12	wd	5/8 FLAT WASHER	A307	0.03	0.40		SHIPPING
						SUB TOTAL	68.74		

LINE		QTY	MARK	DESCRIPTION	WT PER (IN LBS)	NET WT (IN LBS)	HEAT #	REMARKS
38		3.25	---	SSA2 EXTRUSION x 23'-0"	121.90	396.18		D.S. BROWN
39	*	2	---	A2R-400 STRIP SEAL x 19'-6"	0.00	0.00		D.S. BROWN
40	*	1	---	GALLON OF SEAL GLUE	0.00	0.00		D.S. BROWN
					SUB TOTAL	396.18		

* INDICATES AN ITEM THAT WILL BE SHIPPED LOOSE

TOTAL WT	4,962.35
----------	----------

Submittal: 128

Revision:

Date Submitted: 4/13/2021

Response Due By:



Project: 16051 - ODOT 173000 CUY IR 490/SR010 (OC3)

Description: BU25 E 89th Bridge Fence Drawings

To: Mark Gabele, PE
Ohio Department of Transportation - District 12

Email: Mark.Gabele@dot.ohio.gov

From: Nicole DeVille
Kokosing Construction Company, Inc.

Email: nfd@kokosing.biz


Submittal Type:	Submitted For:
<input type="checkbox"/> Engineered Drawings	<input checked="" type="checkbox"/> Approval
<input checked="" type="checkbox"/> Shop Drawings	<input type="checkbox"/> Record
<input type="checkbox"/> Working Drawings	<input type="checkbox"/> Other
<input type="checkbox"/> CPM Schedule	
<input type="checkbox"/> Material Certifications / Test Results	Sent Via:
<input type="checkbox"/> Reports	<input checked="" type="checkbox"/> Attached (Electronic)
<input type="checkbox"/> Product Data/Samples	<input type="checkbox"/> Attached (Hard Copy)
<input type="checkbox"/> Other:	

Submittal #	Copies	Spec #	Rev. #	Description	
128	1			128 – BU25 E 89th Bridge Fence Drawings	


Comments:

Nicole DeVille


Signed: _____

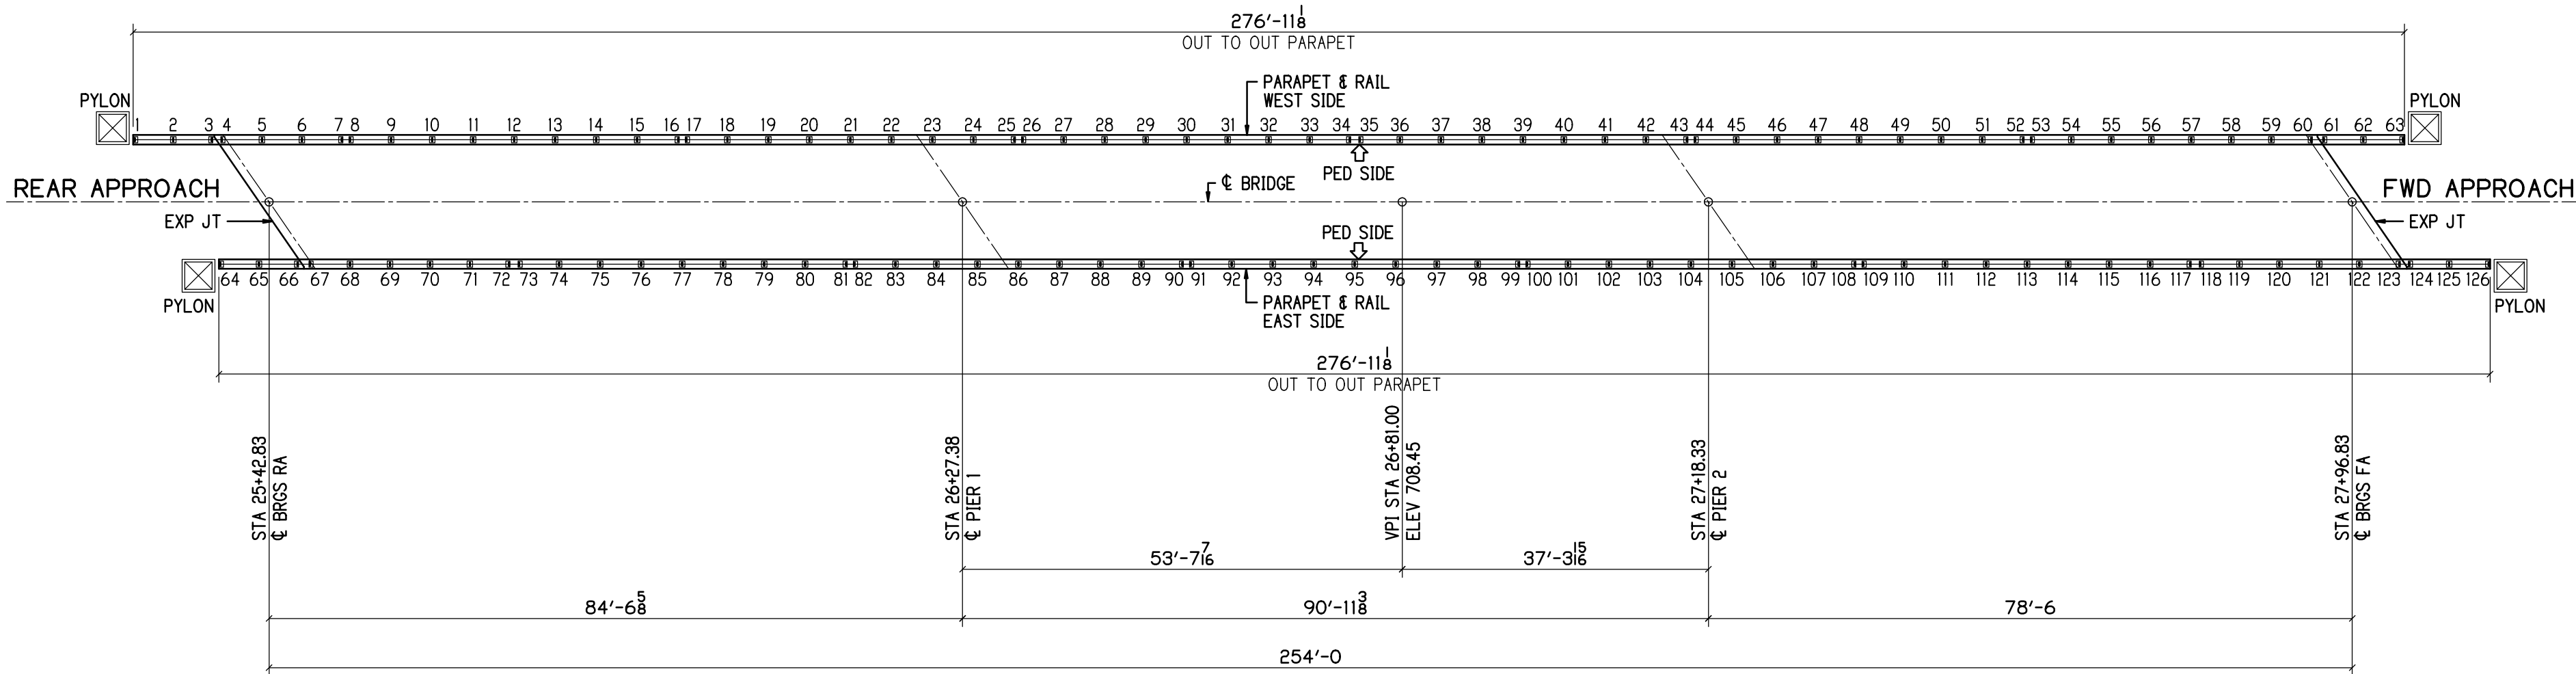

GENERAL PLAN
E 89TH STREET PEDESTRIAN BRIDGE
ALL DIMENSIONS ARE IN PLAN

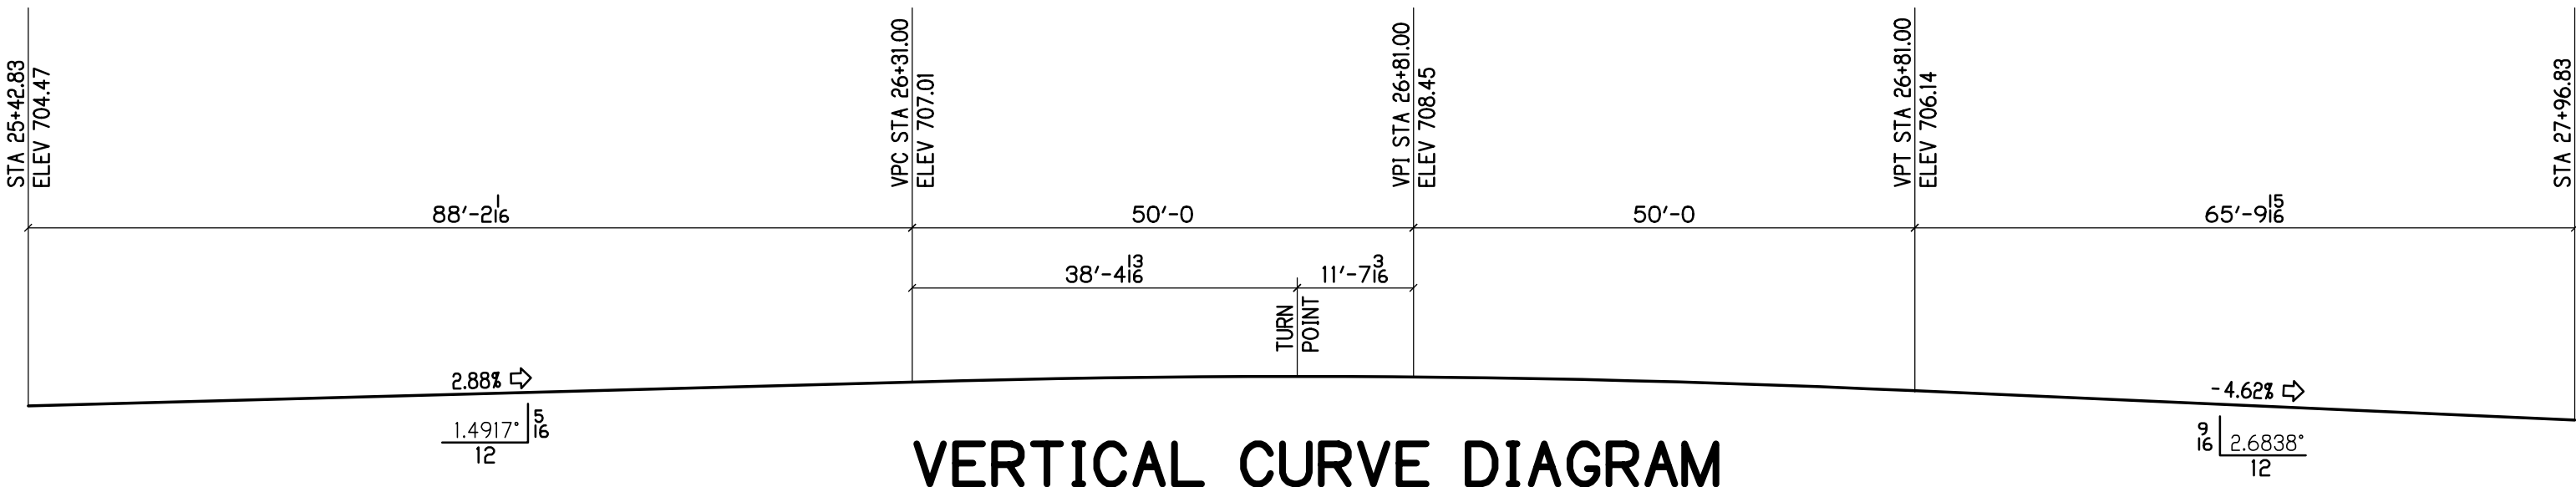

VERTICAL CURVE DIAGRAM

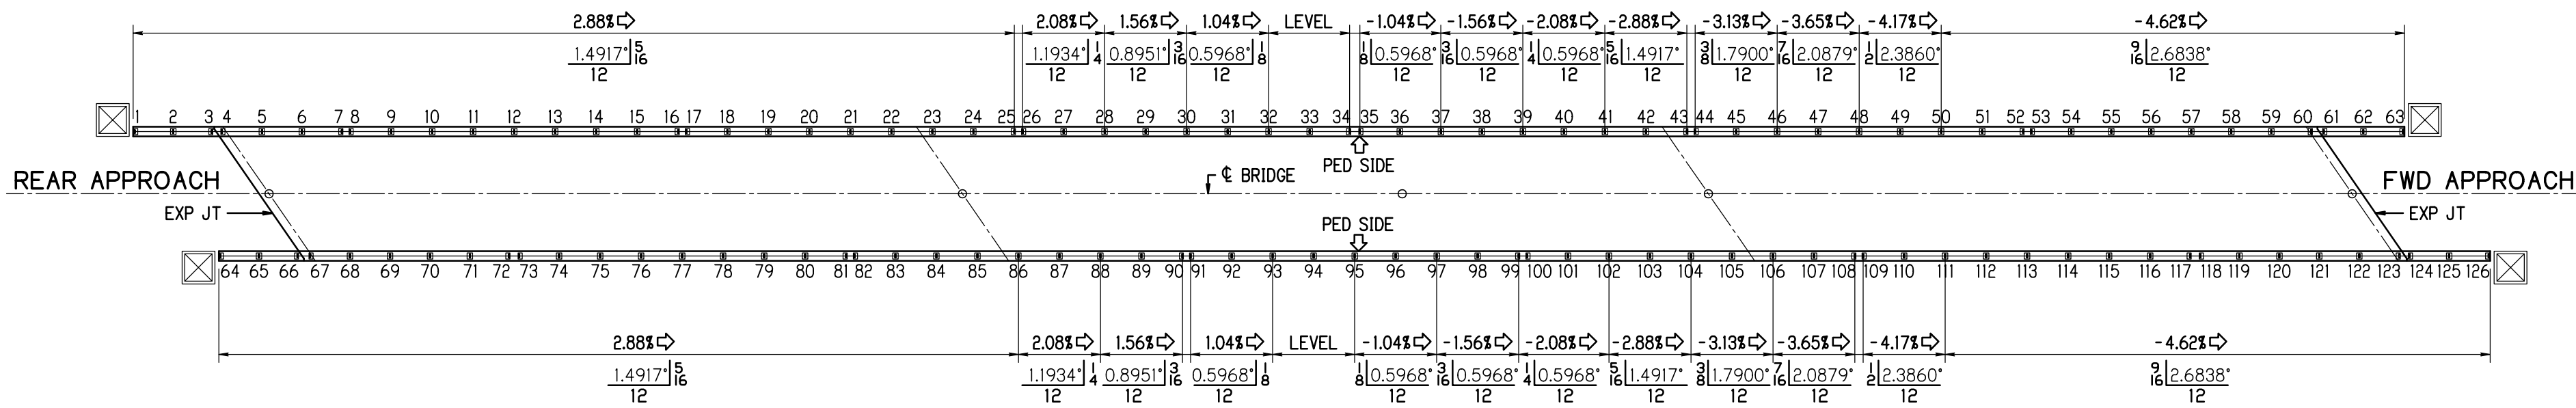

RAIL SLOPE PLAN

INDEX OF SHEETS	
SHEET #	DESCRIPTION
E300	GENERAL PLANS & NOTES
E301	ANCHOR SETTING PLANS
E302	ANCHOR SETTING DETAILS

VERTICAL CURVE DATA

VPC STA 2631.0000 EL = 707.0100
VPI STA 2681.0000 EL = 708.4500
VPT STA 2731.0000 EL = 706.1400

LC = 100.0000
G1 = 2.8800%
G2 = -4.6200%
K = 13.3333
E = 0.9375
RC = 7.5000
TP = STA 2669.4000 EL = 707.5630

STATION INCREMENT = 10.0000
GRADE SHOWN FOR STA IS FROM PREVIOUS STA

STA 2631.0000	EL = 707.0100	VPC STA
STA 2641.0000	EL = 707.2605	GRD = 2.5050%
STA 2651.0000	EL = 707.4360	GRD = 1.7550%
STA 2661.0000	EL = 707.5365	GRD = 1.0050%
STA 2671.0000	EL = 707.5620	GRD = 0.2550%
STA 2681.0000	EL = 707.5125	GRD = -0.4950%
STA 2691.0000	EL = 707.3880	GRD = -1.2450%
STA 2701.0000	EL = 707.1885	GRD = -1.9950%
STA 2711.0000	EL = 706.9140	GRD = -2.7450%
STA 2721.0000	EL = 706.5645	GRD = -3.4950%
STA 2731.0000	EL = 706.1400	GRD = -4.2450%

GENERAL NOTES

FINISH

THE FABRICATED RAILING AND HARDWARE (EXCEPT EMBED ANCHORS) SHALL BE GALVANIZED PER C&MS 711.02 EXCEPT THAT FABRICATED RAILING ELEMENTS SHALL NOT BE POST TREATED WITH WATER QUENCHING OR CHROMATE CONVERSION COATED.

ALL VENT HOLES REQUIRED FOR GALVANIZING SHALL BE AT THE DISCRETION OF THE FABRICATOR AND GALVANIZER.

THE PAINT SYSTEM SHALL BE PROVIDED UNDER A SEPARATE COVER. THE FINISH COAT SHALL MATCH FEDERAL COLOR STANDARD FS 595C-17038 BLACK.

WELDING

AWS - BRIDGE WELDING CODE D1.5 - LATEST EDITION

AWS - STRUCTURAL WELDING CODE D1.1 - LATEST EDITION

WELD PROCESS SHALL BE GMAW

RAILING NOTES

- ALL POSTS SHALL BE FABRICATED AND SET PLUMB TO GRADE ALL RAIL PANELS SHALL FOLLOW THE GRADE.
- ALL EMBEDDED ANCHORS SHALL BE INSTALLED WITH A TOLERANCE OF +/- 1/16".
- ALL TEMPLATE PLATES FOR THE ANCHORS SHALL NOT BE SUPPLIED BY THIS FABRICATOR. THE CONTRACTOR SHALL BE RESPONSIBLE TO INSTALL THE ANCHORS WITH THE PRECISION REQUIRED FOR POST INSTALLATION.
- ALL PLASTIC BASE P. SHIMS AND CAULKING SHALL NOT BE SUPPLIED BY THIS FABRICATOR. THE CONTRACTOR OR INSTALLER SHALL BE REQUIRED TO SUPPLY AND INSTALL THESE REQUIREMENTS PER THE CONTRACT.

WIRE MESH NOTES

- THE WELDED WIRE MESH SHALL BE 10.5 GA CORE WIRE, GALVANIZED AFTER WELDING.
- THE WIRE MESH PATTERN SHALL BE 1x1 SET IN THE SQUARE POSITION AS PLUMB.
- THE WIRE MESH PANELS SHALL BE FIELD INSTALLED USING CLAMP BARS.
- THE CLAMP BARS SHALL BE SHOP DRILLED FOR FASTENER LOCATIONS.
- FIELD INSTALLATION SHALL USE THE 1/4" SELF DRILL AND TAP SCREWS.
- THE TEK SCREW HEADS SHALL BE FIELD PAINTED BLACK AFTER INSTALLATION.

MATERIAL NOTES

NO	MATERIAL	ASTM	GRADE	TYPE	NOTES
1	PLATES, ANGLES & BARS	A709	36 / 50		
2	HSS RAIL TUBES	A500	B		
3	WIRE MESH	A185-1064			


FASTENER NOTES

NO	MATERIAL	ASTM/ANSI	GRADE	TYPE	REMARKS
1	HIGH STRENGTH BOLTS	A325			GALV ASTM A153
2	HIGH STRENGTH NUTS	A563			GALV ASTM A153
3	HIGH STRENGTH WASHERS	F436			GALV ASTM A153
4	SS ALL THREAD ANCHOR RODS	A320	B8	304	MILL FINISH
5	SS HEX BOLTS	A194	B8	304	MILL FINISH
6	SS HEX NUTS	A194	B8	304	MILL FINISH
7	SS WASHERS	A194	B8	304	MILL FINISH


MATERIAL QUANTITY

DESCRIPTION	POSTS	CONTRACT LN/FT	ACTUAL LN/FT	REMARKS
BU-25 E 89TH STREET DECORATIVE FENCE	126	554'-0	557'-104	+3'-104


BU-25 EAST 89TH STREET

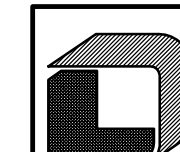
		P.H. DREW INC.		APPROVAL	
2450 N. RACEWAY RD. - P.O. BOX 34295 INDIANAPOLIS, INDIANA 46234		PHONE : (317) 297-5152 FAX : (317) 297-5313			
CUY-IR490 / SR010-2.09 / 19.28					
DECORATIVE FENCE					
GENERAL PLANS & NOTES					
REVISION	REV	DATE	DESCRIPTION	BY	STATE
					OHIO
					COUNTY
					CUYAHOGA (CITY OF CLEVELAND)
					PROJECT
APPROVAL RECORD	DATE	ISSUED	APP. DATE	APPROVAL STATUS	CUSTOMER
					LAKE ERIE CONSTRUCTION COMPANY
					CONTRACTOR
					APPROVED
					REFERENCE
FINISH					ITEM
SEE NOTES-SHT E300					
DRAWN BY MRH 04-06-21		CHECKED BY MRH NO 1914		JOB MGR JL	
DWG STATUS APPROVAL 04-06-21		JOB NO. 19-1108		TOTAL SHEETS SHEET E300	

APPROVAL SUBMIT FOR ANCHOR AND POST
LOCATIONS ONLY 04-06-21

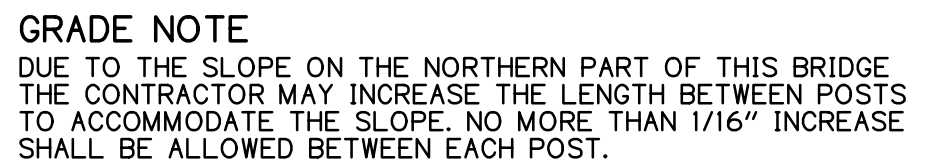


BU-25 EAST 89TH STREET


	P.H. DREW INC.				APPROVAL
	2450 N. RACEWAY RD. - P.O. BOX 34295 INDIANAPOLIS, INDIANA 46234		PHONE : (317) 297-5152 FAX : (317) 297-5133		
<div style="font-size: 1.5em; font-weight: bold; margin: 0;">CUY-IR490 / SR010-2.09 / 19.28</div> <div style="font-size: 1.2em; font-weight: bold; margin: 5px 0 0 0;">DECORATIVE FENCE</div> <div style="font-size: 1.5em; font-weight: bold; margin: 0;">ANCHOR SETTING PLANS</div>					
REVISION	REV.	DATE	DESCRIPTION		BY
					STATE
					COUNTY
					PROJECT
					CONTRACT
					SECTION
					STRUCTURE
					STATE JOB
APPROVAL RECORD	DATE	ISSUED	APP. DATE	APPROVAL STATUS	CUSTOMER
					CONTRACTOR
					ARCH/ENG
					REFERENCE
					ITEM
					FINISH
					SEE NOTES - SHT E300
DRAWN BY		CHECKED BY	MRH NO	JOB MGR	DWG STATUS
MRH		1914	JL	APPROVAL 04-06-21	
04-06-21					JOB NO.
					TOTAL SHEETS
					SHEET
					E301

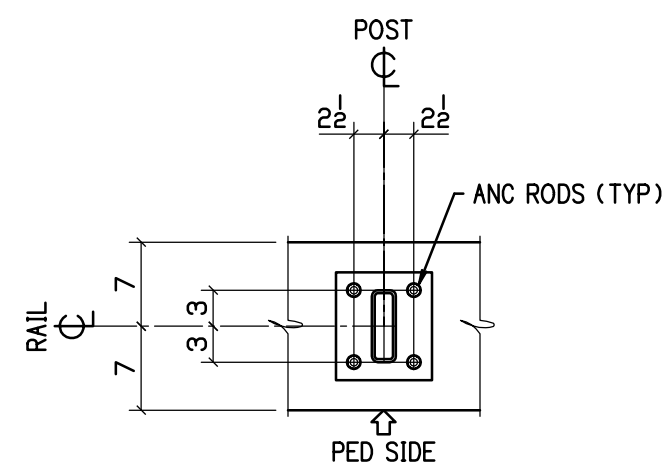


ANC DETAIL **A**

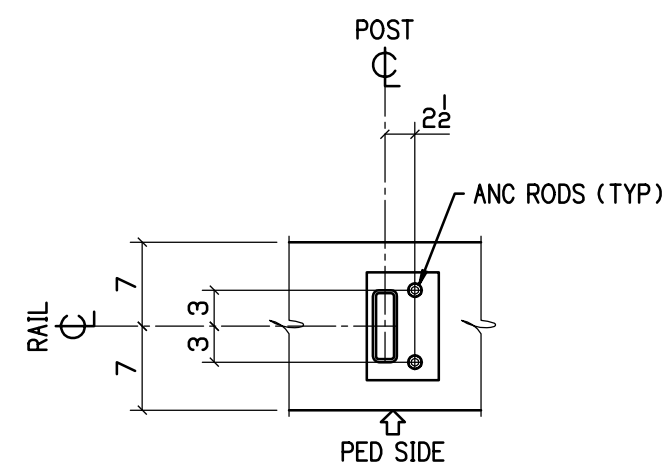


ANC DETAIL **B**

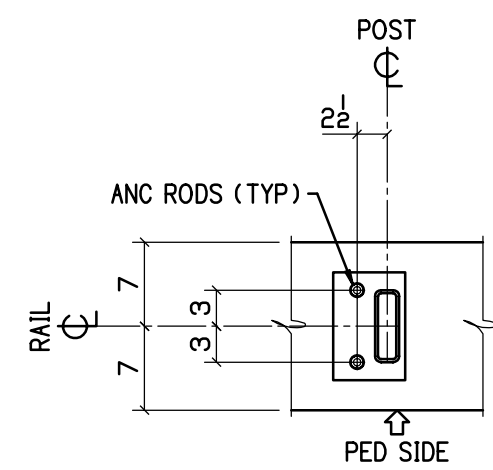


ANC DETAIL **C**

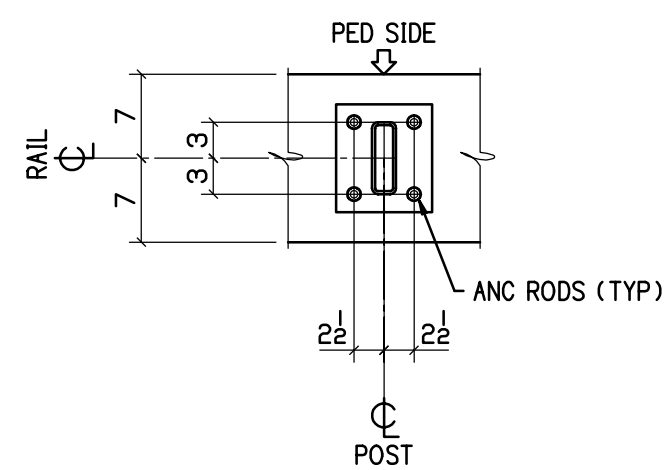


ANC DETAIL **D**

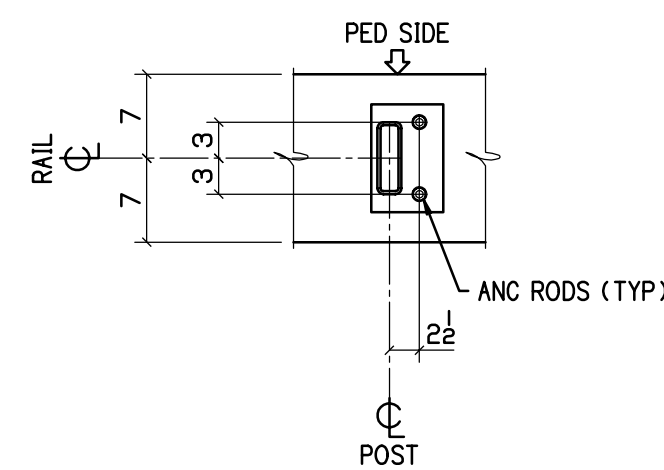


ANC DETAIL **E**

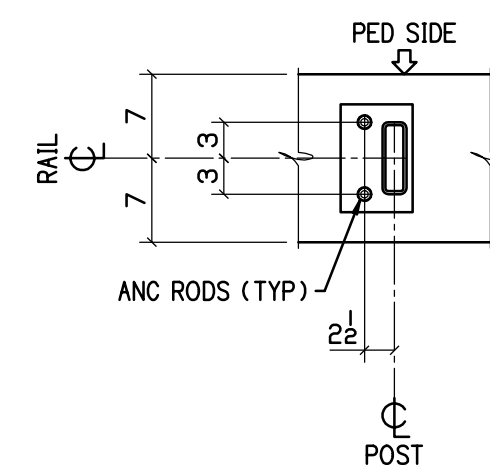


ANC DETAIL **F**

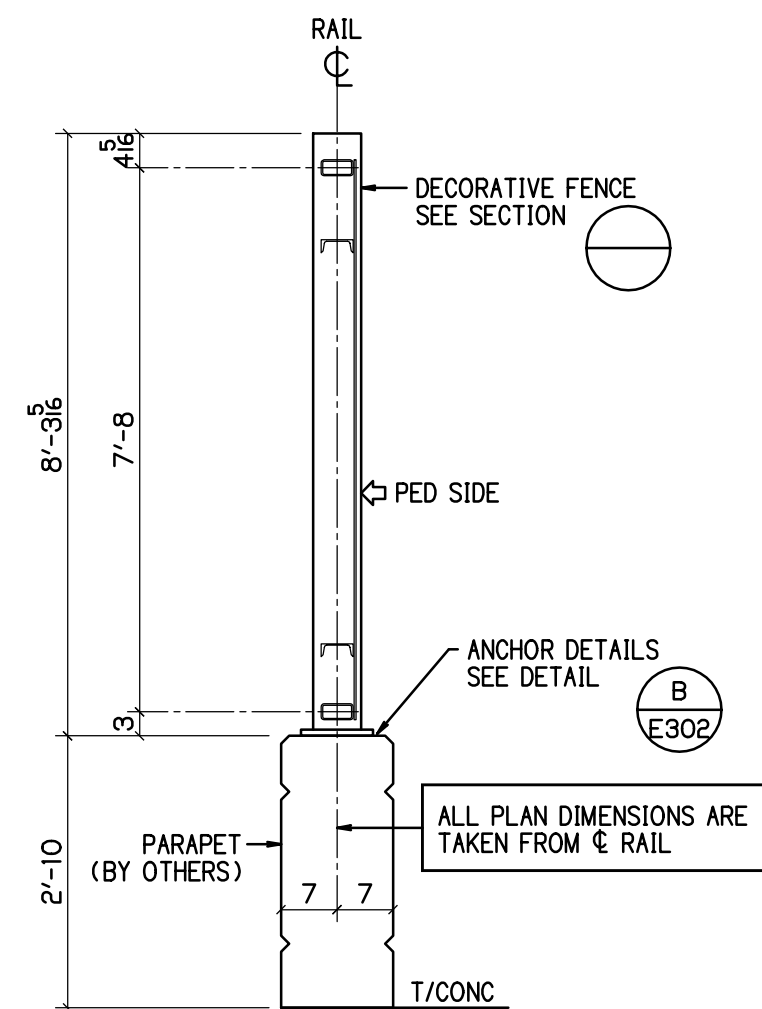


SECTION **A**
1/2" = 1'-0"

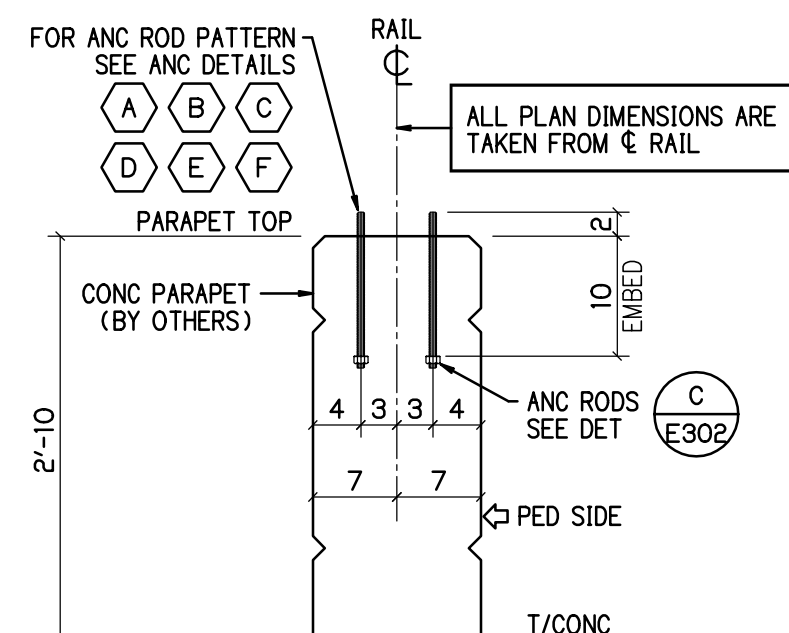


DETAIL **B**
E302

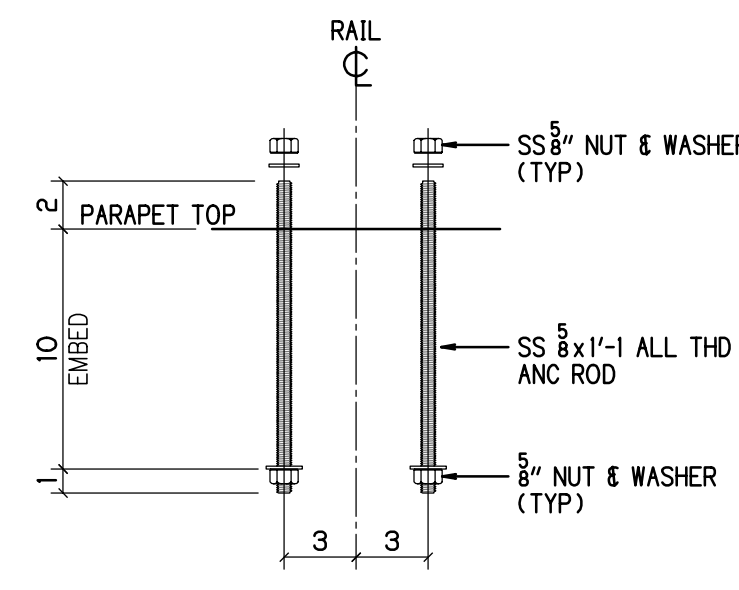


DETAIL **C**
E302

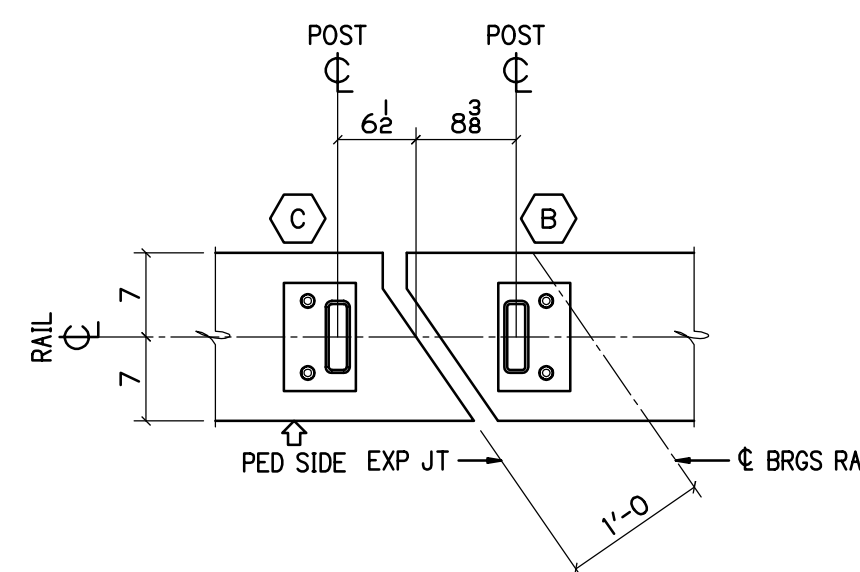


DETAIL **D**
3/4" = 1'-0"

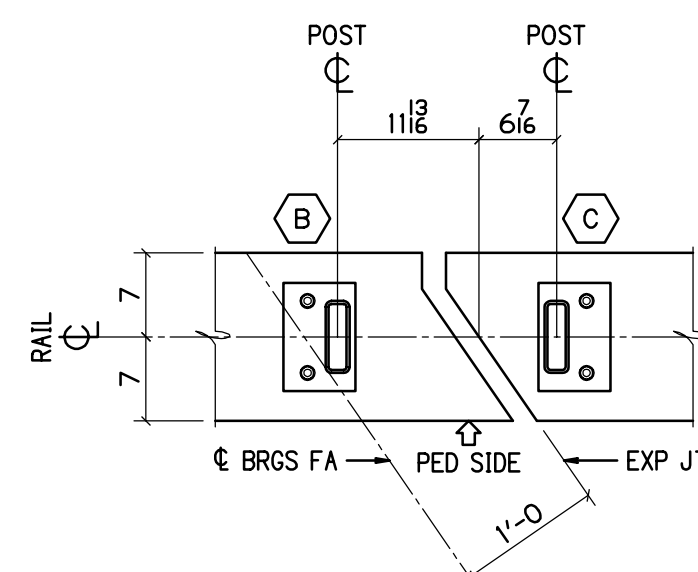

DETAIL **E**
3/4" = 1'-0"

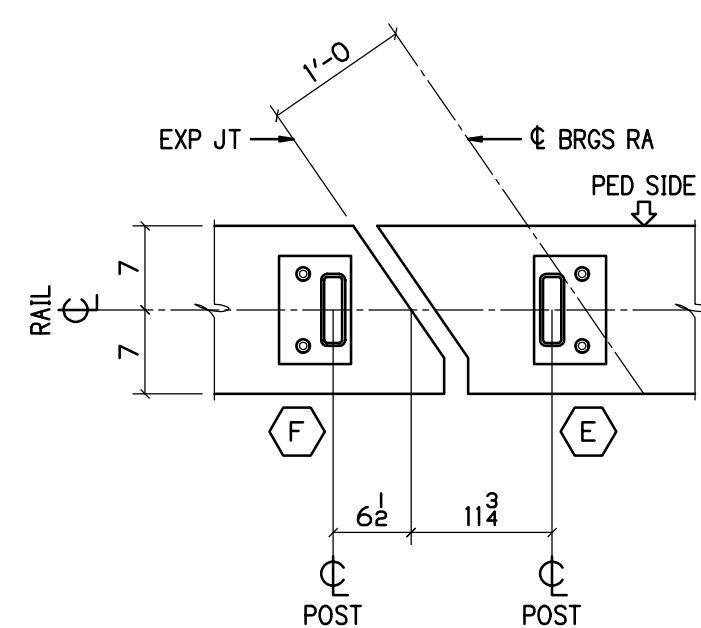

DETAIL **F**
3/4" = 1'-0"

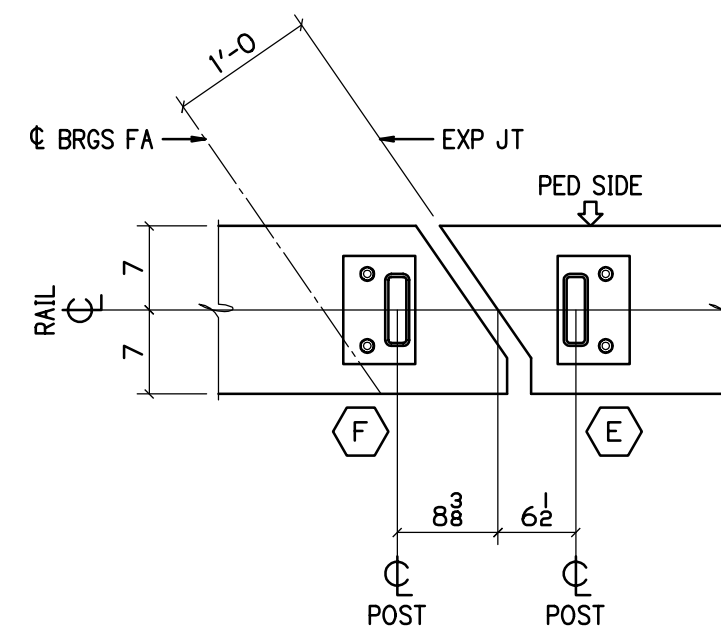

DETAIL **G**
3/4" = 1'-0"

BU-25 EAST 89TH STREET

		2450 N. RACEWAY RD. - P.O. BOX 34295 INDIANAPOLIS, INDIANA 46234		PHONE : (317) 297-5152 FAX : (317) 297-5313	APPROVAL	
		CUY-IR490 / SR010-2.09 / 19.28 DECORATIVE FENCE ANCHOR SETTING DETAILS				
REVISION	REV	DATE	DESCRIPTION	BY	STATE	OHIO
					COUNTY	CUYAHOGA (CITY OF CLEVELAND)
					PROJECT	3000 (17)
					CONTRACT	PID 96833
					SECTION	
APPROVAL RECORD	DATE	ISSUED	APP. DATE	APPROVAL STATUS	CUSTOMER	LAKE ERIE CONSTRUCTION COMPANY
					CONTRACTOR	
					APPROVED	
					REFERENCE	
					ITEM	
					FINISH	SEE NOTES-SHT E300
DRAWN BY	CHECKED BY	MRH NO	JOB MGR	DWG STATUS	JOB NO.	TOTAL SHEETS
MRH	1914	JL	APPROVAL	04-06-21	19-1108	E302

Submittal: 132

Revision:

Date Submitted: 4/28/2021

Response Due By:



Project: 16051 - ODOT 173000 CUY IR 490/SR010 (OC3)

Description: BU25 - E 89th St Decorative Fence Shop Drawings

To: Mark Gabele, PE
Ohio Department of Transportation - District 12

Email: Mark.Gabele@dot.ohio.gov

From: Nicole DeVille
Kokosing Construction Company, Inc.


Email: nfd@kokosing.biz

Submittal Type:	Submitted For:
<input type="checkbox"/> Engineered Drawings	<input checked="" type="checkbox"/> Approval
<input checked="" type="checkbox"/> Shop Drawings	<input type="checkbox"/> Record
<input type="checkbox"/> Working Drawings	<input type="checkbox"/> Other
<input type="checkbox"/> CPM Schedule	
<input type="checkbox"/> Material Certifications / Test Results	Sent Via:
<input type="checkbox"/> Reports	<input checked="" type="checkbox"/> Attached (Electronic)
<input type="checkbox"/> Product Data/Samples	<input type="checkbox"/> Attached (Hard Copy)
<input type="checkbox"/> Other:	


Submittal #	Copies	Spec #	Rev. #	Description	
132	1			132 – BU25 - E 89th St Decorative Fence Shop Drawings	

Comments:


Signed: 

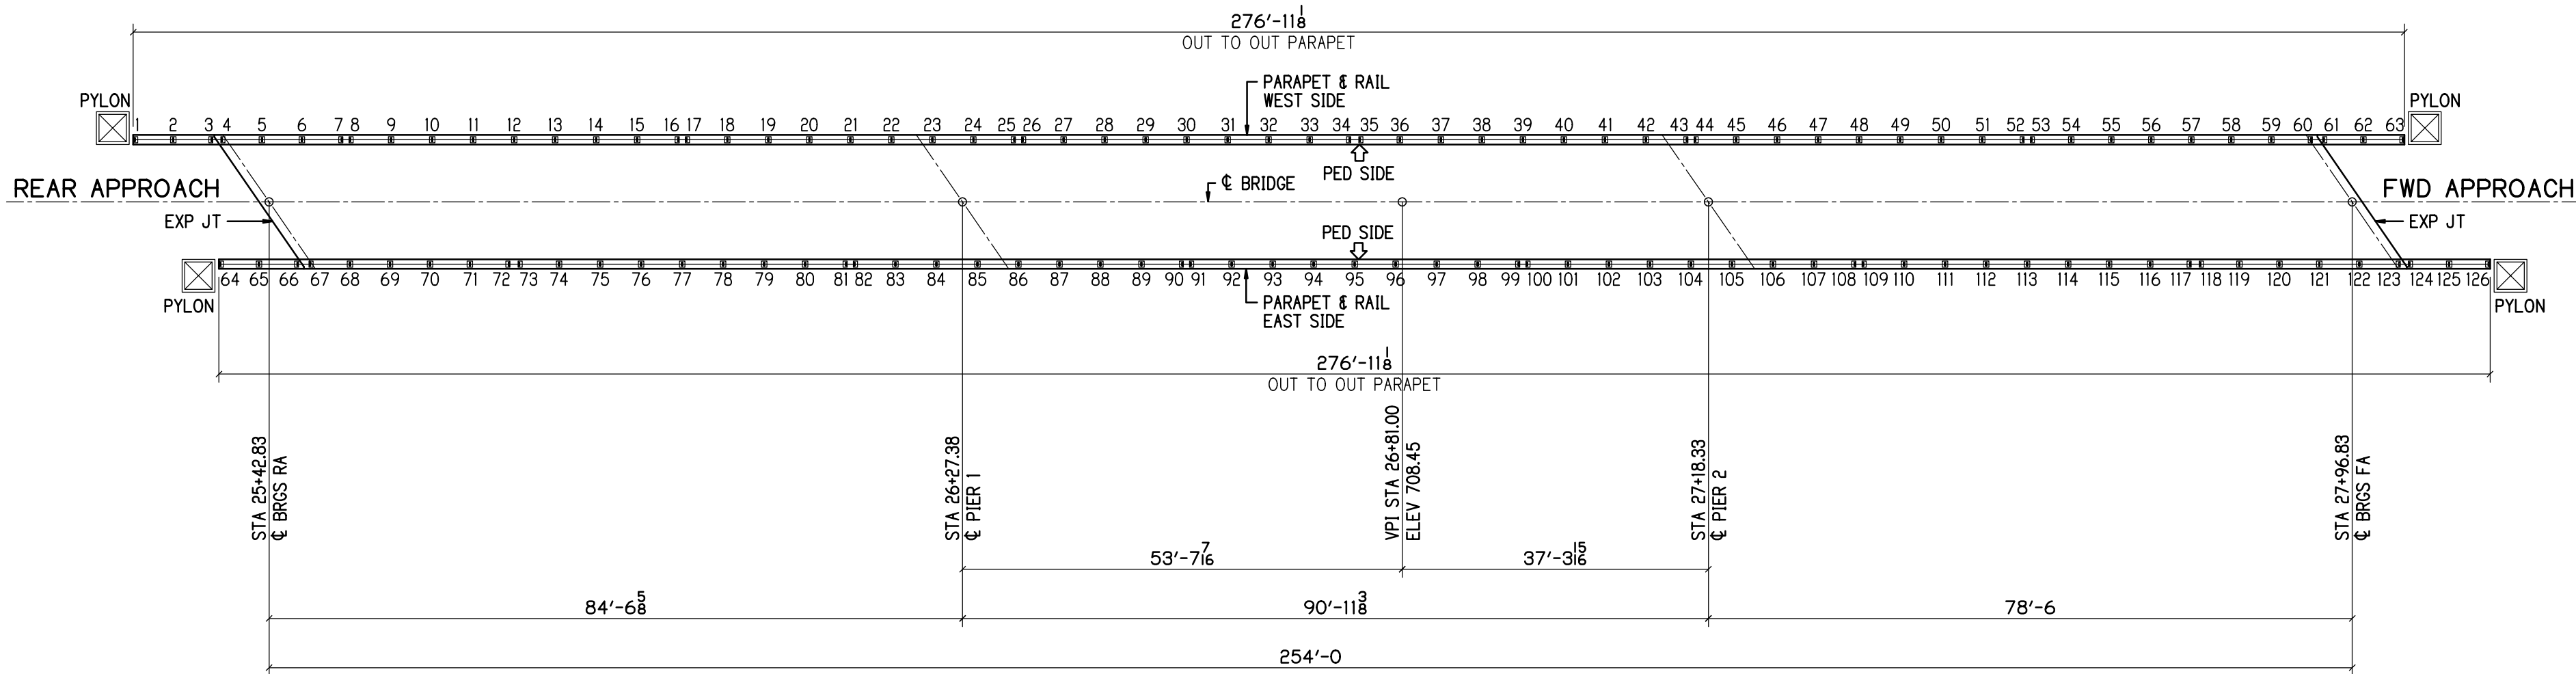

GENERAL PLAN 
E 89TH STREET PEDESTRIAN BRIDGE
ALL DIMENSIONS ARE IN PLAN

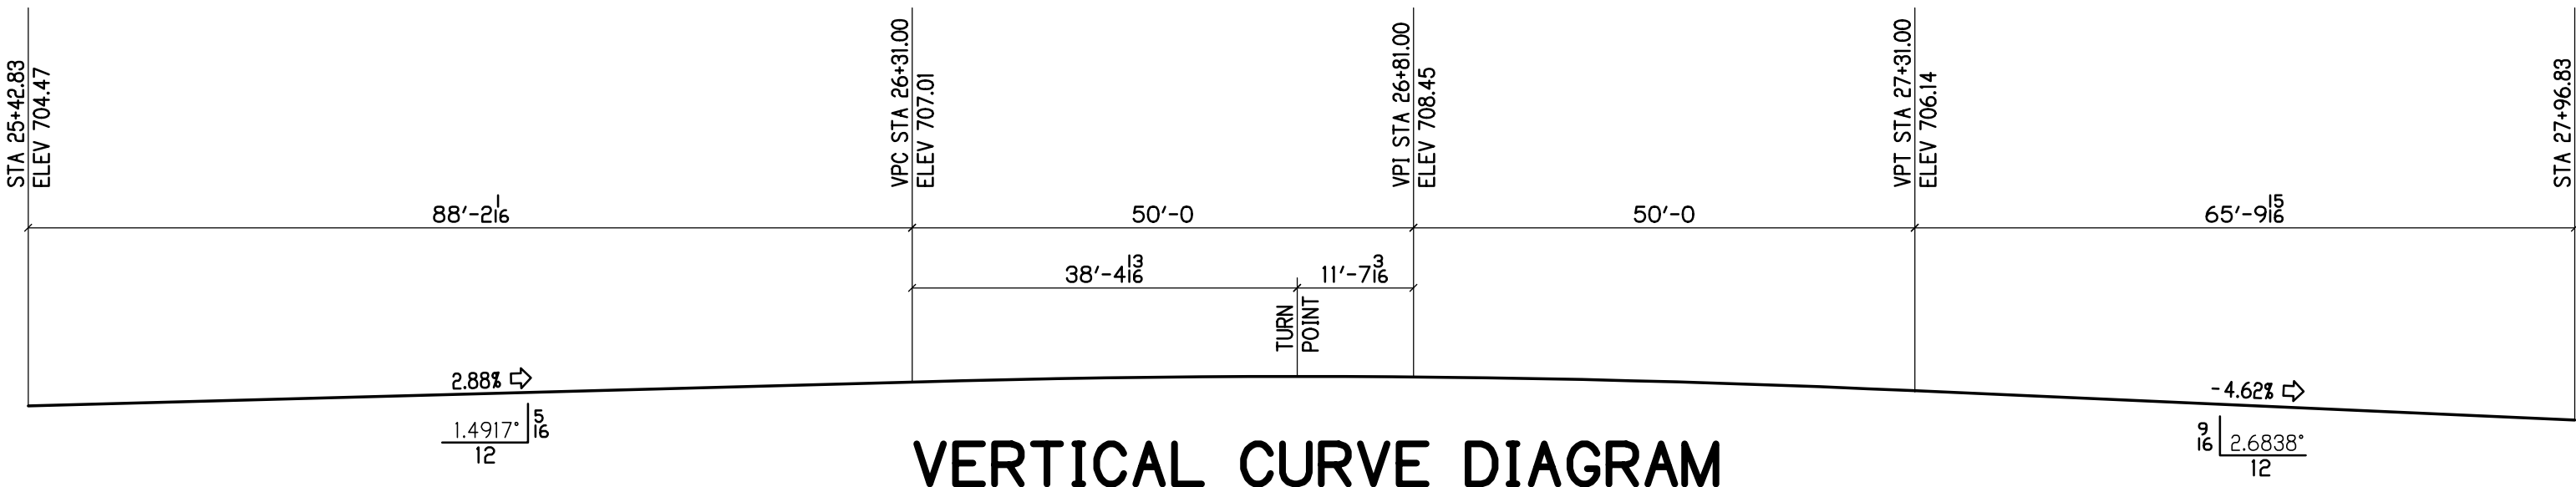

VERTICAL CURVE DIAGRAM

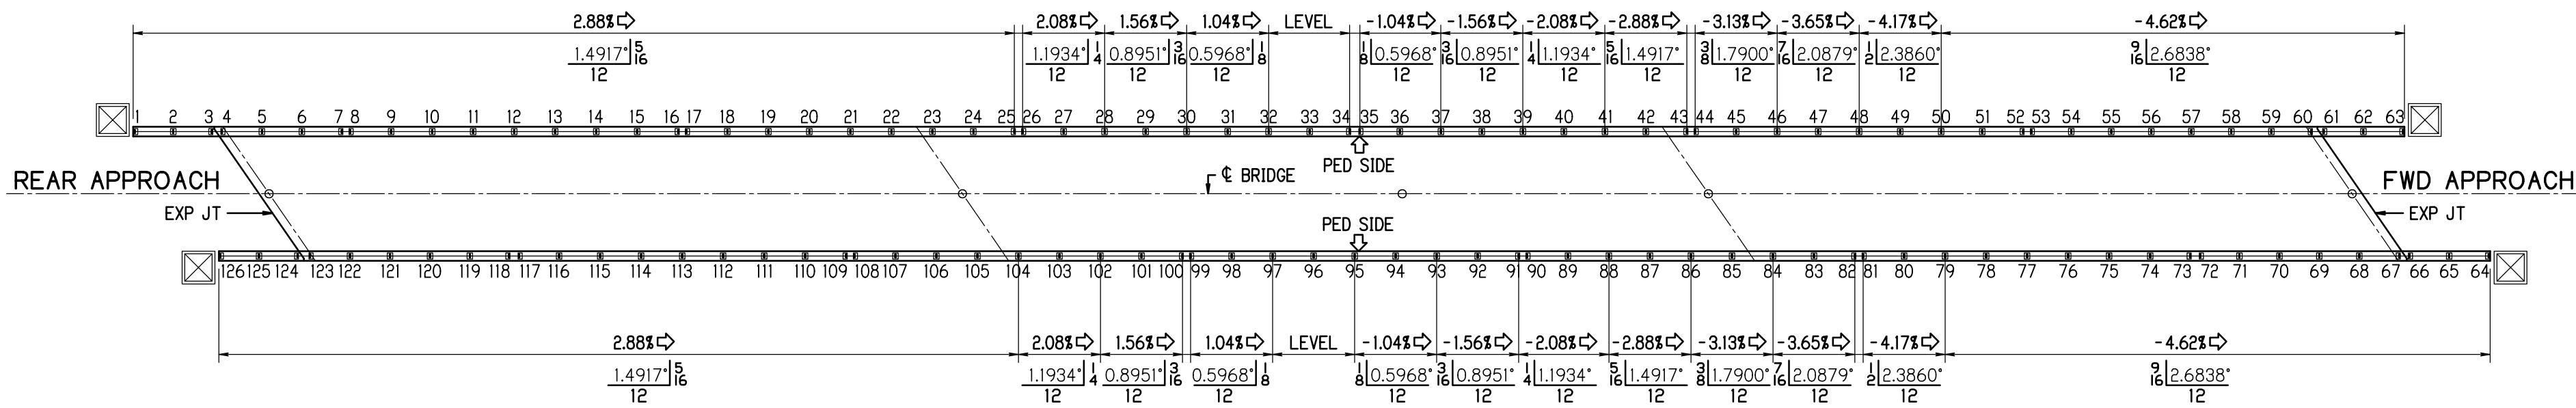

RAIL SLOPE PLAN 

INDEX OF SHEETS

SHEET #	DESCRIPTION
E300	GENERAL PLANS & NOTES
E301	ANCHOR SETTING PLANS
E302	ANCHOR SETTING DETAILS
E303	WEST PARAPET RAIL ELEVATION
E304	EAST PARAPET RAIL ELEVATION
E305	RAIL STANDARD DETAILS

VERTICAL CURVE DATA

VPC STA 2631.0000 EL = 707.0100
VPI STA 2681.0000 EL = 708.4500
VPT STA 2731.0000 EL = 706.1400

LC = 100.0000
G1 = 2.8800%
G2 = -4.6200%
K = 13.3333
E = 0.9375
RC = 7.5000
TP = STA 2669.4000 EL = 707.5630

STATION INCREMENT = 10.0000
GRADE SHOWN FOR STA IS FROM PREVIOUS STA

STA 2631.0000	EL = 707.0100	VPC STA
STA 2641.0000	EL = 707.2605	GRD = 2.5050%
STA 2651.0000	EL = 707.4360	GRD = 1.7550%
STA 2661.0000	EL = 707.5365	GRD = 1.0050%
STA 2671.0000	EL = 707.5620	GRD = 0.2550%
STA 2681.0000	EL = 707.5125	GRD = -0.4950%
STA 2691.0000	EL = 707.3880	GRD = -1.2450%
STA 2701.0000	EL = 707.1885	GRD = -1.9950%
STA 2711.0000	EL = 706.9140	GRD = -2.7450%
STA 2721.0000	EL = 706.5645	GRD = -3.4950%
STA 2731.0000	EL = 706.1400	GRD = -4.2450% VPT STA

GENERAL NOTES

FINISH

THE FABRICATED RAILING AND HARDWARE (EXCEPT EMBED ANCHORS) SHALL BE GALVANIZED PER C&MS 711.02 EXCEPT THAT FABRICATED RAILING ELEMENTS SHALL NOT BE POST TREATED WITH WATER QUENCHING OR CHROMATE CONVERSION COATED.

ALL VENT HOLES REQUIRED FOR GALVANIZING SHALL BE AT THE DISCRETION OF THE FABRICATOR AND GALVANIZER.

THE PAINT SYSTEM SHALL BE PROVIDED UNDER A SEPARATE COVER. THE FINISH COAT SHALL MATCH FEDERAL COLOR STANDARD FS 595C-17038 BLACK.

WELDING

AWS - BRIDGE WELDING CODE D1.5 - LATEST EDITION

AWS - STRUCTURAL WELDING CODE D1.1 - LATEST EDITION

WELD PROCESS SHALL BE GMAW

RAILING NOTES

- ALL POSTS SHALL BE FABRICATED AND SET PLUMB TO GRADE ALL RAIL PANELS SHALL FOLLOW THE GRADE.
- ALL EMBEDDED ANCHORS SHALL BE INSTALLED WITH A TOLERANCE OF +/- 1/16".
- ALL TEMPLATE PLATES FOR THE ANCHORS SHALL NOT BE SUPPLIED BY THIS FABRICATOR. THE CONTRACTOR SHALL BE RESPONSIBLE TO INSTALL THE ANCHORS WITH THE PRECISION REQUIRED FOR POST INSTALLATION.
- ALL PLASTIC BASE P. SHIMS AND CAULKING SHALL NOT BE SUPPLIED BY THIS FABRICATOR. THE CONTRACTOR OR INSTALLER SHALL BE REQUIRED TO SUPPLY AND INSTALL THESE REQUIREMENTS PER THE CONTRACT.

WIRE MESH NOTES

- THE WELDED WIRE MESH SHALL BE 10.5 GA CORE WIRE, GALVANIZED AFTER WELDING.
- THE WIRE MESH PATTERN SHALL BE 1x1 SET IN THE SQUARE POSITION AS PLUMB.
- THE WIRE MESH PANELS SHALL BE FIELD INSTALLED USING CLAMP BARS.
- THE CLAMP BARS SHALL BE SHOP DRILLED FOR FASTENER LOCATIONS.
- FIELD INSTALLATION SHALL USE THE 1/4" SELF DRILL AND TAP SCREWS.
- THE TEK SCREW HEADS SHALL BE FIELD PAINTED BLACK AFTER INSTALLATION.

MATERIAL NOTES

NO	MATERIAL	ASTM	GRADE	TYPE	NOTES
1	PLATES, ANGLES & BARS	A709	36 / 50		
2	HSS RAIL TUBES	A500	B		
3	WIRE MESH	A185-1064			

FASTENER NOTES

NO	MATERIAL	ASTM/ANSI	GRADE	TYPE	REMARKS
1	HIGH STRENGTH BOLTS	A325			GALV ASTM A153
2	HIGH STRENGTH NUTS	A563			GALV ASTM A153
3	HIGH STRENGTH WASHERS	F436			GALV ASTM A153
4	SS ALL THREAD ANCHOR RODS	A320	B8	304	MILL FINISH
5	SS HEX BOLTS	A194	B8	304	MILL FINISH
6	SS HEX NUTS	A194	B8	304	MILL FINISH
7	SS WASHERS	A194	B8	304	MILL FINISH

MATERIAL QUANTITY

DESCRIPTION	POSTS	CONTRACT LN/FT	ACTUAL LN/FT	REMARKS
BU-25 E 89TH STREET DECORATIVE FENCE	126	554'-0	557'-104	+3'-104

BU-25 EAST 89TH STREET
FOR APPROVAL 04-26-21

 **P.H. DREW INC.**
2450 N. RACEWAY RD. - P.O. BOX 34295 INDIANAPOLIS, INDIANA 46234
PHONE : (317) 297-5152 FAX : (317) 297-5313

APPROVAL

CUY-IR490 / SR010-2.09 / 19.28
DECORATIVE FENCE
GENERAL PLANS & NOTES

REVISION	REV	DATE	DESCRIPTION	BY	STATE	OHIO
					COUNTY	CUYAHOGA (CITY OF CLEVELAND)
					PROJECT	3000 (17)
					CONTRACT	PID 96833
					SECTION	
APPROVAL RECORD					STRUCTURE	
					STATE JOB	
					CUSTOMER	LAKE ERIE CONSTRUCTION COMPANY
					CONTRACTOR	
					APPROVED	
					REFERENCE	
					ITEM	
					FINISH	SEE NOTES-SHT E300
					JOB NO.	19-1108
					TOTAL SHEETS	
					SHEET	E300


DRAWN BY
MRH
04-06-21

CHECKED BY
SRF
04-20-21

MRH NO
1914

JOB MGR
JL

DWG STATUS
APPROVAL
04-26-21

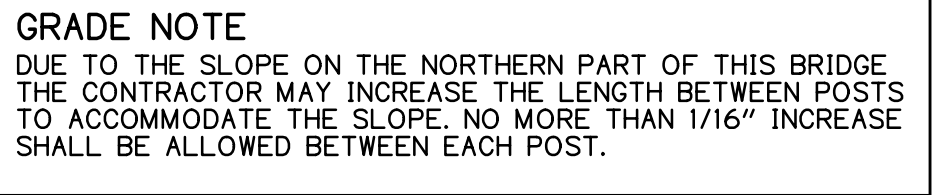

- DIMENSION NOTES**
1. ALL DIMENSIONS SHOWN ARE TAKEN FROM THE CENTERLINE OF RAIL & PARAPET.
 2. ALL DIMENSIONS SHOWN ARE IN PLAN ONLY.
 3. SEE SHEET E302 FOR ANCHOR DETAILS.

LEGEND

X > ANCHOR SETTING DETAIL

X POST NUMBER



BU-25 EAST 89TH STREET
FOR APPROVAL 04-26-21




CUY-IR490 / SR010-2.09 / 19.28


DECORATIVE FENCE

ANCHOR SETTING PLANS


REVISION	REV	DATE	DESCRIPTION		BY	STATE	OHIO		
						COUNTY	CUYAHOGA (CITY OF CLEVELAND)		
						PROJECT	3000 (17)		
						CONTRACT	PID 96833		
						SECTION			
APPROVAL RECORD						STRUCTURE			
						STATE JOB			
	DATE	ISSUED	APP DATE	APPROVAL STATUS	CUSTOMER	LAKE ERIE CONSTRUCTION COMPANY			
					CONTRACTOR				
					ARCH/ENG				
					REFERENCE				
					ITEM				
					FINISH	SEE NOTES -SHT E300			
DRAWN BY	CHECKED BY	MRH NO	JOB MGR	DWG STATUS	JOB NO.	TOTAL SHEETS	SHEET		
MRH 04-06-21	SRF 04-20-21	1914	JL	APPROVAL 04-26-21	19-1108		E301		

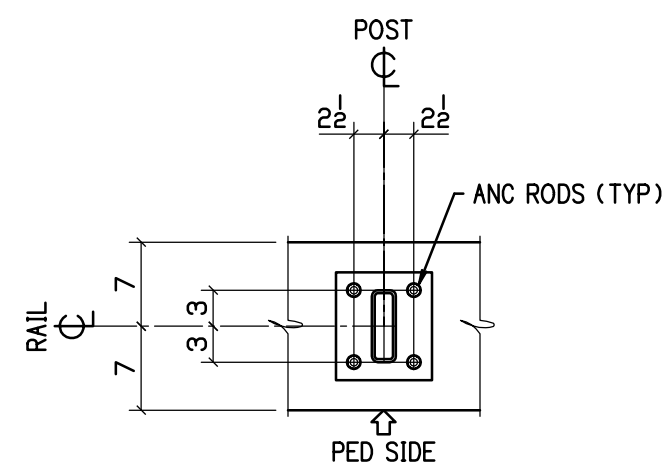


ANC DETAIL A

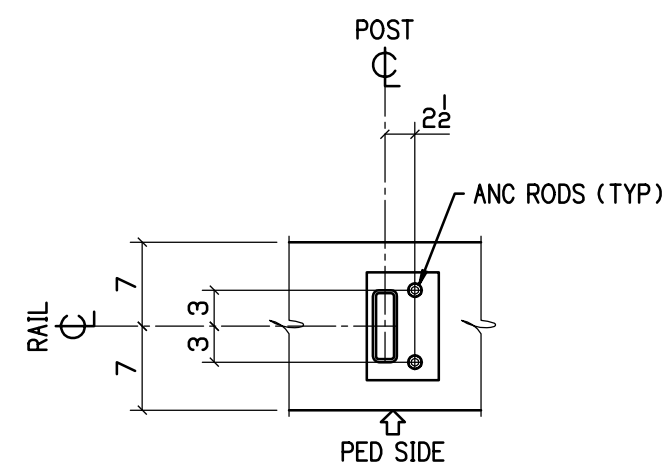


ANC DETAIL B

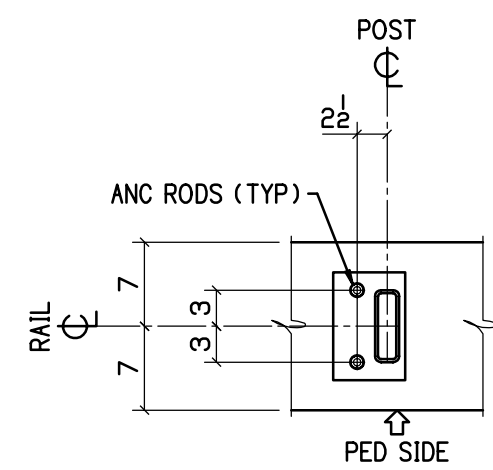


ANC DETAIL C

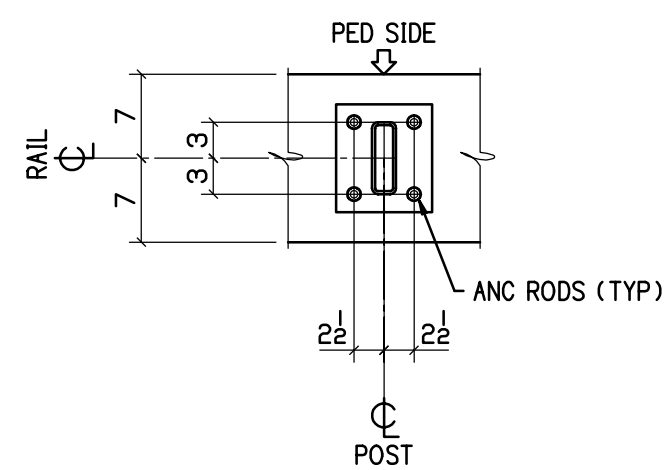


ANC DETAIL D

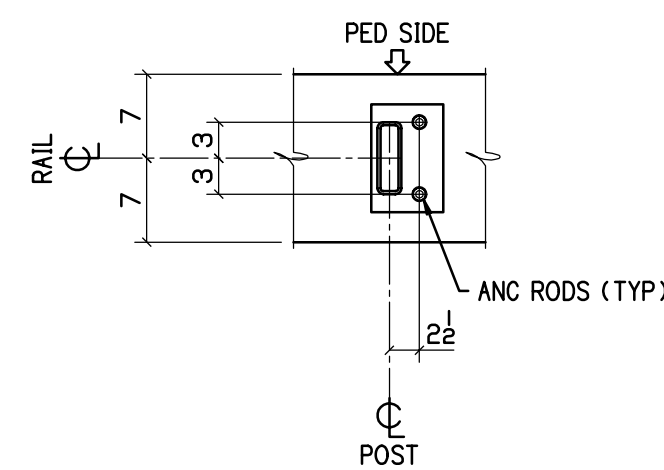


ANC DETAIL E

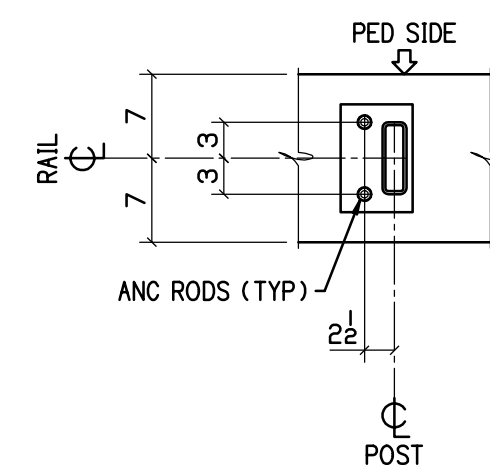


ANC DETAIL F

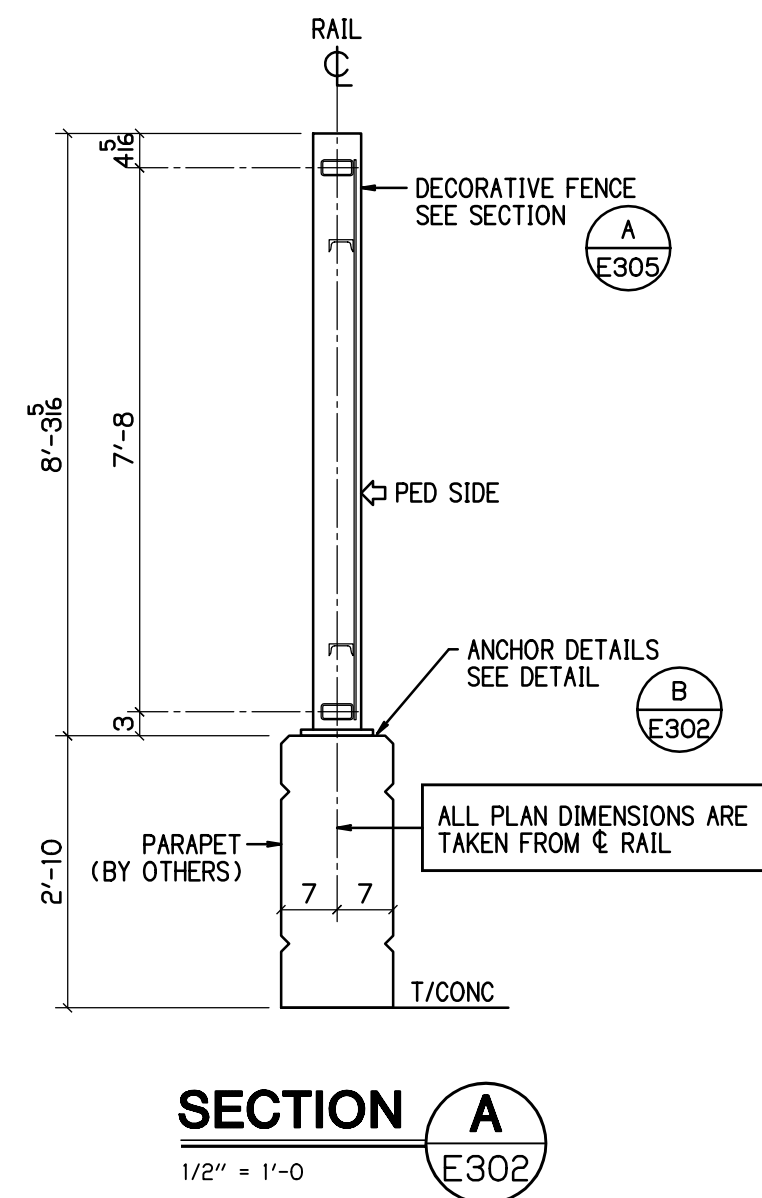


SECTION A
1/2" = 1'-0"

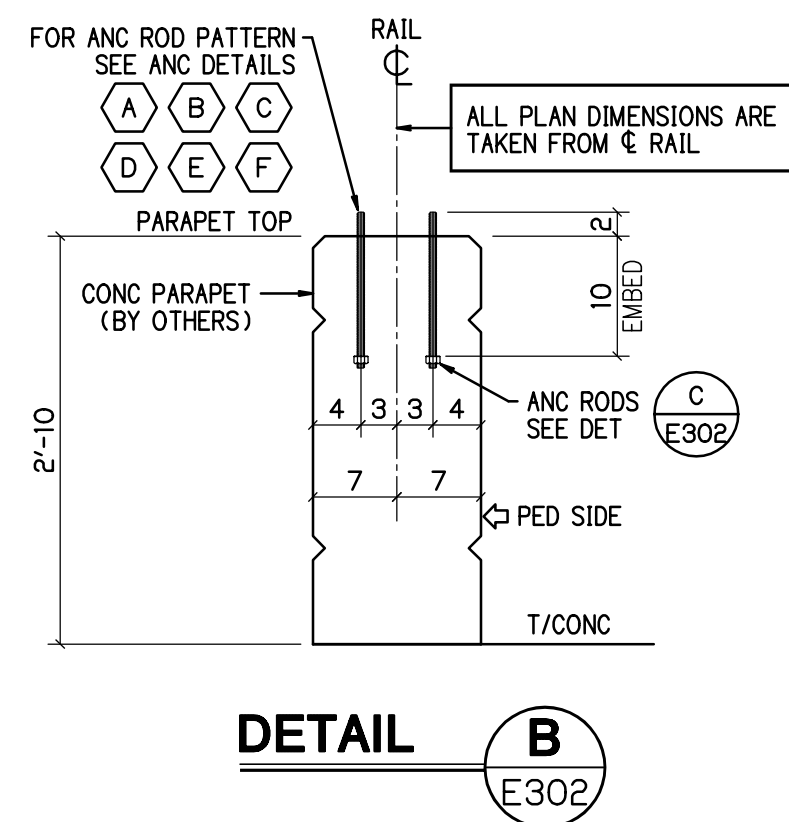


DETAIL B
E302

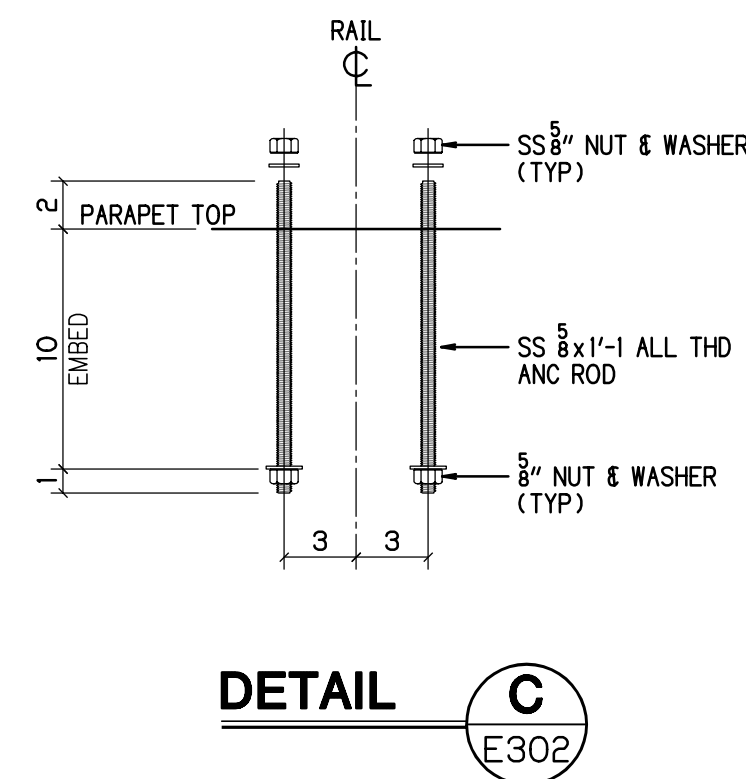


DETAIL C
E302

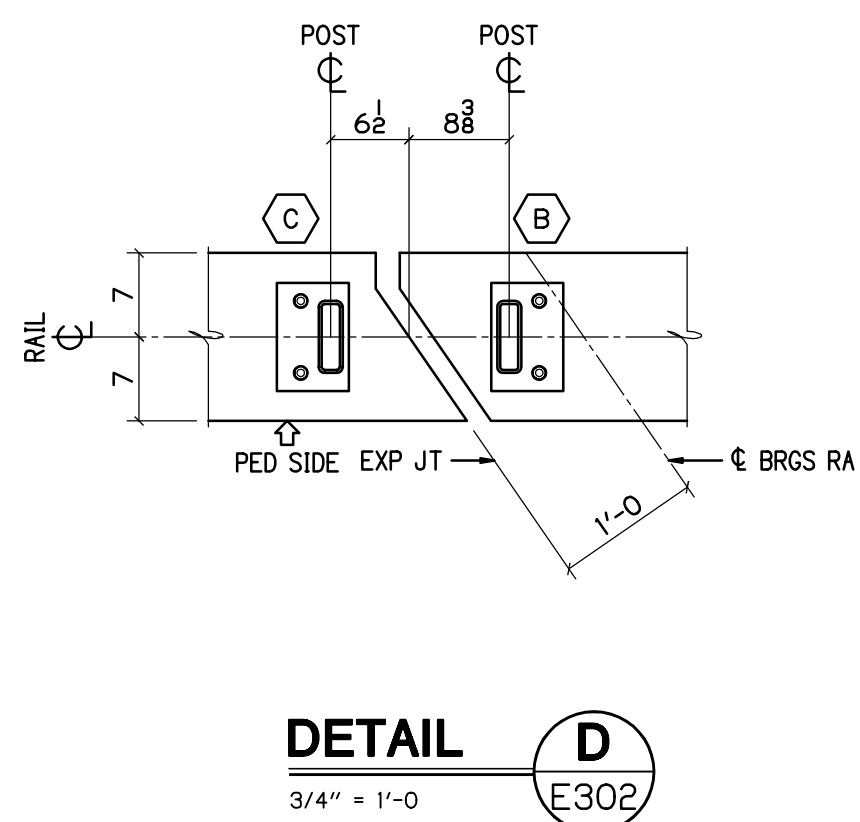


DETAIL D
3/4" = 1'-0"

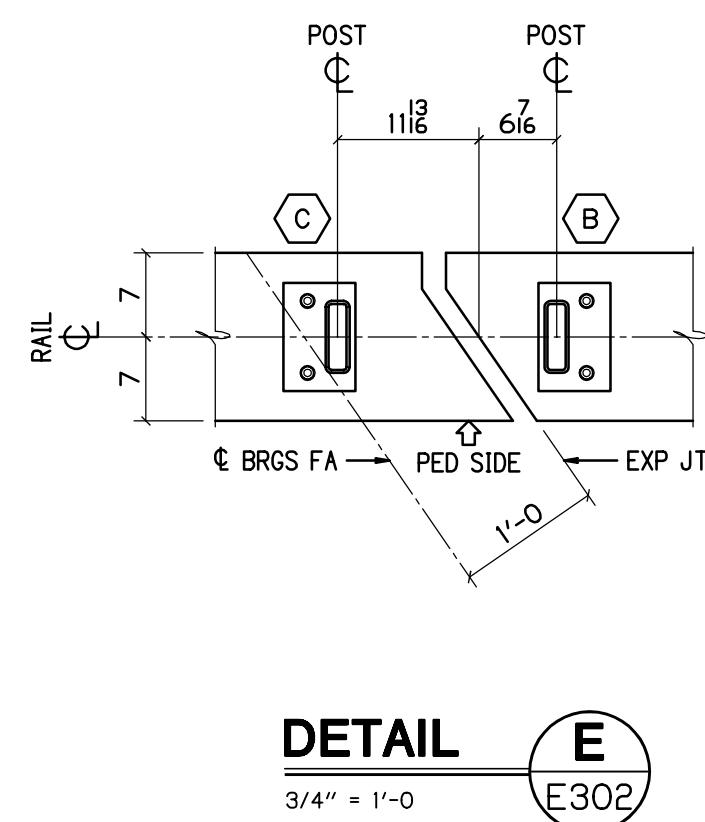

DETAIL E
3/4" = 1'-0"

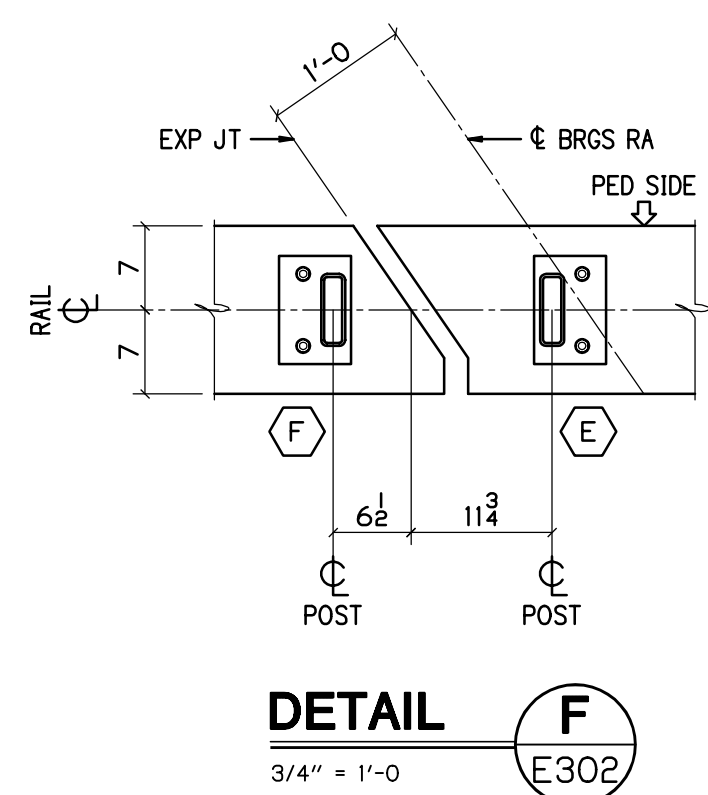

DETAIL F
3/4" = 1'-0"

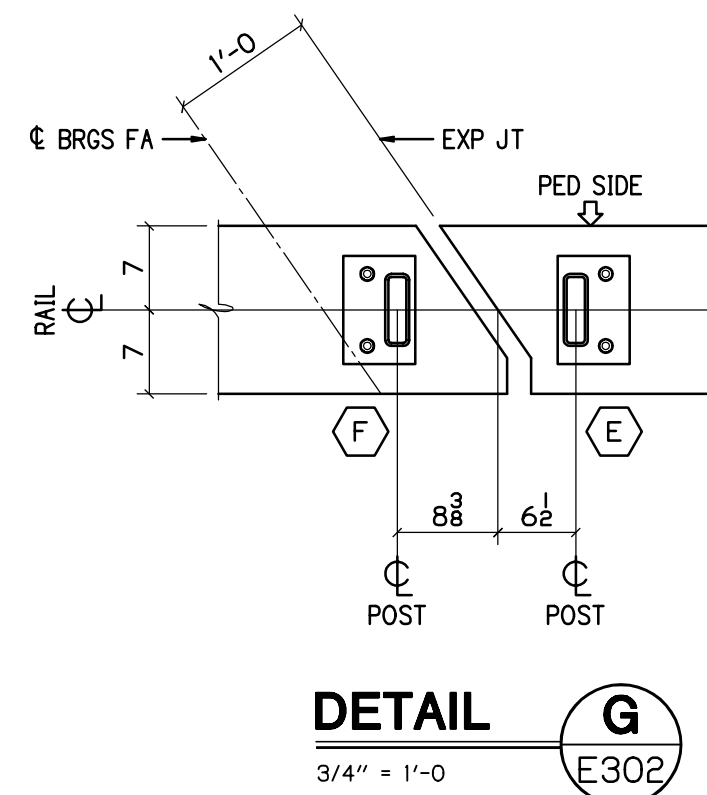


DETAIL G
3/4" = 1'-0"

BU-25 EAST 89TH STREET
FOR APPROVAL 04-26-21


P.H. DREW INC.
2450 N. RACEWAY RD. - P.O. BOX 34295
INDIANAPOLIS, INDIANA 46234
PHONE : (317) 297-5152
FAX : (317) 297-5313

CUY-IR490 / SR010-2.09 / 19.28
DECORATIVE FENCE
ANCHOR SETTING DETAILS

REV	DATE	DESCRIPTION	BY	STATE	OHIO
				COUNTY	CUYAHOGA (CITY OF CLEVELAND)
				PROJECT	3000 (17)
				CONTRACT	PID 96833
				SECTION	
				STRUCTURE	
				STATE JOB	
DATE	ISSUED	APP. DATE	APPROVAL STATUS	CUSTOMER	LAKE ERIE CONSTRUCTION COMPANY
				CONTRACTOR	
				APPROVED	
				REFERENCE	
				ITEM	
				FINISH	SEE NOTES-SHT E300
DRAWN BY	CHECKED BY	MRH NO	JOB MGR	DWG STATUS	JOB NO.
MRH	SRF	1914	JL	APPROVAL	19-1108
04-06-21	04-20-21			04-26-21	TOTAL SHEETS
					SHEET
					E302

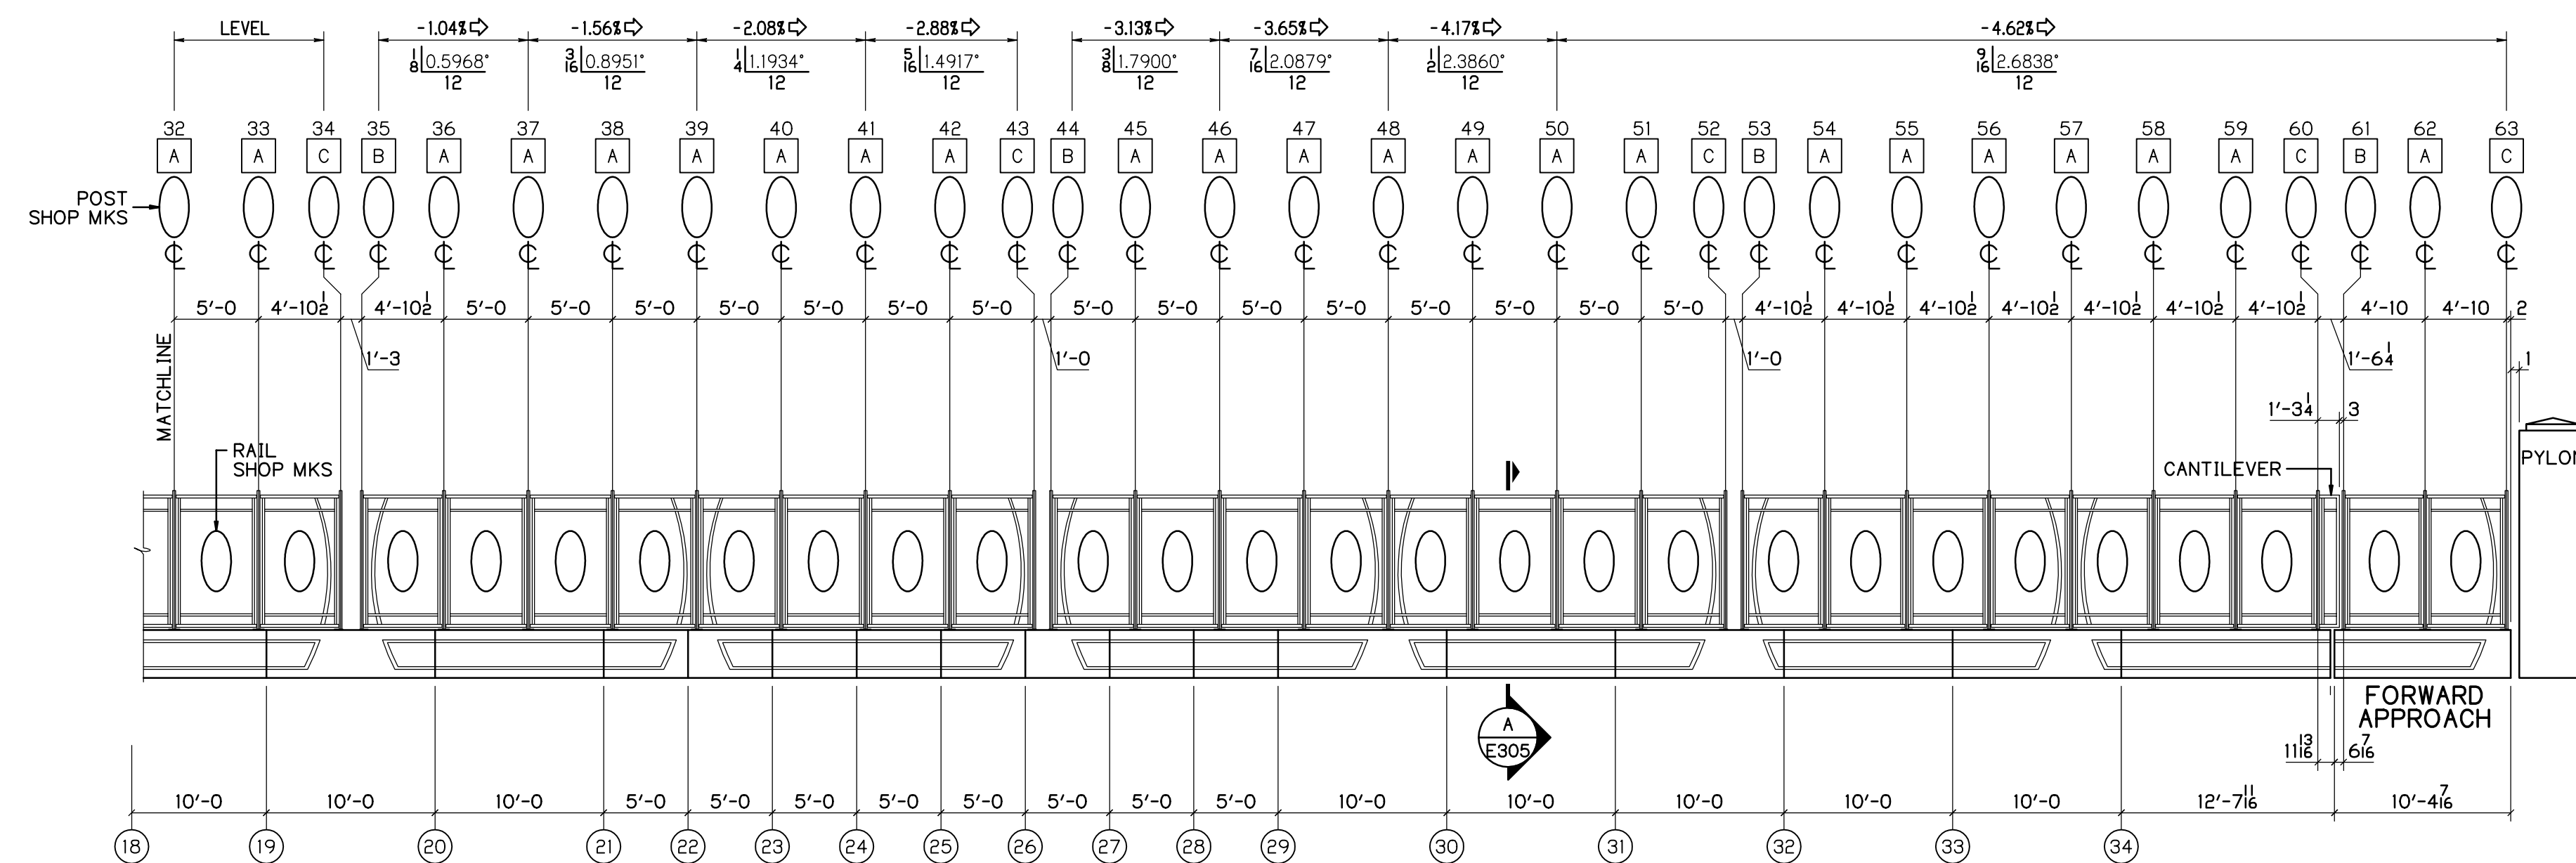

PEDESTRIAN SIDE SHOWN
NO WIRE ROPE


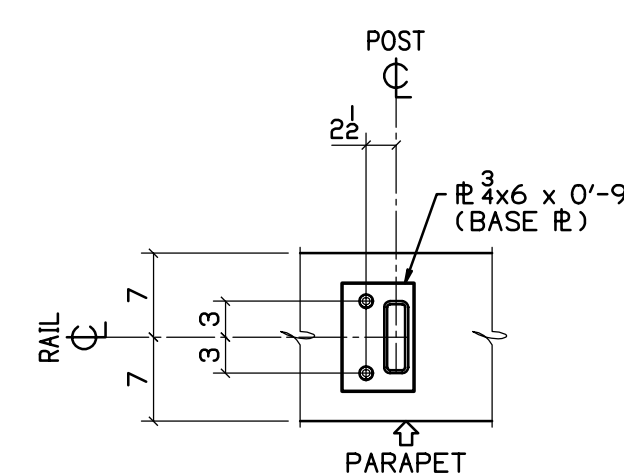


BASE & DETAIL C


[illegible]

X POST NUMBER


<h1 style="margin: 0;">BU-25 EAST 89TH STREET</h1> <h1 style="margin: 0;">FOR APPROVAL 04-26-21</h1>										
				<h2 style="margin: 0;">P.H. DREW INC.</h2>				APPROVAL		
2450 N. RACEWAY RD. - P.O. BOX 34295 INDIANAPOLIS, INDIANA 46234				PHONE : (317) 297-5152 FAX : (317) 297-5313						
<h2 style="margin: 0;">CUY-IR490 / SR102-2.09 / 19.28</h2> <h3 style="margin: 0;">DECORATIVE FENCE</h3> <h3 style="margin: 0;">WEST PARAPET RAIL ELEVATION</h3>										
REVISION	REV	DATE	DESCRIPTION	BY	STATE					
APPROVAL RECORD	DATE	ISSUED	APP. DATE	APPROVAL STATUS	CUSTOMER					
					JOB NO.	TOTAL SHEETS		SHEET		
MRH 04-26-21					19-1108		E303			

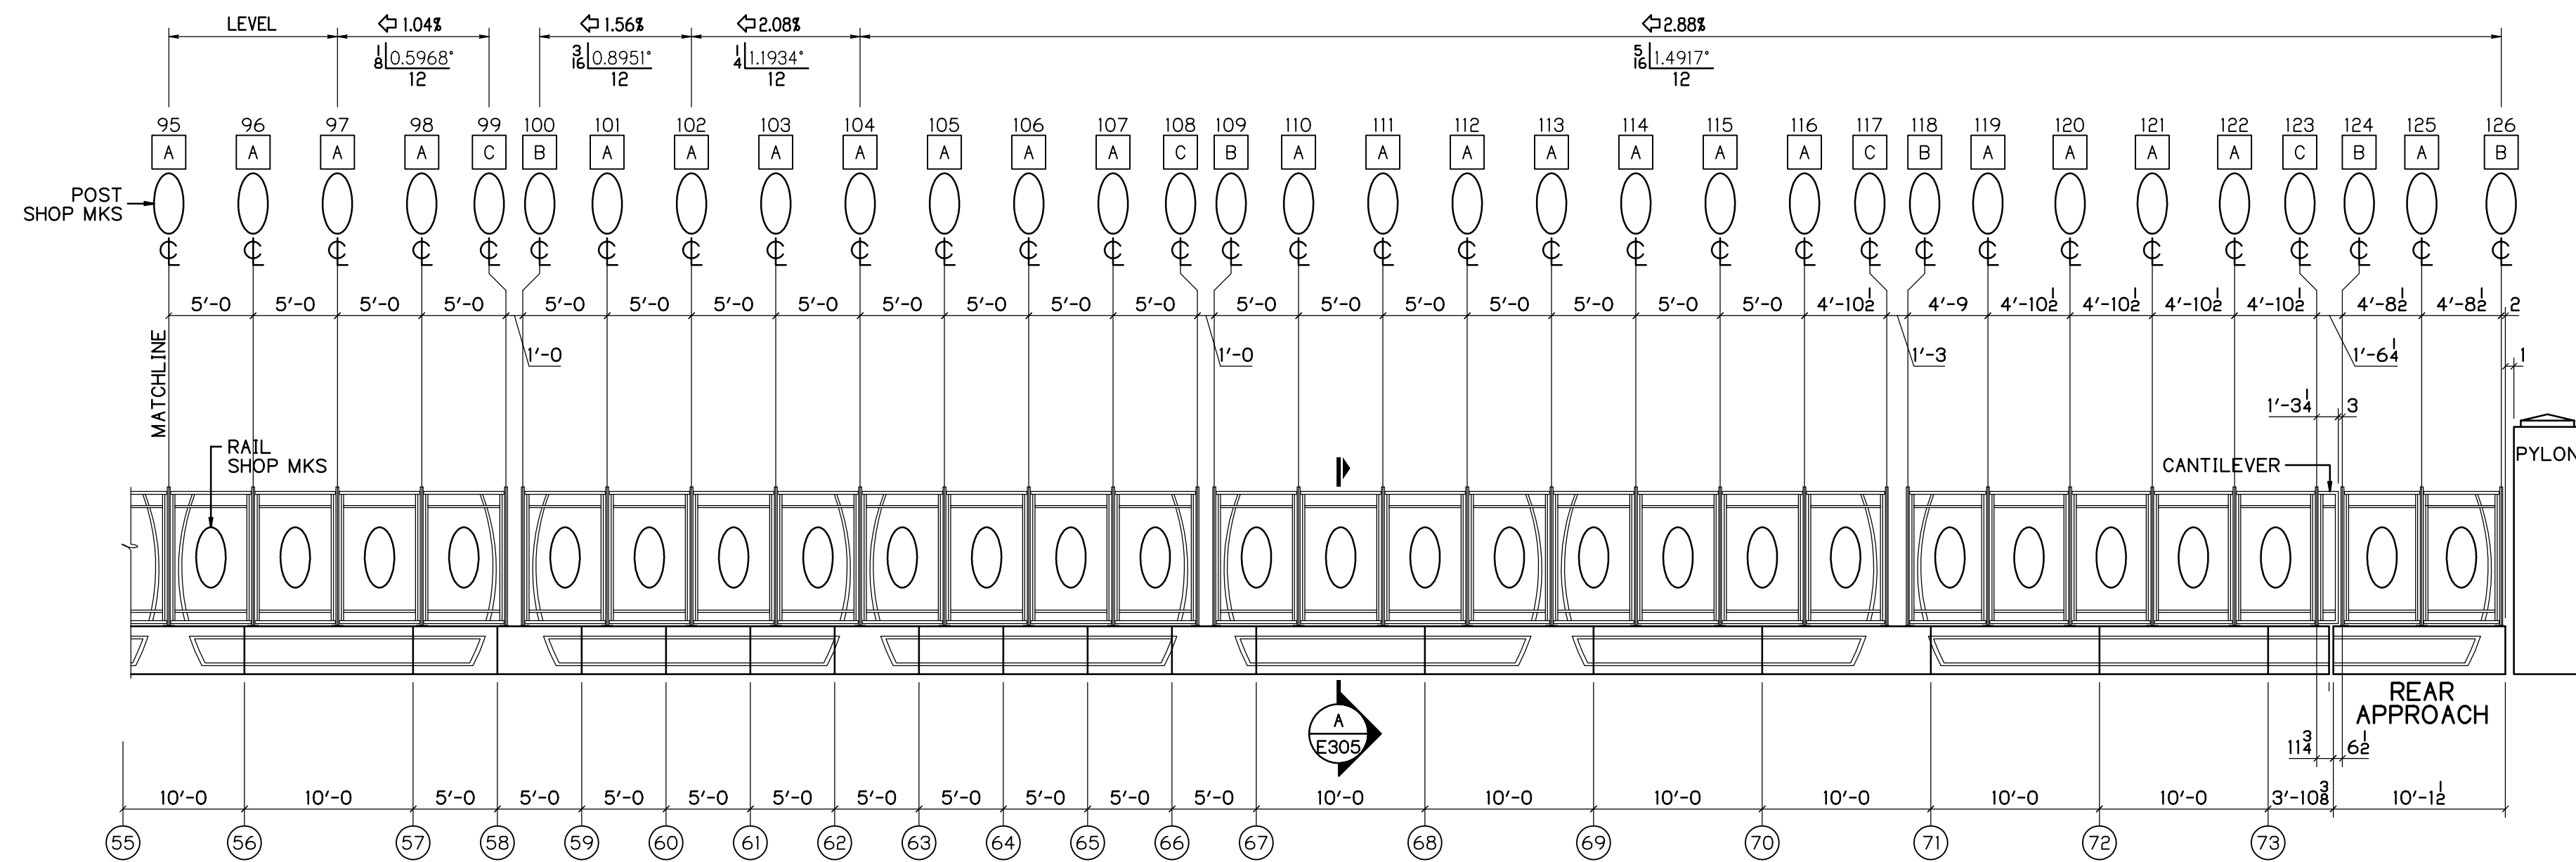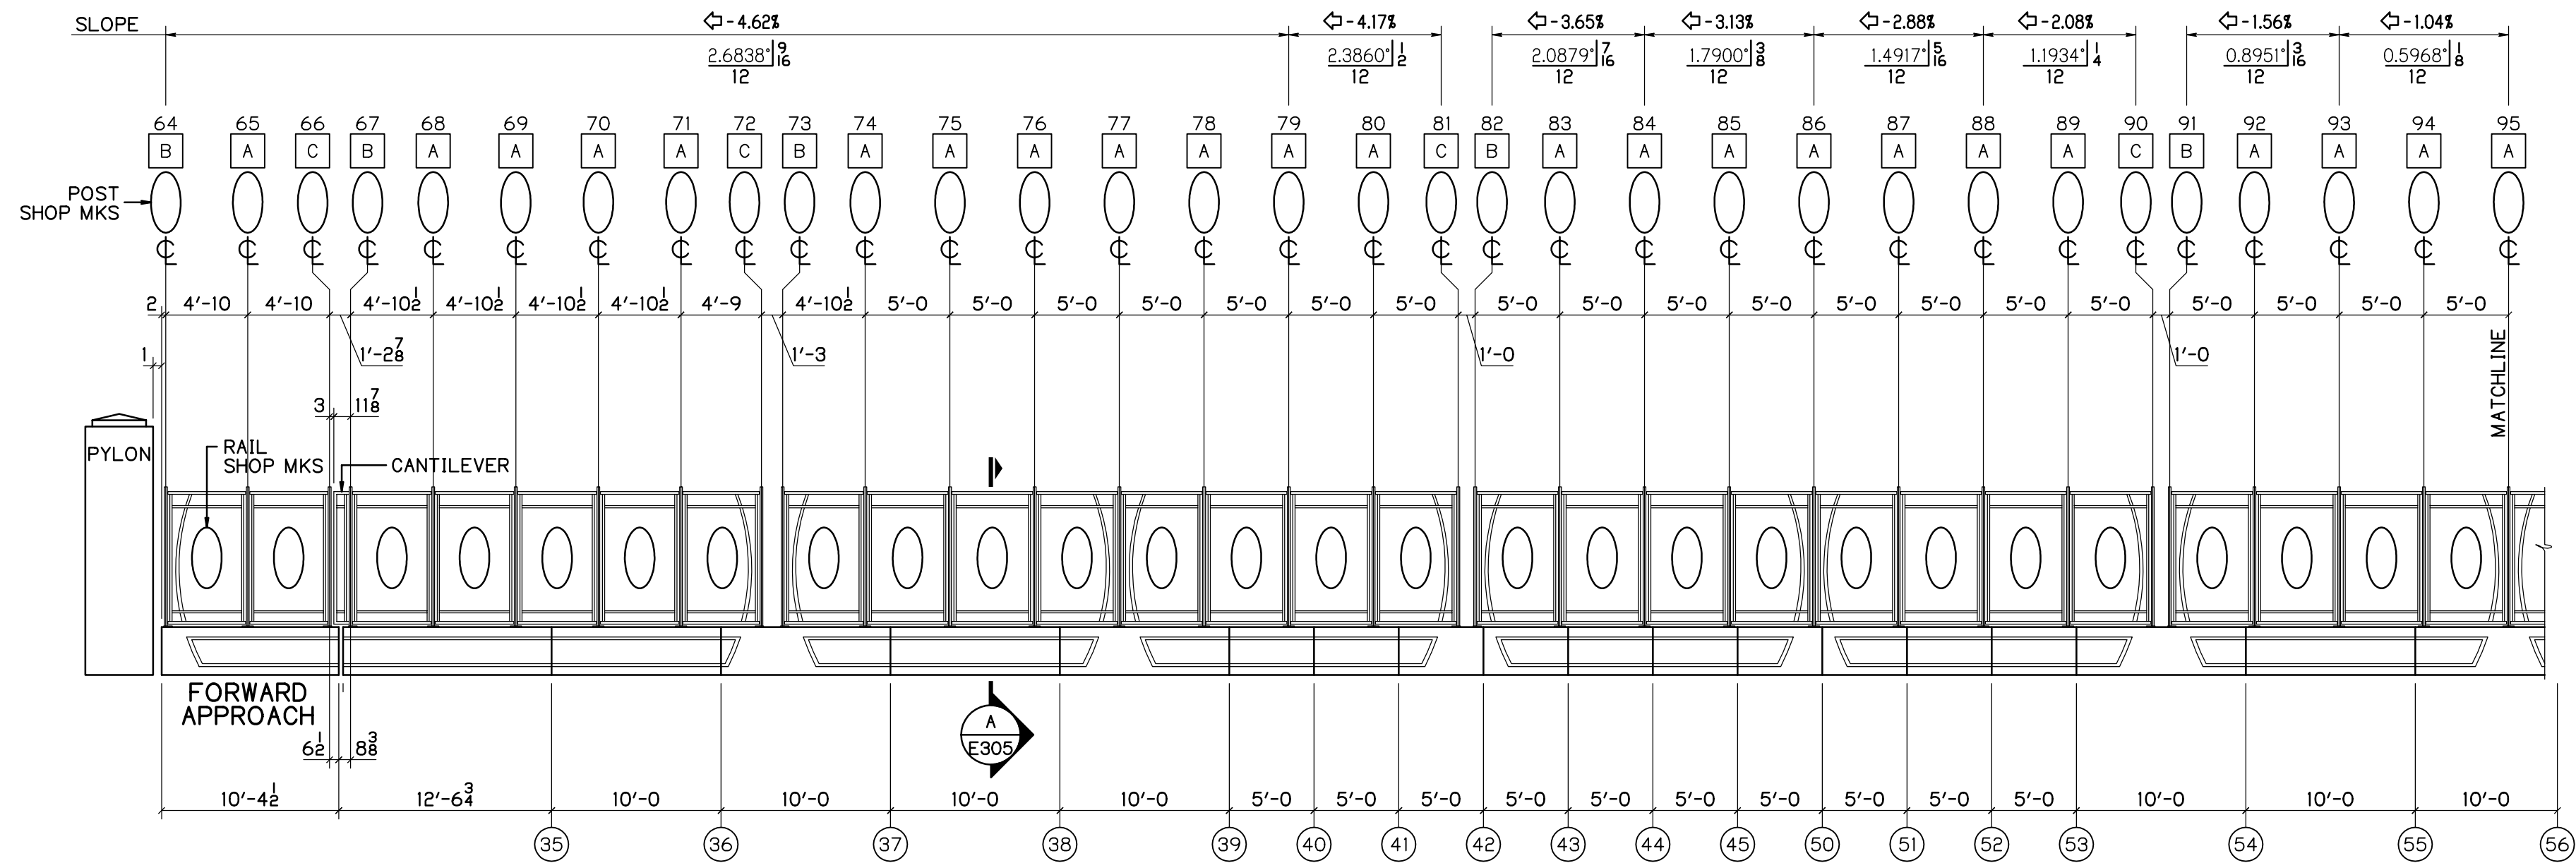


EAST PARAPET RAIL ELEVATION
PEDESTRIAN SIDE SHOWN
NO WIRE ROPE

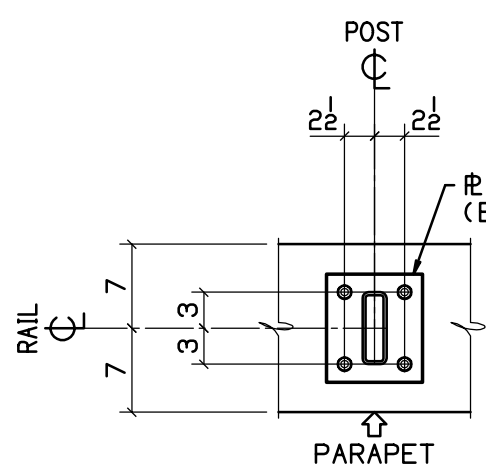

BASE R DETAIL **A**

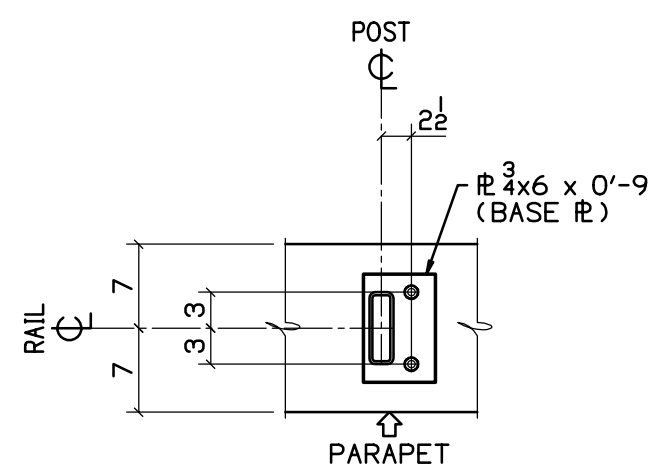

BASE R DETAIL **B**

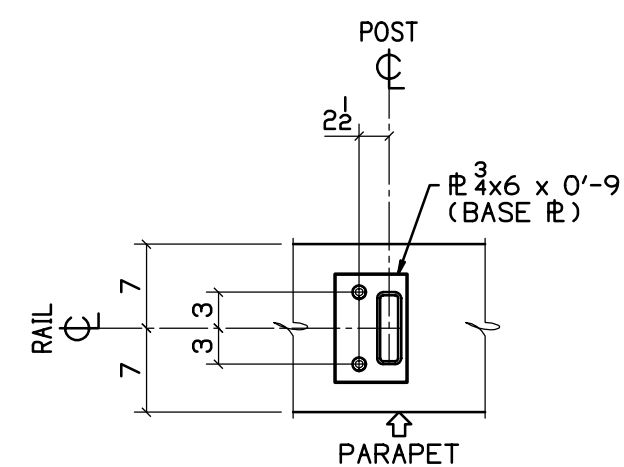

BASE R DETAIL **C**

POST COUNT	
QUAN	MARK
X	X

RAIL COUNT	
QUAN	MARK
X	X

CLAMP BAR COUNT	
QUAN	MARK
X	X

WIRE MESH COUNT	
QUAN	MARK
X	X

RAILING NOTES

- ALL POSTS SHALL BE SET PLUMB, RAILS SHALL FOLLOW GRADE.

WIRE MESH NOTES

- SEE SHOP DRAWINGS FOR WIRE MESH & CLAMP BAR INSTALLATION.

DIMENSION NOTES

- ALL DIMENSIONS SHOWN ARE TAKEN FROM THE CENTERLINE OF RAIL.
- ALL DIMENSIONS SHOWN ARE IN PLAN ONLY.
- SEE SHEET E302 FOR ANCHOR DETAILS.

LEGEND


- X BASE R DETAIL
⊗ CONTR OR EXP JOINT NUMBER
X POST NUMBER

BU-25 EAST 89TH STREET
FOR APPROVAL 04-26-21




CUY-IR490 / SR010-209 / 19.28
DECORATIVE FENCE
EAST PARAPET RAIL ELEVATION



REVISION	REV	DATE	DESCRIPTION	BY	STATE	OHIO
					COUNTY	CUYAHOGA (CITY OF CLEVELAND)
					PROJECT	3000 (17)
					CONTRACT	PID 96833
					SECTION	
APPROVAL RECORD					STRUCTURE	
					STATE JOB	
					CUSTOMER	LAKE ERIE CONSTRUCTION COMPANY
					CONTRACTOR	
					APPROVAL	
					REFERENCE	
					ITEM	
					FINISH	SEE NOTES-SHT E300
					JOB NO.	19-1108
					TOTAL SHEETS	
					SHEET	E304

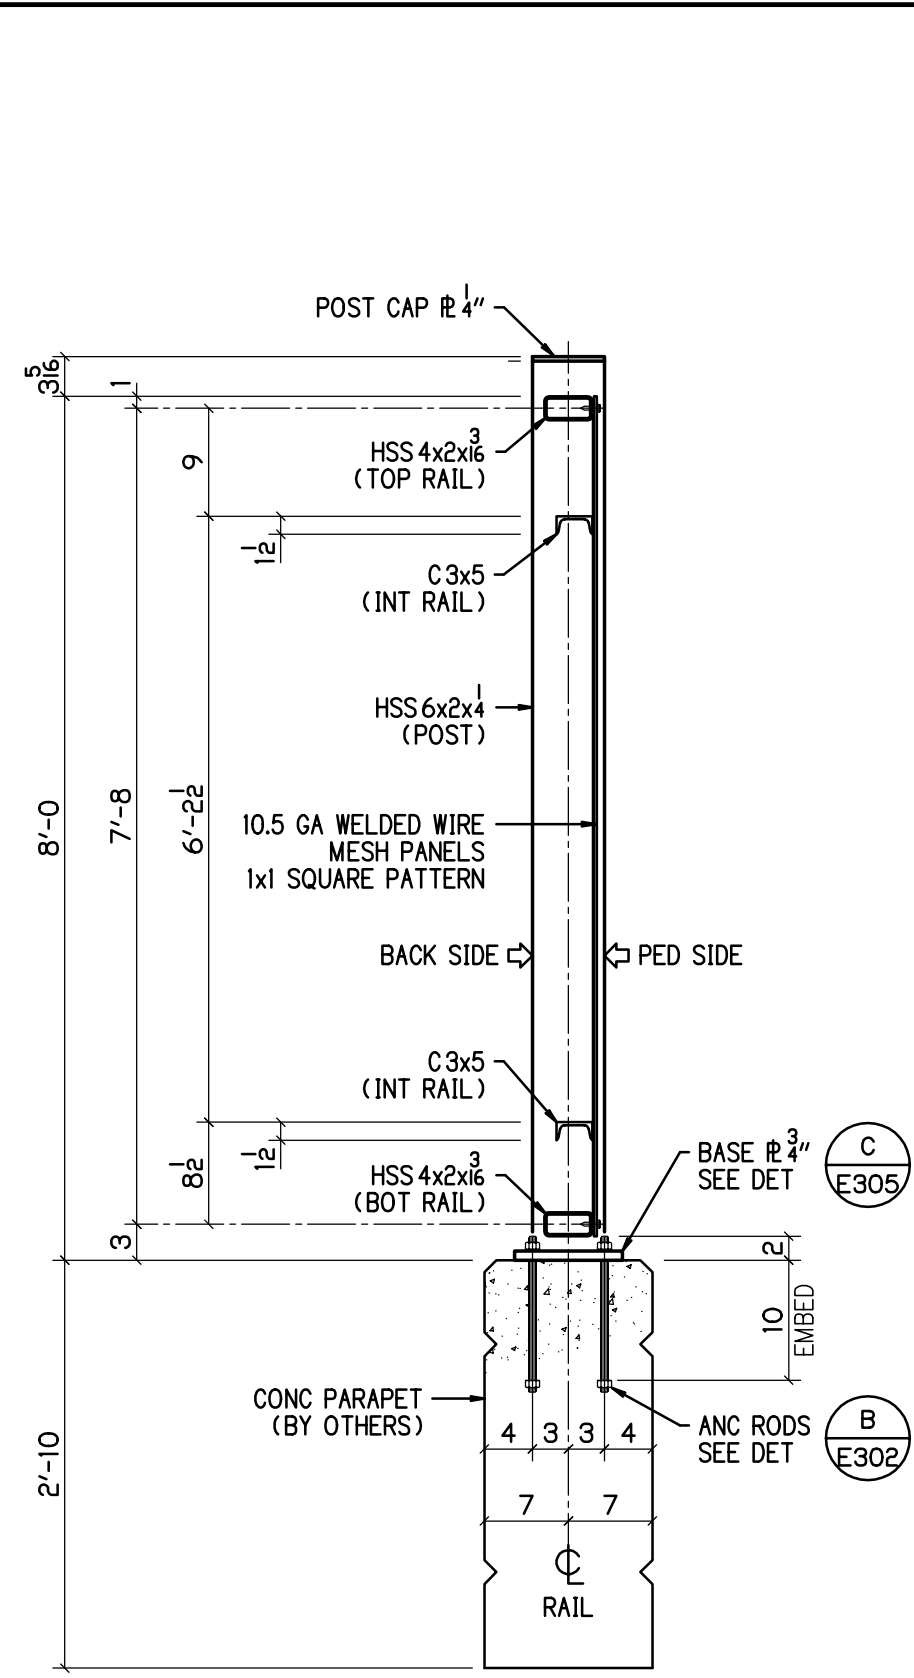



SECTION A
3/4" = 1'-0"

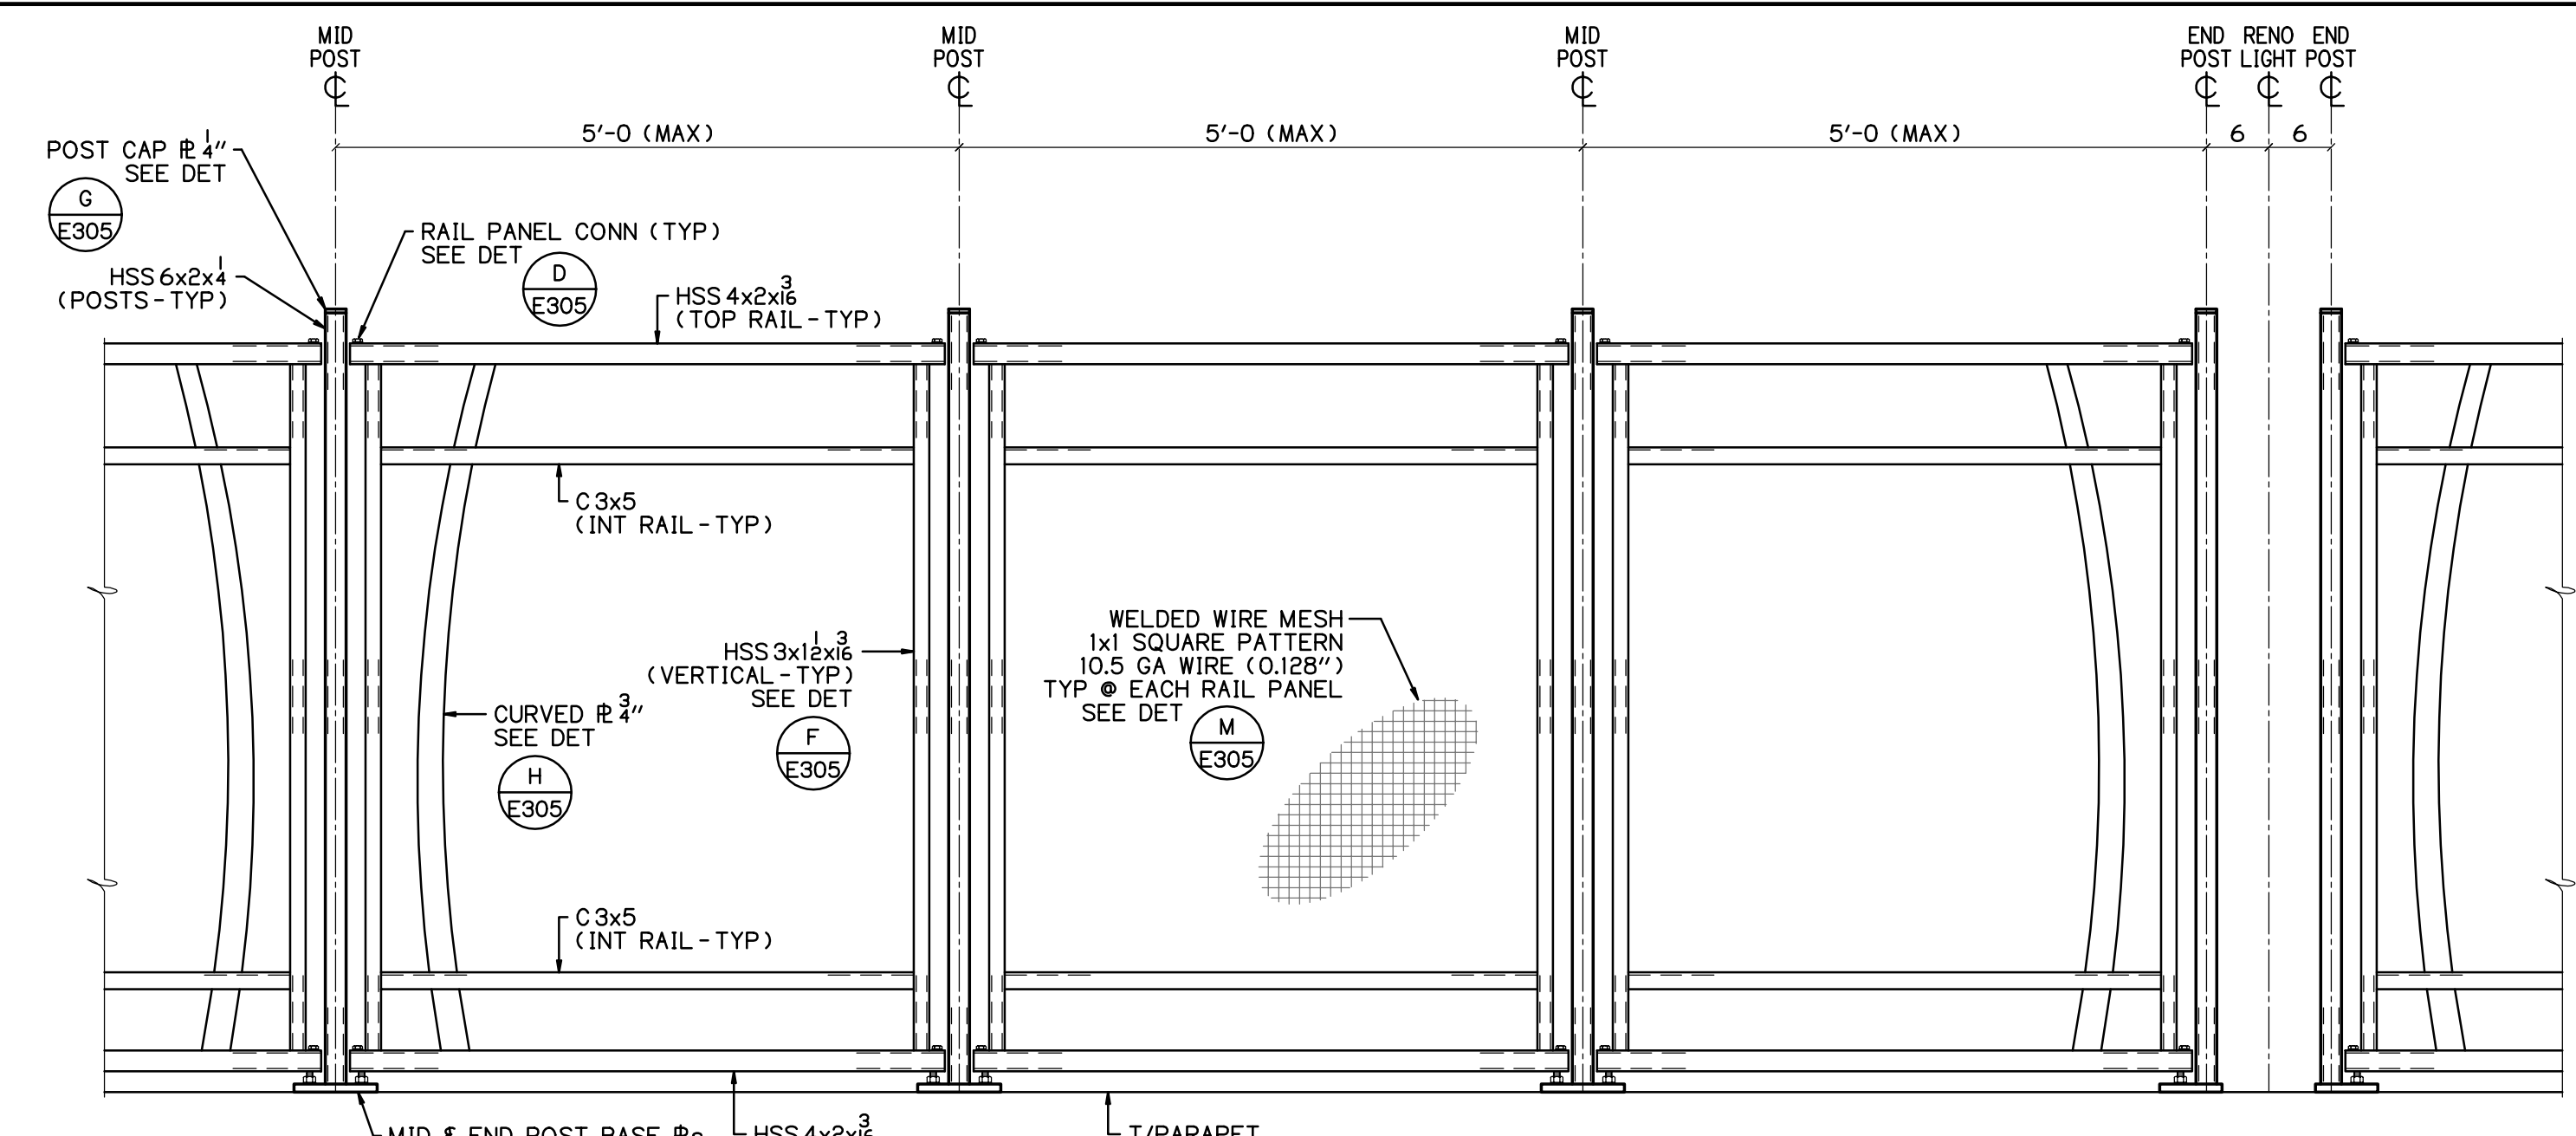


TYP FENCE RAIL ELEVATION
PEDESTRIAN SIDE SHOWN

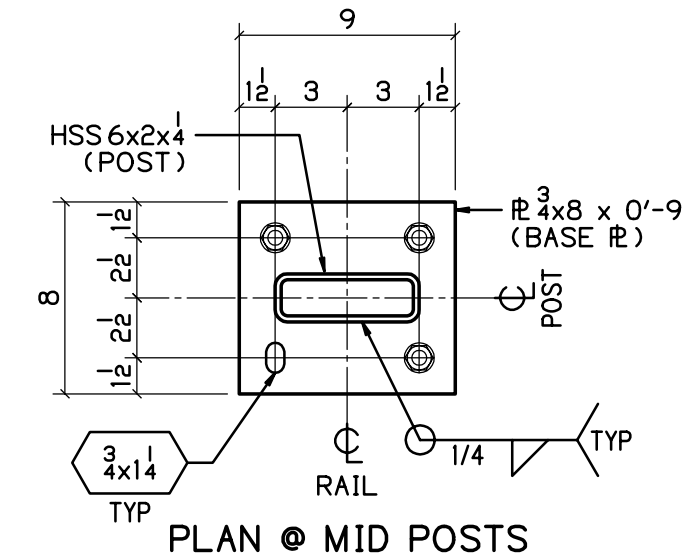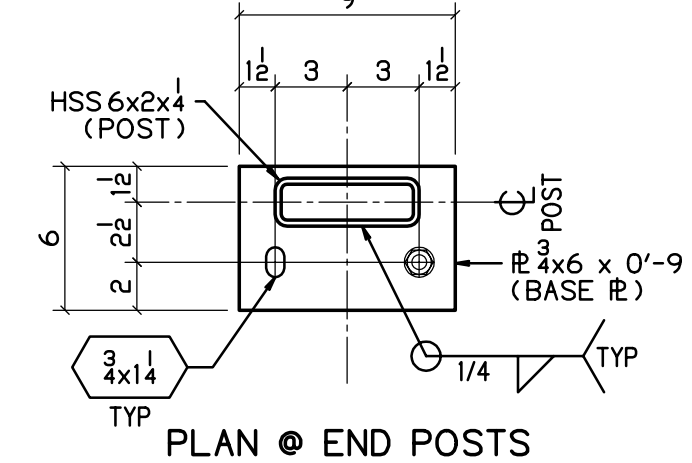


DETAIL C
1 1/2" = 1'-0"

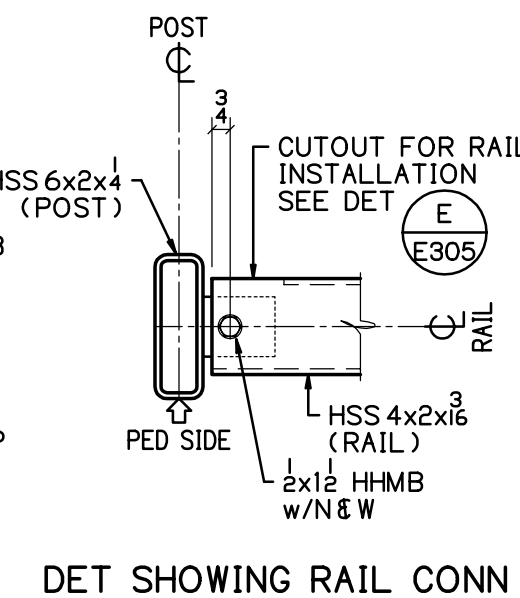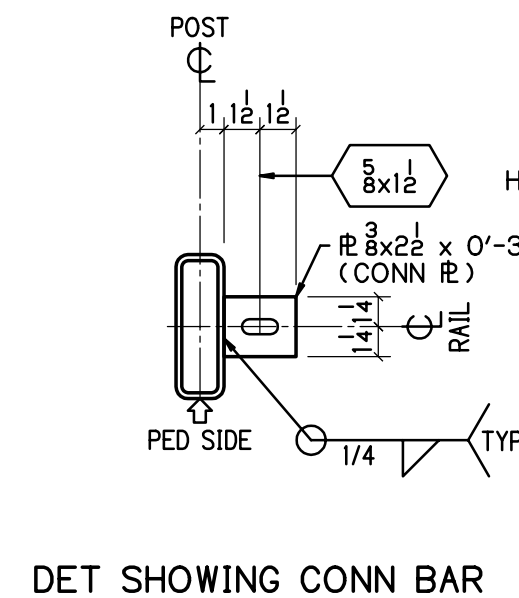


DETAIL D
1 1/2" = 1'-0"

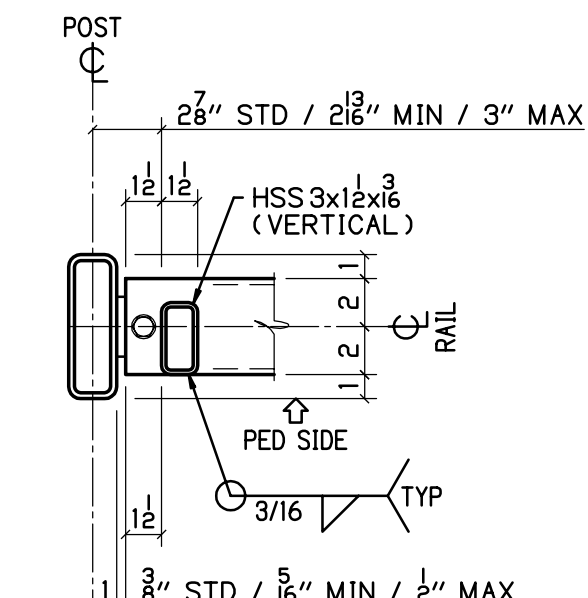


DETAIL E
1 1/2" = 1'-0"

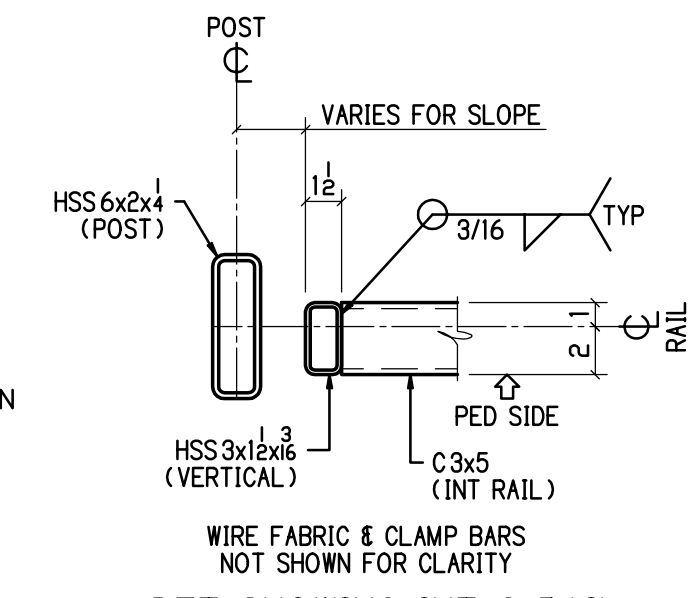


DETAIL F
1 1/2" = 1'-0"

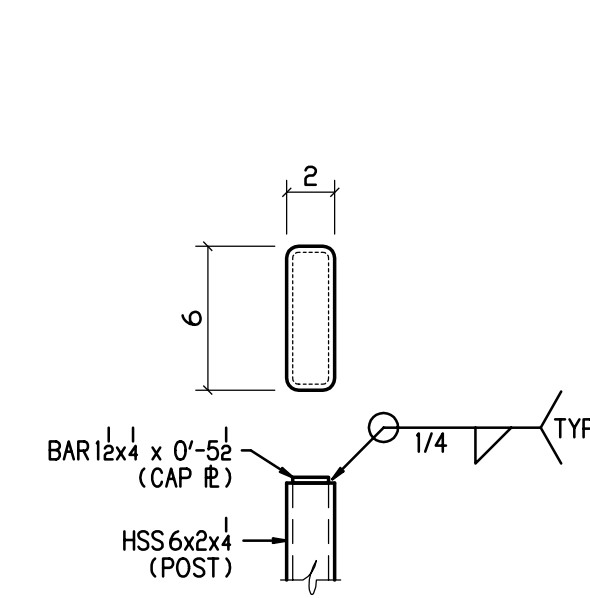


DETAIL G
1 1/2" = 1'-0"

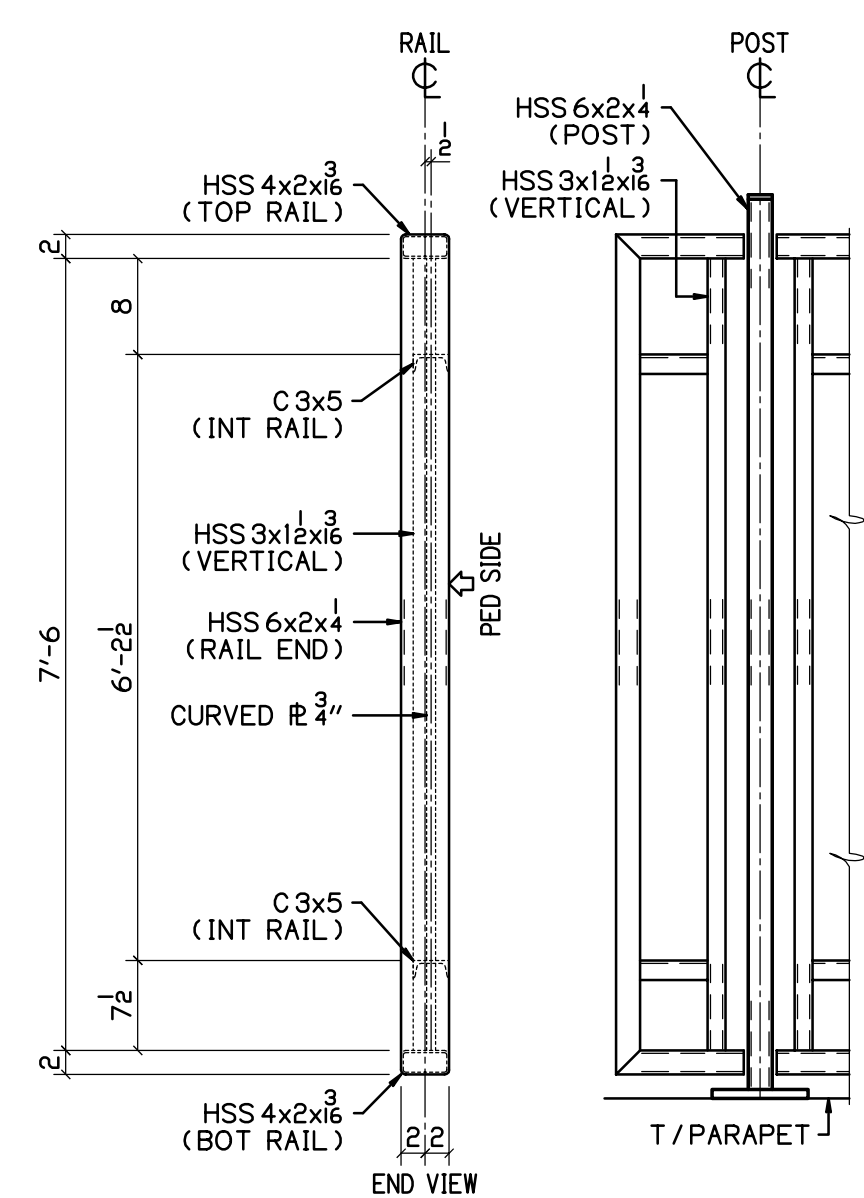


TYP RAIL CANTILEVER
PEDESTRIAN SIDE SHOWN

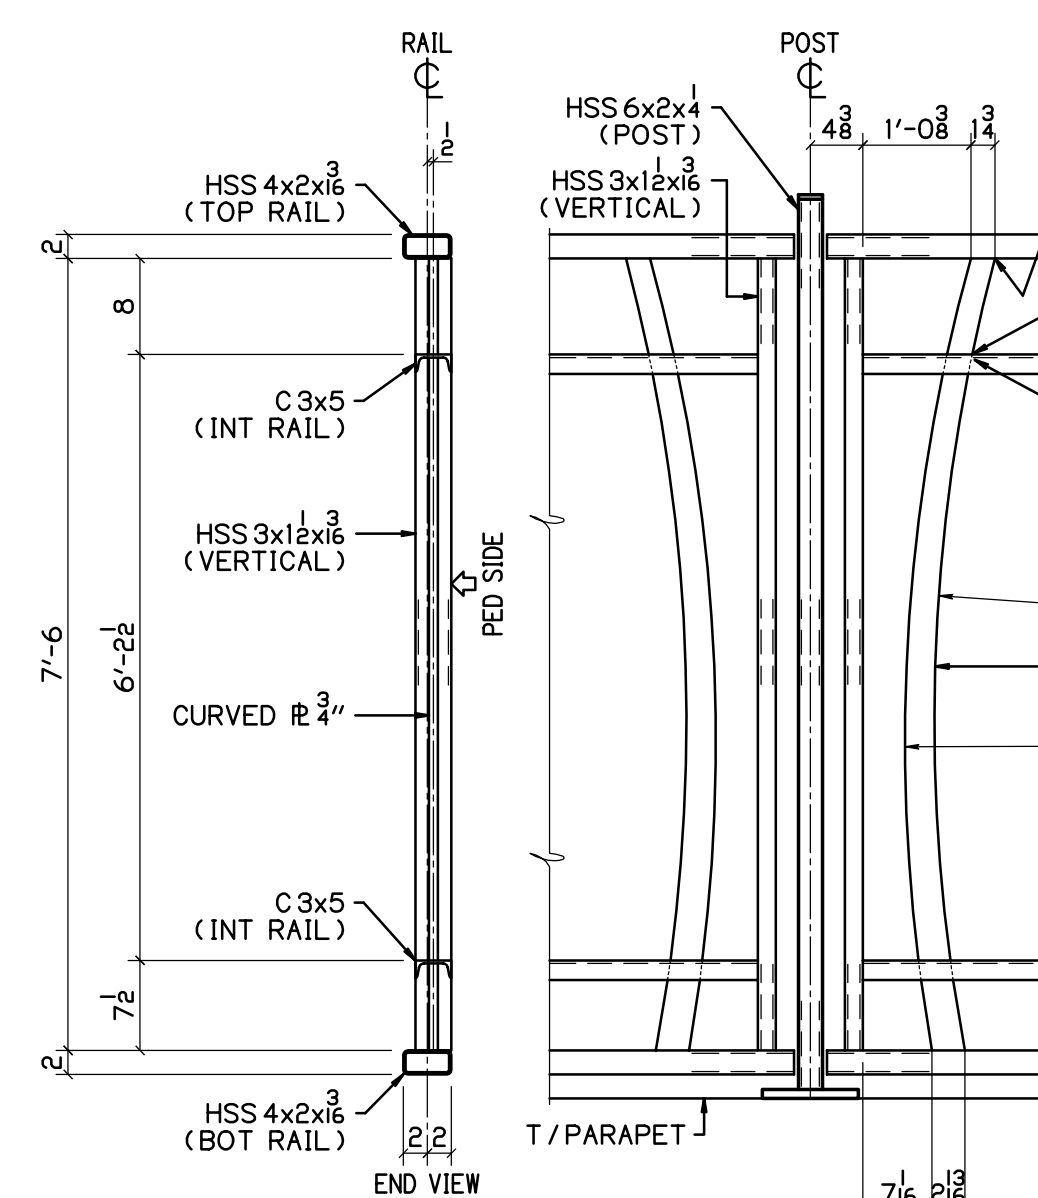


DETAIL H
3/4" = 1'-0"

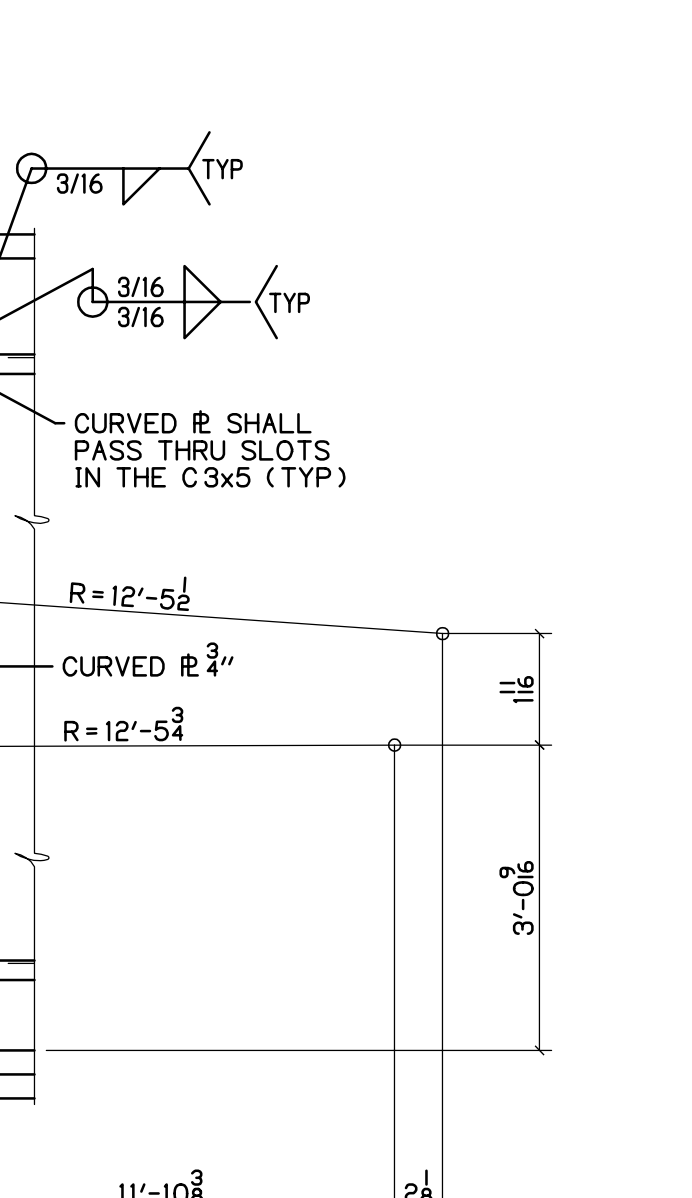


DETAIL H
3/4" = 1'-0"

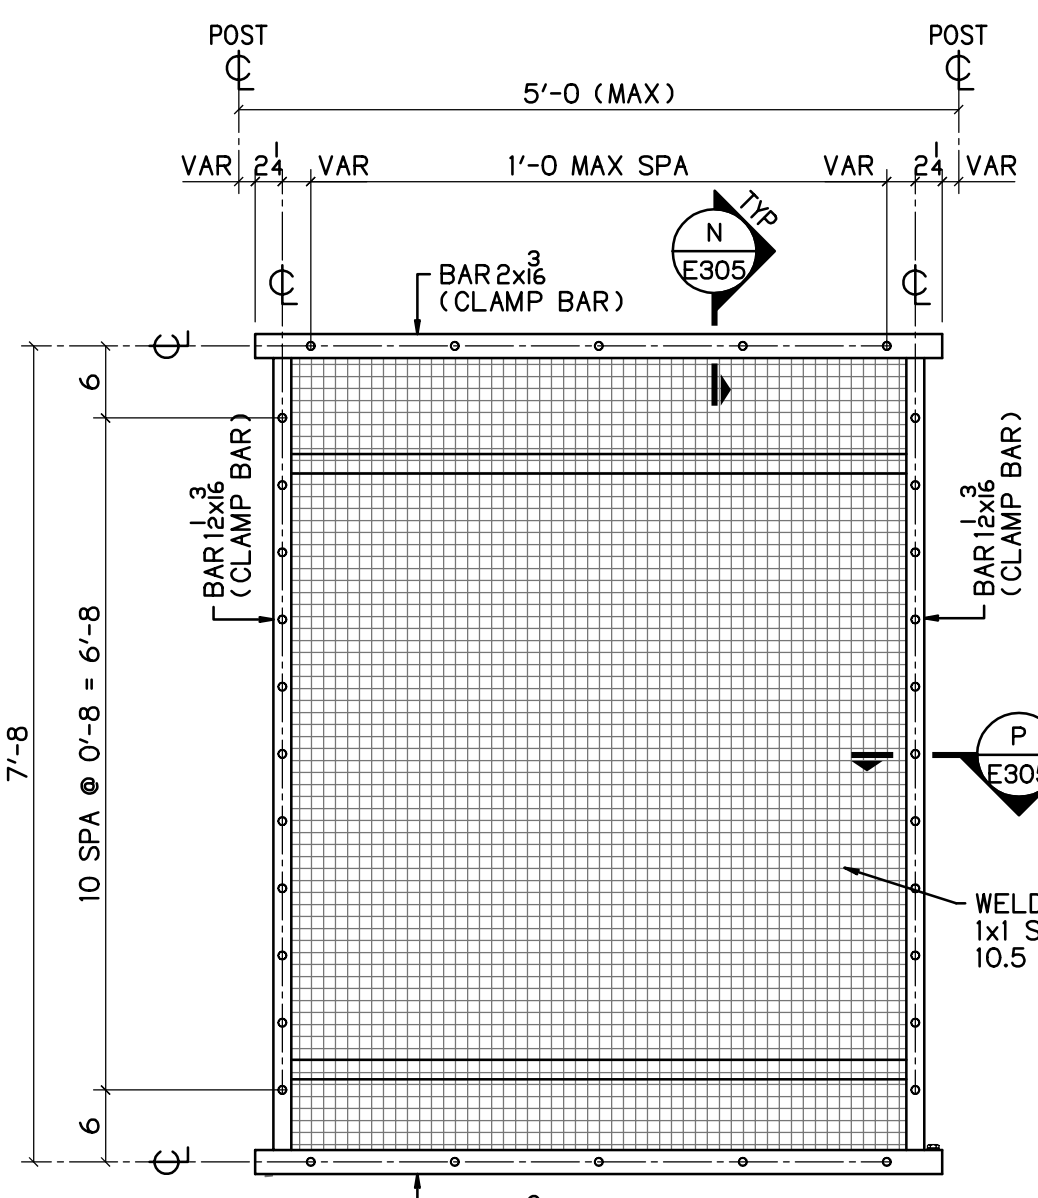


TYP WIRE MESH ELEVATION
PEDESTRIAN SIDE SHOWN

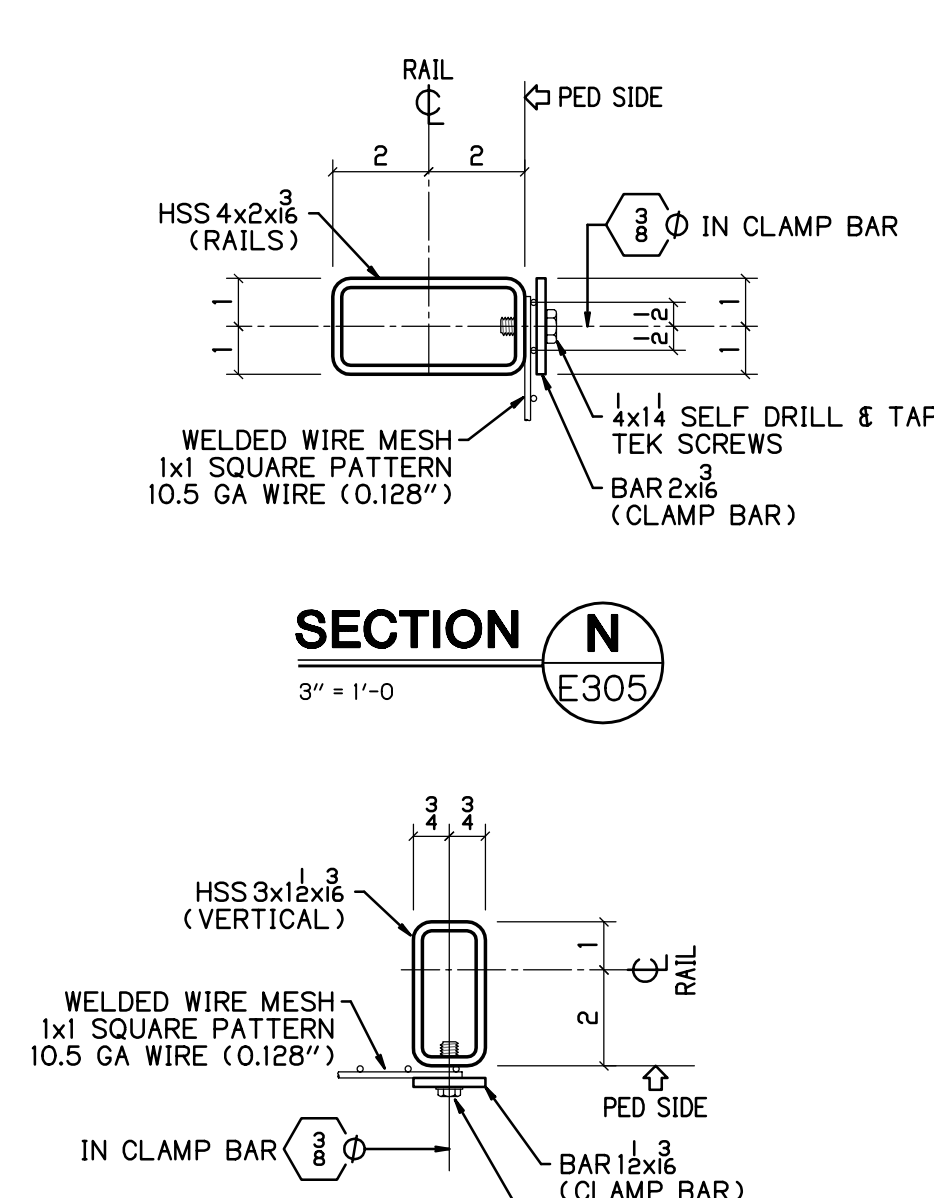

SECTION N
3" = 1'-0"

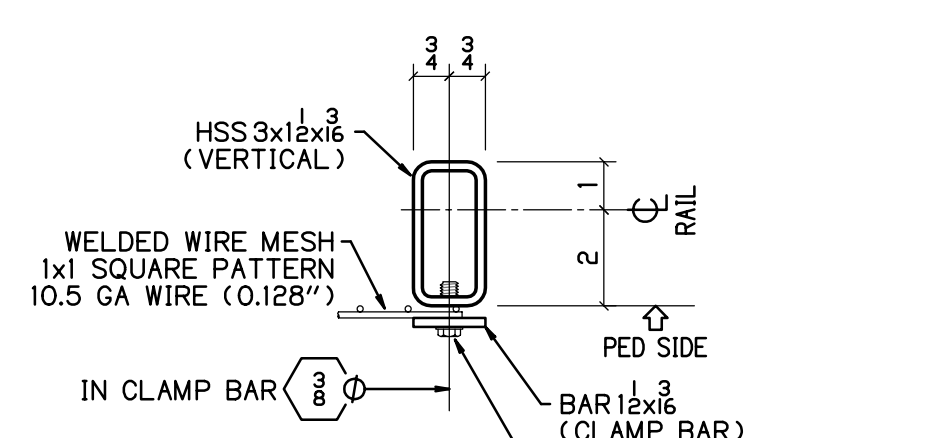

SECTION P
3" = 1'-0"

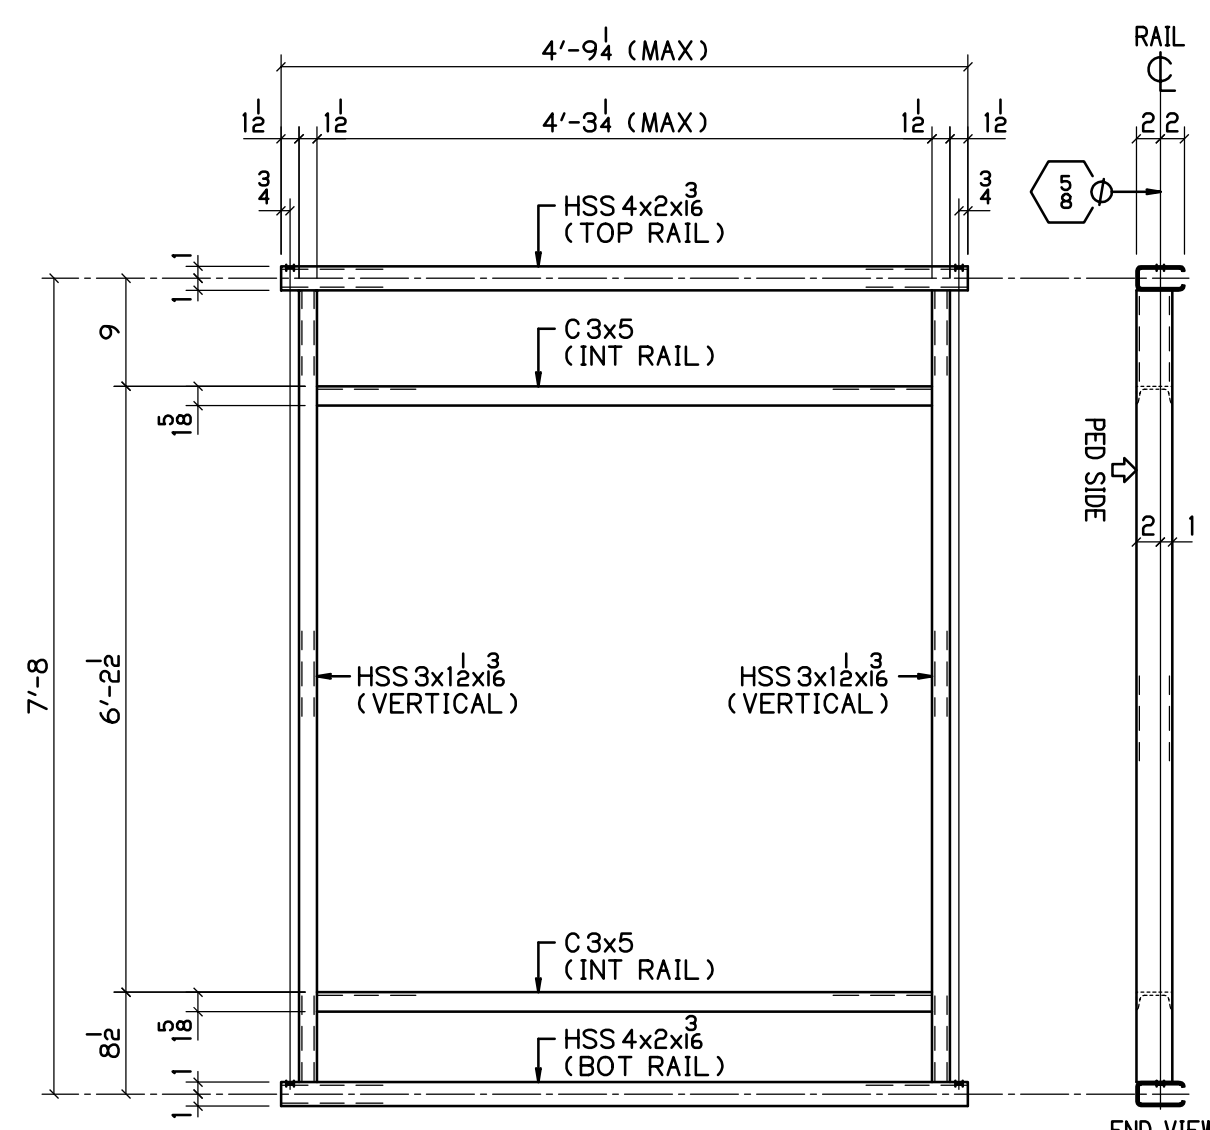

TYP FENCE RAIL DETAIL
LEVEL AND SLIGHT SLOPE

PEDESTRIAN SIDE SHOWN

BU-25 EAST 89TH STREET
FOR APPROVAL 04-26-21

P.H. DREW INC.
2450 N. RACEWAY RD. - P.O. BOX 34295
INDIANAPOLIS, INDIANA 46234
PHONE : (317) 297-5152
FAX : (317) 297-5313

CUY-IR490 / SR010-2.09 / 19.28
DECORATIVE FENCE
RAIL STANDARD DETAILS

REV	DATE	DESCRIPTION	BY	STATE	OHIO
				COUNTY	CUYAHOGA (CITY OF CLEVELAND)
				PROJECT	3000 (17)
				CONTRACT	PID 96833
				SECTION	
				STRUCTURE	
				STATE JOB	
				CUSTOMER	LAKE ERIE CONSTRUCTION COMPANY
				CONTRACTOR	
				APPROVING	
				REFERENCE	
				ITEM	
				FINISH	SEE NOTES-SHT E300
				JOB NO.	19-1108
				TOTAL SHEETS	19-1108
				SHEET	E305



Nondestructive Examination Report Magnetic Particle

Page 1 of 2

Client:	Kokosing Construction Company, Inc.	Date:	4/12/2022
Address:	6235 Westerville Road	RNDT Job #:	J22-1358
	Westerville, OH 43081	Cust. P.O.#:	
Location:	Cleveland, OH		
Spec. / Code:	ASTM E709-21		
Accept. Std.	No cracks located at arc strike locations		
NDE Procedure:	RNDT-MT-709D, Rev. 1		
Job Name:	Pedestrian Bridge - Woodland Ave		
Subcontract #:	16051-069	ODOT Project #:	173000
Type of Inspection:	Dry magnetic particle (MT) examination, in accordance with the above mentioned procedure, utilizing equipment, materials and values noted on page 2 of this report.		
Item Description:	Arc strike locations		
Areas Inspected:	Arc strike locations		

Examination Results

By use of a dry powder magnetic particle examination, fifty-six (56) arc strike areas were examined. The area of interest was all arc strike areas as directed by Kokosing Construction Company personnel. No cracks were noted at the time of inspection and the arc strike areas were found to be acceptable IAW the above noted acceptance criteria.

Technician:	George Scott Hollingsworth	Level	II	Date:	4/12/2022
Signature:					
Technique Sheet Attached:	Yes	Additional Attachments:	No		
All inspection results are valid only at the time of inspection.					



NDT Technique Record Magnetic Particle



Page 2 of 2

Client: Kokosing Construction Company, Inc.		Date: 4/12/2022	
Address: 6235 Westerville Road		RNDT Job #: J22-1358	
Westerville, OH 43081		Cust. P.O.#:	
Location: Cleveland, OH			
Spec. / Code: ASTM E709-21			
Accept. Std.: No cracks located at arc strike locations			
NDE Procedure: RNDT-MT-709D, Rev. 1			
Job Name: Pedestrian Bridge - Woodland Ave			
Subcontract #: 16051-069		ODOT Project #: 173000	
WELDS		OTHER TEST ITEMS	
Weld Joint	N/A	Type of Item	HAZ
Weld Process	N/A	Processing	Unknown
Base Material	N/A	Material	Carbon Steel
Thickness	N/A	Dimensions	1" around arc strike
Weld Length / OD	N/A	Additional Info.	see below
Surface	N/A	Surface Condition	As processed
PRECLEAN:	Method N/A	Material N/A	Batch No. N/A
EQUIPMENT:	Make Parker Industries	Model No. B300, SN 28599	Cal. Due. 9/22/2022
CURRENT:	Amps Fixed AC		
CONTACTS:			
Contact Material: Carbon steel articulating legs		Cable Size: N/A	
Prod / Leg Spacing: 4" to 6", pie gage used to verify		Coil Turns: N/A	
Lighting Equipment: N/A		Light Meter: N/A	
PARTICLE TYPE: Dry - Ancolor Red		Lot Number: 128259	
Vehicle Ambient Air			
Application: Powder applicator, light dusting during application of current. Excess powder removed with puff bulb.			
METHOD: Continuous			
DEMAG: Method N/A		Residual Field After Demag: N/A	
POSTCLEAN: Method N/A		Batch No. N/A	
OTHER INFORMATION: Arc strike areas were power sanded/ground to repair arc strike and remove surface rust immediately prior to testing, the need to pre-clean was eliminated by this action.			
Technician: George Scott Hollingsworth		Level II	Date: 4/12/2022
Signature:			
Attachments: No		Pictures No	
All inspection results are valid only at the time of inspection.			



TIME AND MATERIALS FORM

CLIENT: Kokosing Construction

DATE: 4/11/2022

LOCATION: Cleveland, OH

RNDT JOB NO: J22-1358

PO:

CONTACT: Scott Hartenstine

Project: Woodland Ave Pedestrian Bridge - Cleveland

Subcontract #: 16051-069

ODOT Project # 173000

NAME	SHIFT	HOURS ON SITE	TRAVEL TIME	TOTAL HOURS
George Scott Hollingsworth	1	5	7	12

VEHICLE ID NUMBER: Truck #95

MILES: 394 miles

ARRIVAL TIME: 9:00 AM

DEPARTURE TIME: 2:00 PM

JOB SCOPE: MT: (56) Arc strike locations

MATERIALS: (2) 1b. anc color red


COMMENTS:


The following signatures verify the above entries made, and work performed, are acceptable and accurate. It also verifies that a daily safety meeting was held prior to the start of work.


RNDT, Inc. Representative April 12, 2022
Date


Client Representative April 12, 2022
Date

Job Safety Analysis

 <p>RNDT, Inc. Job Number: <u>J22-1358</u></p> <p>Date: <u>2022-04-12</u></p>	<p>Client:</p> <p>Kokosing Construction Company</p>	<p>Job Location (Including GPS Coordinate if required):</p> <p>Pedestrian Bridge 9005 Woodland Avenue Cleveland, OH</p>															
<p>Performed Tasks:</p> <p><input type="checkbox"/> Radiographic Inspection</p> <p><input checked="" type="checkbox"/> Magnetic Particle Inspection</p> <p><input type="checkbox"/> Penetrant Inspection</p> <p><input type="checkbox"/> Ultrasonic Inspection</p> <p><input type="checkbox"/> Visual Inspection</p> <p><input type="checkbox"/> Other _____</p>	<p>Personnel Performing Tasks:</p> <p>Name (Print): <u>George Scott Hollingsworth</u></p> <p>Signature: _____</p> <p>Name (Print): _____</p> <p>Signature: _____</p> <p>Name (Print): _____</p> <p>Signature: _____</p>																
<p>Required Personal Protective Equipment (PPE):</p> <table style="width: 100%;"> <tr> <td><input checked="" type="checkbox"/> Safety Toe Shoes</td> <td><input type="checkbox"/> Metatarsal Boots</td> <td><input type="checkbox"/> Other <u>covid-19 mask</u></td> </tr> <tr> <td><input checked="" type="checkbox"/> Safety Glasses</td> <td><input checked="" type="checkbox"/> High Visibility Clothing</td> <td><input type="checkbox"/> Other <u>survey meter</u></td> </tr> <tr> <td><input type="checkbox"/> Hearing Protection</td> <td><input checked="" type="checkbox"/> Hard Hat</td> <td><input type="checkbox"/> Other <u>dosimetry</u></td> </tr> <tr> <td><input type="checkbox"/> Leather Gloves</td> <td><input type="checkbox"/> FR Clothing</td> <td></td> </tr> <tr> <td><input type="checkbox"/> Metacarpal Gloves</td> <td><input type="checkbox"/> Fall Protection</td> <td></td> </tr> </table>			<input checked="" type="checkbox"/> Safety Toe Shoes	<input type="checkbox"/> Metatarsal Boots	<input type="checkbox"/> Other <u>covid-19 mask</u>	<input checked="" type="checkbox"/> Safety Glasses	<input checked="" type="checkbox"/> High Visibility Clothing	<input type="checkbox"/> Other <u>survey meter</u>	<input type="checkbox"/> Hearing Protection	<input checked="" type="checkbox"/> Hard Hat	<input type="checkbox"/> Other <u>dosimetry</u>	<input type="checkbox"/> Leather Gloves	<input type="checkbox"/> FR Clothing		<input type="checkbox"/> Metacarpal Gloves	<input type="checkbox"/> Fall Protection	
<input checked="" type="checkbox"/> Safety Toe Shoes	<input type="checkbox"/> Metatarsal Boots	<input type="checkbox"/> Other <u>covid-19 mask</u>															
<input checked="" type="checkbox"/> Safety Glasses	<input checked="" type="checkbox"/> High Visibility Clothing	<input type="checkbox"/> Other <u>survey meter</u>															
<input type="checkbox"/> Hearing Protection	<input checked="" type="checkbox"/> Hard Hat	<input type="checkbox"/> Other <u>dosimetry</u>															
<input type="checkbox"/> Leather Gloves	<input type="checkbox"/> FR Clothing																
<input type="checkbox"/> Metacarpal Gloves	<input type="checkbox"/> Fall Protection																
Sequence of Basic Job Steps	Potential Hazards	Preventive or Corrective Action															
1) Unload and Setup	1) Slip, Trip, Fall, Strain	1) Watch Footing and Path Proper Lift and Carry															
2) Perform Inspections	2) electricity	2) inspect cords															
3) Breakdown and load up	3) Same as #1	3) Same as #1															
Onsite Safety Meeting Topic																	
<p>Watch your step</p>																	

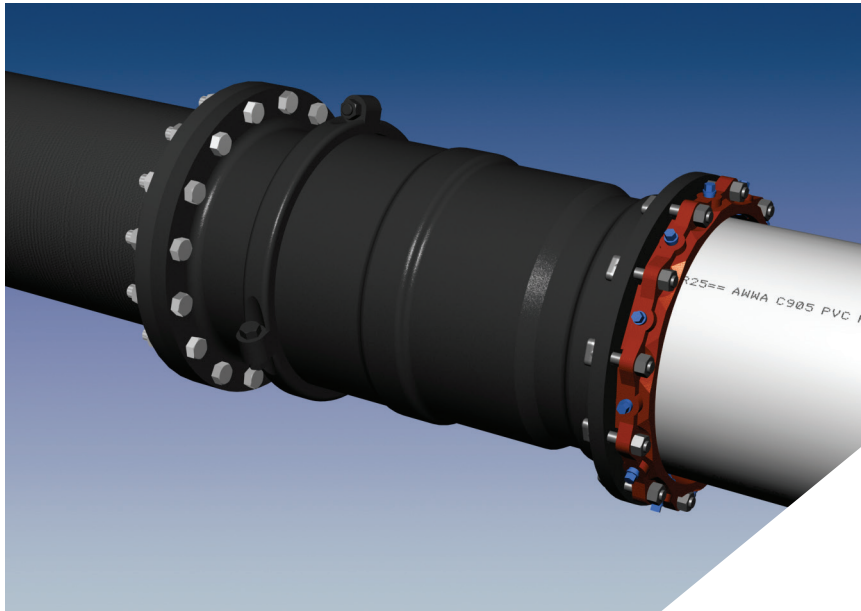

▲ Series 216C0 EX-TEND, 16 inch combination mechanical joint by flanged expansion joint. (DIP by PVC)
▼ Series 216C0 EX-TEND, 16 inch combination mechanical joint by flanged expansion joint.



Sample Specification


Expansion joints shall be installed in the locations indicated on the drawings and shall be manufactured of ductile iron conforming to the material properties of ANSI/AWWA C153/A21.53. All expansion joints shall be capable of expanding or contracting to the amounts shown on the drawings, or indicated in the specifications, but in no case shall there be less than 4" total axial movement. Separation beyond the maximum extension of the expansion joint shall be prevented without the use of external tie rods. Each expansion joint shall be pressure tested against its own restraint to a minimum of 350 psi (250 psi 24 inch and greater). MEGALUG joint restraint shall be provided with each mechanical joint connection. All internal surfaces (wetted parts) shall be lined with a minimum of 15 mils of fusion bonded epoxy conforming to the applicable requirements of ANSI/AWWA C213. Exterior surfaces shall be coated with a minimum of 6 mils of fusion bonded epoxy conforming to the applicable requirements of ANSI/AWWA C116/A21.16. Sealing gaskets shall be constructed of EPDM. The coating shall meet ANSI/NSF-61. All expansion joints shall be EX-TEND 200, as manufactured by EBAA Iron, Inc., or approved equal.

Features and Applications:


- Sizes 3 inch through 36 inch
- For Ductile Iron, Steel, PVC or HDPE pipe
- 3 inch through 20 inch rated at 350 PSI
24 inch and greater rated at 250 PSI
- Constructed of ASTM A536 Ductile Iron
- No Periodic Maintenance is Required
- Each unit tested to rated working pressure prior to shipment
- Self restrained at full expansion without the use of external tie bars
- Due to the design of the seals, no periodic maintenance is required
- Seals conform to the applicable requirements of ANSI/AWWA C111/A21.11
- End connections:
Flanged Joint; 3 inch through 36 inch
Mechanical Joint; 3 inch through 24 inch
Combination of the two Joints available
- Flange outlets conform to the dimensional requirements of ANSI/AWWA C110/A21.10 (class 150) with the addition of an O-ring gasket which is provided to ensure a watertight seal
- Mechanical Joint end connections conform to the dimensional requirements of either ANSI/AWWA C111/A21.11 or ANSI/AWWA C153/A21.53 depending on size
- All "wetted" parts are coated with a NSF61 approved fusion bonded epoxy
- Insertion of additional sleeves for increased expansion capacity can be done at the factory or in the field as the need occurs

For use on water or wastewater pipelines subject to hydrostatic pressure and tested in accordance with either AWWA C600, C605, or ASTM D2774.

FLEX-TEND, EX-TEND, AND FLEX-900 O-ring Groove

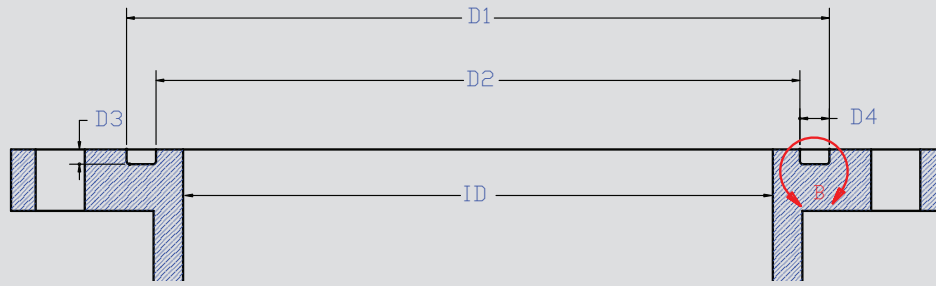

D5 GROOVE RADIUS

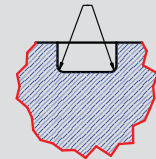

DETAIL B
SCALE 1.25 : 1

Size	D1	D2	D3	D4	D5	O-ring Diameter	O-ring Part Number
3	4.885	4.185	0.175	0.350	0.0625	0.25	983003
4	5.900	4.700	0.300	0.600	0.0625	0.5	983004
6	8.00	6.800	0.300	0.600	0.0625	0.5	983006
8	10.100	8.900	0.300	0.600	0.0625	0.5	983008
10	12.200	11.000	0.300	0.600	0.0625	0.5	983010
12	14.300	13.100	0.300	0.600	0.0625	0.5	983012
14	16.200	15.00	0.300	0.600	0.0625	0.5	983014
16	18.500	16.900	0.400	0.800	0.1250	0.625	983016
18	20.700	19.100	0.400	0.800	0.1250	0.625	983018
20	23.000	21.400	0.400	0.800	0.1250	0.625	983020
24	27.200	25.600	0.400	0.800	0.1250	0.625	983024
30	33.500	31.700	0.400	0.900	0.1250	0.75	983030
36	40.000	38.300	0.400	0.850	0.1250	0.75	983036
42	46.580	44.080	0.650	1.250	0.1250	N/A	983042
48	52.720	50.220	0.650	1.250	0.1250	1	983048

Determine your expansion requirements

Expansion Coefficient Table

Material	Coefficient inch/inch/degree F
Ductile Iron	0.0000062
PVC	0.000030
Cast Iron	0.0000058
Steel	0.0000065
HDPE	0.000080
Concrete	0.0000055

The Change in length (ΔL) due to thermal contraction/expansion is given by:

$$\Delta L = L (\Delta T)(C)$$

Where: L = length of pipe (inches)
 ΔT = change in Temperature (degrees F)
 C = coefficient of thermal expansion

Example:

- Determine the Expansion Needed
 1000 Foot Bridge; 6 inch Ductile Iron Pipe; 120° F Total Temperature Change
 $(1000)(12\text{in/ft})(120^\circ \text{F})(0.0000062\text{in/in/}^\circ \text{F}) = 8.93 \text{ in (Nearly 9 inches)}$
- Select Proper Unit
 Referring to the chart on the opposite page, we will require a Series 206M2 EX-TEND because of the ability to accommodate the nine inches of expansion needed, with it's 12 inches of maximum expansion.
- Determine the installation preset
 Factory preset for the EX-TEND is at 50% Contraction 50% Expansion setting, but the preset can be changed in the field to accommodate the present installation Temperature .


When working with continuous pipelines (i.e. fused HDPE, fused PVC, welded steel,...) be sure to consider the Poisson effect when determining expansion/contraction requirements.

Series 200 EX-TEND® Submittal Reference Drawing


FLANGE BY FLANGE

MECHANICAL JOINT BY MECHANICAL JOINT

EBAA IRON

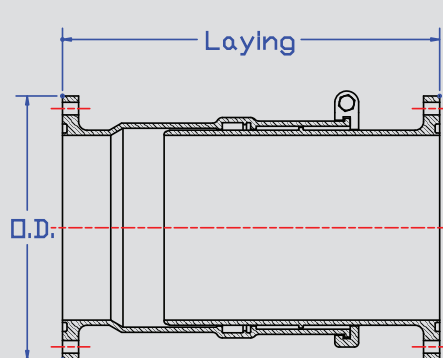

STANDARD UNIT

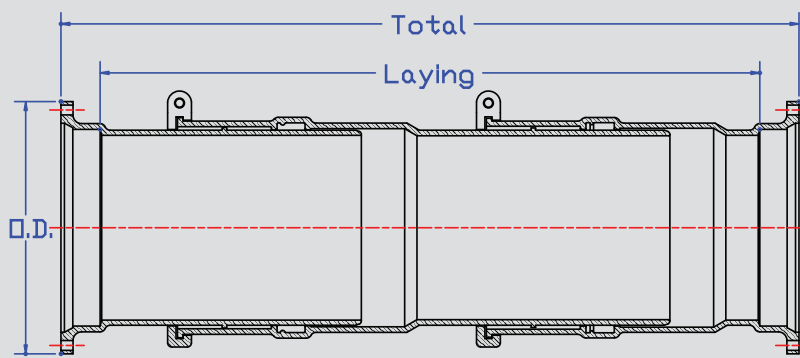

UNIT WITH ONE ADDITIONAL SLEEVE

MADE IN USA

		Flange by Flange				Mechanical Joint by Mechanical Joint					
Nominal Pipe Size	Expansion (Linear)	Series Number	Maximum O.D.	Laying*	Weight (Approx lbs.)		Series Number	Maximum O.D.	Laying*	Total*	Weight (Approx)
3	4	203F0	‡	‡	‡		203M0	‡	‡	‡	‡
	8	203F1	‡	‡	‡		203M1	‡	‡	‡	‡
	12	203F2	‡	‡	‡		203M2	‡	‡	‡	‡
4	4	204F0	11.0	18.2	69		204M0	11.0	15.6	20.6	74
	8	204F1	11.0	33.5	113		204M1	11.0	30.9	35.9	118
	12	204F2	11.0	48.8	157		204M2	11.0	46.2	51.2	162
6	4	206F0	12.4	19.5	95		206M0	12.4	15.4	20.4	96
	8	206F1	12.4	33.8	160		206M1	12.4	29.7	34.7	161
	12	206F2	12.4	48.1	225		206M2	12.4	44.0	49.0	226
8	4	208F0	14.8	20.7	143		208M0	14.8	16.4	21.4	139
	8	208F1	14.8	37.8	235		208M1	14.8	33.5	38.5	231
	12	208F2	14.8	54.9	327		208M2	14.8	50.6	55.6	323
10	4	210F0	17.0	21.0	196		210M0	17.0	18.8	23.8	192
	8	210F1	17.0	36.8	333		210M1	17.0	30.5	35.5	329
	12	210F2	17.0	52.6	470		210M2	17.0	44.5	49.5	466
12	4	212F0	19.3	21.5	245		212M0	19.3	19.2	24.2	244
	8	212F1	19.3	37.5	396		212M1	19.3	35.2	40.2	395
	12	212F2	19.3	53.5	547		212M2	19.3	51.2	56.2	546
14	8	214F0	22.3	32.4	389		214M0	22.3	27.0	34.0	432
	16	214F1	22.3	58.8	677		214M1	22.3	53.3	60.0	677
	24	214F2	22.3	85.3	922		214M2	22.3	79.6	87.0	921
16	8	216F0	24.5	33.9	621		216M0	24.5	31.3	38.8	621
	16	216F1	24.5	61.8	959		216M1	24.5	59.2	66.2	959
	24	216F2	24.5	89.7	1297		216M2	24.5	87.1	94.1	1297
18	8	218F0	27.1	33.7	661		218M0	27.1	27.6	34.6	652
	16	218F1	27.1	60.8	1041		218M1	27.1	54.7	61.7	1032
	24	218F2	27.1	87.9	1421		218M2	27.1	81.8	88.8	1412
20	8	220F0	27.5	32.7	701		220M0	27.5	27.5	34.5	683
	16	220F1	27.5	60.0	1123		220M1	27.5	54.8	61.8	1105
	24	220F2	27.5	87.3	1545		220M2	27.5	82.1	89.1	1527
24	8	224F0	34.9	33.5	908		224M0	34.9	29.0	36.0	882
	16	224F1	34.9	60.8	1610		224M1	34.9	56.3	63.3	1584
	24	224F2	34.9	88.1	2312		224M2	34.9	83.6	90.6	2286
30	10	230F0	40.98	43.95	1433		~	~	~	~	~
	20	230F1	40.98	78.79	2300		~	~	~	~	~
	30	230F2	40.98	113.63	3200		~	~	~	~	~
36	10	236F0	49.2	46.8	2347		~	~	~	~	~

NOTE: Dimensions are in inches ± 1% and are subject to change without notice. Contact EBAA for availability of sizes not shown or listed.

* Laying Lengths and Total Lengths reflect unit set at midpoint of expansion capacity.

‡ Contact EBAA for sizes not listed

Installation Instructions for EX-TEND® 200

1. Remove protective end covers.
2. Remove polyethylene sleeve and other material.
3. Check interior, remove dirt and foreign material from interior and end connections.
4. For buried applications install polyethylene sleeve per ANSI/AWWA C105/A21.5 recommendations.
5. Assembly of flange joint:
 - a. Place flange o-ring in groove.
 - b. Place EX-TEND flange against adjoining flange, install and hand tighten bolts.
 - c. Tighten flange bolts.
6. Install mechanical joint EX-TEND end connections using the EBAA IRON MEGALUG® Joint Restraint suitable for adjacent pipe material.

MEGALUG 1100 should be used on ductile iron pipe.

MEGALUG 2000PV should be used on AWWA PVC pipe.

Assembly instructions for each of these products are included with restraint device.

7. Assembly of restrained plain end:
 - a. Lubricate and install EBAA-Seal® gasket provided over plain end per ANSI/AWWA C600.
 - b. Insert plain end into adjacent mechanical joint bell.
 - c. Install and hand tighten t-bolts.
 - d. Tighten t-bolts per AWWA recommendations.
8. Remove shipping skid.
9. If coating was damaged by transport or installation, touch-up kits are available. Contact EBAA Iron to order the kits.

*



Important Notes

Due to hydrostatic forces that cause the EX-TEND 200 to expand, some applications may require blocking to isolate the areas of anticipated movement and to prevent this expansion from affecting adjacent piping.

In order for the EX-TEND 200 to protect pipeline connections, any load must be transferred to the unit by the restrained joints. Depending on the piping arrangement and the anticipated movement of the pipelines, adjacent piping must be restrained to adequately transfer the loads to the unit. Joint restraint is provided with each mechanical joint end connection.

The flanged outlets have dimensions according to ANSI/AWWA C110/A21.10 with each flange to ensure a proven water tight seal to a maximum of 350 PSI pressure.

Mechanical joint connections conform to the dimensional requirements of either ANSI/AWWA C110/A21.10 or ANSI/AWWA C153/A21.53 depending on the size.

When connecting a EX-TEND to HDPE pipe, a flanged end connection is required. This is to be joined to a fused flange adapter on the HDPE pipe. A filler flange between the two gaskets is necessary to assure proper seal contact.

EBAA IRON Sales, Inc.

P.O. Box 857, Eastland, TX 76448


Tel: (254) 629-1731

Fax: (254) 629-8931

(800) 433-1716 within US and Canada

contact@ebaa.com

www.ebaa.com

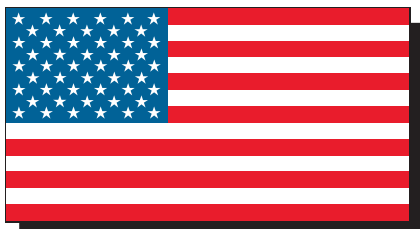

Members of...





**McWANE
DUCTILE**

IRON STRONG

TR FLEX

**® RESTRAINED JOINT DUCTILE IRON PIPE
AND FITTINGS**



SIZES - 4" to 36"

4" - 36" DUCTILE IRON TR FLEX[®] PIPE

MATERIAL	Ductile Iron per AWWA C150/ANSI A21.50, AWWA C151/ANSI A21.51, ASTM A536
PRESSURE	350 PSI Water Working Pressure 4" - 24" & 250PSI FOR 30 & 36"
TESTING	ANSI / AWWA C151 / ANSI 21.51 & UL - FM requirements
LAYING LENGTH	18 foot Nominal Length
CEMENT LINING	ANSI / AWWA C104 / ANSI 21.4
COATING	ANSI / AWWA C104 / ANSI 21.4
GASKETS	ANSI / AWWA C111/ ANSI A21.11
STANDARDS	AWWA C150/ANSI A21.50, AWWA C151/ANSI A21.51, AWWA C104 / ANSI 21.4, AWWA C111/ ANSI A21.11



❖ visit pe.mcwane.com for more information

❖ All Dimensions are in Inches

DUCTILE IRON TR FLEX® Pulling Force at Equivalent Pressure for HDD Applications

Nominal Pipe Size	Pipe O.D. (in)	350 psi Equivalent Force	500 psi Equivalent Force	Recommended Maximum Pulling Force	Absolute Maximum Pulling Force
4	4.80	6,333	9,048	6,000	9,000
6	6.90	13,087	18,696	13,000	18,000
8	9.05	22,514	32,163	22,000	32,000
10	11.10	33,869	48,384	33,000	48,000
12	13.20	47,897	68,424	47,000	68,000
14	15.30	64,349	91,927	64,000	91,000
16	17.40	83,226	118,894	83,000	118,000
18	19.50	104,527	149,324	104,000	149,000
20	21.60	128,252	183,218	128,000	183,000
24	25.80	182,977	261,396	182,000	261,000
30	32.00	201,062	281,487	201,000	281,000
36	38.30	288,023	403,232	288,000	403,000

Notes:

- 350 psi is the rated pressure of the joint.
- 500 psi equivalent is the absolute maximum pulling force that should be used.
- 30" and 36" Equivalent Forces are 250 psi equivalent


Actual Laying Length

Nominal Size	Feet	Inch
4	18	1
6	18	1
8	18	1
10	17	11
12	17	11
14	17	10
16	17	10
18	17	10
20	17	9
24	17	9
30	17	9
36	17	7

❖ visit pe.mcwane.com for more information

❖ All Dimensions are in Inches

DUCTILE IRON TR FLEX® PIPE 4" - 36" Bell Details

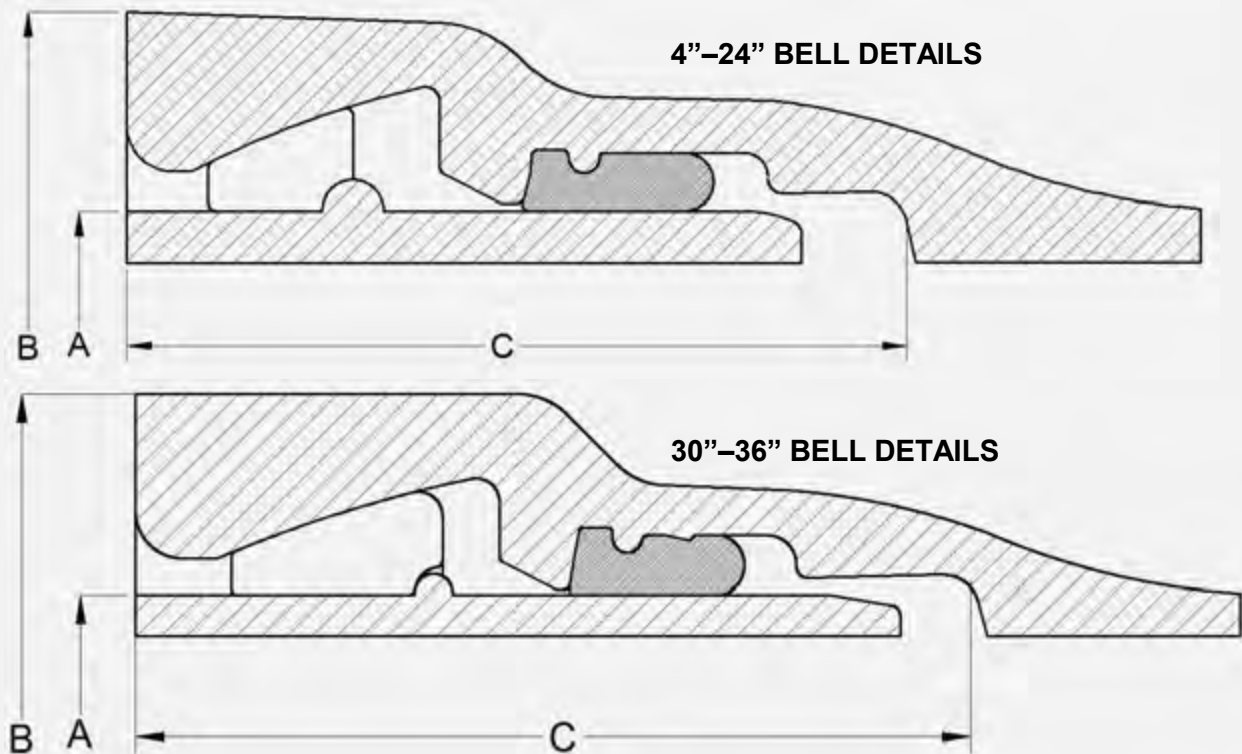

Pipe Size In.	*Pressure Rating psi	A In.	B In.	C In.	# of D.I Locking Segments	# of Rubber Segments Retainers	Max Deflection Degrees	Pullout
4	350	4.80	7.25	4.84	2	1	5	0.03
6	350	6.90	9.52	5.27	2	1	5	0.04
8	350	9.05	11.93	5.82	2	1	5	0.04
10	350	11.10	14.37	6.03	2	1	5	0.05
12	350	13.20	16.68	6.30	4	2	5	0.06
14	350	15.30	19.16	7.75	4	2	3-1/4	0.05
16	350	17.40	21.46	7.95	4	2	3-1/4	0.05
18	350	19.50	23.76	8.19	4	2	3	0.05
20	350	21.60	26.04	8.40	4	2	2-1/2	0.05
24	350	25.80	30.61	8.86	8	4	2-1/4	0.05
30	250	32.00	36.88	10.28	8	4	1-3/4	0.05
36	250	38.30	43.85	10.87	8	4	1-1/2	0.05

*The TR FLEX® Restrained Joint has a working pressure rating equivalent to the working pressure rating of the parent pipe with a maximum working pressure rating of 350 psi for 4 in. through 24 in. and 250 psi for 30 in. through 36 in.

NOTE: These deflections are based on joints with nominal dimensions.


❖ visit pe.mcwane.com for more information

❖ All Dimensions are in Inches

DUCTILE IRON TR FLEX® FITTINGS


MATERIAL	Ductile Iron Grade 70-50-05 in accordance with AWWA C153 / ANSI A21.53
PRESSURE	350 PSI Water Working Pressure for 4" - 24" & 250PSI for 30 & 36"
TESTING	AWWA C153 / ANSI A21.53 & UL - FM requirements
LAYING LENGTH	AWWA C153 / ANSI A21.53
CEMENT LINING	AWWA C104 / ANSI A21.4
COATING	AWWA C104 / ANSI A21.4
GASKETS	AWWA C111 / ANSI A21.11
STANDARDS	AWWA C153 / ANSI A21.53, AWWA C104 / ANSI A21.4, AWWA C111 / ANSI A21.11

BASIC SPECIFICATIONS

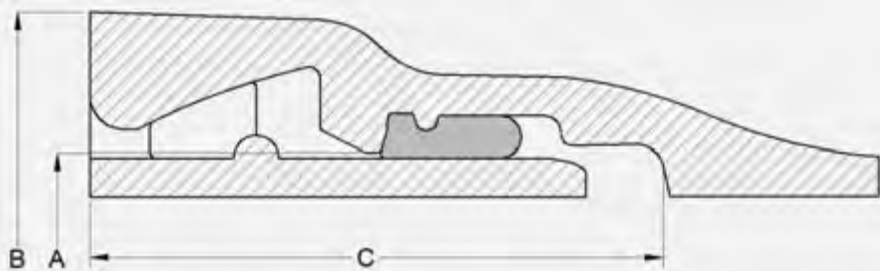


SIZE	A in	B in	C in
4	4.80	7.11	4.84
6	6.90	9.39	5.27
8	9.05	11.85	5.82
10	11.10	14.12	6.03
12	13.20	16.46	6.30
14	15.30	19.13	7.75
16	17.40	21.33	7.95
18	19.50	23.53	8.19
20	21.60	25.75	8.40
24	25.80	30.15	8.86
30	32.00	37.19	10.28
36	38.30	43.85	10.87

TR FLEX[®] FITTING THICKNESS & DIMENSIONS BENDS

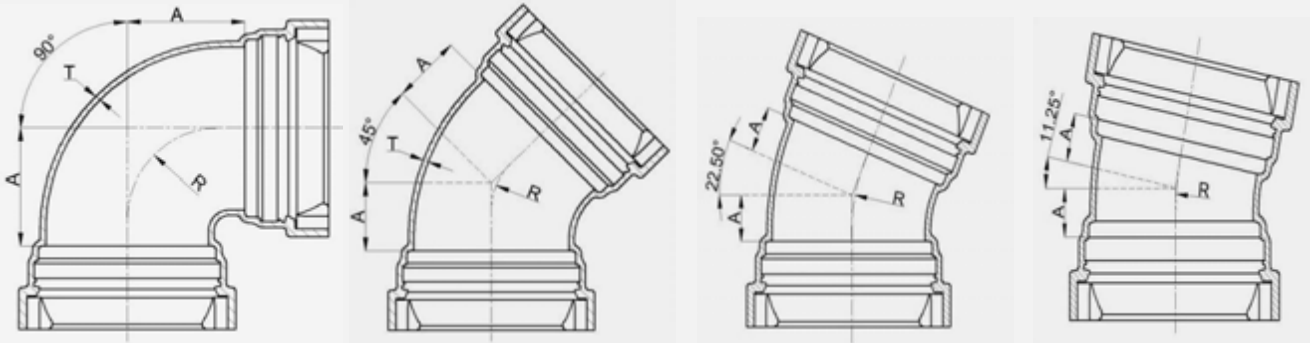

SIZE	90°			45°			22 1/2°			11 1/4°		
	A in	R in	T in	A in	R in	T in	A in	R in	T in	A in	R in	T in
4	4.00	3.34	0.34	2.00	3.24	0.34	1.50	4.23	0.34	1.25	6.01	0.34
6	5.00	4.31	0.36	3.00	5.57	0.36	2.00	6.57	0.36	1.50	8.19	0.36
8	6.50	5.60	0.38	3.50	6.28	0.38	2.50	8.04	0.38	1.75	8.62	0.38
10	7.50	6.68	0.40	4.50	8.89	0.40	3.00	10.97	0.40	2.00	12.00	0.40
12	9.00	7.76	0.42	5.50	11.00	0.42	3.50	13.50	0.42	2.25	14.50	0.42
14	11.50	10.00	0.47	5.00	8.50	0.47	3.75	12.00	0.47	2.50	11.00	0.47
16	12.50	11.00	0.50	5.50	9.50	0.50	3.75	11.50	0.50	2.50	10.00	0.50
18	14.00	12.50	0.54	6.00	10.50	0.54	4.50	14.50	0.54	3.00	14.00	0.54
20	15.00	13.50	0.57	7.00	13.00	0.57	4.50	14.00	0.57	3.00	13.00	0.57
24	16.75	15.00	0.61	7.50	14.00	0.61	4.50	14.00	0.61	3.00	13.50	0.61
30	21.50	19.00	0.66	10.50	20.50	0.66	6.75	24.00	0.66	4.75	29.00	0.66
36	24.50	22.00	0.74	11.50	22.50	0.74	7.75	28.00	0.74	5.00	30.00	0.74

TR FLEX® FITTING THICKNESS & DIMENSIONS TEES

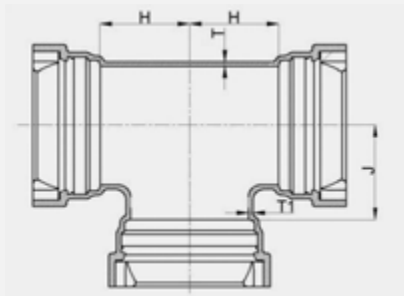


SIZE		H in	J in	T in	T1 in
Run	Branch				
4	4	4.00	4.00	0.34	0.34
6	4	4.00	5.00	0.36	0.34
6	6	5.00	5.00	0.36	0.36
8	4	4.00	6.50	0.38	0.34
8	6	5.00	6.50	0.38	0.36
8	8	6.50	6.50	0.38	0.38
10	4	4.00	7.50	0.40	0.34
10	6	5.00	7.50	0.40	0.36
10	8	6.50	7.50	0.40	0.38
10	10	7.50	7.50	0.40	0.40
12	4	4.00	8.75	0.42	0.34
12	6	5.00	8.75	0.42	0.36
12	8	6.50	8.75	0.42	0.38
12	10	7.50	8.75	0.42	0.40
12	12	8.75	8.75	0.42	0.42
14	14	10.50	10.50	0.47	0.47
16	12	9.50	11.50	0.50	0.42
16	14	10.50	11.50	0.50	0.47
16	16	11.50	11.50	0.50	0.50
18	12	9.50	12.50	0.54	0.42
18	14	10.50	12.50	0.54	0.47
18	16	11.50	12.50	0.54	0.50
18	18	12.50	12.50	0.54	0.54
20	12	10.00	14.00	0.57	0.42
20	14	11.00	14.00	0.57	0.47
20	16	12.00	14.00	0.57	0.50
20	18	13.00	14.00	0.57	0.54
20	20	14.00	14.00	0.57	0.57

❖ visit pe.mcwane.com for more information


❖ All Dimensions are in Inches

TR FLEX® FITTING THICKNESS & DIMENSIONS TEES

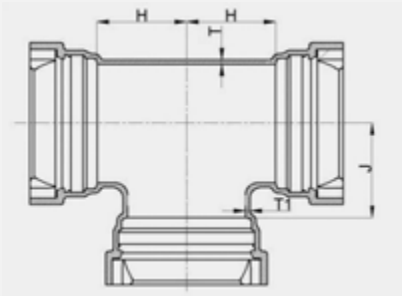


SIZE		H in	J in	T in	T1 in
Run	Branch				
24	12	10.00	16.00	0.61	0.42
24	14	11.00	16.00	0.61	0.47
24	16	12.00	16.00	0.61	0.50
24	18	13.00	16.00	0.61	0.54
24	20	14.00	16.00	0.61	0.57
24	24	16.00	16.00	0.61	0.61
30	14	12.50	20.00	0.66	0.47
30	16	12.50	20.00	0.66	0.50
30	18	15.00	20.00	0.66	0.54
30	20	15.00	20.00	0.66	0.57
30	24	16.00	20.00	0.66	0.61
30	30	20.00	20.00	0.66	0.66
36	14	16.00	23.50	0.74	0.47
36	16	16.00	23.50	0.74	0.50
36	18	16.00	23.50	0.74	0.54
36	20	16.00	23.50	0.74	0.57
36	24	16.00	23.50	0.74	0.61
36	30	20.00	23.50	0.74	0.66
36	36	23.50	23.50	0.74	0.74

TR FLEX[®] FITTING THICKNESS & DIMENSIONS CAPS & PLUGS

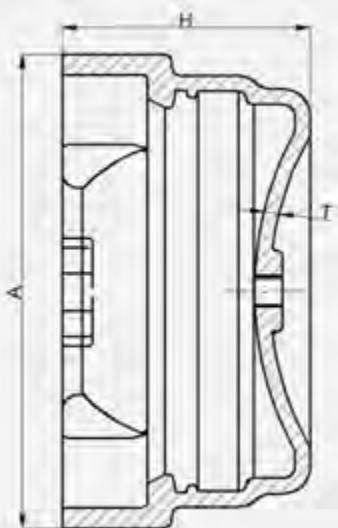

SIZE	A in	T in	H in
4	7.11	0.34	5.18
6	9.39	0.36	5.63
8	11.85	0.38	6.20
10	14.12	0.40	6.43
12	16.46	0.42	6.72
14	19.13	0.47	8.22
16	21.33	0.50	8.45
18	23.53	0.54	8.73
20	25.75	0.57	8.97
24	30.15	0.61	9.47
30	37.19	0.66	10.94
36	43.85	0.74	11.61

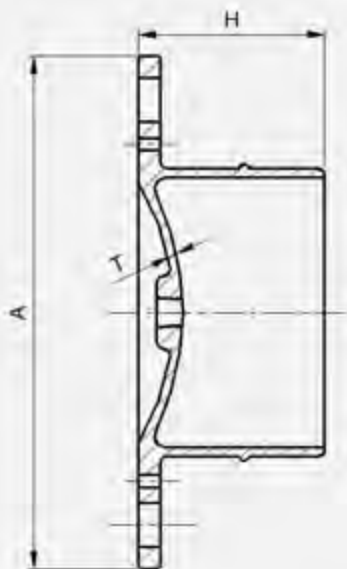

SIZE	A in	T in	H in
4	12.00	0.34	6.50
6	14.50	0.36	7.00
8	17.00	0.38	7.50
10	20.00	0.80	8.00
12	23.50	0.80	11.00
14	21.75	0.47	10.25
16	24.00	0.50	10.25
18	26.25	0.54	10.50
20	28.50	0.57	10.75
24	32.50	0.61	11.25
30	40.25	0.66	13.50
36	46.50	0.74	14.25

4" - 36" DUCTILE IRON TR FLEX® PIPE ASSEMBLY INSTRUCTIONS

TR Flex® pipes and fittings assembly instructions:

- When laying a pipe or fitting in a trench, orient the locking segment insertion bell slots so that:
 - The 2 slots on 4" - 20" pipe are at the horizontal or 3 and 9 o'clock positions
 - The 4 slots on 24" - 36" pipe are at the 2, 4, 8 and 10 o'clock positions or forming an 'X' when looking at the bell face



4"-20"



24"-36"

- Thoroughly clean the bell cavity area including the gasket seat and the locking segment groove to remove all dirt, debris and any foreign material(s) that could inhibit proper gasket sealing or locking segment placement. Ensure the gasket seat area is dry
- Insert a standard Tyton gasket in the bell socket, make sure the retainer bead on the heel of the gasket is fully inserted into the corresponding socket groove
- Apply a thin but continuous layer of lubricant on the installed gasket and the pipe spigot up to the weld bead
- Keeping the mating pipe aligned, insert the pipe spigot into the corresponding pipe bell and push home
- There are two locking segments for 4" - 10" joints, four locking segments for 12" - 20" joints and eight locking segments for 24" - 36" joints
- Insert the locking segments one at a time into the bell slots and rotate / slide each locking segment into the bell cavity. Red segments rotate to the right and black segments rotate to the left
- Insert the rubber retainer into the bell slot between two installed locking segments to retain the locking segments in their correct position
- Once all locking segments and rubber retainers are properly installed, pull back on the installed joint to fully extend the joint and set any desired deflection