

STATE OF OHIO
DEPARTMENT OF TRANSPORTATION


ASD-250-0.00
VILLAGE OF SAVANNAH
VILLAGE OF BAILEY LAKES

CLEAR CREEK TOWNSHIP
RUGGLES TOWNSHIP

ASHLAND COUNTY

INDEX OF SHEETS:


| | |
|--|-------|
| TITLE SHEET | 1 |
| DESIGN DESIGNATION & STRAIGHT LINE DIAGRAM | 2 |
| TYPICAL SECTIONS | 3 |
| GENERAL NOTES | 4-7 |
| GENERAL SUMMARY | 8-9 |
| PAVEMENT & SHOULDER DATA | 10 |
| GUARDRAIL DATA | 11 |
| GUARDRAIL DETAILS | 12-19 |
| PAVEMENT MARKING & RPM DATA | 20 |
| STRUCTURE DETAILS | |
| ASD-250-0.09 | 21-22 |
| ASD-250-1.06 | 23 |
| ASD-250-7.42 | 24 |
| ASD-250-7.56 | 25 |
| PIS GR-3.4 | 26 |

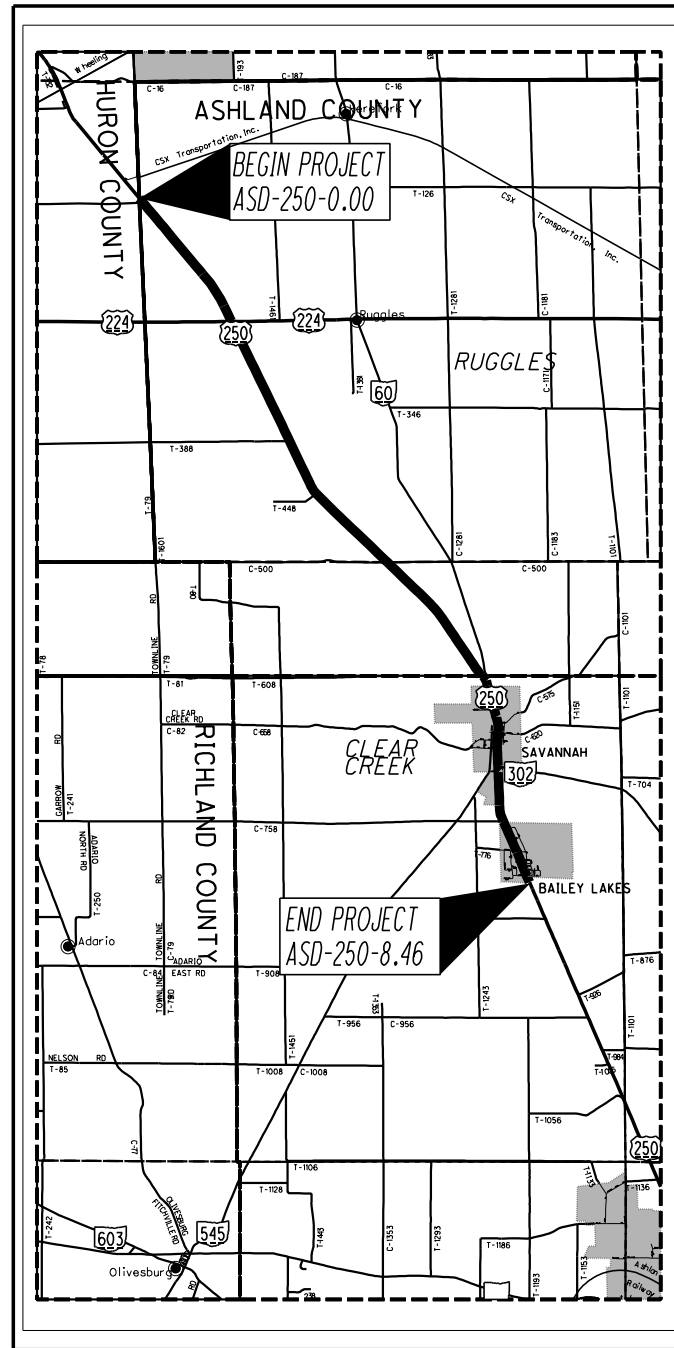

LOCATION MAP

LATITUDE: 40° 59' 49" N LONGITUDE: 82° 23' 32" W

SCALE IN MILES

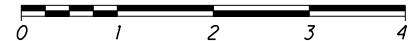

| | |
|-------------------------|-------|
| PORTION TO BE IMPROVED | ————— |
| INTERSTATE HIGHWAY | ————— |
| FEDERAL ROUTES | ————— |
| STATE ROUTES | ————— |
| COUNTY & TOWNSHIP ROADS | ————— |
| OTHER ROADS | ————— |

DESIGN DESIGNATION: SEE SHEET 2

DESIGN EXCEPTIONS

NONE REQUIRED

| ENGINEERS SEAL | STANDARD CONSTRUCTION DRAWINGS | | | | | | SUPPLEMENTAL SPECIFICATIONS | |
|----------------|--------------------------------|---------|-----------|---------|----------|----------|-----------------------------|----------|
| | BP-3.1 | 1/17/20 | MGS-1.1 | 1/19/18 | TC-41.20 | 10/18/13 | 800 | 4/17/20 |
| | BP-4.1 | 7/19/13 | MGS-2.1 | 1/19/18 | TC-42.10 | 10/18/13 | 832 | 10/19/18 |
| | BP-5.1 | 1/18/19 | MGS-4.2 | 7/19/13 | TC-42.20 | 10/18/13 | 846 | 4/17/15 |
| | BP-6.1 | 7/19/13 | MGS-4.3 | 1/18/13 | TC-52.10 | 10/18/13 | 872 | 4/17/20 |
| | BP-7.1 | 7/20/18 | | | TC-52.20 | 7/20/18 | 874 | 4/17/20 |
| | BP-9.1 | 1/18/19 | MT-96.11 | 1/17/20 | TC-61.10 | 1/17/20 | 875 | 1/18/19 |
| | | | MT-96.20 | 7/15/16 | TC-61.30 | 7/19/19 | 861 | 10/18/19 |
| | RM-1.1 | 7/18/14 | MT-96.26 | 1/18/19 | TC-64.10 | 1/17/20 | | |
| | | | MT-97.10 | 4/19/19 | TC-65.10 | 1/17/14 | | |
| | | | MT-97.12 | 1/20/17 | TC-65.11 | 7/21/17 | | |
| | | | MT-99.20 | 4/19/19 | TC-71.10 | 1/19/18 | | |
| | DM-4.3 | 1/15/16 | MT-99.30 | 1/17/20 | | | | |
| | DM-4.4 | 1/15/16 | MT-101.90 | 7/21/17 | | | | |
| | | | MT-105.10 | 1/17/20 | DBR-3-11 | 7/15/11 | | |
| | | | | | DS-1-92 | 7/18/03 | | |

SIGNED: _____

DATE: _____

PROJECT DESCRIPTION

THIS PROJECT WILL INCLUDE PAVEMENT REPAIRS, PLANING, PAVING WITH ASPHALT CONCRETE, BRIDGE MAINTENANCE, AND REPLACING PAVEMENT MARKINGS.

EARTH DISTURBED AREAS

PROJECT EARTH DISTURBED AREA: N/A ACRES (MAINTENANCE PROJECT)
ESTIMATED CONTRACTOR EARTH DISTURBED AREA: N/A ACRES (MAINTENANCE PROJECT)
NOTICE OF INTENT EARTH DISTURBED AREA: N/A ACRES (MAINTENANCE PROJECT)

2019 SPECIFICATIONS

THE STANDARD SPECIFICATIONS OF THE STATE OF OHIO, DEPARTMENT OF TRANSPORTATION, INCLUDING SUPPLEMENTAL SPECIFICATIONS LISTED IN THE PLANS AND CHANGES LISTED IN THE PROPOSAL SHALL GOVERN THIS IMPROVEMENT.

I HEREBY APPROVE THESE PLANS AND DECLARE THAT THE MAKING OF THIS IMPROVEMENT WILL NOT REQUIRE THE CLOSING TO TRAFFIC OF THE HIGHWAY AND THAT PROVISIONS FOR THE MAINTENANCE AND SAFETY OF TRAFFIC WILL BE AS SET FORTH ON THE PLANS AND ESTIMATES.

APPROVED _____
DATE _____ DISTRICT DEPUTY DIRECTOR

APPROVED _____
DATE _____ DIRECTOR, DEPARTMENT OF TRANSPORTATION

UNDERGROUND UTILITIES

Contact Two Working Days Before You Dig



OHIO811, 8-1-1, or 1-800-362-2764 (Non-members must be called directly)

PLANS PREPARED BY:
 OHIO DEPARTMENT OF TRANSPORTATION
DISTRICT THREE ENGINEERING

FEDERAL PROJECT NO.
NON-FEDERAL

PID NO.
110311

CONSTRUCTION PROJECT NO.

ASD-250-0.00

1
26

ITEM 254 - PATCHING PLANED SURFACE

AN ESTIMATED QUANTITY OF ITEM 254 - PATCHING PLANED SURFACE HAS BEEN SET UP TO BE USED AS DIRECTED BY THE ENGINEER AS DESCRIBED IN CMS 254.04. THE LIMIT OF THE PATCHING DEPTH IS 0 TO 2 IN.

ITEM 254 - PAVEMENT PLANING, ASPHALT CONCRETE

THE INTENT OF THE PLANING IS TO MILL 1.5 INCHES AT THE CENTER OF PAVEMENT AT NON-CURBED AREAS. THE PAVEMENT SLOPE SHALL BE 0.010 MINIMUM AND 0.016 PREFERRED, CONTINUOUS BETWEEN THE CROWN AND THE PROPOSED EDGELINE/SHOULDER. THE MILLING DEPTH SHALL BE CONTROLLED FROM THE CENTER OF PAVEMENT IN CONFORMANCE WITH THE ABOVE GUIDELINES.

SPECIAL ATTENTION SHALL BE GIVEN TO SUPERELEVATED CURVES. THE SUPERELEVATION SHALL BE MAINTAINED AND/OR RESTORED, IF NECESSARY, AS DIRECTED BY THE ENGINEER. IF THERE IS NO INFORMATION IN THE PLANS TO CHANGE THE SUPERELEVATION, THE INTENT IS TO MAINTAIN THE EXISTING SUPERELEVATION.

THE CONTRACTOR SHALL MAINTAIN POSITIVE DRAINAGE TO ALL CATCH BASINS AND INLETS.

THE PROGRESSION OF THE PLANING SHALL PROCEED IN SUCH A MANNER THAT NORMAL TRAFFIC WILL NOT BE REQUIRED TO RUN OVER THE PLANED ROADWAY SURFACE MORE THAN FOURTEEN (14) CALENDAR DAYS. FOR EACH CALENDAR DAY BEYOND THE 14 DAYS THAT THE ROADWAY REMAINS EXPOSED TO THE PLANED SURFACE, THE CONTRACTOR WILL BE ASSESSED A DISINCENTIVE FEE OF \$1000 PER DAY.

PAYMENT SHALL INCLUDE ALL LABOR, EQUIPMENT, AND MATERIALS NECESSARY TO COMPLETE THE PAVEMENT PLANING, ASPHALT CONCRETE. PAYMENT WILL BE MADE AT THE UNIT BID PRICE PER SQUARE YARD OF ITEM 254 - PAVEMENT PLANING, ASPHALT CONCRETE.

ITEM 254 - PAVEMENT PLANING, ASPHALT CONCRETE (CURBED SECTION)

THE INTENT OF THE PLANING IS TO MILL THE SPECIFIED DEPTH ALONG THE CURB CONTINGENT ON THE FOLLOWING: THE MAXIMUM CROSS SLOPE SHALL BE 0.02 WHILE THE MINIMUM CROSS SLOPE SHALL BE 0.01. THE PREFERRED CROSS SLOPE IS 0.016. THE CROWN OF THE PAVEMENT SHALL BE LOCATED BETWEEN THE TRAVELED LANES, OR AS DIRECTED BY THE ENGINEER. THE MILLING DEPTH SHALL BE CONTROLLED FROM THE CURB, TO PRODUCE A CROSS SLOPE IN CONFORMANCE WITH THE ABOVE GUIDELINES.

SPECIAL ATTENTION SHALL BE GIVEN TO SUPERELEVATED CURVES. THE SUPERELEVATION SHALL BE MAINTAINED AND/OR RESTORED, IF NECESSARY, AS DIRECTED BY THE ENGINEER. IF THERE IS NO INFORMATION IN THE PLANS TO CHANGE THE SUPERELEVATION, THE INTENT IS TO MAINTAIN THE EXISTING SUPERELEVATION.

THE CONTRACTOR SHALL MAINTAIN POSITIVE DRAINAGE TO ALL CATCH BASINS AND INLETS.

THE PROGRESSION OF THE PLANING SHALL PROCEED IN SUCH A MANNER THAT NORMAL TRAFFIC WILL NOT BE REQUIRED TO RUN OVER THE PLANED ROADWAY SURFACE MORE THAN FOURTEEN (14) CALENDAR DAYS. FOR EACH CALENDAR DAY BEYOND THE 14 DAYS THAT THE ROADWAY REMAINS EXPOSED TO THE PLANED SURFACE, THE CONTRACTOR WILL BE ASSESSED A DISINCENTIVE FEE OF \$1,000 PER DAY.

PAYMENT SHALL INCLUDE ALL LABOR, EQUIPMENT, AND MATERIALS NECESSARY TO COMPLETE THE PAVEMENT PLANING, ASPHALT CONCRETE. PAYMENT WILL BE MADE AT THE UNIT BID PRICE PER SQUARE YARD OF ITEM 254 - PAVEMENT PLANING, ASPHALT CONCRETE.

COORDINATION OF WORK BETWEEN CONTRACTORS

THE CONTRACTOR SHOULD BE AWARE THAT THERE MAY BE OTHER WORK BEING PERFORMED BY A SEPARATE CONTRACT. ASD-SMOOTH-FY2020 PID 102960 IS A PAVING CONTRACT THAT BEGINS ON ASD-250-8.46. AND IS SCHEDULED TO BEGIN WORK IN THE 2020 CONSTRUCTION SEASON. COORDINATION OF WORK IS THE RESPONSIBILITY OF THE CONTRACTOR.

ITEM 408 - PRIME COAT, AS PER PLAN

THE CONTRACTOR SHALL APPLY ONE COAT OF MC-70 (AS PER SECTION 702) AT A RATE OF 0.40 GAL/SY TO THE COMPLETED AGGREGATE SHOULDER (ITEM 617) AS DIRECTED BY THE ENGINEER. THE CONTRACTOR SHALL PROVIDE A SHIELD TO PREVENT THE SPRAYING OR DRIFTING OF LIQUID BITUMINOUS MATERIAL ONTO THE EDGE OF PAVEMENT OR EDGE LINE. THE ATTENTION OF THE CONTRACTOR IS DIRECTED TO 107.10 OF THE SPECIFICATIONS.

ROLLER REQUIREMENTS WITHIN THE CITY CORP LIMITS

WITHIN THE CORPORATION LIMITS OF THE VILLAGE SAVANNAH, THE CONTRACTOR SHALL NOT USE A VIBRATORY ROLLER TO COMPACT THE ASPHALT CONCRETE.

ITEM 623 - MONUMENT BOX ADJUSTED TO GRADE

ALL WORK RELATED TO ADJUSTING MONUMENT BOXES TO GRADE WILL BE IN ACCORDANCE TO SECTIONS 623.04 AND 623.05 OF THE 2016 ODOT CONSTRUCTION AND MATERIALS SPECIFICATIONS.

THE MONUMENT BOX TO BE ADJUSTED MAY OR MAY NOT HAVE AN EXISTING ADJUSTABLE FRAME. THE WORK SHALL CONSIST OF ADJUSTING THE EXISTING MONUMENT BOX TO THE SATISFACTION OF THE ENGINEER. THE CONTRACTOR IS REMINDED TO FIELD CHECK ALL ADJUSTMENT TO GRADE ITEMS PRIOR TO BIDDING, AS NO ADDITIONAL COMPENSATION WILL BE GRANTED FOR LABOR AND MATERIALS REQUIRED TO SATISFACTORILY ADJUST CASTINGS WITHOUT ADJUSTABLE FRAMES.

ITEM 623 - MONUMENT BOX ADJUSTED TO GRADE 5 EA

**ITEM 251 - PARTIAL DEPTH PAVEMENT REPAIR (442)
ITEM 253 - PAVEMENT REPAIR**

THESE ITEMS OF WORK SHALL CONSIST OF THE REMOVAL OF THE EXISTING PAVEMENT OR PAVED BERM WHICH MAY BE ASPHALT, BRICK, CONCRETE, OR A COMBINATION OF EACH, IN AREAS OF EXISTING PAVEMENT FAILURE. CORING HAS BEEN PERFORMED TO HELP DETERMINE THE COMPONENTS THAT MAY BE ENCOUNTERED DURING THIS ITEM OF WORK. THE PAVEMENT CORING INFORMATION IS SHOWN ON PLAN SHEET 5.

PAVEMENT REPAIR SHALL BE PERFORMED AFTER PAVEMENT PLANING AND BEFORE PLACEMENT OF THE INTERMEDIATE AND/OR SURFACE COURSE. THE DEPTH OF REMOVAL SHALL BE SUFFICIENT TO REMOVE ALL DETERIORATED PAVEMENT WITH A MAXIMUM DEPTH OF 6", BASED ON THE PAVEMENT DESIGN AND AN AVERAGE DEPTH OF 4" AND AN AVERAGE WIDTH OF 4 FT FOR ESTIMATING PURPOSES.

THE CONTRACTOR SHALL BE CAPABLE OF PERFORMING PAVEMENT REPAIRS 2 FEET WIDE.

REPLACEMENT MATERIAL SHALL BE ITEM 301, OR ITEM 442 19MM MATERIAL AND SHALL BE PLACED AND COMPACTED TO FINISH FLUSH WITH THE ADJACENT PAVEMENT SURFACE. ITEM 301 ASPHALT CONCRETE CAN BE USED WHEN THE DEPTH OF THE REPAIR IS BETWEEN 3" AND 12" WITH A MAXIMUM PAVEMENT LIFT OF 6". ITEM 442 19MM CAN BE USED WHEN THE DEPTH OF THE REPAIR IS BETWEEN 1.5" AND 3". ITEM 301 SHALL USE PG64-22 ASPHALT BINDER AND ITEM 442 19MM SHALL USE PG64-28 BINDER.

PAYMENT SHALL INCLUDE ALL LABOR, EQUIPMENT, AND MATERIALS NECESSARY TO COMPLETE THE PAVEMENT REPAIR. FOR PAYMENT PURPOSES ITEM 251 PARTIAL DEPTH PAVEMENT REPAIR (442) IS TO BE A MAXIMUM OF 4" DEEP AND ITEM 253 PAVEMENT REPAIR IS FOR DEPTHS GREATER THAN 4". PAYMENT WILL BE MADE AT THE UNIT BID PRICE PER CUBIC YARD, (BY TICKET WEIGHT CONVERSION), OF ITEM 251 - PARTIAL DEPTH PAVEMENT REPAIR (442) OR ITEM 253 - PAVEMENT REPAIR. THE FOLLOWING ESTIMATED QUANTITIES ARE PROVIDED IN THE GENERAL SUMMARY TO BE USED AS DIRECTED BY THE ENGINEER:

ITEM 251 - PARTIAL DEPTH PAVEMENT REPAIR (442) 1300 CY
ITEM 253 - PAVEMENT REPAIR 130 CY

CURB RAMPS

ESTIMATED QUANTITIES SHOWN IN THE TABLE BELOW HAVE BEEN CARRIED TO THE GENERAL SUMMARY TO INSTALL OR UPGRADE CURB RAMPS. RAMPS SHALL BE BUILT AS DETAILED IN BP-7.1.

| CURB RAMP SUBSUMMARY | | | | | | | | | |
|----------------------------------|--------|------|----------------------|----------------------|-----------------------------|-----------|--------------|--------------|--------------|
| PLAN SPLIT | ROUTE | SLM | INTERSECTED FACILITY | SIDE OF INTERSECTION | CURB RAMP TYPE (SEE BP-7.1) | 608 | 202 | 609 | 202 |
| | | | | | | CURB RAMP | WALK REMOVED | CURB TYPE, 6 | CURB REMOVED |
| | | | | | | SF | SF | FT | FT |
| 01/NFP/PV | US 250 | 6.74 | CHAPEL ST. | NE | A2 | 75 | 75 | 15 | 15 |
| 01/NFP/PV | US 250 | 6.74 | | SE | A2 | 75 | 75 | 15 | 15 |
| 01/NFP/PV | US 250 | 6.84 | CROWELL ST. | NW | B3 | 75 | 75 | 15 | 15 |
| 01/NFP/PV | US 250 | 6.84 | | NW | A2 | 75 | 75 | 15 | 15 |
| 01/NFP/PV | US 250 | 6.84 | ROBINSON ST. | SW | A2 | 75 | 75 | 15 | 15 |
| 01/NFP/PV | US 250 | 6.84 | | NE | A2 | 75 | 75 | 15 | 15 |
| 01/NFP/PV | US 250 | 6.84 | ROBINSON ST. | NE | A2 | 75 | 75 | 15 | 15 |
| 01/NFP/PV | US 250 | 6.84 | | SE | A2 | 75 | 75 | 15 | 15 |
| 01/NFP/PV | US 250 | 6.92 | W. MAIN ST. | NW | A2 | 75 | 75 | 15 | 15 |
| 01/NFP/PV | US 250 | 6.92 | | NW | A2 | 75 | 75 | 15 | 15 |
| 01/NFP/PV | US 250 | 6.92 | W. MAIN ST. | SW | A2 | 75 | 75 | 15 | 15 |
| 01/NFP/PV | US 250 | 6.92 | | NE | A2 | 75 | 75 | 15 | 15 |
| 01/NFP/PV | US 250 | 6.92 | E. MAIN ST. | NE | A2 | 75 | 75 | 15 | 15 |
| 01/NFP/PV | US 250 | 6.92 | | NE | A2 | 75 | 75 | 15 | 15 |
| 01/NFP/PV | US 250 | 6.92 | E. MAIN ST. | SE | A2 | 75 | 75 | 15 | 15 |
| 01/NFP/PV | US 250 | 6.92 | | SE | A2 | 75 | 75 | 15 | 15 |
| 01/NFP/PV | US 250 | 7.00 | TALLEY ALLEY | NW | A2 | 75 | 75 | 15 | 15 |
| 01/NFP/PV | US 250 | 7.00 | | SW | A2 | 75 | 75 | 15 | 15 |
| TOTAL CARRIED TO GENERAL SUMMARY | | | | | | 1200 | 1200 | 240 | 240 |


ITEM 611 - CASTINGS ADJUSTED TO GRADE

THE CASTING TO BE ADJUSTED MAY OR MAY NOT HAVE AN EXISTING FRAME. THE WORK SHALL CONSIST OF ADJUSTING THE EXISTING CASTING TO THE SATISFACTION OF THE ENGINEER. IT IS NOT INTENDED TO PLACE NEW FRAMES WHERE NONE CURRENTLY EXIST. THE CONTRACTOR IS REMINDED TO FIELD CHECK ALL ADJUSTMENT TO GRADE ITEMS PRIOR TO BIDDING, AS NO ADDITIONAL COMPENSATION WILL BE GRANTED FOR LABOR AND MATERIALS REQUIRED TO SATISFACTORILY ADJUST CASTINGS WITHOUT FRAMES.

ITEM 611 - MANHOLE ADJUSTED TO GRADE 10 EA
ITEM 611 - CATCH BASIN ADJUSTED TO GRADE 19 EA

ITEM 644 - CROSSWALK LINE, AS PER PLAN

THE MARKING DETAIL SHOWN BELOW SHALL ONLY BE APPLIED TO ASD-250 MAINLINE AT THE SR545 INTERSECTION AND THE MAIN ST INTERSECTION TO IMPROVE DRIVER AWARENESS OF THE PEDESTRIAN CROSSINGS IN THE VILLAGE OF SAVANNAH.

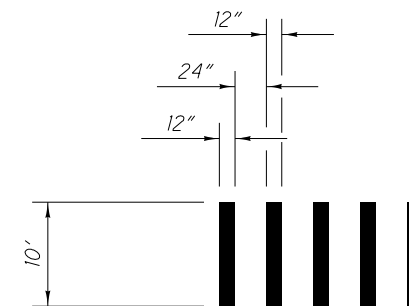

ITEM 442 - ASPHALT CONCRETE INTERMEDIATE COURSE, 19MM, TYPE A (448), AS PER PLAN

THIS ITEM SHALL BE USED FOR CORRECTION OF CROWN, PROFILE AND ANY OTHER IRREGULARITIES.

ALL OPEN TRANSVERSE JOINTS SHALL BE TAPERED TO MEET EXISTING PAVEMENT BEFORE INTRODUCING TRAFFIC. A "BUMP" SIGN (W8-1-36) SHALL BE ERECTED ON EACH SIDE OF TRANSVERSE JOINTS LEFT OPEN OVER NIGHT, INCLUDING A SPEED ADVISORY SIGN. THESE SIGNS SHALL BE REMOVED IMMEDIATELY AFTER JOINT HAS BEEN CLOSED. PLACEMENT OF SIGNS SHALL BE INCLUDED IN THE UNIT PRICE BID FOR ITEM 614 MAINTAINING TRAFFIC.

REQUIREMENTS OF 442 APPLY EXCEPT AS FOLLOWS:
MIX DESIGN: FOR Ndes USE 50 GYRATIONS, FOR Nmax USE 75 GYRATIONS. CHOOSE OPTIMUM BINDER CONTENT AT DESIGN AIR VOIDS OF 3.5%. USE A PG 64-22 BINDER.
MAXIMUM RECLAIMED ASPHALT CONCRETE PAVEMENT IS 30 PERCENT. APPLY 703.05 FOR COARSE AND FINE AGGREGATE EXCEPT GRADATION FOR FINE AGGREGATE DOES NOT APPLY.
QUALITY CONTROL: DO NOT PERFORM Nmax IN QUALITY CONTROL TESTING. DO NOT TAKE EXTRA ASPHALT BINDER SAMPLES AS OUTLINED IN CMS 442.05.

ITEM 442 - ASPHALT CONCRETE SURFACE COURSE, 12.5 MM, TYPE A (446)

ALL OPEN TRANSVERSE JOINTS SHALL BE TAPERED TO MEET EXISTING PAVEMENT BEFORE INTRODUCING TRAFFIC. A "BUMP" SIGN (W-8-1-36) SHALL BE ERECTED AT ANY TRANSVERSE JOINT LEFT OPEN OVER NIGHT, INCLUDING A SPEED ADVISORY SIGN. THESE SIGNS SHALL BE REMOVED IMMEDIATELY AFTER JOINT HAS BEEN CLOSED. PLACEMENT OF SIGNS SHALL BE INCLUDED IN THE UNIT PRICE BID FOR ITEM 614 MAINTAINING TRAFFIC.


CARE SHALL BE TAKEN TO MATCH EXISTING PAVEMENT ELEVATIONS AT EXISTING PAVED BERMS, DRIVES, INTERSECTIONS, ETC.

| SHEET NUM. | | | | | | | | | | PART. | | ITEM | ITEM EXT | GRAND TOTAL | UNIT | DESCRIPTION | SEE SHEET NO. | CALCULATED CVH | CHECKED CAD |
|------------|---|-----|---------|---------|-------|----|----|----|----|---------------------------------|-----------|---------|----------|-------------|------|--|---------------|----------------|-------------|
| 4 | 5 | 7 | 10 | 11 | 20 | 21 | 23 | 24 | 25 | 01/NFP/PV | 02/NFP/BR | | | | | | | | |
| | | | | | | | | | | ROADWAY | | | | | | | | | |
| 1,200 | | | | | | | | | | 1,200 | | 202 | 30000 | 1,200 | SF | WALK REMOVED | | | |
| 240 | | | | | | | | | | 240 | | 202 | 32000 | 240 | FT | CURB REMOVED | | | |
| | | | | 2,550 | | | | | | 2,550 | | 202 | 50000 | 2,550 | FT | GUARDRAIL REMOVED | | | |
| | | | | 22 | | | | | | 22 | | 202 | 42010 | 22 | EACH | ANCHOR ASSEMBLY REMOVED, TYPE E | | | |
| | | | | 8 | | | | | | 8 | | 202 | 42040 | 8 | EACH | ANCHOR ASSEMBLY REMOVED, TYPE T | | | |
| | | | | 20 | | | | | | 20 | | 202 | 47000 | 20 | EACH | BRIDGE TERMINAL ASSEMBLY REMOVED | | | |
| | | | | 617 | | | | | | 617 | | 203 | 20001 | 617 | CY | EMBANKMENT, AS PER PLAN | | | 6 |
| | | | | 44.4 | | | | | | 44.4 | | 209 | 15000 | 44.4 | STA | RESHAPING UNDER GUARDRAIL | | | |
| | | | 15.68 | | | | | | | 15.68 | | 209 | 60500 | 15.68 | MILE | LINEAR GRADING | | | |
| | | | | 2,912.5 | | | | | | 2,912.5 | | 606 | 15050 | 2,912.5 | FT | GUARDRAIL, TYPE MGS | | | |
| | | | | 150 | | | | | | 150 | | 606 | 17300 | 150 | FT | GUARDRAIL, TYPE 5, 25' LONG-SPAN | | | |
| | | | | 23 | | | | | | 23 | | 606 | 26150 | 23 | EACH | ANCHOR ASSEMBLY, MGS TYPE EMASH 2016 | | | |
| | | | | 7 | | | | | | 7 | | 606 | 26550 | 7 | EACH | ANCHOR ASSEMBLY, MGS TYPE T | | | |
| | | | | 20 | | | | | | 20 | | 606 | 35140 | 20 | EACH | BRIDGE TERMINAL ASSEMBLY, TYPE 4 | | | |
| 1,200 | | | | | | | | | | 1,200 | | 608 | 52000 | 1,200 | SF | CURB RAMP | | | |
| 240 | | | | | | | | | | 240 | | 609 | 26000 | 240 | FT | CURB, TYPE 6 | | | 4 |
| | | | | | | | | | | 5 | | 623 | 39500 | 5 | EACH | MONUMENT BOX ADJUSTED TO GRADE | | | |
| | | | | | | | | | | EROSION CONTROL | | | | | | | | | |
| | | | | | | | | | | 5,000 | | 832 | 30000 | 5,000 | EACH | EROSION CONTROL | | | |
| | | | | | | | | | | DRAINAGE | | | | | | | | | |
| 19 | | | | | | | | | | 19 | | 611 | 98630 | 19 | EACH | CATCH BASIN ADJUSTED TO GRADE | | | |
| 10 | | | | | | | | | | 10 | | 611 | 99654 | 10 | EACH | MANHOLE ADJUSTED TO GRADE | | | |
| | | | | | | | | | | PAVEMENT | | | | | | | | | |
| 1,300 | | | | | | | | | | 1,300 | | 251 | 01030 | 1,300 | CY | PARTIAL DEPTH PAVEMENT REPAIR (442) | | | |
| 130 | | | | | | | | | | 130 | | 253 | 02000 | 130 | CY | PAVEMENT REPAIR | | | |
| | | | 157,349 | | | | | | | 157,349 | | 254 | 01000 | 157,349 | SY | PAVEMENT PLANING, ASPHALT CONCRETE (1.50") | | | |
| | | | 43 | | | | | | | 43 | | 254 | 01600 | 43 | SY | PATCHING PLANED SURFACE | | | |
| | | | 12,423 | | | | | | | 12,423 | | 407 | 20000 | 12,423 | GAL | NON-TRACKING TACK COAT @ 0.08 | | | |
| | | | 7,600 | | | | | | | 7,600 | | 408 | 10001 | 7,600 | GAL | PRIME COAT, AS PER PLAN @ 0.04 | | | 4 |
| | | | 6,565 | | | | | | | 6,565 | | 442 | 10000 | 6,565 | CY | ASPHALT CONCRETE SURFACE COURSE, 12.5 MM, TYPE A (446) | | | |
| | | | 792 | | | | | | | 792 | | 617 | 10100 | 792 | CY | COMPACTED AGGREGATE | | | |
| | | | 12.34 | | | | | | | 12.34 | | 618 | 41000 | 12.34 | MILE | RUMBLE STRIPES, EDGE LINE (ASPHALT CONCRETE) | | | |
| | | | 6.17 | | | | | | | 6.17 | | 618 | 43000 | 6.17 | MILE | RUMBLE STRIPES, CENTER LINE (ASPHALT CONCRETE) | | | |
| | | | | | | | | | | 32,578 | | 874 | 20000 | 32,578 | FT | LONGITUDINAL JOINT PREPARATION | | | |
| | | | | | | | | | | TRAFFIC CONTROL | | | | | | | | | |
| | | | | 613 | | | | | | 613 | | 621 | 00100 | 613 | EACH | RPM | | | |
| | | | | 610 | | | | | | 610 | | 621 | 54000 | 610 | EACH | RAISED PAVEMENT MARKER REMOVED | | | |
| | | | | 59 | | | | | | 59 | | 626 | 00110 | 59 | EACH | BARRIER REFLECTOR, TYPE 2BIDIRECTIONAL | | | |
| | | 129 | | | | | | | | 129 | | 632 | 90500 | 129 | FT | SIGNALIZATION, MISC.: UNLASH AND RELASH MESSENGER WIRE | | | 5 |
| | | | | | 16.92 | | | | | 16.92 | | 642 | 00104 | 16.92 | MILE | EDGE LINE, 6", TYPE 1 | | | |
| | | | | 8.47 | | | | | | 8.47 | | 642 | 00300 | 8.47 | MILE | CENTER LINE, TYPE 1 | | | |
| | | | | 450 | | | | | | 450 | | 644 | 00404 | 450 | FT | CHANNELIZING LINE, 12" | | | |
| | | | | 438 | | | | | | 438 | | 644 | 00500 | 438 | FT | STOP LINE | | | |
| | | | | 440 | | | | | | 440 | | 644 | 00600 | 440 | FT | CROSSWALK LINE | | | |
| | | | | 295 | | | | | | 295 | | 644 | 00700 | 295 | FT | TRANSVERSE/DIAGONAL LINE | | | |
| | | | | 6 | | | | | | 6 | | 644 | 01300 | 6 | EACH | LANE ARROW | | | |
| | 4 | | | | | | | | | 4 | | 809 | 69100 | 4 | EACH | STOP LINE RADAR DETECTION | | | |
| | | | | | | | | | | STRUCTURE REPAIR (ASD-250-0009) | | | | | | | | | |
| | | | | 82 | | | | | | 82 | | 202 | 38602 | 82 | FT | BRIDGE RAILING REMOVED FOR REUSE | | | |
| | | | | 2 | | | | | | 2 | | 254 | 01000 | 2 | SY | PAVEMENT PLANING, ASPHALT CONCRETE (1.50") | | | 4 |
| | | | | 17 | | | | | | 17 | | 513 | 33000 | 17 | SK | TYPE 3 WATERPROOFING | | | |
| | | | | 37 | | | | | | 37 | | 515 | 30000 | 37 | FT | HIGH EARLY STRENGTH KEYWAY GROUT | | | |
| | | | | 82 | | | | | | 82 | | 517 | 75600 | 82 | FT | DEEP BEAM BRIDGE RETROFIT RAILING | | | |
| | | | | 74 | | | | | | 74 | | SPECIAL | 5182500 | 74 | FT | STEEL DRIP STRIP | | | 6 |
| | | | | 48 | | | | | | 48 | | 846 | 00110 | 48 | CF | POLYMER MODIFIED ASPHALT EXPANSION JOINT SYSTEM | | | |

GENERAL SUMMARY

ASD-250-0.00


I:\ProjectData\1031\Design\Roadway\Sheets\1031L_GG001.dgn

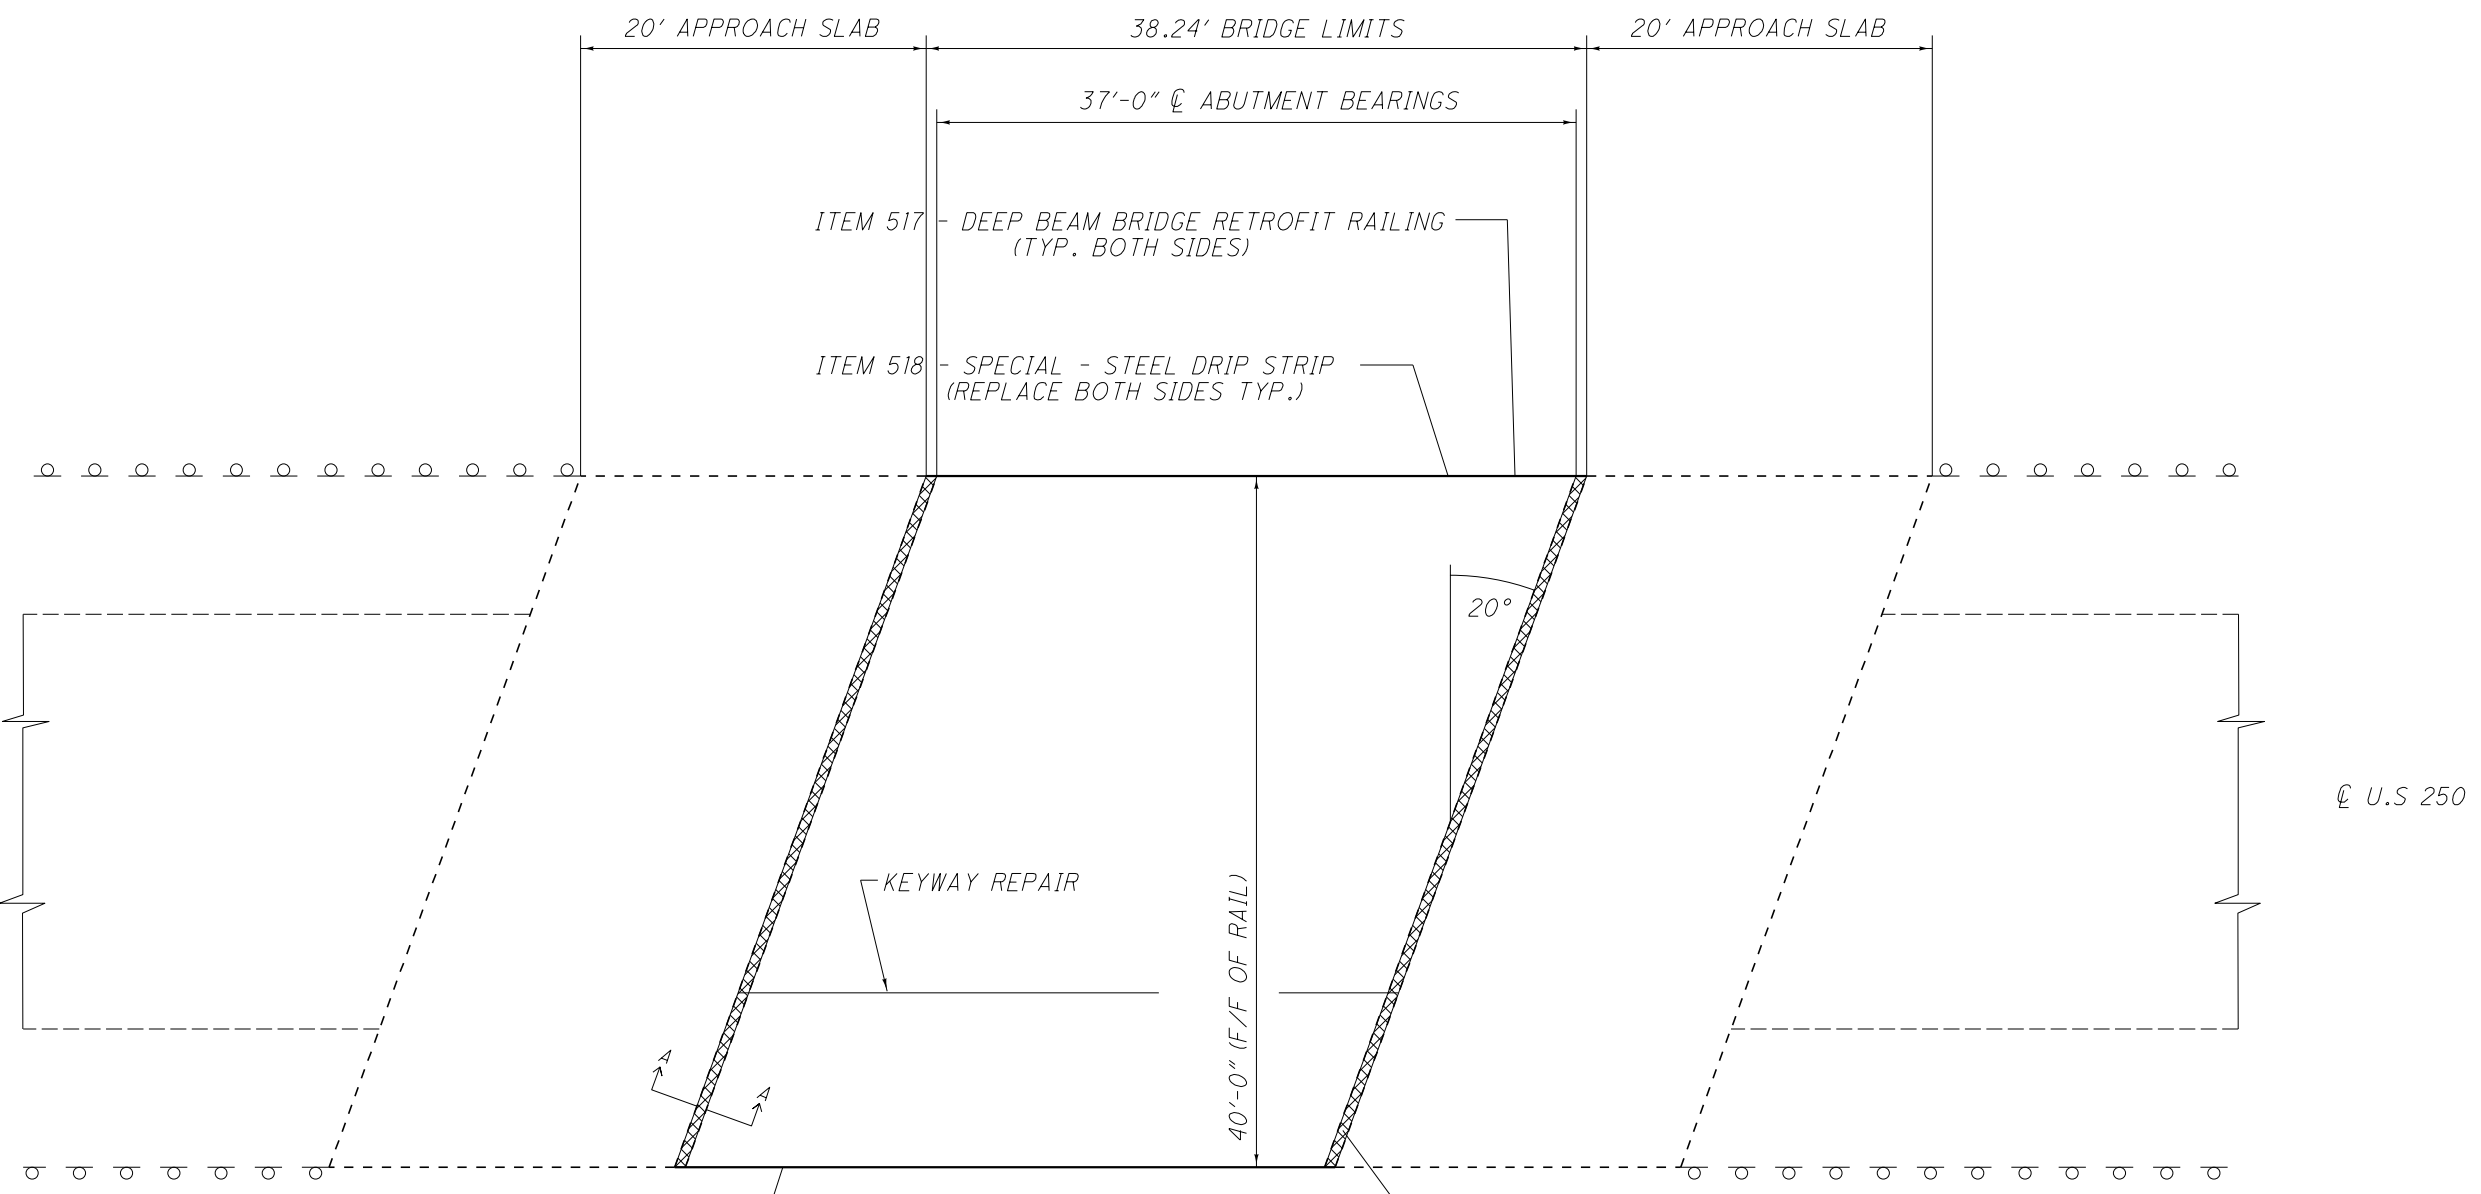

ITEM 202 - BRIDGE RAILING REMOVED FOR REUSE (TYPICAL BOTH SIDES)

REMOVE AND REPLACE POLYMER MODIFIED ASPHALT EXPANSION JOINT SYSTEM. TYPICAL BOTH ENDS OF STRUCTURE


ITEM 846 - POLYMER MODIFIED ASPHALT EXPANSION JOINT SYSTEM

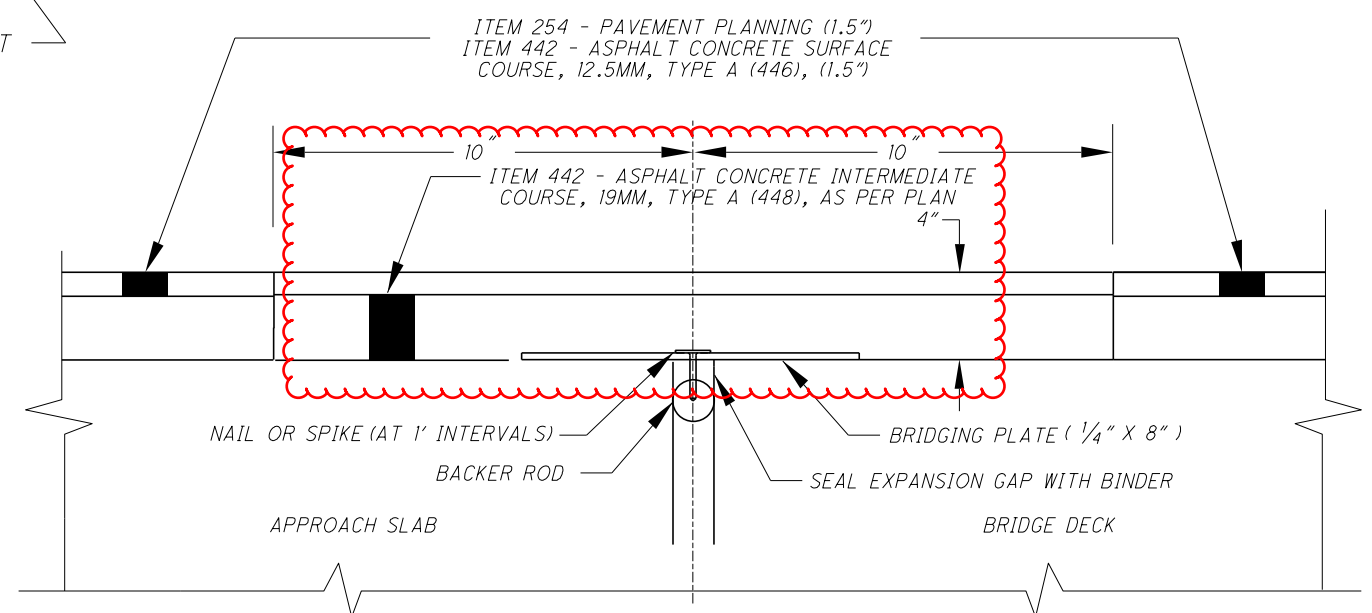

| ESTIMATED QUANTITIES ASD-250-0009 (SFN: 0304549) | | | | |
|--|-----------|----------|------|---|
| ITEM | EXTENSION | QUANTITY | UNIT | DESCRIPTION |
| 202 | 38602 | 82 | FT | BRIDGE RAILING REMOVED FOR REUSE |
| 254 | 01000 | 17 | SY | PAVEMENT PLANING, ASPHALT CONCRETE (2.50") |
| 442 | 10000 | 2 | CY | ASPHALT CONCRETE INTERMEDIATE COURSE, 19MM, TYPE A (448), AS PER PLAN |
| 512 | 33016 | 17 | SY | TYPE 3 WATERPROOFING |
| 515 | 30000 | 37 | FT | HIGH EARLY STRENGTH KEYWAY GROUT |
| 517 | 75600 | 82 | FT | DEEP BEAM BRIDGE RETROFIT RAILING |
| 518 | 22300 | 74 | FT | SPECIAL - STEEL DRIP STRIP |
| 846 | 00110 | 48 | CF | POLYMER MODIFIED ASPHALT EXPANSION JOINT SYSTEM |

ALL QUANTITIES CARRIED TO GENERAL SUMMARY

SECTION A-A

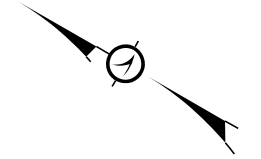

DESIGN AGENCY: ODOT DISTRICT THREE

DATE: MM/DD/YY

REVIEWED: XXX

STRUCTURE FILE NUMBER: 0304549

DRAWN: XXX

CHECKED: CVH

DESIGNED: []


SITE PLAN: ASD-250-0009 OVER INTERMITTENT WATERWAY

ASD-250-0.00

1 / 2


21 / 26

I:\ProjectData\1031\Design\Structures\1031\ASD-250-0.09.dgn

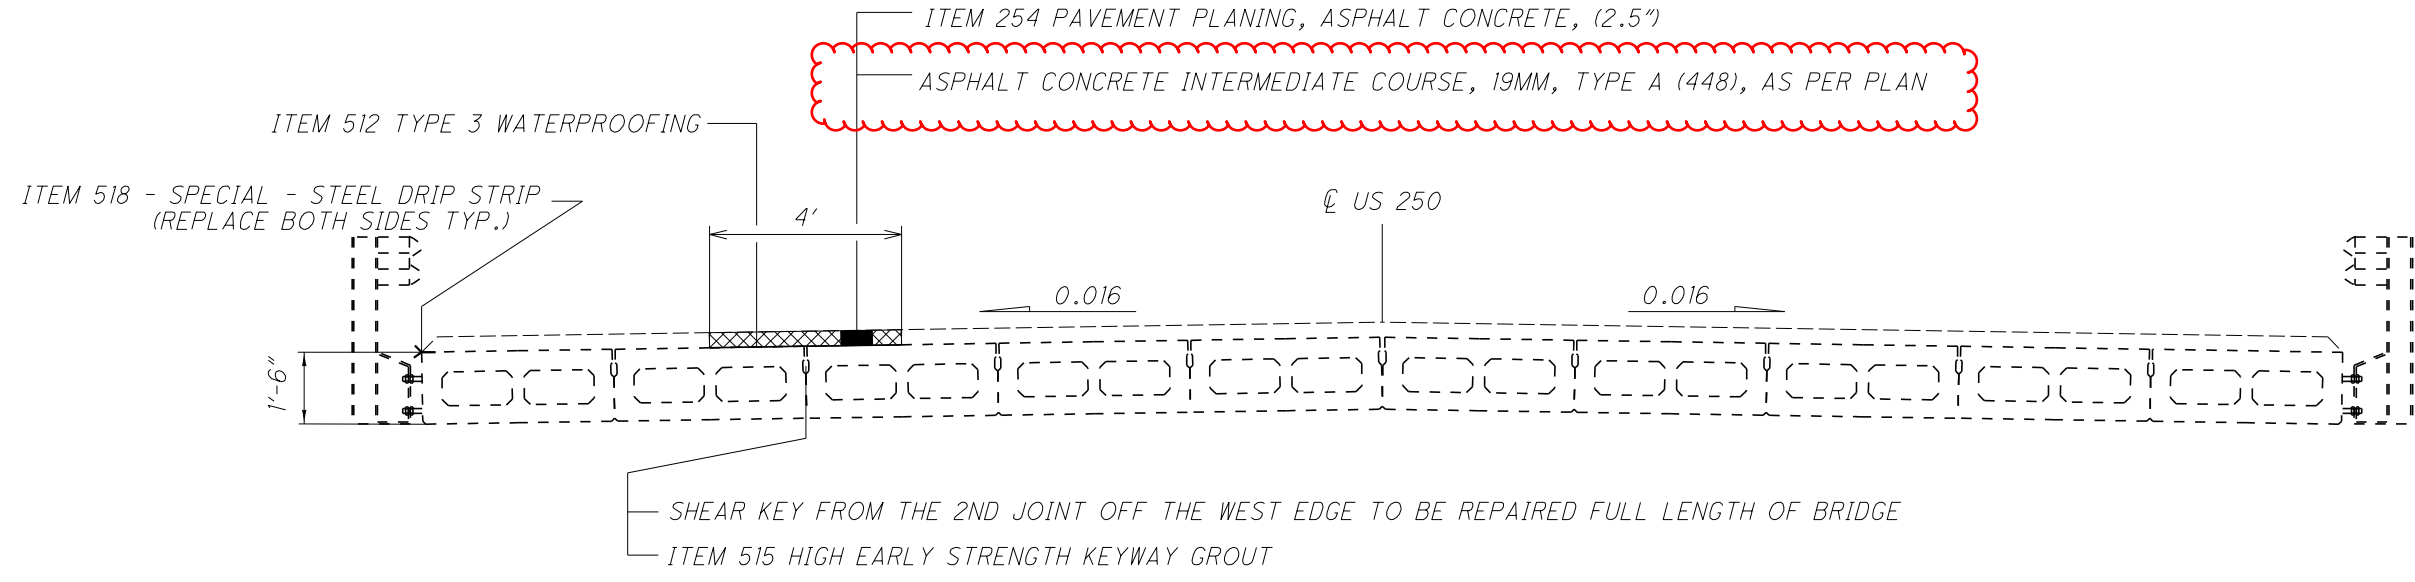

▨ - WEARING COURSE REMOVED

TYPICAL DECK SECTION



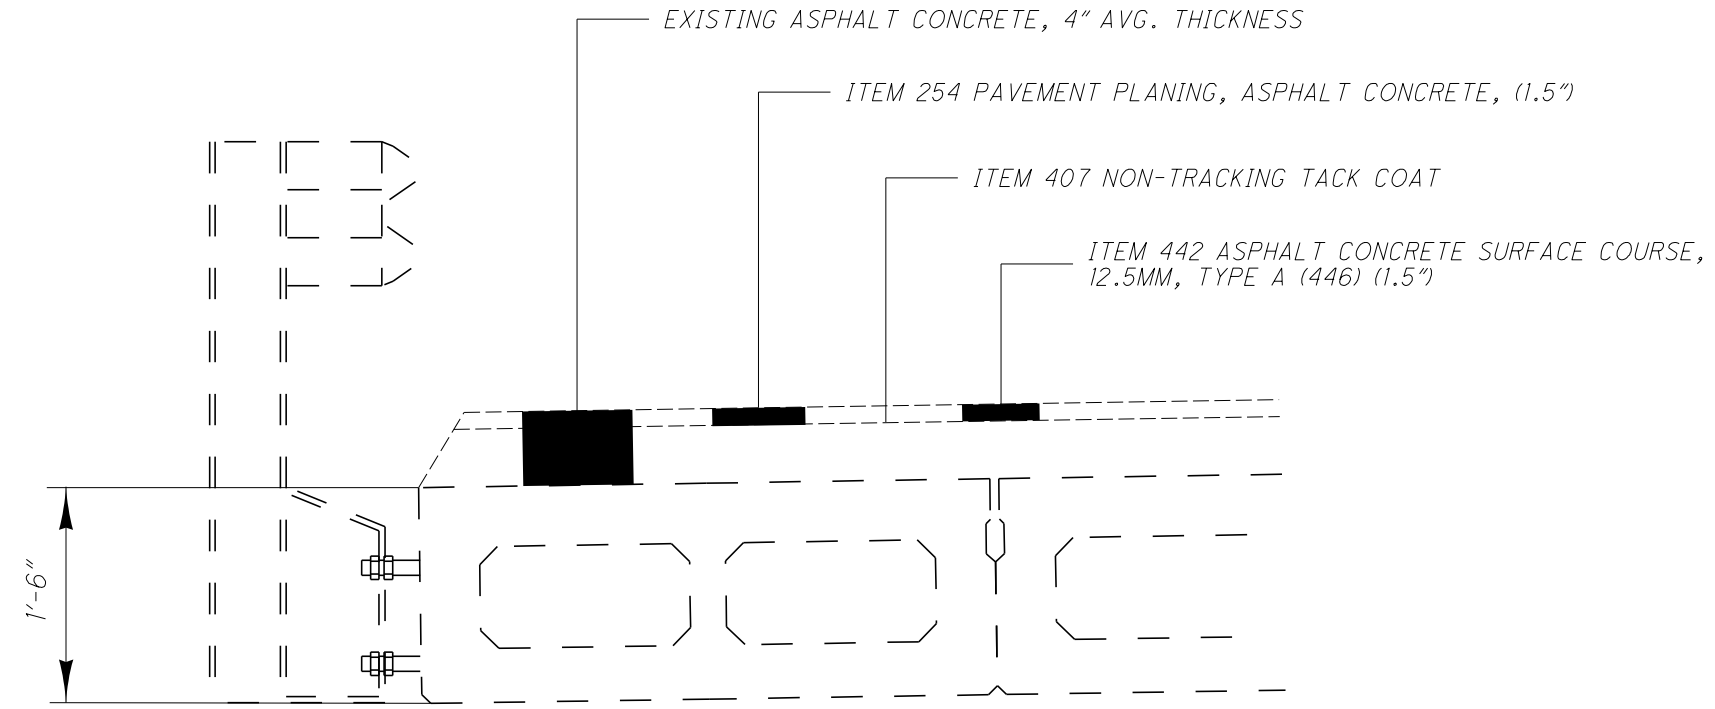


SEQUENCE OF WORK

- 1) PLANE BRIDGE DECK 1.5" TO MEET MT-101.90 AND INSTALL WORK ZONE CENTER LINE.
- 2) REMOVE WEARING COURSE.
- 3) REMOVE AND REPAIR GROUT IN KEYWAY JOINT. THE KEYWAY SURFACES SHALL BE THOROUGHLY CLEANED OF ALL DIRT, DUST AND OTHER FOREIGN MATTER BY SANDBLASTING AND HIGH PRESSURE WASHING. ANY CARBONATION FOUND SHALL BE REMOVED BY RE-BLASTING AND RE-WASHING. DRYNESS OF THE KEYWAY SURFACE BEFORE GROUTING SHALL BE AS PER THE MANUFACTURERS RECOMMENDATION
- 4) INSTALL WATERPROOFING AND INTERMEDIATE ASPHALT AFTER GROUT ACHIEVES 5000PSI PER ALTERNATE 2 ON PSBD-2-07
- 5) PAVE SURFACE COURSE ON BRIDGE

I:\ProjectData\1031\Design\Structures\1031L ASD-250-0.09.dgn

| | | | | | |
|--------------|---------|---------|----------------------------|----------|----------------|
| DESIGNED | CHECKED | DRAWN | REVIEWED | DATE | DESIGN AGENCY |
| | | XXX | XXX | MM/DD/YY | ODOT |
| | | REVISED | STRUCTURE FILE NUMBER | | DISTRICT THREE |
| | | CVH | 0304549 | | |
| SITE PLAN | | | OVER INTERMITTENT WATERWAY | | |
| ASD-250-0.00 | | | ASD-250-0009 | | |
| 2 / 2 | | | | | |
| 22 | | | 26 | | |

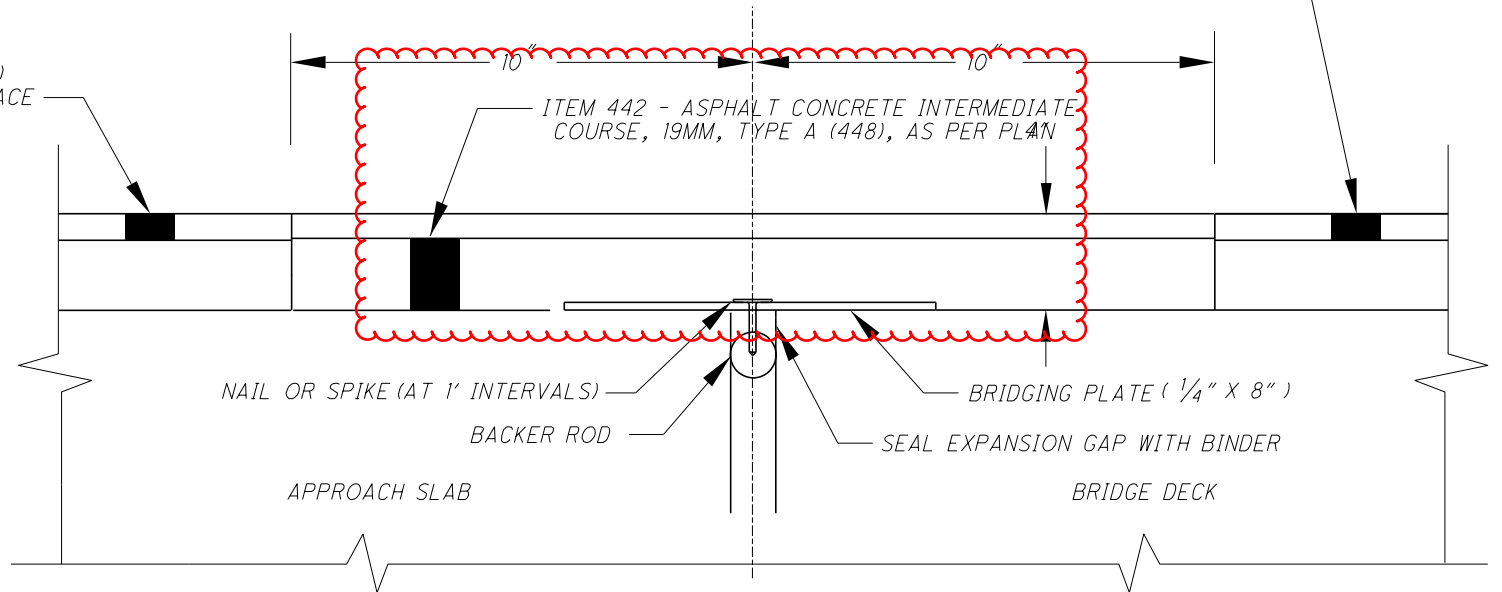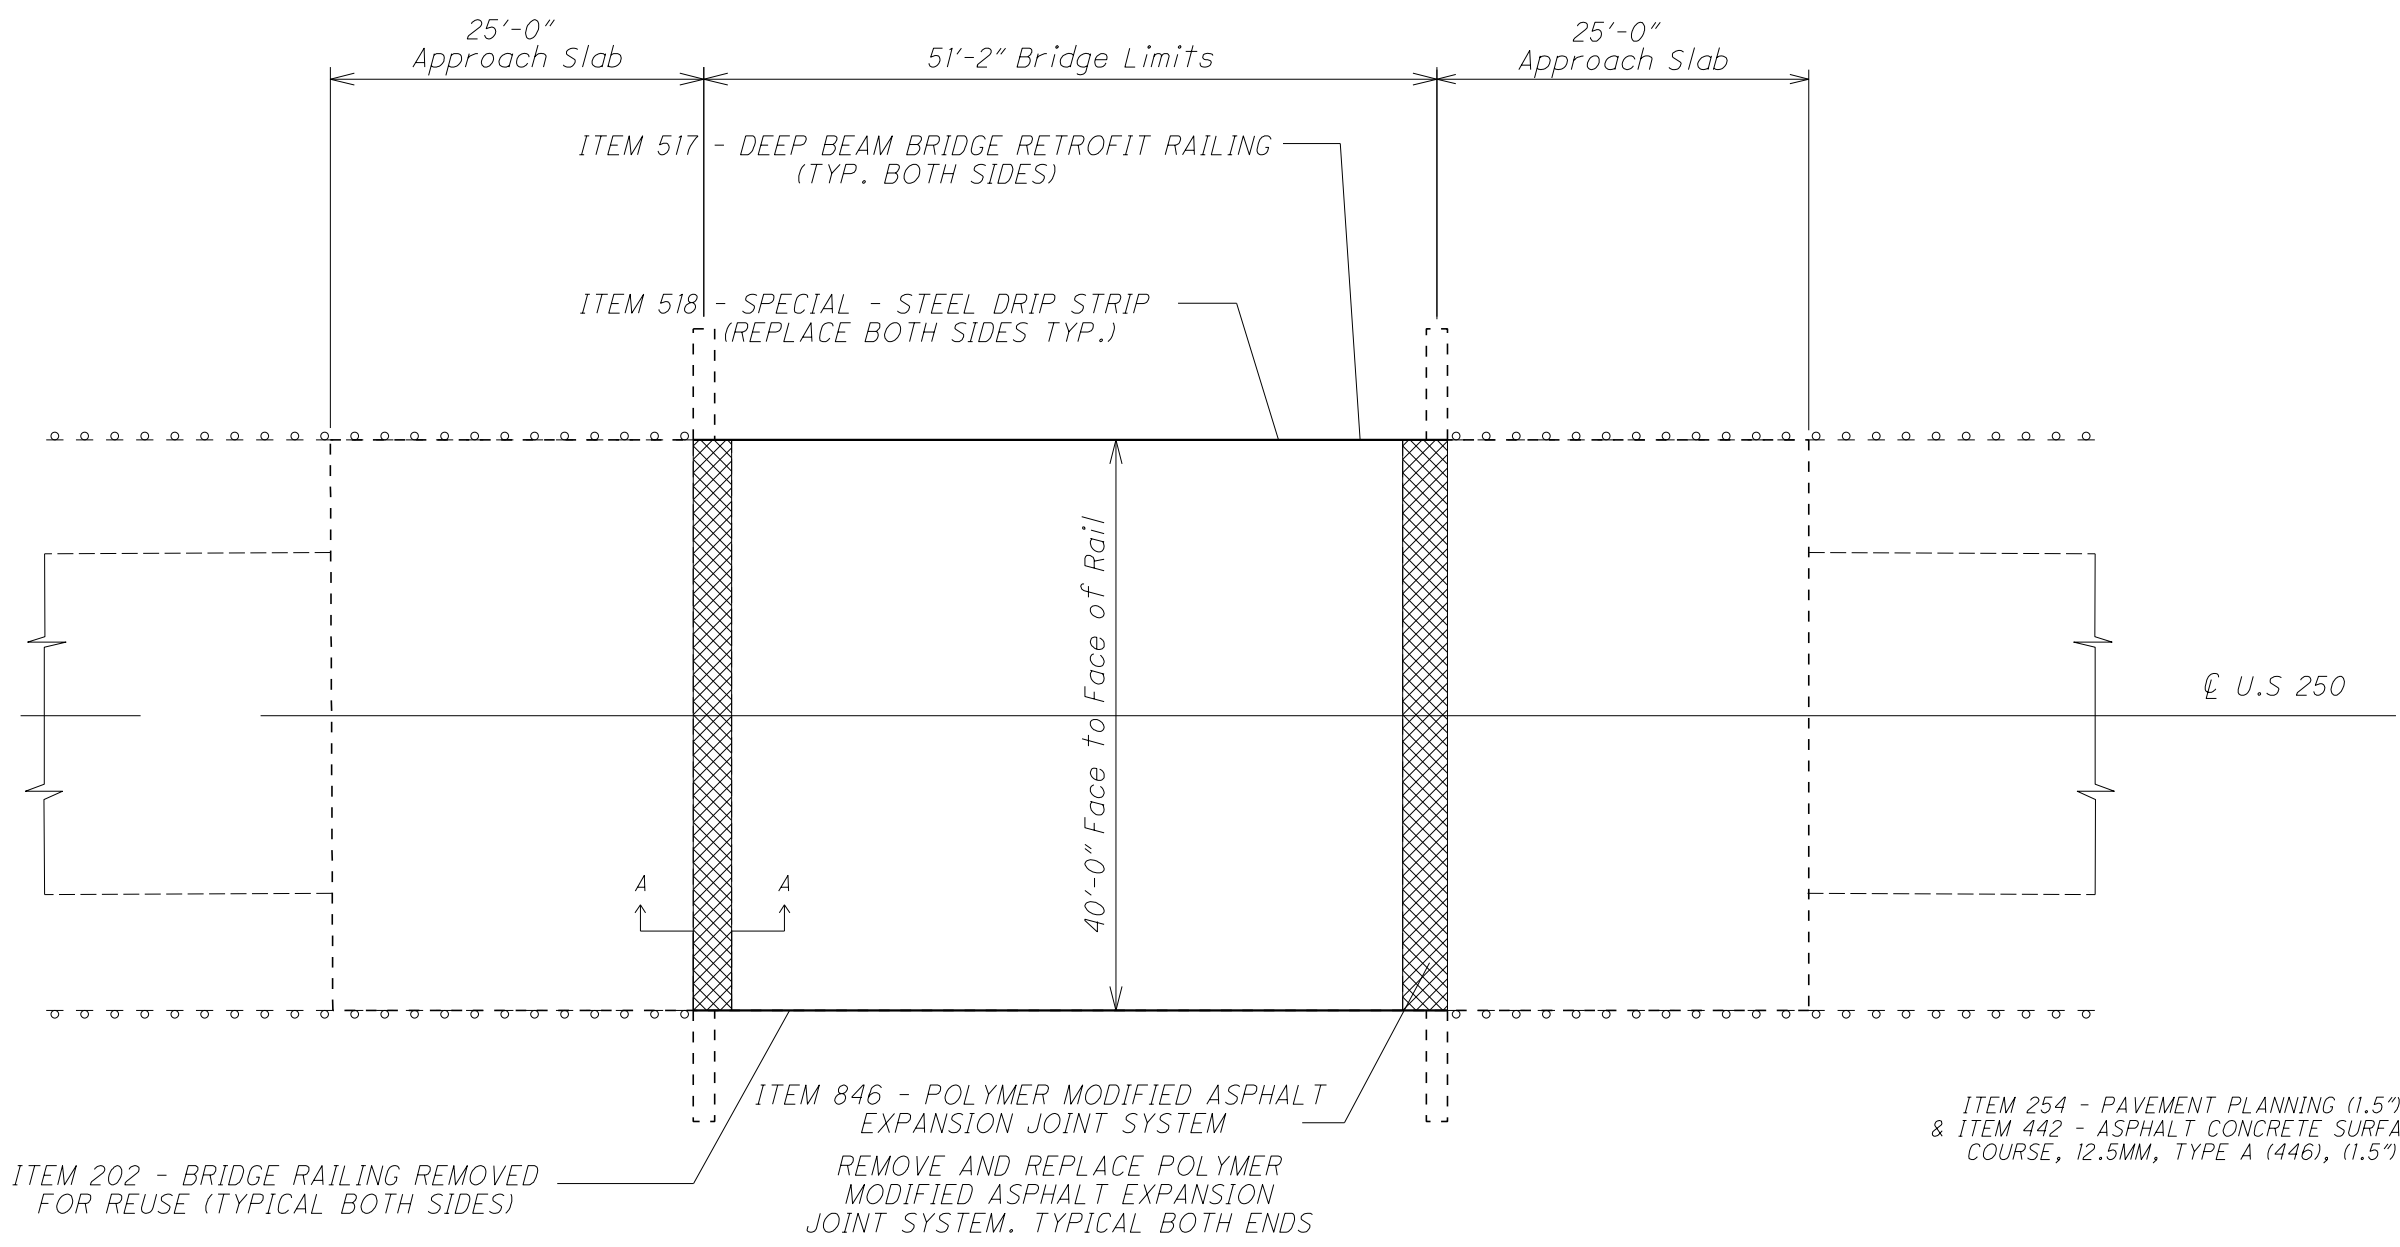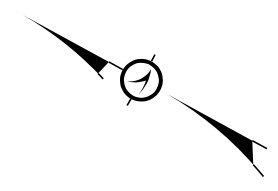

SECTION A-A

| ESTIMATED QUANTITIES ASD-250-0106 (SFN: 0304573) | | | | |
|--|-----------|----------|------|---|
| ITEM | EXTENSION | QUANTITY | UNIT | DESCRIPTION |
| 202 | 88602 | 932 | FT | BRIDGE RAILINGS REMOVED FOR REUSE |
| 442 | 10000 | 1 | CY | ASPHALT CONCRETE INTERMEDIATE COURSE, 19MM, TYPE A (448), AS PER PLAN |
| 517 | 75000 | 113 | FT | DEEP BEAM BRIDGE RETROFIT RAILING |
| 518 | 22500 | 102 | FT | SPECIAL - STEEL DRIP STRIP |
| 846 | 00110 | 44 | CF | POLYMER MODIFIED ASPHALT EXPANSION JOINT SYSTEM |
| | | | | |
| | | | | |

ALL QUANTITIES CARRIED TO GENERAL SUMMARY

DESIGN AGENCY
ODOT
DISTRICT THREE

DATE
MM/DD/YY
03/04/23

REVIEWED
XXX
STRUCTURE FILE NUMBER
0304573

DRAWN
XXX
REVISED
CVH

DESIGNED
CHECKED



SITE PLAN
ASD-250-0106
OVER BRANCH OF VERMILION RIVER

ASD-250-0.00

1 / 1

23
26

I:\ProjectData\1031\Design\Structures\1031\ASD-250-1.06.dgn

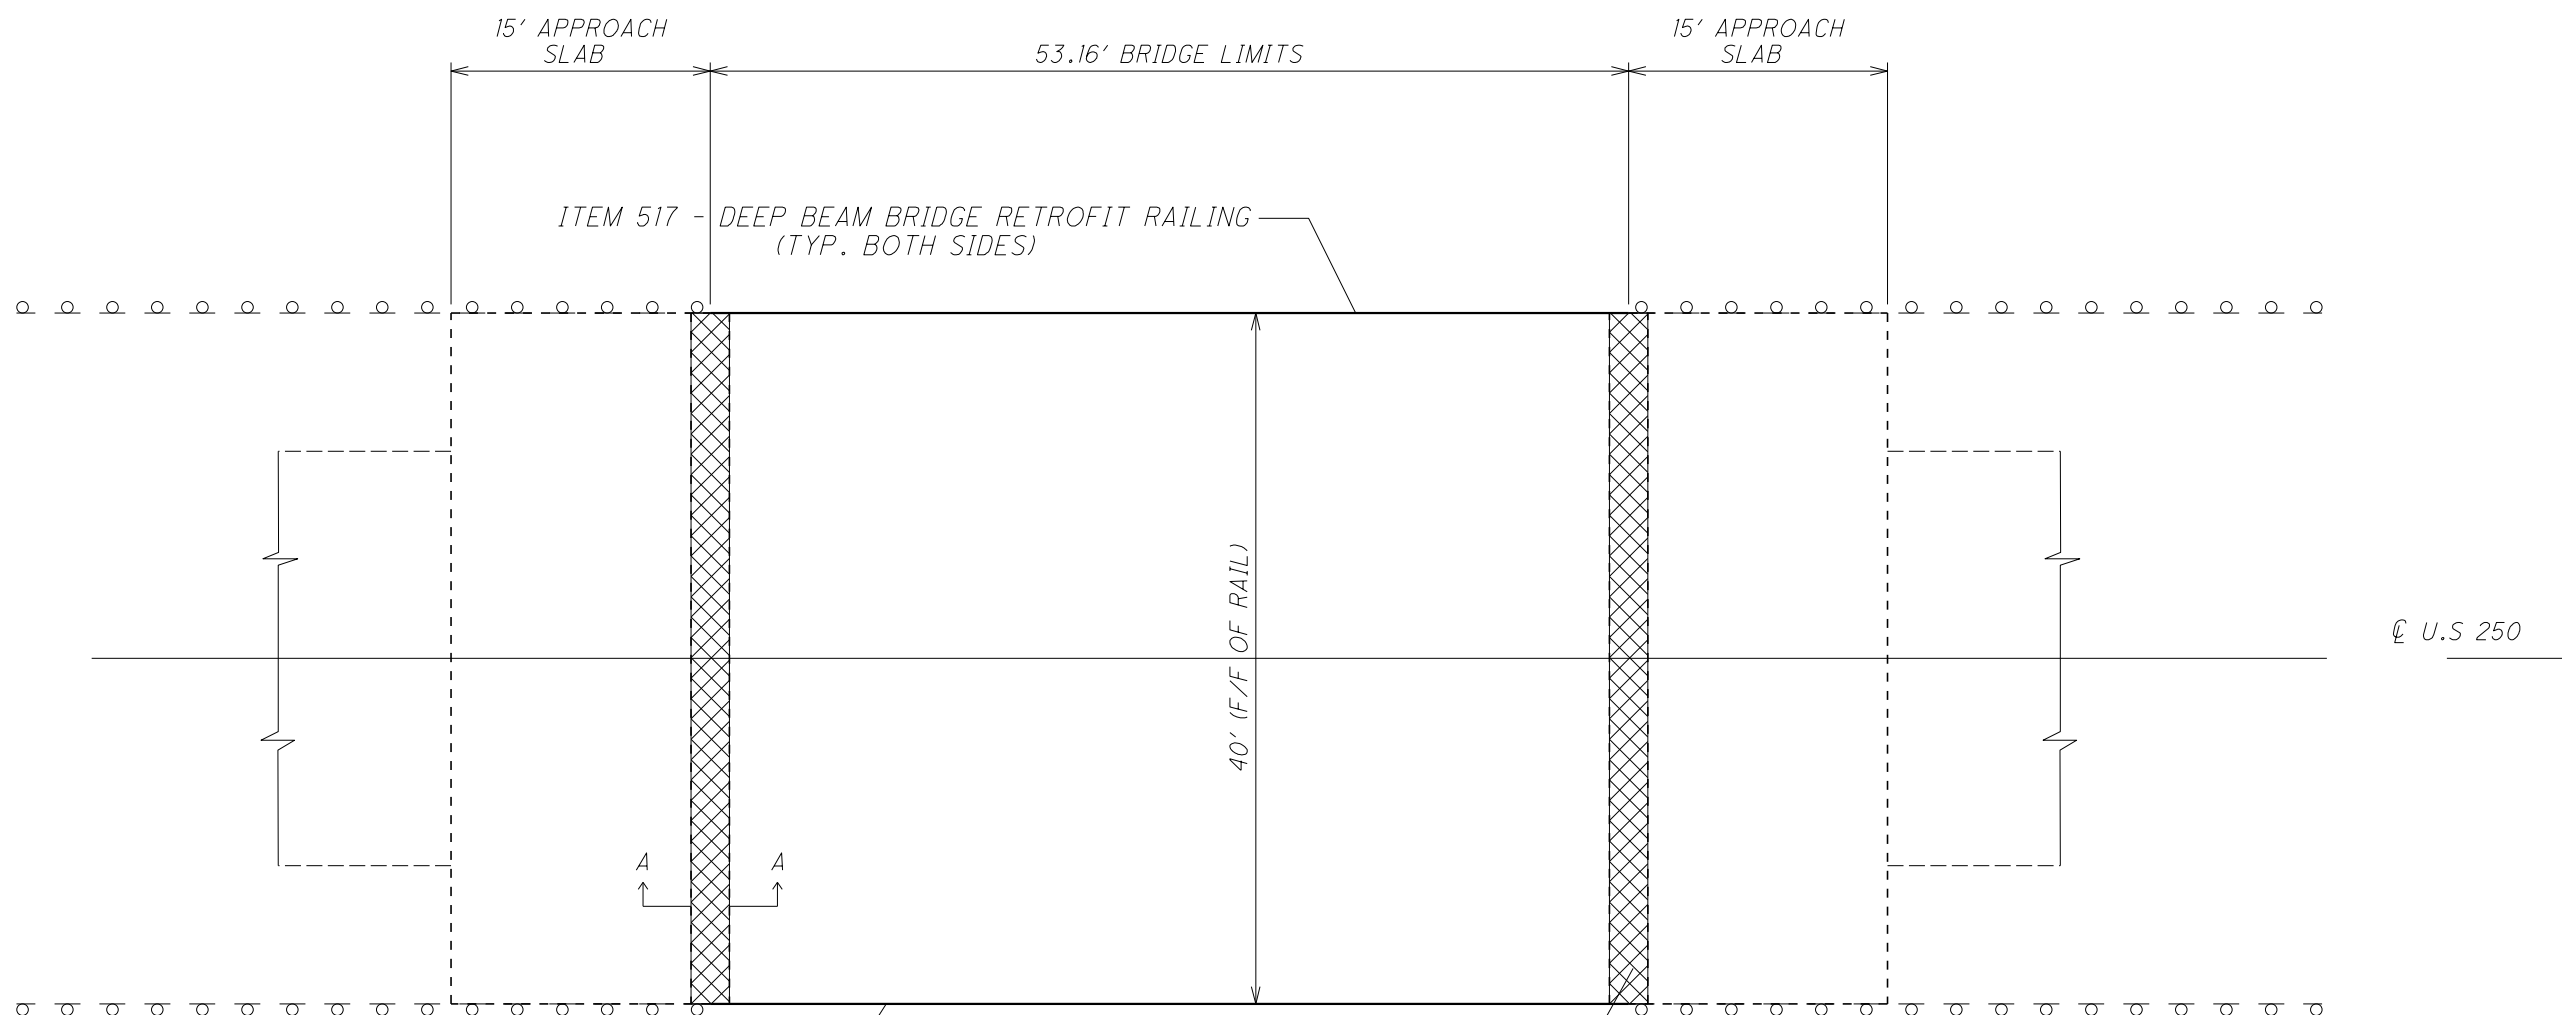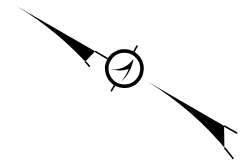

ITEM 202 - BRIDGE RAILING REMOVED FOR REUSE (TYPICAL BOTH SIDES)


ITEM 846 - POLYMER MODIFIED ASPHALT EXPANSION JOINT SYSTEM

REMOVE AND REPLACE POLYMER MODIFIED ASPHALT EXPANSION JOINT SYSTEM. TYPICAL BOTH ENDS

ITEM 254 - PAVEMENT PLANNING (1.5") & ITEM 442 - ASPHALT CONCRETE SURFACE COURSE, 12.5MM, TYPE A (446), (1.5")

ITEM 254 - PAVEMENT PLANNING (1.5") & ITEM 442 - ASPHALT CONCRETE SURFACE COURSE, 12.5MM, TYPE A (446), (1.5")

ITEM 442 - ASPHALT CONCRETE INTERMEDIATE COURSE, 19MM, TYPE A (448), AS PER PLAN 4"

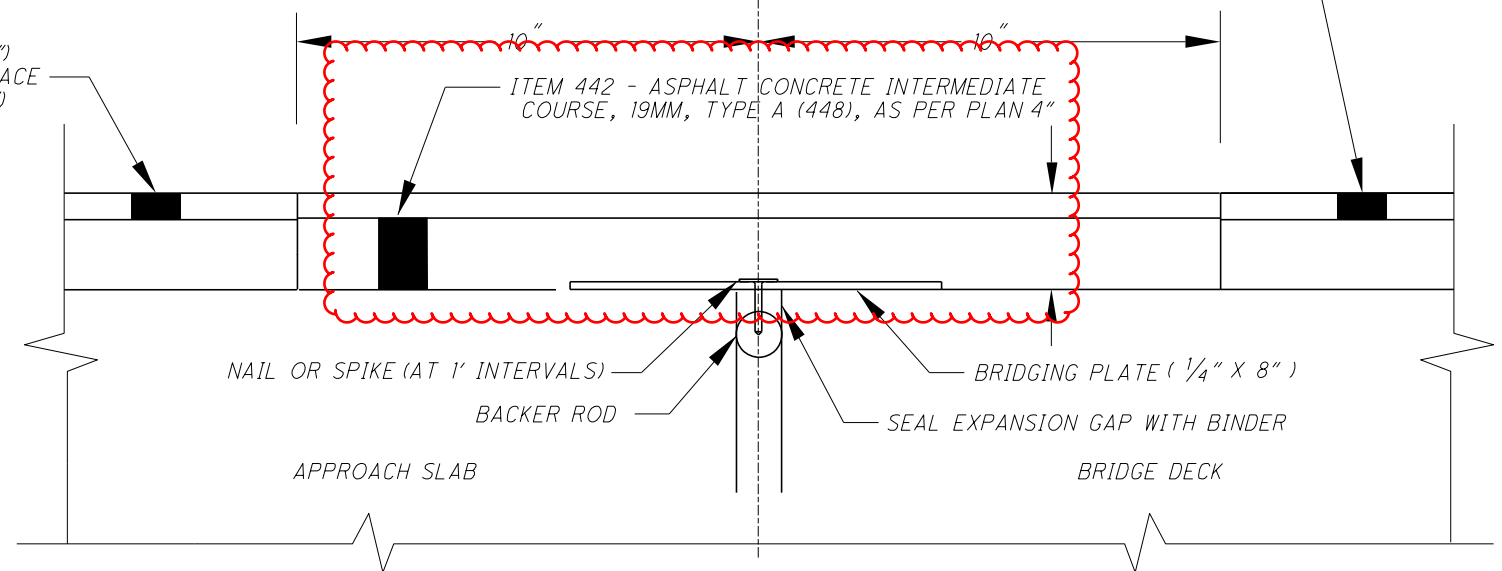

SECTION A-A

| ESTIMATED QUANTITIES ASD-250-0742 (SFN: 0304735) | | | | |
|--|-----------|----------|------|---|
| ITEM | EXTENSION | QUANTITY | UNIT | DESCRIPTION |
| 202 | 58602 | 156 | FT | BRIDGE RAILING REMOVED FOR REUSE |
| 442 | 10000 | 1 | CY | ASPHALT CONCRETE INTERMEDIATE COURSE, 19MM, TYPE A (448), AS PER PLAN |
| 517 | 15800 | 108 | FT | DEEP BEAM BRIDGE RETROFIT RAILING |
| 846 | 00110 | 44 | CF | POLYMER MODIFIED ASPHALT EXPANSION JOINT SYSTEM |
| | | | | |
| | | | | |
| | | | | |
| | | | | |

ALL QUANTITIES CARRIED TO GENERAL SUMMARY

DESIGN AGENCY
ODOT
DISTRICT THREE

DATE
MM/DD/YY
XXX

REVIEWED
STRUCTURE FILE NUMBER
0304735

DRAWN
XXX

DESIGNED
XXX

CHECKED
XXX

REVISED
XXX



SITE PLAN
ASD-250-0742
OVER BRANCH OF VERMILION RIVER

ASD-250-0.00

1 / 1

24
26

I:\ProjectData\1031\Design\Structures\1031L\ASD-250-7.42.dgn

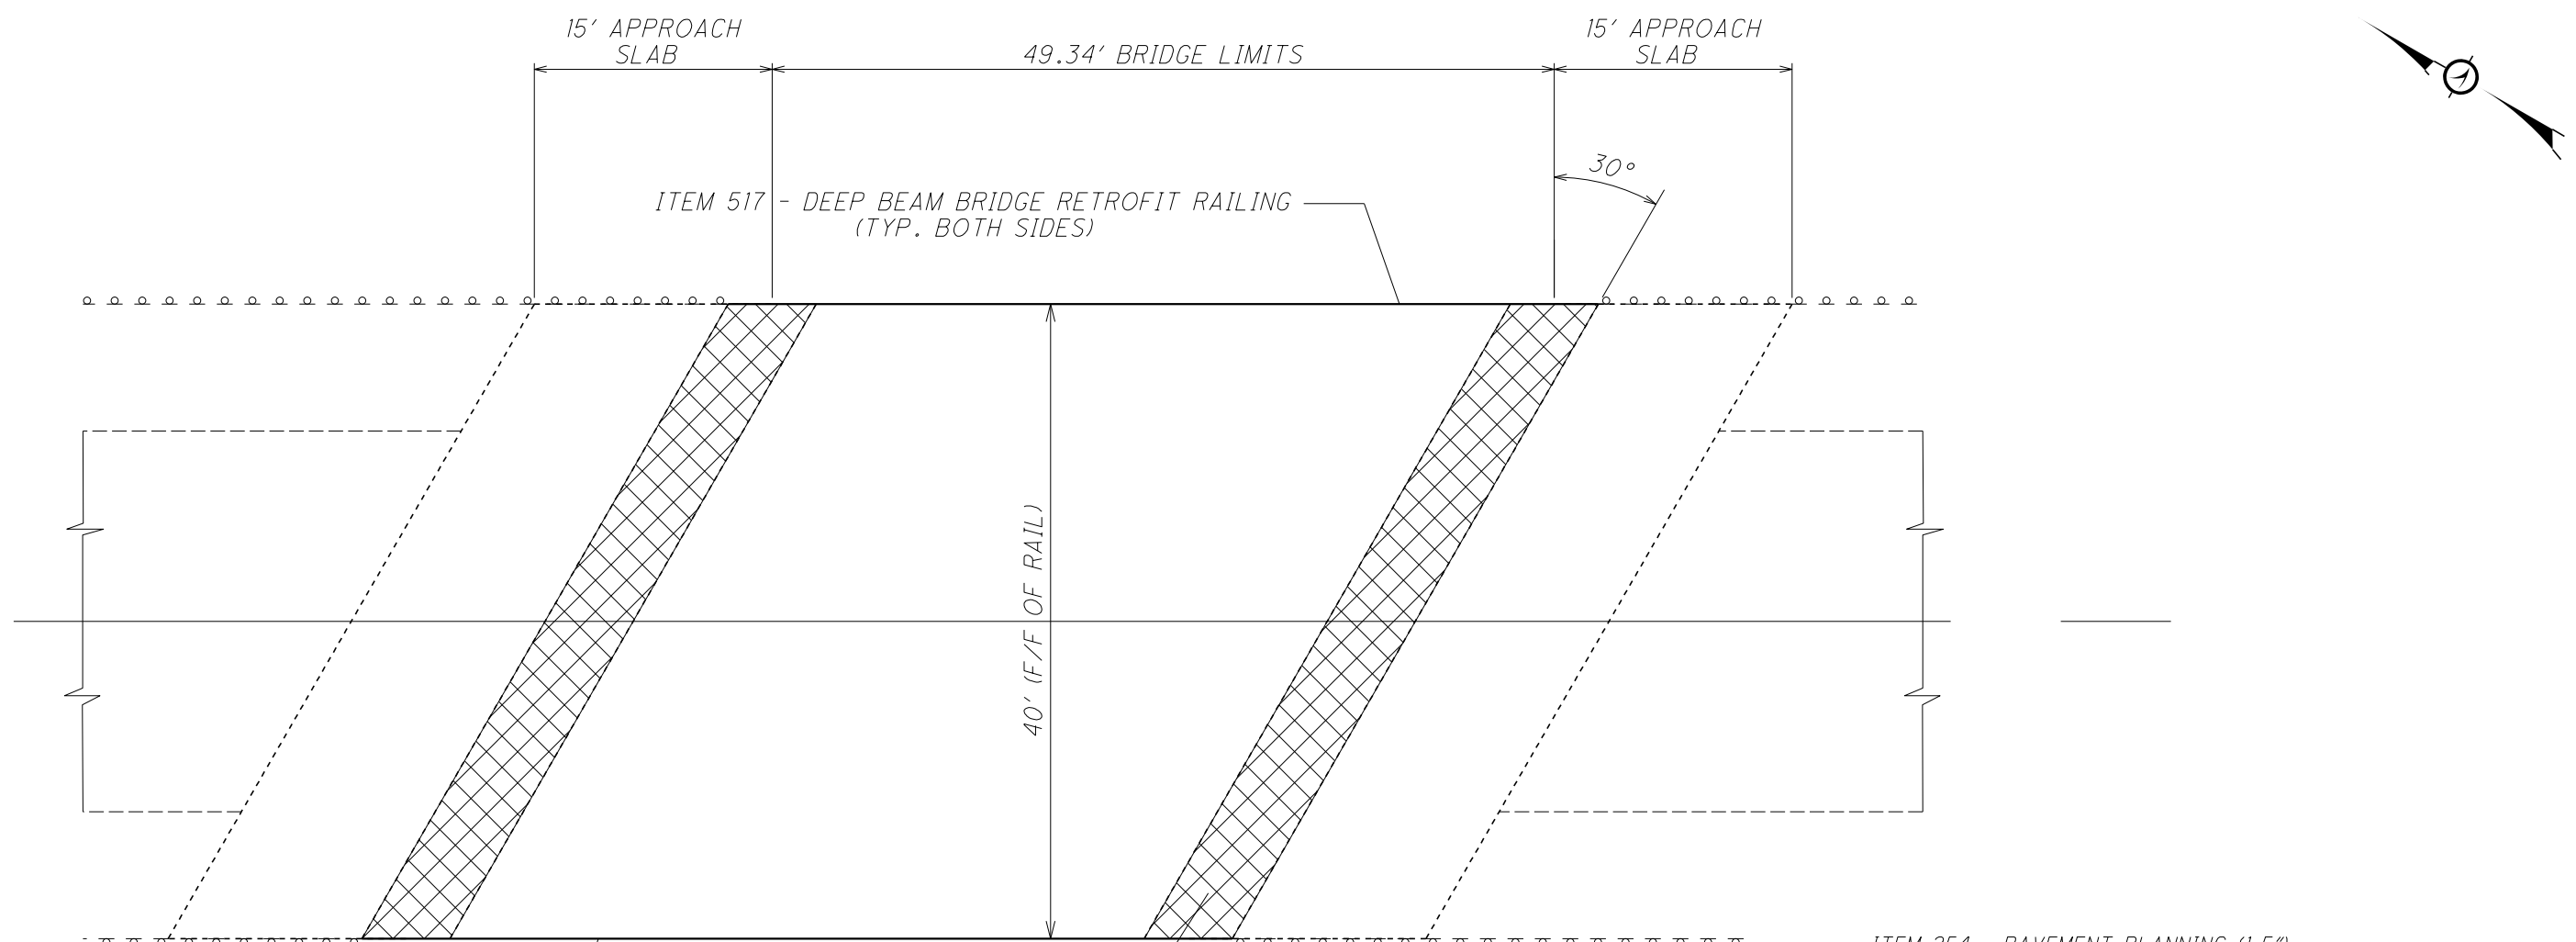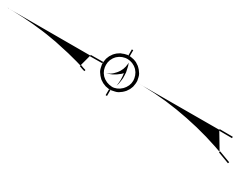


ITEM 202 - BRIDGE RAILING REMOVED FOR REUSE (TYPICAL BOTH SIDES)

ITEM 846 - POLYMER MODIFIED ASPHALT EXPANSION JOINT SYSTEM
REMOVE AND REPLACE POLYMER MODIFIED ASPHALT EXPANSION JOINT SYSTEM. TYPICAL BOTH ENDS

ITEM 254 - PAVEMENT PLANNING (1.5") & ITEM 442 - ASPHALT CONCRETE SURFACE COURSE, 12.5MM, TYPE A (446), (1.5")

ITEM 254 - PAVEMENT PLANNING (1.5") & ITEM 442 - ASPHALT CONCRETE SURFACE COURSE, 12.5MM, TYPE A (446), (1.5")

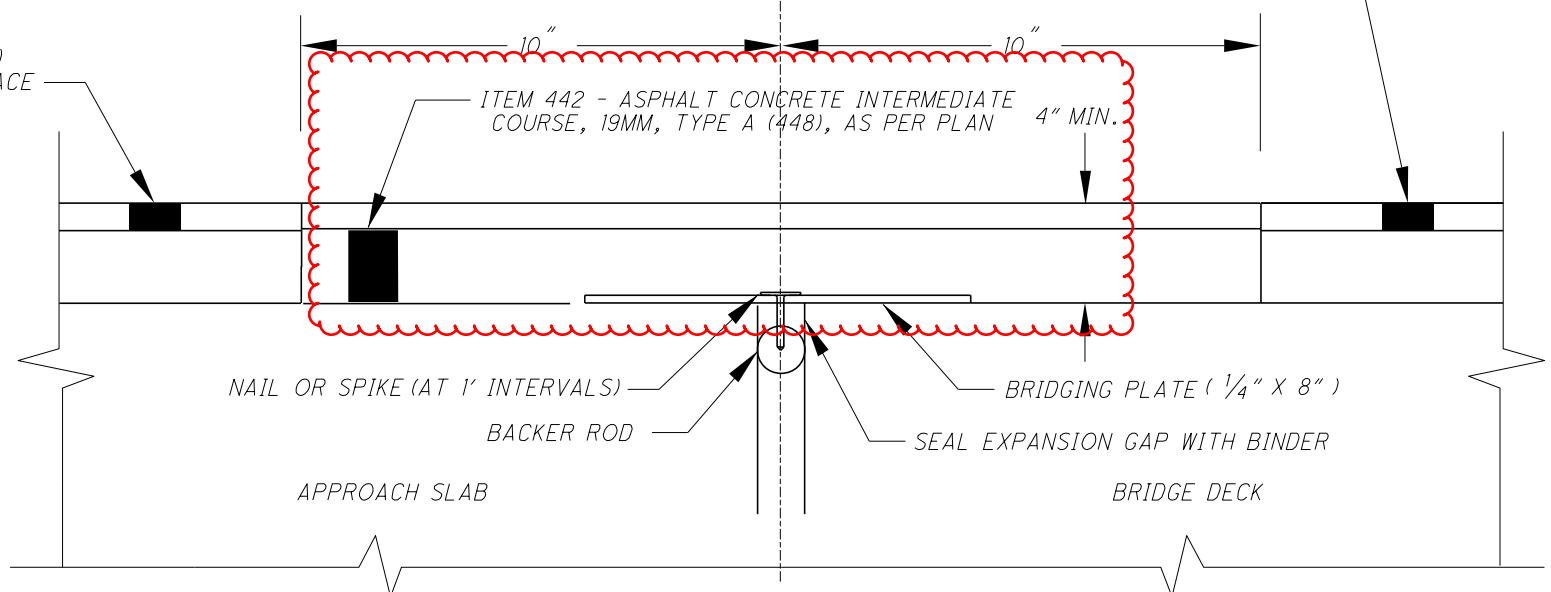

SECTION A-A

| ESTIMATED QUANTITIES ASD-250-0756 (SFN: 0304751) | | | | |
|--|-----------|----------|------|---|
| ITEM | EXTENSION | QUANTITY | UNIT | DESCRIPTION |
| 202 | 0000 | 150 | FT | BRIDGE RAILING REMOVED FOR REUSE |
| 442 | 10000 | 1 | CY | ASPHALT CONCRETE INTERMEDIATE COURSE, 19MM, TYPE A (448), AS PER PLAN |
| 517 | 15000 | 100 | FT | DEEP BEAM BRIDGE RETROFIT RAILING |
| 846 | 00110 | 48 | CF | POLYMER MODIFIED ASPHALT EXPANSION JOINT SYSTEM |
| | | | | |
| | | | | |
ALL QUANTITIES CARRIED TO GENERAL SUMMARY

DESIGN AGENCY
ODOT
DISTRICT THREE

DATE
MM/DD/YY
XXX
STRUCTURE FILE NUMBER
0304751

DRAWN
XXX
REVISOR
XXX

DESIGNED
XXX
CHECKED
XXX

SITE PLAN
ASD-250-0756
OVER SAVANNAH LAKE DITCH

ASD-250-0.00

1 / 1

25
26

I:\ProjectData\1031\Design\Structures\1031L_ASD-250-7.56.dgn