


STATE OF OHIO DEPARTMENT OF TRANSPORTATION

ASD-42-18.03

JACKSON TOWNSHIP
ASHLAND COUNTY

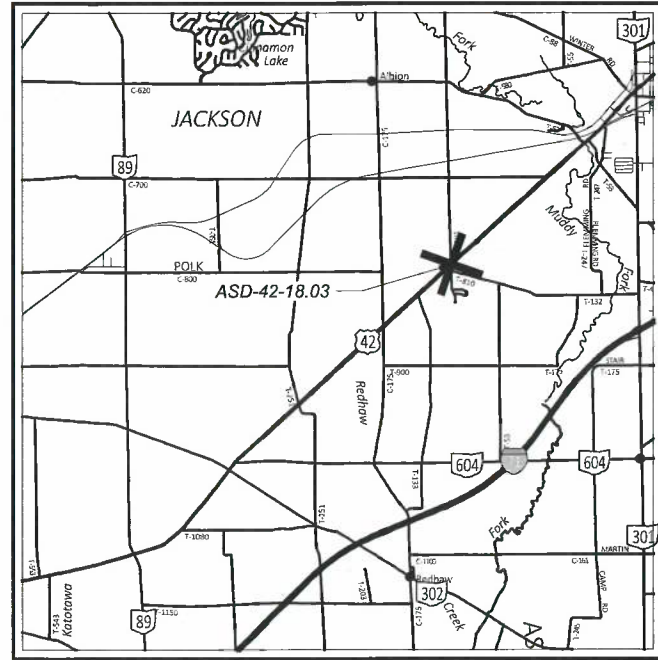

LOCATION MAP

LATITUDE: 40°56'45" LONGITUDE: 82°08'51"



PORTION TO BE IMPROVED	X
INTERSTATE HIGHWAY	_____
FEDERAL ROUTES	=====
STATE ROUTES	=====
COUNTY & TOWNSHIP ROADS	=====
OTHER ROADS	=====

DESIGN DESIGNATION **U.S.R. 42**

CURRENT ADT (2023)	2,400
DESIGN YEAR ADT (2043)	3,100
DESIGN HOURLY VOLUME (2043)	350
DIRECTIONAL DISTRIBUTION	53%
TRUCKS (24 HOUR B&C)	5%
DESIGN SPEED	60 MPH
LEGAL SPEED	60 MPH
DESIGN FUNCTIONAL CLASSIFICATION:	
MAJOR COLLECTOR	
NHS PROJECT	NO

DESIGN EXCEPTIONS

NONE

ADA DESIGN WAIVERS

NONE

UNDERGROUND UTILITIES
Contact Two Working Days
Before You Dig

OHIO811.org
Before You Dig

OHIO811, 8-1-1, or 1-800-362-2764
(Non members must be called directly)

PLAN PREPARED BY:



ENGINEER'S SEAL:

STATE OF OHIO
NICHOLAS RYAN FOSTER
E-81255
REGISTERED PROFESSIONAL ENGINEER

SIGNED: *Nicholas R Foster*
DATE: 10/14/2022

STANDARD CONSTRUCTION DRAWINGS						SUPPLEMENTAL SPECIFICATIONS	SPECIAL PROVISIONS
BP-3.1	1/21/22	MT-95.30	7/19/19	TC-41.20	10/18/13	800-2019 SEE PROPOSAL	WATERWAY
		MT-95.40	1/17/20	TC-42.10	10/18/13	821 4/20/12	PERMITS
DM-1.1	7/17/20	MT-95.50	7/21/17	TC-42.20	10/18/13	832 7/15/22	CONDITIONS
DM-4.3	1/15/16	MT-97.10	4/19/19	TC-52.20	1/15/21	921 4/20/12	DATED 10/17/22
DM-4.4	1/15/16	MT-99.30	1/17/20	TC-61.30	7/19/19		
		MT-101.70	1/17/20				
RM-4.2	4/17/20	MT-101.75	1/17/20				
		MT-101.90	7/17/20				
		MT-105.10	1/17/20				

FEDERAL PROJECT NUMBER

E200490

RAILROAD INVOLVEMENT

NONE

PROJECT DESCRIPTION

THIS PROJECT INCLUDES CONSTRUCTION OF DRILLED SHAFTS TO CORRECT AND PREVENT ROADWAY SLIPPAGE DUE TO LANDSLIDES. IT ALSO INCLUDES REPLACEMENT OF EXISTING GUARDRAIL AND OTHER MISCELLANEOUS WORK.

EARTH DISTURBED AREAS

PROJECT EARTH DISTURBED AREA:	N/A*
ESTIMATED CONTRACTOR EARTH DISTURBED AREA:	N/A*
NOTICE OF INTENT EARTH DISTURBED AREA:	N/A*
	* MAINTENANCE PROJECT

2019 SPECIFICATIONS

THE STANDARD SPECIFICATIONS OF THE STATE OF OHIO, DEPARTMENT OF TRANSPORTATION, INCLUDING SUPPLEMENTAL SPECIFICATIONS LISTED IN THE PLANS AND CHANGES LISTED IN THE PROPOSAL SHALL GOVERN THIS IMPROVEMENT.

MAINTENANCE OF TRAFFIC ENDORSEMENT

I HEREBY APPROVE THESE PLANS AND DECLARE THAT THE MAKING OF THIS IMPROVEMENT WILL NOT REQUIRE THE CLOSING TO TRAFFIC OF THE HIGHWAY AND THAT PROVISIONS FOR THE MAINTENANCE AND SAFETY OF TRAFFIC WILL BE AS SET FORTH ON THE PLANS AND ESTIMATES.

APPROVED *[Signature]*
DATE 10/04/22 DISTRICT DEPUTY DIRECTOR

APPROVED _____
DATE _____ DIRECTOR, DEPARTMENT OF TRANSPORTATION

TITLE SHEET

DESIGN AGENCY	DISTRICT 3
ENGINEERING TEAM FOUR	
DESIGNER	NRF
REVIEWER	JNC 09/22
PROJECT ID	111652
SHEET TOTAL	P.001 P.051

ASD-42-18.03
MODEL: Sheet PAPER: 17x11 (in.) DATE: 10/4/2022 TIME: 6:12:42 AM USER: nrfoster
p:\ohiodot-pw-bentley.com\ohiodot-pw-02\Documents\01_Active Projects\District 03_Ashland\111652\400-Engineering\Roadway\Sheets\111652_GT001.dgn