

**UTILITIES**

THE CONTRACTOR SHALL USE THE FOLLOWING PROCEDURE AT EACH LOCATION WHERE WORK IS PERFORMED, IN ACCORDANCE WITH SECTIONS 105.07 AND 107.16 IN THE CONSTRUCTION AND MATERIALS SPECIFICATIONS:

THE CONTRACTOR SHALL NOTIFY THE PROJECT ENGINEER, OHIO811, THE OHIO DEPARTMENT OF TRANSPORTATION DISTRICT 4 HEADQUARTERS (MICHELLE CHANEY AT 330-786-2267) AND ALL NON REGISTERED UTILITY OWNERS AT LEAST TWO (2) WORKING DAYS PRIOR TO COMMENCING CONSTRUCTION OPERATIONS IN ALL AREAS.

THE LOCATION OF THE UNDERGROUND UTILITIES SHOWN ON THE PLANS ARE AS OBTAINED FROM THE OWNERS AS REQUIRED BY SECTION 153.64 O.R.C.

LISTED BELOW ARE ALL UTILITIES LOCATED WITHIN THE PROJECT CONSTRUCTION LIMITS TOGETHER WITH THEIR RESPECTIVE OWNERS:

ADESTA, A GAS COMPANY  
ATTN: MICHAEL DANDARAW  
4 WALKER WAY, SUITE #1  
ALBANY, NY 12205  
518-869-5053 ext. 122

ASHTABULA CO. DEPT. OF ENVIRONMENTAL SERVICES  
ATTN: DOUG STARKEY  
PO BOX 520  
JEFFERSON, OHIO 44047  
440-576-3725

OHIO EDISON  
ATTN: MIKE BECK  
730 SOUTH AVENUE  
YOUNGSTOWN, OHIO 44502  
330-740-7704 ext. 7704

DOMINION EAST OHIO  
ATTN: KEVIN BIRT  
320 SPRINGSIDE DRIVE, SUITE 320  
AKRON, OHIO 44333  
330-664-2541

WINDSTREAM  
ATTN: RAMON FRENCH  
205 S. HAMB DEN STREET  
CHARDON, OH 44024  
440-285-5537

TUSSEL, JR. COMPANY  
ATTN: CLARENCE TUSSEL  
141 E. JEFFERSON ST.  
JEFFERSON STREET, OH 44047  
440-576-3415

CEI THE ILLUMINATING COMPANY  
ATTN: JOHN ZASSICK  
6896 MILLER ROAD  
BRECKSVILLE, OHIO 44141  
440-546-8706

CENTURYLINK  
ATTN: BOBBY WALTERS  
3801 ELM ROAD  
WARREN, OHIO 44483  
440-244-8415

**WORK LIMIT**

THE WORK LIMITS SHOWN ON THESE PLANS ARE FOR PHYSICAL CONSTRUCTION ONLY. PROVIDE THE INSTALLATION AND OPERATION OF ALL WORK ZONE TRAFFIC CONTROL AND WORK ZONE TRAFFIC CONTROL DEVICES REQUIRED BY THESE PLANS WHETHER INSIDE OR OUTSIDE THESE WORK LIMITS.

**CLEARING AND GRUBBING**

REMOVE ALL TREES AND STUMPS SPECIFICALLY MARKED FOR REMOVAL WITHIN THE CONSTRUCTION LIMITS UNDER THE LUMP SUM BID FOR ITEM 201, CLEARING AND GRUBBING. THE FOLLOWING IS AN APPROXIMATE ESTIMATE OF THE NUMBER OF TREES AND STUMPS TO BE REMOVED.

SIZES	NO. TREES	NO. STUMPS	TOTAL
18"	1	0	1

**ITEM 441 - ASPHALT CONCRETE SURFACE COURSE, TYPE 1, (448), AS PER PLAN, PG64-22**

703.05 DO NOT USE COARSE AGGREGATE FROM A SOURCE DESIGNATED 'SR' OR 'SRH' ACCORDING TO THE OFFICE OF MATERIALS MANAGEMENT (OMM) IN ANY JOB MIX FORMULA (JMF) FOR THIS ITEM.

**ITEM 408 - PRIME COAT, AS PER PLAN**

APPLY "MC-70" AT A RATE OF 0.4 GALLONS PER SQUARE YARD, OR AS DETERMINED BY THE ENGINEER, TO THE COMPLETED COMPACTED AGGREGATE SHOULDER.

**ITEM 617 - COMPACTED AGGREGATE, AS PER PLAN**

IN LOW SHOULDER AREAS EXCEEDING 1", AND ADJACENT TO THE SAFETY EDGE, OR AS DIRECTED BY THE ENGINEER, RECYCLED ASPHALT PAVEMENT (RAP) SHALL BE USED IN AREAS ADJACENT TO THE PAVED BERM. THE RAP SHALL HAVE A MINIMUM PG CONTENT OF 4.5% AND MEET THE FOLLOWING GRADATION. ONCE THE STOCKPILE MEETS THE GRADATION, THE PG CONTENT OF THE RAP SHALL BE DETERMINED PER 441.03. THE RAP ANALYSIS MUST BE SUBMITTED TO THE ENGINEER FOR APPROVAL 2 WEEKS PRIOR TO USE. METHOD OF MEASUREMENT SHALL BE AS PER 617.06. PLACEMENT AND COMPACTION SHALL MEET THE REQUIREMENTS OF ITEM 617. ALL MATERIALS, LABOR, EQUIPMENT, TOOLS AND INCIDENTALS NECESSARY TO COMPLETE THE WORK SHALL BE INCLUDED IN THE UNIT PRICE BID FOR ITEM 617 COMPACTED AGGREGATE, AS PER PLAN.

MODIFIED GRADATION SHALL APPLY:

SIEVE	TOTAL PERCENT PASSING
1-1/2"	100
3/4"	50-100
NO. 4	35-70
NO. 30	9-33
NO. 200	0-13

**ITEM 606 - ANCHOR ASSEMBLY, MGS TYPE E (MASH 2016)**

THIS ITEM SHALL CONSIST OF FURNISHING AND INSTALLING ANY OF THE GUARDRAIL END TERMINALS FOR TYPE MGS GUARDRAIL AS LISTED ON ROADWAY ENGINEERING'S WEB PAGE UNDER ROADSIDE SAFETY DEVICES FOR APPROVED GUARDRAIL END TREATMENTS. INSTALLATION SHALL BE AT THE LOCATIONS SPECIFIED IN THE PLANS, IN ACCORDANCE WITH THE MANUFACTURER'S SPECIFICATIONS.

THE FACE OF THE TYPE E IMPACT HEAD SHALL BE COVERED WITH A SHEET OF TYPE G REFLECTIVE SHEETING, PER CMS 730.19.

REFER TO THE MANUFACTURER'S INSTRUCTIONS REGARDING THE INSTALLATION OF, AND THE GRADING AROUND THE FOUNDATION TUBES AND GROUND STRUT. THE TOP OF ANY FOUNDATION TUBE SHOULD BE LESS THAN 4 INCHES ABOVE THE GROUND. THE PLACEMENT OF THE FOUNDATION TUBES SHOULD BE AN APPROPRIATE DEPTH BELOW THE LEVEL LINE IN ORDER TO MAINTAIN THE FINISHED GUARDRAIL HEIGHT OF 31 INCHES FROM THE EDGE OF THE SHOULDER.

ON-SITE GRADING IS REQUIRED IF THE TOP OF THE FOUNDATION TUBES OR TOP OF THE GROUND STRUT DOES PROJECT MORE THAN 4 INCHES ABOVE THE GROUND LINE.

PAYMENT FOR THE ABOVE WORK SHALL BE MADE AT THE UNIT PRICE BID FOR ITEM 606, ANCHOR ASSEMBLY, MGS TYPE E, EACH, AND SHALL INCLUDE ALL LABOR, TOOLS, EQUIPMENT AND MATERIALS NECESSARY TO CONSTRUCT A COMPLETE AND FUNCTIONAL ANCHOR ASSEMBLY SYSTEM, INCLUDING ALL RELATED TRANSITIONS, REFLECTIVE SHEETING, HARDWARE, GRADING, EMBANKMENT AND EXCAVATION NOT SEPARATELY SPECIFIED, AS REQUIRED BY THE MANUFACTURER.

I:\Project+Data\ATB\06804\_CULVERTS\_FY2021\Design\Roadway\Sheets\06804\_GN001.dgn Sheet 3/18/2021 11:25:18 AM rbaughma

CALCULATED  
RCB  
CHECKED  
MAC

GENERAL NOTES

ATB -  
CULVERTS - FY 2021

**FARM DRAINS**

ALL FARM DRAINS, WHICH ARE ENCOUNTERED DURING CONSTRUCTION, SHALL BE PROVIDED WITH UNOBSTRUCTED OUTLETS. EXISTING COLLECTORS WHICH ARE LOCATED BELOW THE ROADWAY DITCH ELEVATIONS, AND WHICH CROSS THE ROADWAY, SHALL BE REPLACED WITHIN THE (RIGHT OF WAY) (CONSTRUCTION) LIMITS BY ITEM 611 CONDUIT, TYPE B, ONE COMMERCIAL SIZE LARGER THAN THE EXISTING CONDUIT.

EXISTING COLLECTORS AND ISOLATED FARM DRAINS, WHICH ARE ENCOUNTERED ABOVE THE ELEVATION OF ROADWAY DITCHES, SHALL BE OUTLETTED INTO THE ROADWAY DITCH BY 611 TYPE F CONDUIT. THE OPTIMUM OUTLET ELEVATION SHALL BE ONE FOOT ABOVE THE FLOWLINE ELEVATION OF THE DITCH. LATERAL FIELD TILES WHICH CROSS THE ROADWAY SHALL BE INTERCEPTED BY 611, TYPE E CONDUIT, AND CARRIED IN A LONGITUDINAL DIRECTION TO AN ADEQUATE OUTLET OR ROADWAY CROSSING.

THE LOCATION, TYPE, SIZE AND GRADE OF REPLACEMENTS SHALL BE DETERMINED BY THE ENGINEER AND PAYMENT SHALL BE MADE ON FINAL MEASUREMENTS.

EROSION CONTROL PADS SHALL BE PROVIDED AT THE OUTLET END OF ALL FARM DRAINS AS PER STANDARD CONSTRUCTION DRAWING DM-1.1, EXCEPT WHEN THEY OUTLET INTO A DRAINAGE STRUCTURE. PAYMENT FOR THE EROSION CONTROL PADS AND ANY NECESSARY BENDS OR BRANCHES SHALL BE INCLUDED FOR PAYMENT IN THE PERTINENT CONDUIT ITEMS.

THE FOLLOWING ESTIMATED QUANTITIES HAVE BEEN INCLUDED IN THE GENERAL SUMMARY FOR THE WORK NOTED ABOVE:

611 6" CONDUIT, TYPE B	20 FT
611 6" CONDUIT, TYPE E	20 FT
611 6" CONDUIT, TYPE F	20 FT
601 ROCK CHANNEL PROTECTION TYPE C WITH FILTER	2 CY

**REVIEW OF DRAINAGE FACILITIES**

BEFORE ANY WORK IS STARTED ON THE PROJECT AND AGAIN BEFORE FINAL ACCEPTANCE BY THE STATE, REPRESENTATIVES OF THE STATE AND THE CONTRACTOR, ALONG WITH LOCAL REPRESENTATIVES, SHALL MAKE AN INSPECTION OF ALL EXISTING SEWERS WHICH ARE TO REMAIN IN SERVICE AND WHICH MAY BE AFFECTED BY THE WORK. THE CONDITION OF THE EXISTING CONDUITS AND THEIR APPURTENANCE SHALL BE DETERMINED FROM FIELD OBSERVATIONS. RECORDS OF THE INSPECTION SHALL BE KEPT IN WRITING BY THE STATE.

ALL NEW CONDUITS, INLETS, CATCH BASINS, AND MANHOLES CONSTRUCTED AS A PART OF THE PROJECT SHALL BE FREE OF ALL FOREIGN MATTER AND IN A CLEAN CONDITION BEFORE THE PROJECT WILL BE ACCEPTED BY THE STATE.

ALL EXISTING SEWERS INSPECTED INITIALLY BY THE ABOVE MENTIONED PARTIES SHALL BE MAINTAINED AND LEFT IN A CONDITION REASONABLY COMPARABLE TO THAT DETERMINED BY THE ORIGINAL INSPECTION. ANY CHANGE IN THE CONDITION RESULTING FROM THE CONTRACTOR S OPERATIONS SHALL BE CORRECTED BY THE CONTRACTOR TO THE SATISFACTION OF THE ENGINEER.

PAYMENT FOR ALL OPERATIONS DESCRIBED ABOVE SHALL BE INCLUDED IN THE CONTRACT PRICE FOR THE PERTINENT 611 CONDUIT ITEMS.

**DRAINAGE DISCHARGE CONTINUANCE**

FURNISH A DRAINAGE DISCHARGE CONTINUANCE FOR ANY DRAINAGE DISCHARGE DISTURBED BY THE WORK AND NOT SHOWN IN THE PLANS. THE LOCATION, TYPE (CONDUIT ORSWALE), SIZE AND GRADE OF THE DRAINAGE DISCHARGE CONTINUANCE WILL BE AGREED TO BY THE ENGINEER

FURNISH AN INSPECTION WELL AT THE RIGHT OF WAY LINE IN ACCORDANCE WITH SCD DM-3.1 FOR EACH DRAINAGE DISCHARGE THAT OUTLETS THROUGH A CURB OPENING, OR INTO A STORM SEWER OR DRAINAGE STRUCTURE. THE COST IS INCLUDED IN ITEM 611, INSPECTION WELL.

FURNISH A WELL GRADED TRANSITION BETWEEN THE DITCH AND THE SWALEWHEN OUTLETTING A SWALE TO A DITCH. THE COST FOR THE GRADED TRANSITION IS INCLUDED IN ITEM 203, EMBANKMENT AS PER PLAN.

FURNISH AN EROSION CONTROL PAD AS SHOWN IN SCD DM-1.1 WHEN OUTLETTING A CONDUIT TO A DITCH. THE COST FOR THE EROSION CONTROL PAD IS INCLUDED IN ITEM 611, CONDUIT, MISC: TYPE \_ FOR DRAINAGE DISCHARGE CONTINUANCE.

FURNISH A DRILLED HOLE OR A CURB SECTION WITH A HOLE WHEN OUTLETTING A CONDUIT THROUGH A CURB OPENING. THE COST OF DRILLING, OR FURNISHING THE CURB SECTION WITH HOLE IS INCLUDED IN ITEM 611, CONDUIT, MISC.: TYPE \_ FOR DRAINAGE DISCHARGE CONTINUANCE.

FURNISH A DRILLED CORE HOLE WHEN OUTLETTING INTO A STORM SEWER OR DRAINAGE STRUCTURE. THE COST OF THE DRILLED CORE HOLE IS INCLUDED IN ITEM 611, CONDUIT, MISC.: TYPE \_ FOR DRAINAGE DISCHARGE CONTINUANCE.

**DOCUMENTATION**

THE CONTRACTOR SHALL FURNISH WRITTEN DOCUMENTATION TO THE ENGINEER AND TO THE DISTRICT R/W PERMIT OFFICE. THE DOCUMENTATION INCLUDES THE CONSTRUCTION PROJECT NUMBER, PID, COUNTY, ROUTE, SECTION, LATITUDE AND LONGITUDE OF THE DRAINAGE DISCHARGE AT THE R/W, THE NAME OF PROPERTY OWNER WITH ADDRESS, THE DATE THE DRAINAGE DISCHARGE WAS LOCATED, THE DATE THE DRAINAGE DISCHARGE CONTINUANCE WAS FURNISHED, A DETAILED DESCRIPTION OF THE WORK AND PICTURES OF THE DRAINAGE DISCHARGE CONTINUANCE (IN PDF OR JPEG FORMAT). THE DOCUMENTATION IS INCLUDED IN ITEM 611, CONDUIT, MISC.: TYPE \_ FOR DRAINAGE DISCHARGE CONTINUANCE OR ITEM 203, EMBANKMENT AS PER PLAN.

DRAINAGE DISCHARGE CONTINUANCE REMOVAL THE ENGINEER MAY REQUIRE THE NEWLY INSTALLED DRAINAGE DISCHARGE CONTINUANCE TO BE REMOVED.

REMOVE THE NEWLY INSTALLED CONDUIT AND ANY EXISTING CONDUIT TO THE RIGHT OF WAY LINE. FOR CONDUIT THAT OUTLETS THROUGH THE CURB RESTORE THE CURB BY FILLING THE HOLE WITH CLASS QC 1 CONCRETE OR REPLACE THE CURB SECTION. FOR CONDUIT THAT OUTLETS TO A STORM SEWER OR DRAINAGE STRUCTURE LEAVE 6 INCHES PROTRUDING OUTSIDE OF THE CONDUIT. PLUG THE PROTRUDING CONDUIT WITH EITHER A MANUFACTURED CAP OR CLASS QC 1 CONCRETE. FOR CONDUIT THAT OUTLETS TO THE DITCH REMOVE THE EROSION CONTROL PAD. RESTORE ALL AREAS AS REQUIRED. PLUG THE EXISTING CONDUIT REGARDLESS OF SIZE AT THE RIGHT OF WAY LINE WITH CLASS QC 1 CONCRETE AND RESTORE ALL AREAS AS REQUIRED. ALL COSTS ARE INCLUDED IN ITEM 202, REMOVAL MISC. CONDUIT.

DAM THE SWALE THAT OUTLETS TO THE DITCH AT THE R/W AS DIRECTED BY THE ENGINEER. ALL COSTS ARE INCLUDED IN ITEM 203, EMBANKMENT AS PER PLAN.

REMOVE THE INSPECTION WELL AND RESTORE ALL AREAS AS REQUIRED. THE COST IS INCLUDED IN ITEM 202, REMOVAL MISC. INSPECTION WELL.

CONDUIT MATERIAL TYPES  
THE FOLLOWING CONDUIT MATERIAL TYPES MAY BE USED:  
707.33, 707.41 NON-PERFORATED, 707.42, 707.43, 707.45, 707.46, 707.47, 707.51, AND 707.52 SDR35.

PAY ITEMS  
EACH OF THE PAY ITEMS LISTED BELOW FOR CONDUIT MISCELLANEOUS TYPES B, C, E AND F FOR DRAINAGE DISCHARGE CONTINUANCE INCLUDE CONDUIT SIZES 2 INCH TO 10 INCH. THERE IS NO COST DIFFERENTIATION FOR SIZE IN THESE PAY ITEMS.

THE FOLLOWING ESTIMATED QUANTITIES HAVE BEEN INCLUDED IN THE GENERAL SUMMARY FOR USE AS DIRECTED BY THE ENGINEER IN MAKING THE ABOVE DRAINAGE DISCHARGE CONTINUANCE:

ITEM 611, 1 EACH, INSPECTION WELL  
ITEM 611, 5 FT, CONDUIT, MISC.: TYPE B FOR DRAINAGE DISCHARGE CONTINUANCE  
ITEM 611, 5 FT, CONDUIT, MISC.: TYPE C FOR DRAINAGE DISCHARGE CONTINUANCE  
ITEM 611, 5 FT, CONDUIT, MISC.: TYPE E FOR DRAINAGE DISCHARGE CONTINUANCE  
ITEM 611, 5 FT, CONDUIT, MISC.: TYPE F FOR DRAINAGE DISCHARGE CONTINUANCE  
ITEM 202, 5 FT, REMOVAL MISC.: CONDUIT  
ITEM 202, 1 EACH, REMOVAL MISC.: INSPECTION WELL  
ITEM 203, 50 CY, EMBANKMENT, AS PER PLAN

**CROSS SECTION EARTHWORK SUMMARY**

SHEET NO.	203	203
	EXCAVATION	EMBANKMENT
	CY	CY
15	74	219
21	59	192
29	21	122
37		23
38	29	16
42	37	140
43	4	94
51	26	149
52	35	59
TOTAL	285	1014

I:\Project\06804\ATB\06804\_CULVERTS\FY2021\Design\Roadway\Sheets\06804\_GN001.dgn Sheet2 3/18/2021 11:25:19 AM rbaughma

CALCULATED  
RCB  
CHECKED  
MAC

GENERAL NOTES

ATB-  
CULVERTS-FY2021




I:\Project\06804\_CULVERTS\FY2021\Design\Roadway\Sheets\06804\_G000.dgn Sheet2 3/18/2021 11:25:58 AM rbaughma

SHEET NUM.												PART.	ITEM	ITEM	GRAND	UNIT	DESCRIPTION	SEE SHEET NO.
5	18	23	24	31	32	40	45	46	54	55	01/STR/C V	EXT	TOTAL					
<b>PAVEMENT</b>																		
	477	522		448		540	452		433		2,872	254	01000	2,872	SY	PAVEMENT PLANING, ASPHALT CONCRETE, T=3"		
	57	58		55		60	49		49		328	255	20000	328	FT	FULL DEPTH PAVEMENT SAWING		
	58	73		47		58	70		53		359	301	46000	359	CY	ASPHALT CONCRETE BASE, PG64-22		
	26	33		22		35	32		33		181	304	20000	181	CY	AGGREGATE BASE		
	80	91		75		90	83		75		494	407	20000	494	GAL	NON-TRACKING TACK COAT		
	27	29		26		29	30		29		170	408	10001	170	GAL	PRIME COAT, AS PER PLAN		
200											200	411	10000	200	CY	STABILIZED CRUSHED AGGREGATE		
	40	44		38		45	38		37		242	441	50101	242	CY	ASPHALT CONCRETE SURFACE COURSE, TYPE 1, (448), AS PER PLAN, PG64-22		
	4	4		4		4	5		4		25	617	10101	25	CY	COMPACTED AGGREGATE, AS PER PLAN		
<b>TRAFFIC CONTROL</b>																		
	3	4		3		4	4		3		21	621	00100	21	EACH	RPM		
	9		9		8	10		9	10		55	626	00110	55	EACH	BARRIER REFLECTOR, TYPE 2 (BIDIRECTIONAL)		
	2	2		2		2	2		2		12	630	02100	12	FT	GROUND MOUNTED SUPPORT, NO. 2 POST		
	15	15		15		15	15		15		90	630	80100	90	SF	SIGN, FLAT SHEET, 730.20		
	0.1	0.07		0.06		0.07	0.07		0.07		0.44	642	00104	0.44	MILE	EDGE LINE, 6", TYPE 1		
	0.05	0.04		0.03		0.04	0.04		0.04		0.24	642	00300	0.24	MILE	CENTER LINE, TYPE 1		
<b>RETAINING WALLS</b>																		
						LS					LS	503	11100	LS		COFFERDAMS AND EXCAVATION BRACING (ATB-45-1769)		
								LS			LS	503	11100	LS		COFFERDAMS AND EXCAVATION BRACING (ATB-46-1106)		
										LS	LS	503	11100	LS		COFFERDAMS AND EXCAVATION BRACING (ATB-46-1192)		
	LS		LS								LS	503	11100	LS		COFFERDAMS AND EXCAVATION BRACING (ATB-6-1723)		
											LS	503	11100	LS		COFFERDAMS AND EXCAVATION BRACING (ATB-6-2804)		
						LS					LS	503	11100	LS		COFFERDAMS AND EXCAVATION BRACING (ATB-7-0090)		
								LS			LS	503	21300	LS		UNCLASSIFIED EXCAVATION (WINGWALL FOOTING) (ATB-46-1106)		
										LS	LS	503	21300	LS		UNCLASSIFIED EXCAVATION (WINGWALL FOOTING) (ATB-46-1192)		
			LS								LS	503	21300	LS		UNCLASSIFIED EXCAVATION (WINGWALL FOOTING) (ATB-6-2804)		
					LS						LS	503	21300	LS		UNCLASSIFIED EXCAVATION (WINGWALL FOOTING) (ATB-7-0090)		
				2,772		2,946			4,612		3,768	14,098	509	10000	14,098	LB	EPOXY COATED REINFORCING STEEL	
				7		9			18		14	48	511	46010	48	CY	CLASS QC1 CONCRETE, RETAINING/WINGWALL NOT INCLUDING FOOTING	
				21		27			39		33	120	511	46510	120	CY	CLASS QC1 CONCRETE, FOOTING	
				2		1			2		2	7	511	46610	7	CY	CLASS QC1 CONCRETE, HEADWALL	
									LS		LS	518	21230	LS		POROUS BACKFILL WITH GEOTEXTILE FABRIC (ATB-46-1106)		
											LS	518	21230	LS		POROUS BACKFILL WITH GEOTEXTILE FABRIC (ATB-46-1192)		
			LS								LS	518	21230	LS		POROUS BACKFILL WITH GEOTEXTILE FABRIC (ATB-6-2804)		
					LS						LS	518	21230	LS		POROUS BACKFILL WITH GEOTEXTILE FABRIC (ATB-7-0090)		
<b>STRUCTURE REPAIR</b>																		
	38			37		39			58		49	221	512	10100	221	SY	SEALING OF CONCRETE SURFACES (EPOXY-URETHANE)	
	76			62		46			90		87	361	512	33000	361	SY	TYPE 2 WATERPROOFING	
	68			66		48			52		56	290	512	33010	290	SY	TYPE 3 WATERPROOFING	
				26		24			34		30	114	516	13600	114	SF	1" PREFORMED EXPANSION JOINT FILLER	
<b>MAINTENANCE OF TRAFFIC</b>																		
	LS										LS	614	12420	LS		DETOUR SIGNING (ATB-45-1769)		
	LS										LS	614	12420	LS		DETOUR SIGNING (ATB-46-1106)		
	LS										LS	614	12420	LS		DETOUR SIGNING (ATB-46-1192)		
	LS										LS	614	12420	LS		DETOUR SIGNING (ATB-6-1723)		
	LS										LS	614	12420	LS		DETOUR SIGNING (ATB-6-2804)		
	LS										LS	614	12420	LS		DETOUR SIGNING (ATB-7-0090)		
	50										50	614	13000	50	CY	ASPHALT CONCRETE FOR MAINTAINING TRAFFIC		
	12										12	614	18601	12	SNMT	PORTABLE CHANGEABLE MESSAGE SIGN, AS PER PLAN		
<b>INCIDENTALS</b>																		
											LS	614	11000	LS		MAINTAINING TRAFFIC		
											9	619	16010	9	MNTH	FIELD OFFICE, TYPE B		
											LS	623	10000	LS		CONSTRUCTION LAYOUT STAKES AND SURVEYING		
											LS	624	10000	LS		MOBILIZATION		

GENERAL SUMMARY

ATB - CULVERTS - FY2021

SEEDING  
END SO.  
WIDTH YDS.

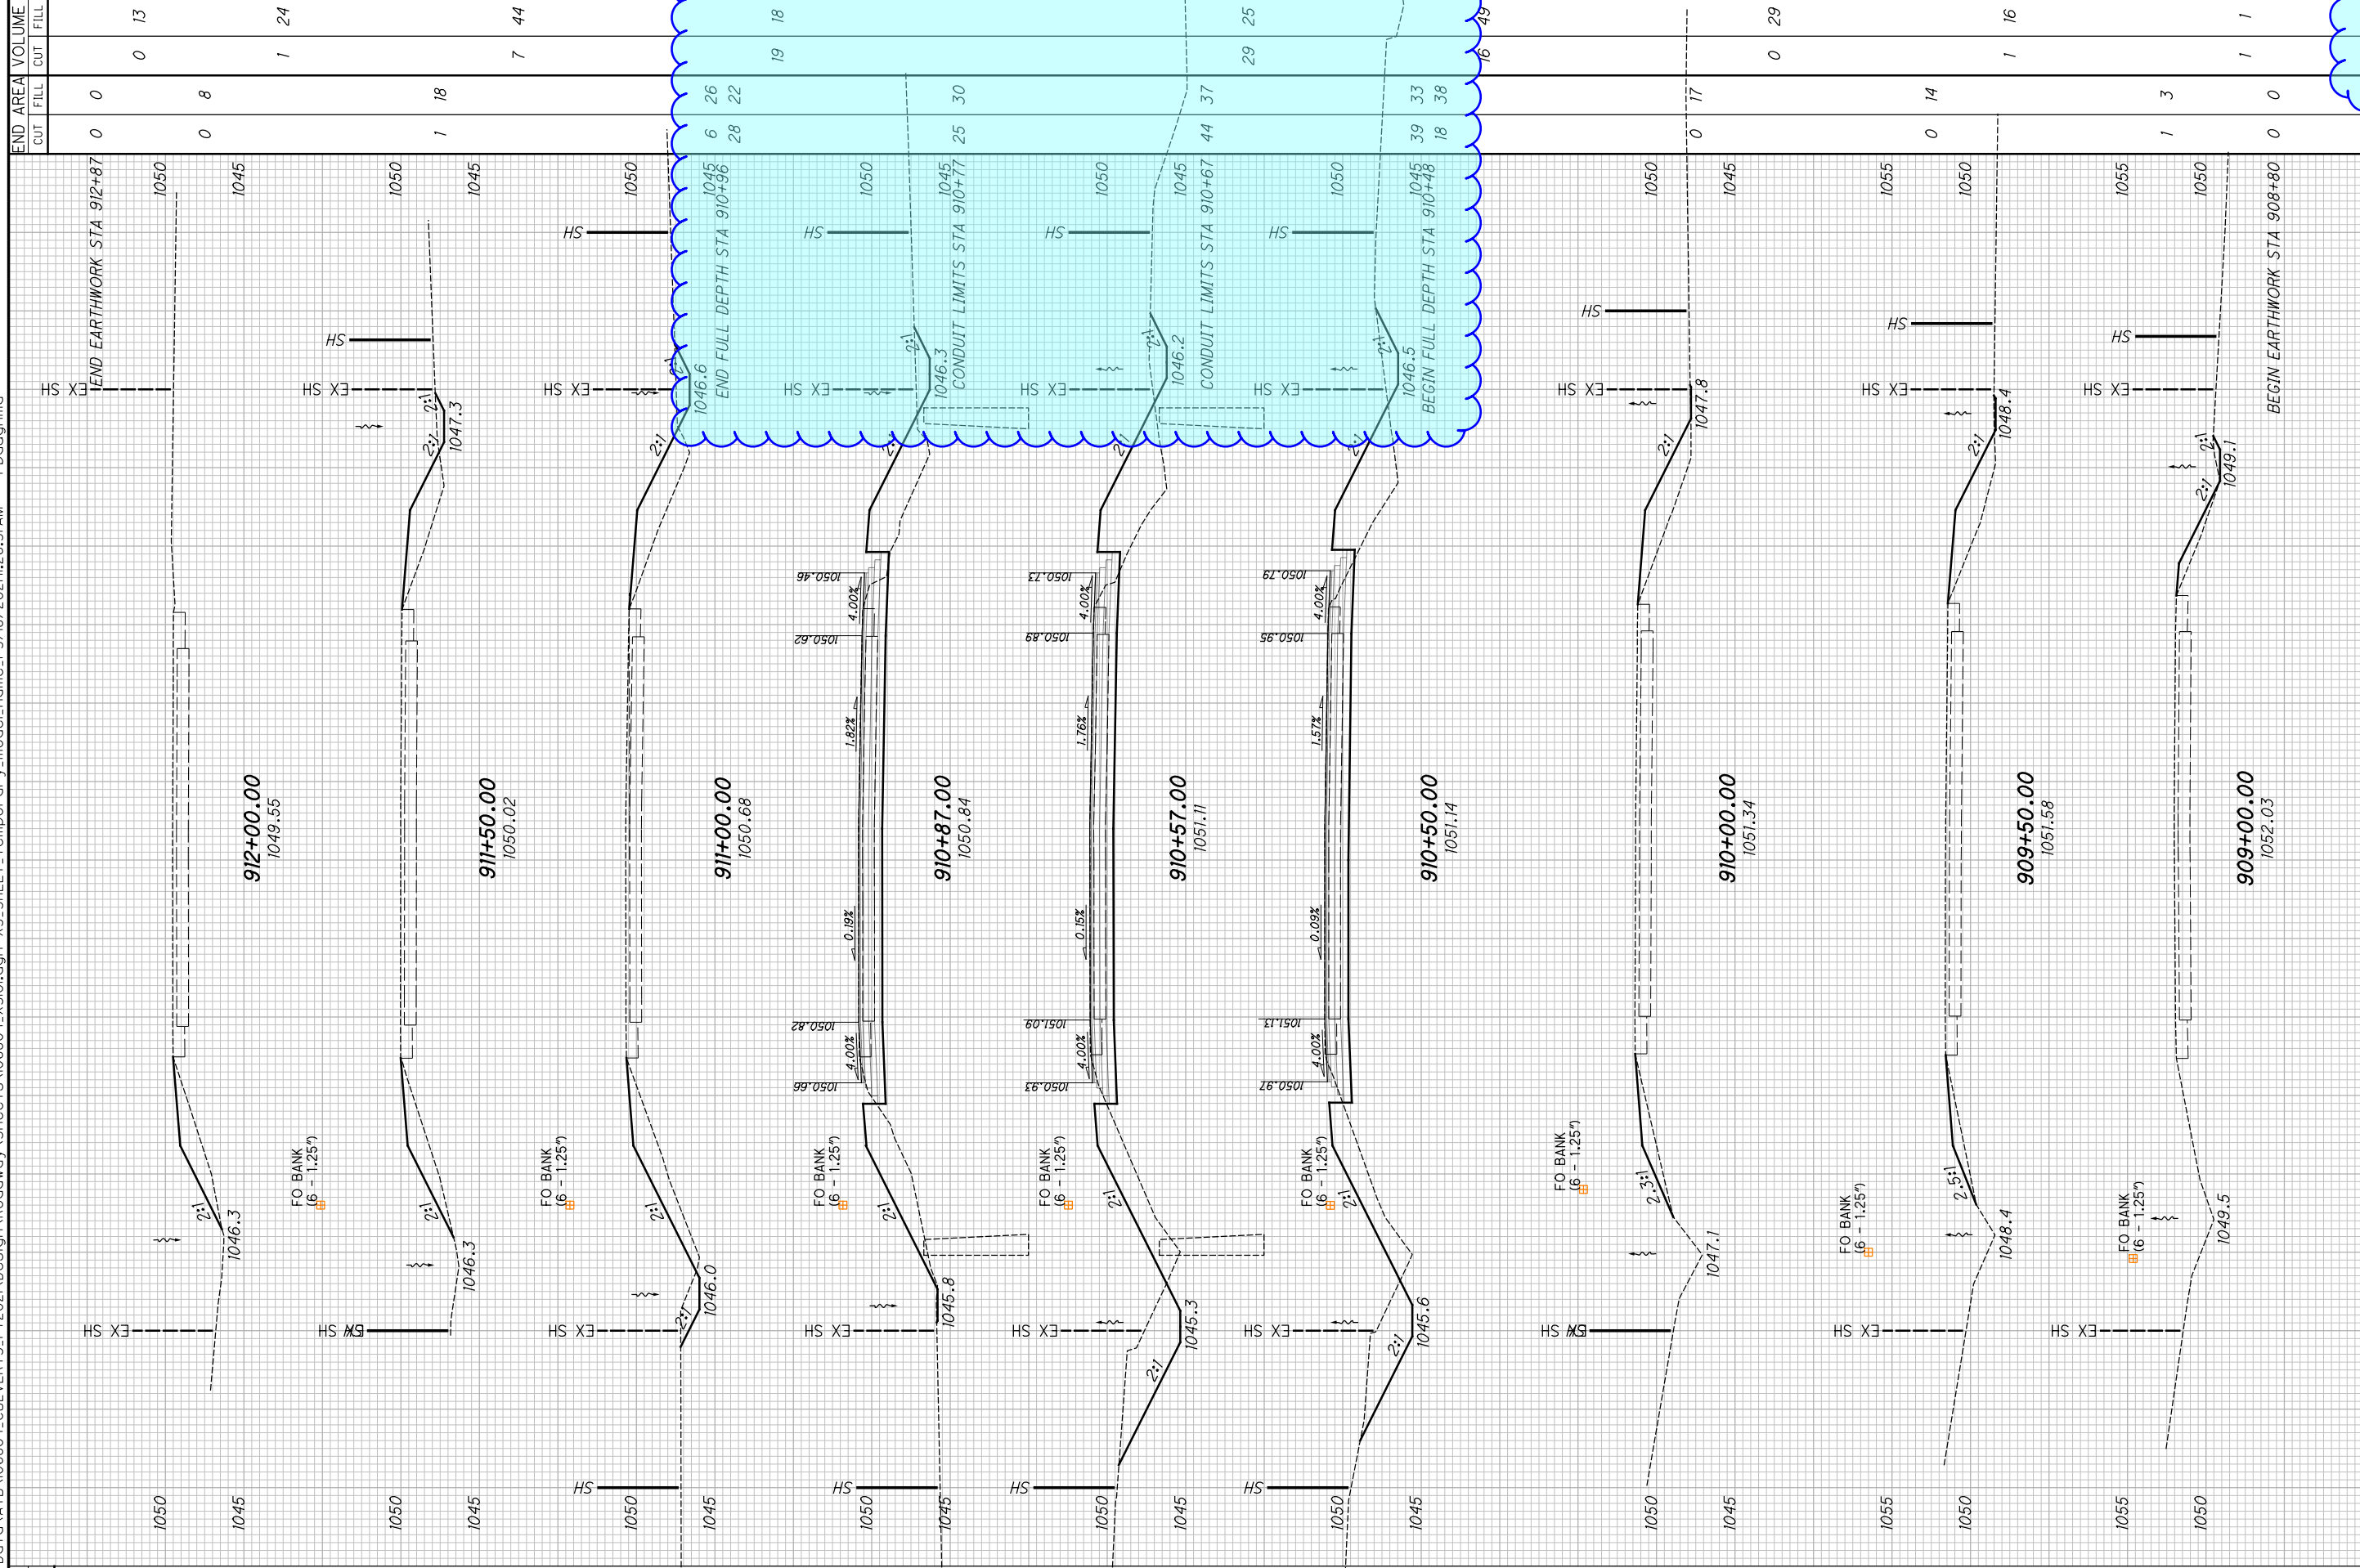

END STA	END AREA		VOLUME
	CUT	FILL	
912+87	0	0	0
911+50	0	8	13
911+00	1	18	24
911+50	7	44	44
910+96	6	26	18
910+77	28	22	25
910+67	44	37	29
910+38	39	33	18
910+38	18	38	16
910+00	0	17	0
909+50	0	14	0
909+00	1	3	1
908+80	0	0	0

CARRIED TO GENERAL NOTES SHEET 4

30 20 10 0 10 20 30 40

**ATB-  
CULVERTS-FY2021**

**CROSS SECTIONS - U.S. 6 (17.23)  
STA. 909+00.00 TO STA. 912+00.00**

15 64	74	219	CALCULATED
	74	219	CHECKED

MAC

**SEEDING AND MULCHING**

THE FOLLOWING QUANTITIES ARE PROVIDED TO PROMOTE GROWTH AND CARE OF PERMANENT SEEDED AREAS:

659, TOPSOIL	153 CU. YD.
659, SEEDING AND MULCHING	1381 SQ. YD.
659, REPAIR SEEDING AND MULCHING	69 SQ. YD.
659, COMMERCIAL FERTILIZER	0.19 TON
659, LIME	0.29 ACRES
659, WATER	7 M. GAL.

SEEDING AND MULCHING SHALL BE APPLIED TO ALL AREAS OF EXPOSED SOIL BETWEEN THE RIGHT-OF-WAY LINES, AND WITHIN THE CONSTRUCTION LIMITS FOR AREAS OUTSIDE THE RIGHT-OF-WAY LINES COVERED BY WORK AGREEMENT OR SLOPE EASEMENT. QUANTITY CALCULATIONS FOR SEEDING AND MULCHING ARE BASED ON THESE LIMITS.

**UNSUITABLE SOILS**

THE FOLLOWING ITEMS AND QUANTITIES ARE TO BE USED AS DIRECTED BY THE ENGINEER TO ADDRESS UNSUITABLE SOILS ENCOUNTERED IN THE AREA UNDER THE PROPOSED CULVERT.

203, EXCAVATION	34 CU YD
203, GRANULAR MATERIAL, TYPE C (703.16)	34 CU YD
204, GEOTEXTILE FABRIC, TYPE D	68 SQ YD

**STRUCTURE/CULVERT IDENTIFICATION SIGNS**

STRUCTURE IDENTIFICATION SIGNS (I-H25b) WILL BE PLACED ON EACH APPROACH OFF THE RIGHT SHOULDER, FACING TRAFFIC, AND BEHIND THE GUARDRAIL IF APPLICABLE. A QUANTITY OF ONE SIGN PER APPROACH WILL BE INSTALLED. THE SIGNS WILL HAVE A NON-REFLECTIVE WHITE SHEETING BACKGROUND.

THE SIGNS WILL BE MOUNTED ON NEW NO. 2 POSTS AND WILL BE INSTALLED AS PER STANDARD CONSTRUCTION DRAWING TC-41.20, MOST CURRENT REVISION. EACH POST WILL BE 7.5' IN LENGTH.

INSTALL SIGNS FOR THE FOLLOWING STRUCTURE:  
ATB-6-1723

THE FOLLOWING QUANTITIES HAVE BEEN INCLUDED FOR EACH APPROACH:

- 630, SIGN, FLAT SHEET, 730.20, 1 SQ FT
- 630, GROUND MOUNTED SUPPORT, NO. 2 POST, 7.5 FT

**PAVEMENT RESTORATION FOR PIPE INSTALLATIONS AND/OR REMOVALS**

THE FOLLOWING QUANTITY HAS BEEN PROVIDED FOR PAVEMENT RESTORATION FOLLOWING INSTALLATION AND/OR REMOVAL OF PIPES.

STA. 910+48 TO STA. 910+67 & STA. 910+77 TO STA. 910+96	
202, PAVEMENT REMOVED	122 SY
204, SUBGRADE COMPACTION	150 SY
255, FULL DEPTH PAVEMENT SAWING	57 FT
301, ASPHALT CONCRETE BASE, PG64-22 (T=12")	50 CY
304, AGGREGATE BASE (T=6")	26 CY
407, NON-TRACKING TACK COAT @ 0.06 GAL/SY	18 GAL

STA. 910+67 TO STA. 910+77 (ATB-6-1723)	
202, PAVEMENT REMOVED	32 SY
301, ASPHALT CONCRETE BASE, PG64-22 (AVG=6.1")	8 CY
407, NON-TRACKING TACK COAT @ 0.06 GAL/SY	4 GAL

THE ABOVE QUANTITIES ARE BASED ON THE PAVEMENT WIDTHS GIVEN IN THE PLANS.

PROVIDE ANY MATERIALS USED OUTSIDE THE LIMITS STATED ABOVE AT NO ADDITIONAL COST.

**RESURFACING AFTER PIPE INSTALLATION**

THE FOLLOWING QUANTITIES HAVE BEEN PROVIDED TO RESURFACE THE ROADWAY AFTER THE COMPLETION OF THE CULVERT OR STRUCTURE PLACEMENT. THIS WORK DOES NOT HAVE TO BE COMPLETE DURING THE DETOUR PERIOD.

STA. 909+98 TO STA. 911+46 (ATB-6-1723)	
254, PAVEMENT PLANING, ASPHALT CONCRETE (T=3")	477 SY
407, NON-TRACKING TACK COAT @ 0.06 GAL/SY	58 GAL
408, PRIME COAT, AS PER PLAN @ 0.40 GAL/SY	27 GAL
441, ASPHALT CONCRETE SURFACE COURSE, TYPE 1, (448), AS PER PLAN, PG64-22 (2 - 1 1/2" LIFTS)	40 CY
617, COMPACTED AGGREGATE, AS PER PLAN (T=2")	4 CY

THE ABOVE QUANTITIES ARE BASED ON A RESURFACING THE WIDTH OF THE PAVEMENT AND SHOULDERS AND A LENGTH OF 50' ON EACH SIDE OF THE REQUIRED TRENCH WIDTH FOR INSTALLATION AND/OR REMOVAL.


**PAVEMENT MARKINGS**

ALL PAVEMENT MARKINGS THAT ARE REMOVED DURING THE CULVERT REPLACEMENT WILL BE REPLACED WITH ITEM 642 - TRAFFIC PAINT. THE FOLLOWING ESTIMATED QUANTITIES HAVE BEEN CARRIED TO THE GENERAL SUMMARY:

621, RPM	3 EA
642, EDGE LINE, 6", TYPE 1	0.1 MI
642, CENTER LINE, TYPE 1	0.05 MI

**ITEM 202, PIPE REMOVED, OVER 24", AS PER PLAN**

THIS ITEM OF WORK SHALL INCLUDE THE REMOVAL OF AN ESTIMATED 10-20 CUBIC YARDS OF EXISTING CONCRETE FROM BETWEEN THE EXISTING 42"x60" CORRUGATED METAL PIPES WHICH ARE TO BE REMOVED AT THIS LOCATION.

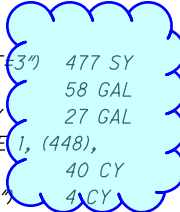


I:\ProjectData\ATB\106804\_CULVERTS\FY2021\Design\Roadway\Sheets\106804\_DN101.dgn\_Sheet 2 3/18/2021 11:26:34 AM rbaughma

REF NO.	SHEET NO.	STATION TO STATION				202	202	503	512	512	512	601	601	602	611	606	606	606	606	626	
						PIPE REMOVED, OVER 24", AS PER PLAN	GUARDRAIL REMOVED	COFFERDAMS AND EXCAVATION BRACING (ATB-6-1723)	SEALING OF CONCRETE SURFACES (EPOXY-URETHANE)	TYPE 2 WATERPROOFING	TYPE 3 WATERPROOFING	RIPRAP	ROCK CHANNEL PROTECTION, TYPE B WITH GEOTEXTILE FABRIC	CONCRETE MASONRY	8' X 5' CONDUIT, TYPE A, 706.05	GUARDRAIL, TYPE MGS WITH LONG POSTS	ANCHOR ASSEMBLY, MGS TYPE E (MASH 2016)	ANCHOR ASSEMBLY, MGS TYPE T	GUARDRAIL, TYPE MGS, LONG-SPAN	BARRIER REFLECTOR, TYPE 2 (BIDIRECTIONAL)	
						FT	FT	LS	SY	SY	SY	SY	CY	CY	FT	FT	EACH	EACH	FT	EACH	
R1	14	909+66.86	LT	TO	911+97.11	LT															
R2	14	909+41.95	RT		911+71.12	RT															
R3	14	910+72.00	LT/RT				80														
D1	14	910+72.00	LT/RT					LS	38	76	68	12	19	8.9	54						
GR1	14	909+22.00	LT		912+84.50	LT									212.5	2		50	5		
GR2	14	908+87.54	RT		911+84.50	RT									187.5	1	1	50	4		
TOTALS CARRIED TO GENERAL SUMMARY							80	461	LS	38	76	68	12	19	8.9	54	400	3	1	100	9

DESIGN AGENCY ODOT DISTRICT 4	DATE MM/DD/YY XXX	REVIEWED STRUCTURE FILE NUMBER XXX	DRAWN RCB REVISOR XXX	DESIGNED RCB CHECKED XXX
ASHTABULA COUNTY STA. 910+44 STA. 911+00				
<b>CULVERT NOTES AND QUANTITIES</b>				
ATB-6-1723 US 6 OVER TRIB. OF PYMATUNING CREEK				
<b>ATB- CULVERTS-FY2021 PID No. 106804</b>				
3 / 4				18 64

I:\ProjectData\ATB\06804\_CULVERTS\FY2021\Design\Roadway\Sheets\06804\_XS20.dgn XS\_SHEET\_Temporary\_model\_name\_1\_3/18/2021 11:26:54 AM rbaughma

SEEDING	
END WIDTH	SO. YDS.
60	
50	
40	
30	
20	
10	
0	
10	
20	
30	
40	
50	

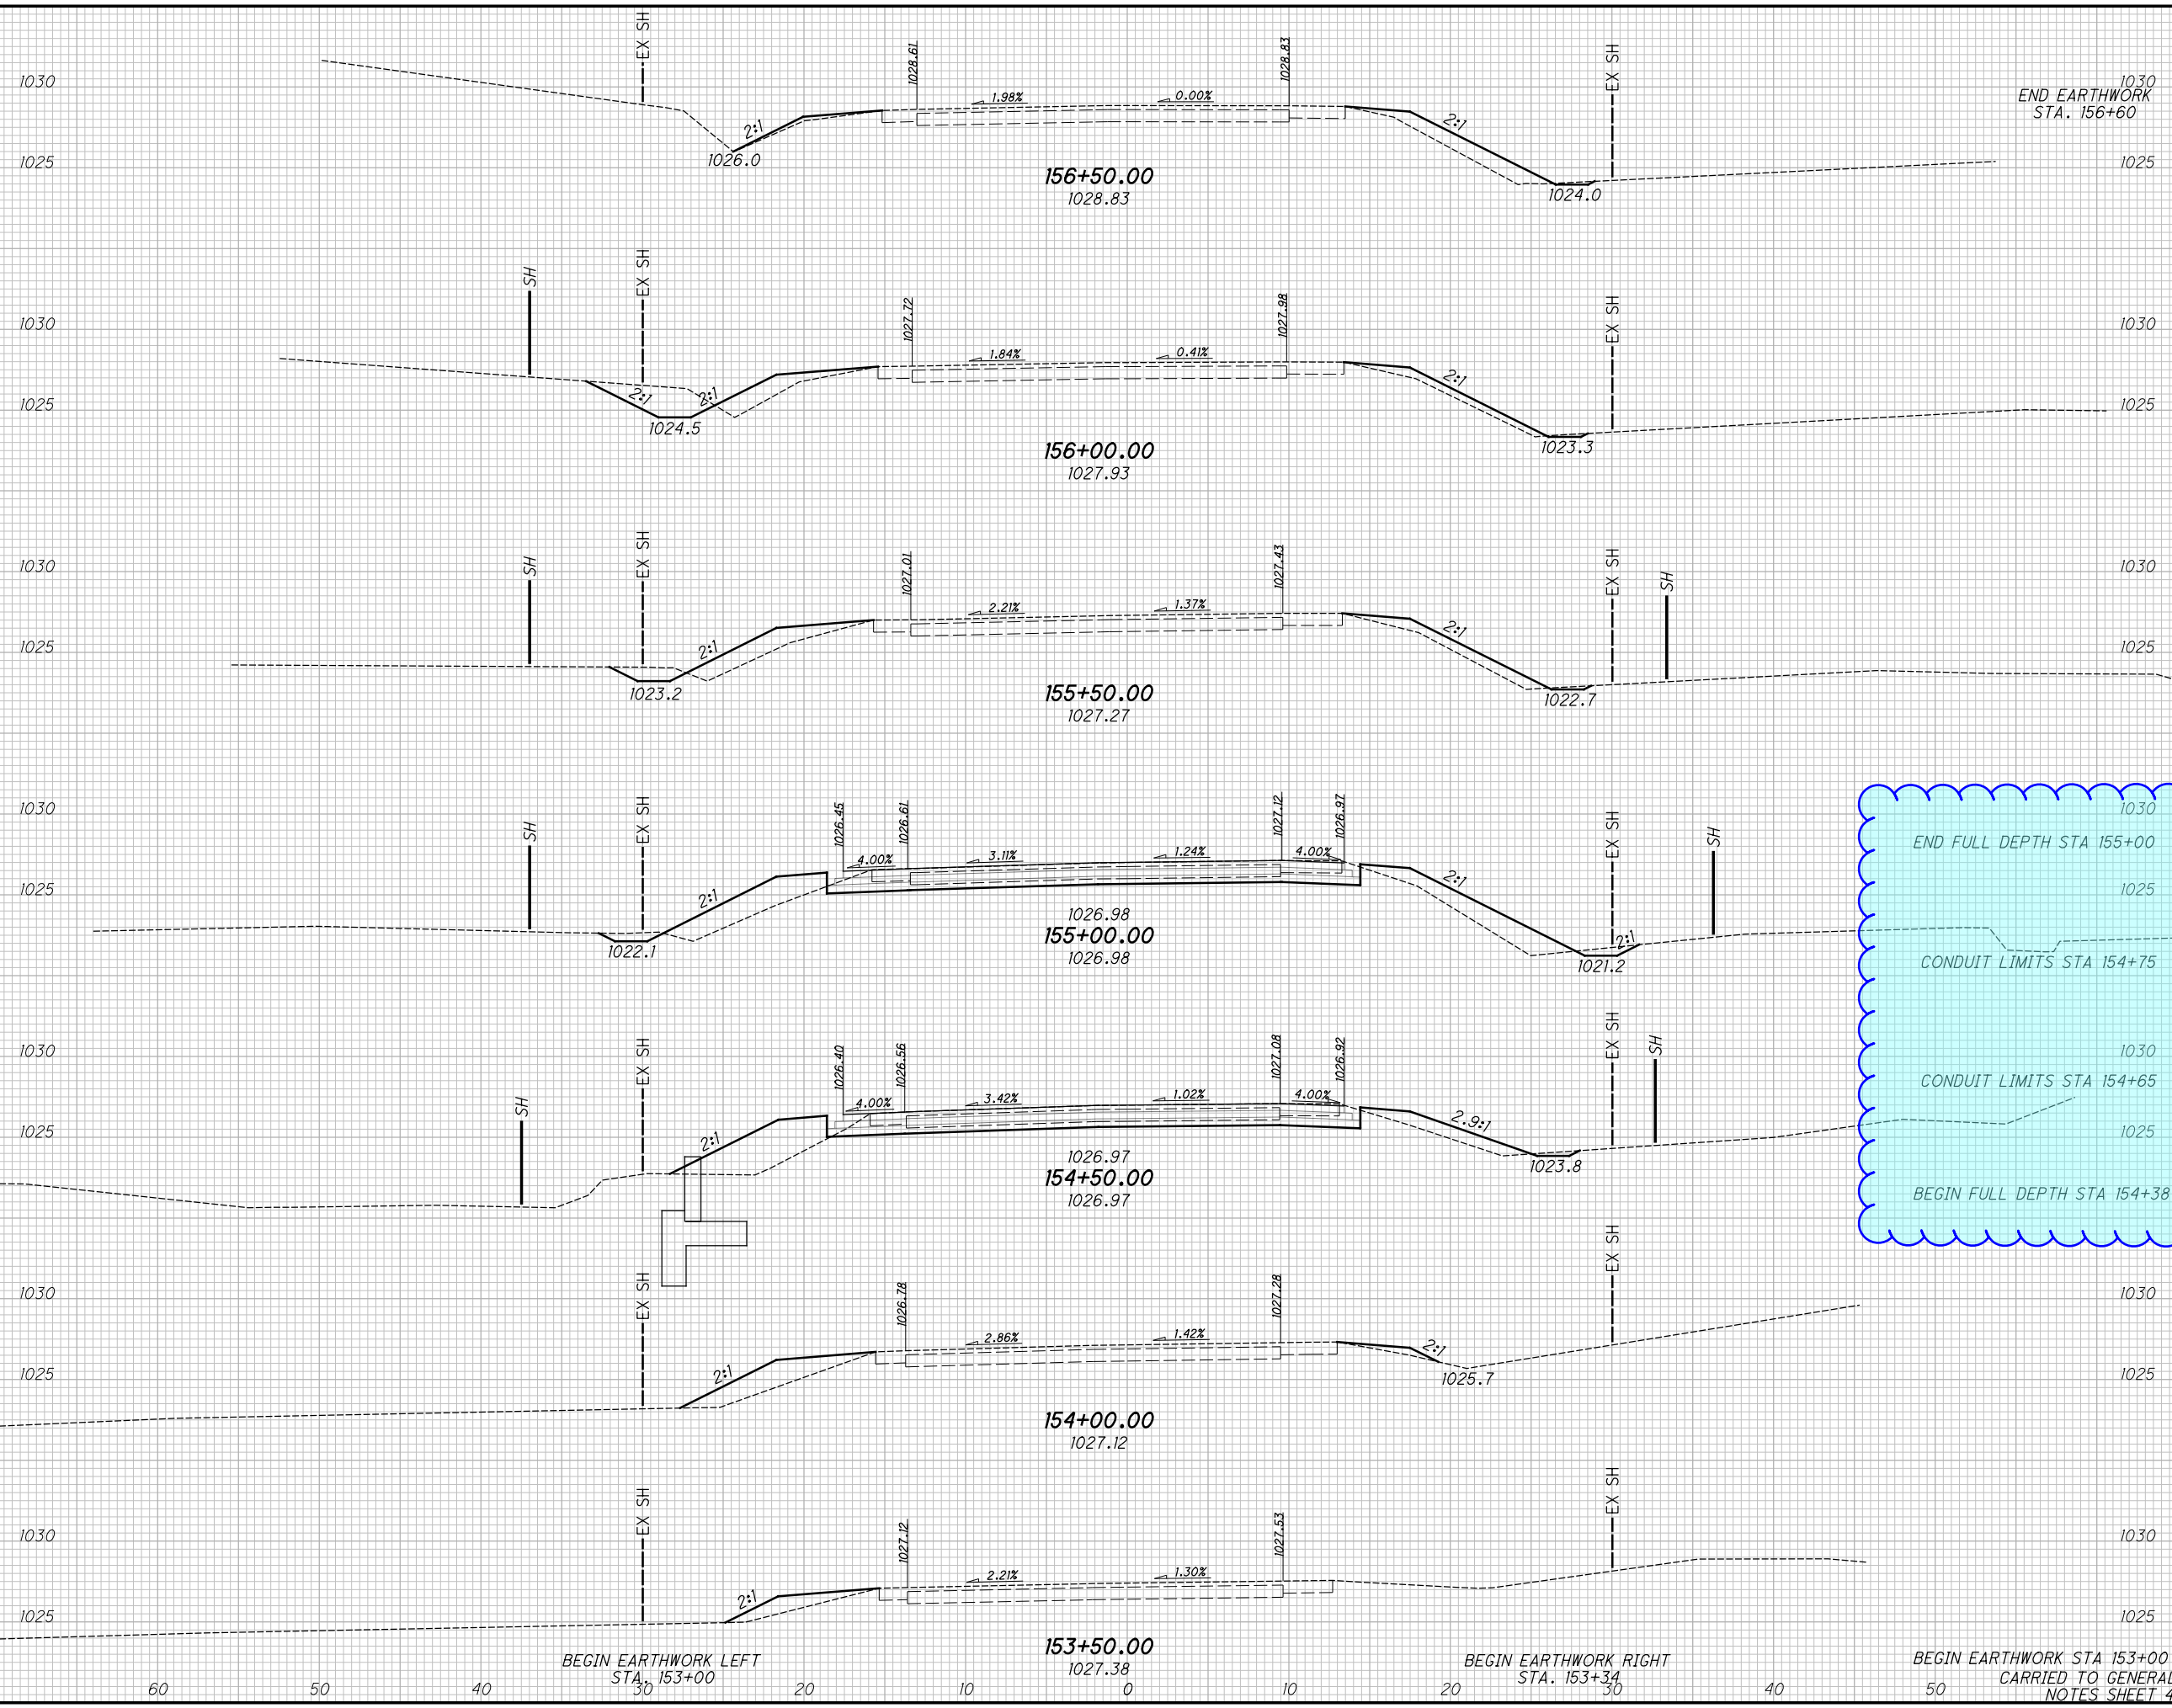

END STA.	AREA		VOLUME	
	CUT	FILL	CUT	FILL
156+60	0	0	0	2
156+50.00	1	11	9	21
156+00.00	9	12	11	27
155+50.00	3	17	6	42
155+00.00	3	28	18	27
CONDUIT LIMITS STA 154+75	18	27		17
CONDUIT LIMITS STA 154+65	15	24		15
BEGIN FULL DEPTH STA 154+38	15	24	1	26
154+50.00	0	13	0	18
154+00.00	0	6	0	6
153+50.00	0	0	0	6
TOTAL	59	132		

END FULL DEPTH STA 155+00  
 CONDUIT LIMITS STA 154+75  
 CONDUIT LIMITS STA 154+65  
 BEGIN FULL DEPTH STA 154+38

CROSS SECTIONS - U.S. 6 (28.04)  
 STA. 153+27.00 TO STA. 156+60.00


ATB-  
 CULVERTS-FY2021

21
64

BEGIN EARTHWORK STA 153+00  
 CARRIED TO GENERAL NOTES SHEET 4

I:\ProjectData\ATB\06804\_CULVERTS\FY2021\Design\Roadway\Sheets\06804\_XS30.dgn XS\_SHEET\_Temporary\_model\_name\_1 3/18/2021 11:27:22 AM rbaughma

SEEDING  
END SO.  
WIDTH YDS.

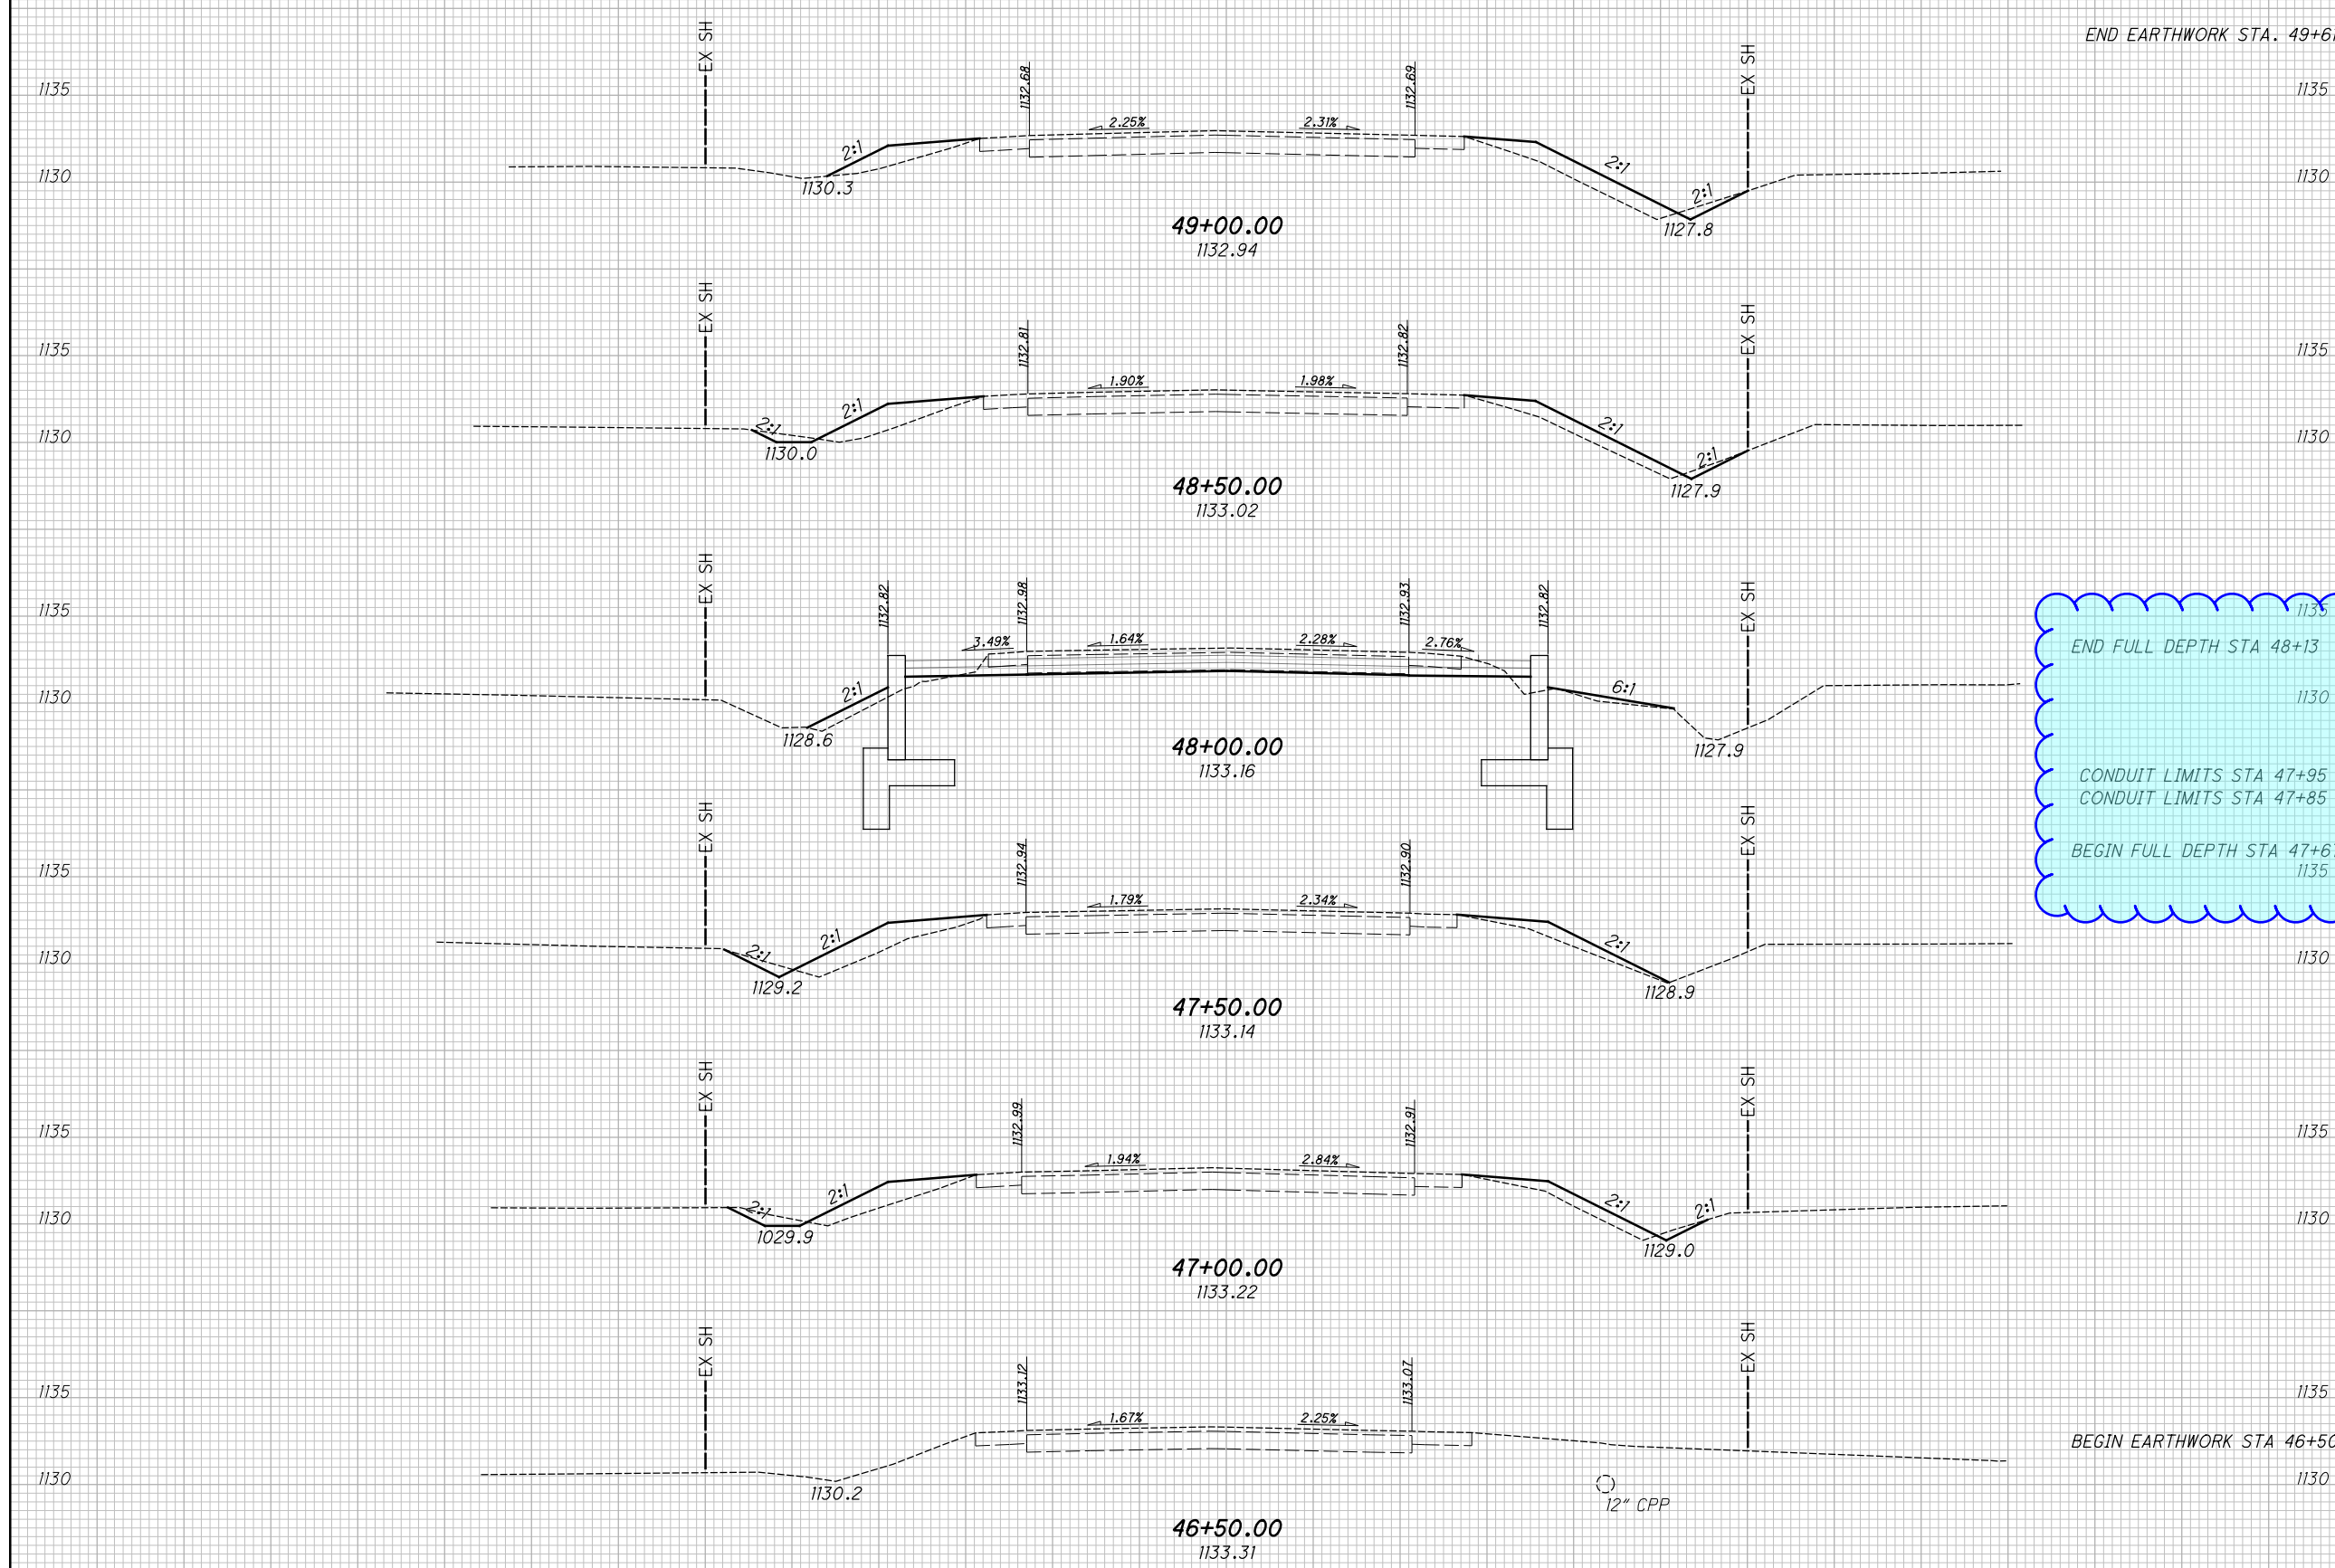

END FULL DEPTH STA 48+13  
 CONDUIT LIMITS STA 47+95  
 CONDUIT LIMITS STA 47+85  
 BEGIN FULL DEPTH STA 47+67

END STA	END AREA		VOLUME		CALCULATED RCB	CHECKED MAC
	CUT	FILL	CUT	FILL		
49+61	0	0				
1135			1	18		
1130	1	16	3	30		
48+50			1	14		
1135	2	16				
1130						
48+13	0	4				
1135	5	4				
1130			3	3		
47+95	5	4				
47+85	8	15				
47+67	8	15				
1135	1	15				
1130	1	15				
47+50			4	26		
1135	3	13				
1130						
47+00			3	12		
1135						
1130						
46+50	0	0				
1135						
1130						
46+50						
1135						
1130						
21			21	22		

CROSS SECTIONS - S.R. 7 (00.90)  
 STA. 46+50.00 TO STA. 49+61.00

ATB-  
 CULVERTS-FY2021


29  
 64

CARRIED TO GENERAL NOTES SHEET 4



I:\ProjectData\ATB\06804\_CULVERTS\FY2021\Design\Roadway\Sheets\06804\_XS40.dgn XS\_SHEET\_Temporary\_model\_name\_13/18/2021 12:27:40 AM rbaughma

SEEDING  
END SO.  
WIDTH YDS.

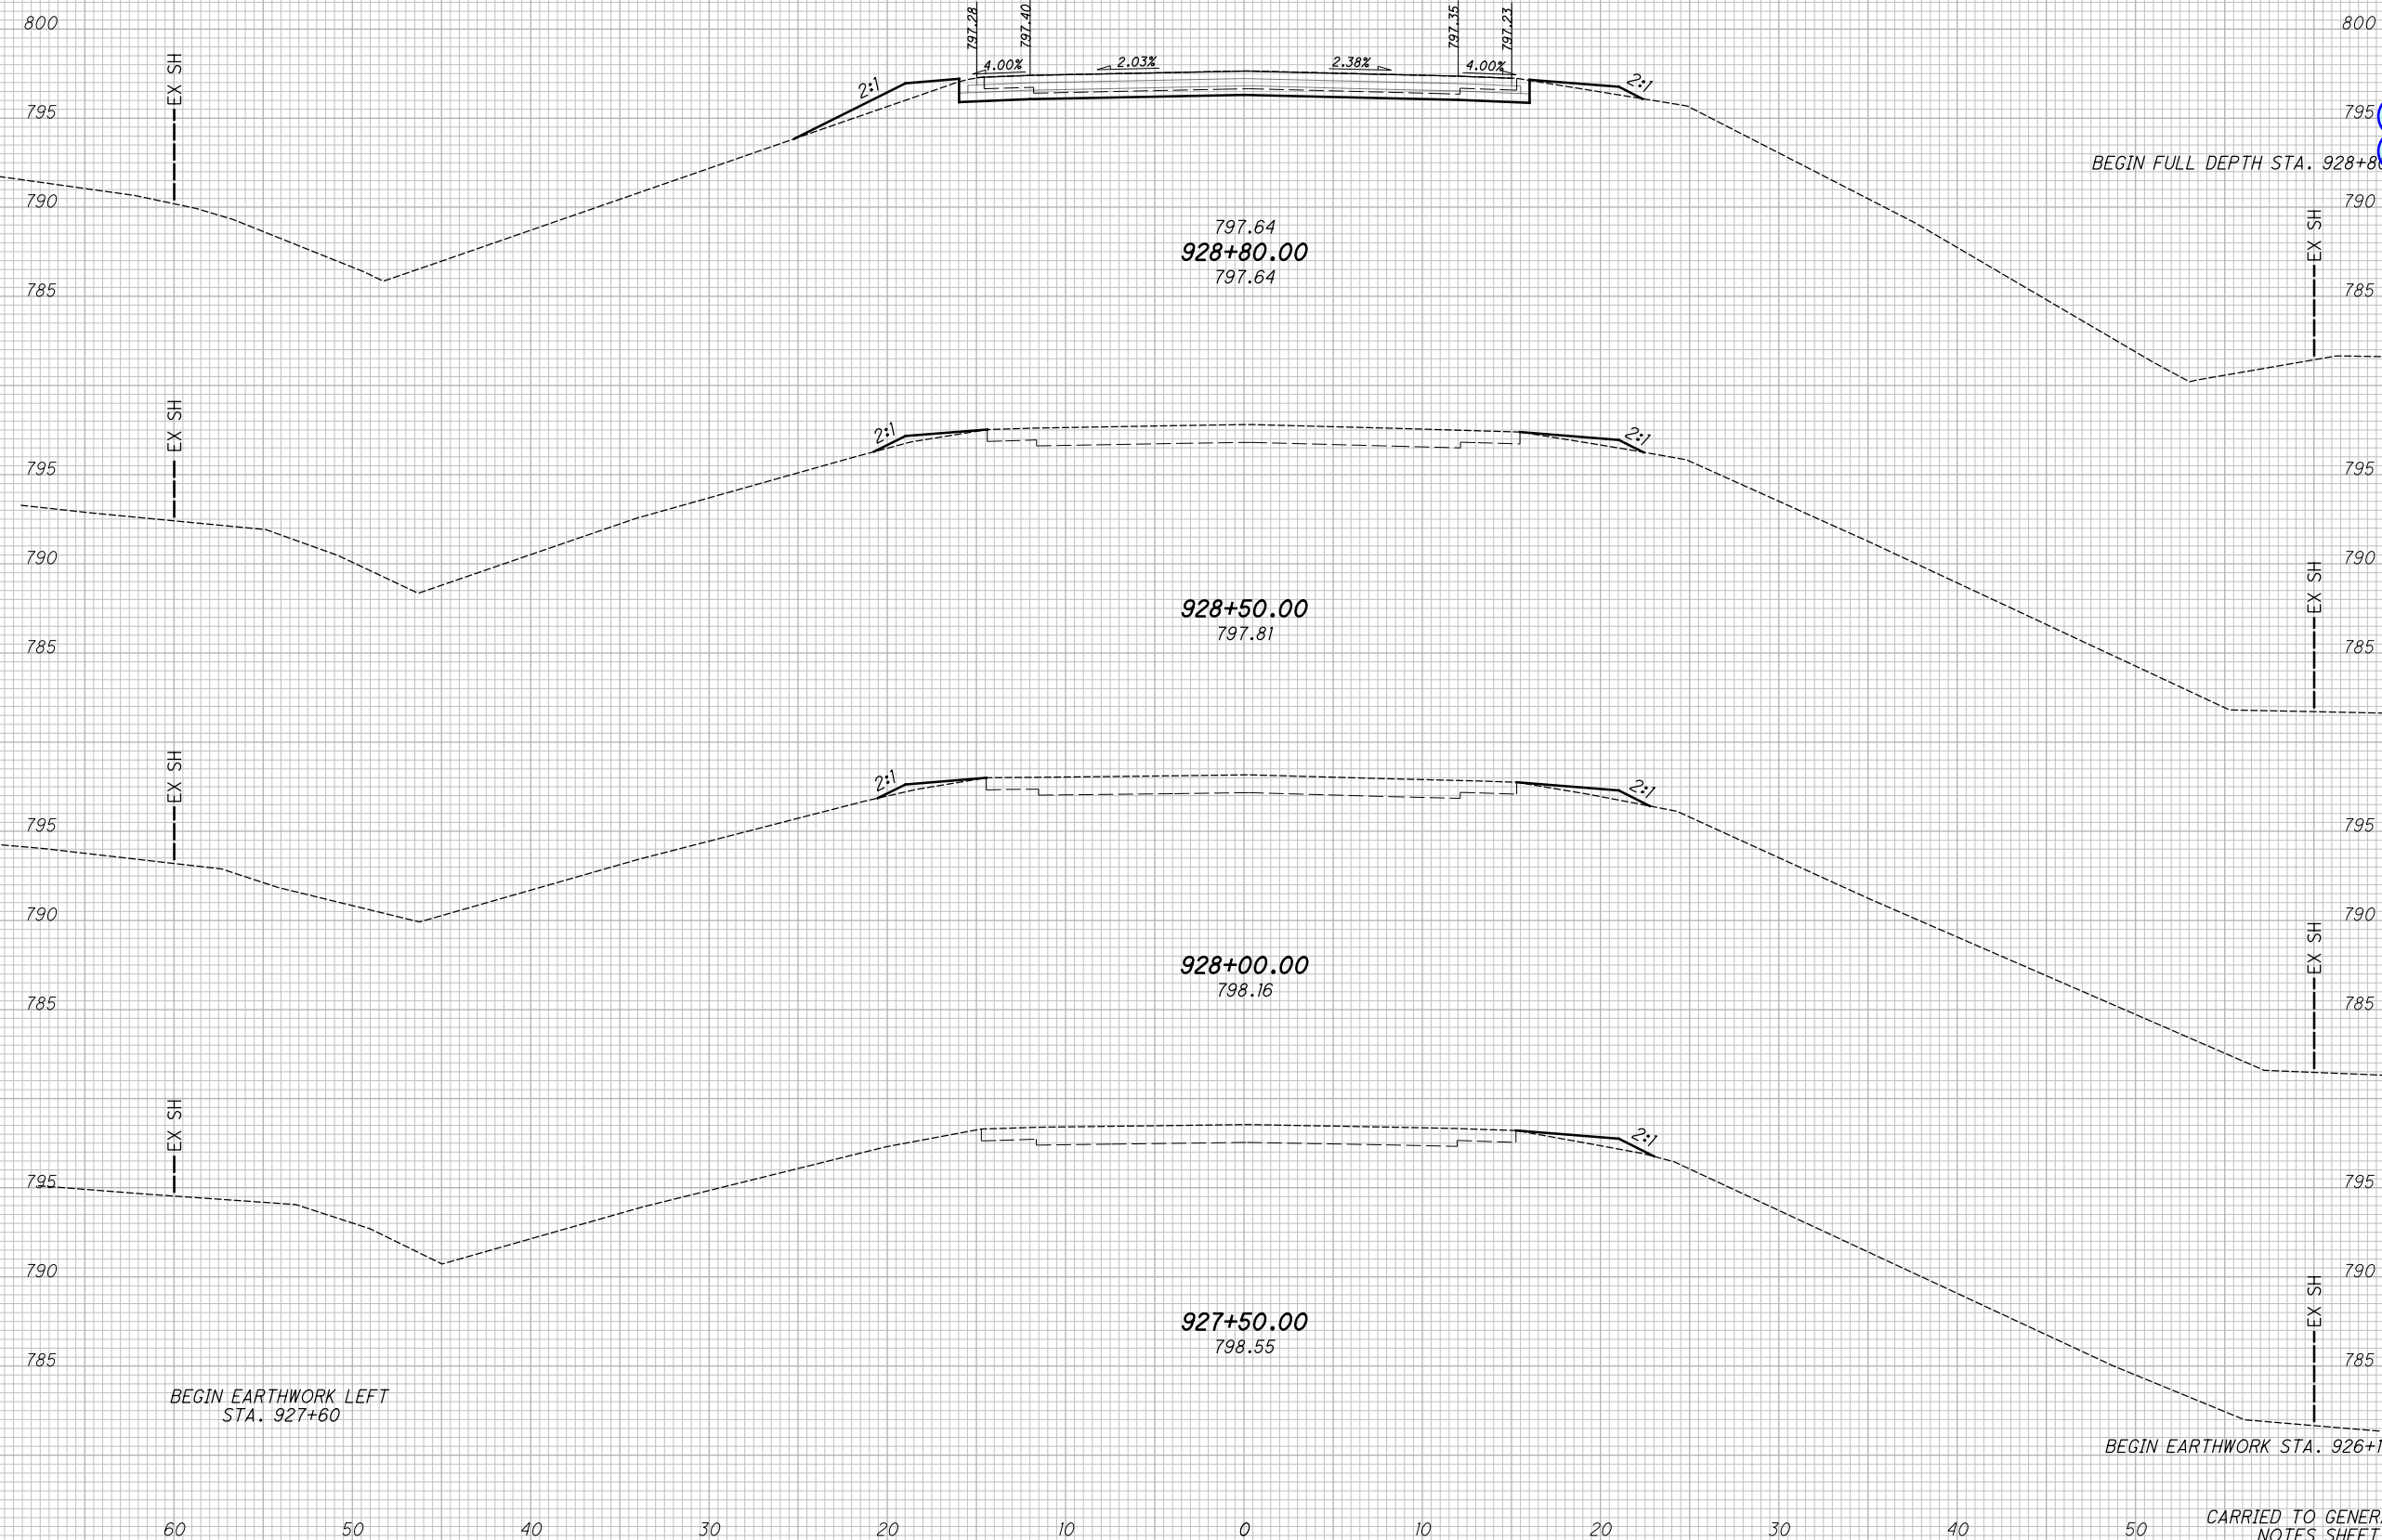

END AREA		VOLUME		CALCULATED RCB	CHECKED MAC
CUT	FILL	CUT	FILL		
0	15.6	0	6		
0	0	0	5		
0	3	0	7		
0	5	0	6		
0	2	0	5		
0	0	0	23		

BEGIN FULL DEPTH STA. 928+80

CROSS SECTIONS - S.R. 45 (17.69)  
STA. 926+14.00 TO STA. 928+80.00


ATB-  
CULVERTS-FY2021

37  
64

CARRIED TO GENERAL NOTES SHEET 4

I:\ProjectData\ATB\06804\_CULVERTS\FY2021\Design\Roadway\Sheets\06804\_XS40.dgn XS\_SHEET\_Temporary\_model\_name\_2 3/18/2021 11:27:41 AM rbaughma

SEEDING	
END WIDTH	SO. YDS.

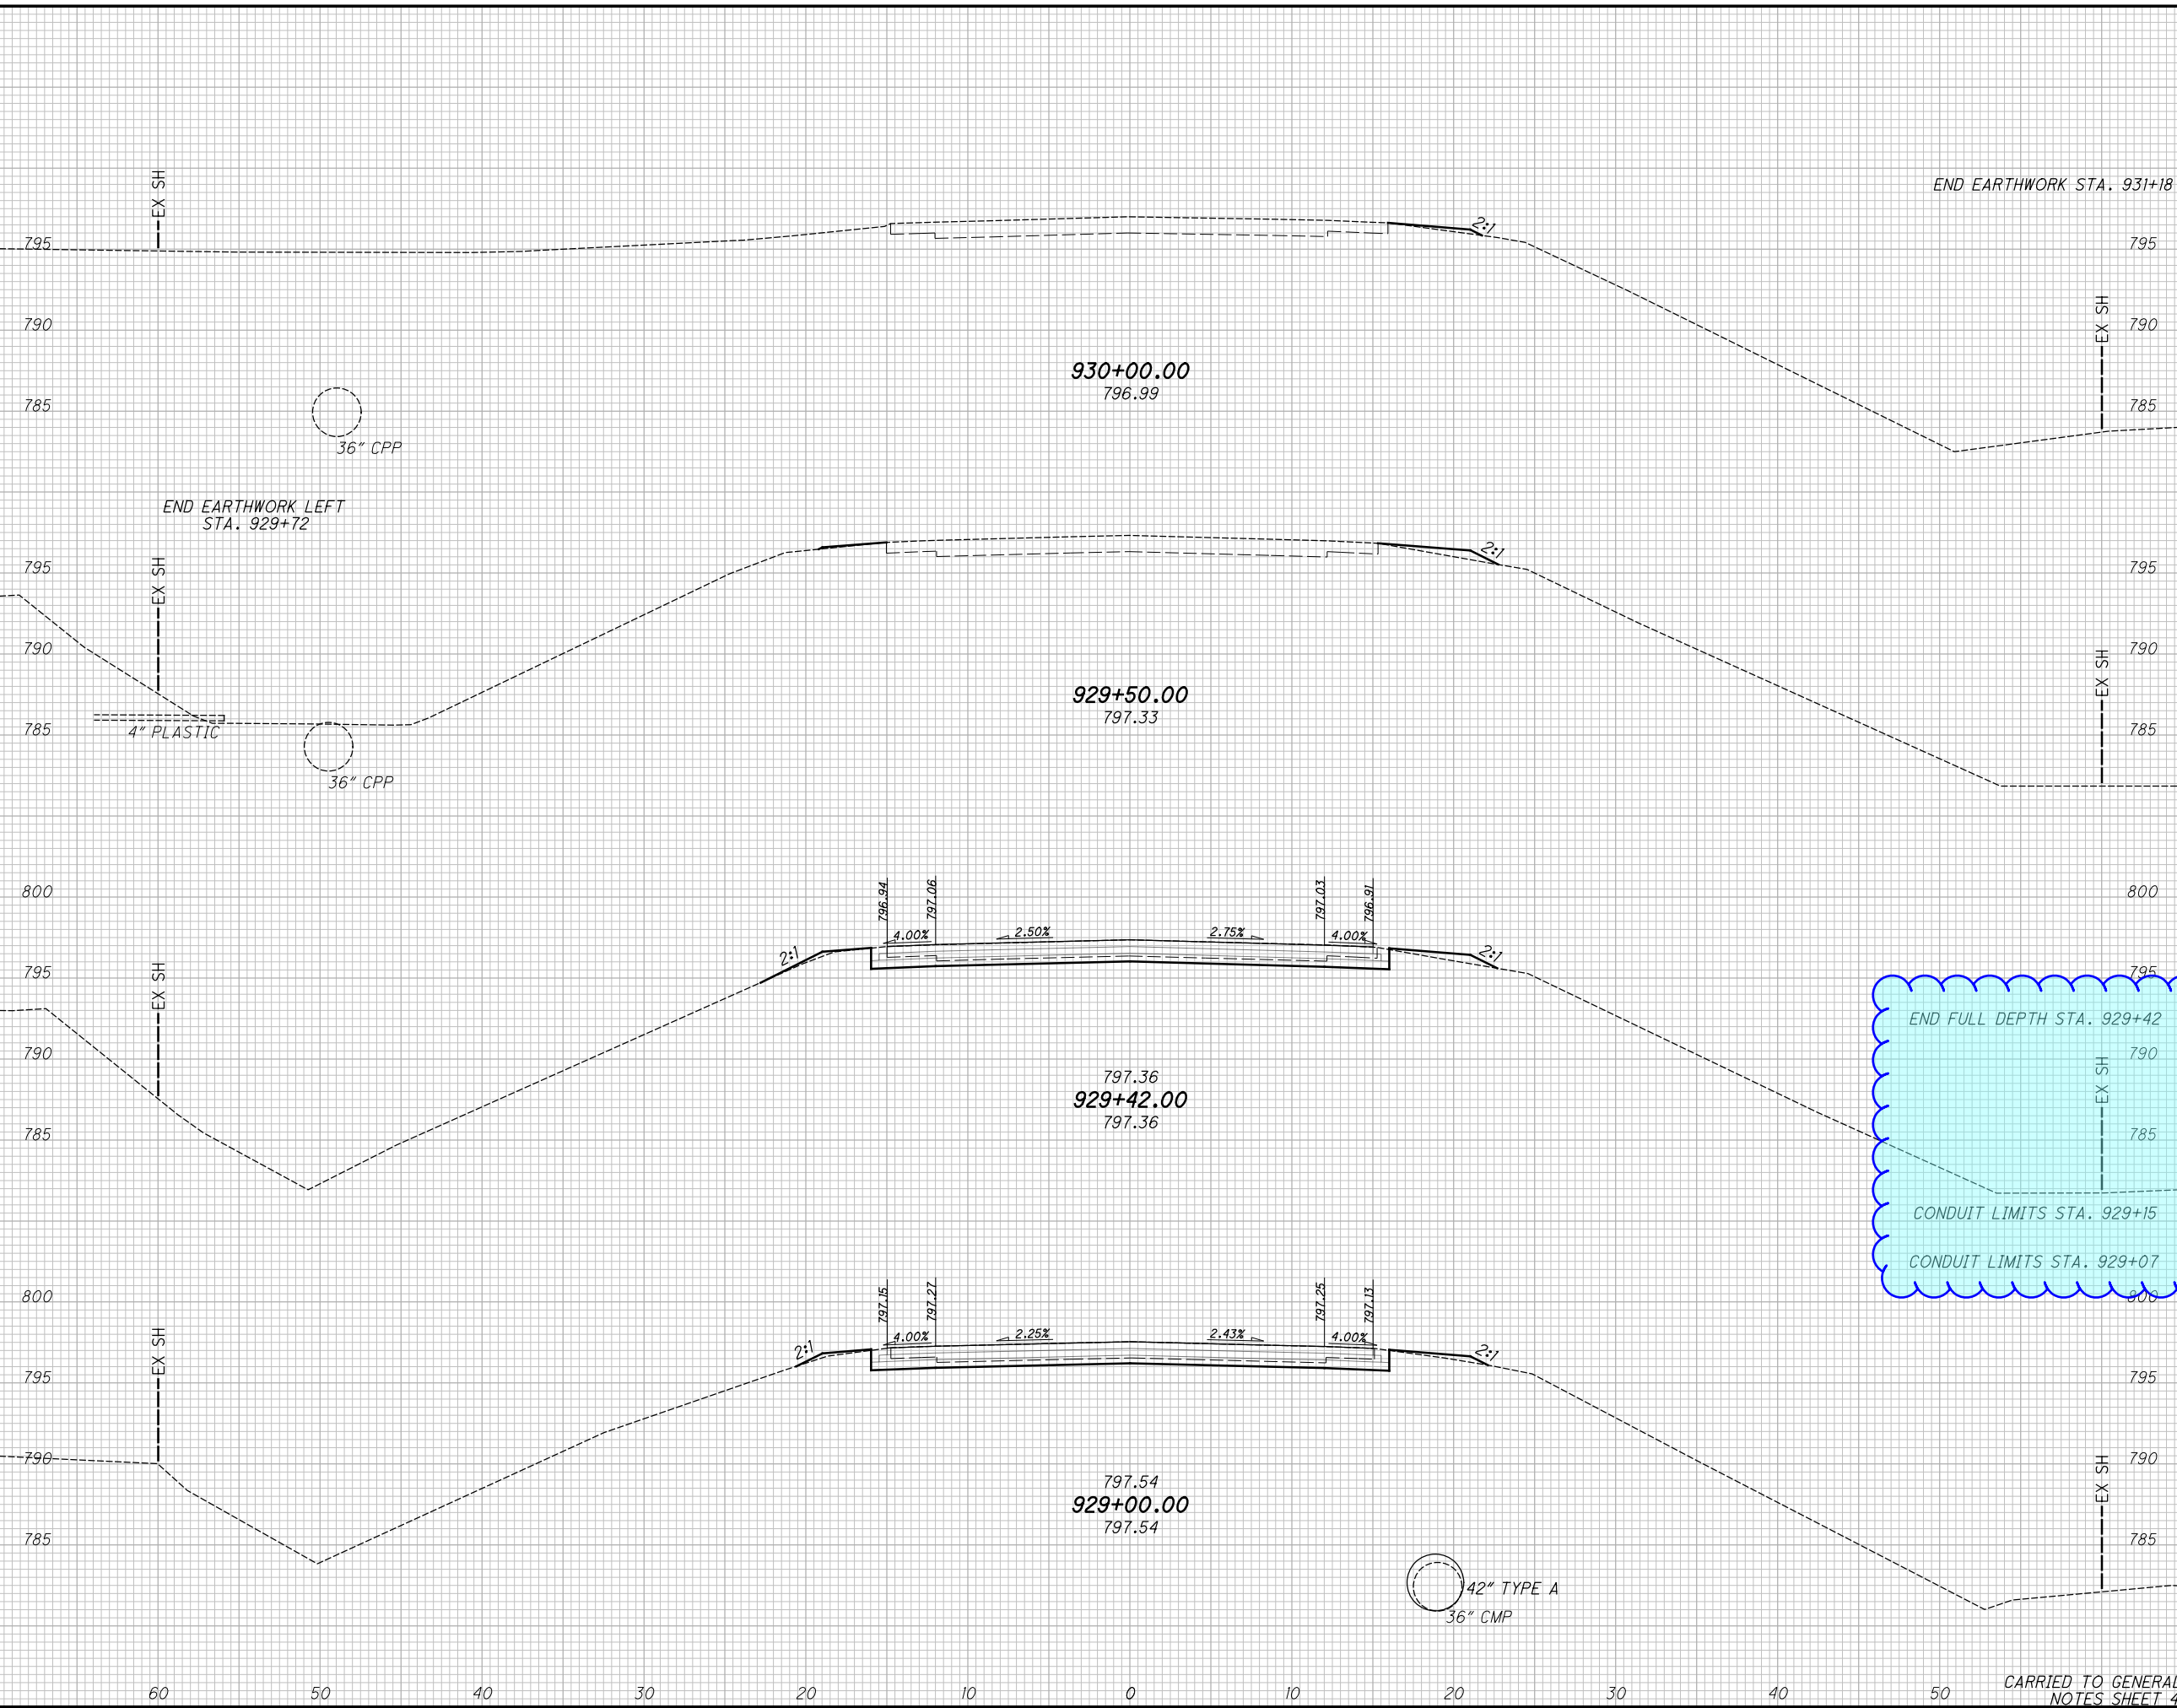

END AREA	VOLUME	CALCULATED	CHECKED
0	0		
0	0	0	2
0	1	0	3
0	2	0	1
0	3	14	3
14	6	14	4
15	6	15	6
29	16	38	64

**CROSS SECTIONS - S.R. 45 (17.69)**  
**STA. 929+00.00 TO STA. 931+18.00**  
**ATB- CULVERTS-FY2021**


CARRIED TO GENERAL NOTES SHEET 4



I:\ProjectData\ATB\06804\_CULVERTS\FY2021\Design\Roadway\Sheets\06804\_XS50.dgn XS\_SHEET\_Temporary\_model\_name.2 3/18/2021 11:27:53 AM rbaughma

SEEDING  
END SO.  
WIDTH YDS.

END AREA  
CUT FILL  
VOLUME  
CUT FILL  
CALCULATED  
RCB  
CHECKED  
MAC

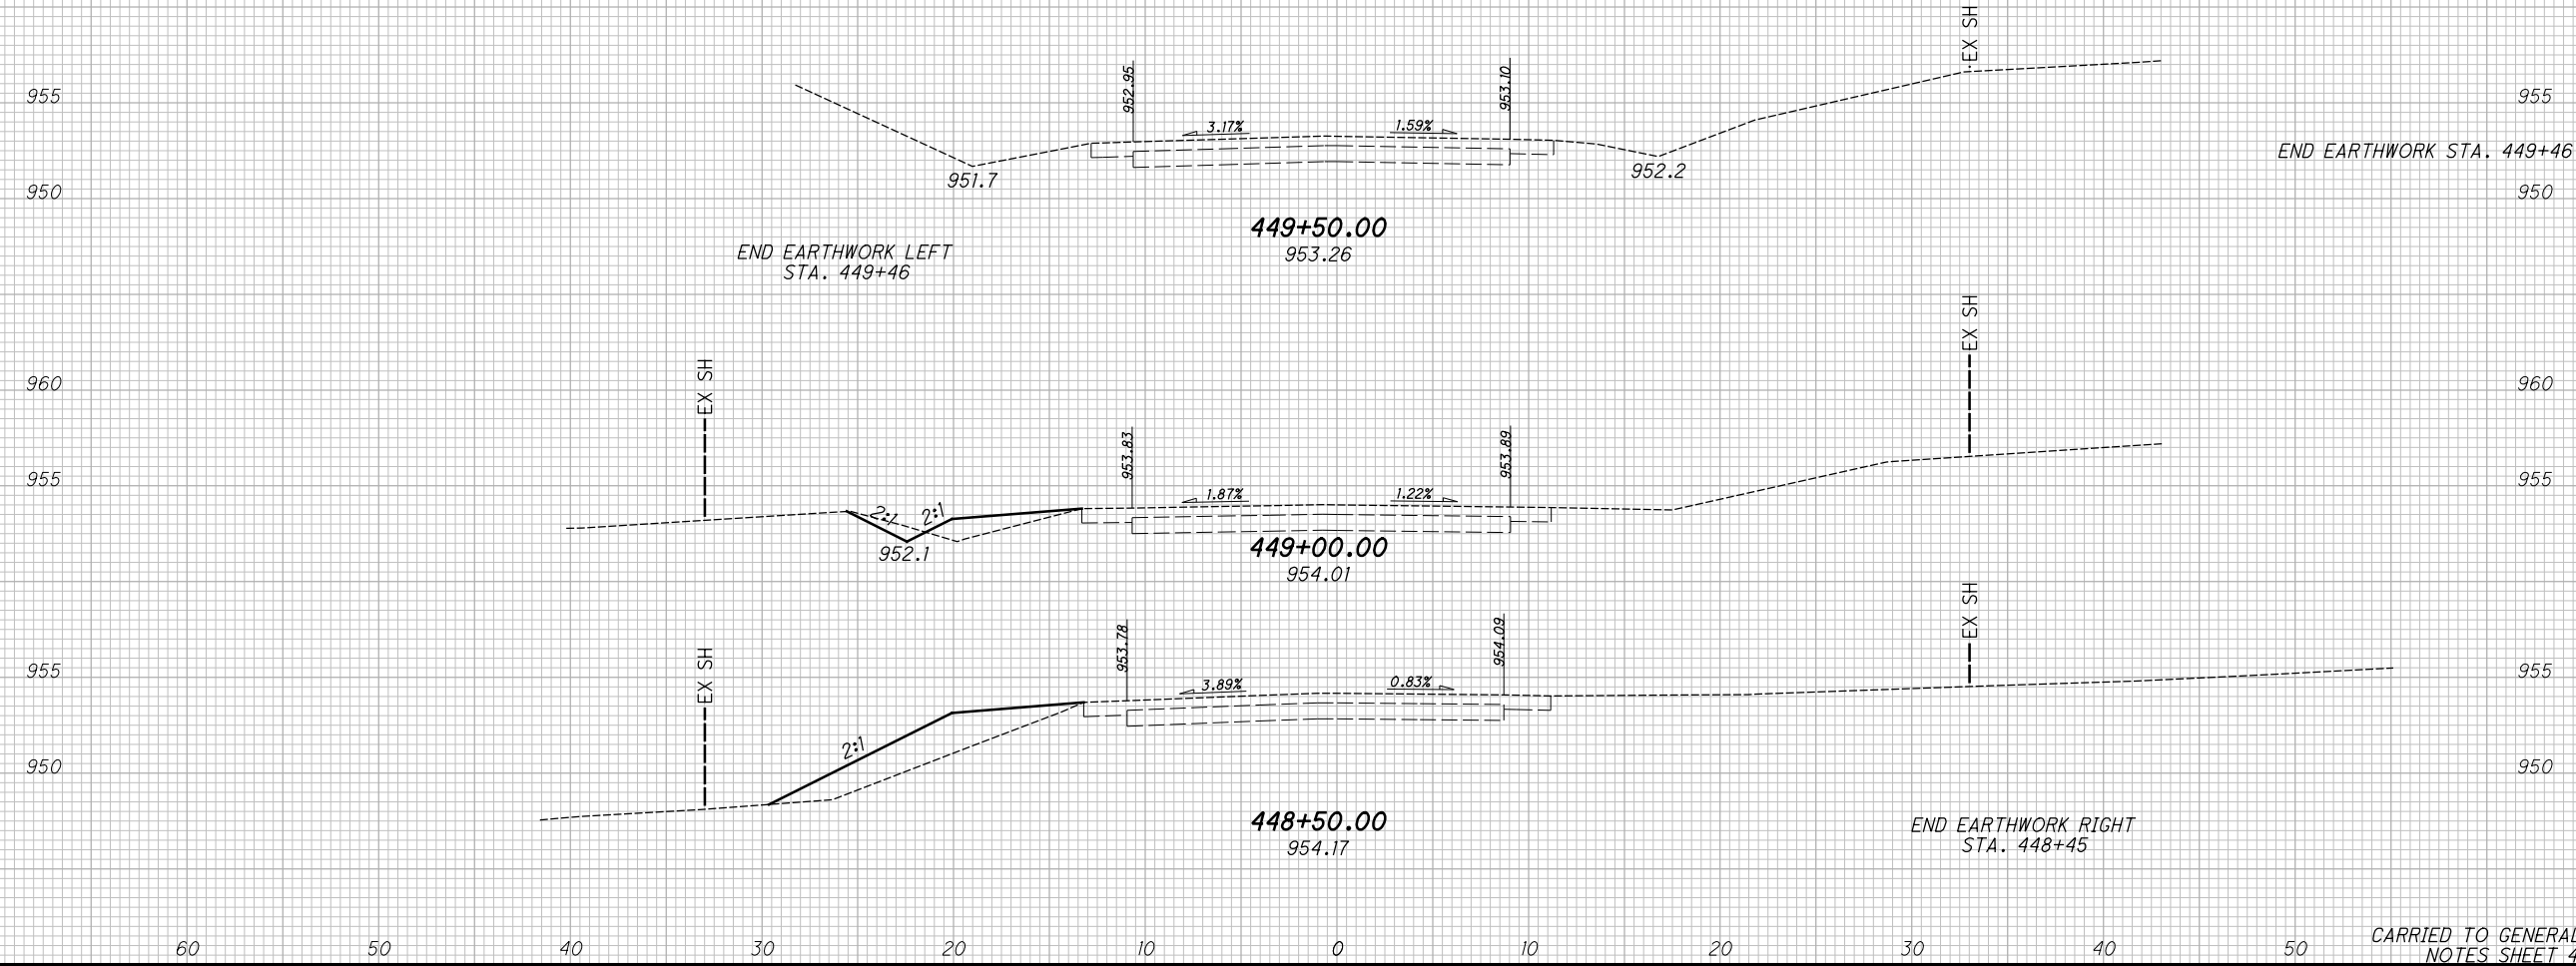


END AREA	VOLUME		CALCULATED RCB	CHECKED MAC
	CUT	FILL		
0	0	0		
2	2	4		
2	5	5		
0	21	24		
0	0	66		
4	94	64		

**CROSS SECTIONS - S.R. 46 (11.06)  
STA. 448+50.00 TO STA. 449+50.00**

**ATB-  
CULVERTS-FY2021**

CARRIED TO GENERAL NOTES SHEET 4

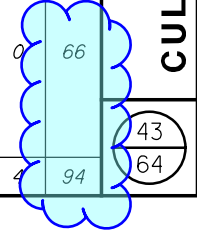

43  
64

**SURVEYING PARAMETERS**

USE THE FOLLOWING PROJECT CONTROL, VERTICAL POSITIONING, AND HORIZONTAL POSITIONING PARAMETERS FOR ALL SURVEYING:

**VERTICAL POSITIONING**

ORTHOMETRIC HEIGHT DATUM: NAVD88  
GEOID: 2012A

**HORIZONTAL POSITIONING**

REFERENCE FRAME: NAD83 (2011) (EPOCH: 2010.0000)  
ELLIPSOID: GRS80  
MAP PROJECTION: LAMBERT CONFORMAL CONIC  
COORDINATE SYSTEM: OHIO NORTH 3401  
COMBINED SCALE FACTOR: 0.99995356286  
ORIGIN OF SCALE (X,Y): EASTING (X): 0, NORTHING (Y): 0

USE THE POSITIONING METHODS AND MONUMENT TYPE USED IN THE ORIGINAL SURVEY TO RESTORE ALL MONUMENTS RELATED TO PRIMARY PROJECT CONTROL THAT ARE DAMAGED OR DESTROYED BY CONSTRUCTION ACTIVITIES. RESTORE THE DAMAGED OR DESTROYED MONUMENTS IN ACCORDANCE WITH CMS 623.

UNITS ARE IN U.S. SURVEY FEET.

**PROJECT CONTROL POINTS (LOCAL GROUND COORDINATES)**

Table with columns: Point, North, East, Station, Offset, Elevation (NAVD88), Geoid 12a. Includes points SV348, T400, T500, VM429, and VM486 with their respective coordinates and features.

**SEEDING AND MULCHING**

THE FOLLOWING QUANTITIES ARE PROVIDED TO PROMOTE GROWTH AND CARE OF PERMANENT SEEDED AREAS:

Table listing quantities for seeding and mulching: 659, TOPSOIL (142 CU. YD.), 659, SEEDING AND MULCHING (1281 SQ. YD.), 659, REPAIR SEEDING AND MULCHING (64 SQ. YD.), 659, COMMERCIAL FERTILIZER (0.17 TON), 659, LIME (0.26 ACRES), 659, WATER (7 M. GAL.).

SEEDING AND MULCHING SHALL BE APPLIED TO ALL AREAS OF EXPOSED SOIL BETWEEN THE RIGHT-OF-WAY LINES, AND WITHIN THE CONSTRUCTION LIMITS FOR AREAS OUTSIDE THE RIGHT-OF-WAY LINES COVERED BY WORK AGREEMENT OR SLOPE EASEMENT. QUANTITY CALCULATIONS FOR SEEDING AND MULCHING ARE BASED ON THESE LIMITS.

**UNSUITABLE SOILS**

THE FOLLOWING ITEMS AND QUANTITIES ARE TO BE USED AS DIRECTED BY THE ENGINEER TO ADDRESS UNSUITABLE SOILS ENCOUNTERED IN THE AREA UNDER THE PROPOSED CULVERT.

Table listing quantities for unsuitable soils: 203, EXCAVATION (26 CU YD), 203, GRANULAR MATERIAL, TYPE C (703.16) (26 CU YD), 204, GEOTEXTILE FABRIC, TYPE D (52 SQ YD).

**STRUCTURE/CULVERT IDENTIFICATION SIGNS**

STRUCTURE IDENTIFICATION SIGNS (I-H25b) WILL BE PLACED ON EACH APPROACH OFF THE RIGHT SHOULDER, FACING TRAFFIC, AND BEHIND THE GUARDRAIL IF APPLICABLE. A QUANTITY OF ONE SIGN PER APPROACH WILL BE INSTALLED. THE SIGNS WILL HAVE A NON-REFLECTIVE WHITE SHEETING BACKGROUND.

THE SIGNS WILL BE MOUNTED ON NEW NO. 2 POSTS AND WILL BE INSTALLED AS PER STANDARD CONSTRUCTION DRAWING TC-41.20, MOST CURRENT REVISION. EACH POST WILL BE 7.5' IN LENGTH.

INSTALL SIGNS FOR THE FOLLOWING STRUCTURE: ATB-46-1106

THE FOLLOWING QUANTITIES HAVE BEEN INCLUDED FOR EACH APPROACH:

- 630, SIGN, FLAT SHEET, 730.20, 1 SQ FT
- 630, GROUND MOUNTED SUPPORT, NO. 2 POST, 7.5 FT

**PAVEMENT RESTORATION FOR PIPE INSTALLATIONS AND/OR REMOVALS**

THE FOLLOWING QUANTITY HAS BEEN PROVIDED FOR PAVEMENT RESTORATION FOLLOWING INSTALLATION AND/OR REMOVAL OF PIPES.

Table listing quantities for STA. 447+17 TO STA. 447+83: 202, PAVEMENT REMOVED (152 SY), 204, SUBGRADE COMPACTION (194 SY), 255, FULL DEPTH PAVEMENT SAWING (29 FT), 301, ASPHALT CONCRETE BASE, PG64-22 (T=10") (50 CY), 304, AGGREGATE BASE (T=6") (32 CY), 407, NON-TRACKING TACK COAT @ 0.06 GAL/SY (22 GAL).

Table listing quantities for STA. 447+45 TO STA. 447+55 (ATB-46-1106): 202, PAVEMENT REMOVED (17 SY), 301, ASPHALT CONCRETE BASE, PG64-22 (AVG=23.2") (20 CY), 407, NON-TRACKING TACK COAT @ 0.06 GAL/SY (6 GAL).

THE ABOVE QUANTITIES ARE BASED ON THE PAVEMENT WIDTHS GIVEN IN THE PLANS.

PROVIDE ANY MATERIALS USED OUTSIDE THE LIMITS STATED ABOVE AT NO ADDITIONAL COST.

**RESURFACING AFTER PIPE INSTALLATION**

THE FOLLOWING QUANTITIES HAVE BEEN PROVIDED TO RESURFACE THE ROADWAY AFTER THE COMPLETION OF THE CULVERT OR STRUCTURE PLACEMENT. THIS WORK DOES NOT HAVE TO BE COMPLETE DURING THE DETOUR PERIOD.

Table listing quantities for STA. 446+67 TO STA. 448+33 (ATB-46-1106): 254, PAVEMENT PLANING, ASPHALT CONCRETE (T=3") (452 SY), 407, NON-TRACKING TACK COAT @ 0.06 GAL/SY (55 GAL), 408, PRIME COAT, AS PER PLAN @ 0.40 GAL/SY (30 GAL), 441, ASPHALT CONCRETE SURFACE COURSE, TYPE 1, (448), AS PER PLAN, PG64-22 (2 - 1 1/2" LIFTS) (38 CY), 617, COMPACTED AGGREGATE, AS PER PLAN (T=2") (5 CY).

THE ABOVE QUANTITIES ARE BASED ON A RESURFACING THE WIDTH OF THE PAVEMENT AND SHOULDERS AND A LENGTH OF 50' ON EACH SIDE OF THE REQUIRED TRENCH WIDTH FOR INSTALLATION AND/OR REMOVAL.

**PAVEMENT MARKINGS**

ALL PAVEMENT MARKINGS THAT ARE REMOVED DURING THE CULVERT REPLACEMENT WILL BE REPLACED WITH ITEM 642 - TRAFFIC PAINT. THE FOLLOWING ESTIMATED QUANTITIES HAVE BEEN CARRIED TO THE GENERAL SUMMARY:

Table listing quantities for pavement markings: 621, RPM (4 EA), 642, EDGE LINE, 6", TYPE 1 (0.07 MI), 642, CENTER LINE, TYPE 1 (0.04 MI).


I:\Project+Data\ATB\106804\_CULVERTS\FY2021\Design\Roadway\Sheets\106804\_DN501.dgn Sheet 3/18/2021 11:27:54 AM rbaughma

Vertical sidebar containing: DESIGN AGENCY (ODOT DISTRICT 4), DATE (MM/DD/YY), REVIEWED (STRUCTURE FILE NUMBER), DRAWN (RCB), DESIGNED (RCB), COUNTY (ASHTABULA COUNTY), CULVERT NOTES (ATB-46-1106, SR 46 OVER TRIB. OF SKIDMORE LAKE), and project title (ATB-CULVERTS-FY2021 PID No. 106804).



I:\ProjectData\ATB\06804\_CULVERTS\FY2021\Design\Roadway\Sheets\06804\_XS60.dgn XS\_SHEET\_Temporary\_model\_name\_2 3/18/2021 11:28:11 AM rbaughma

SEEDING  
END SO.  
WIDTH YDS.

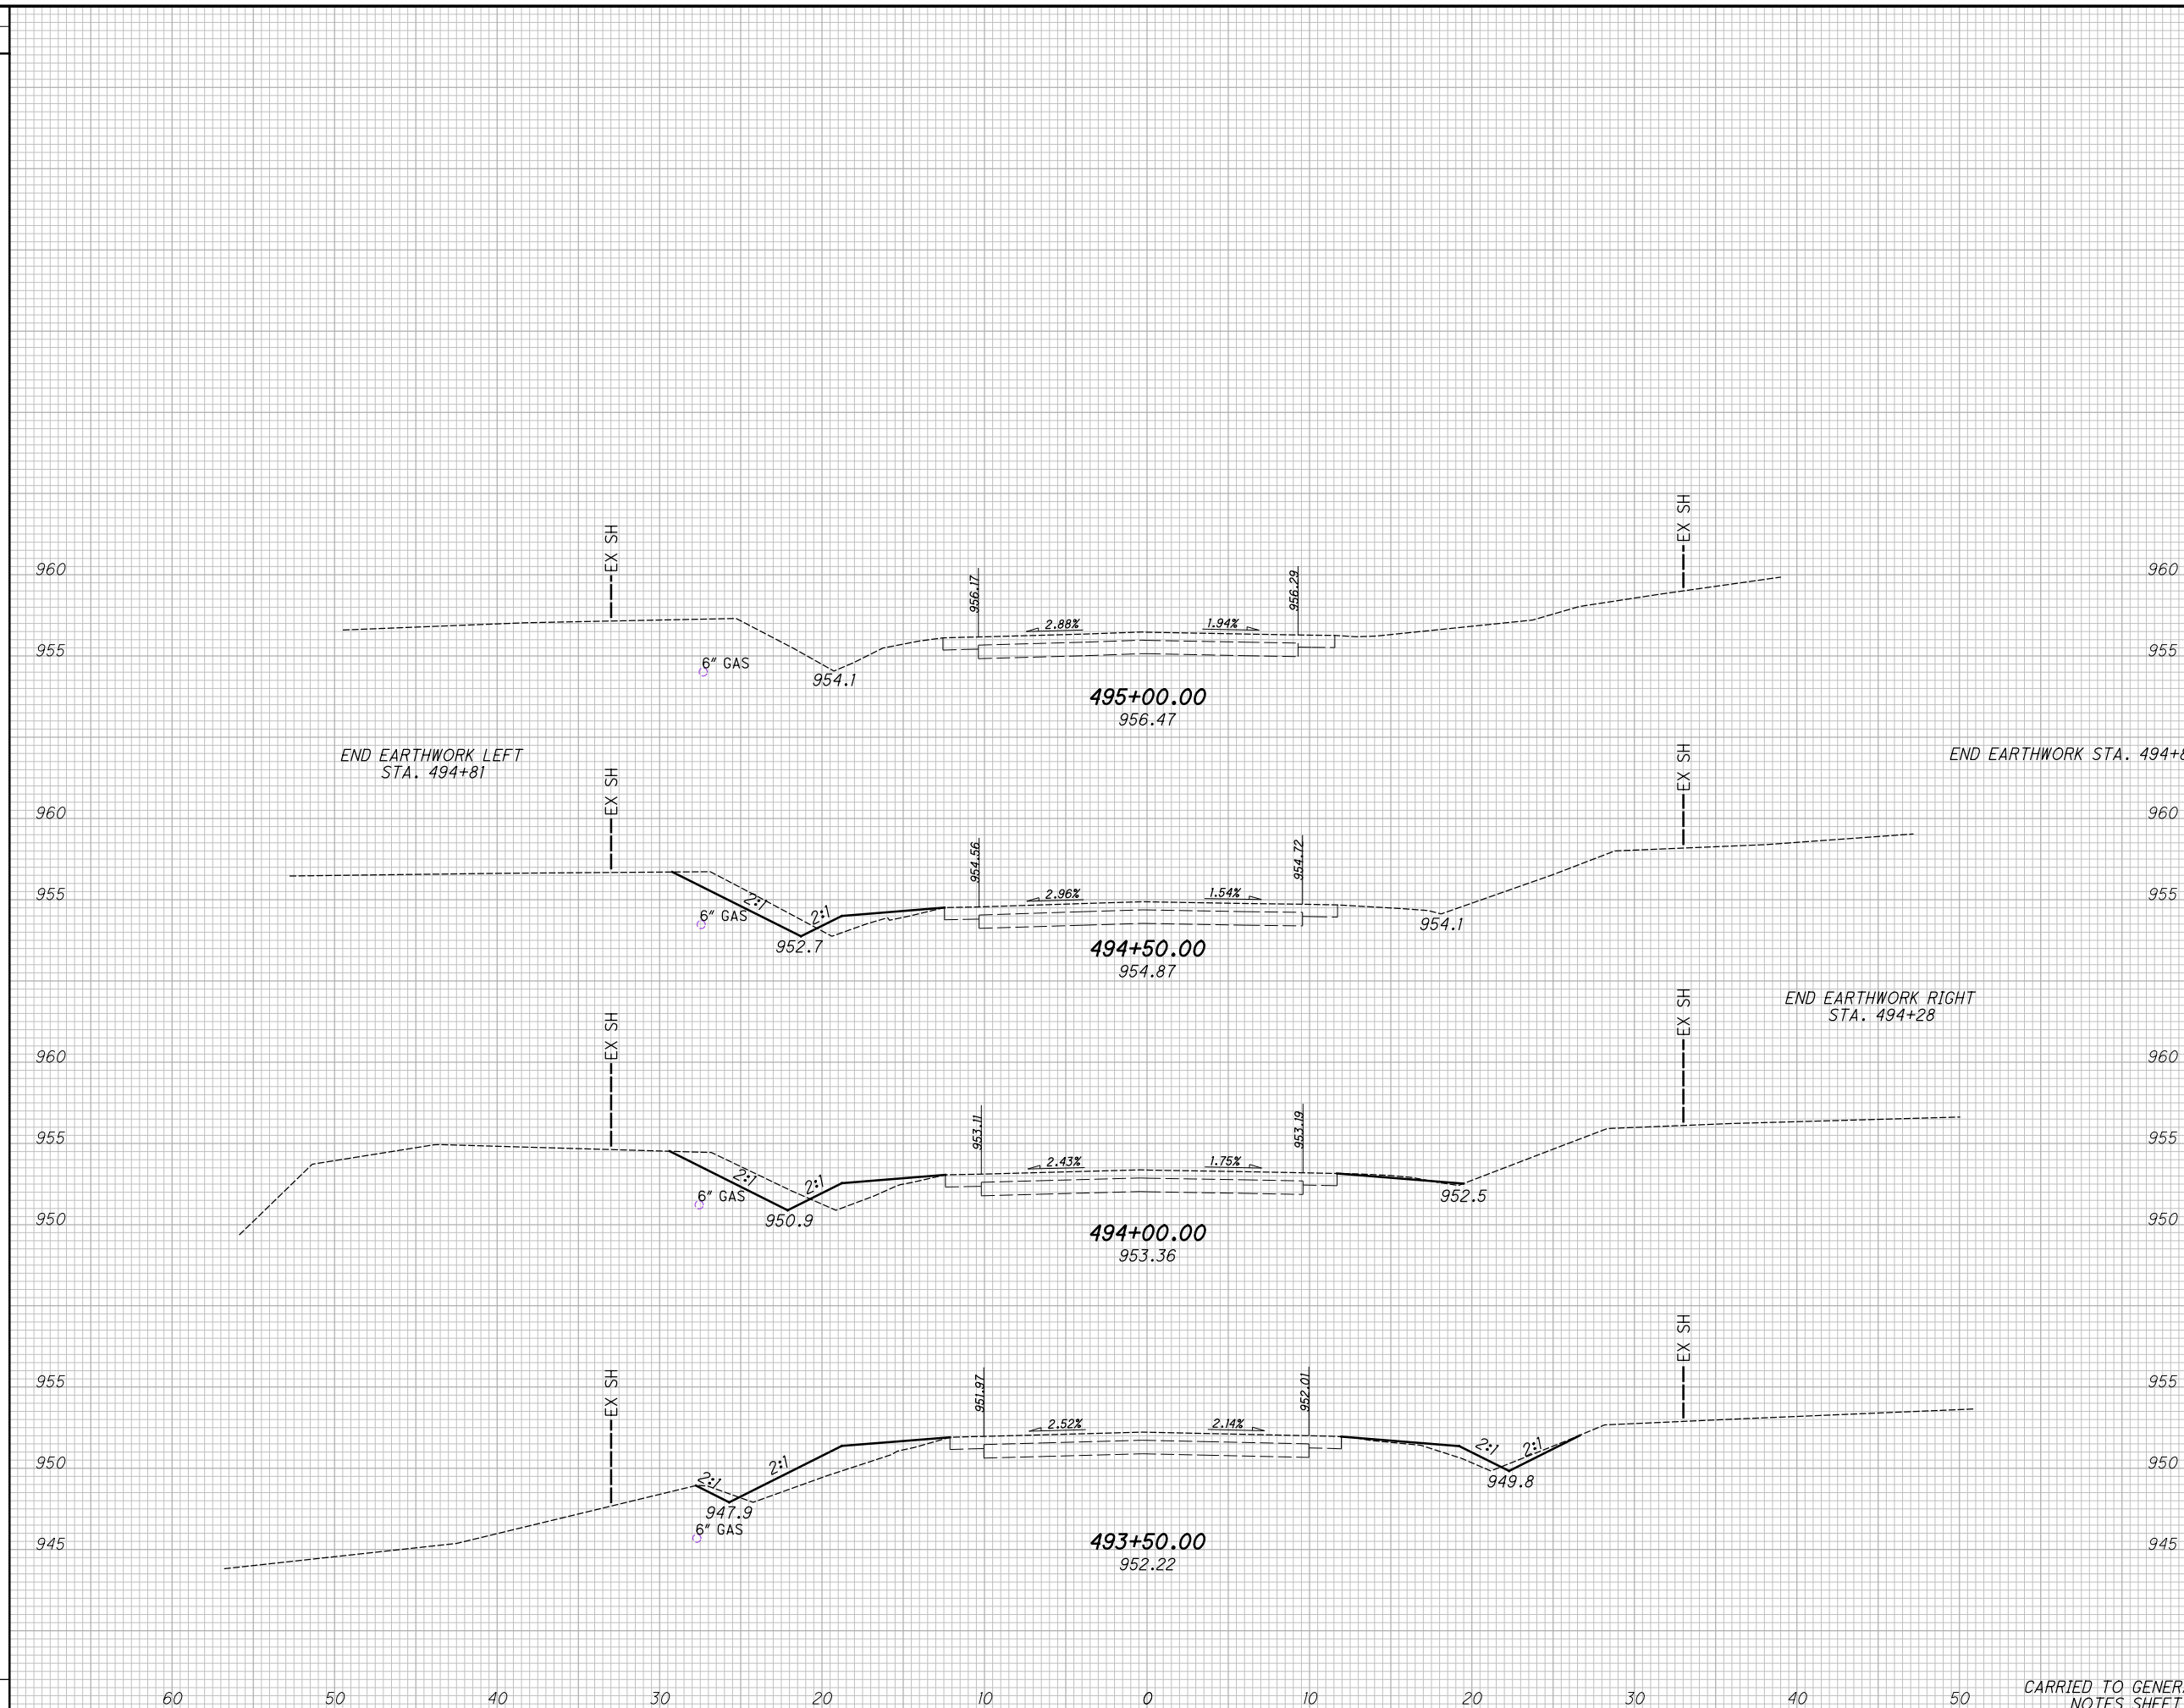

END STA.	AREA		VOLUME		CALCULATED RCB	CHECKED MAC
	CUT	FILL	CUT	FILL		
493+50.00	2	14	4	29		
494+00.00	9	6	10	19		
494+50.00	8	4	16	9		
495+00.00	0	0	0	0		
<b>TOTAL</b>	<b>19</b>	<b>24</b>	<b>34</b>	<b>57</b>		

**CROSS SECTIONS - S.R. 46 (11.92)  
STA. 493+50.00 TO STA. 495+00.00**

**ATB-  
CULVERTS-FY2021**

52  
64

CARRIED TO GENERAL NOTES SHEET 4