

DESIGN DESIGNATION

CURRENT A.D.T. (1983) 9240
DESIGN YEAR A.D.T. (2003) 15,140
D.H.V. 1510
D. (DIRECTIONAL DISTRIBUTION) 44-56
T. (PERCENT B.&C. TRUCKS) 3.50%
V. (DESIGN SPEED) 35 M.P.H.

STATE OF OHIO
DEPARTMENT OF TRANSPORTATION
ATB-84-13.61
46th STREET BRIDGE OVER
ASHTABULA RIVER
CITY OF ASHTABULA
ASHTABULA COUNTY

FUNDS: BRM-3X05(1)

R/W ONLY

FHWA REGION	STATE	PROJECT
5	OHIO	BRM 3X05(1)

ASHTABULA COUNTY
ATB-84-13.61

1983 SPECIFICATIONS

THE STANDARD SPECIFICATIONS OF THE STATE OF OHIO,
DEPARTMENT OF TRANSPORTATION, INCLUDING CHANGES AND
SUPPLEMENTAL SPECIFICATIONS LISTED IN THE PROPOSAL
SHALL GOVERN THIS IMPROVEMENT.

I HEREBY APPROVE THESE PLANS AND DECLARE
THAT THE MAKING OF THIS IMPROVEMENT WILL NOT REQUIRE
THE CLOSING TO TRAFFIC OF THE HIGHWAY AND THAT
PROVISIONS FOR THE MAINTENANCE AND SAFETY OF
TRAFFIC WILL BE AS SET FORTH ON THE PLANS AND
ESTIMATES.

APPROVED: _____
DATE: _____ ASHTABULA CITY ENGINEER

APPROVED: _____
DATE: _____ DISTRICT DEPUTY DIRECTOR OF TRANSPORTATION

APPROVED: _____
DATE: _____ DIRECTOR, DEPARTMENT OF TRANSPORTATION


APPROVED: _____
DATE: _____ ENGINEER, BUREAU OF BRIDGES AND
STRUCTURAL DESIGN

APPROVED: _____
DATE: _____ CHIEF ENGINEER, PLANNING AND DESIGN

CONVENTIONAL SIGNS

COUNTY LINE ————
TOWNSHIP LINE ————
SECTION LINE ————
CORPORATION LINE ————
FENCE LINE (EXISTING) —x—x— (PROPOSED) —x—x—
CENTER LINE ————
TREES STUMPS (TO BE REMOVED)
UTILITY POLES TELEPHONE POWER LIGHT
LIMITED ACCESS —LA— LA—
RIGHT OF WAY —RW— RW—
TEMPORARY RIGHT OF WAY —T—
EXISTING RIGHT OF WAY ————
PROPERTY LINE —P— (IN EXISTING FENCE) —P—
RAILROAD —+—+—+—
GUARD RAIL (EXISTING) —a—a—a— (PROPOSED) —a—a—a—
WORK LIMITS ————

INDEX OF SHEETS

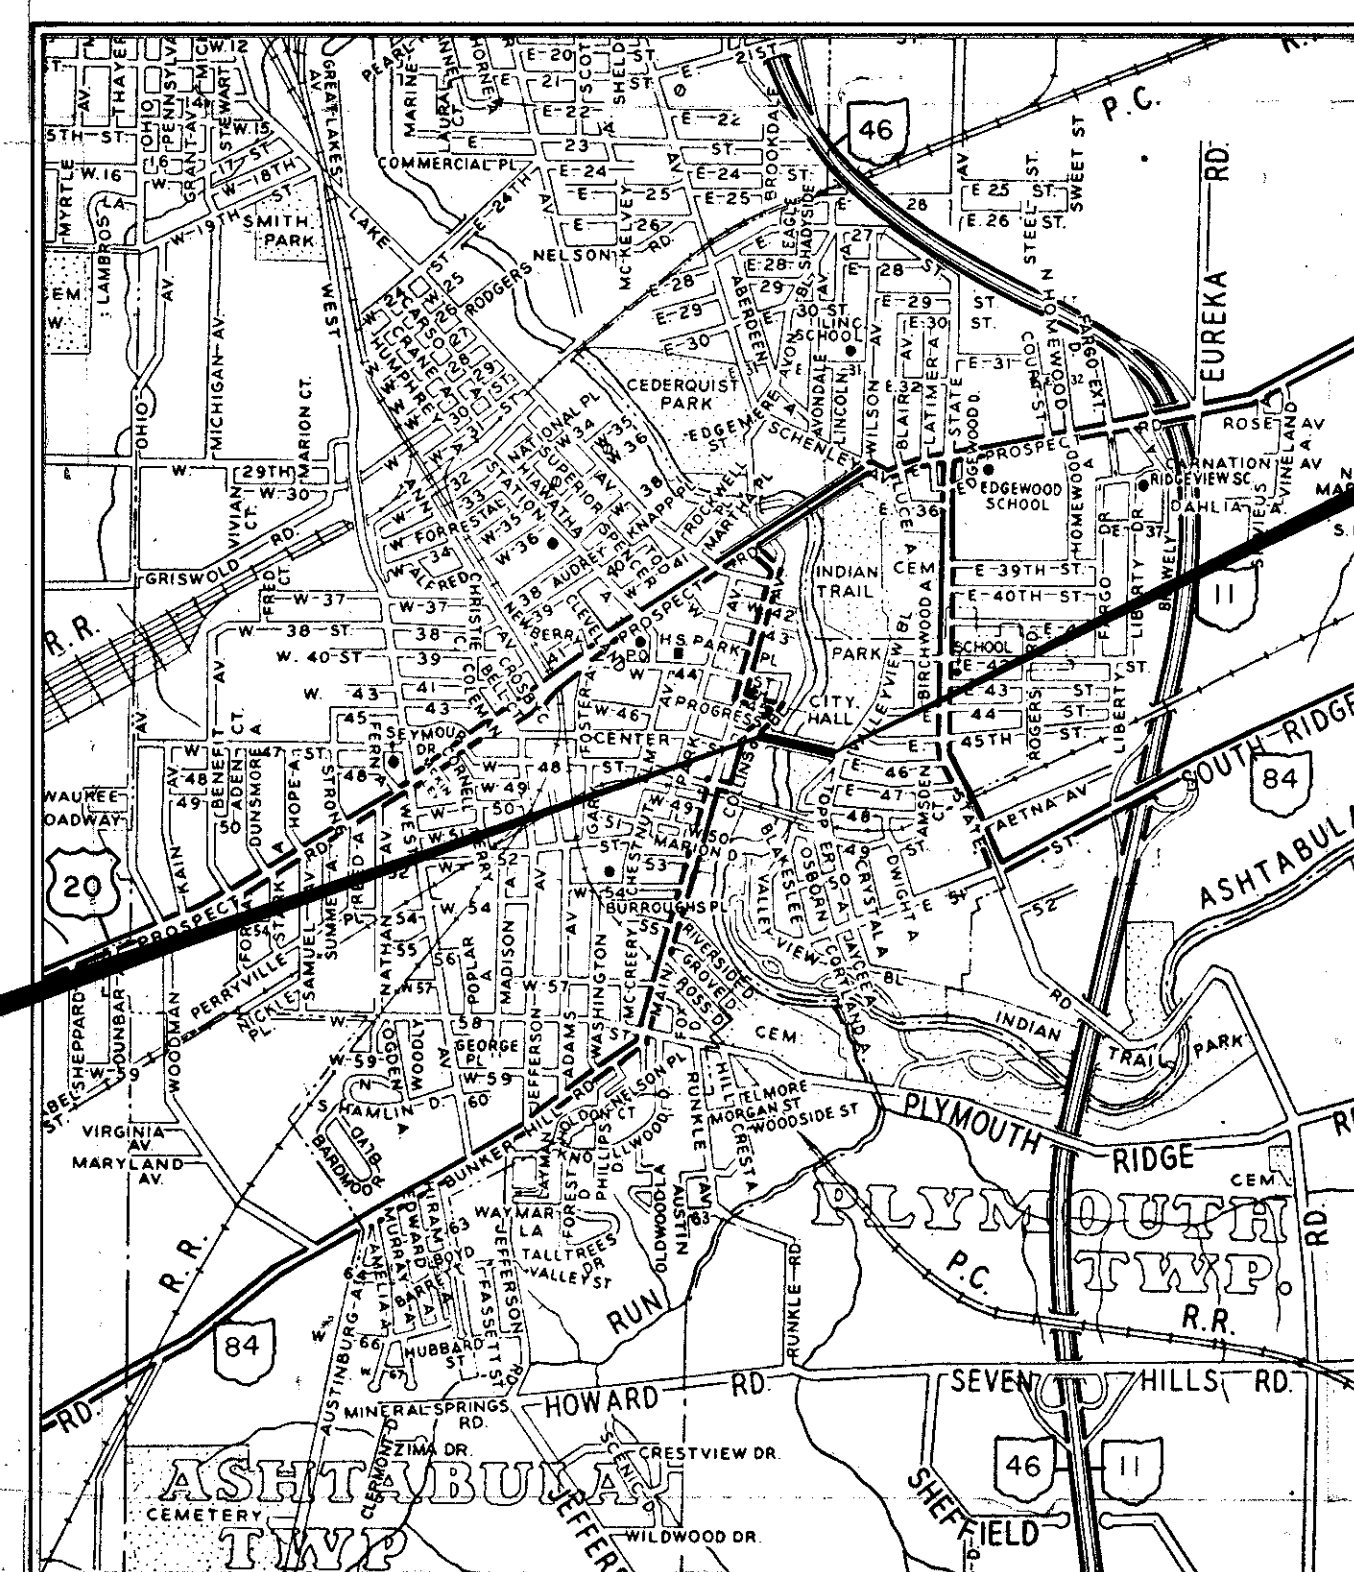

BEGIN PROJECT
STA. 718+38.60
BRM 3X05(1)

BRM 3X05(1)
END PROJECT
STA. 729+54.00

LOCATION MAP

SCALE OF MILES

PORTION TO BE IMPROVED
STATE HIGHWAYS
OTHER STREETS

PLAN
PROFILE - HORIZONTAL
PROFILE - VERTICAL
CROSS SECTIONS
RIGHT OF WAY
OTHERS

AS SHOWN

SUPPLEMENTAL SPECIFICATIONS

UNDERGROUND UTILITIES

48 HOURS
BEFORE YOU DIG
Call 800-362-2764 (Toll free)
OHIO UTILITIES
PROTECTION SERVICE
NON-MEMBERS
MUST BE CALLED DIRECTLY

LINE DATA

	PROJECT	WORK
BEGIN	718+38.60	713+00
END	729+54.00	732+42
GROSS	1,115.40 L.F.	1,942.00 L.F.
NET LENGTH	1,115.40 L.F. = 0.211 MILES	1,942.00 L.F. = 0.368 MILES

SUPPLEMENTAL PRINTS OF STANDARD CONSTRUCTION DRAWINGS

			HL-11	6-1-79	TC-41.20	3-26-79
			HL-12	4-6-73	TC-41.40	6-18-79
			HL-15	4-6-73	TC-42.20	3-26-79
			HL-16	4-6-73		
					TC-52.2	4-3-79
			HL-3	7-27-73	HL-19	3-22-77
			HL-4	9-6-73	TC-71.10	4-9-79
			HL-5	9-6-73	TC-81.10	4-10-79
			HL-7	9-6-73	TC-18.24	4-25-79
					TC-18.26	5-31-79
					TC-21.20	5-31-79
					TC-22.20	3-1-79
			HL-9	3-22-77	TC-85.10	4-18-79
			HL-10	6-1-79	TC-85.20	4-18-79

DEPARTMENT OF TRANSPORTATION
FEDERAL HIGHWAY ADMINISTRATION

APPROVED:

DIVISION ADMINISTRATOR

DATE

PROJECT ATB-84-13.61

DATE OF LETTING 19 CONTRACT NO.

PREPARED AND RECOMMENDED BY

RICHLAND ENGINEERING LIMITED
Consulting Engineers
MANSFIELD, CLEVELAND OHIO

A graphic scale bar labeled "SCALE IN FEET" with markings at 0, 50, 100, 150, 200, and 250 feet. The bar is divided into alternating black and white segments.

ASHTABULA COUNTY
ATB-84-13.61
R/W PLANS

ASHTABULA COUNTY
ATB-84-13.61
R/W PLANS

BRM-3X05(1)
END PROJECT
STA.729+54

END ACQUISITION
STA.729+07.11

BRM-3X05(1)
BEGIN PROJECT
STA.718+38.60

BEGIN ACQUISITION
STA.718+61.25

PATCH TRACT
IN LOT 3

~~Township 13~~
~~Township 12~~

✓ E. 46TH St. (S.R. 84)

Exist. R/W 7

§ E. 46TH St. (S.R. 84)

UTILITY OWNERS

TYPE	NAME AND ADDRESS
Electric	Cleveland Electric Illuminating Co. 2210 South Ridge West P.O. Box 668 Ashtabula, Ohio 44004
Telephone	Western Reserve Telephone Co. 4614 Park Ave. Ashtabula, Ohio 44236
Gas	East Ohio Gas Co. 1010 West 30 TH Street Ashtabula, Ohio 44004
Cable T.V.	Tele-Media of Lake Erie 5440 Main Ave. Ashtabula, Ohio 44030
Sanitary Sewer	Ashtabula County Court House Annex Jefferson, Ohio 44047
Water	Ohio-American Water Co. 4540 Park Ave. Ashtabula, Ohio 44004

CITY OF ASHTABULA, ASHTABULA COUNTY
IN LOTS 3 TOWNSHIP 12, IN LOT 1 TOWNSHIP 13 & PATCH TRACT TOWNSHIP 13
T. 12 & 13 R. 3

TYPE FUNDS.....BRM

COMPLETION DATE 7-30-84

[illegible]**PROPERTY MAP R/W**

SUMMARY OF ADDITIONAL RIGHT OF WAY REQUIRED

STATE JOB NUMBER	FHWA REGION	STATE	PROJECT
	5	OHIO	BRM-3X05(1)


ASHTABULA COUNTY
ATB- 84-13.61
R/W PLANS

TOTAL NO. OWNERS.....2
TOTAL TAKES.....0
STRUCTURE PARCELS.....0


PARCEL NO.	TYPE FUNDS	PROPERTY OWNER	PERMANENT PARCEL NO.	RECORDED		DEED AREA	TOTAL P.R.O.	GROSS TAKE	P.R.O. IN TAKE	NET TAKE	NET RESIDUE		BUILDING	SHT. NO.	REMARKS	AS ACQUIRED	
				VOLUME	PAGE						LEFT	RIGHT				VOLUME	PAGE
1-10		Not Assigned															
11		City of Ashtabula		No R/W Required													
12		Greater Ashtabula Service Corporation		No R/W Required													
13WD 13T	BRM	City of Ashtabula		701/702	668,669/449,456,460	37,570 S.F.		2110 Sq. Ft. 605 Sq. Ft.		2110 Sq. Ft. 605 Sq. Ft.	35,460 S.F.			3 3	Construct Structure & Remove Exist. Structure		
14-WD 14-S 14-T		City of Ashtabula		699	598	10,350 S.F.		458 Sq. Ft. 1190 Sq. Ft. 1190 Sq. Ft.		458 Sq. Ft. 1190 Sq. Ft. 1190 Sq. Ft.	9892 S.F.			3 3 3	Construct Structure & Remove Exist. Structure		
15 15-A 15-B 15-C 15-T 15-T-1 15-S		Ashtabula Township Park Board		192/194	448,512/330	10,672,200 S.F.		608 Sq. Ft. 635 Sq. Ft. 880 Sq. Ft. 235 Sq. Ft. 37,920 Sq. Ft. 42,040 Sq. Ft.		608 Sq. Ft. 635 Sq. Ft. 880 Sq. Ft. 235 Sq. Ft. 37,920 Sq. Ft. 42,040 Sq. Ft.	4,266,697 S.F. 6,403,145 S.F.			3 3 5 5 3-5 3-5	Construct Structure & Remove Exist. Structure Construct Structure " " "		
16 17	BRM	R. Richard & Judith M. Brown Ted P. & Frances C. Norris		No R/W Required No R/W Required													
18		I. & F. Enterprises, Incorporated		No R/W Required													
19		Sallie Carter		No R/W Required													
20		Joseph J. & Marianne C. Birmingham		No R/W Required													
21		John L. & Donna D. McLean		No R/W Required													
22		Deborah Jean Boyd		No R/W Required													

COMPLETION DATE	REV.	DATE	DESCRIPTION	REV.	DATE	DESCRIPTION
7-30-84						

3-8-85 Changed Pels 15-WD, 15-WD-1, 15-WD-2 & 15-WD-3 To 15, 15-A, 15-B & 15-C (Standard Highway Easements)
12-31-84 REVISED TBA Pels 14-WD, 15-WD & 15-T-1 & Revised Bridge Pels 14-WD & 15-WD

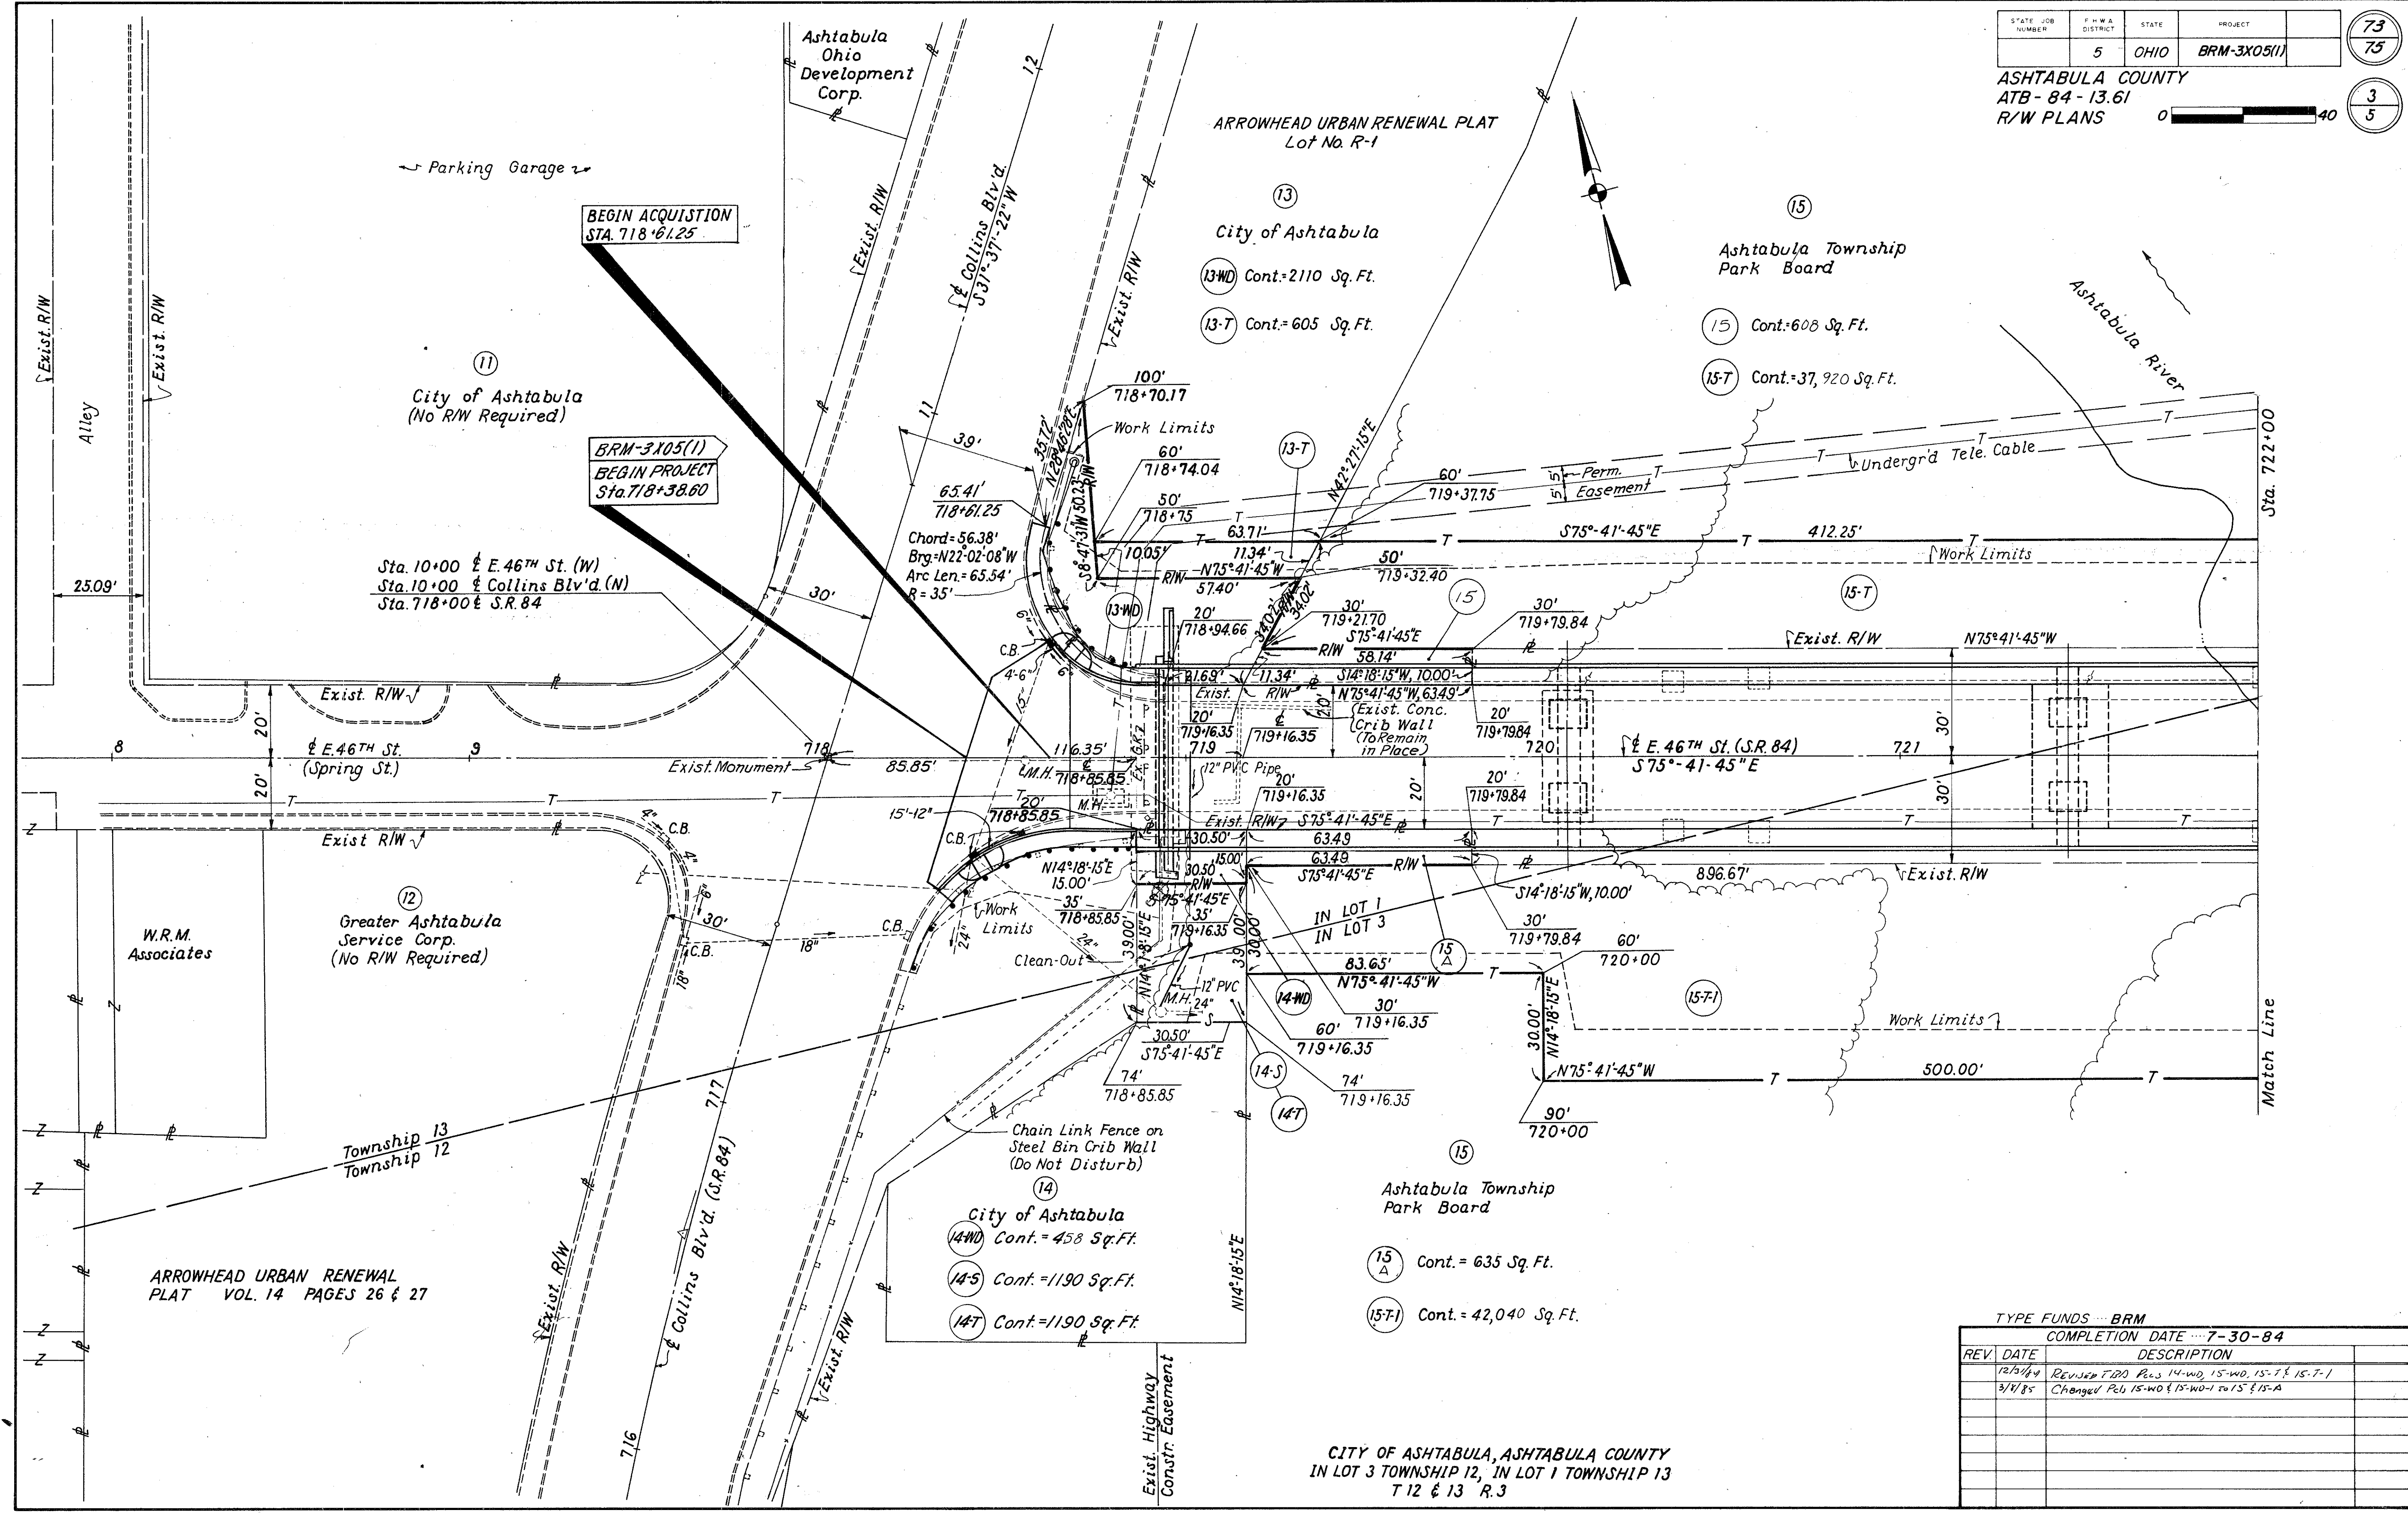

TYPE FUNDS - BRM		COMPLETION DATE - 7-30-84	
REV.	DATE	DESCRIPTION	
12/3/84		Revised F.O.D. P.L. 14-WD, 15-WD, 15-T & 15-T-1	
3/1/85		Changed P.L. 15-WD & 15-WD-1 to 15-T & 15-A	

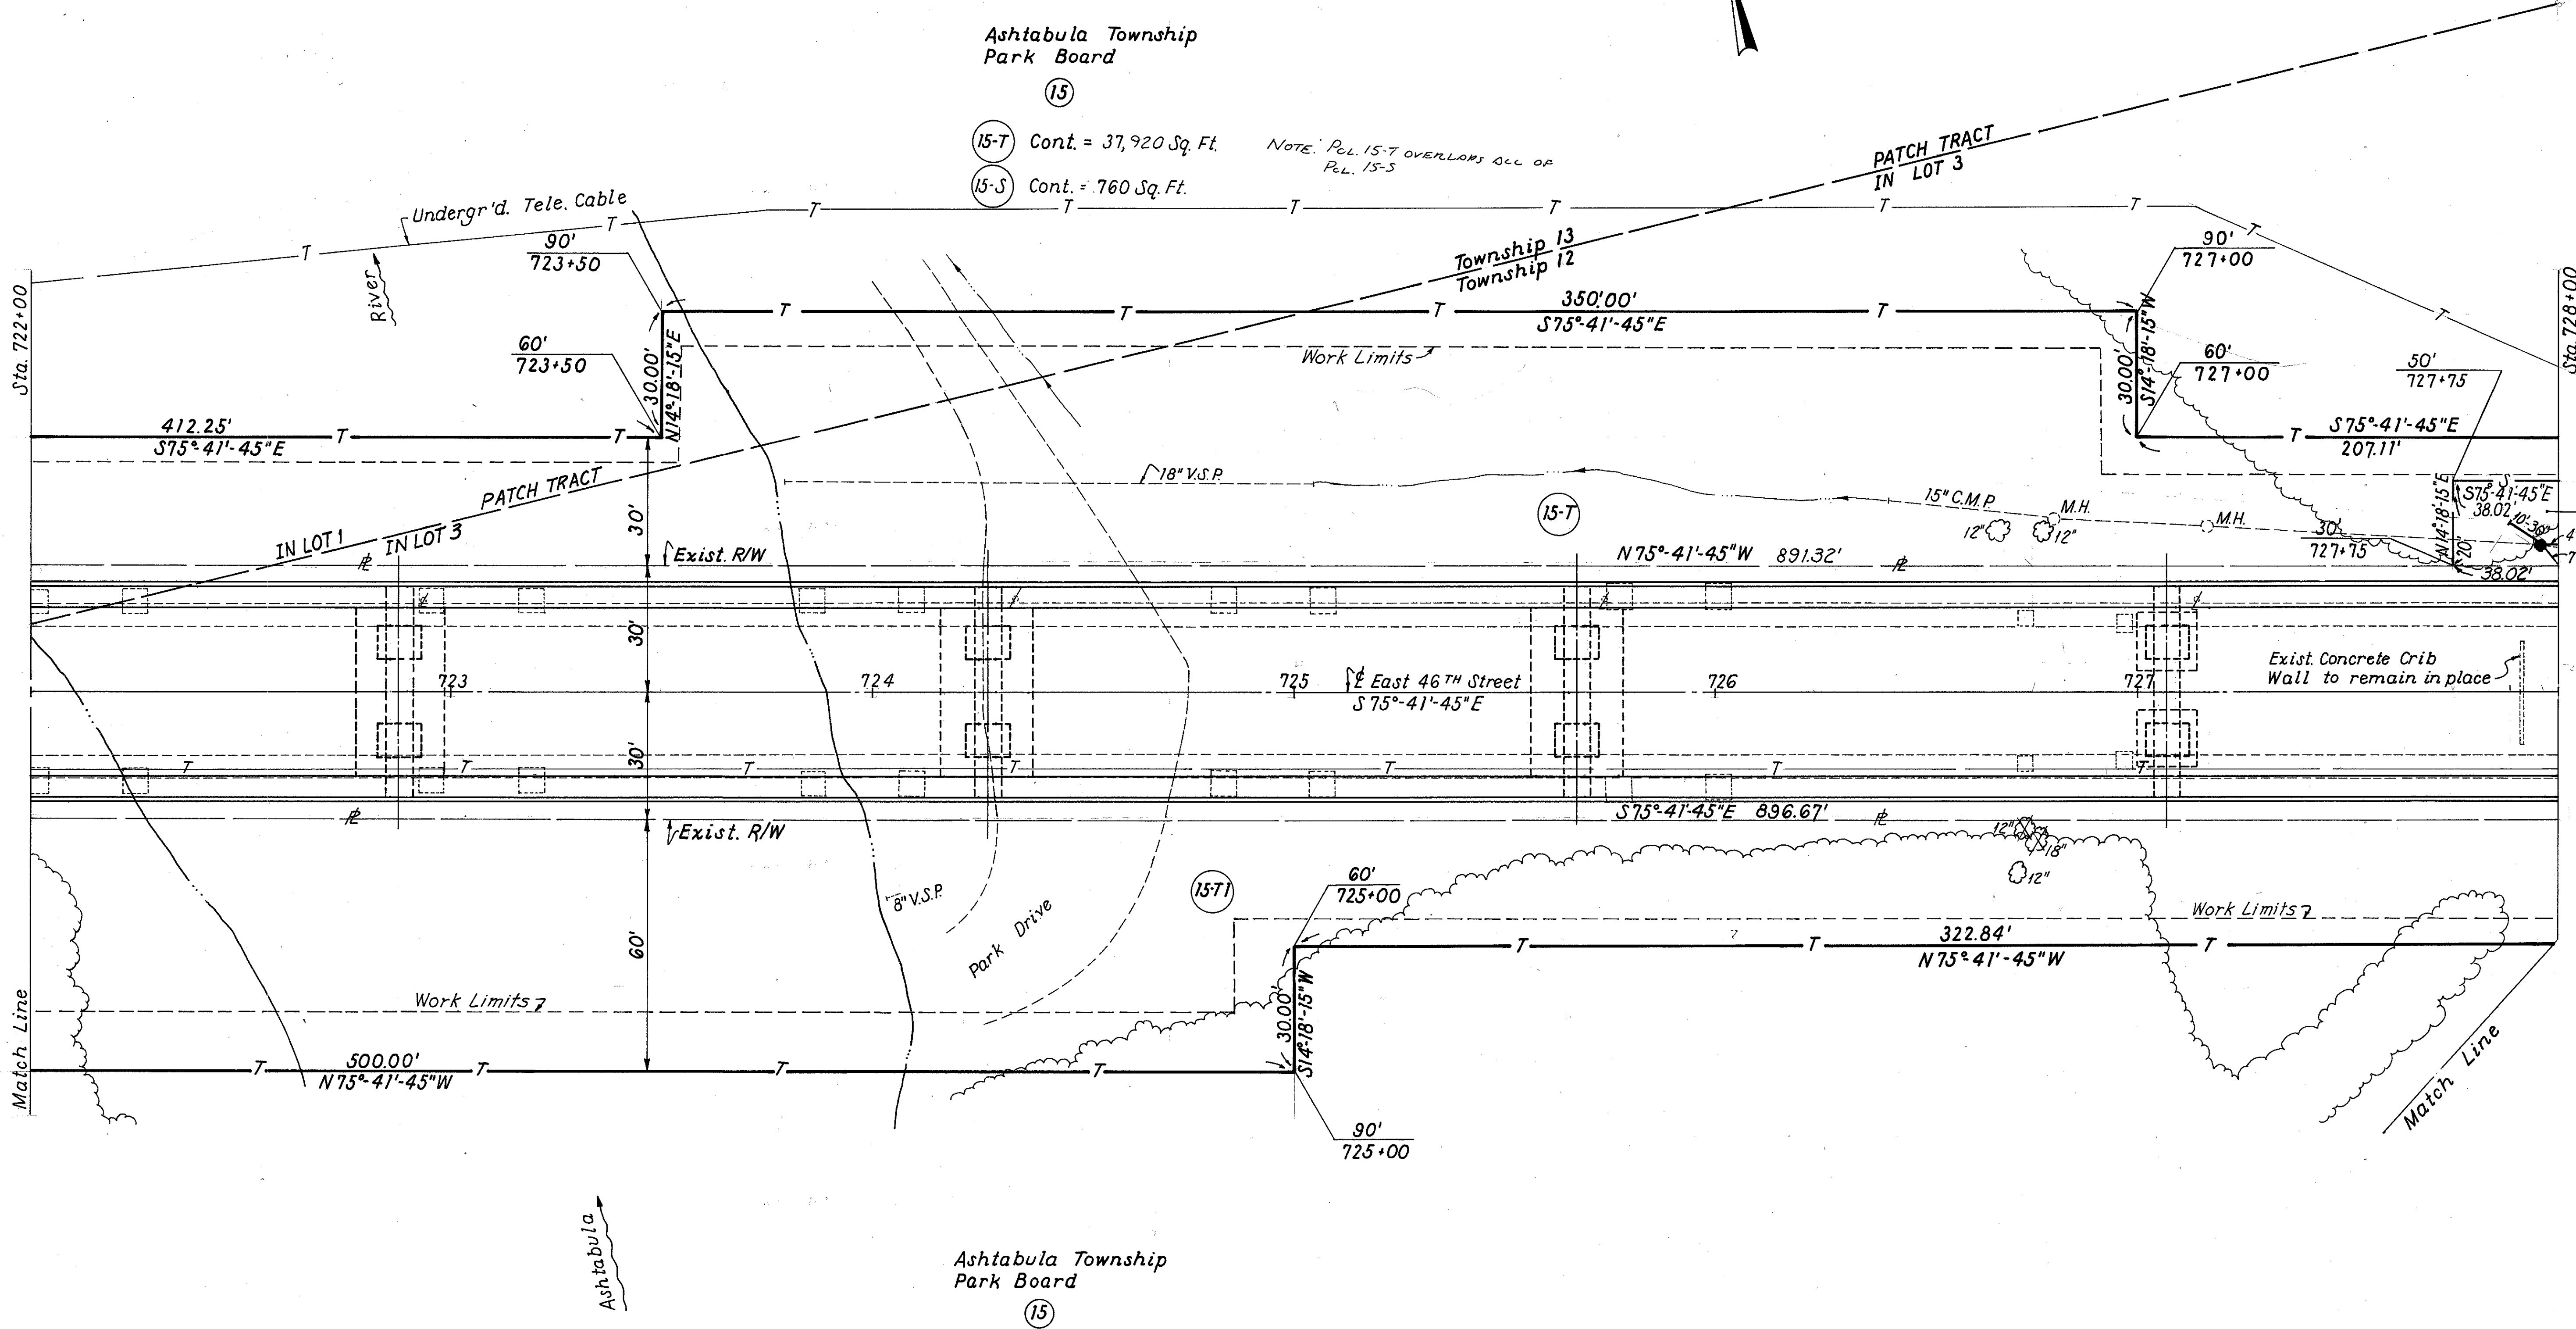

CITY OF ASHTABULA, ASHTABULA COUNTY
IN LOT 3 TOWNSHIP 12, IN LOT 1 TOWNSHIP 13 & PATCH TRACT TOWNSHIP 13
T 12 & 13 R 3

TYPE FUNDS - BRM		COMPLETION DATE - 7-30-84	
REV.	DATE	DESCRIPTION	
	12/9/84	REVISED T&A P.C.L. 15-T, 15-S-1	

