


USZO + WEST AVE. N
50

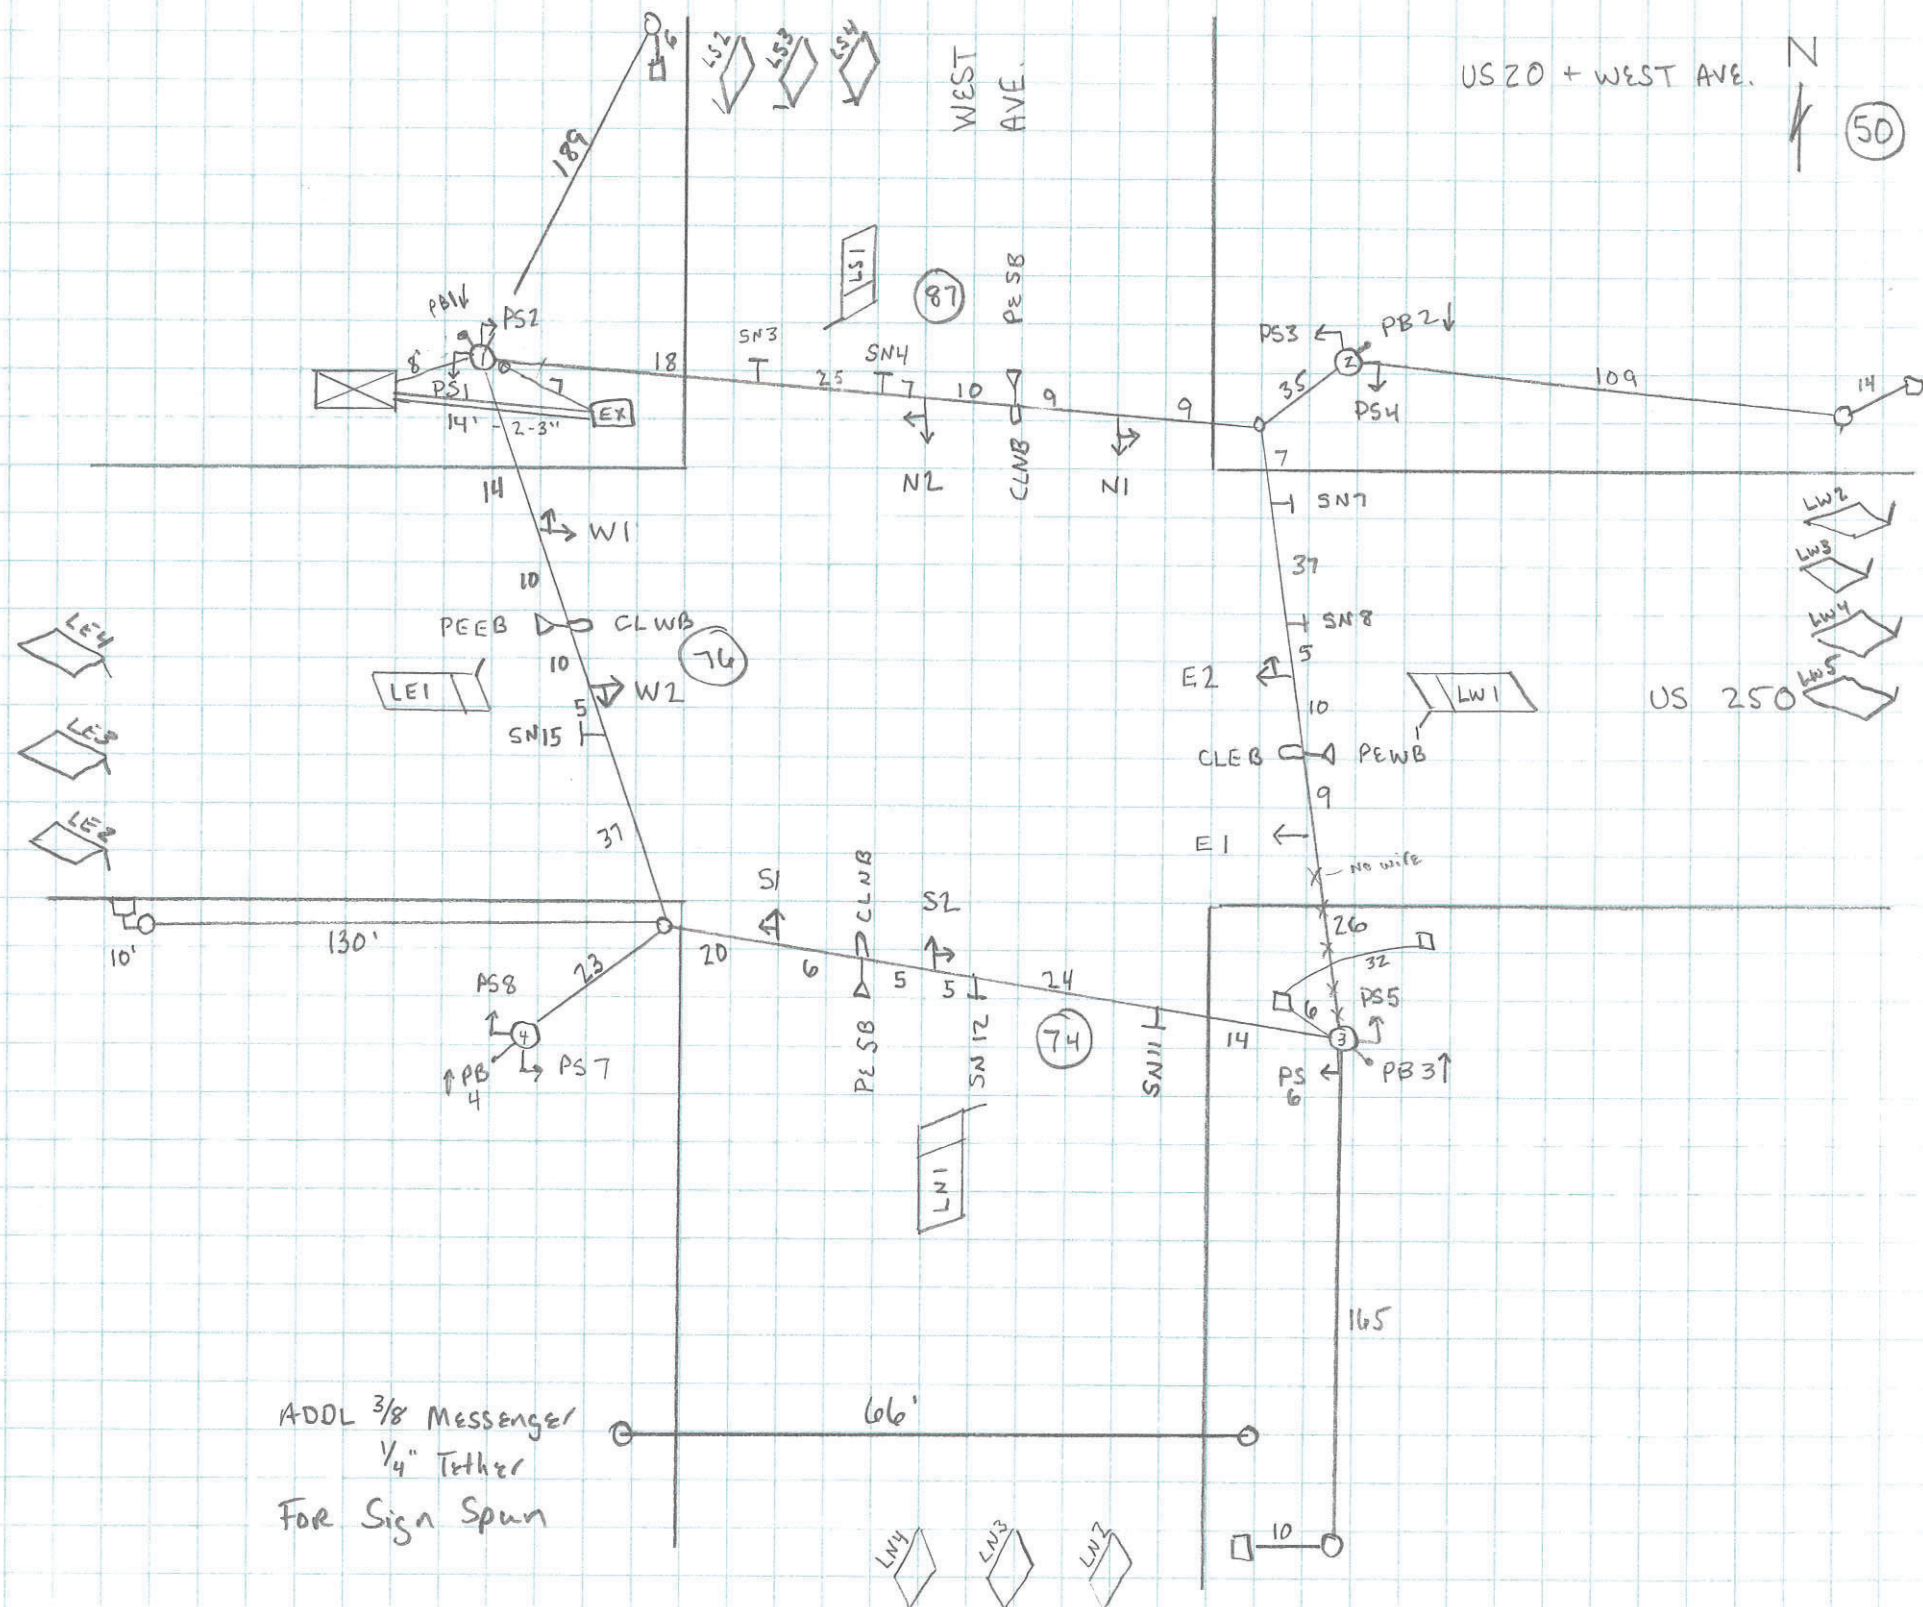

ADDL 3/8 Messenger
1/4" Tether
For Sign Spun