
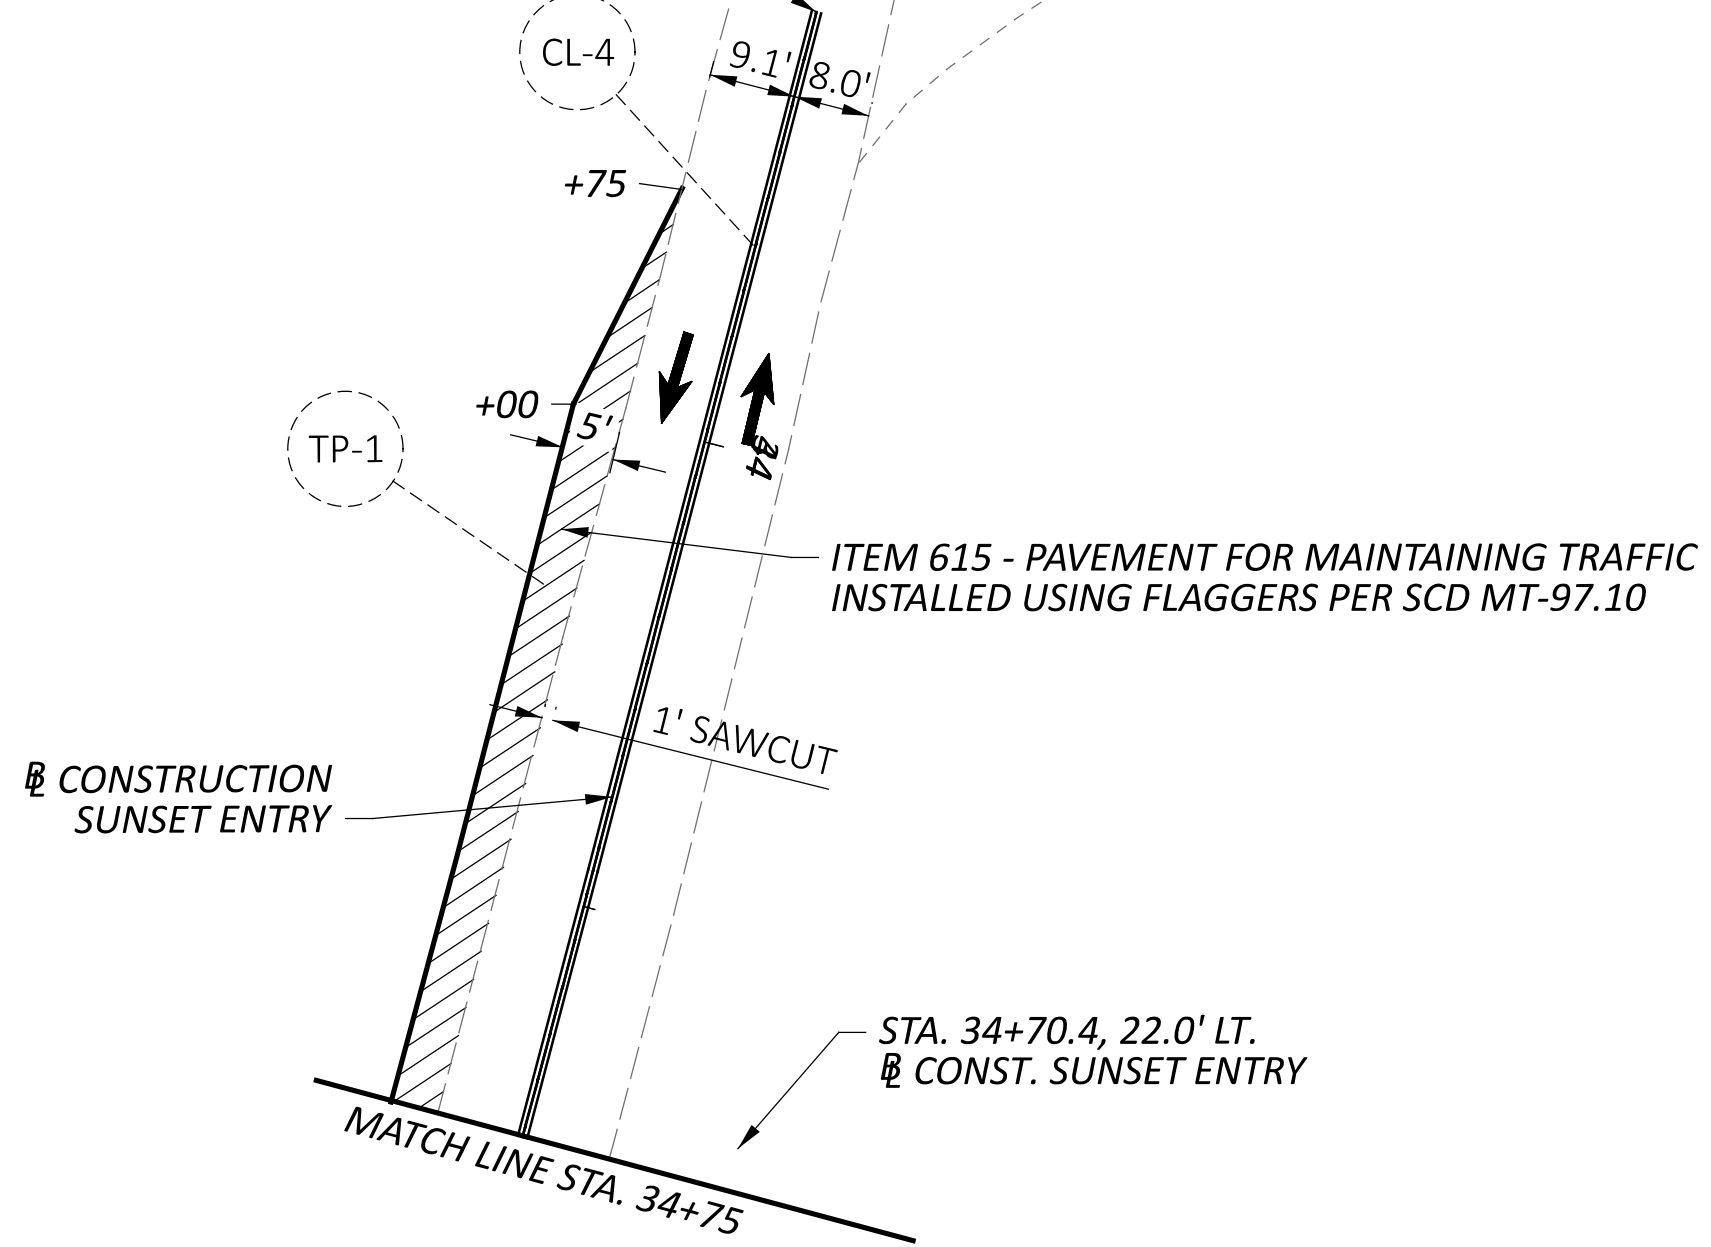



# SUNSET LANE

END WZ CENTERLINE  
STA. 34+54.0  
CONST. SUNSET ENTRY

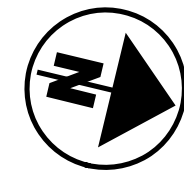


# RAMP B


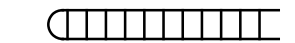

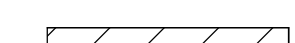


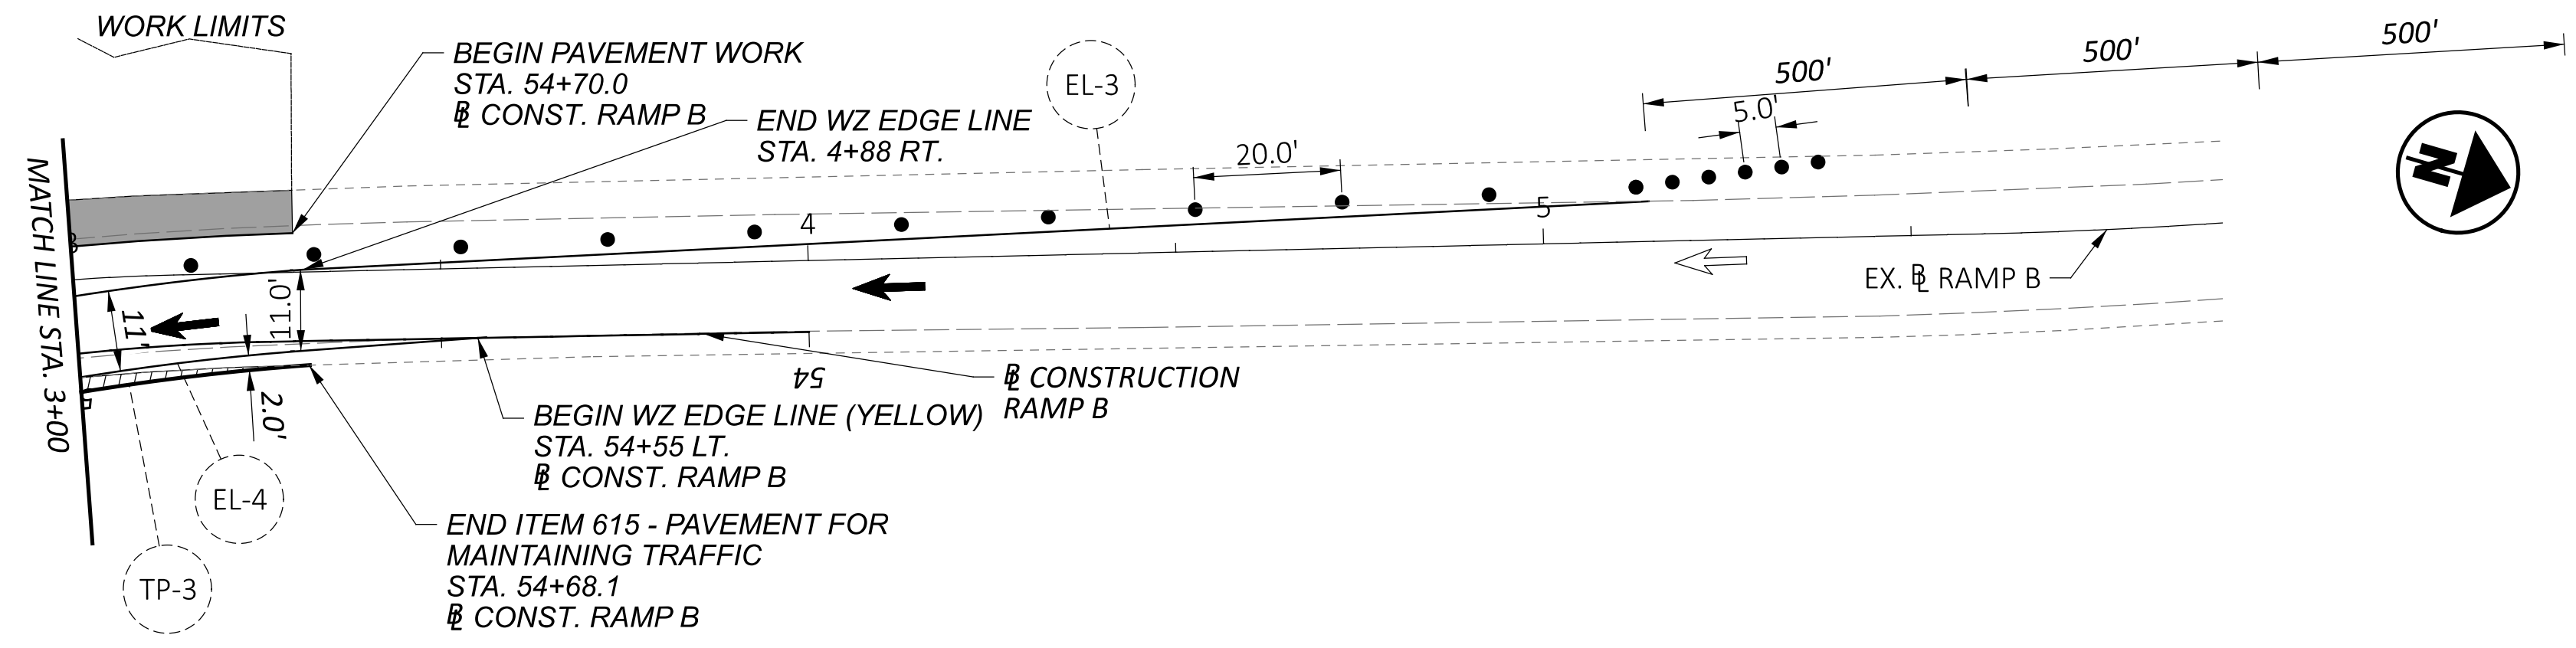

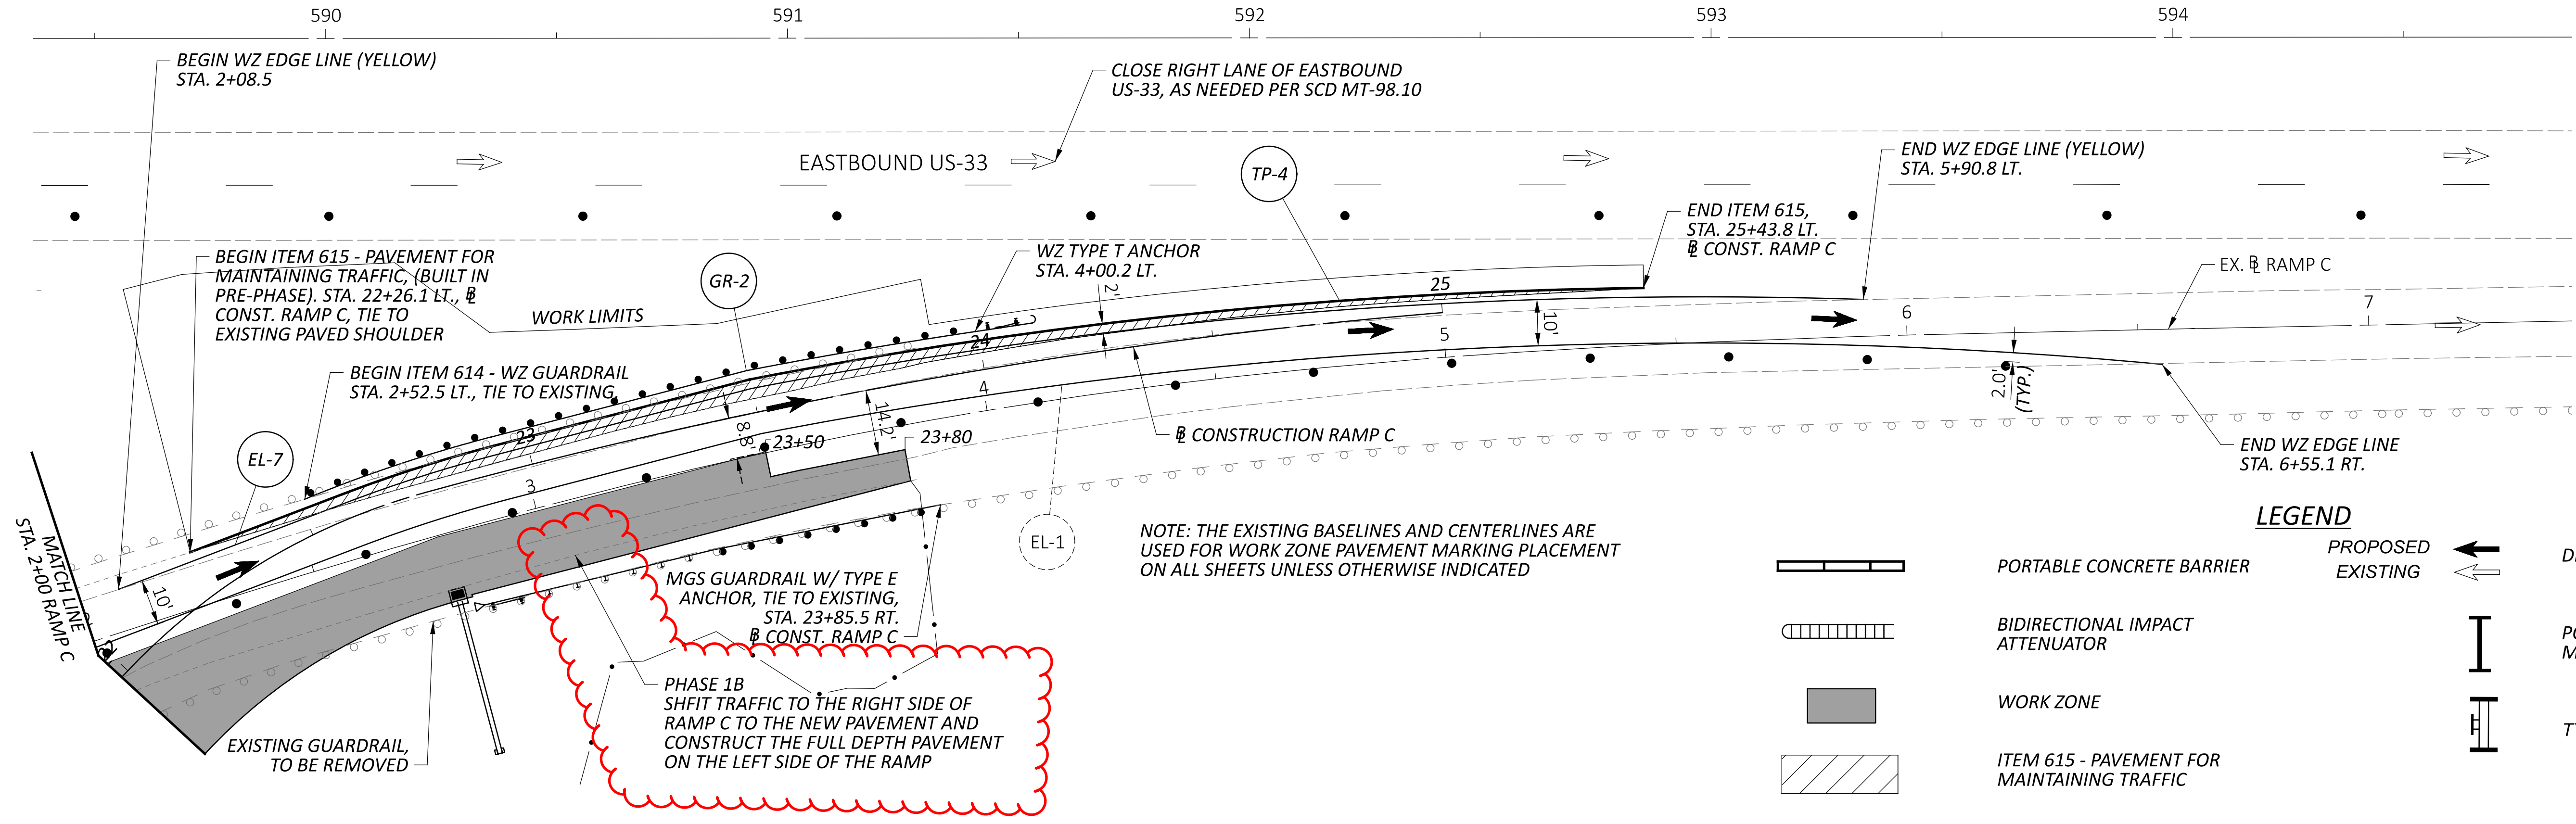

(NOT TO SCALE)




# RAMP C




### LEGEND

-  PORTABLE CONCRETE BARRIER
-  BIDIRECTIONAL IMPACT ATTENUATOR
-  WORK ZONE
-  ITEM 615 - PAVEMENT FOR MAINTAINING TRAFFIC
-  DRUMS
-  PROPOSED
-  EXISTING
-  DIRECTION OF TRAFFIC
-  PORTABLE CHANGEABLE MESSAGE SIGN
-  TYPE III BARRICADE




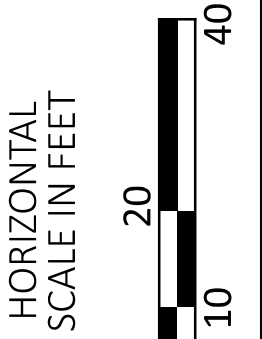


## MAINTENANCE OF TRAFFIC PHASE ONE

DESIGN AGENCY	
	
DESIGNER	MS
REVIEWER	JGW 07/10/24
PROJECT ID	118465
SHEET	TOTAL
23	240

# SR-682 SOUTH

NOTE: THE EXISTING BASELINES AND CENTERLINES ARE USED FOR WORK ZONE PAVEMENT MARKING PLACEMENT ON ALL SHEETS UNLESS OTHERWISE INDICATED

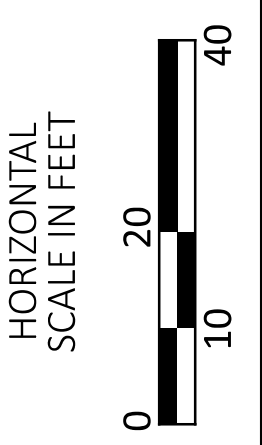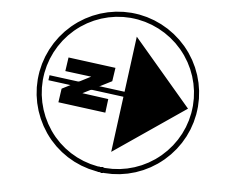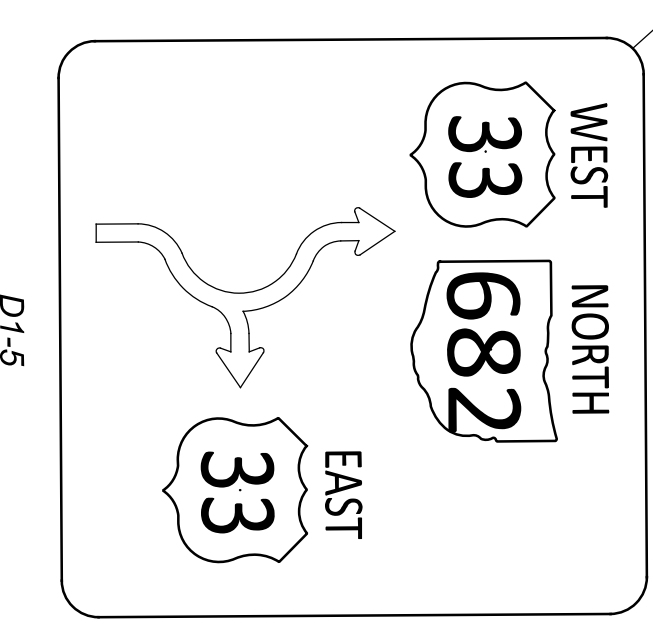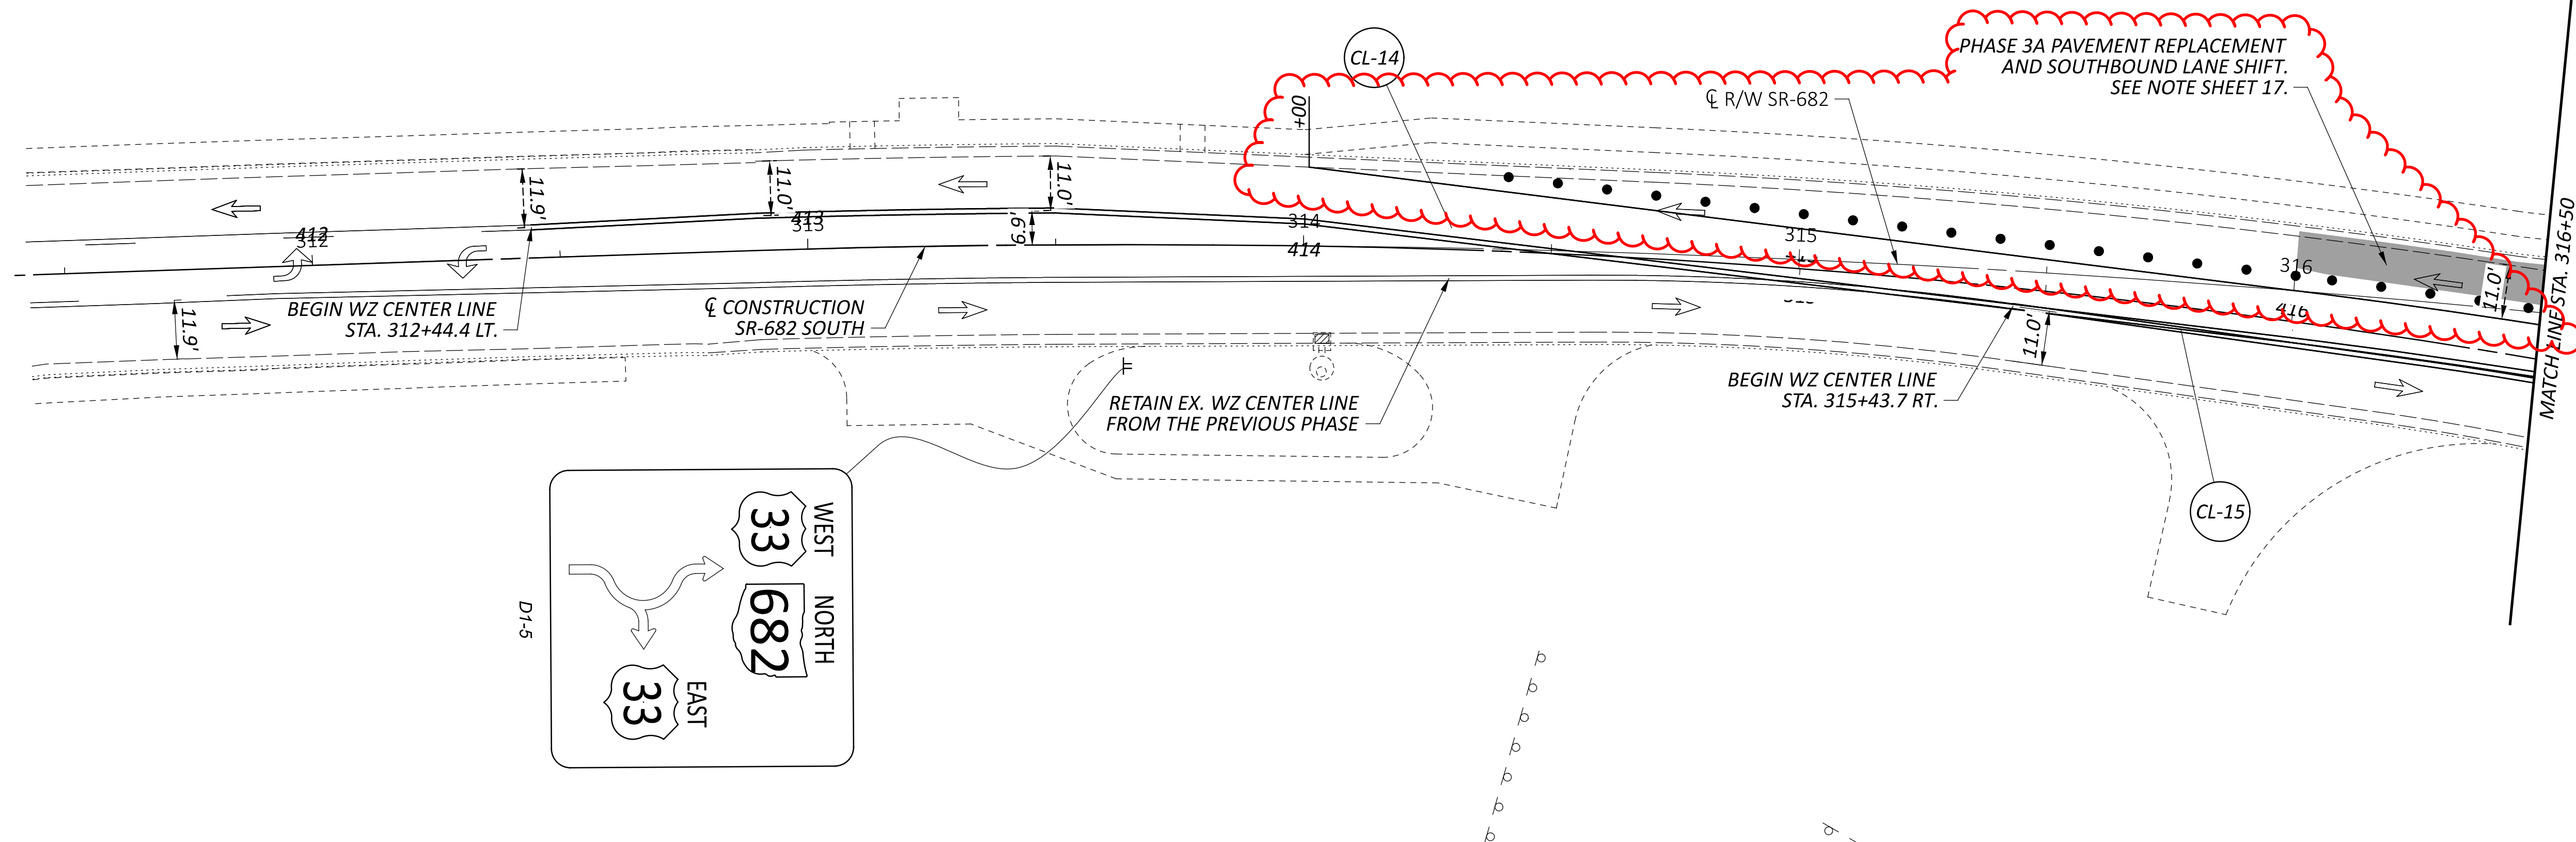


## MAINTENANCE OF TRAFFIC PHASE THREE

**LEGEND**




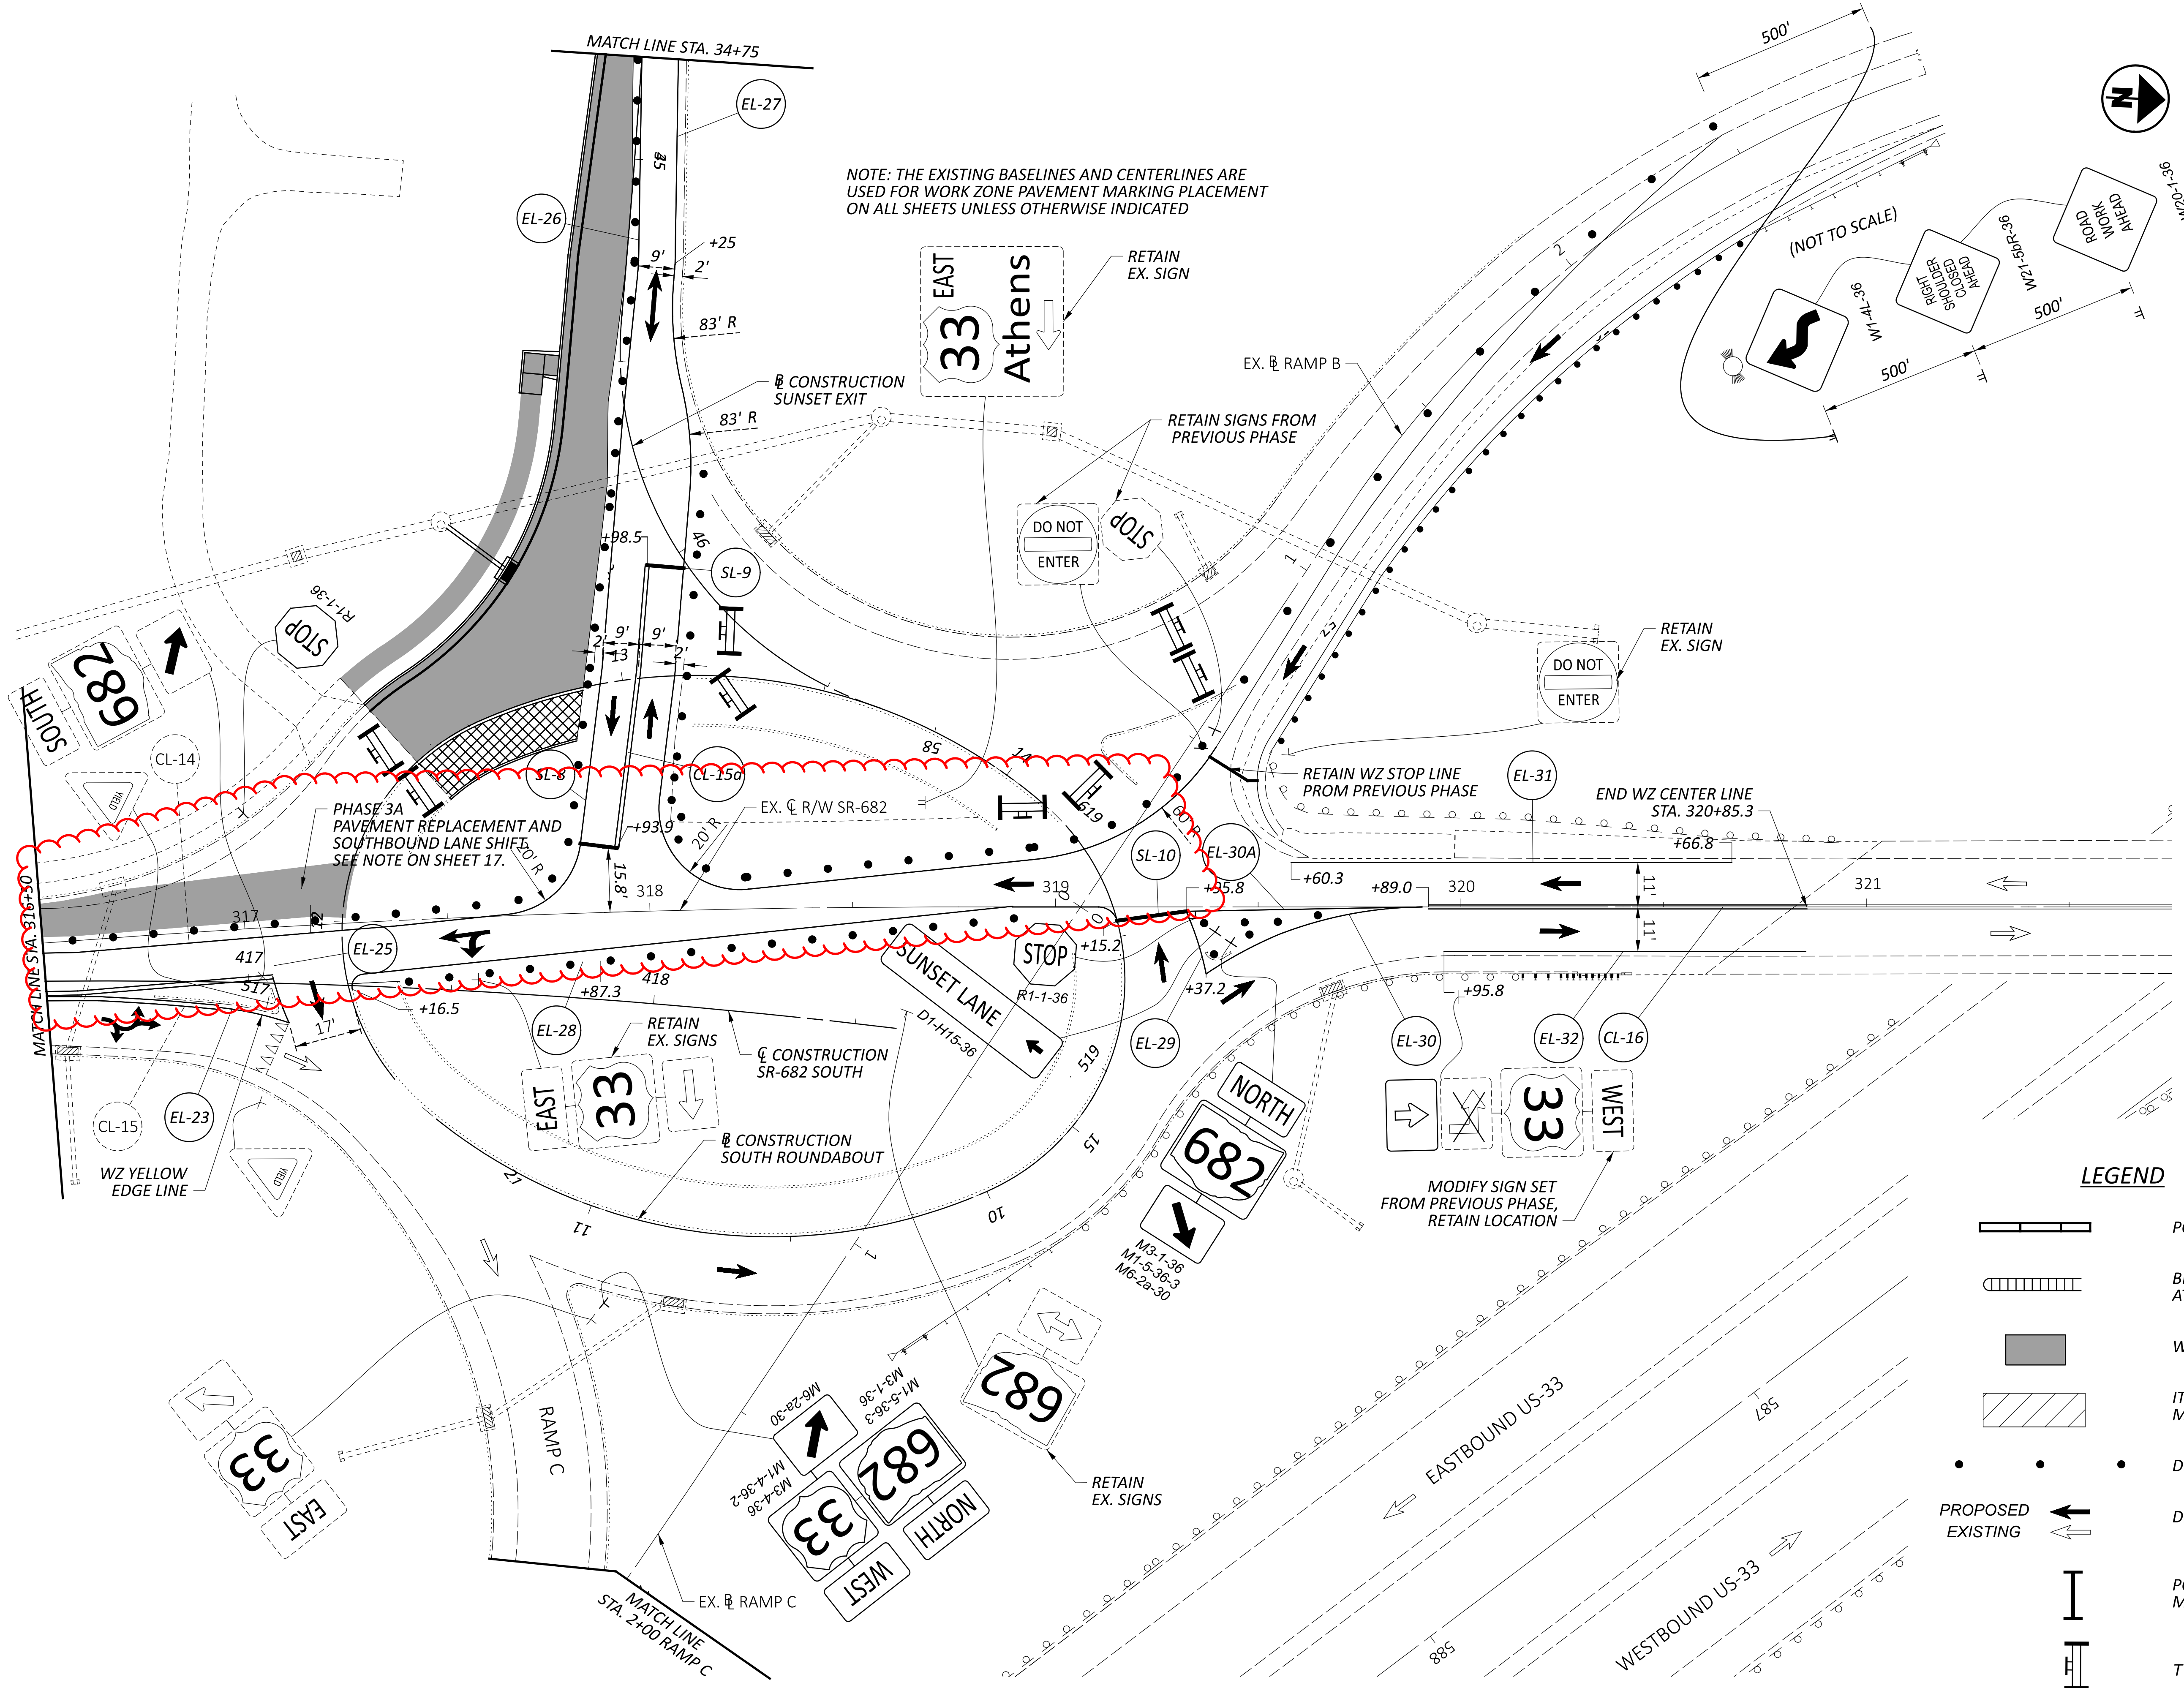




	PORTABLE CONCRETE BARRIER
	BIDIRECTIONAL IMPACT ATTENUATOR
	WORK ZONE
	ITEM 615 - PAVEMENT FOR MAINTAINING TRAFFIC
	DRUMS
	DIRECTION OF TRAFFIC
	PORTABLE CHANGEABLE MESSAGE SIGN
	TYPE III BARRICADE


DESIGN AGENCY	
DESIGNER	MS
REVIEWER	JGW 07/10/24
PROJECT ID	118465
SHEET	TOTAL
31	240

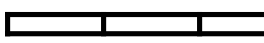


NOTE: THE EXISTING BASELINES AND CENTERLINES ARE USED FOR WORK ZONE PAVEMENT MARKING PLACEMENT ON ALL SHEETS UNLESS OTHERWISE INDICATED


**LEGEND**

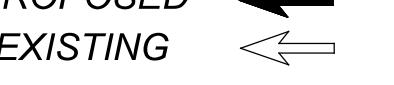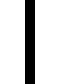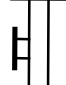-  PORTABLE CONCRETE BARRIER
-  BIDIRECTIONAL IMPACT ATTENUATOR
-  WORK ZONE
-  ITEM 615 - PAVEMENT FOR MAINTAINING TRAFFIC
-  DRUMS
-  DIRECTION OF TRAFFIC  
 PROPOSED ←  
 EXISTING →
-  PORTABLE CHANGEABLE MESSAGE SIGN
-  TYPE III BARRICADE

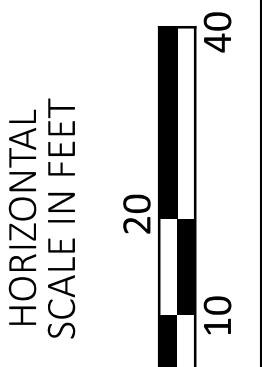

**MAINTENANCE OF TRAFFIC  
PHASE THREE**


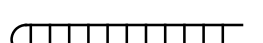


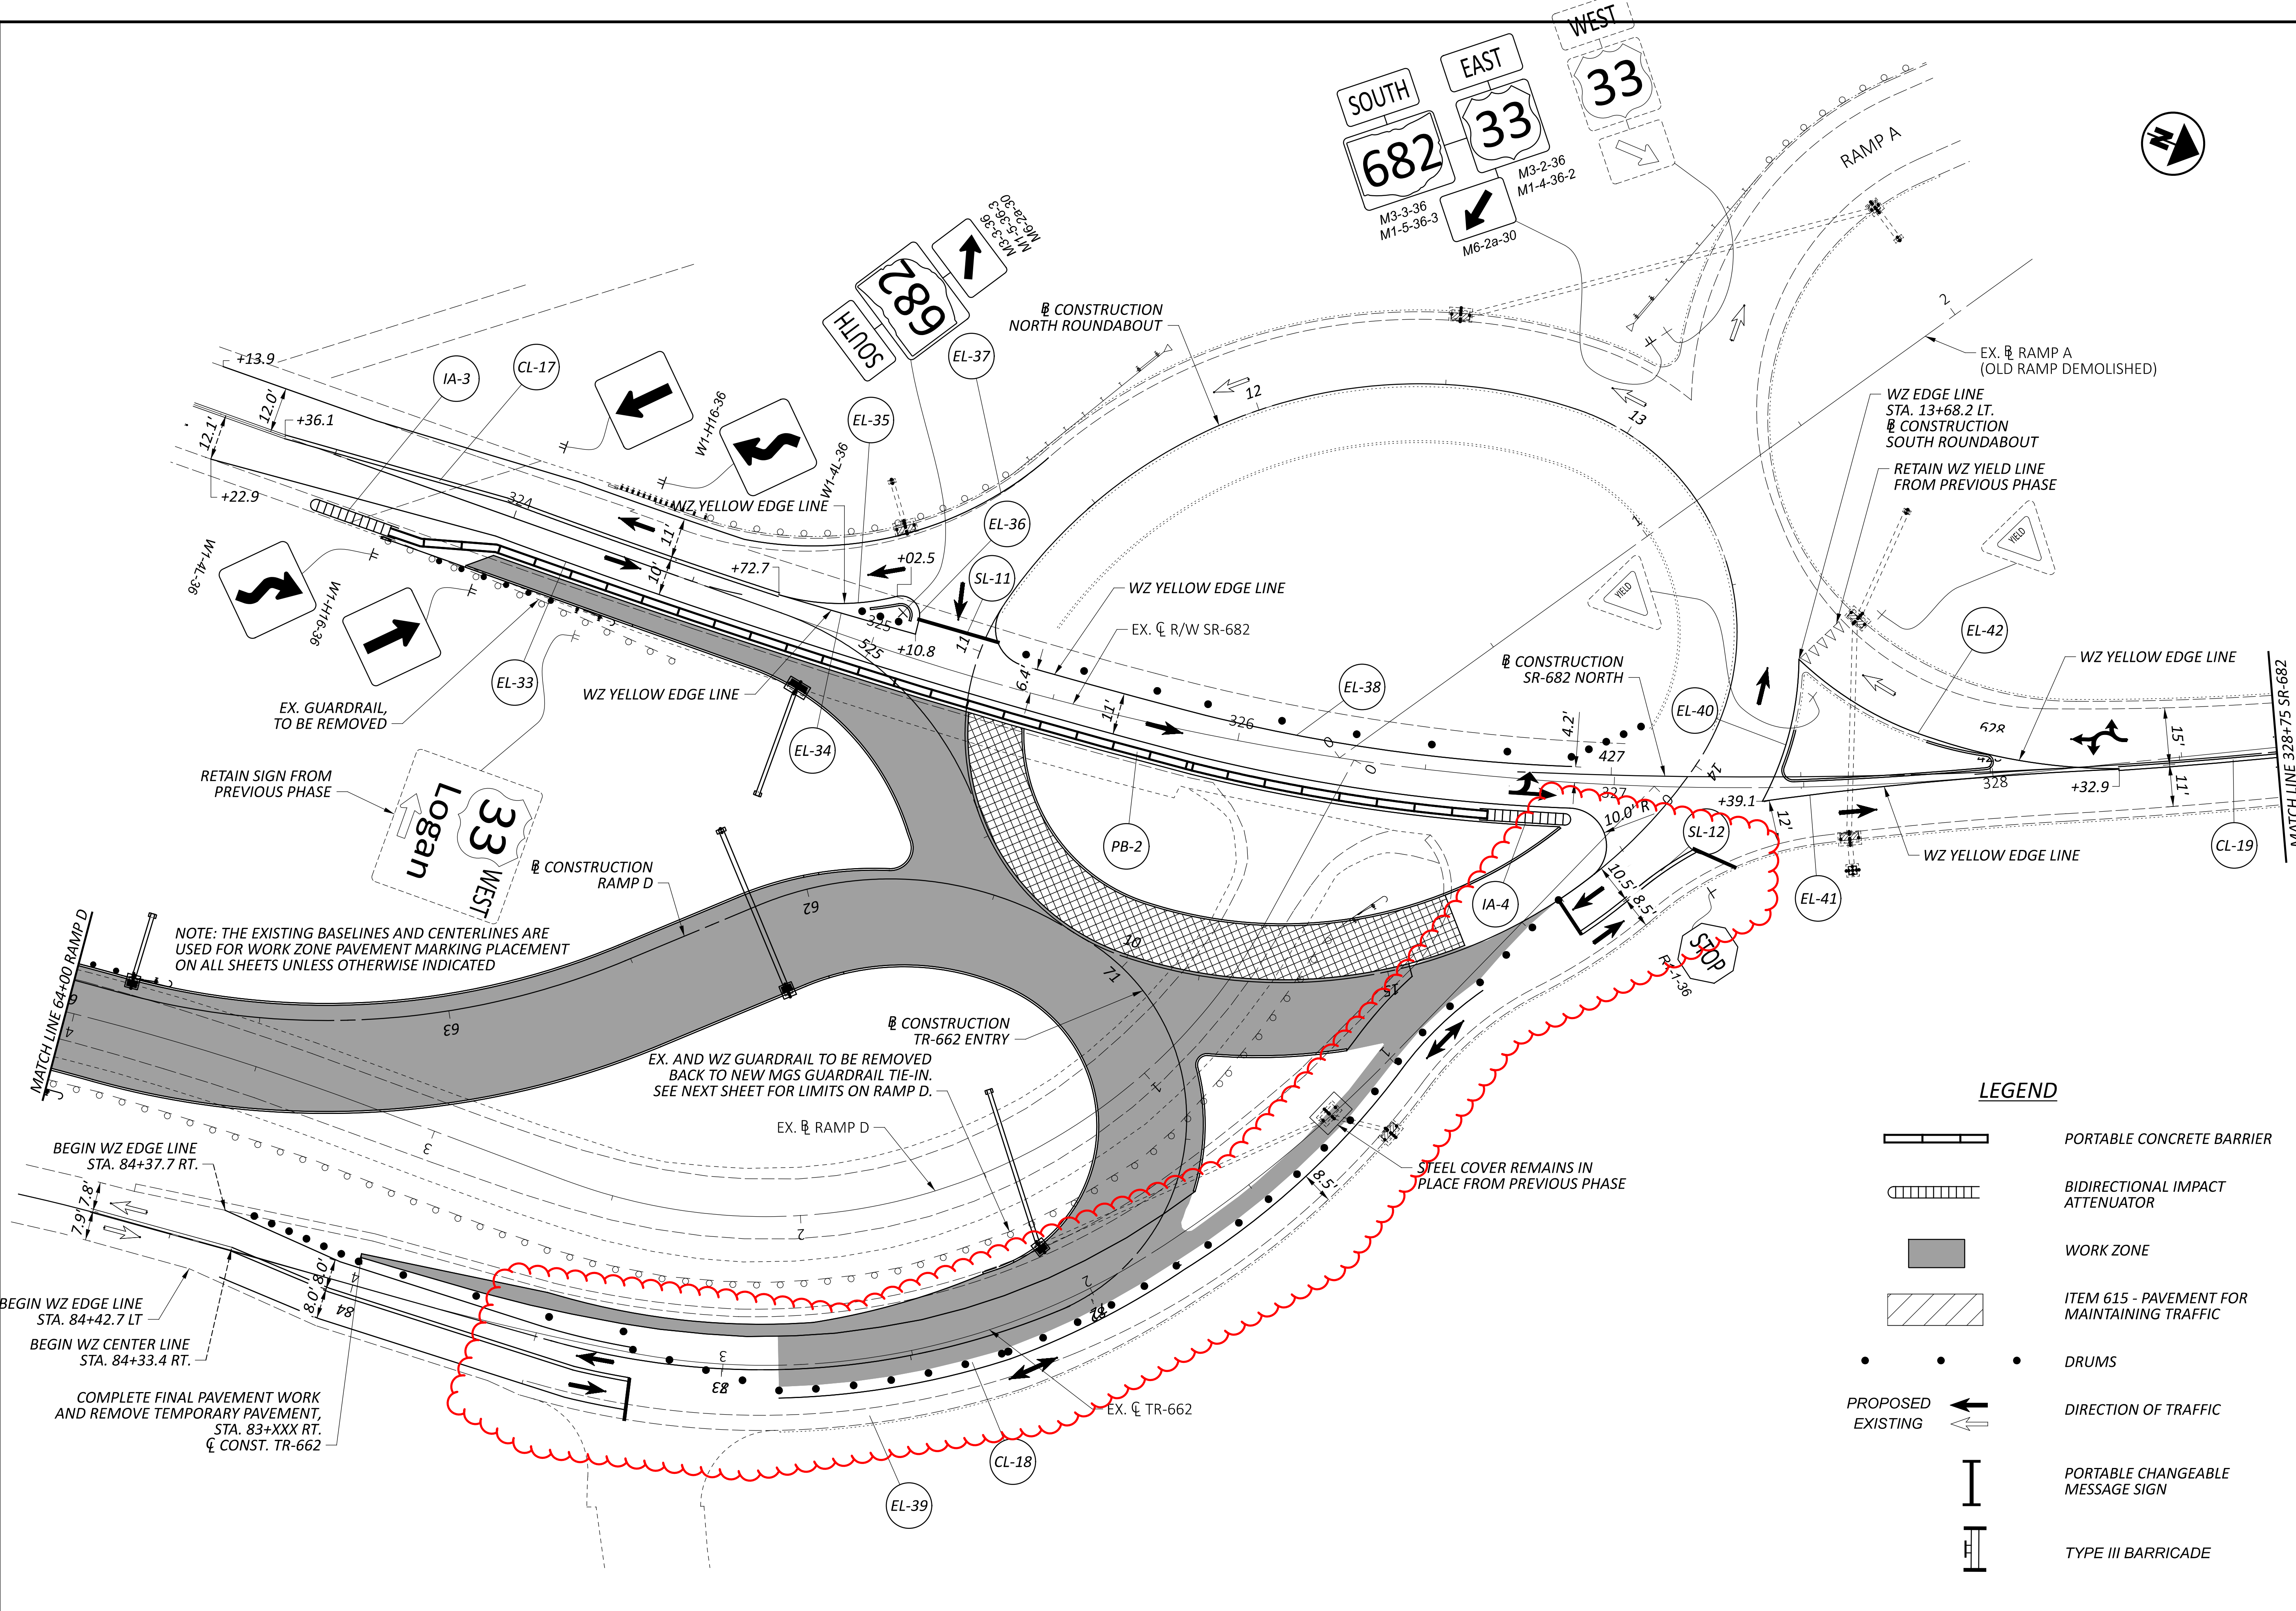
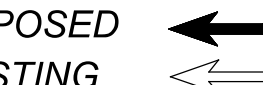


DESIGN AGENCY	
	
DESIGNER	MS
REVIEWER	JGW 07/10/24
PROJECT ID	118465
SHEET	TOTAL
32	240




NOTE: THE EXISTING BASELINES AND CENTERLINES ARE USED FOR WORK ZONE PAVEMENT MARKING PLACEMENT ON ALL SHEETS UNLESS OTHERWISE INDICATED


EX. AND WZ GUARDRAIL TO BE REMOVED BACK TO NEW MGS GUARDRAIL TIE-IN. SEE NEXT SHEET FOR LIMITS ON RAMP D.




**LEGEND**

-  PORTABLE CONCRETE BARRIER
-  BIDIRECTIONAL IMPACT ATTENUATOR
-  WORK ZONE
-  ITEM 615 - PAVEMENT FOR MAINTAINING TRAFFIC
-  DRUMS
-  DIRECTION OF TRAFFIC
-  PORTABLE CHANGEABLE MESSAGE SIGN
-  TYPE III BARRICADE

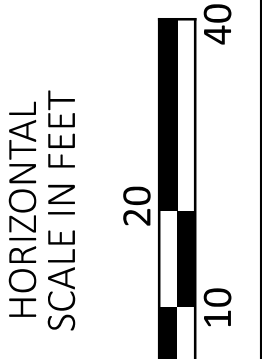







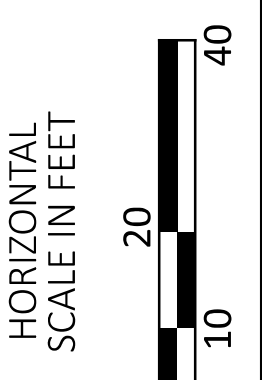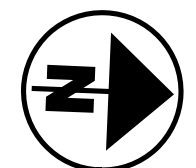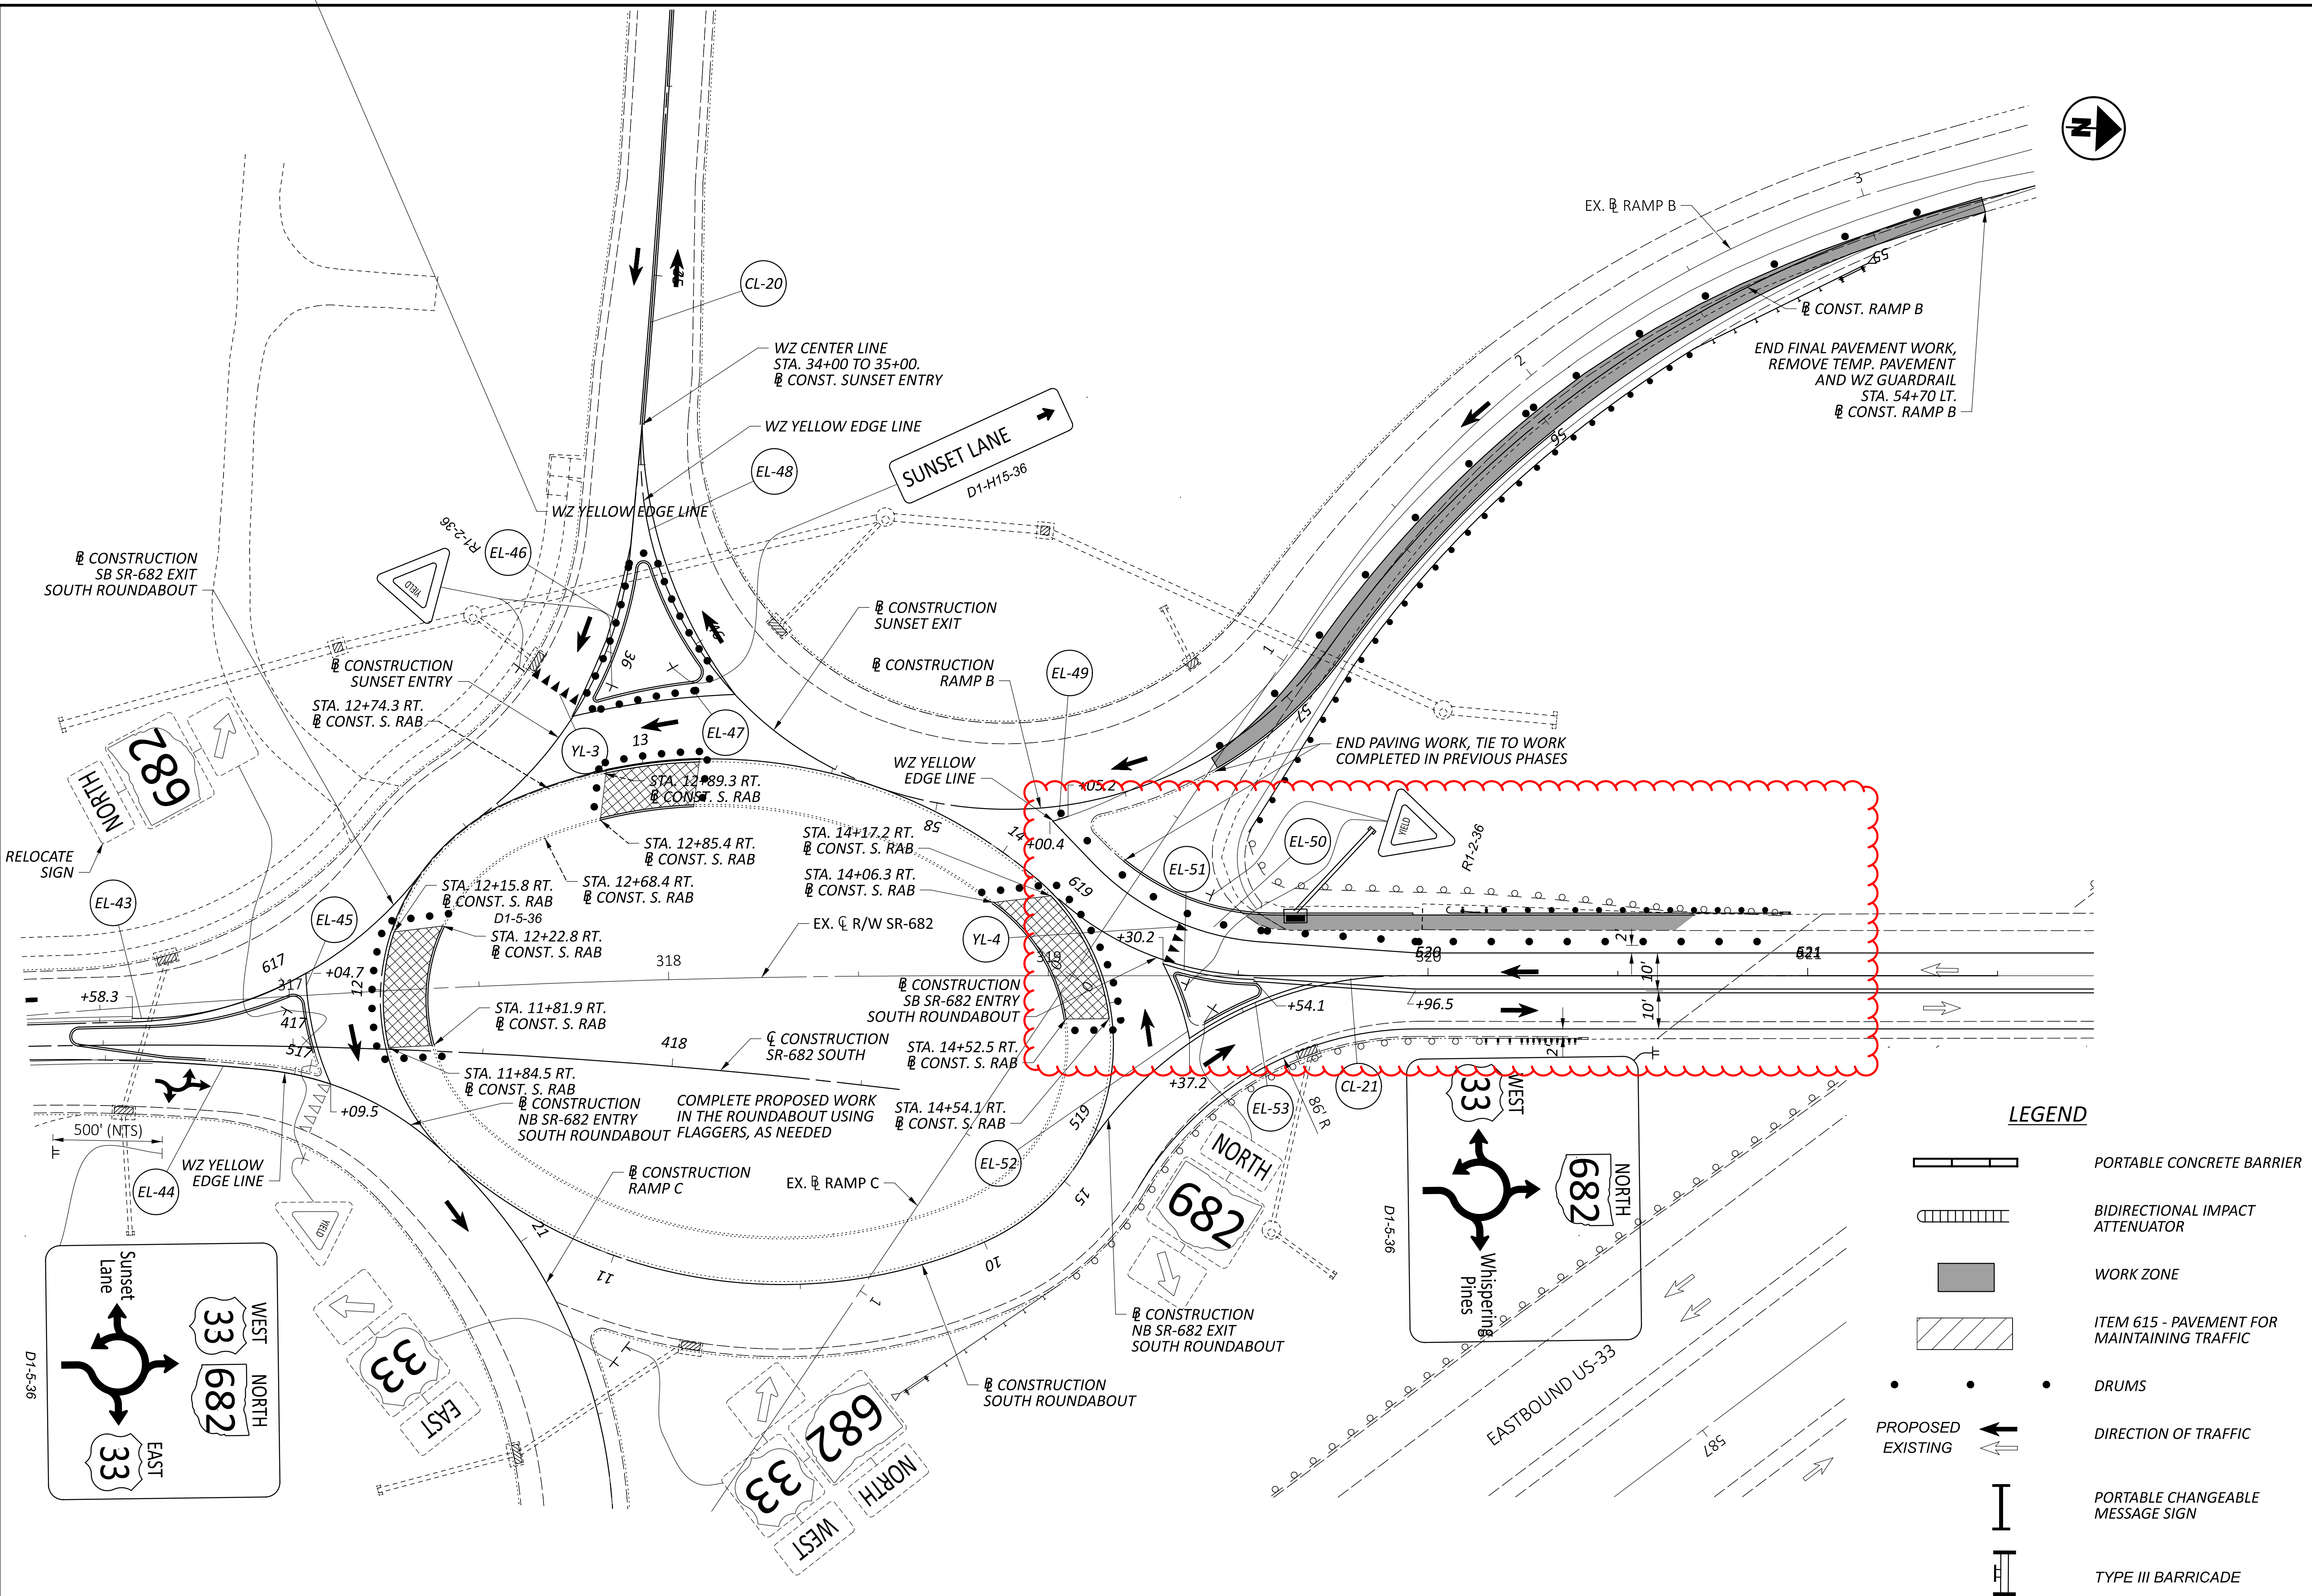

**MAINTENANCE OF TRAFFIC  
PHASE THREE**



DESIGN AGENCY	
DESIGNER	MS
REVIEWER	JGW 07/10/24
PROJECT ID	118465
SHEET	TOTAL
34	240

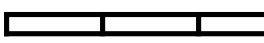

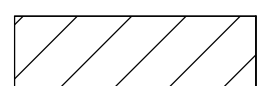
**MAINTENANCE OF TRAFFIC  
PHASE FOUR**

**LEGEND**

-  PORTABLE CONCRETE BARRIER
-  BIDIRECTIONAL IMPACT ATTENUATOR
-  WORK ZONE
-  ITEM 615 - PAVEMENT FOR MAINTAINING TRAFFIC
-  DRUMS
-  DIRECTION OF TRAFFIC
-  PORTABLE CHANGEABLE MESSAGE SIGN
-  TYPE III BARRICADE

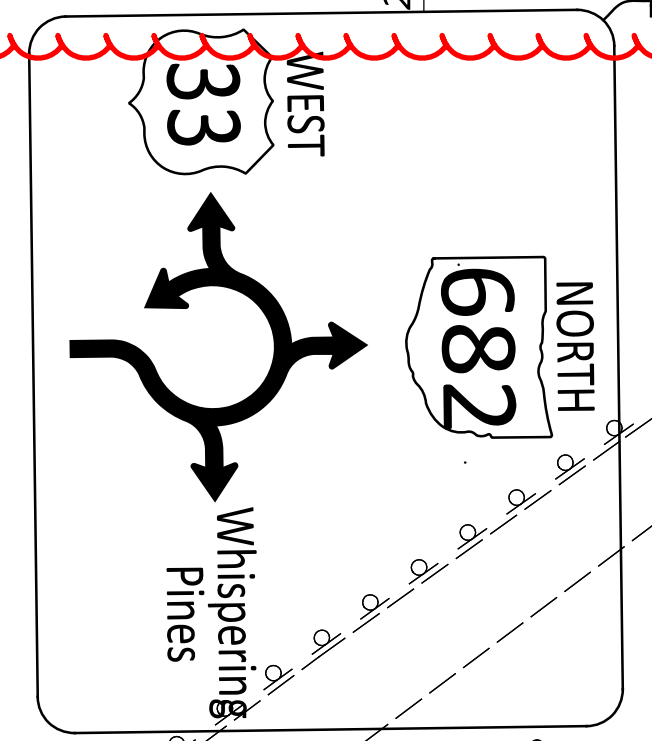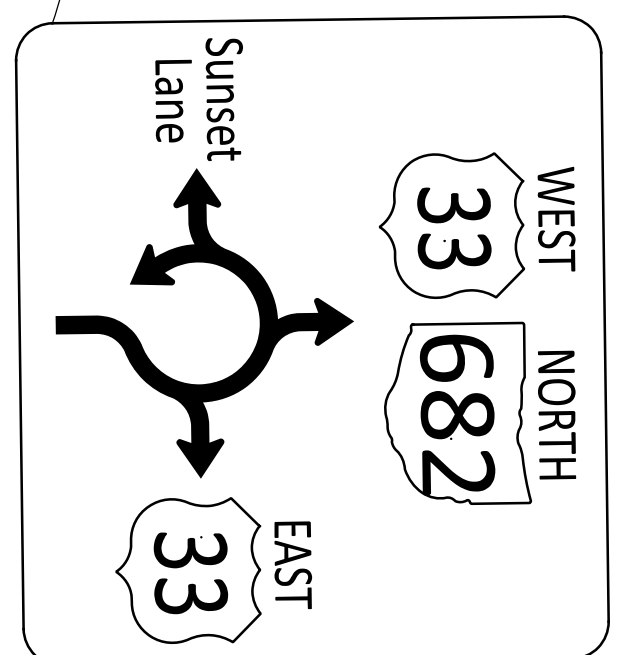

DESIGN AGENCY	
DESIGNER	MS
REVIEWER	JGW 07/10/24
PROJECT ID	118465
SHEET	36
TOTAL	240