




**ADDED THE CFN # PER
OHE REQUEST**


**ADDED THE CFN # PER
OHE REQUEST**

**REVISED THE DATE FROM
06/22/26 TO 08/17/26**

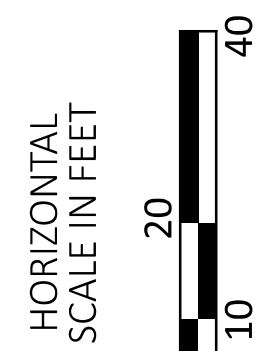

PLAN - RAMP A - STA. 1372+00.00 TO STA. 1376+09.71
PLAN - EASTBOUND PARKING - STA. 5376+09.71 TO STA. 5376+50.00

DESIGN AGENCY

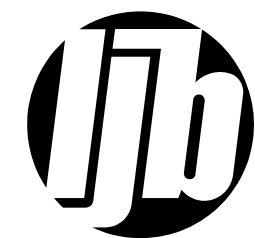

DESIGNER	
KGR	
REVIEWER	
RN	08/17/26
PROJECT ID	
122894	
SHEET	TOTAL
P.30	143

ADDED THE CFN #
PER OHE REQUEST

ADDED THE CFN #
PER OHE REQUEST

ADDED THE CFN #
PER OHE REQUEST


ADDED THE CFN #
PER OHE REQUEST

ADDED THE CFN #
PER OHE REQUEST

ADDED THE CFN #
PER OHE REQUEST

ADDED THE CFN #
PER OHE REQUEST

REVISED THE DATE FROM
06/22/26 TO 08/17/26

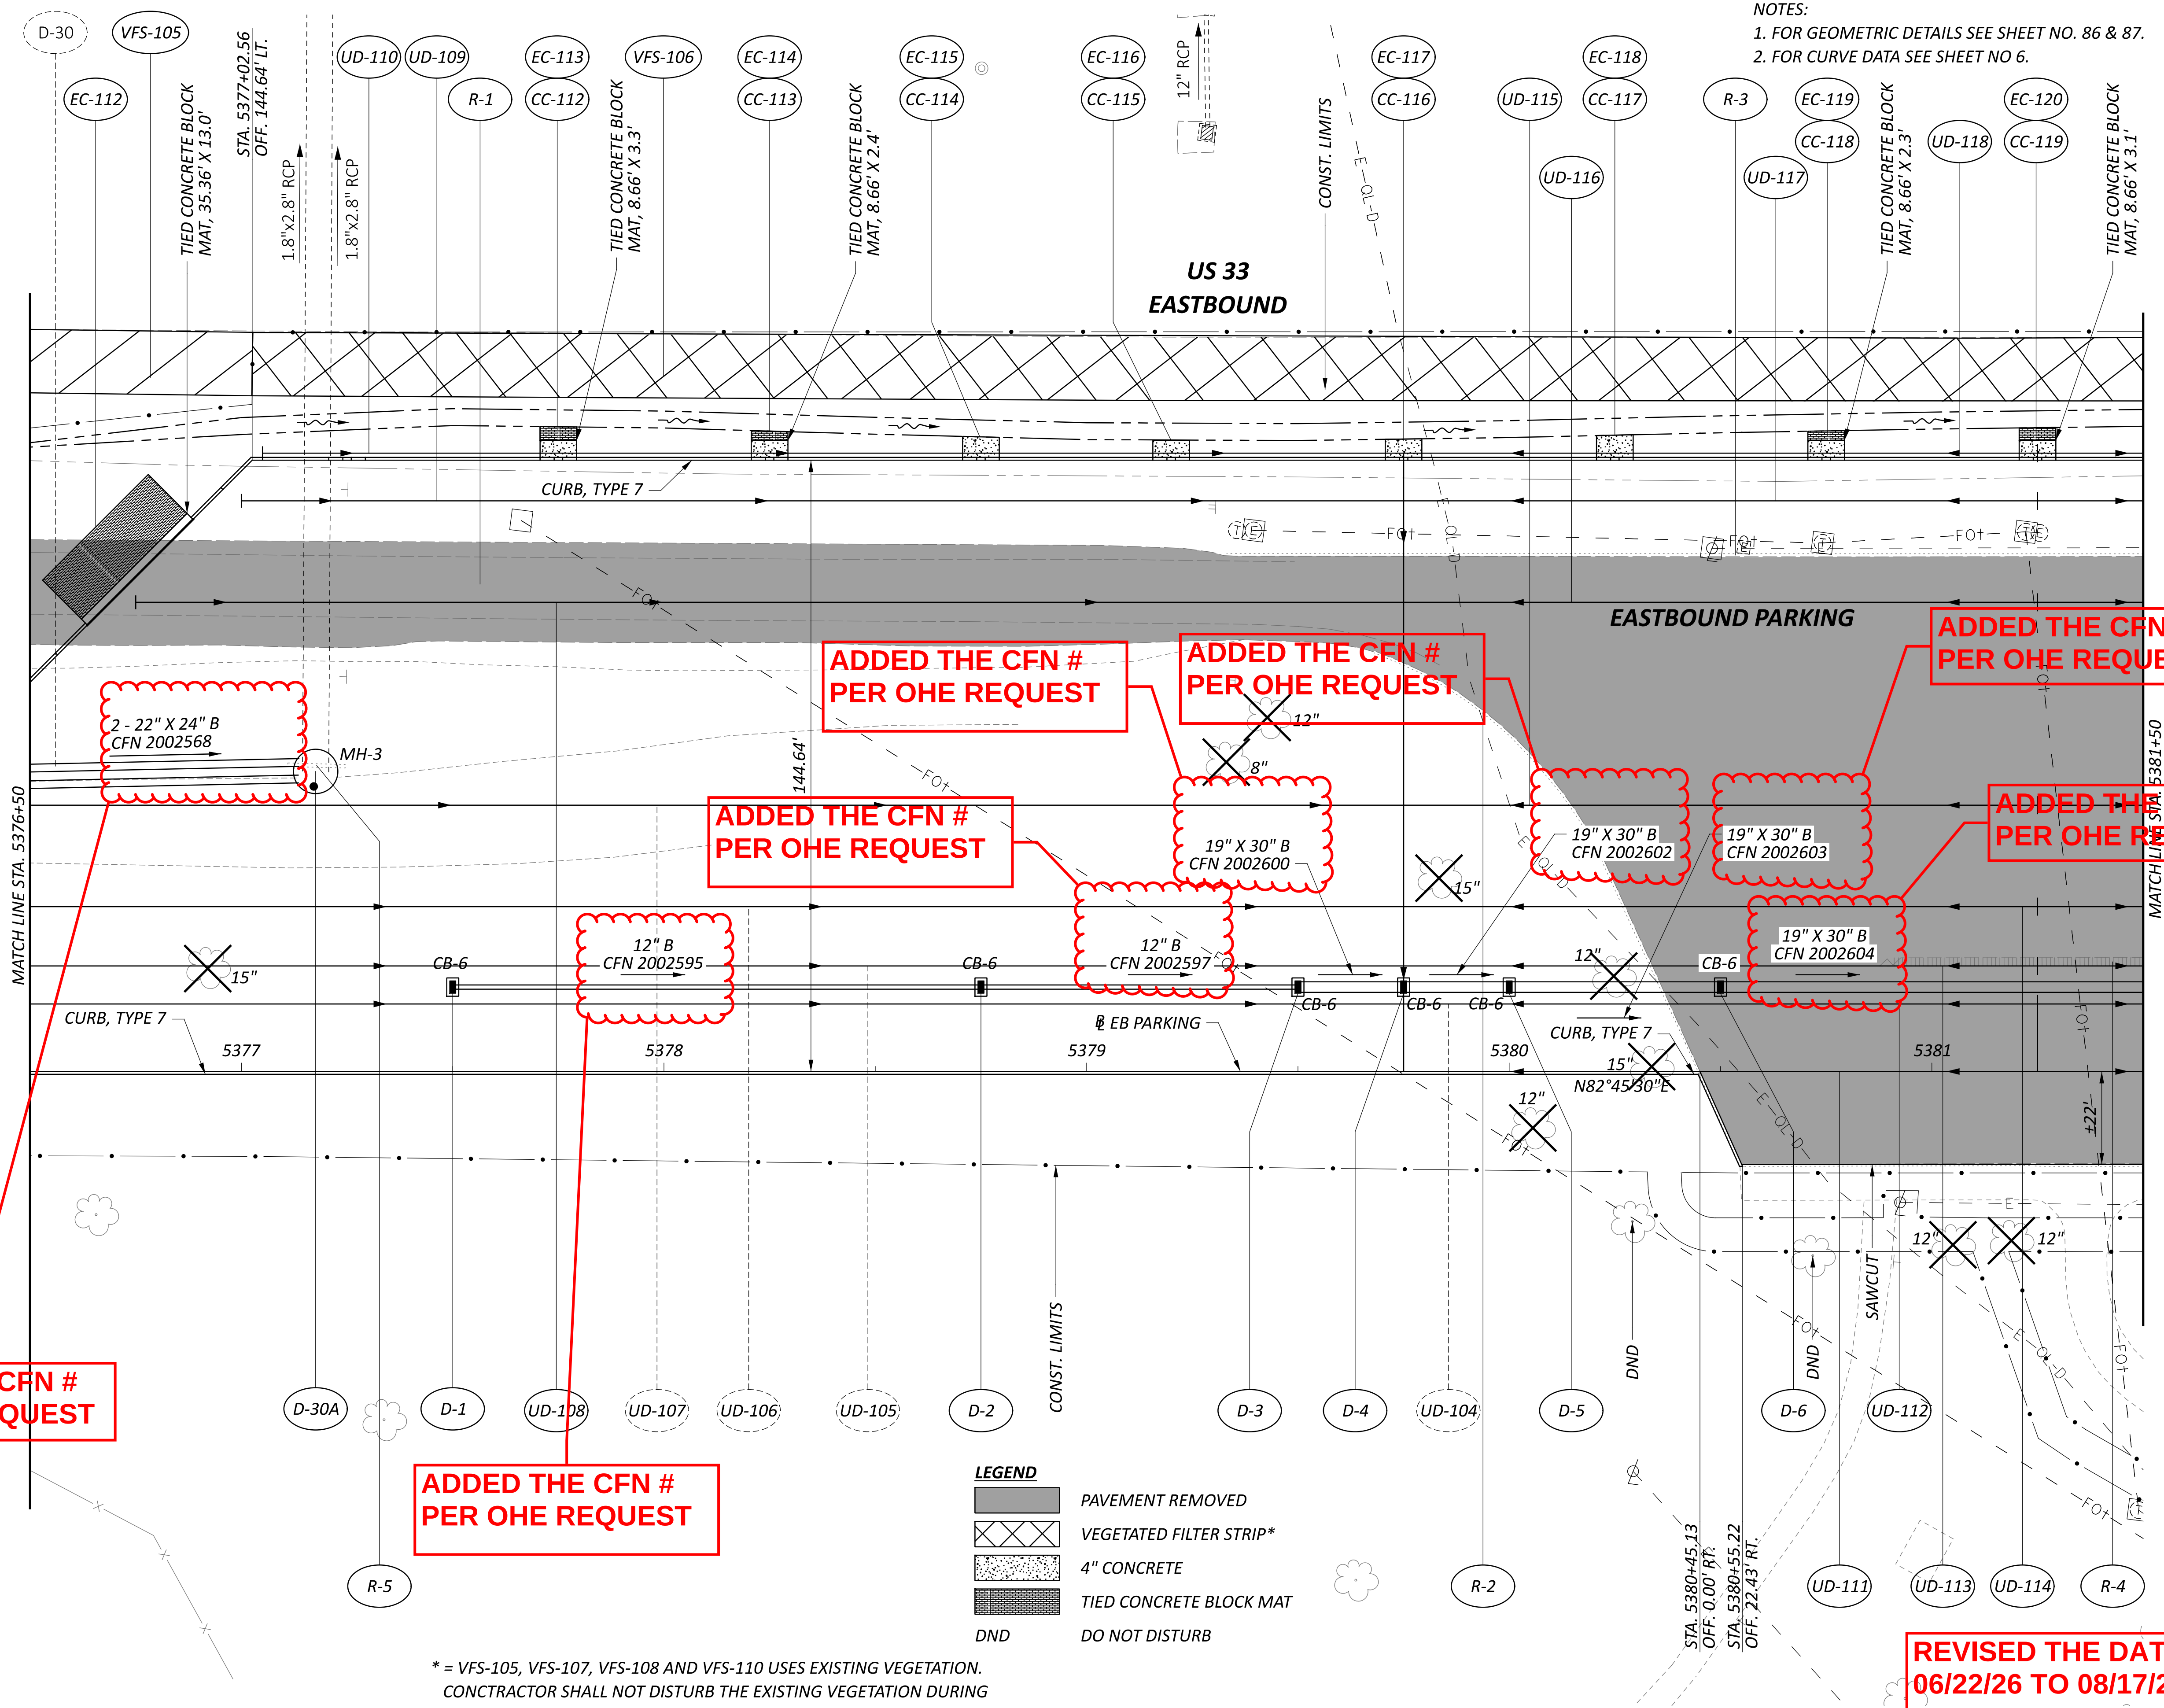

LEGEND	
	PAVEMENT REMOVED
	VEGETATED FILTER STRIP*
	4" CONCRETE
	TIED CONCRETE BLOCK MAT
	DO NOT DISTURB

* = VFS-105, VFS-107, VFS-108 AND VFS-110 USES EXISTING VEGETATION.
CONTRACTOR SHALL NOT DISTURB THE EXISTING VEGETATION DURING
CLEARING AND GRUBBING AT THESE VEGETATED FILTER STRIP LOCATIONS.

NOTES:
1. FOR GEOMETRIC DETAILS SEE SHEET NO. 86 & 87.
2. FOR CURVE DATA SEE SHEET NO 6.

PLAN - EASTBOUND PARKING
STA. 5376+50.00 TO STA. 5381+50.00

DESIGN AGENCY




DESIGNER
KGR

REVIEWER
RN


PROJECT ID
122894

SHEET
P.31


TOTAL
143

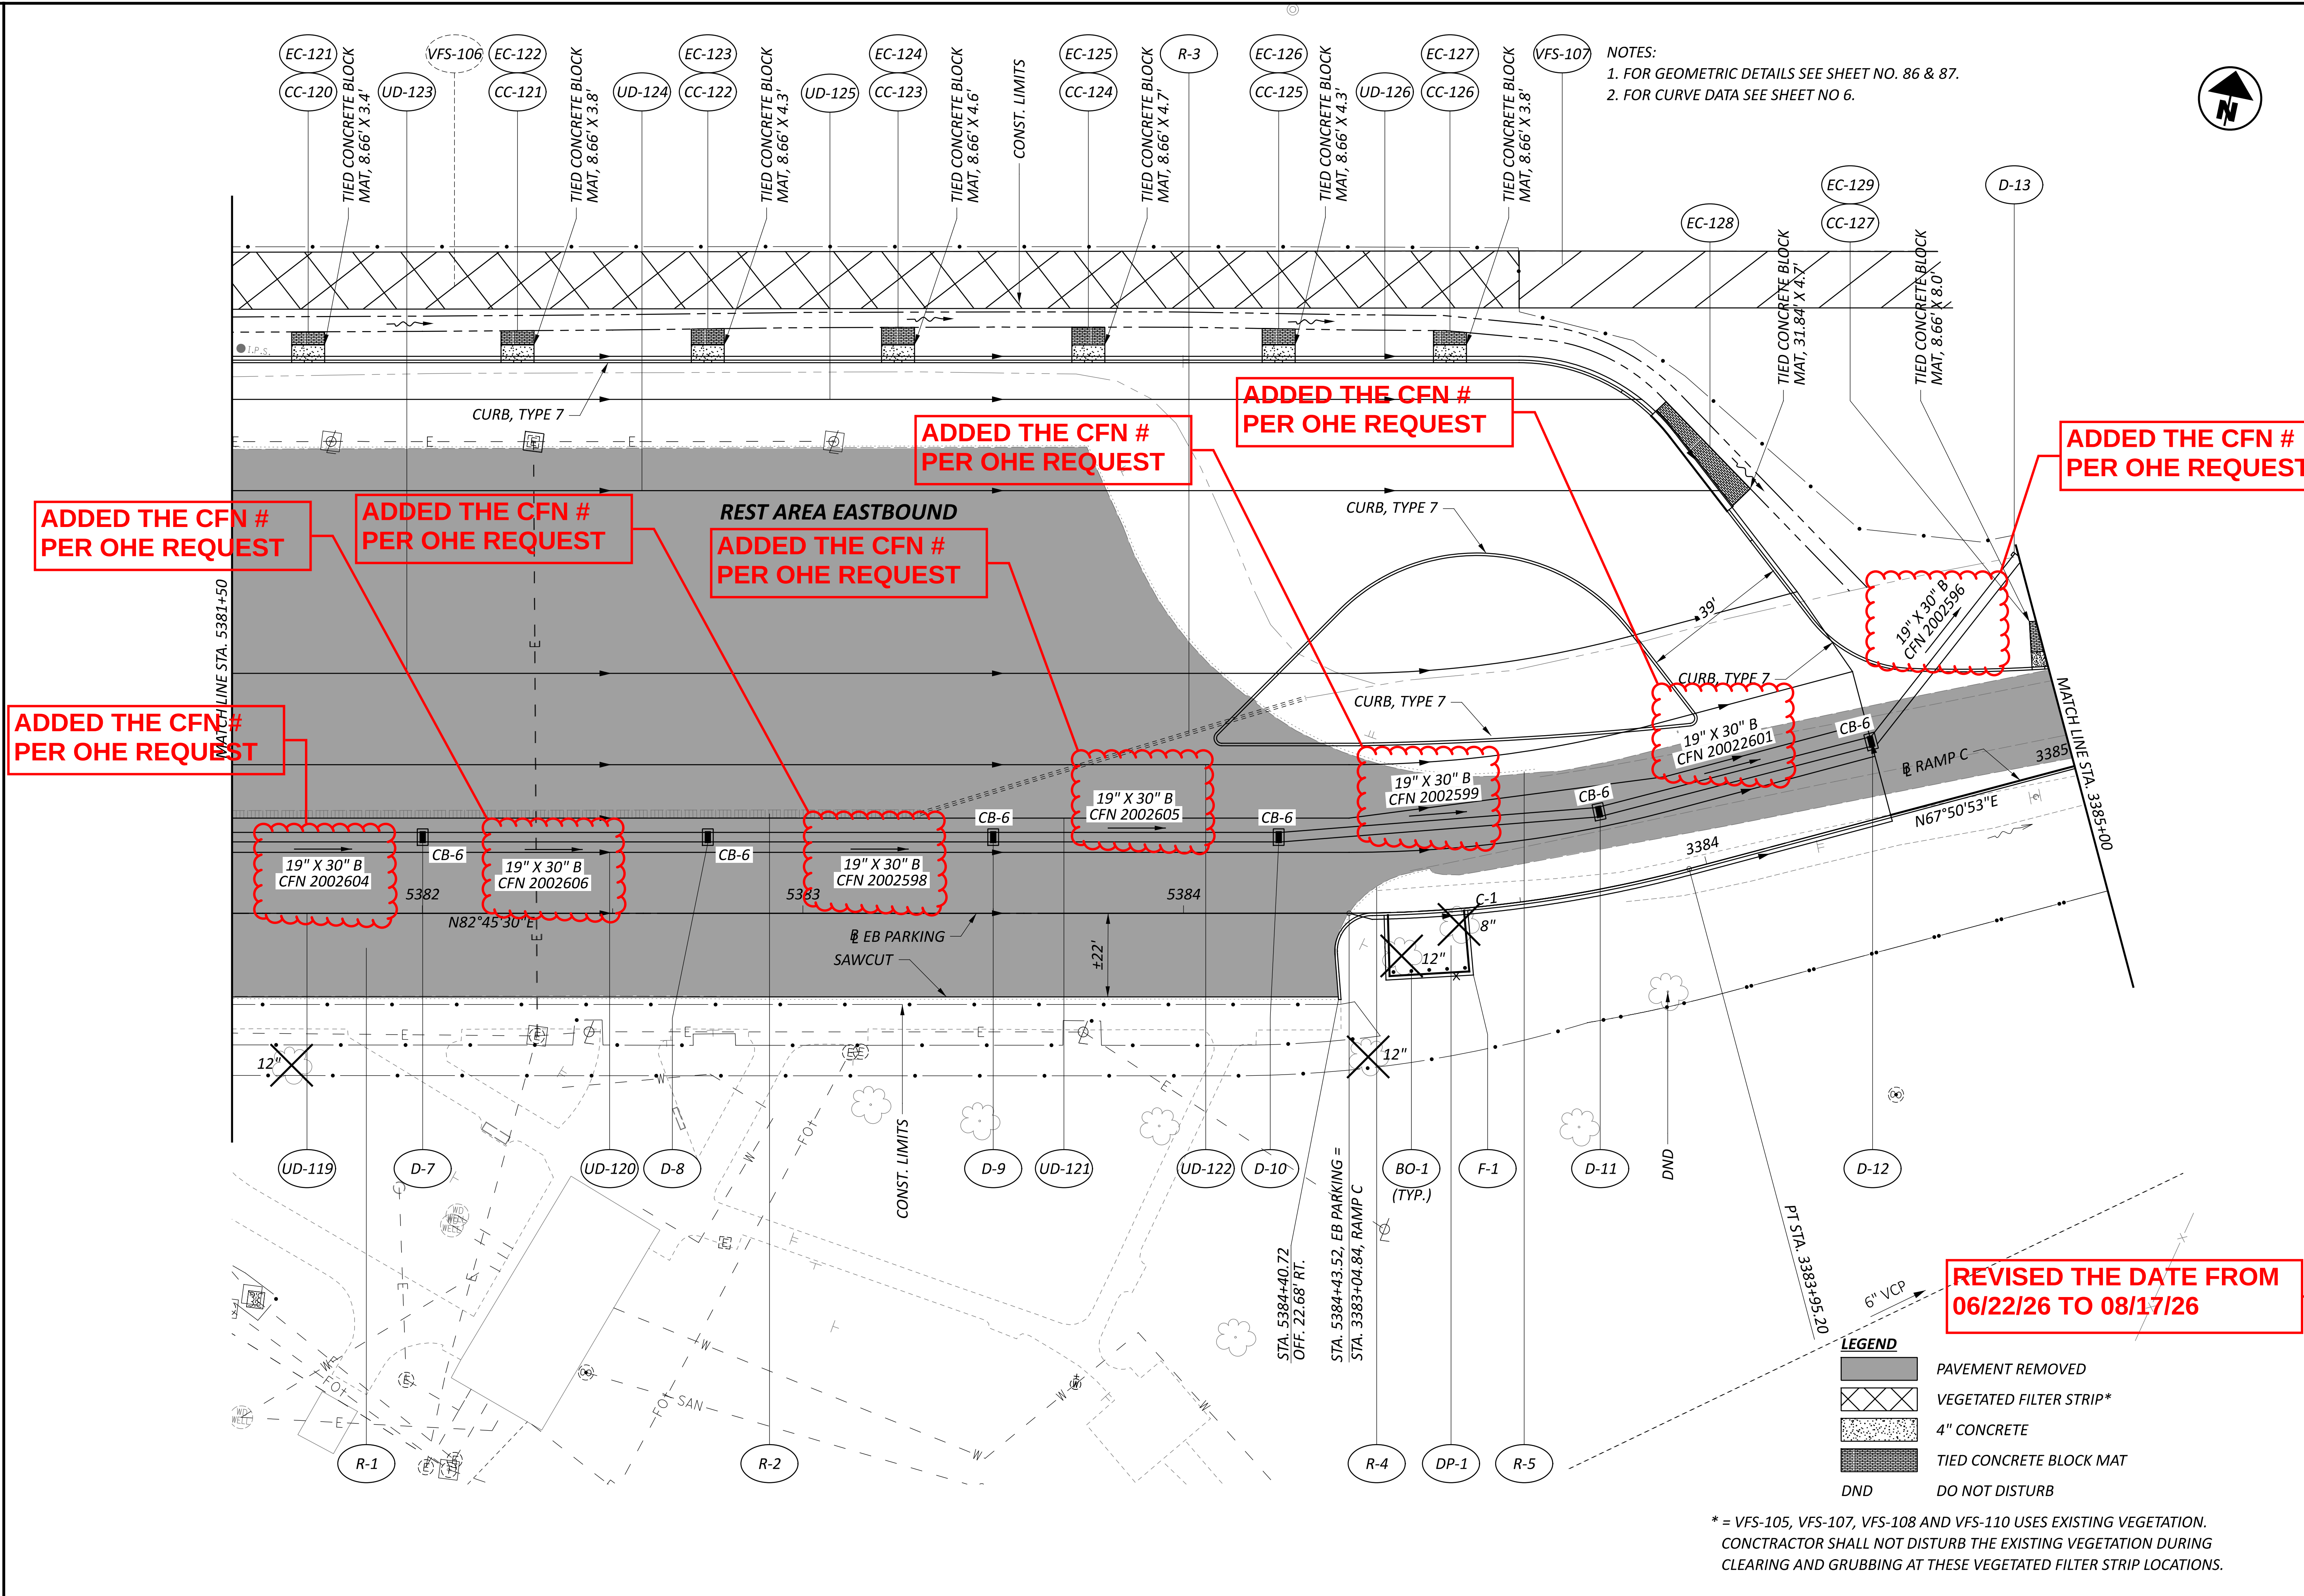

NOTES:
1. FOR GEOMETRIC DETAILS SEE SHEET NO. 86 & 87.
2. FOR CURVE DATA SEE SHEET NO 6.

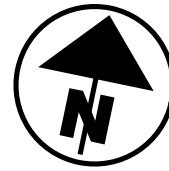


PLAN - EASTBOUND PARKING - STA. 5381+50.00 TO STA. 5384+43.52
PLAN - RAMP C - STA. 3383+04.84 TO STA. 3385+00.00

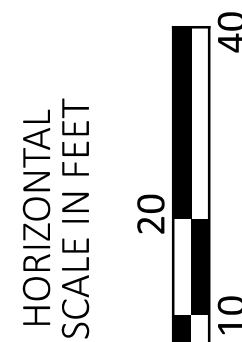

LEGEND	
	PAVEMENT REMOVED
	VEGETATED FILTER STRIP*
	4" CONCRETE
	TIED CONCRETE BLOCK MAT
	DO NOT DISTURB

* = VFS-105, VFS-107, VFS-108 AND VFS-110 USES EXISTING VEGETATION.
CONTRACTOR SHALL NOT DISTURB THE EXISTING VEGETATION DURING
CLEARING AND GRUBBING AT THESE VEGETATED FILTER STRIP LOCATIONS.

DESIGN AGENCY

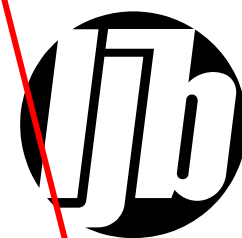

DESIGNER

KGR

REVIEWER

RN 08/17/26

PROJECT


122894


SHEET


P.32

TOTAL

143

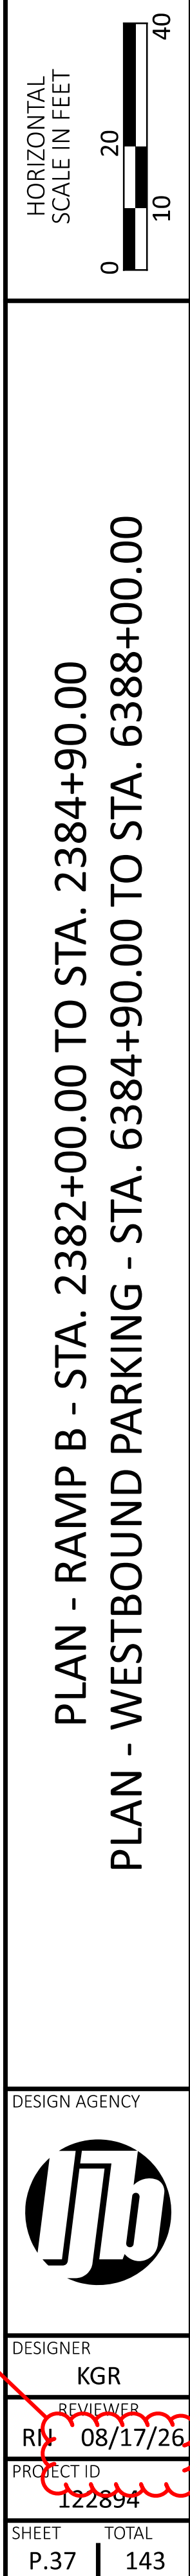

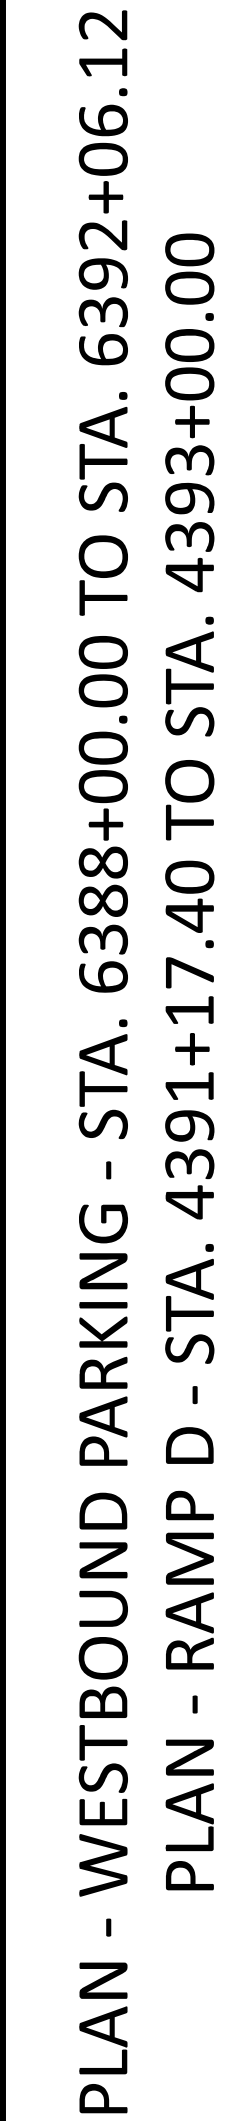

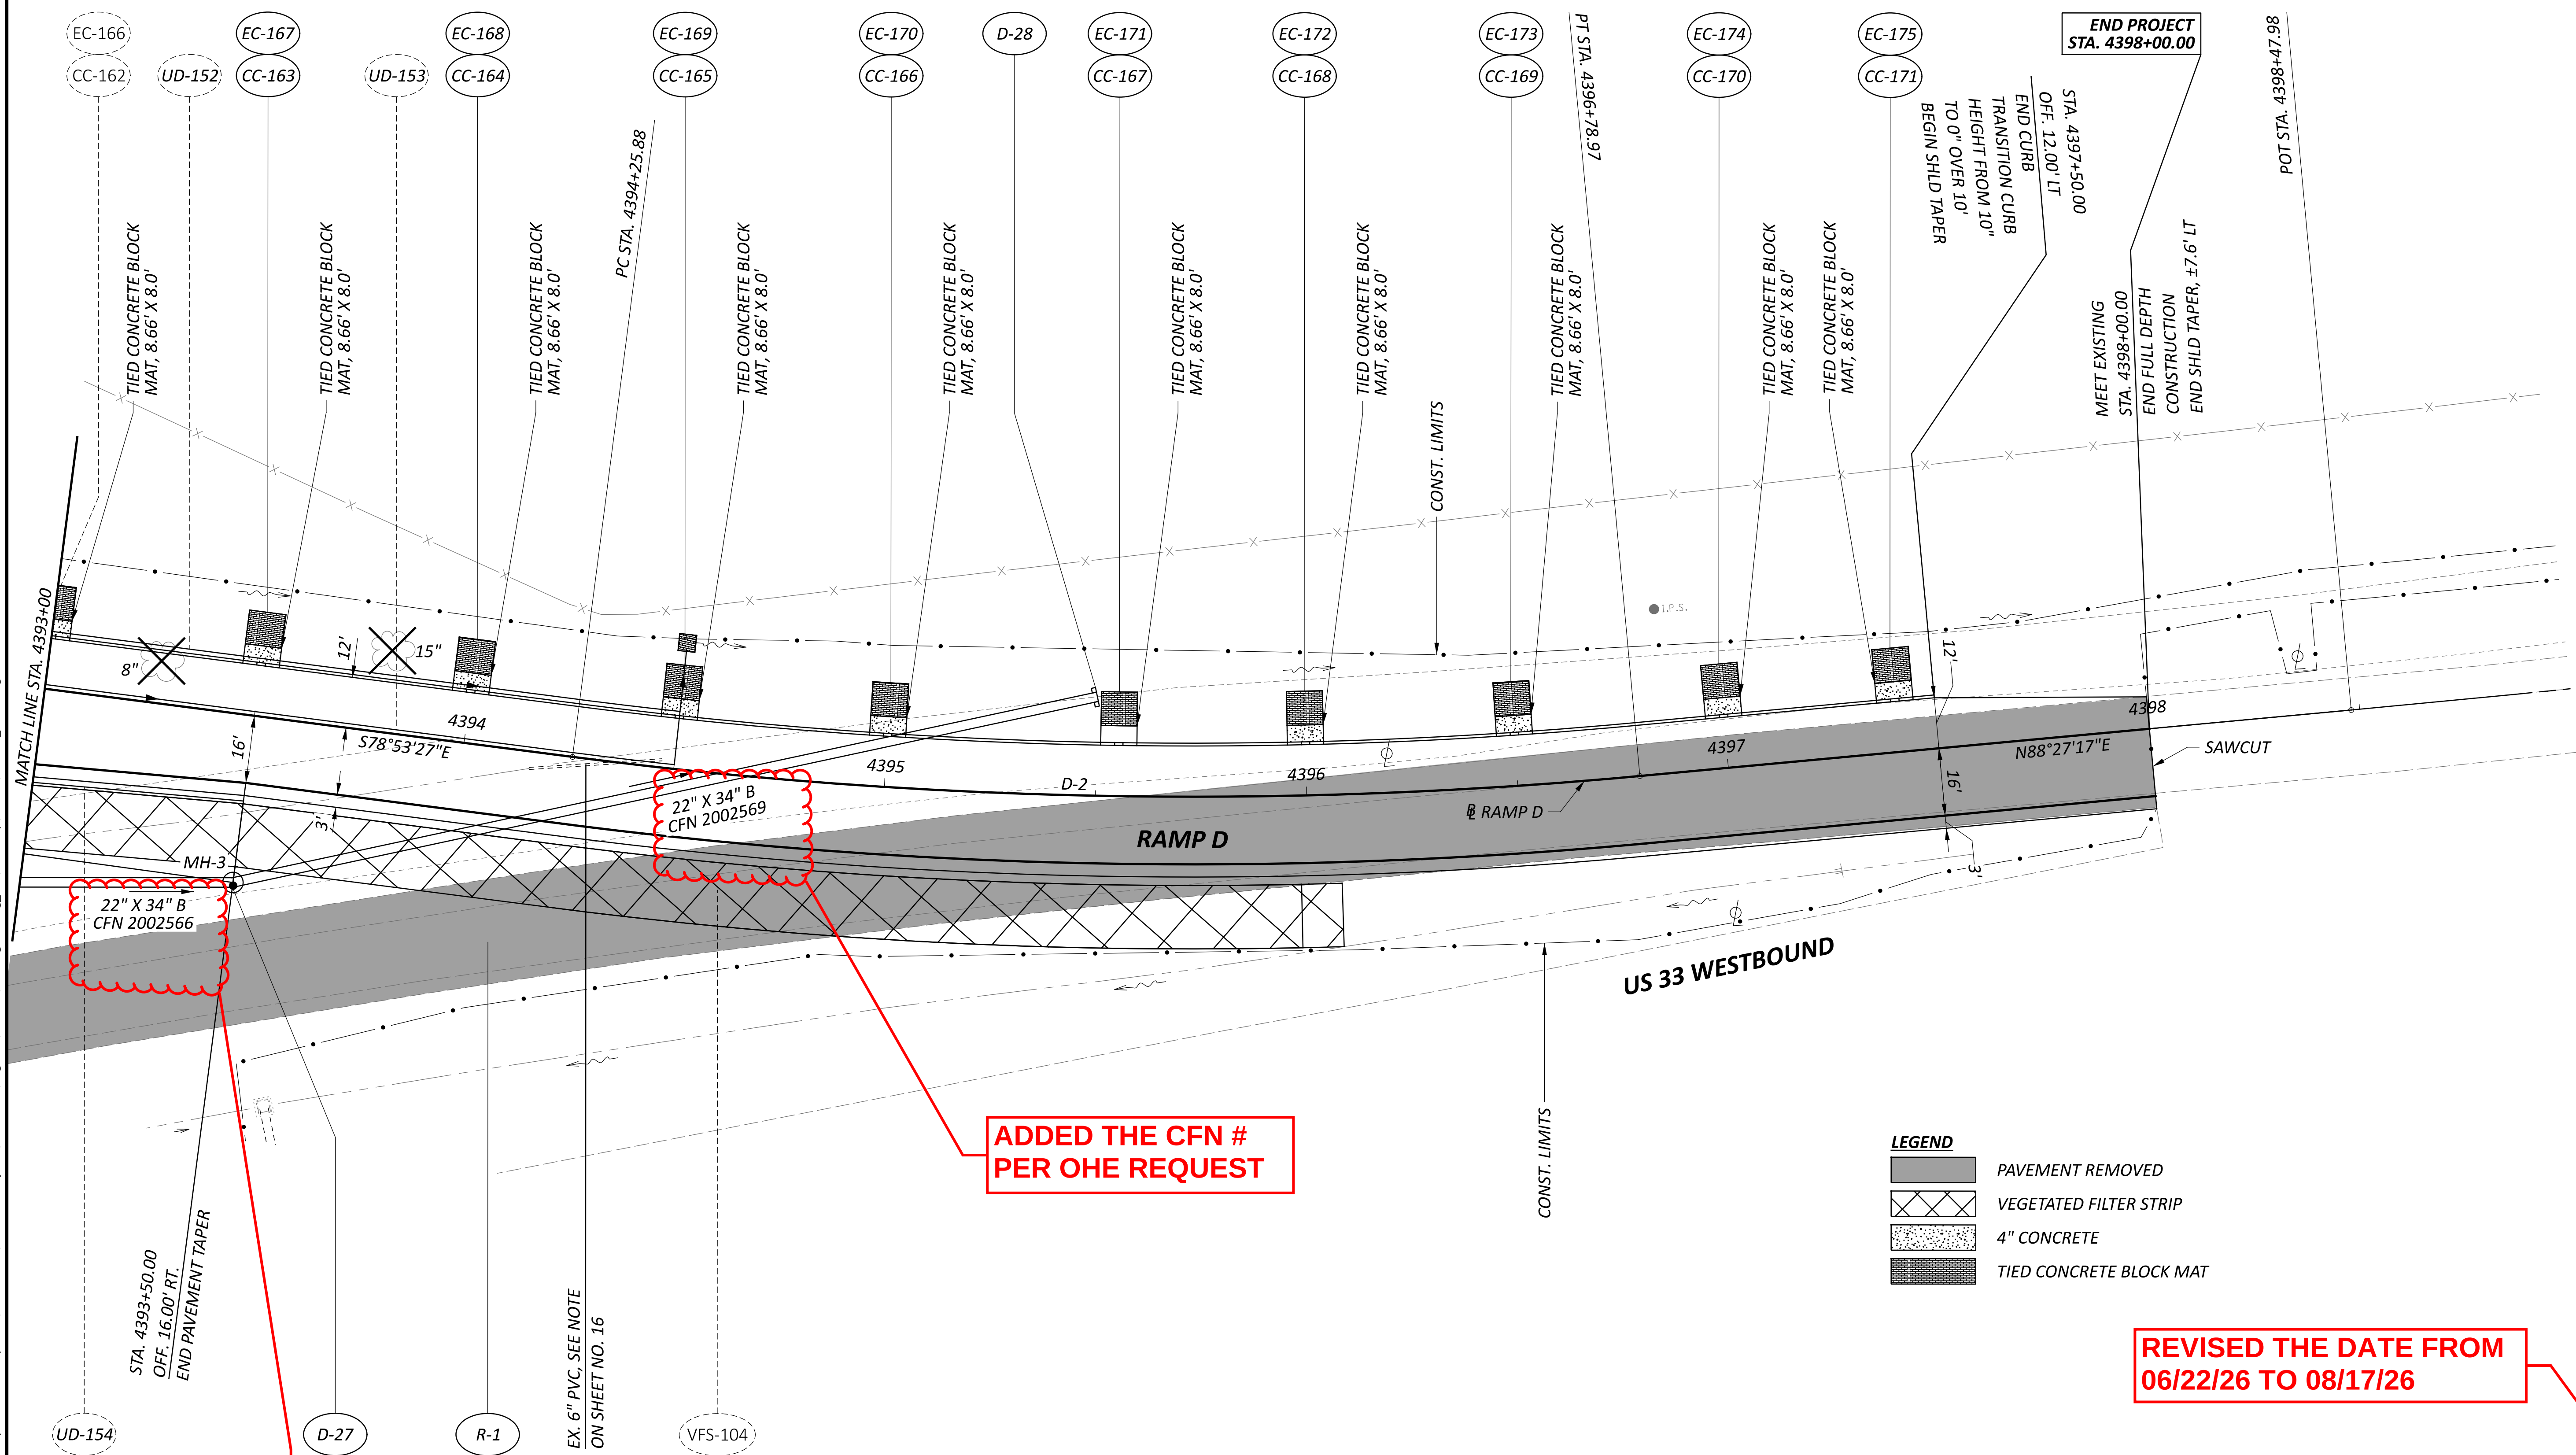


NOTES:
1. FOR GEOMETRIC DETAILS SEE SHEET NO. 88 & 89.
2. FOR CURVE DATA SEE SHEET NO 6.



PLAN - RAMP D
STA. 4393+00.00 TO STA. 4399+00.00

LEGEND	
	PAVEMENT REMOVED
	VEGETATED FILTER STRIP
	4" CONCRETE
	TIED CONCRETE BLOCK MAT

DESIGN AGENCY

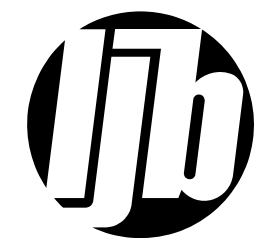

DESIGNER

KGR

REVIEWER


RN 08/17/26

PROJECT ID

122894

SHEET TOTAL

P.39 143

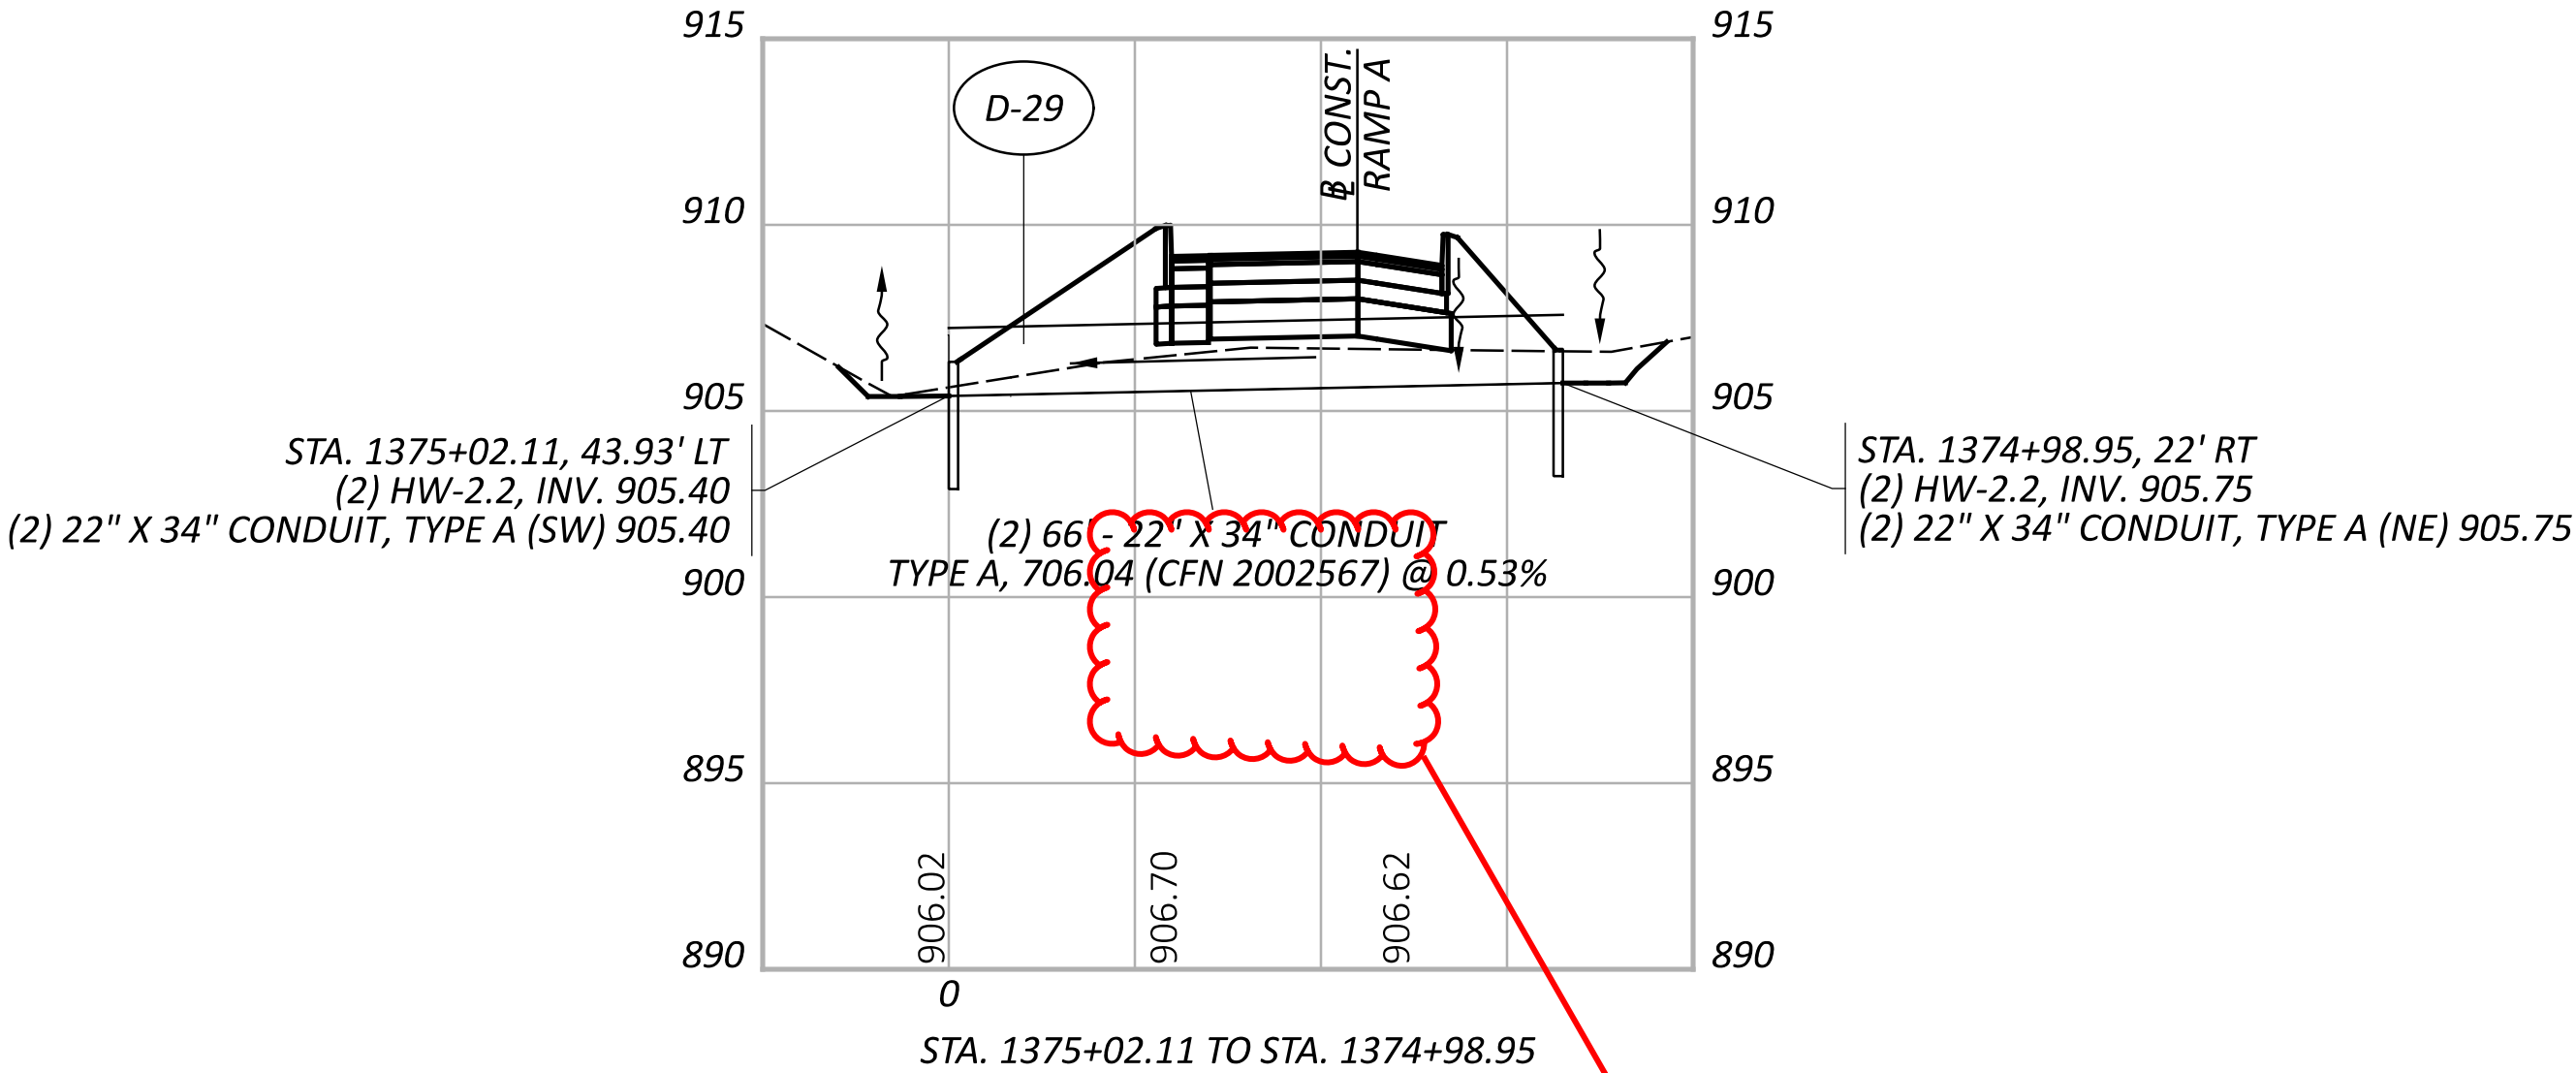


ADDED THE CFN #
PER OHE REQUEST

REVISED THE DATE FROM
06/22/26 TO 08/17/26

CULVERT PROFILE

DESIGN AGENCY

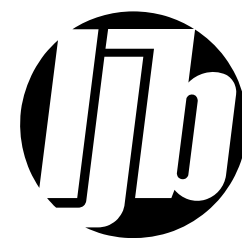

DESIGNER

AIM

REVIEWER

RN 08/17/26

PROJECT ID


122894

SHEET

P.97

TOTAL


143

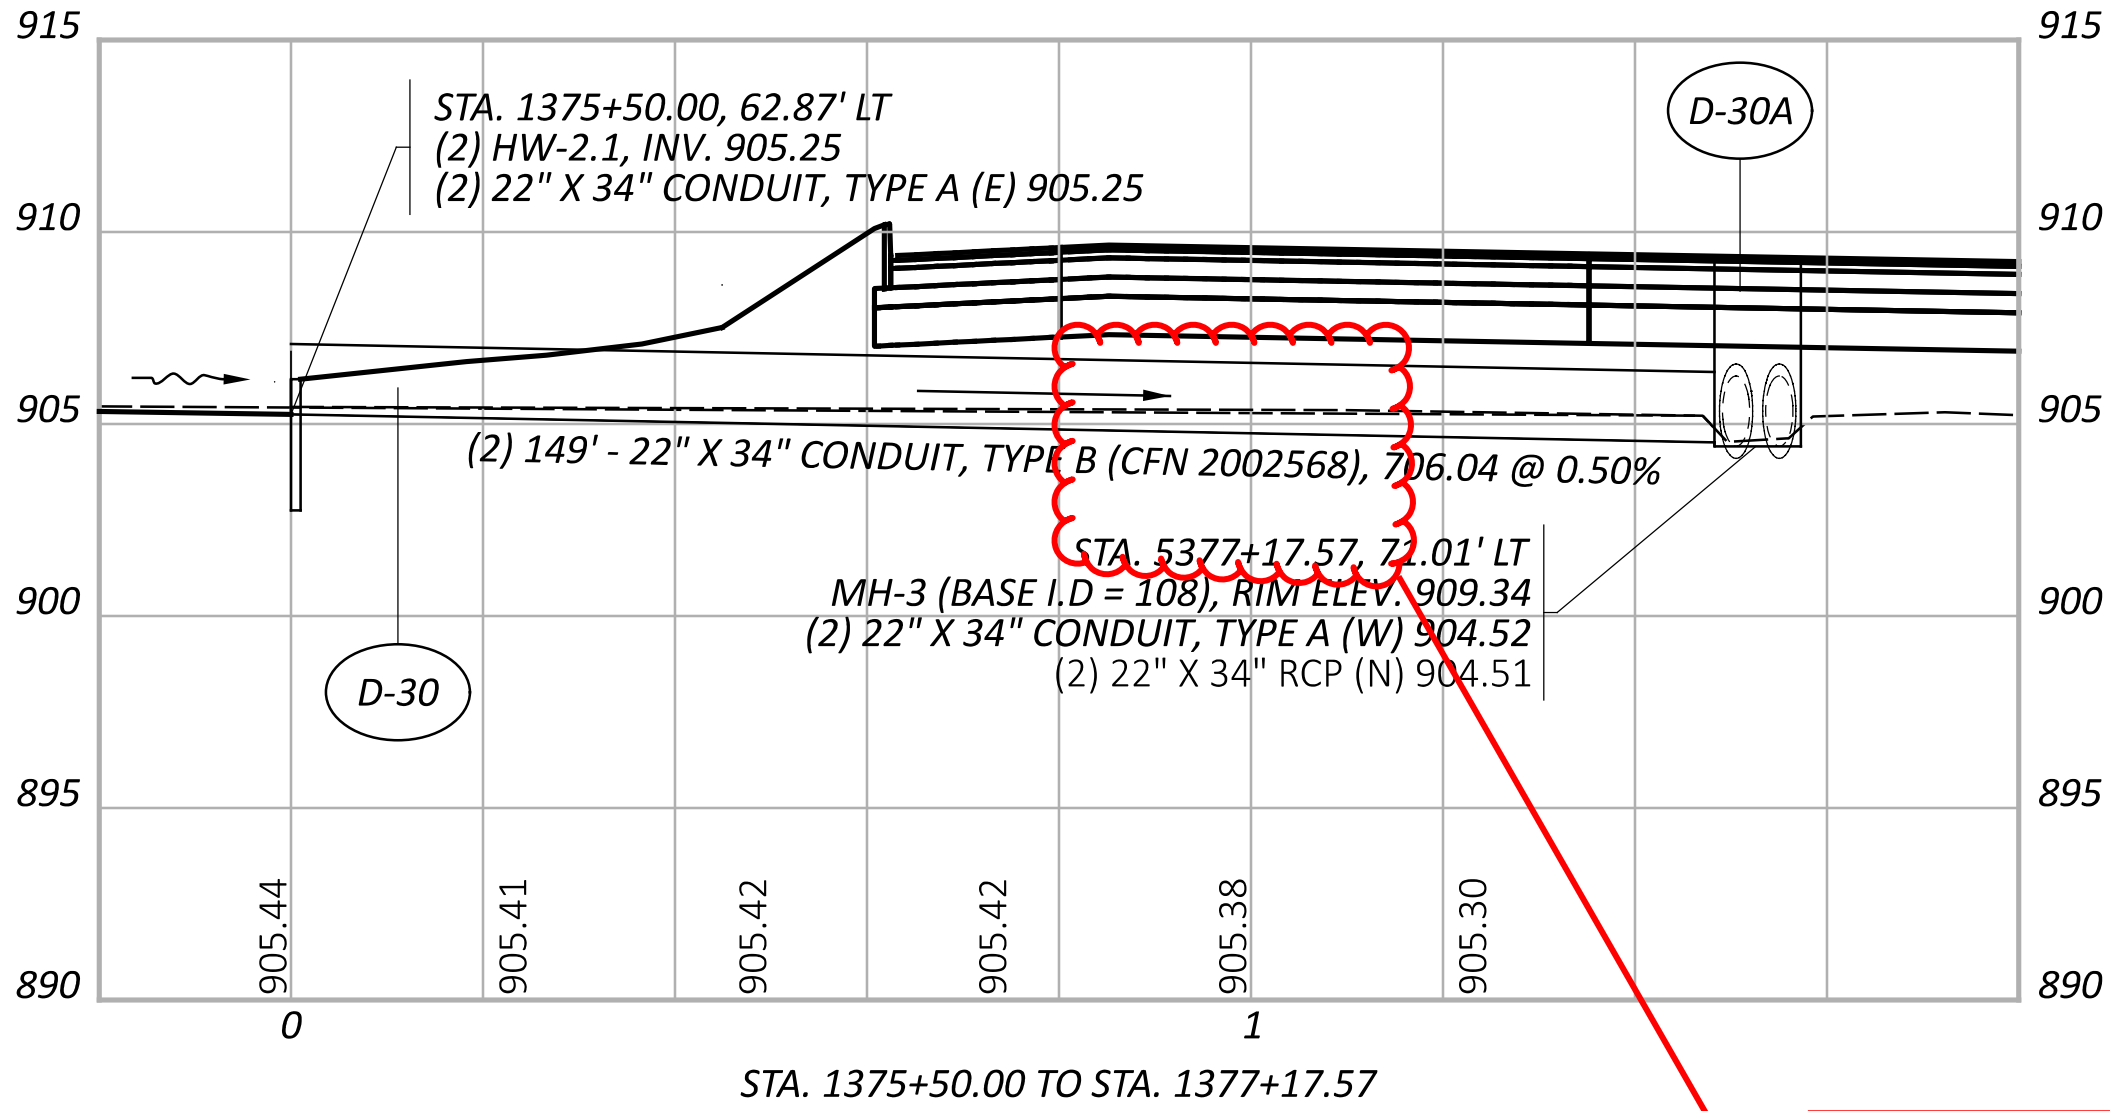

ADDED THE CFN #
PER OHE REQUEST

REVISED THE DATE FROM
06/22/26 TO 08/17/26

DESIGN AGENCY	
	
DESIGNER	AIM
REVIEWER	RN
PROJECT NO.	122894
SHEET	P.98
TOTAL	143

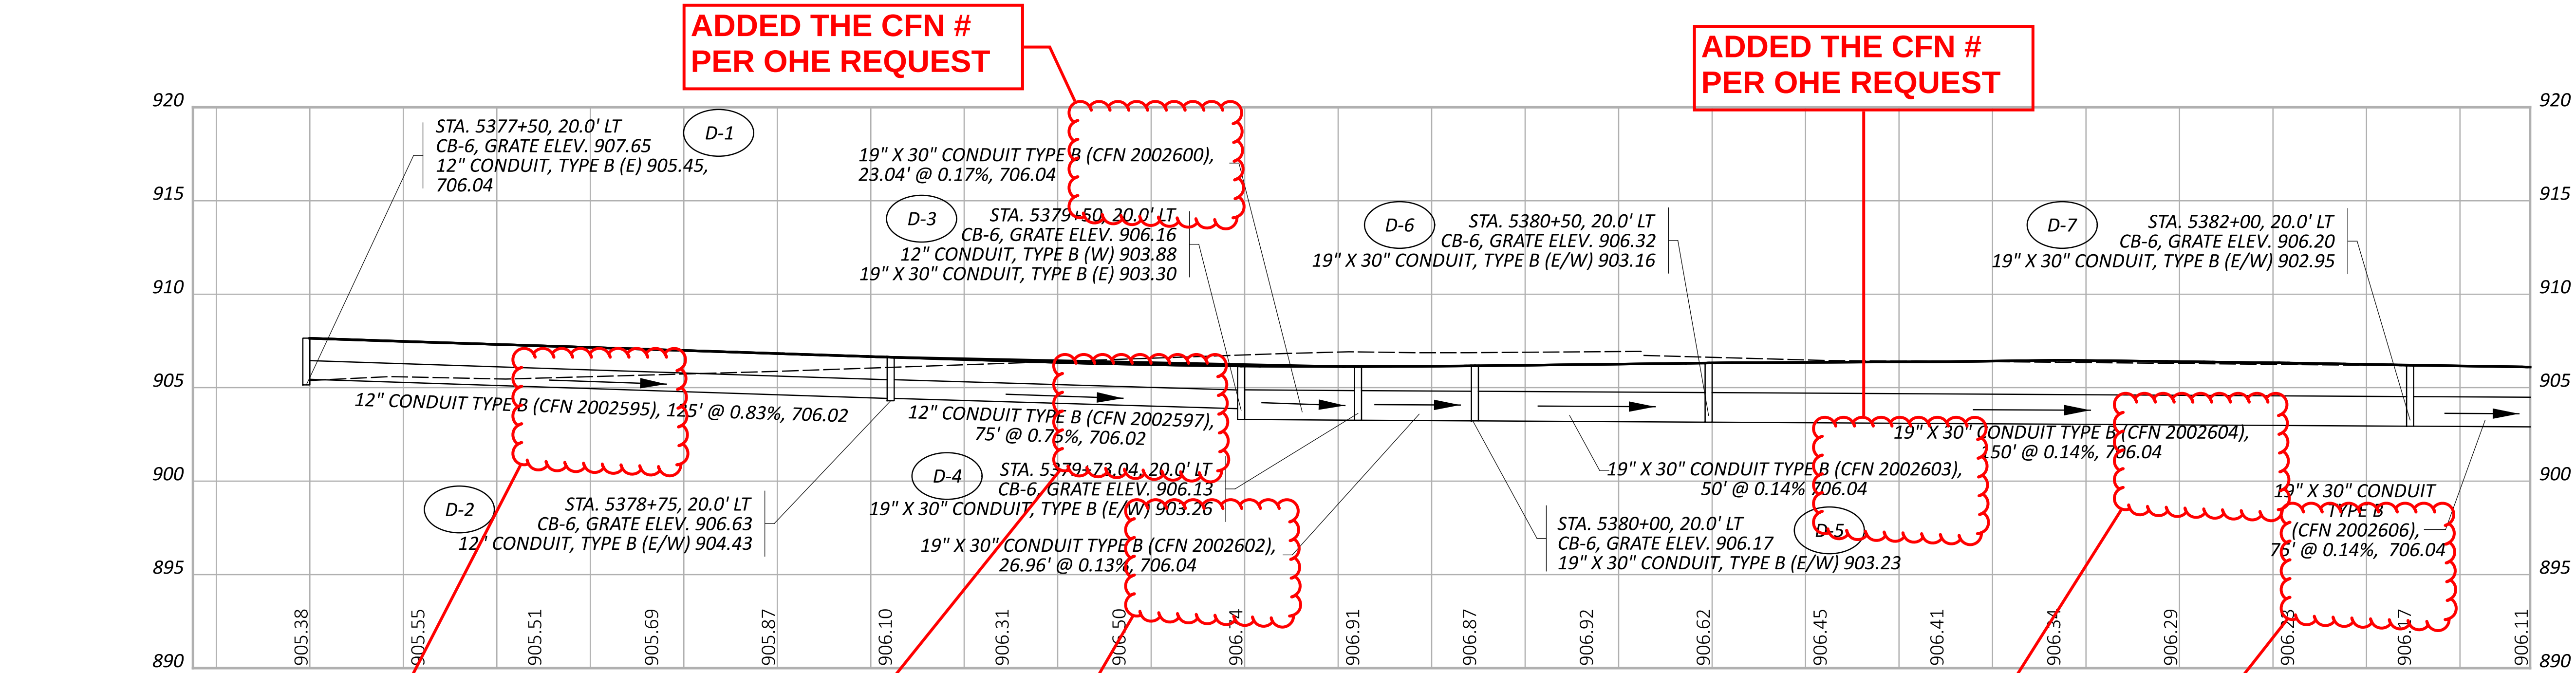

ADDED THE CFN #
PER OHE REQUEST

ADDED THE CFN #
PER OHE REQUEST


ADDED THE CFN #
PER OHE REQUEST

ADDED THE CFN #
PER OHE REQUEST

REVISED THE DATE FROM
06/22/26 TO 08/17/26

STORM PROFILE - EASTBOUND PARKING

DESIGN AGENCY

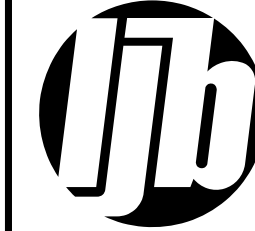

DESIGNER

AIM

REVIEWER

08/17/26

PROJECT ID


122894

SHEET

P.99

TOTAL

143

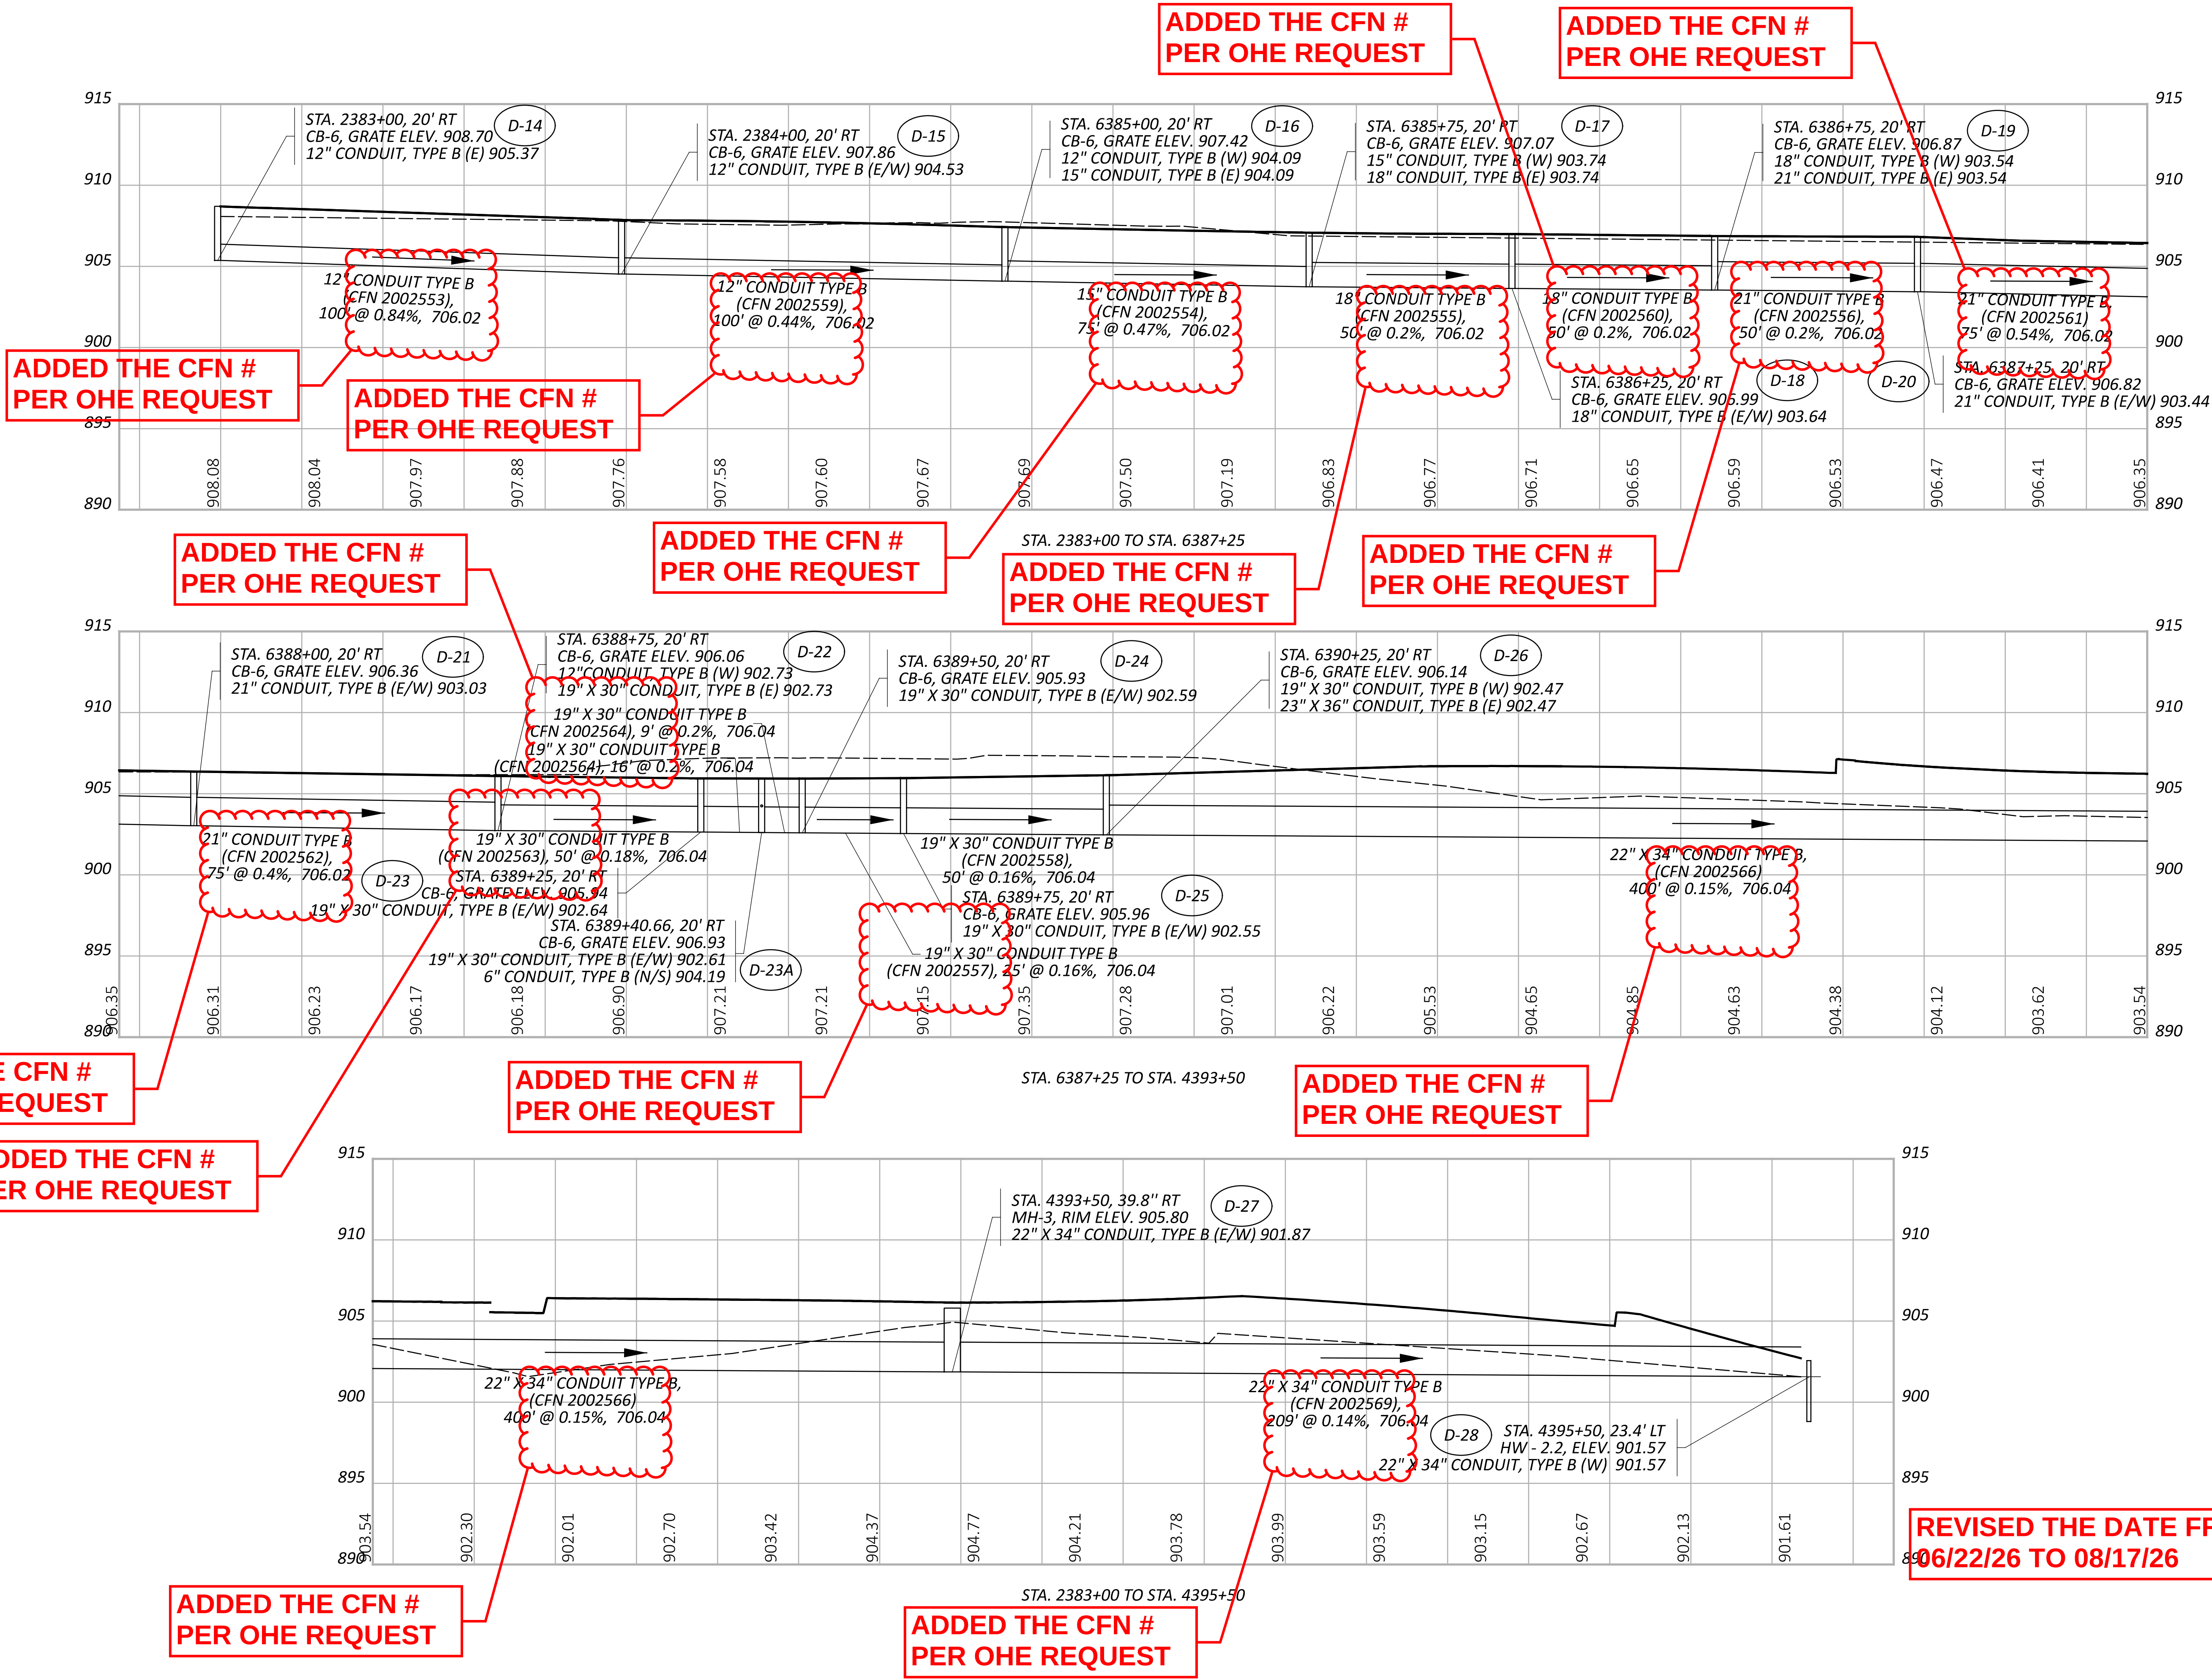

REVISED THE DATE FROM 06/22/26 TO 08/17/26