

FORCE MAIN 1 (CONT.)
 6" CL200 PVC(SDR21)
 PRESSURE SEWER (GREEN PIPE)


66280
 WASTE WATER LINE 2147.76 FT. / .41 MI. (2-27-23) JGH

RECORD DRAWING 10/07

NO.	DATE	REVISION	dms
1	10/07	RECORD DRAWING	

DRAWN BY:
DAVID STEWART

CHECKED BY:
JEFFREY A. VAUGHN

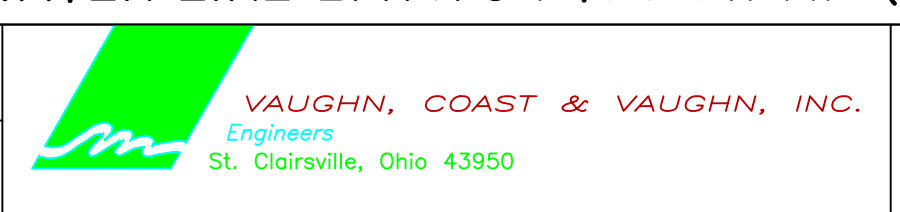

BELMONT COUNTY SANITARY SEWER DISTRICT
 Belmont Sewage Lift Station and Force Main
 Belmont County, Ohio

BELMONT SEWAGE LIFT STATION AND FORCE MAIN
 ALONG STATE ROUTE 149 GOING NORTH
 FORCE MAIN 1

SCALE: 1"=50' (22"x34") 1"=100' (11"x17")	PROJECT NO. 04040
DATE: MAY 2006	DRAWING NO. 10