




SECTION A-A

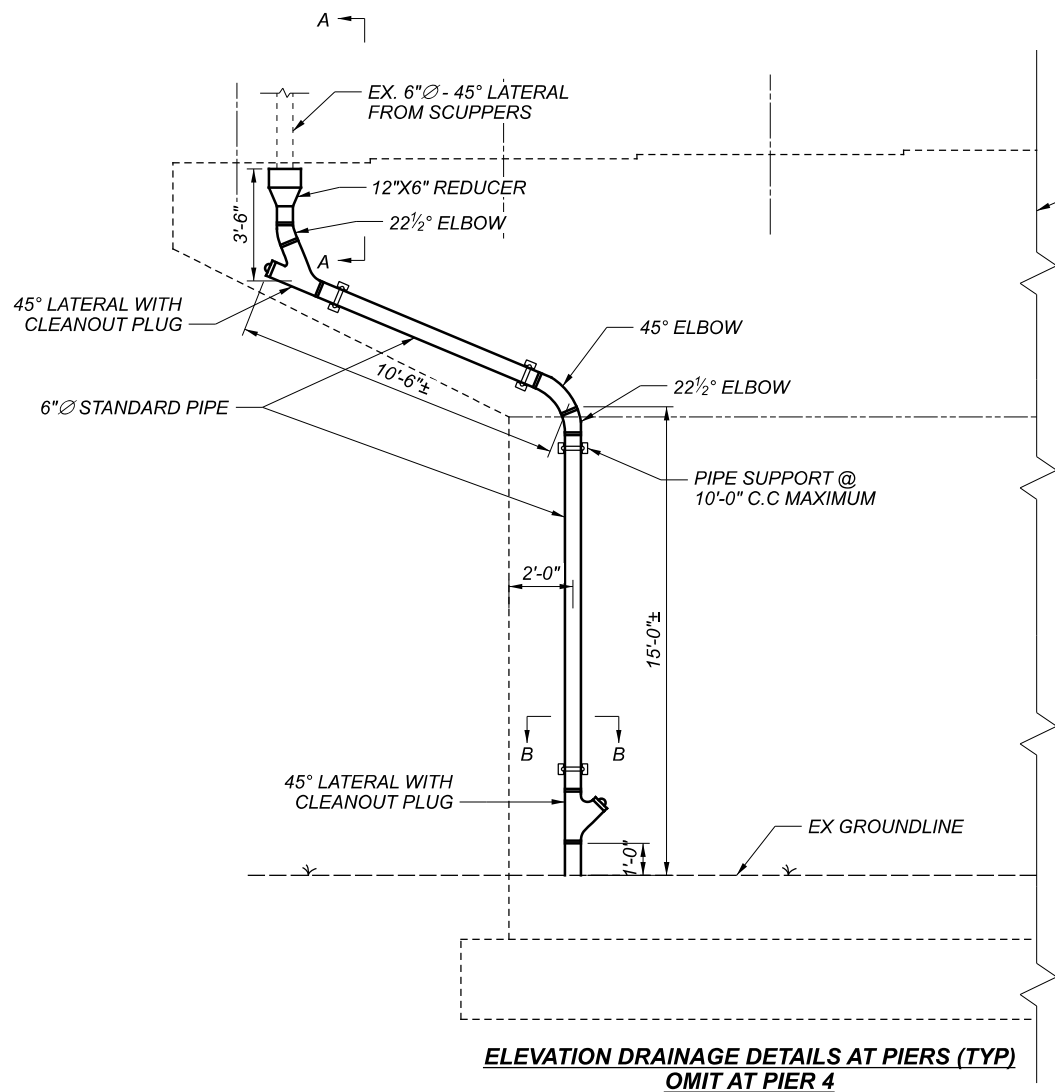


ELEVATION DRAINAGE DETAILS AT PIERS (TYP)
 OMIT AT PIER 4

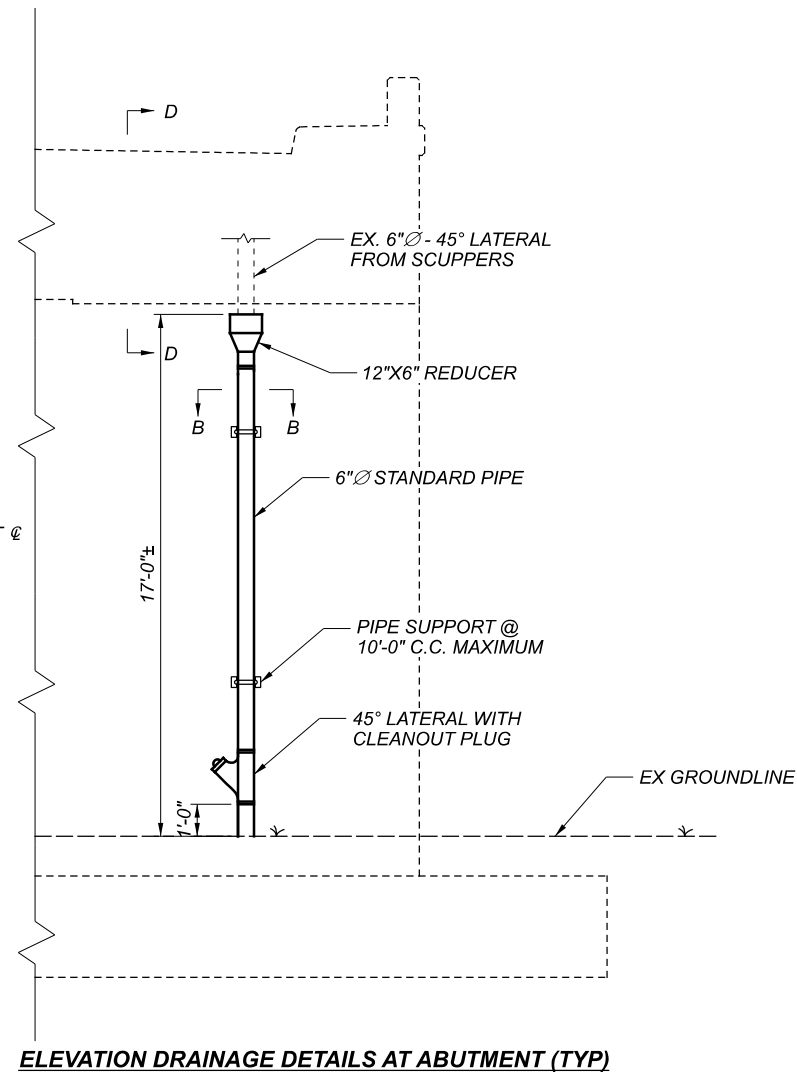


ELEVATION DRAINAGE DETAILS AT ABUTMENT (TYP)

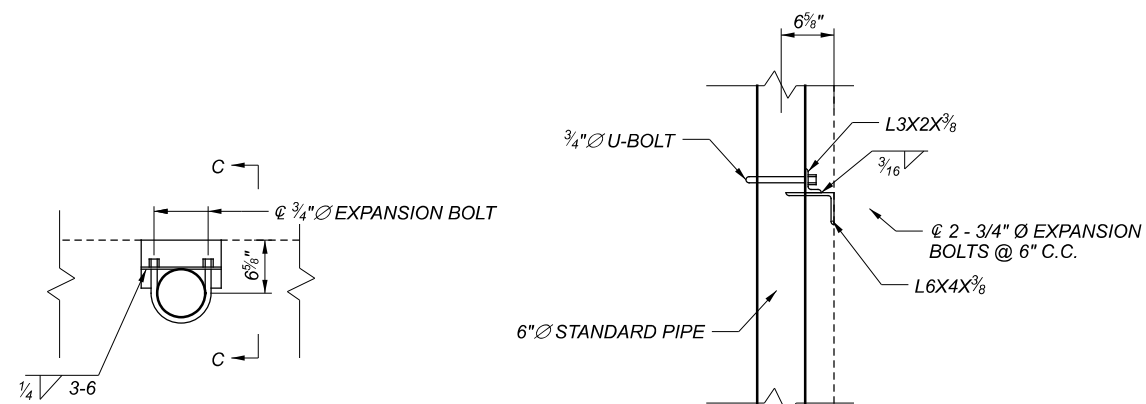

SECTION B-B

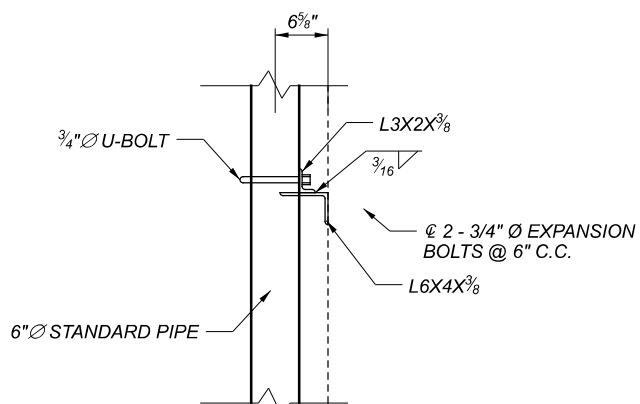

SECTION C-C

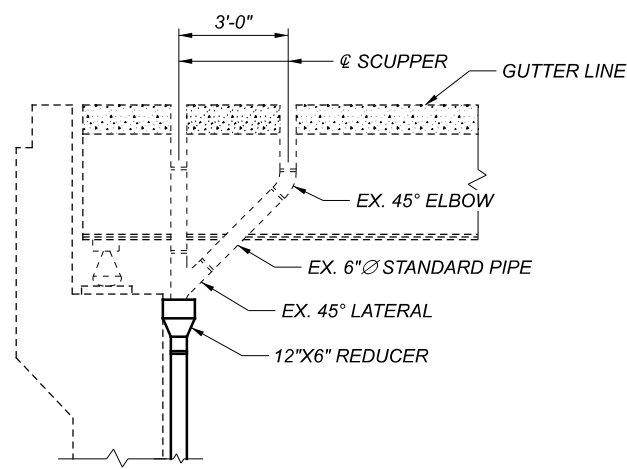

SECTION D-D

NOTES

- REMOVAL OF EXISTING DOWNSPOUTS ARE INCLUDED IN ITEM 202 PORTIONS OF STRUCTURE REMOVED, LS.
- DOWNSPOUT MATERIAL SHALL BE SCHEDULE 40 PVC PIPE, ALL PIPE SUPPORTS SHALL BE GALVANIZED STEEL.
- SET SET PROPOSED ANCHORS FOR DOWNSPOUT SUPPORT FROM PREVIOUS ANCHORS.
- PAYMENT FOR SUPPORTS, CLEANOUTS, BOLTS, ANGLES, ELBOWS, REDUCERS, ETC. ARE INCLUDED IN LINEAR FT ITEM 518 BID.
- OUTLETS TO ABUTMENT DRAINAGE IS TO EXISTING DRAINAGE GRATES. OUTLETS ON PIER DRAINAGE IS TO EXISTING FLEXIBLE OUTLETS ATTACHED TO THE END OF THE DOWNSPOUT.

