


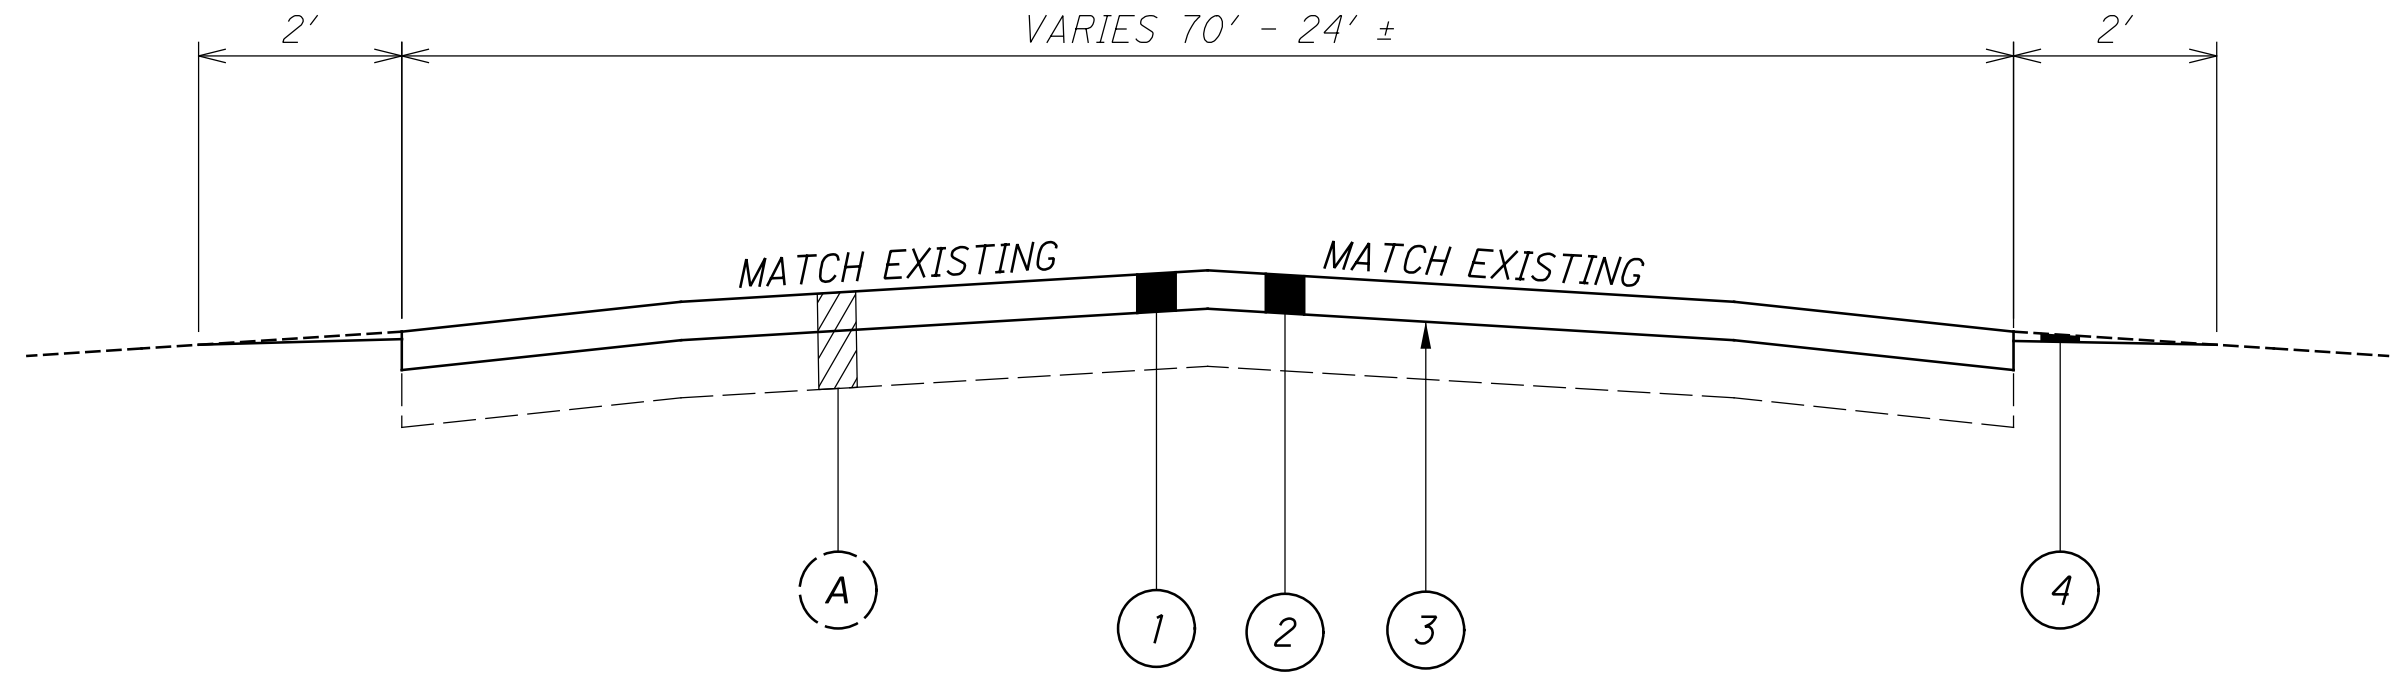


TYPICAL 1
MAIN DRIVE APPROACH

LEGEND

- A - EXISTING ASPHALT PAVEMENT
- 1 - ITEM 441 - ASPHALT CONCRETE SURFACE COURSE, TYPE 1 (449), PG64-22 1.50"
- 2 - ITEM 254 - PAVEMENT PLANING 1.50"
- 3 - ITEM 407 - NON-TACKING TACK COAT (0.085 GAL/SY)
- 4 - ITEM 617 - COMPACTED AGGREGATE 1.5" (average thickness)


NOTE:
ITEM 617 - COMPACTED AGGREGATE IS TO BE USED AS DIRECTED
BY THE ENGINEER THROUGHOUT LIMITS OF PROJECT.

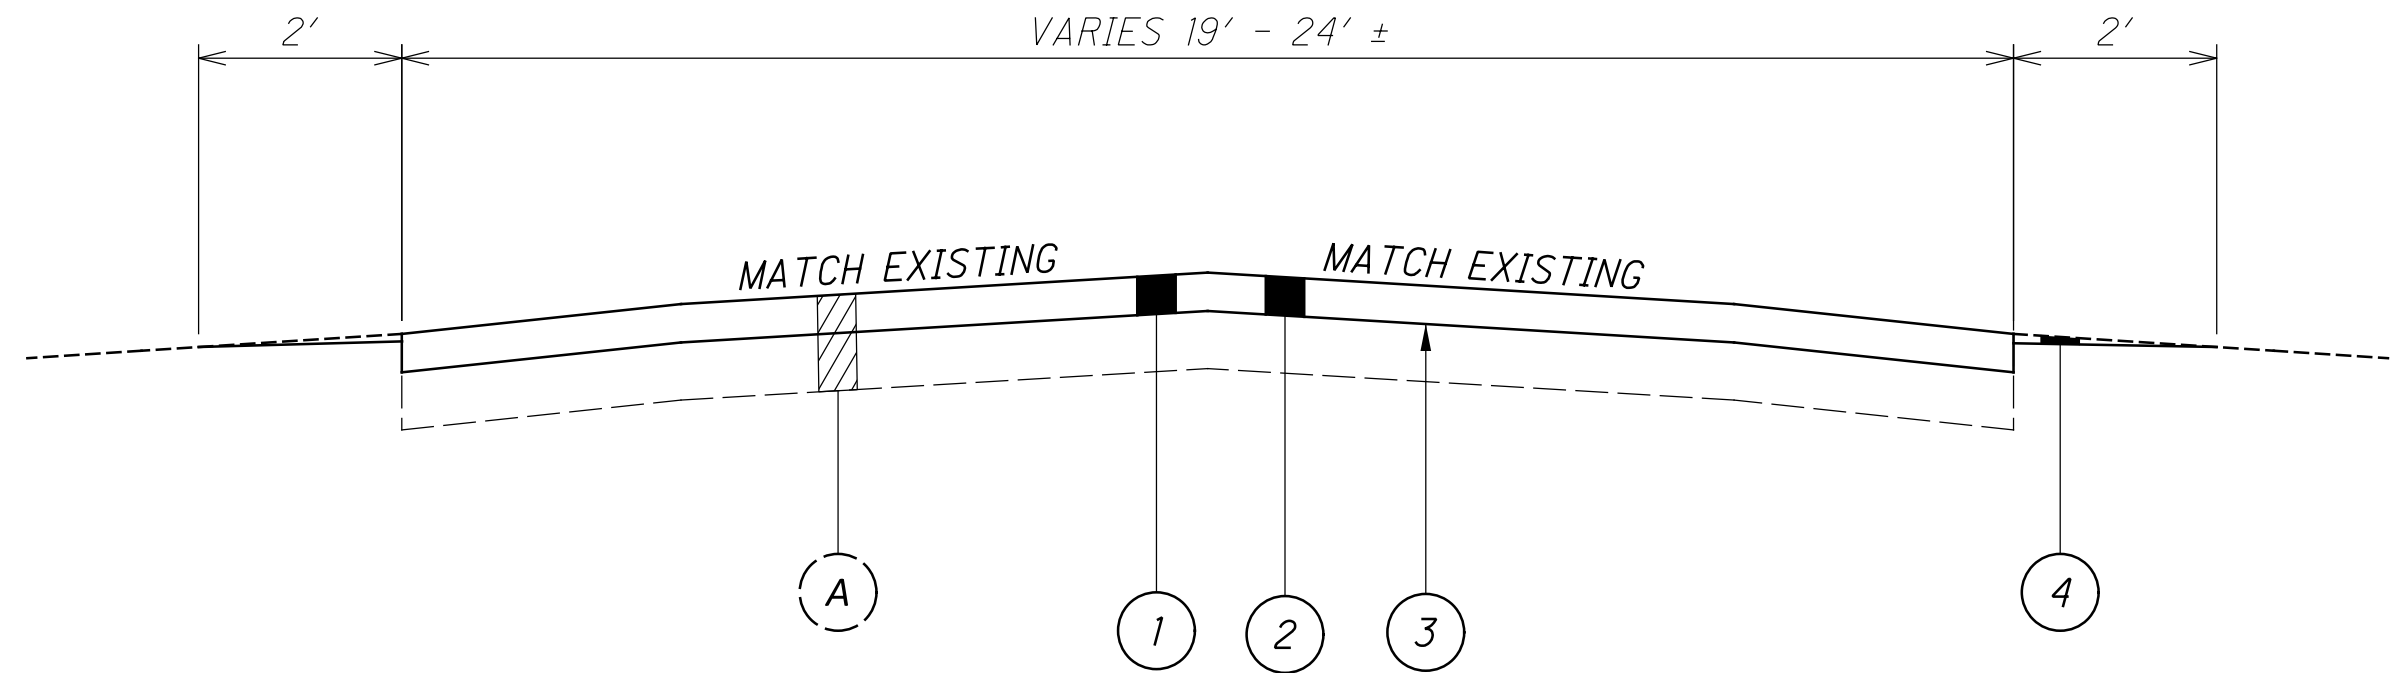

TYPICAL 2
MAIN DRIVE

LEGEND


- A - EXISTING ASPHALT PAVEMENT
- 1 - ITEM 441 - ASPHALT CONCRETE SURFACE COURSE, TYPE 1 (449), PG64-22 1.50"
- 2 - ITEM 254 - PAVEMENT PLANING 1.50"
- 3 - ITEM 407 - NON-TACKING TACK COAT (0.085 GAL/SY)
- 4 - ITEM 617 - COMPACTED AGGREGATE 1.5" (average thickness)

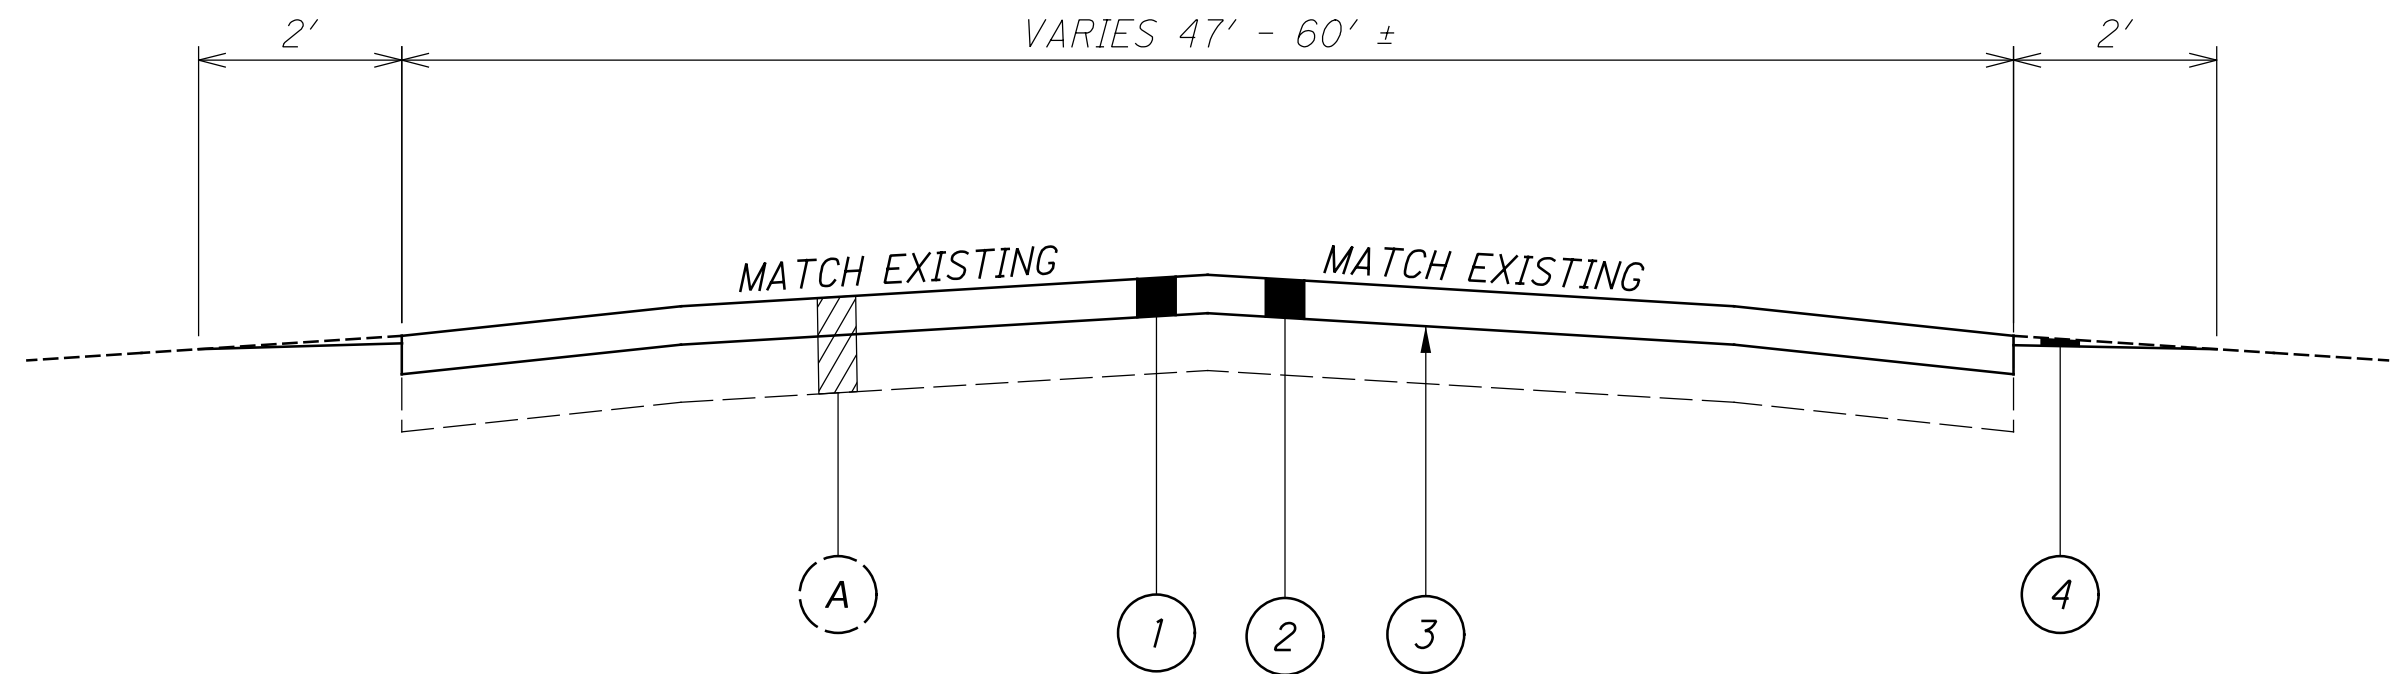

TYPICAL 3
PARKING LOT F-1

LEGEND


- A - EXISTING ASPHALT PAVEMENT
- 1 - ITEM 441 - ASPHALT CONCRETE SURFACE COURSE, TYPE 1 (449), PG64-22 1.50"
- 2 - ITEM 254 - PAVEMENT PLANING 1.50"
- 3 - ITEM 407 - NON-TACKING TACK COAT (0.085 GAL/SY)
- 4 - ITEM 617 - COMPACTED AGGREGATE 1.5" (average thickness)

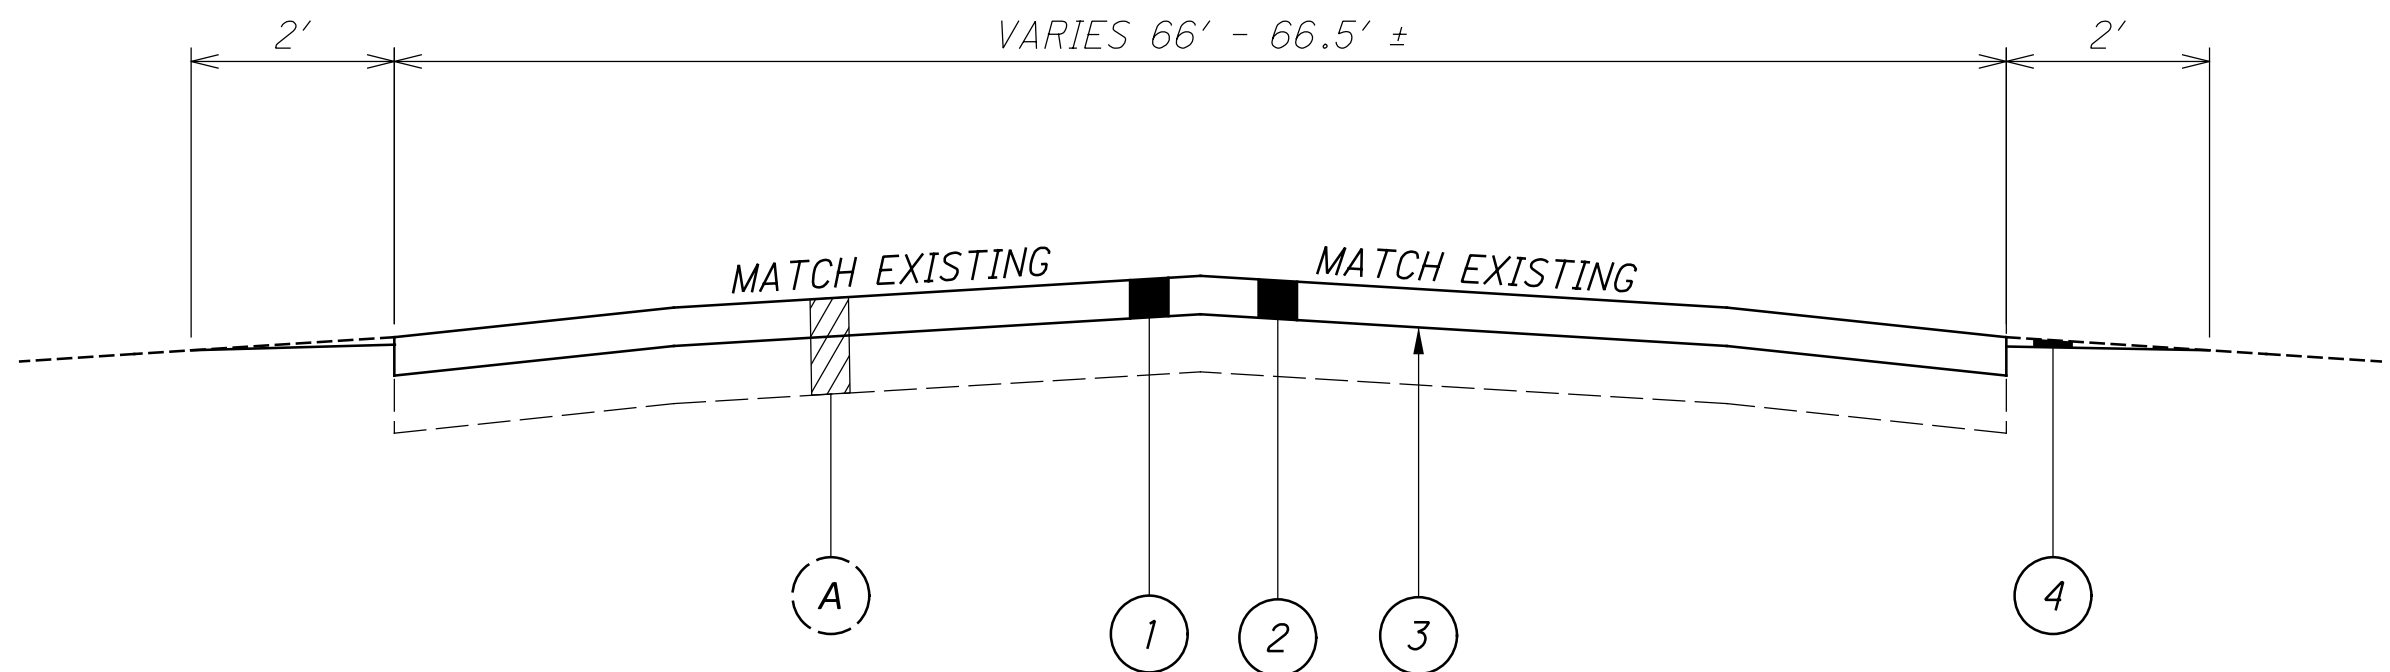

TYPICAL 4
PARKING LOT F-2

LEGEND


- A - EXISTING ASPHALT PAVEMENT
- 1 - ITEM 441 - ASPHALT CONCRETE SURFACE COURSE, TYPE 1 (449), PG64-22 1.50"
- 2 - ITEM 254 - PAVEMENT PLANING 1.50"
- 3 - ITEM 407 - NON-TACKING TACK COAT (0.085 GAL/SY)
- 4 - ITEM 617 - COMPACTED AGGREGATE 1.5" (average thickness)

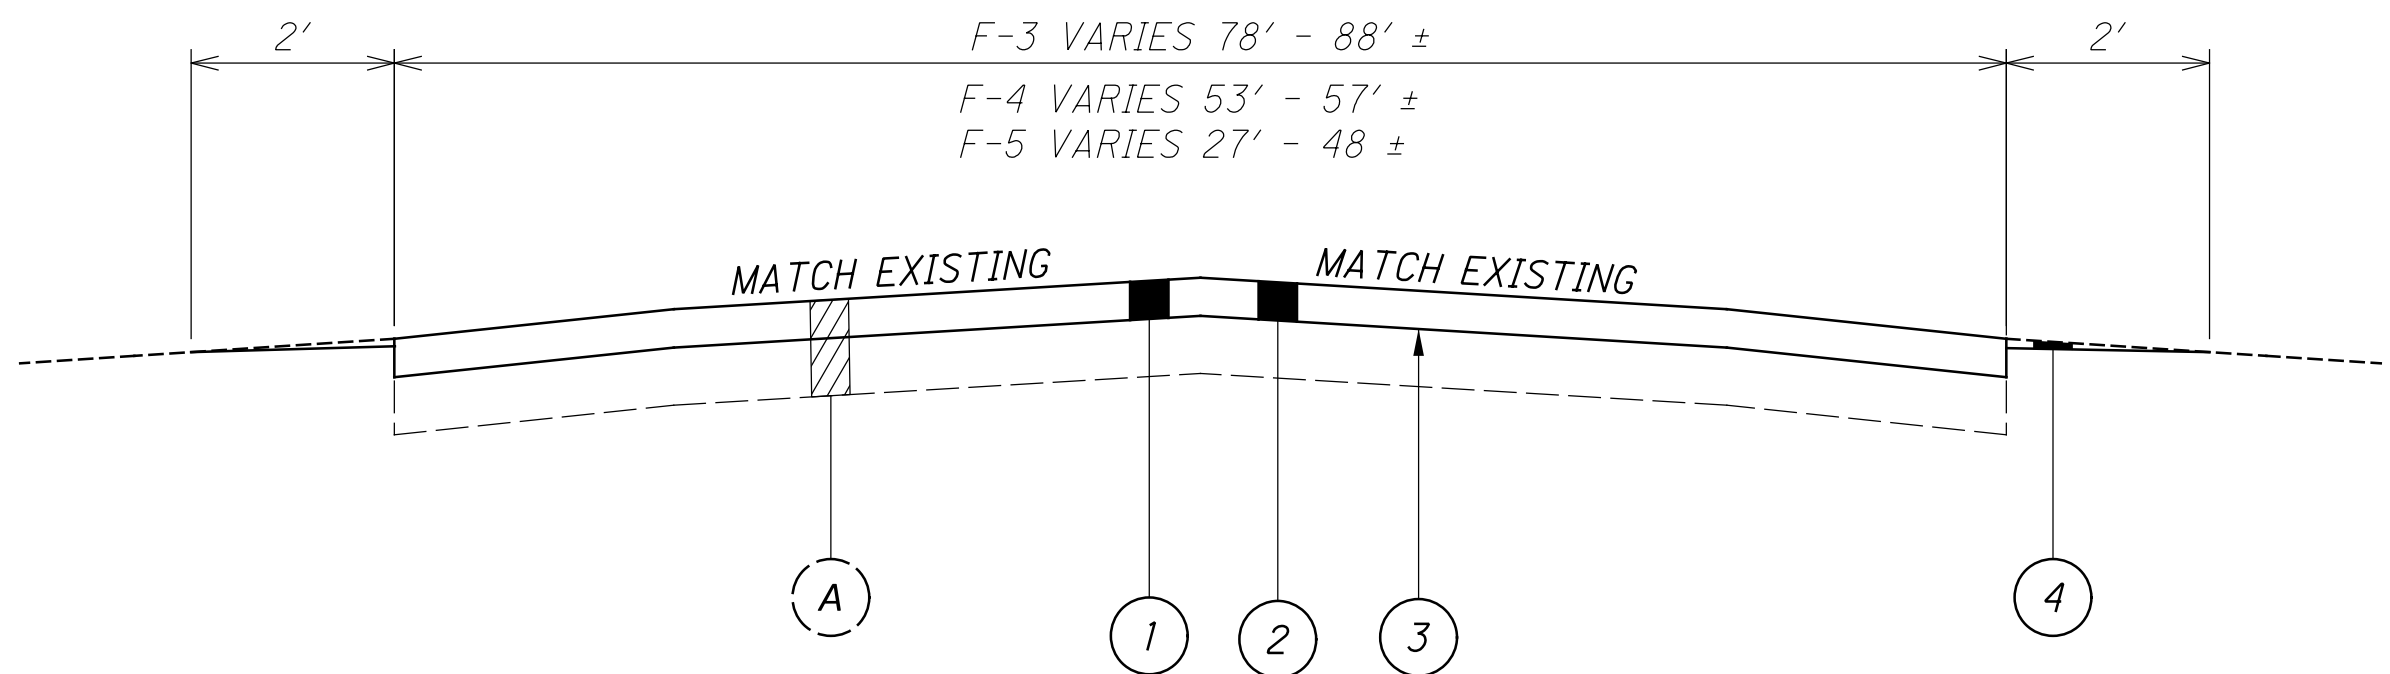

TYPICAL 5
PARKING LOT F-3, F-4, F-5

LEGEND

- A - EXISTING ASPHALT PAVEMENT
- 1 - ITEM 441 - ASPHALT CONCRETE SURFACE COURSE, TYPE 1 (449), PG64-22 1.50"
- 2 - ITEM 254 - PAVEMENT PLANING 1.50"
- 3 - ITEM 407 - NON-TACKING TACK COAT (0.085 GAL/SY)
- 4 - ITEM 617 - COMPACTED AGGREGATE 1.5" (average thickness)

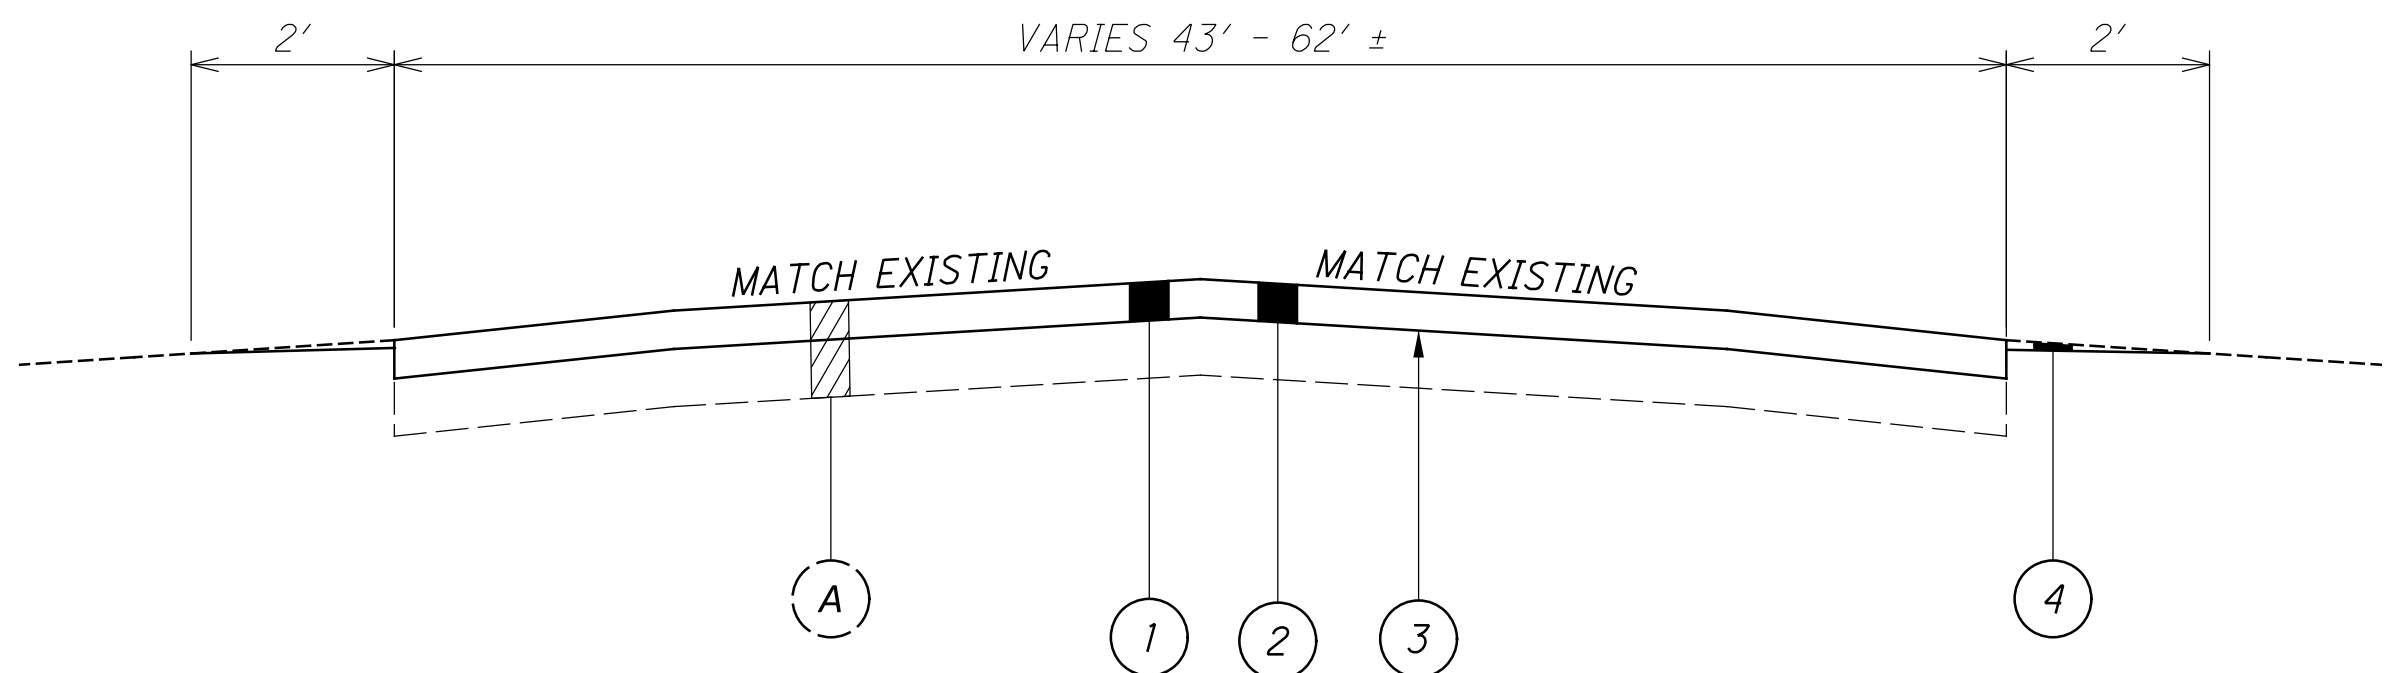

TYPICAL 6
PARKING LOT F-8

LEGEND

- A - EXISTING ASPHALT PAVEMENT
- 1 - ITEM 441 - ASPHALT CONCRETE SURFACE COURSE, TYPE 1 (449), PG64-22 1.50"
- 2 - ITEM 254 - PAVEMENT PLANING 1.50"
- 3 - ITEM 407 - NON-TACKING TACK COAT (0.085 GAL/SY)
- 4 - ITEM 617 - COMPACTED AGGREGATE 1.5" (average thickness)

CLA CLARK LAKE WLF

MODEL: Sheet PAPERSIZE: 34x22 (in.) DATE: 9/3/2025 TIME: 10:11:13 AM PLTDRV: OHDOT_PDF.pltcrfg PENTBL: OHDOT_Pen.tbl USER: Benjamin.Ankrom@dot.ohio.gov WORKSPACE: OHDOTCEV02 WORKSET: 111255 PRODUCT: OpenRoadsDesigner 24.00.00.205
pww\ohdot-pw.bentley.com:ohdot-pw-02\Documents\01 Active Projects\District 07\Clark\111255400-Engineering\Roadway\Sheets\111255 GG001.dgn

[illegible]

GENERAL SUMMARY

DESIGN AGENCY



*DISTRICT 7
ENGINEERING*

DESIGNER

REB


REVIEWER

XXX MM-DD-YY

PROJECT ID

111255

SHEET	TOTAL
P.04	7

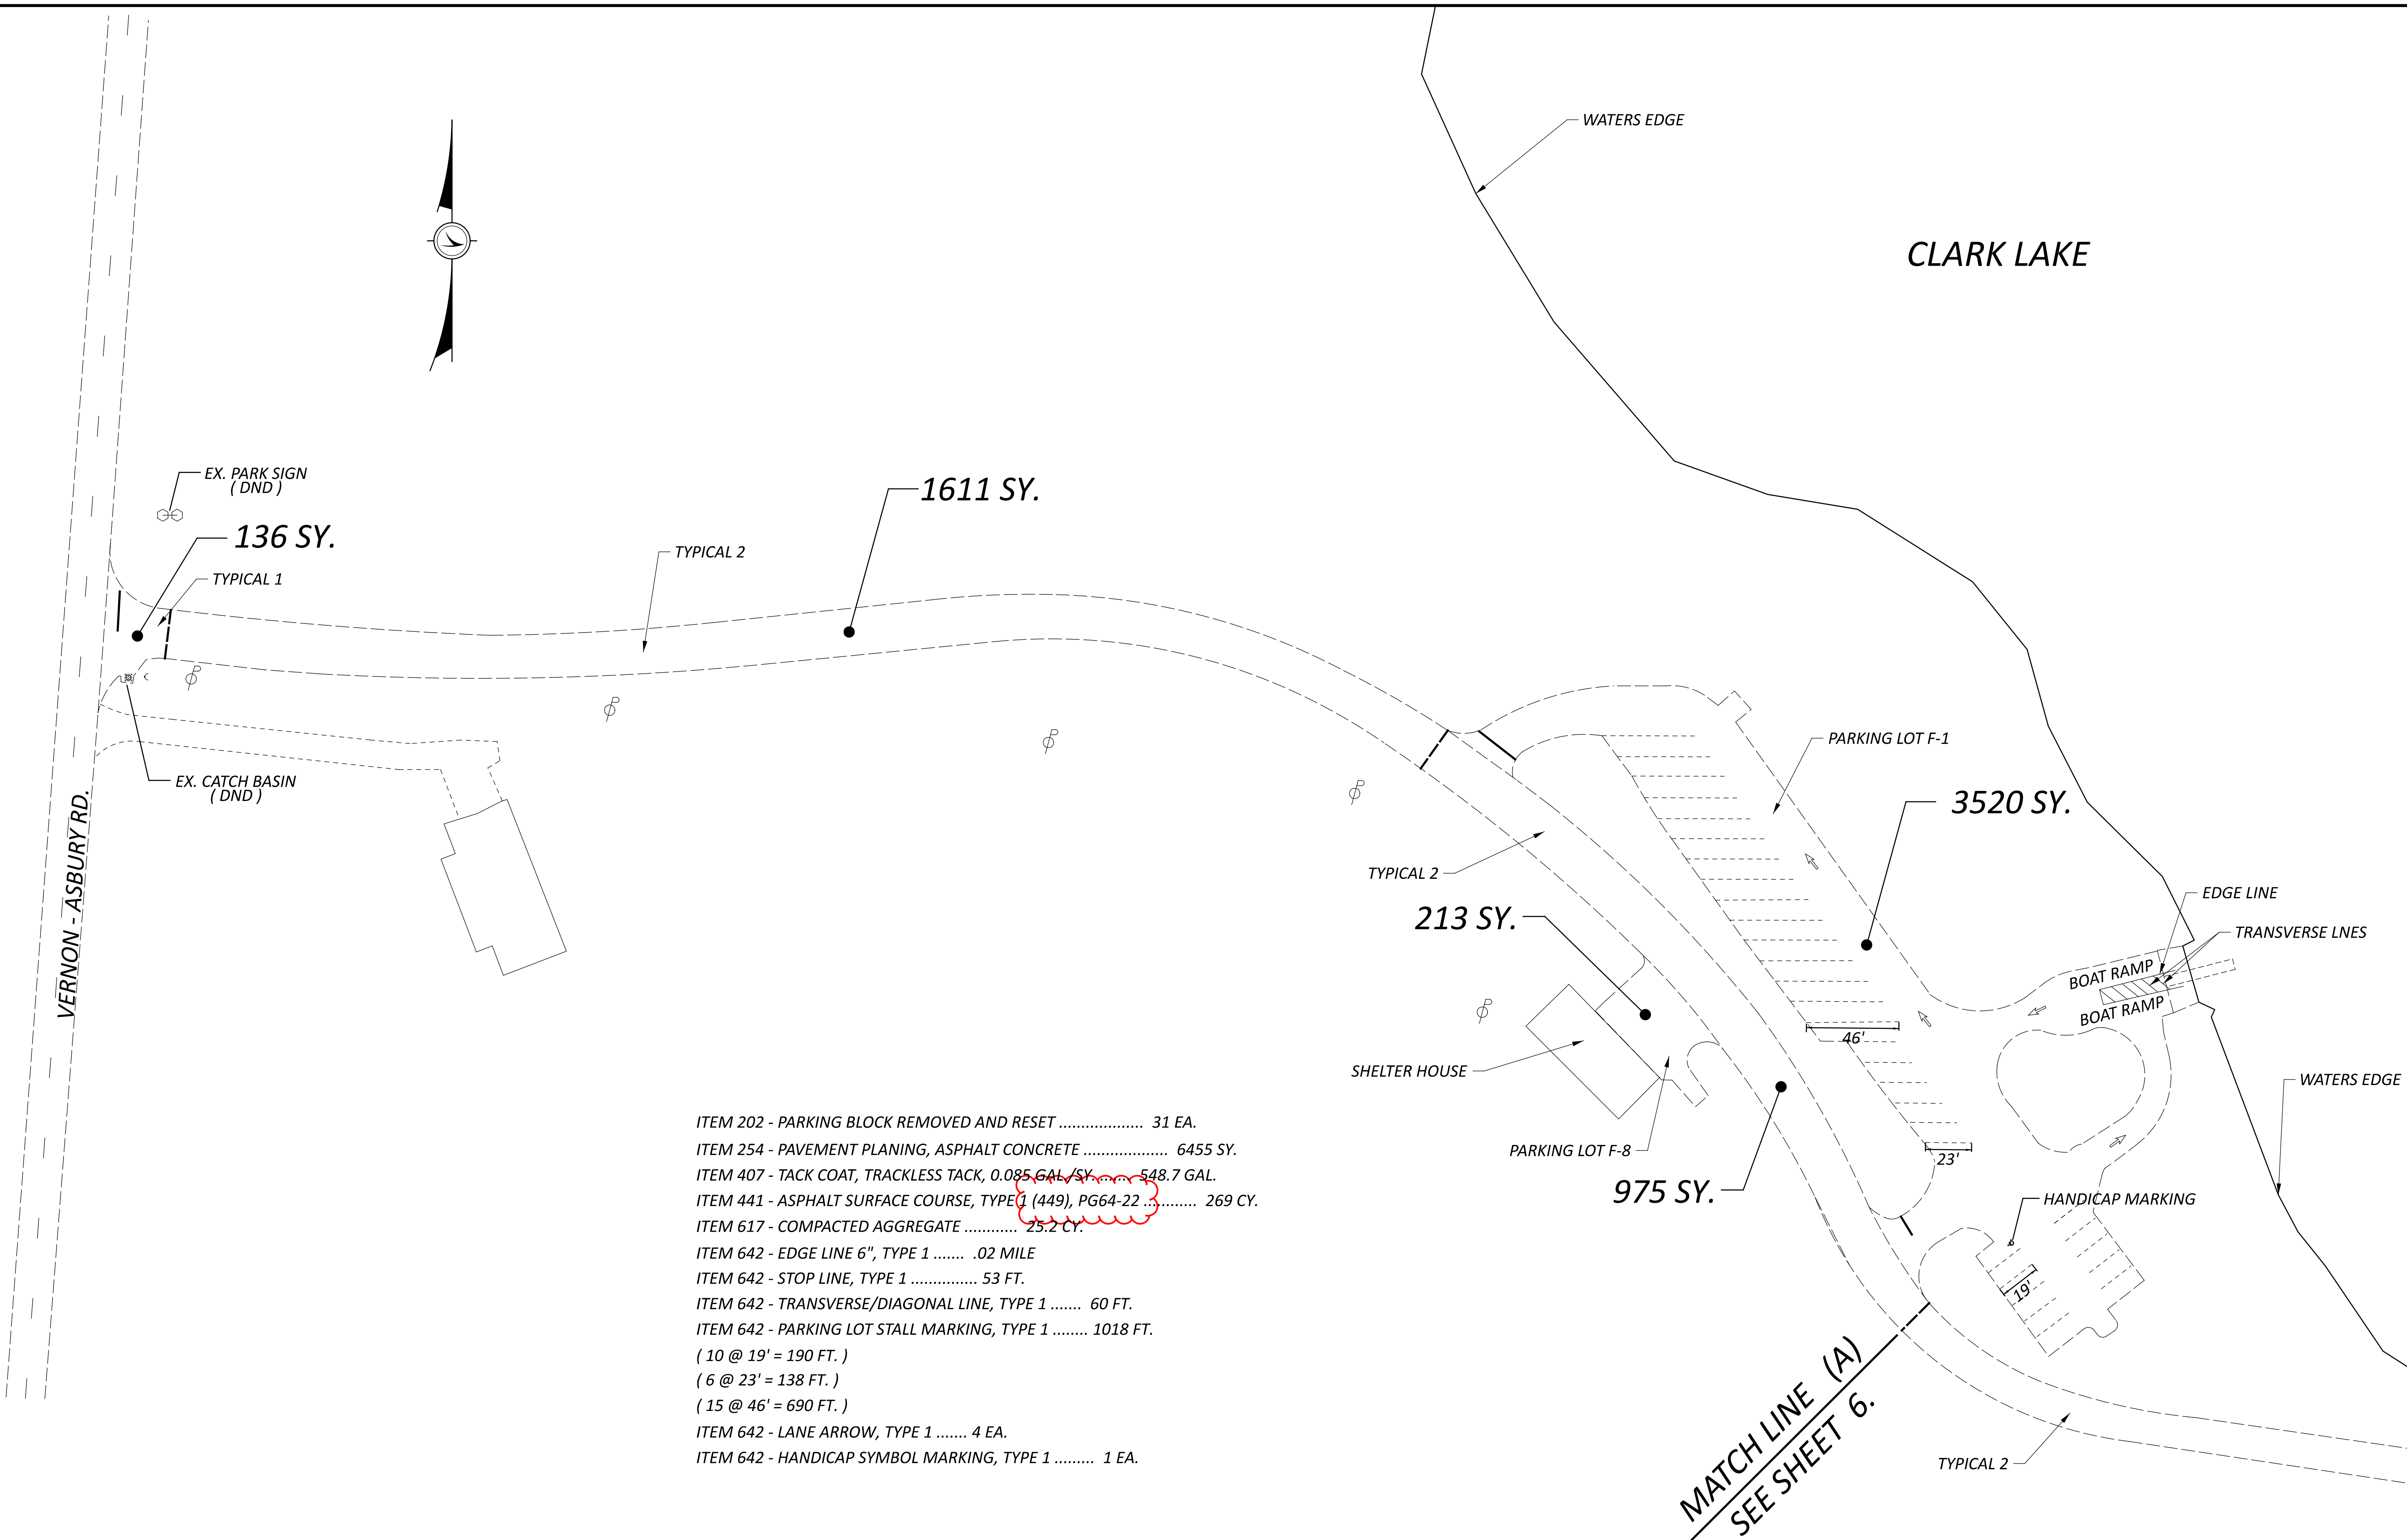

- ITEM 202 - PARKING BLOCK REMOVED AND RESET 31 EA.
- ITEM 254 - PAVEMENT PLANING, ASPHALT CONCRETE 6455 SY.
- ITEM 407 - TACK COAT, TRACKLESS TACK, 0.085 GAL/SY 548.7 GAL.
- ITEM 441 - ASPHALT SURFACE COURSE, TYPE 1 (449), PG64-22 269 CY.
- ITEM 617 - COMPACTED AGGREGATE 25.2 CY.
- ITEM 642 - EDGE LINE 6", TYPE 102 MILE
- ITEM 642 - STOP LINE, TYPE 1 53 FT.
- ITEM 642 - TRANSVERSE/DIAGONAL LINE, TYPE 1 60 FT.
- ITEM 642 - PARKING LOT STALL MARKING, TYPE 1 1018 FT.
(10 @ 19' = 190 FT.)
(6 @ 23' = 138 FT.)
(15 @ 46' = 690 FT.)
- ITEM 642 - LANE ARROW, TYPE 1 4 EA.
- ITEM 642 - HANDICAP SYMBOL MARKING, TYPE 1 1 EA.

HORIZONTAL
SCALE IN FEET

0

20

40

80

PLAN SHEET

CLA CLARK LAKE WLF

DESIGN AGENCY



DISTRICT 7
ENGINEERING

DESIGNER

REB

REVIEWER

XXX MM-DD-YY

PROJECT ID

111255

SHEET

P.05

TOTAL

7

