


I:\ProjectData\CLE\05138_CLE_GPS-FY2023\Design\Roadway\Sheets\05138_GG001.dgn_Sheet 5/2/2022 12:59:20 PM jdaVis4

SHEET NUM.								PART.		ITEM	ITEM EXT	GRAND TOTAL	UNIT	DESCRIPTION	SEE SHEET NO.
3	4	5	8	9	10	11	01/STR/PV	02/S>2/PV							
													ROADWAY		
						2	2		202	23000	2	SY	PAVEMENT REMOVED		
						474	474		202	30000	474	SF	WALK REMOVED		
						4	4		202	32000	4	FT	CURB REMOVED		
					525			525	202	38000	525	FT	GUARDRAIL REMOVED		
					8			8	202	42001	8	EACH	ANCHOR ASSEMBLY REMOVED, TYPE A, AS PER PLAN	10	
						1	1		203	10000	1	CY	EXCAVATION		
					325			325	606	15100	325	FT	GUARDRAIL, TYPE MGS WITH LONG POSTS		
					8			8	606	26150	8	EACH	ANCHOR ASSEMBLY, MGS TYPE E, (NCHRP 350 OR MASH 2016)		
						86	86		608	10000	86	SF	4" CONCRETE WALK		
						450	450		608	52000	450	SF	CURB RAMP	11	
2							1	1	623	39500	2	EACH	MONUMENT ASSEMBLY ADJUSTED TO GRADE		
													EROSION CONTROL		
							500	500	832	30000	1,000	EACH	EROSION CONTROL		
													DRAINAGE		
2							1	1	611	98630	2	EACH	CATCH BASIN ADJUSTED TO GRADE		
5							2	3	611	99654	5	EACH	MANHOLE ADJUSTED TO GRADE		
													PAVEMENT		
225						10	100	125	253	02000	225	CY	PAVEMENT REPAIR, (A)		
							10		253	02000	10	CY	PAVEMENT REPAIR, (B)		
			5,838				2,987	2,851	407	20000	5,838	GAL	NON-TRACKING TACK COAT		
			2,703				1,383	1,320	424	14000	2,703	CY	FINE GRADED POLYMER ASPHALT CONCRETE, TYPE B, (448)		
			286				170	116	617	10100	286	CY	COMPACTED AGGREGATE		
			6,876				4,072	2,804	617	20000	6,876	SY	SHOULDER PREPARATION		
			6				2	4	617	25000	6	MGAL	WATER		
			97,295				49,787	47,508	897	01010	97,295	SY	PAVEMENT PLANING, ASPHALT CONCRETE, CLASS A, 1"		
			979				501	478	897	02000	979	SY	PATCHING PLANED SURFACE		
													WATER WORK		
5							2	3	638	10800	5	EACH	VALVE BOX ADJUSTED TO GRADE		
													TRAFFIC CONTROL		
587							250	337	621	00100	587	EACH	RPM		
587							250	337	621	54000	587	EACH	RAISED PAVEMENT MARKER REMOVED		
					14			14	626	00110	14	EACH	BARRIER REFLECTOR, TYPE 2, BI-DIRECTIONAL		
39							39		630	03100	39	FT	GROUND MOUNTED SUPPORT, NO. 3 POST		
2							2		630	84900	2	EACH	REMOVAL OF GROUND MOUNTED SIGN AND DISPOSAL		
4							4		630	85100	4	EACH	REMOVAL OF GROUND MOUNTED SIGN AND REERECTION		
4							4		630	86002	4	EACH	REMOVAL OF GROUND MOUNTED POST SUPPORT AND DISPOSAL		
				11.72			6.94	4.78	644	00104	11.72	MILE	EDGE LINE, 6"		
				6.16			3.49	2.67	644	00300	6.16	MILE	CENTER LINE		
				315			315		644	00620	315	FT	CROSSWALK LINE, 12"		
				1,480				1,480	644	00404	1,480	FT	CHANNELIZING LINE, 12"		
				202				202	644	00500	202	FT	STOP LINE		
				410				410	644	00700	410	FT	TRANSVERSE/DIAGONAL LINE		
				46				46	644	00720	46	FT	CHEVRON MARKING		
				236				236	644	00900	236	SF	ISLAND MARKING		
				44				44	644	01300	44	EACH	LANE ARROW		
				160				160	644	01510	160	FT	DOTTED LINE, 6"		
				0.12				0.12	646	10010	0.12	MILE	EDGE LINE, 6"		
				0.06				0.06	646	10200	0.06	MILE	CENTER LINE		

CALCULATED JD	CHECKED JDO
GENERAL SUMMARY	
CLE-50/131- 2.21/8.51	
6 14	

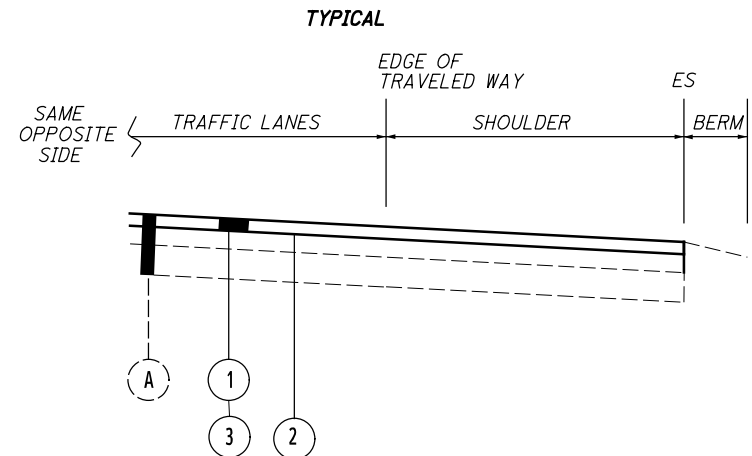

- (A) EXISTING ASPHALT CONCRETE PAVEMENT
- (1) ITEM 424 - 1" FINE GRADED POLYMER ASPHALT CONCRETE, TYPE B
- (2) ITEM 407 - NON-TRACKING TACK COAT
- (3) ITEM 897 - 1" PAVEMENT PLANING ASPHALT CONCRETE, CLASS A

I:\ProjectData\CLE\05138_CLE-GPS-FY2023\Design\Roadway\Sheets\05138_GC001.dgn_Sheet_5/2/2022 12:59 PM_jdavis4

PLAN SPLIT	COUNTY-ROUTE	LOG POINT (MILE)		LENGTH		PAVEMENT AREA (Micro-Station Generated Area)	PAVEMENT AREA	897		PATCHING PLANED SURFACE	407 NON TRACKING TACK COAT @ 0.06 GAL/SQ YD	424		617 COMPACTED AGGREGATE, 1.5" DEPTH, 12" WIDTH	SHOULDER PREPARATION	WATER @ 20 GAL/CU YD	NOTES	
		FROM	TO	MILES	FT			SQ FT	SQ YD			PAVEMENT PLANING ASPHALT CONCRETE, CLASS A	THICKNESS					CU YD
												DEPTH	SQ YD					INCHES
02/S>2/PV	CLE-50	2.21	2.71	0.50	2640	46176	5131	1.00	5130.7	52	307.8	1.00	142.5	24.4	586.7	0.5		
02/S>2/PV	CLE-50	2.71	3.21	0.50	2640	151531	16837	1.00	16836.8	169	1010.2	1.00	467.7	24.4	586.7	0.5		
02/S>2/PV	CLE-50	3.21	3.71	0.50	2640	92635	10293	1.00	10292.8	103	617.6	1.00	285.9	24.4	586.7	0.5		
02/S>2/PV	CLE-50	3.71	4.21	0.50	2640	79360	8818	1.00	8817.8	89	529.1	1.00	244.9	24.4	586.7	0.5		
02/S>2/PV	CLE-40	4.21	4.60	0.39	2059	57872	6430	1.00	6430.2	65	385.8	1.00	178.6	19.1	457.6	0.4		
01/STR/PV	CLE-131	8.51	9.21	0.70	3696	86930	9659	1.00	9658.9	97	579.5	1.00	268.3	34.2	821.3	0.7		
01/STR/PV	CLE-131	9.21	9.51	0.30	1584	35975	3997	1.00	3997.2	40	239.8	1.00	111.0	14.7	352.0	0.3		
01/STR/PV	CLE-131	9.51	10.01	0.50	2640	61222	6802	1.00	6802.4	69	408.1	1.00	189.0	24.4	586.7	0.5		
01/STR/PV	CLE-131	10.01	10.51	0.50	2640	80779	8975	1.00	8975.4	90	538.5	1.00	249.3	24.4	586.7	0.5		
01/STR/PV	CLE-131	10.51	11.01	0.50	2640	63590	7066	1.00	7065.6	71	423.9	1.00	196.3	24.4	586.7	0.5		
01/STR/PV	CLE-131	11.01	11.51	0.50	2640	60588	6732	1.00	6732.0	68	403.9	1.00	187.0	24.4	586.7	0.5		
	CLE-131	11.51	11.98	0.47	2482	58990	6554	1.00	6554.4	66	393.3	1.00	182.1	23.0	551.5	0.5		
TOTALS CARRIED TO GENERAL SUMMARY								X	97295	979	5838	X	2703	286	6876	6	X	

PAVEMENT CALCULATIONS

**CLE-50/131-
2.21/8.51**