

Phil Hold - 650 P. 123


1	2	3	4
5	6	7	8

LOCATION PLAN COL-14-7.94 1955 SCALE 1"=200'

AUG 30 2 11 PM '55

PLAT BOOK 5 PAGE 57

STA. 31+00
BEGIN PROJECT

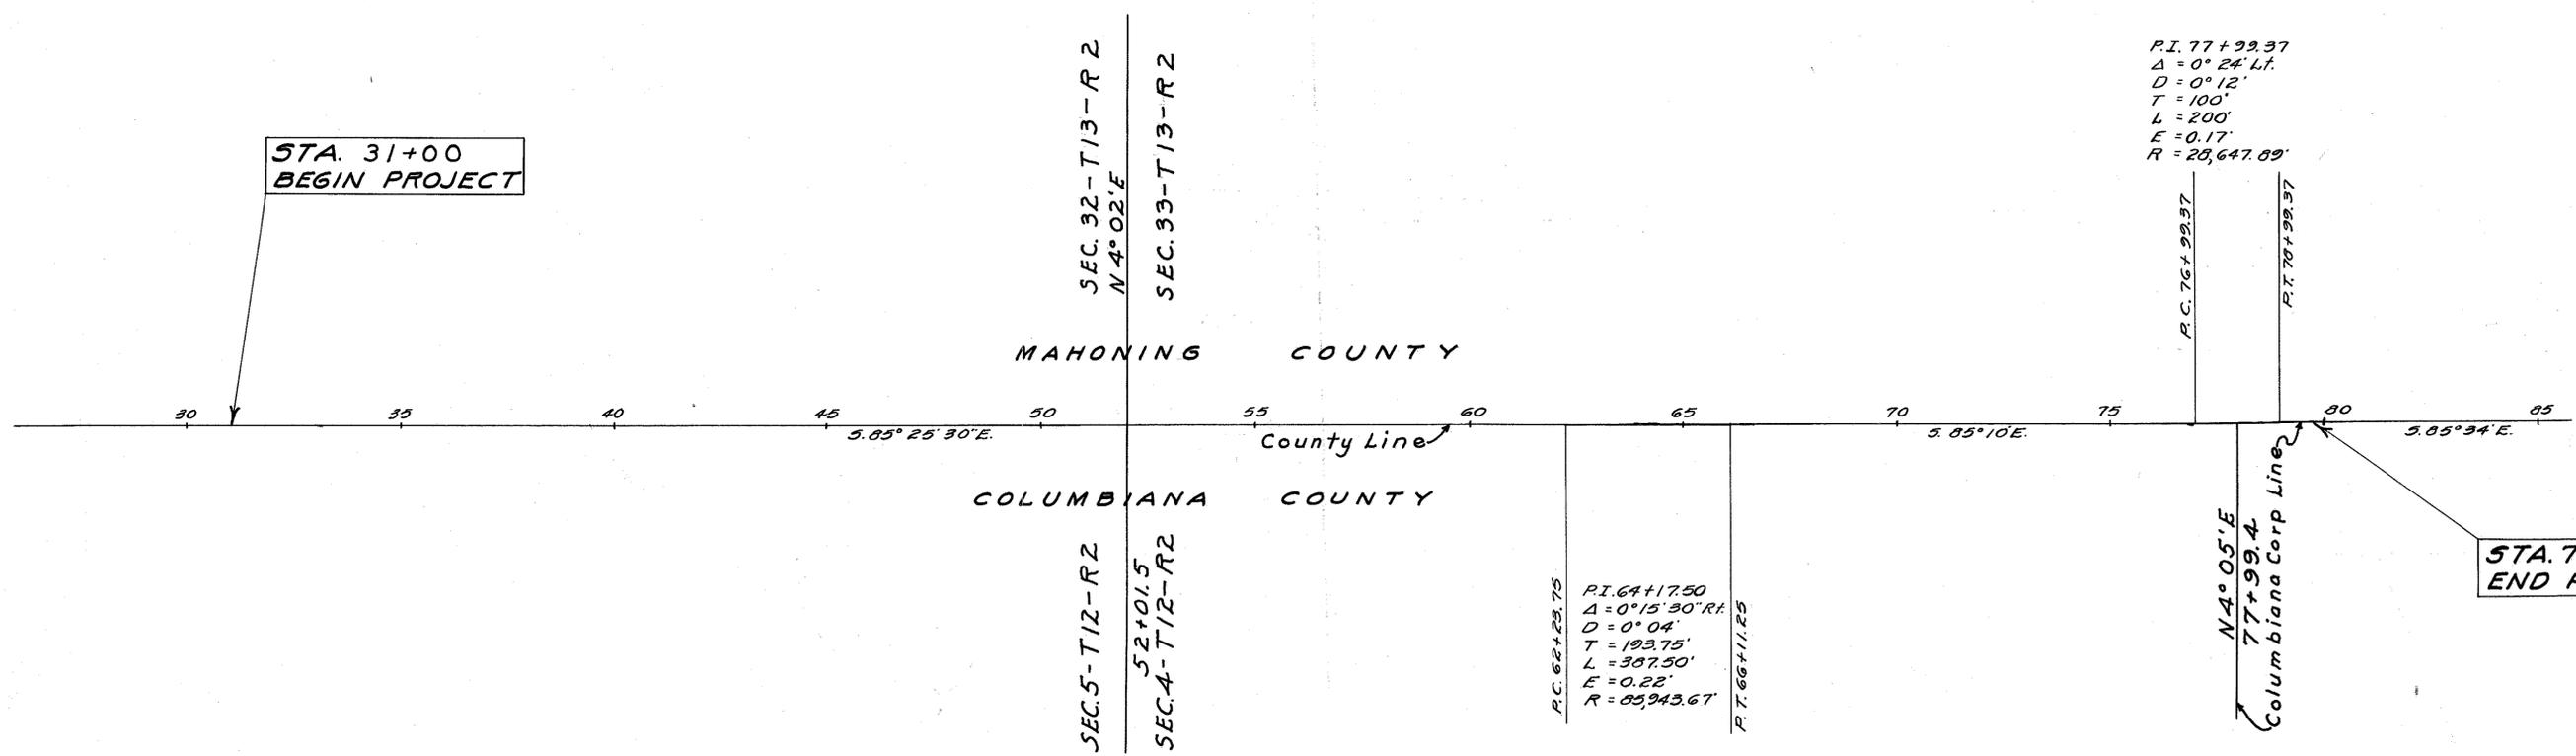

P.I. 77+99.37
 $\Delta = 0^\circ 24' Lt.$
 $D = 0^\circ 12'$
 $T = 100'$
 $L = 200'$
 $E = 0.17'$
 $R = 28,647.89'$

P.I. 64+17.50
 $\Delta = 0^\circ 15' 30'' Rt.$
 $D = 0^\circ 04'$
 $T = 193.75'$
 $L = 387.50'$
 $E = 0.22'$
 $R = 85,943.67'$

Needs No Transfer September 30th 1955

C. B. Rayburn, Jr. Esq.
Mahoning County Auditor

Received for Record September 30th 1955 at 11:15 a.m.
Recorded October 3rd 1955 Vol 40 Pages 4 & 5

William D. Holt
Mahoning County Recorder

All Monuments Will Be Placed 6" Below Berm Line
CENTER LINE REFERENCE MONUMENTS WILL BE PLACED BEFORE OR AFTER CONSTRUCTION

Monuments will be set as per sketch shown at left, at the following stations

P.O.T. 31+00	P.C. 62+23.75
" 36+50	P.T. 66+11.25
" 41+00	P.O.T. 72+00
" 46+00	P.C. 76+99.37
" 51+00	P.T. 78+99.37
" 56+00	

I hereby certify that this plot is correct to the best of my knowledge and belief.
 Dean R. Severn
 Division Engineer
 Date 8-15-55
 1200


BK 5 Page 57

D.H.K.

LIMITED ACCESS

5-LA
Merle H. Esterly
Estella G. Esterly
1.35 Ac.

6-LA
Merle H. Esterly
0.19 Ac.

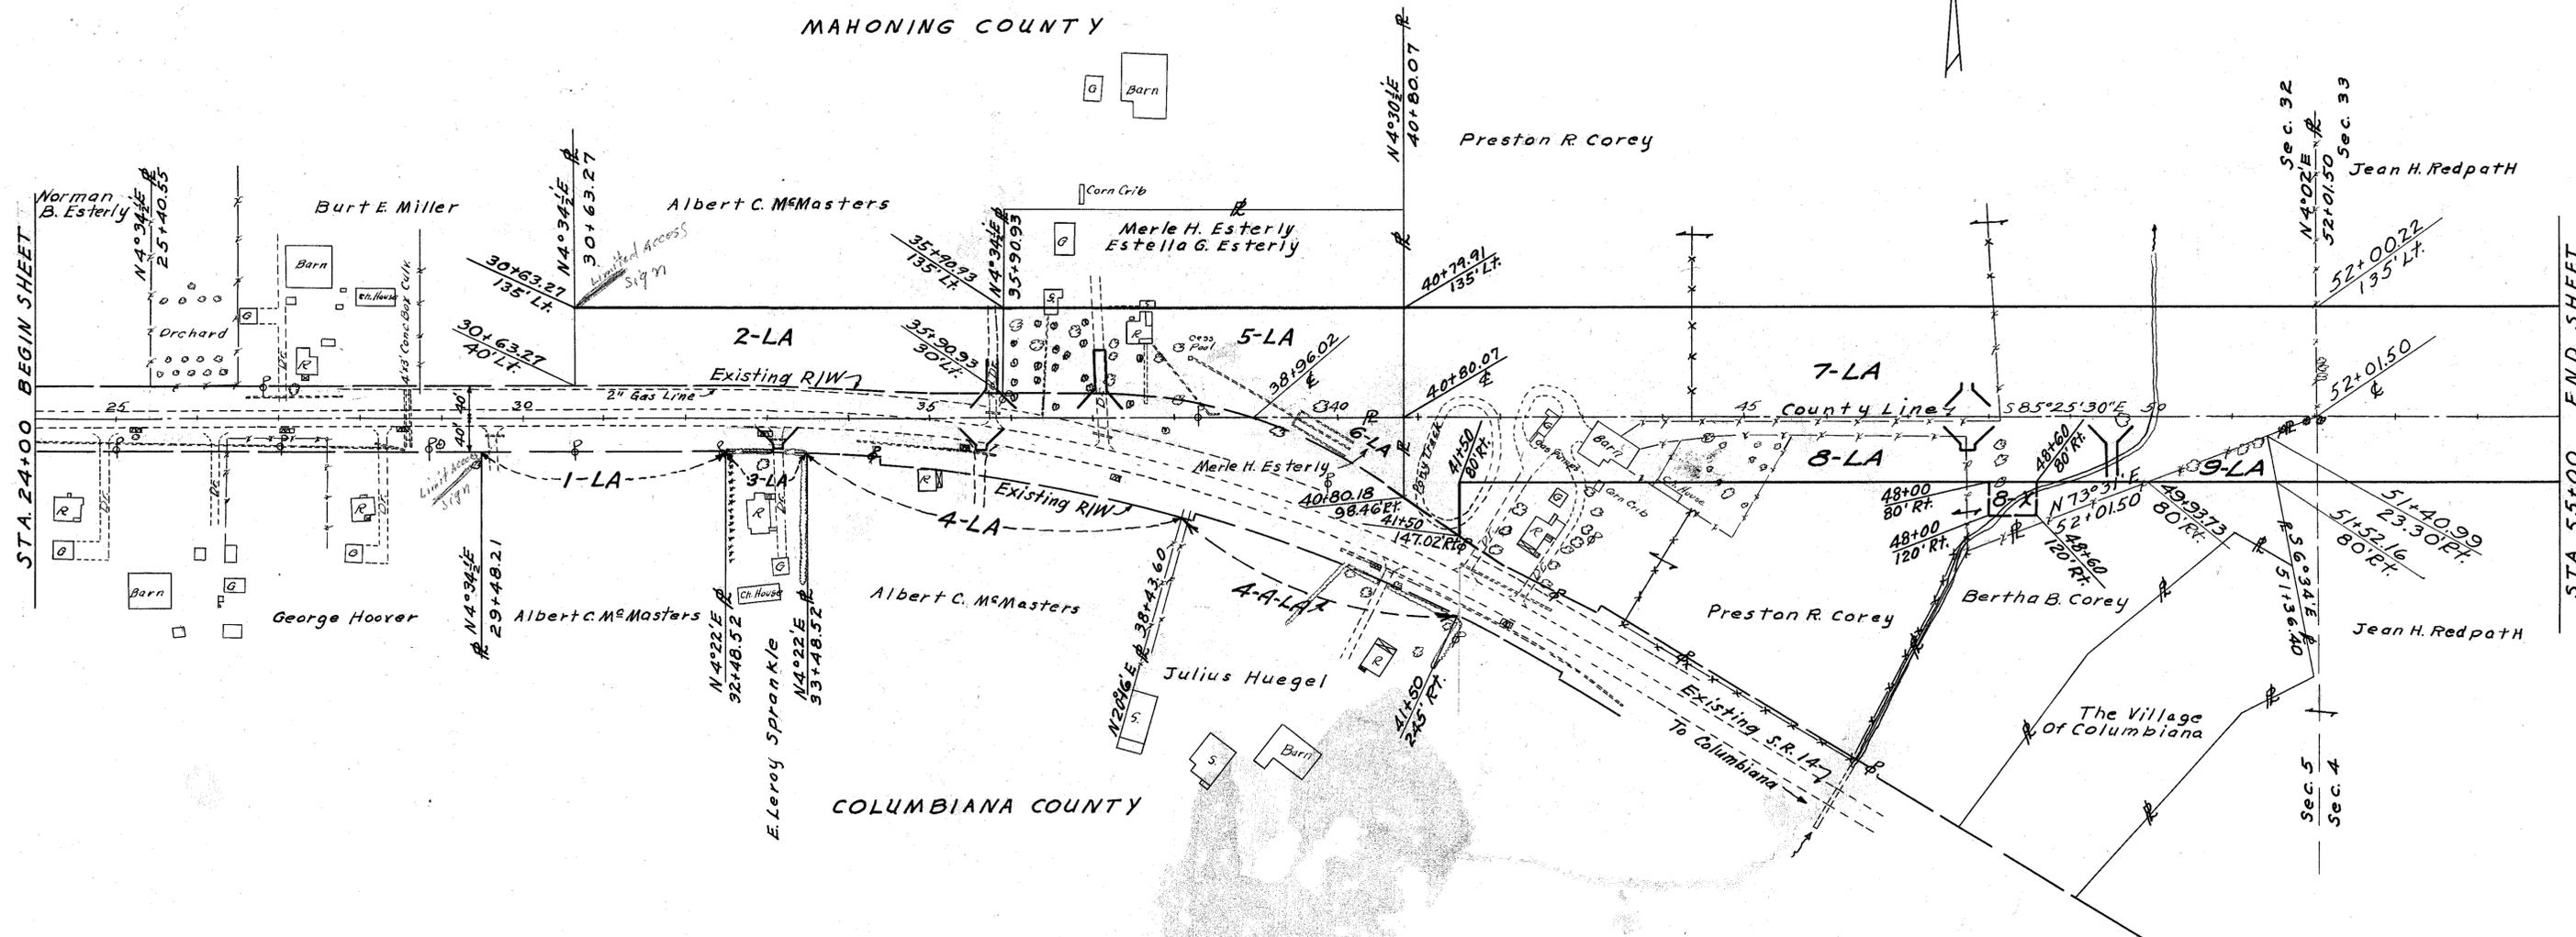

SR 46
is STA 24+00

4-A-LA
Julius Huegel
Limited Access Only

1-LA, 2-LA, 4-LA
Albert C. McMasters
1-LA: Limited Access Only
2-LA: 1.18 Ac.
4-LA: Limited Access Only

3-LA
E. Leroy Sprankle
Limited Access Only

7-LA, 8-LA, 8-X
Preston R. Corey
7-LA: 3.47 Ac.
8-LA: 1.94 Ac.
8-X: 0.055 Ac.

9-LA
Bertha B. Corey
0.10 Ac.

LIMITED ACCESS

PARCEL 12-V

James R. & Helen M. Barrow
Vacated ~ Dec. 13, 1982
Containing ~ 2.731 Ac.


Recorded:
Director's Journal - Vol. 11, Page 345
Mahoning County Records - Vol. 74, Page 168-170
Feb. 24, 1983

PARCEL 12-V-1

St. Clair Properties, Inc.
Vacated ~ Aug. 9, 1990
Containing ~ 0.929 Ac.

Recorded:
Directors Journal - Vol. 19, Page 329
Mahoning County Records

PI = 77+99.37
Δ = 0°24' Lt.
D = 0°12'
T = 100'
L = 2.00'
E = 0.17
R = 28,647.89'

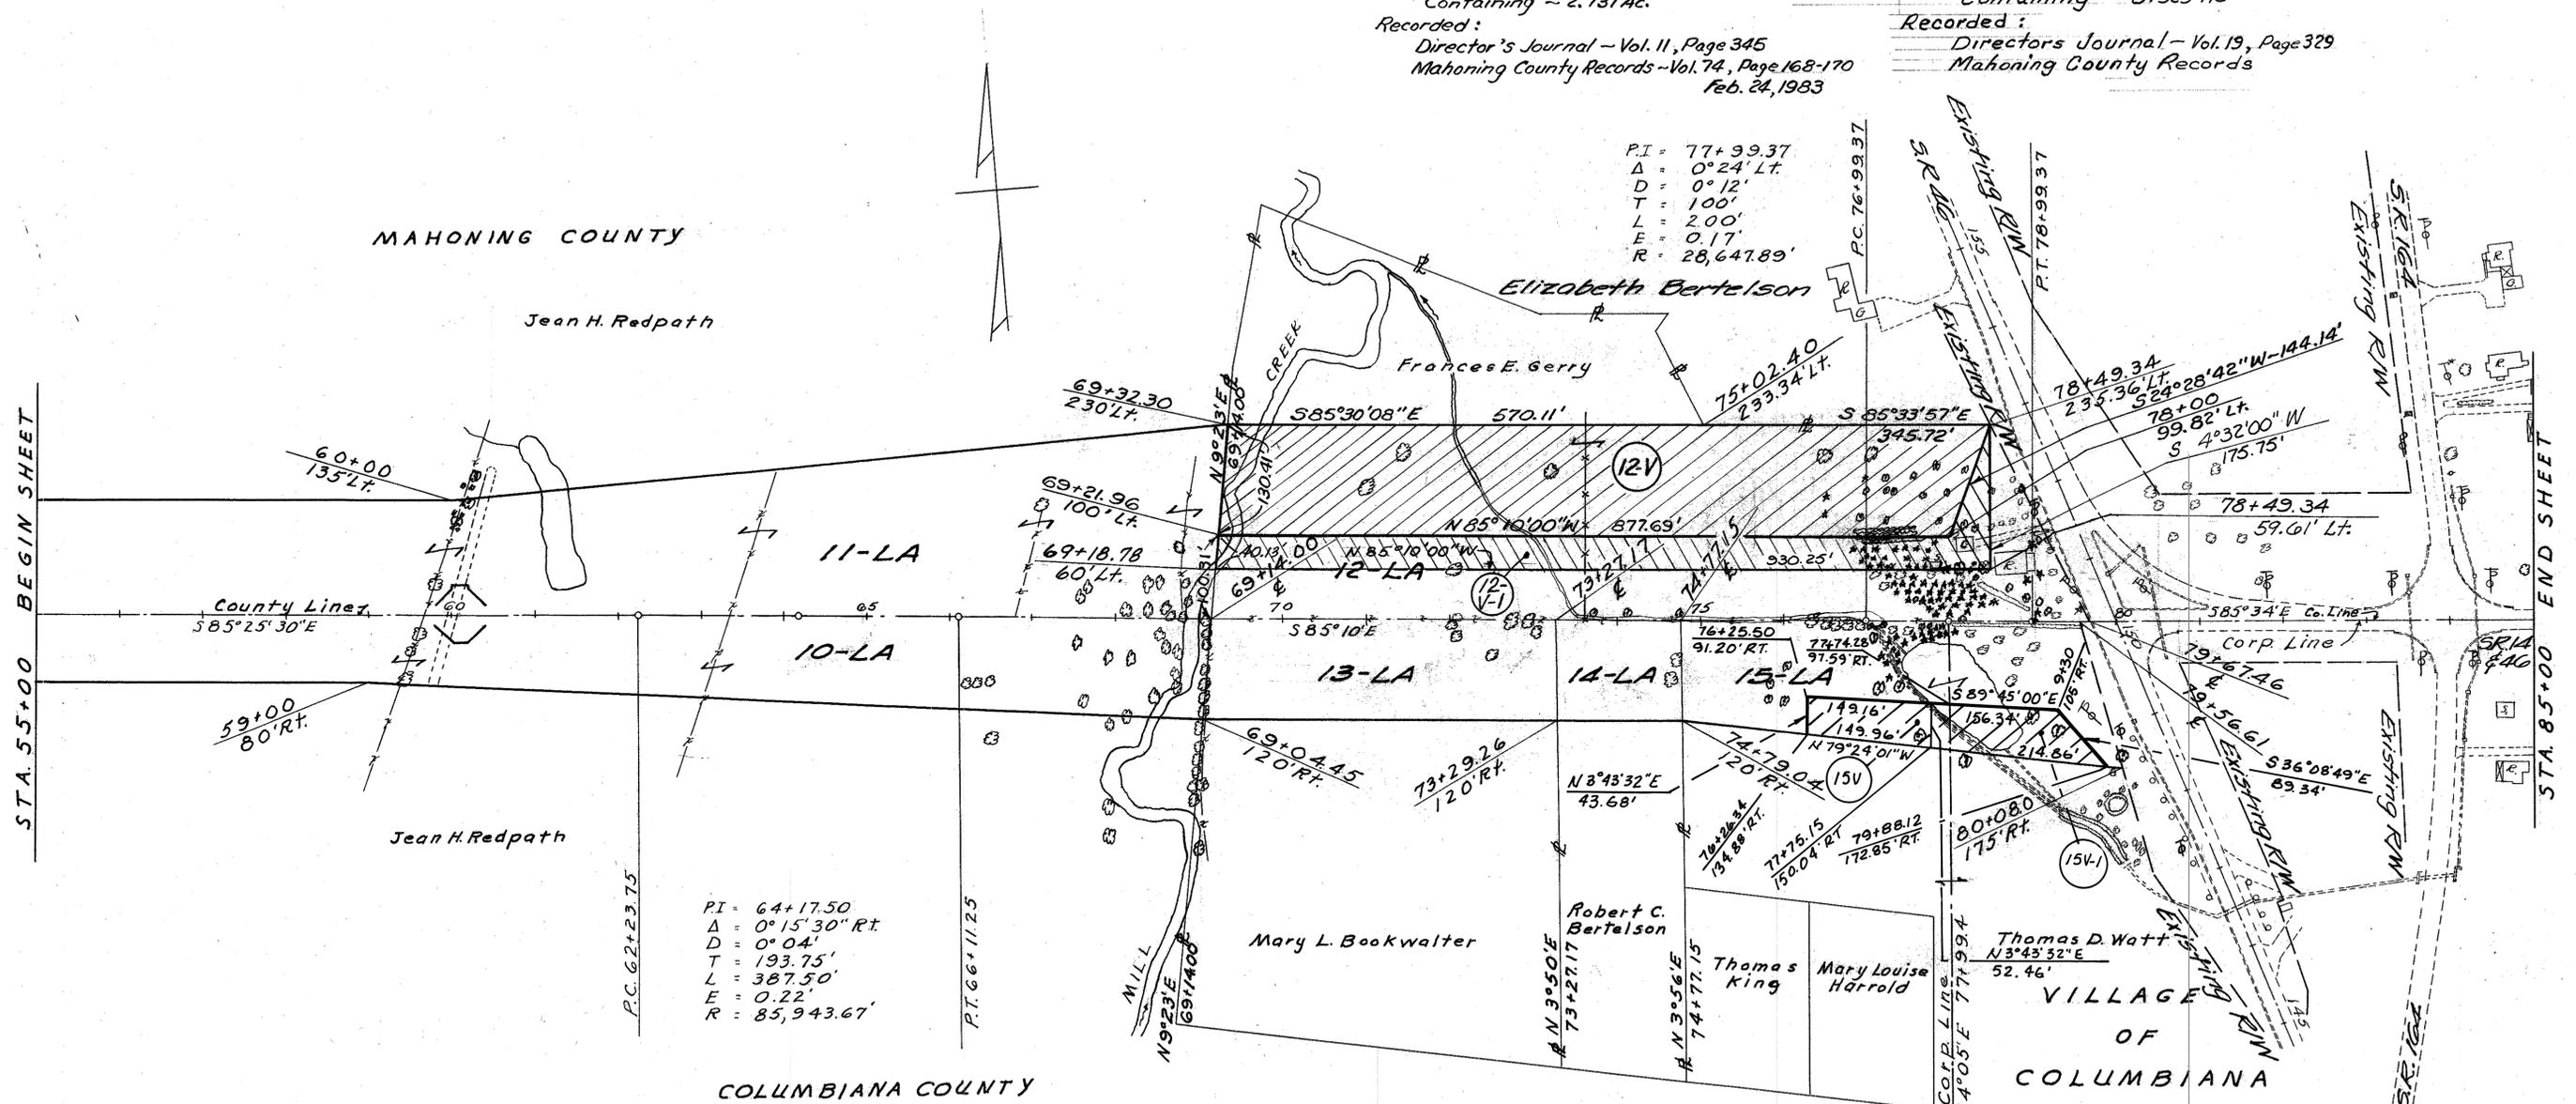

PI = 64+17.50
Δ = 0°15'30" Rt.
D = 0°04'
T = 193.75'
L = 387.50'
E = 0.22'
R = 85,943.67'

10-LA, 11-LA
Jean H. Redpath
10-LA: 3.70 Ac.
11-LA: 6.33 Ac.

12-LA
Frances E. Gerry
5.26 Ac.

13-LA
Mary L. Bookwalter
1.15 Ac.

14-LA
Robert C. Bertelson
0.41 Ac.

15-LA
Thomas D. Watt
1.69 Ac.

PARCEL 15V - DAVID A. FLYNN
VACATED OR 1506, Pg. 516 - 0.164 Ac.
RECORDED: COLUMBIANA COUNTY OR 1506, Pg. 516

PARCEL 15V-1 - DAVID A. FLYNN, INC.
VACATED OR 1506, Pg. 518 - 0.245 Ac.
RECORDED: COLUMBIANA COUNTY OR 1506, Pg. 516

Added Parcel No. 12-V 3-2-83
Added Parcel No. 12-V-1 11-7-90