
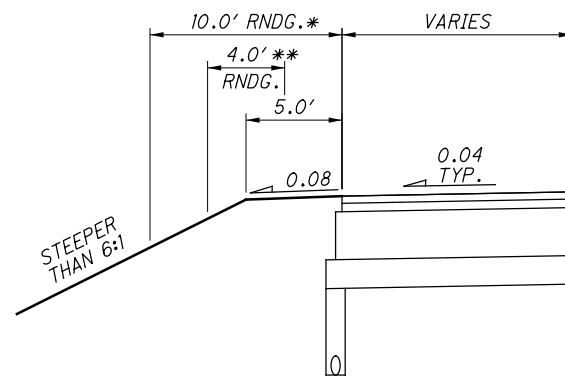
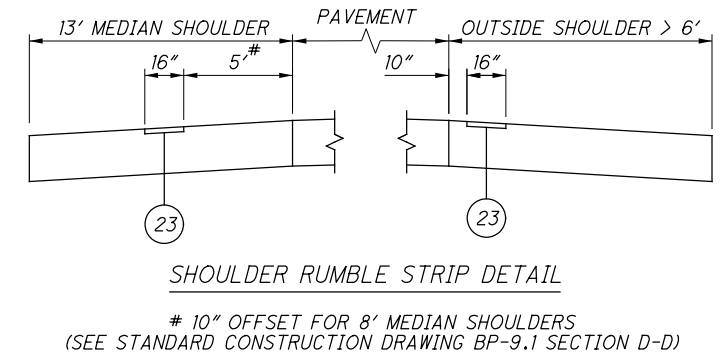
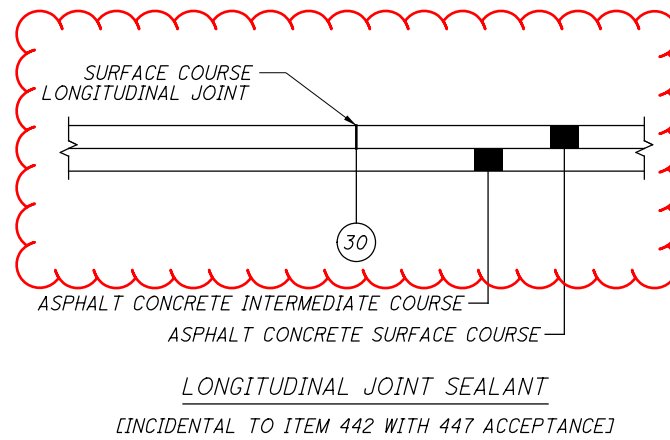
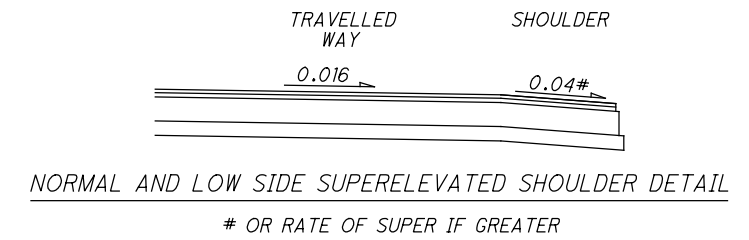
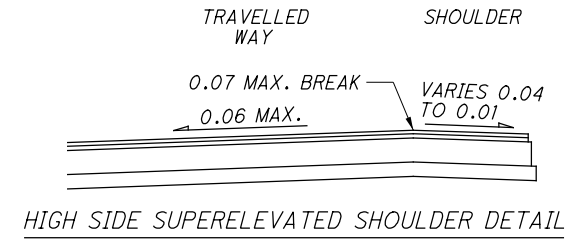




p:\aecom\NA-AWS\ecomonline\local\AECOM_DS01_NA\Documents\60527425-CUY-176-10.13\900-CAD_GIS\01941_CUY-176-10.13\Design\Roadway\Sheets\01941_GY007.dgn Sheet 6/19/2020 10:46:32 AM Robert.jank

PROPOSED LEGEND

- 1 ITEM 202 - PAVEMENT REMOVED
- 2 ITEM 202 - CURB REMOVED
- 3 NOT USED
- 4 ITEM 202 - CONCRETE BARRIER REMOVED
- 4A ITEM 202 - TRAFFIC ISLAND REMOVED
- 4B ITEM 202 - CONCRETE BARRIER REMOVED, AS PER PLAN
- 5 ITEM 204 - EMBANKMENT
- 6 ITEM 204 - SUBGRADE COMPACTION AND PROOF ROLLING
- 7 ITEM 204 - EXCAVATION OF SUBGRADE
- 8 ITEM 204 - GRANULAR MATERIAL, TYPE C (703.16)
- 9 ITEM 204 - GEOGRID (PLACED AT BOTTOM OF UNDERCUT)
- 10 ITEM 254 - PAVEMENT PLANING, ASPHALT CONCRETE (T = 3 1/4")
- 11 ITEM 442 - ASPHALT CONCRETE INTERMEDIATE COURSE, 19MM, TYPE A (448) (T = VARIABLE; 1.75" MIN. TO 5" MAX.) [2 LIFTS WHEN T > 3"]
- 12 ITEM 252 - FULL DEPTH PAVEMENT SAWING
- 13 ITEM 302 - ASPHALT CONCRETE BASE, PG64-22 (T = 7 1/2") (SEE NOTE 4)
- 14 ITEM 304 - AGGREGATE BASE (T = 6")
- 14A ITEM 304 - AGGREGATE BASE (T = 4")
- 15 ITEM 407 - NON-TRACKING TACK COAT
- 15A ITEM 411 - STABILIZED CRUSHED AGGREGATE, AS PER PLAN (T = 4")
- 16 ITEM 441 - ASPHALT CONCRETE INTERMEDIATE COURSE, TYPE 1, (448), (UNDER GUARDRAIL), AS PER PLAN (T = 3")
- 17 ITEM 442 - ASPHALT CONCRETE INTERMEDIATE COURSE, 19MM, TYPE A (446) (T = 1 3/4")
- 18 ITEM 442 - ASPHALT CONCRETE SURFACE COURSE, 12.5MM, TYPE A (447), AS PER PLAN, PG 76-22M (T = 1 1/2")
- 19 ITEM 452 - 12" NON-REINFORCED CONCRETE PAVEMENT, CLASS QC IP
- 20 ITEM 605 - 6" UNDERDRAINS WITH GEOTEXTILE FABRIC (FOR DEPTH AND TYPE, SEE SUBGRADE STABILIZATION DETAILS ON SHEETS 23 AND 24)
- 20A ITEM 605 - 6" ROCK CUT UNDERDRAINS
- 21 ITEM 606 - GUARDRAIL, TYPE MGS
- 22 ITEM 609 - CURB, TYPE 4-C
- 22A ITEM 452 - 4" NON-REINFORCED CONCRETE PAVEMENT, CLASS QC IP
- 23 ITEM 618 - RUMBLE STRIPS, SHOULDER (ASPHALT CONCRETE)
- 24 ITEM 622 - CONCRETE BARRIER, SINGLE SLOPE, TYPE B
- 25 ITEM 622 - CONCRETE BARRIER, SINGLE SLOPE, TYPE B1 (SEE NOTE 3)
- 26 ITEM 622 - CONCRETE BARRIER, SINGLE SLOPE, TYPE C
- 26A ITEM 622 - CONCRETE BARRIER, SINGLE SLOPE, TYPE C, AS PER PLAN
- 27 ITEM 622 - CONCRETE BARRIER, SINGLE SLOPE, TYPE C1 (SEE NOTE 3)
- 28 ITEM 622 - CONCRETE BARRIER, SINGLE SLOPE, TYPE D
- 28A ITEM 622 - CONCRETE BARRIER, SINGLE SLOPE, TYPE D, AS PER PLAN
- 28B ITEM 622 - PORTABLE BARRIER, 32", AS PER PLAN
- 29 ITEM 659 - SEEDING AND MULCHING, CLASS 2
- 30 ITEM 875 - LONGITUDINAL JOINT ADHESIVE [INCIDENTAL TO ITEM 442 WITH 447 ACCEPTANCE]
- L LONGITUDINAL JOINT PER SCD BP-2.1

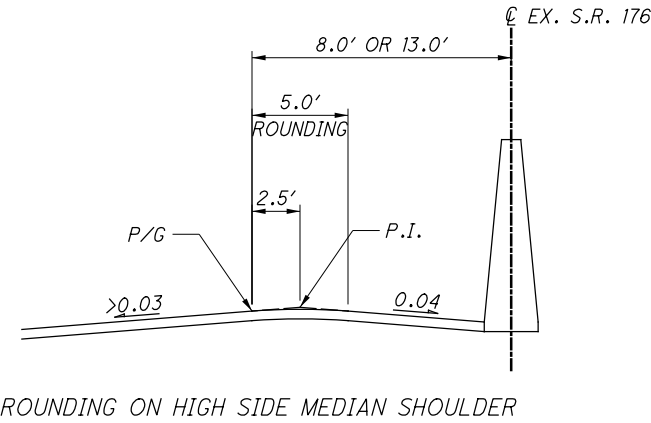

- * WHEN BARRIER IS NOT INSTALLED AND THE FORESLOPE IS STEEPER THAN 6:1.
- ** WHEN BARRIER IS INSTALLED AND THE FORESLOPE IS STEEPER THAN 6:1.

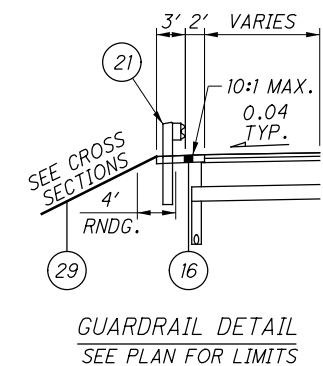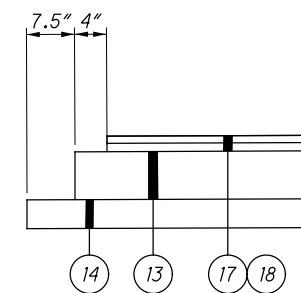

NOTES:

1. FOR EXISTING LEGEND, SEE SHEET 6
2. FOR SUBGRADE STABILIZATION DETAILS, SEE SHEET 23 AND 24
3. CONCRETE BARRIER SHALL INCLUDE TWO 4" SCHEDULE 40 MULTICELL CONDUITS FOR ITS AND ONE 4" CONDUIT FOR LIGHTING (SEE LIGHTING PLANS FOR LIMITS). FOR PLACEMENT DETAILS AND ADDITIONAL REQUIREMENTS, SEE THE LIGHTING AND ITS SCDs. COST FOR CONDUIT AND NYLON PULL ROPE SHALL BE INCIDENTAL TO THE COST OF THE APPLICABLE 622 PAY ITEM.
4. ITEM 302 MAY BE PLACED IN TWO LIFTS IF THE REQUIREMENTS OF C&MS 302.04 ARE MET. AN ADDITIONAL APPLICATION OF ITEM 407, NON-TRACKING TACK COAT SHALL BE REQUIRED. REVISED EDGE COURSE DESIGN SHALL BE APPROVED BY THE ENGINEER.

d:\aecom-na-aws\online\local\AECOM_DS01_NA\Documents\60527425-CUY-176-10.13\900-CAD_GIS\0191_CUY-176-10.13\Design\Roadway\Sheets\0191_GN001.dgn Sheet 6/25/2020 2:43:03 PM robert.j.jank

ROADWAY CONT.

ITEM 606 - IMPACT ATTENUATOR, TYPE 1 (UNIDIRECTIONAL)

THIS ITEM SHALL CONSIST OF FURNISHING AND INSTALLING ANY ONE OF THE TYPE 1 IMPACT ATTENUATORS AS LISTED ON THE OFFICE OF ROADWAY ENGINEERING'S WEB PAGE. INSTALLATION SHALL BE AT THE LOCATIONS SPECIFIED IN THE PLANS, IN ACCORDANCE WITH THE MANUFACTURER'S SPECIFICATIONS.

THE FACE OF THE TYPE 1 IMPACT HEAD SHALL BE COVERED WITH A SHEET OF TYPE G REFLECTIVE SHEETING, PER CMS 730.19. PAYMENT FOR THE ABOVE WORK SHALL BE MADE AT THE UNIT PRICE BID FOR ITEM 606, IMPACT ATTENUATOR, TYPE 1 (UNIDIRECTIONAL), EACH, AND SHALL INCLUDE ALL LABOR, TOOLS, EQUIPMENT AND MATERIALS NECESSARY TO CONSTRUCT A COMPLETE AND FUNCTIONAL IMPACT ATTENUATOR SYSTEM, INCLUDING ALL RELATED TRANSITIONS, HARDWARE, REFLECTIVE SHEETING AND GRADING, NOT SEPARATELY SPECIFIED, AS REQUIRED BY THE MANUFACTURER.

ITEM 622 - CONCRETE BARRIER, SINGLE SLOPE, TYPE C, AS PER PLAN

A PAVED GUTTER TYPE 1-2 AS PER DM-2.1 SHALL BE CONSTRUCTED BEHIND THE CONCRETE BARRIER, SINGLE SLOPE, TYPE C AS PER RM-4.3 AT LOCATIONS SHOWN IN THE PLANS ON RAMP JN-OBE. PAYMENT FOR THE CONCRETE BARRIER AND PAVED GUTTER WORK SHALL BE MADE AT THE UNIT PRICE BID FOR ITEM 622 CONCRETE BARRIER, SINGLE SLOPE TYPE C, AS PER PLAN, AND SHALL INCLUDE ALL LABOR, TOOLS, EQUIPMENT AND MATERIALS NECESSARY TO CONSTRUCT THE CONCRETE BARRIER AND PAVED GUTTER.

ITEM 622 - CONCRETE BARRIER, END ANCHORAGE, REINFORCED, TYPE C, AS PER PLAN

A PAVED GUTTER TYPE 1-2 AS PER DM-2.1 SHALL BE CONSTRUCTED BEHIND THE CONCRETE BARRIER, END ANCHORAGE, REINFORCED, TYPE C AS PER RM-4.3 AT LOCATIONS SHOWN IN THE PLANS ON RAMP JN-OBE. PAYMENT FOR THE CONCRETE BARRIER END ANCHORAGE AND PAVED GUTTER WORK SHALL BE MADE AT THE UNIT PRICE BID FOR ITEM 622 CONCRETE BARRIER, END ANCHORAGE, REINFORCED, TYPE C, AS PER PLAN, AND SHALL INCLUDE ALL LABOR, TOOLS, EQUIPMENT AND MATERIALS NECESSARY TO CONSTRUCT THE CONCRETE BARRIER END ANCHORAGE AND PAVED GUTTER.

ITEM 614 - WORK ZONE IMPACT ATTENUATOR FOR 24" WIDE HAZARDS (UNIDIRECTIONAL)

THIS ITEM SHALL CONSIST OF FURNISHING AND INSTALLING A NONGATING IMPACT ATTENUATOR. FURNISH AN IMPACT ATTENUATOR FROM THE OFFICE OF ROADWAY ENGINEERING'S APPROVED LIST FOR WORK ZONE IMPACT ATTENUATORS, FROM THE ROADWAY STANDARDS APPROVED PRODUCTS WEB PAGE.

INSTALLATION SHALL BE AT THE LOCATIONS SPECIFIED IN THE PLANS IN ACCORDANCE WITH THE MANUFACTURER'S SPECIFICATIONS.

THE CONTRACTOR SHALL REPAIR OR REPLACE A DAMAGED UNIT WITHIN 24 HOURS OF A DAMAGING IMPACT.

WHEN BIDIRECTIONAL DESIGNS ARE SPECIFIED, THE CONTRACTOR SHALL SUPPLY APPROPRIATE TRANSITIONS.

WHEN GATING IMPACT ATTENUATORS ARE DESIRED, THE CONTRACTOR SHALL SUBMIT DOCUMENTATION TO THE ENGINEER FOR ACCEPTANCE.

THE COST FOR THE ADDITIONAL BARRIER REQUIRED FOR A GATING IMPACT ATTENUATOR SHALL BE INCLUDED IN THE COST OF THE GATING IMPACT ATTENUATOR.

PAYMENT FOR THE ABOVE WORK SHALL BE MADE AT THE UNIT PRICE BID AND SHALL INCLUDE ALL LABOR, TOOLS, EQUIPMENT AND MATERIALS NECESSARY TO CONSTRUCT AND MAINTAIN A COMPLETE AND FUNCTIONAL IMPACT ATTENUATOR SYSTEM, INCLUDING ALL RELATED BACKUPS, TRANSITIONS, LEVELING PADS, HARDWARE AND GRADING, NOT SEPARATELY SPECIFIED, AS REQUIRED BY THE MANUFACTURER.

PAVEMENT

PART-WIDTH CONSTRUCTION

BECAUSE OF THE NECESSITY TO BUILD THIS PROJECT UNDER TRAFFIC AND TO CONSTRUCT THE FULL PAVEMENT WIDTH IN STAGES, EXERCISE CARE TO PREVENT THE CONSTRUCTION OF A BUTT JOINT IN THE BASE COURSES. LAP LONGITUDINAL JOINTS AS SHOWN ON STANDARD CONSTRUCTION DRAWING BP-3.1.

ITEM 442 - ASPHALT CONCRETE SURFACE COURSE, 12.5MM, TYPE A (447), AS PER PLAN, PG 76-22M

THE COARSE VIRGIN AGGREGATE FOR THIS ITEM SHALL BE LIMITED TO A BLEND OF AIR COOLED BLAST FURNACE SLAG (ACBFS) OR TRAP ROCK FROM ONTARIO AND LIMESTONE. THE CONTRACTOR SHALL USE A MINIMUM 60% OF ACBFS OR TRAP ROCK FROM ONTARIO WITH LIMESTONE COMPRISING THE REMAINING PERCENTAGE. AT LEAST 50% OF FINE VIRGIN AGGREGATE FOR THIS ITEM SHALL BE LIMITED TO ACBFS OR TRAP ROCK FROM ONTARIO.

TABLE 442.02-2 APPLIES EXCEPT NO. 4 SIEVE REQUIREMENTS ARE 52 TO 60 TOTAL PERCENT PASSING. FOR THE NO. 4 SIEVE DO NOT EXCEED 63 IN PRODUCTION.

WHEN ACBFS IS USED FOR A FRACTION OF THE COARSE AGGREGATE, PROVIDE A TOTAL ASPHALT BINDER CONTENT GREATER THAN OR EQUAL TO 6.2 PERCENT. IF ACBFS MAKES UP 100% OF THE COARSE AGGREGATE, APPLY THE BINDER CONTENT REQUIREMENTS OF C&S 442.

ASPHALT CONCRETE SURFACE COURSE SEALING REQUIREMENTS

IN ADDITION TO THE GUTTER SEALING REQUIREMENTS SPECIFIED ON SCD BP-3.1 AND IN 401.15, THE CONTRACTOR SHALL SEAL THE FOLLOWING LOCATIONS:

- ALL CASTINGS INCLUDING BUT NOT LIMITED TO MONUMENTS, MANHOLES, WATER VALVES, CATCH BASINS, CURB INLETS.
- BUTT JOINTS AND FEATHER JOINTS INCLUDING BRIDGE APPROACHES.
- BUTT JOINT BETWEEN PAVED SHOULDER AND DRIVEWAY ASPHALT AND TAPERED EDGE WHEN FEATHERING TO AN EXISTING ASPHALT DRIVEWAY.
- PERIMETER OF ALL PAVEMENT REPAIRS OR OTHER ASPHALT INLAYS WHEN PAVEMENT REPAIRS/INLAYS ARE NOT OVERLAID WITH AN ASPHALT CONCRETE SURFACE COURSE.
- ALL COLD LONGITUDINAL JOINTS BETWEEN PAVED SHOULDERS AND GUARDRAIL ASPHALT.

THE MATERIAL USED SHALL BE CERTIFIED 702.01 PG BINDER. THE WIDTH OF THE SEALER SHALL BE 2-3 INCHES.

ANY ADDITIONAL COSTS ASSOCIATED WITH THE WORK IDENTIFIED IN THIS NOTE SHALL BE INCLUDED IN THE APPROPRIATE ASPHALT CONCRETE SURFACE COURSE ITEM OF WORK.

CONTRACTION AND/OR EXPANSION JOINTS

ALTHOUGH SPECIFIC LOCATIONS OF CERTAIN CONTRACTION AND EXPANSION JOINTS HAVE BEEN DETAILED ON THIS PLAN, NO WAIVER OF THE SPECIFICATIONS IS INTENDED. IN ALL CASES, THE PROVISION OF EXPANSION JOINTS AT ALL MAJOR STRUCTURES INCLUDING THE MAXIMUM SPACING BETWEEN CONTRACTION JOINTS IS IN ACCORDANCE WITH STANDARD CONSTRUCTION DRAWING BP-2.2 AND THE SPECIFICATIONS.

S.R. 176 AND BROOKPARK ROAD PAVEMENT REPAIR

THE FOLLOWING CONTINGENCY QUANTITY HAS BEEN INCLUDED FOR PAVEMENT REPAIR, AS DIRECTED BY THE ENGINEER, WITHIN AND ADJACENT TO THE S.R. 176 AND BROOKPARK ROAD INTERSECTION.

255, FULL DEPTH PAVEMENT REMOVAL AND RIGID REPLACEMENT, CLASS QC MS 500 SY

DRAINAGE

ITEM SPECIAL - PIPE CLEANOUT

THIS WORK SHALL CONSIST OF REMOVING SEDIMENT AND DEBRIS FROM THE EXISTING DRAINAGE CONDUITS SPECIFIED IN THE PLANS. ALL MATERIAL REMOVED SHALL BE DISPOSED OF AS PER 105.16 AND 105.17. ALL SEWERS SHALL BE CLEANED OUT TO THE SATISFACTION OF THE ENGINEER.

CLEANOUT OF THE PIPE SHALL BE PAID FOR AT THE UNIT PRICE BID FOR ITEM SPECIAL - PIPE CLEANOUT. THIS PRICE SHALL INCLUDE THE COST FOR MATERIAL, EQUIPMENT, LABOR, AND ALL INCIDENTALS REQUIRED TO COMPLETE THE CLEANOUT.

THE FOLLOWING ESTIMATED QUANTITIES HAVE BEEN INCLUDED IN THE GENERAL SUMMARY FOR THE ABOVE NOTED WORK:

SPECIAL, PIPE CLEANOUT, 24" AND UNDER 625 FT
SPECIAL, PIPE CLEANOUT, 27" TO 48" 70 FT

ITEM 611 - INLET NO. 3 FOR SINGLE SLOPE BARRIER, TYPE B AND TYPE C, AS PER PLAN

THIS ITEM SHALL BE CONSISTENT WITH SPECIFICATIONS OUTLINED IN STANDARD CONSTRUCTION DRAWINGS I-2.1 AND I-2.2 AS APPLICABLE WITH EXCEPTION OF THE 4' DEPRESSED APRON WIDTH SHALL BE REDUCED TO 2' WIDTH ON THE NON-GRATE SIDE OF THE INLET.

ITEM 611 - INLET NO. 3 FOR SINGLE SLOPE BARRIER, TYPE B, AS PER PLAN, EACH

ITEM 611 - INLET NO. 3 FOR SINGLE SLOPE BARRIER, TYPE C, AS PER PLAN (I), EACH

ITEM 611 - INLET NO. 3 FOR SINGLE SLOPE BARRIER, TYPE B1 AND TYPE C1, AS PER PLAN

DURING PHASE 1 OF THE MAINTENANCE OF TRAFFIC PLAN (MOT), THE CONTACTOR SHALL INSTALL THE CATCH BASIN PORTION OF THE INLET PER THE APPLICABLE STANDARD CONSTRUCTION DRAWING (SCD) AND CONNECT ALL INCOMING AND OUTGOING PIPES. THE CONTRACTOR SHALL TEMPORARILY OMIT THE BARRIER PORTION OF THE INLET UNTIL PHASE 4 OF THE MOT PLAN. THE TROUGH PORTIONS OF THE INLET MAY BE CONSTRUCTED WHEN THE INLET IS INITIALLY INSTALLED OR CAN BE CONSTRUCTED JUST PRIOR TO THE BARRIER INSTALLATION AT THE OPTION OF THE CONTRACTOR.

THE TEMPORARY OPENING CREATED BY THE ABSENCE OF THE BARRIER ABOVE THE TROUGHS AND/OR THE PORTION OF THE CATCH BASIN THAT IS NOT COVERED BY THE GRATE SHALL BE COVERED BY MODIFIED FRAME AND GRATE, STEEL PLATE OR OTHER MEANS AND SHALL BE TRAFFICWORTHY. THE CONTRACTOR SHALL ENSURE THAT STORM WATER RUNOFF CAN BE COLLECTED AS INTENDED BY THE MODIFIED INLET AT ALL TIMES AND DOES NOT IMPEDED THE FLOW OF TRAFFIC.

AFTER PHASE 3A OF THE MOT PLAN, THE CONTRACTOR SHALL REMOVE ANY TEMPORARY ELEMENTS USED IN CONJUNCTION WITH THESE INLETS DURING PRIOR PHASES AND SHALL COMPLETE THE CONSTRUCTION OF THE INLETS AS SHOWN PER THE APPLICABLE SCDS.

THE CONTRACTOR SHALL SUBMIT A PLAN AND, IF NECESSARY, SHOP DRAWINGS FOR APPROVAL OF THE ENGINEER DETAILING THE METHOD TO CONTRACTOR WILL USE TO TEMPORARILY MODIFY THE INLETS SO THAT ALL OPENINGS ARE COVERED AND SAFE FOR TRAFFIC, THE INLETS COLLECT RUNOFF AS INTENDED, AND THE SUBSEQUENT MODIFICATION OF THE INLETS CONFORM TO THE APPLICABLE SCDS.

PAYMENT SHALL INCLUDE ALL LABOR, EQUIPMENT AND MATERIALS NECESSARY TO PERFORM THE ABOVE-DESCRIBED WORK AND SHALL BE PAID AT THE CONTRACT PRICE PER EACH FOR:

ITEM 611 - INLET NO. 3 FOR SINGLE SLOPE BARRIER, TYPE B1, AS PER PLAN, EACH

ITEM 611 - INLET NO. 3 FOR SINGLE SLOPE BARRIER, TYPE C1, AS PER PLAN, EACH

DRAINAGE CONT.

ITEM 611 - MANHOLE RECONSTRUCTED TO GRADE, AS PER PLAN

THIS ITEM SHALL CONSIST OF REMOVING THE EXISTING MANHOLE TOP AND WALLS DOWN TO THE ELEVATION AS SHOWN ON THE PLANS AND RECONSTRUCTING THE STRUCTURE TO THE NEW GRADE AS A CB-8. A NEW GRATE AND FRAME PER SCD CB 3.3 ARE TO BE USED. PAYMENT FOR THE ABOVE WORK SHALL BE MADE AT THE UNIT PRICE BID FOR ITEM 611, MANHOLE RECONSTRUCTED TO GRADE, AS PER PLAN, EACH, AND SHALL INCLUDE ALL LABOR, TOOLS, EQUIPMENT AND MATERIALS NECESSARY TO COMPLETE THE WORK. FOR MORE DETAILS SEE SHEET 320.

ITEM SPECIAL - FILL AND PLUG EXISTING CONDUIT

THIS ITEM SHALL CONSIST OF THE CONSTRUCTION OF BULKHEADS IN AN EXISTING 15 IN DIAMETER CONDUIT AND FILLING THE AREA THUS SEALED OFF WITH ITEM 613, SAND OR OTHER MATERIAL APPROVED BY THE ENGINEER.

BULKHEADS SHALL BE LOCATED AT THE LIMITS OF THE AREA TO BE FILLED AS INDICATED ON THE PLANS. THE BULKHEADS SHALL CONSIST OF BRICK OR CONCRETE MASONRY WITH A MINIMUM THICKNESS OF 12 INCHES.

THE FILL MATERIAL SHALL BE PUMPED INTO PLACE, OR PLACED BY OTHER MEANS APPROVED BY THE ENGINEER, SO THAT, AFTER SETTLEMENT, AT LEAST 90 PERCENT OF THE CROSSSECTIONAL AREA OF THE CONDUIT, FOR ITS ENTIRE LENGTH, SHALL BE FILLED. THE LENGTH OF FILLED AND PLUGGED CONDUIT TO BE PAID FOR SHALL BE THE ACTUAL NUMBER OF FEET (MEASURED ALONG THE CENTERLINE OF EACH CONDUIT FROM OUTER FACE TO OUTER FACE OF BULKHEADS) FILLED AND PLUGGED AS DESCRIBED ABOVE.

IN LIEU OF FILLING AND PLUGGING THE EXISTING CONDUIT, THE PIPE MAY BE CRUSHED AND BACKFILLED IN ACCORDANCE WITH THE PROVISIONS OF 203, OR IT MAY BE REMOVED. THE LENGTH, MEASURED AS PROVIDED ABOVE, SHALL BE PAID FOR AT THE CONTRACT PRICE PER FOOT FOR, ITEM SPECIAL, FILL AND PLUG EXISTING CONDUIT.

CALCULATED
SMS
CHECKED
MAW

GENERAL NOTES

CUY-176-10.13

d:\AECOM-NA-AWSI\ecomonline\local\AECOM_DS01_NA\Documents\60527425-CUY-176-10.13\900-CAD_GIS\0941_CUY-176-10.13\Design\MOT\Sheets\0941_MN001.dgn Sheet 6/23/2020 4:08:37 PM robert.j.jankovsky

ITEM 614 - LAW ENFORCEMENT OFFICER (WITH PATROL CAR) FOR ASSISTANCE DURING CONSTRUCTION OPERATIONS

USE OF LAW ENFORCEMENT OFFICERS (LEOS) BY CONTRACTORS OTHER THAN THE USES SPECIFIED BELOW WILL NOT BE PERMITTED AT PROJECT COST. LEOS SHOULD NOT BE USED WHERE THE OMUTCD INTENDS THAT FLAGGERS BE USED.

IN ADDITION TO THE REQUIREMENTS OF C&MS 614 AND THE OMUTCD, A UNIFORMED LEO WITH AN OFFICIAL PATROL CAR (CAR WITH TOP-MOUNTED EMERGENCY FLASHING LIGHTS AND COMPLETE MARKINGS OF THE APPROPRIATE LAW ENFORCEMENT AGENCY) SHALL BE PROVIDED FOR THE FOLLOWING TRAFFIC CONTROL TASKS:

> DURING THE ENTIRE ADVANCE PREPARATION AND CLOSURE SEQUENCE WHERE COMPLETE BLOCKAGE OF TRAFFIC IS REQUIRED.

> DURING A TRAFFIC SIGNAL INSTALLATION WHEN IMPACTING THE NORMAL FUNCTION OF THE SIGNAL OR THE FLOW OF TRAFFIC, OR WHEN TRAFFIC NEEDS TO BE DIRECTED THROUGH AN ENERGIZED TRAFFIC SIGNAL CONTRARY TO THE SIGNAL DISPLAY (E.G., DIRECTING MOTORISTS THROUGH A RED LIGHT).

IN ADDITION TO THE REQUIREMENT OF C&MS 614 AND THE OMUTCD, A UNIFORMED LEO WITH AN OFFICIAL PATROL CAR (CAR WITH TOP-MOUNTED EMERGENCY FLASHING LIGHTS AND COMPLETE MARKINGS OF THE APPROPRIATE LAW ENFORCEMENT AGENCY) SHOULD BE PROVIDED FOR THE FOLLOWING TRAFFIC CONTROL TASKS AS APPROVED BY THE ENGINEER:

> FOR LANE CLOSURES: DURING INITIAL SETUP PERIODS, TEAR DOWN PERIODS, SUBSTANTIAL SHIFTS OF A CLOSURE POINT OR WHEN NEW LANE CLOSURE ARRANGEMENTS ARE INITIATED FOR LONG-TERM LANE CLOSURES/SHIFTS (FOR THE FIRST AND LAST DAY OF MAJOR CHANGES IN TRAFFIC CONTROL SETUP).

IN GENERAL, LEOS SHOULD BE POSITIONED IN ADVANCE OF AND ON THE SAME SIDE AS THE LANE RESTRICTION OR AT THE POINT OF ROAD CLOSURE, AND TO MANUALLY CONTROL TRAFFIC MOVEMENTS THROUGH SIGNALIZED INTERSECTIONS IN WORK ZONES.

LEOS SHOULD NOT FORGO THEIR TRAFFIC CONTROL RESPONSIBILITIES TO APPREHEND MOTORISTS FOR ROUTINE TRAFFIC VIOLATIONS. HOWEVER, IF A MOTORIST'S ACTIONS ARE CONSIDERED TO BE RECKLESS, THEN PURSUIT OF THE MOTORIST IS APPROPRIATE.

THE LEOS WORK AT THE DIRECTION OF THE CONTRACTOR. THE CONTRACTOR IS RESPONSIBLE FOR SECURING THE SERVICES OF THE LEOS WITH THE APPROPRIATE AGENCIES AND COMMUNICATING THE INTENTIONS OF THE PLANS WITH RESPECT TO DUTIES OF THE LEOS. THE ENGINEER SHALL HAVE FINAL CONTROL OVER THE LEOS' DUTIES AND PLACEMENT, AND WILL RESOLVE ANY ISSUES THAT MAY ARISE BETWEEN THE TWO PARTIES.

ENSURE PROVIDED LEO'S HAVE BEEN TRAINED APPROPRIATE TO THE JOB DECISIONS THEY ARE REQUIRED TO MAKE WHILE ON THE PROJECT, IN ACCORDANCE WITH C&MS 614.03.

THE LEO SHALL REPORT IN TO THE CONTRACTOR PRIOR TO THE START OF THE SHIFT, IN ORDER TO RECEIVE INSTRUCTIONS REGARDING SPECIFIC WORK ASSIGNMENTS DURING HIS/HER SHIFT. THE LEO IS EXPECTED TO STAY AT THE PROJECT SITE FOR THE ENTIRE DURATION OF HIS/HER SHIFT. THE LEO SHALL REPORT TO THE CONTRACTOR AT THE END OF HIS/HER SHIFT. ONCE THE LEO HAS COMPLETED THE DUTIES DESCRIBED ABOVE AND STILL HAS TIME REMAINING ON HIS/HER SHIFT, THE LEO MAY BE ASKED TO PATROL THROUGH THE WORK ZONE (WITH FLASHING LIGHTS OFF) OR BE PLACED AT A LOCATION TO DETER MOTORISTS FROM SPEEDING. SHOULD IT BE NECESSARY TO LEAVE THE PROJECT SITE, THE LEO SHALL NOTIFY THE ENGINEER. THE CONTRACTOR SHALL PROVIDE THE LEO WITH A TWO-WAY COMMUNICATION DEVICE WHICH SHALL BE RETURNED TO THE CONTRACTOR AT THE END OF HIS/HER SHIFT.

LEOS (WITH PATROL CAR) REQUIRED BY THE TRAFFIC MAINTENANCE TASKS ABOVE SHALL BE PAID FOR ON A UNIT PRICE (HOURLY) BASIS UNDER ITEM 614, LAW ENFORCEMENT OFFICER (WITH PATROL CAR) FOR ASSISTANCE. THE FOLLOWING ESTIMATED QUANTITIES HAVE BEEN CARRIED TO THE GENERAL SUMMARY.

ITEM 614, LAW ENFORCEMENT OFFICER WITH PATROL CAR FOR ASSISTANCE 600 HOURS

THE HOURS PAID SHALL INCLUDE ANY MINIMUM SHOW-UP TIME REQUIRED BY THE LAW ENFORCEMENT AGENCY INVOLVED.

ANY ADDITIONAL COSTS (ADMINISTRATIVE OR OTHERWISE) INCURRED BY THE CONTRACTOR TO OBTAIN THE SERVICES OF AN LEO ARE INCLUDED WITH THE BID UNIT PRICE FOR ITEM 614, LAW ENFORCEMENT OFFICER WITH PATROL CAR FOR ASSISTANCE.

WORK ZONE QUEUE DETECTION WARNING SIGN

THE CONTRACTOR SHALL FURNISH, INSTALL, AND MAINTAIN AN APPROVED WORK ZONE QUEUE DETECTION WARNING SYSTEM (WZQDWS) AS PER SUPPLEMENTAL SPECIFICATION 896.

THE PROBABLE INITIAL LOCATIONS OF THE WZQDWS DEVICES ARE SHOWN ON SHEETS 64 TO 65 OF THE PLAN. IT IS EXPECTED THAT THESE LOCATIONS WILL VARY BASED ON PLANNED OR UNPLANNED PHASE AND TRAFFIC PATTERN CHANGES. PLACEMENT, OPERATION, MAINTENANCE AND ALL ACTIVATION OF THE DEVICES BY THE CONTRACTOR SHALL BE DIRECTED BY THE ENGINEER.

THE FOLLOWING TRAFFIC SENSOR THRESHOLDS AND PORTABLE CHANGEABLE MESSAGE SIGNS (PCMS) MESSAGES SHALL BE USED:

FOR IR-480 EASTBOUND:
GREATER THAN OR EQUAL TO 50 MPH:
USE FOUR CORNER FLASHING CAUTION MODE
BETWEEN 50 MPH AND 25 MPH:
"TRAFFIC AHEAD XX MPH" / "SLOW DOWN"
BELOW OR EQUAL TO 25 MPH:
"TRAFFIC AHEAD XX MPH" / "PREPARE TO STOP"

FOR ALL OTHERS:
GREATER THAN OR EQUAL TO 50 MPH:
USE FOUR CORNER FLASHING CAUTION MODE
BETWEEN 50 MPH AND 25 MPH:
"T-480 W TRAFFIC XX MPH" / "SLOW DOWN"
BELOW OR EQUAL TO 25 MPH:
"T-480 W TRAFFIC XX MPH" / "PREPARE TO STOP"

FOUR CORNER FLASHING CAUTION MODE SHALL CONSIST OF THE USE OF ONE ASTERISK IN EACH CORNER OF THE PCMS DISPLAY (4 TOTAL ASTERISKS).

XX SHALL BE ROUNDED UP TO THE NEAREST MULTIPLE OF 5 MPH MINUS 1. OCCUPANCY MAY BE DIRECTED TO BE USED BASED ON CERTAIN TRAFFIC CONDITIONS AND SCENARIOS. ODOT WILL DIRECT THE CONTRACTOR OF THE THRESHOLDS TO BE USED FOR THOSE AREAS WHERE OCCUPANCY IS DIRECTED TO BE USED.

THE FOLLOWING ESTIMATED QUANTITY HAS BEEN CARRIED TO THE GENERAL SUMMARY.

ITEM 896, PORTABLE NON-INTRUSIVE TRAFFIC SENSOR, CLASS II 225 SIGN MONTH

(ASSUMING 15 SENSORS FOR 15 MONTHS)

ITEM 896, PORTABLE CHANGEABLE MESSAGE SIGN, AS PER PLAN 90 SIGN MONTH

(ASSUMING 6 PCMS SIGNS FOR 15 MONTHS)

WORK ZONE EGRESS WARNING SYSTEM

THE CONTRACTOR SHALL FURNISH, INSTALL, AND MAINTAIN AN APPROVED WORK ZONE EGRESS WARNING SYSTEM (WZEWS) AS PER SUPPLEMENTAL SPECIFICATION 829.

THE LOCATIONS OF THE WZEWS DEVICES ARE EXPECTED TO VARY BASED ON PLANNED OR UNPLANNED PHASE AND TRAFFIC PATTERN CHANGES. PLACEMENT, OPERATION, AND MAINTENANCE AND ALL ACTIVATION OF THE DEVICES BY THE CONTRACTOR SHALL BE DIRECTED BY THE ENGINEER.

WZEWS SHALL BE USED IN ACCORDANCE WITH MT-103.10. THE FOLLOWING ESTIMATED QUANTITY HAS BEEN CARRIED TO THE GENERAL SUMMARY.

ITEM 829, WORK ZONE EGRESS WARNING SYSTEM 60 SIGN MONTH

(ASSUMING 4 WORK ZONE EGRESS WARNING SYSTEM(S) FOR 15 MONTHS.)

WORK ZONE MARKINGS

THE FOLLOWING PAVEMENT MARKING QUANTITIES ARE PROVIDED FOR USE AS DIRECTED BY THE ENGINEER FOR THE PURPOSE OF INSTALLING PAVEMENT MARKINGS ON THE COMPLETED INTERMEDIATE COURSE PAVEMENT AND HAVE BEEN CARRIED TO THE GENERAL SUMMARY:

ITEM 614, WORK ZONE LANE LINE, CLASS I, 6", 642 PAINT 1.45 MILE

ITEM 614, WORK ZONE EDGE LINE, CLASS I, 6", 642 PAINT 10.45 MILE

ITEM 614, WORK ZONE CHANNELIZING LINE, CLASS I, 12", 642 PAINT 8597 FT

ITEM 614, WORK ZONE DOTTED LINE, CLASS I, 642 PAINT 5431 FT

THE FOLLOWING PAVEMENT MARKING QUANTITIES ARE PROVIDED FOR USE AS DIRECTED BY THE ENGINEER FOR THE PURPOSE OF INSTALLING CLASS III PAVEMENT MARKINGS ON THE COMPLETED SURFACE COURSE PAVEMENT AND HAVE BEEN CARRIED TO THE GENERAL SUMMARY:

ITEM 614, WORK ZONE LANE LINE, CLASS III, 6", 642 PAINT 1.45 MILE

ITEM 614, WORK ZONE EDGE LINE, CLASS III, 6", 642 PAINT 10.45 MILE

ITEM 614, WORK ZONE CHANNELIZING LINE, CLASS III, 12", 642 PAINT 8597 FT

CALCULATED
BNC
CHECKED
JMS

MAINTENANCE OF TRAFFIC GENERAL NOTES


CUY-176-10.13

SHEET NO.	REF. NO.	PHASE	LOCATION		614	614	614	614	614	614	614	614	614	614	614	615	622	622	622	614	614	614	614
					WORK ZONE IMPACT ATTENUATOR FOR 24" WIDE HAZARDS (UNIDIRECTIONAL)	WORK ZONE IMPACT ATTENUATOR FOR 24" WIDE HAZARDS (BIDIRECTIONAL)	WORK ZONE LANE LINE, CLASS I, 6", 642 PAINT	WORK ZONE EDGE LINE, CLASS I, 6", 642 PAINT	WORK ZONE CHANNELIZING LINE, CLASS I, 12", 642 PAINT	WORK ZONE DOTTED LINE, CLASS I, 642 PAINT	WORK ZONE CENTER LINE, CLASS I, 642 PAINT	WORK ZONE STOP LINE, CLASS I, 642 PAINT	WORK ZONE GORE MARKING, CLASS II	WORK ZONE ARROW, CLASS I, 642 PAINT	WORK ZONE ISLAND MARKING, CLASS I	PAVEMENT FOR MAINTAINING TRAFFIC, CLASS A	PORTABLE BARRIER, UNANCHORED	PORTABLE BARRIER, 50", AS PER PLAN	PORTABLE BARRIER, 4" CONNECTOR	BARRIER REFLECTOR, TYPE I, ONE WAY	WORK ZONE RAISED PAVEMENT MARKER	OBJECT MARKER, ONE WAY	WORK ZONE CROSSOVER LIGHTING SYSTEM
			FROM	TO	EACH	EACH	MILE	MILE	FT	FT	MILE	FT	FT	EACH	SF	SY	FT	FT	EACH	EACH	EACH	EACH	EACH
S.R. 176																							
77,-79	ELW-1	PRE-1	104+40	120+70				0.31															
77,-79	ELY-1	PRE-1	104+40	120+70				0.31													20		
77,-79	ELW-2	PRE-1	104+40	117+10				0.24															
77,-79	ELY-2	PRE-1	104+40	117+10				0.24													16		
77,-79	TP-1	PRE-1	110+96	113+02	1											266							
77,-79	PCB-1	PRE-1	110+96	113+02													206			31		10	
77,-79	TP-4	PRE-1	134+00	137+00												581							
79	LIGHTING	PRE-1	134+00	142+00																		1	
77,-79	PCB-2	PRE-1	132+47	137+30													483			64		21	
RAMP OBW-JN																							
78	TP-8	PRE-1	50+42	56+91												604							
PRE-PHASE 1 SUBTOTAL					1			1.10								1451		689		95	36	31	1
S.R. 176																							
80,85	ELW-2	1	93+70	151+60				1.10													72		
80,85	ELY-2	1	93+70	151+60				1.10													72		
80,83	ELW-1	1	95+25	122+65				0.52															
80,85	ELY-1	1	95+25	145+80				0.96													63		
80,85	IA-1, PCB-2	1	98+78	112+31	1												1353			84		28	
80,82	PCB-1	1	99+00	111+50													1250			78		26	
82,85	PCB-1	1	111+50	137+30														2580		316		105	
82,83	CH-6	1	118+43	121+83					340														
82,85	PCB-3	1	110+66	148+00														3734				76	
82,83	TP-2	1	112+73	122+65																			
83,85	CH-1	1	127+48	130+18					270												14		
83,85	CH-1	1	130+18	148+80					1862												93		
80	CH-2, GM-1	1	122+65	127+48					483				80								12		
83	CH-3	1	122+65	127+48					483												12		
83,85	CH-4	1	127+48	130+18					270												2		
83,85	CH-4	1	130+18	148+80					3724												93		
83,85	ELW-3	1	127+48	130+18				0.05															
83,85	ELW-3	1	130+18	138+65				0.16													42		
83,-84	TP-3	1	127+70	135+15													185					16	
81-82	DL-1	1	138+65	145+80						715													
82,83	ELY-4	1	118+43	129+47				0.21															
83,84	ELY-4	1	129+47	141+70				0.23													61		
84,85	ELY-4	1	141+70	148+00				0.12															
82,83	CH-6	1	118+48	121+83					335												8		
SUBTOTAL (CARRIED TO SHEET 35)					1			4.45	7767	715				80		535	6337	2580		478	544	251	

SHEET NO.	REF. NO.	PHASE	LOCATION		614	614	614	614	614	614	614	614	614	614	614	615	622	622	622	614	614	614	614
					WORK ZONE IMPACT ATTENUATOR FOR 24" WIDE HAZARDS (UNIDIRECTIONAL)	WORK ZONE IMPACT ATTENUATOR FOR 24" WIDE HAZARDS (BIDIRECTIONAL)	WORK ZONE LANE LINE, CLASS I, 6", 642 PAINT	WORK ZONE EDGE LINE, CLASS I, 6", 642 PAINT	WORK ZONE CHANNELIZING LINE, CLASS I, 12", 642 PAINT	WORK ZONE DOTTED LINE, CLASS I, 642 PAINT	WORK ZONE CENTER LINE, CLASS I, 642 PAINT	WORK ZONE STOP LINE, CLASS I, 642 PAINT	WORK ZONE GORE MARKING, CLASS II	WORK ZONE ARROW, CLASS I, 642 PAINT	WORK ZONE ISLAND MARKING, CLASS I	PAVEMENT FOR MAINTAINING TRAFFIC, CLASS A	PORTABLE BARRIER, UNANCHORED	PORTABLE BARRIER, 50", AS PER PLAN	PORTABLE BARRIER, 4" CONNECTOR	BARRIER REFLECTOR, TYPE I, ONE WAY	WORK ZONE RAISED PAVEMENT MARKER	OBJECT MARKER, ONE WAY	WORK ZONE CROSSOVER LIGHTING SYSTEM
			FROM	TO	EACH	EACH	MILE	MILE	FT	FT	MILE	FT	FT	EACH	SF	SY	FT	FT	EACH	EACH	EACH	EACH	EACH
RAMP GE-1																							
109	PCB-7	3	50+45	54+00													355			24		8	
RAMP GE-2																							
108	ELW-8	3	30+26	33+29				0.06															
108	ELY-5	3	30+32	33+29				0.06													4		
RAMP JN-OBW																							
104-105	CH-2, ELY-3, ELW-5	3	38+00	40+41				0.09	241												36		
105	ELW-5	3	40+41	44+12				0.07															
104	PCB-5, IA-2	3	39+64	43+87	1												423		1	28		9	
104	PCB-9	3	39+64	44+30													466			31		10	
104	ELW-9	3	44+12	45+30				0.02															
104	ELY-9	3	40+41	45+30				0.09															
BROOKPARK ROAD																							
102	ELW-1	3	101+16	103+13				0.04															
102	DY-1, LL-1, CH-8	3	102+30	102+77			0.01		47		0.01												
102	SL-1, DL-1	3	102+77	103+64 (S.R. 176)						226		33											
102	ELW-2, DL-5	3	104+07	105+37				0.02		130													
SUBTOTAL (THIS SHEET)					1		0.01	0.45	288	356	0.01	33					1244		1	83	40	27	
SUBTOTAL (CARRIED FROM SHEET 40)					2			6.98	4238	3624		11			7		5025	2649		646	523	215	
PHASE 3 SUBTOTAL					3		0.01	7.43	4526	3980	0.01	44			7		6269	2649	1	729	563	242	

MAINTENANCE OF TRAFFIC SUBSUMMARY	CALCULATED BNC CHECKED JMS
CUY -176 -10.13	41 363

SHEET NO.	REF. NO.	PHASE	LOCATION		614	614	614	614	614	614	614	614	614	614	614	615	622	622	622	614	614	614	614
			FROM	TO	EACH	EACH	MILE	MILE	FT	FT	MILE	FT	FT	EACH	SF	SY	FT	FT	EACH	EACH	EACH	EACH	EACH
S.R. 176																							
123	ELY-1	4A	93+70	117+69				0.45														30	
123	ELW-1	4A	93+70	113+44			0.37																
123	CH-1	4A	113+44	117+69				425														11	
123	CH-2	4A	113+58	117+69				411														10	
123-124	CH-3	4A	114+70	124+35				965														24	
123-124	LL-1, ELY-1	4A	117+69	121+50		0.07	0.07															3	
123-124	CH-6	4A	117+77	124+35				658														16	
123	PCB-1, IA-1	4A	120+14	136+99	1												1685			104		35	
124-125	CH-4, ELY-1	4A	121+50	139+88			0.35	1838														184	
124-125	ELW-2	4A	122+35	139+88			0.33															88	
124-125	CH-5	4A	124+35	139+88				1553														78	
PHASE 4A SUBTOTAL					1		0.07	1.57	5850								1685			104	444	35	
PRE-PHASE 1 SUBTOTAL (CARRIED FROM SHEET 33)					1			1.10								1451		689		95	36	31	1
PHASE 1 SUBTOTAL (CARRIED FROM SHEET 35)					6		4.16	12.70	22997	1993			80			5413	23429	2580		1530	1905	602	
PHASE 1A SUBTOTAL (CARRIED FROM SHEET 36)					1		0.19	1.37	3529								1754			118	290	39	
PHASE 2 SUBTOTAL (CARRIED FROM SHEET 39)					4		2.30	10.09	7153	1780		60		2	14	109	17167	4505	2	1616	802	540	
PHASE 3 SUBTOTAL (CARRIED FROM SHEET 41)					3		0.01	7.43	4526	3980	0.01	44			7		6269	2649	1	729	563	242	
PHASE 3A SUBTOTAL (CARRIED FROM SHEET 42)					1			1.40	2195								868			58	55	19	
PHASE 4 SUBTOTAL (CARRIED FROM SHEET 43)					2		0.76	2.11	3496	860				789			4170	92		273	238	91	
PHASE 4A SUBTOTAL (THIS SHEET)					1		0.07	1.57	5850							1685			104	444	35		
TOTAL CARRIED TO GENERAL SUMMARY					19		7.49	37.77	49746	8613	0.01	104	869	2	21	6973	55342	10515	3	4523	4333	1599	1

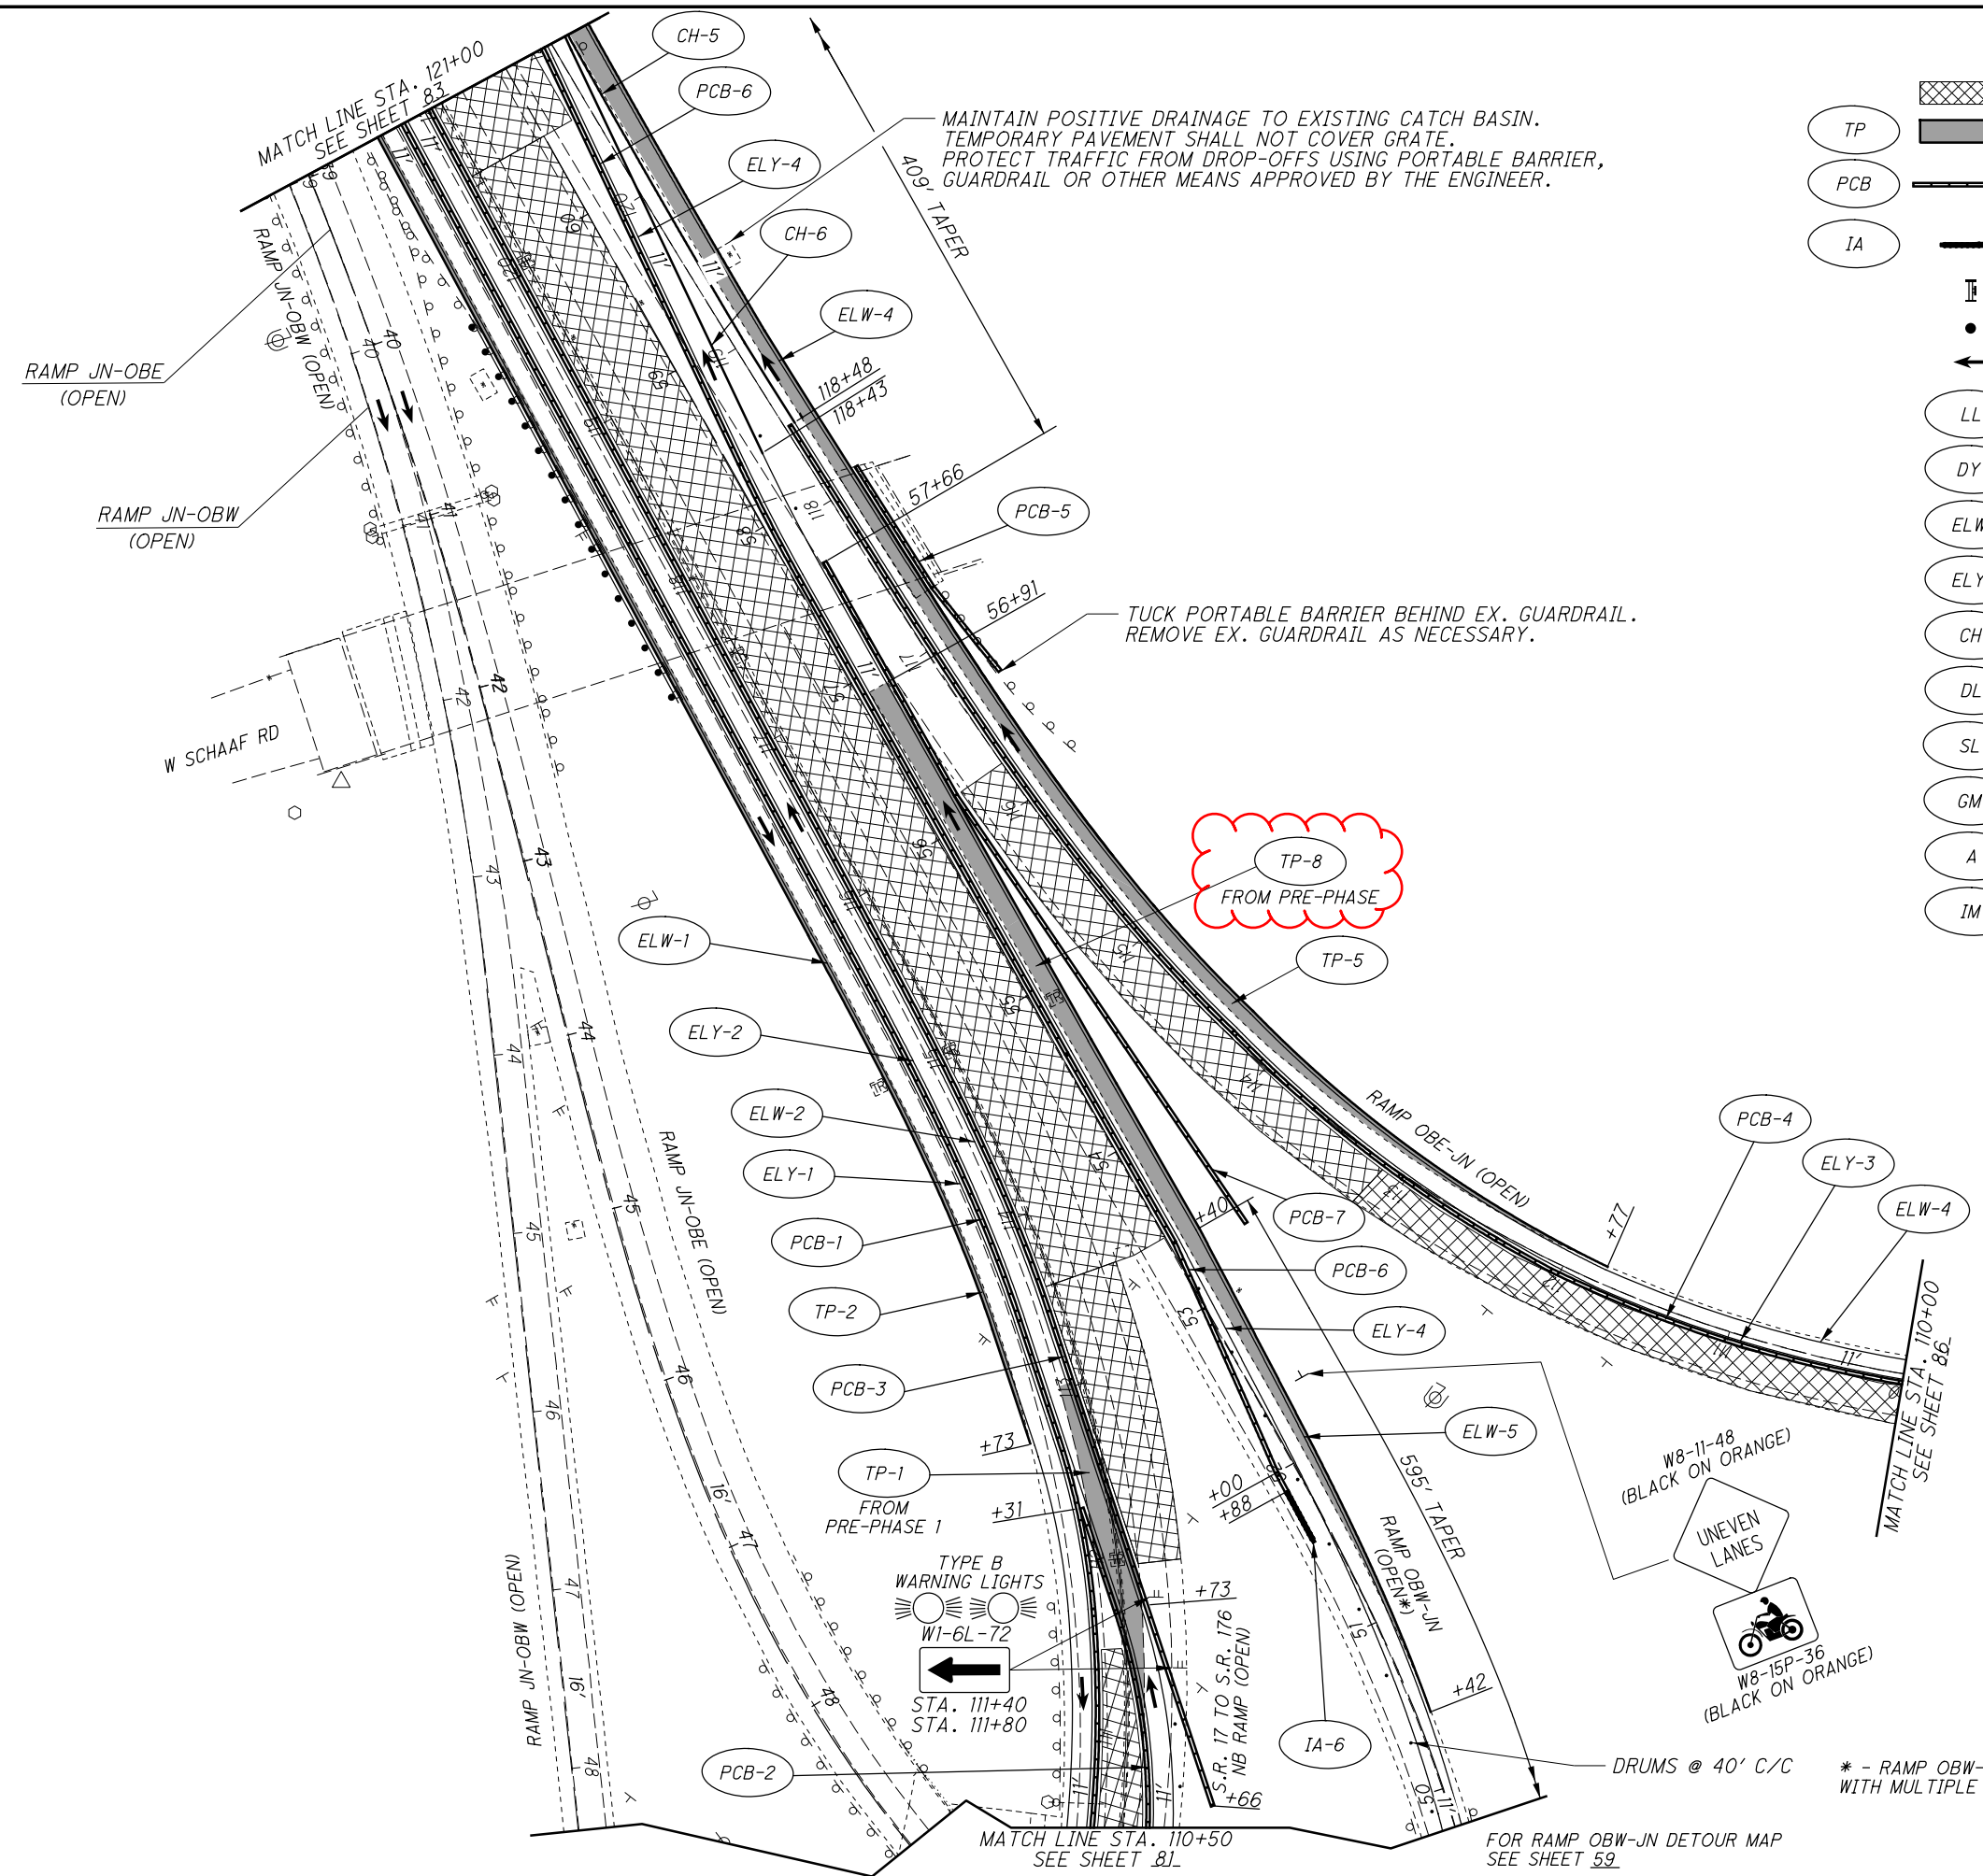


MAINTAIN POSITIVE DRAINAGE TO EXISTING CATCH BASIN.
 TEMPORARY PAVEMENT SHALL NOT COVER GRATE.
 PROTECT TRAFFIC FROM DROP-OFFS USING PORTABLE BARRIER,
 GUARDRAIL OR OTHER MEANS APPROVED BY THE ENGINEER.

TUCK PORTABLE BARRIER BEHIND EX. GUARDRAIL.
 REMOVE EX. GUARDRAIL AS NECESSARY.

MOT LEGEND

- WORK AREA
- TEMPORARY PAVEMENT
- PORTABLE BARRIER
- IMPACT ATTENUATOR
- TYPE III BARRICADE
- DRUM
- DIRECTION OF TRAFFIC
- WORK ZONE LANE LINE, 6"
- WORK ZONE CENTER LINE
- WORK ZONE EDGE LINE (WHITE), 6"
- WORK ZONE EDGE LINE (YELLOW), 6"
- WORK ZONE CHANNELIZING LINE, 12"
- WORK ZONE DOTTED LINE, 6"
- WORK ZONE STOP LINE
- WORK ZONE GORE MARKING
- WORK ZONE ARROW
- WORK ZONE ISLAND MARKING (YELLOW)

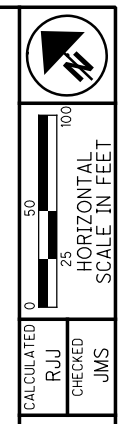

MAINTENANCE OF TRAFFIC
PHASE 1

CUY-176-10.13

* - RAMP OBW-JN OPEN, EXCEPT CLOSED PER A+B BIDDING WITH MULTIPLE SECTIONS CONTRACT TABLE TO BUILD RAMP.

FOR RAMP OBW-JN DETOUR MAP SEE SHEET 59.

SHEET NO.	REFERENCE NO.	STATION		SIDE	LENGTH	209	411	441	606	606	606	606	606	606	606	606	606	606
		FROM	TO			RESHAPING UNDER GUARDRAIL, AS PER PLAN	STABILIZED CRUSHED AGGREGATE, AS PER PLAN	ASPHALT CONCRETE INTERMEDIATE COURSE, TYPE 1, (448), (UNDER GUARDRAIL), AS PER PLAN	GUARDRAIL, TYPE MGS	GUARDRAIL, TYPE MGS HALF POST SPACING	GUARDRAIL, BARRIER DESIGN, TYPE MGS	ANCHOR ASSEMBLY, MGS TYPE E (MASH)	ANCHOR ASSEMBLY, MGS TYPE T	MGS BRIDGE TERMINAL ASSEMBLY, TYPE 1	MGS BRIDGE TERMINAL ASSEMBLY, TYPE 2	IMPACT ATTENUATOR, TYPE 1 (UNIDIRECTIONAL)	BARRIER REFLECTOR, TYPE 3, ONE WAY	BARRIER REFLECTOR, TYPE 3, BI-DIRECTIONAL
					FT	STA	CY	CY	FT	FT	FT	EACH	EACH	EACH	EACH	EACH	EACH	EACH
		SR 176																
150	GR27	92+67.35	94+12.23	LT	144.88	1.4		6.71	137.5				1		1			4
150	GR28	92+74.14	94+29.77	RT	155.63	1.6		7.21	75.0			1		1				3
151 & 152	GR1	99+71.49	103+95.28	LT	423.79	4.2		19.62	362.5			1		1				9
152 & 153	GR2	103+13.55	109+76.01	RT	662.46	6.6		30.67	662.5				1		1			15
154	GR3	110+48.82	111+77.08	LT	128.26	1.3		5.94	62.5			1	1					3
155 & 156	GR4	117+35.61	121+79.58	LT	443.97	4.4		20.55	400.0				1			1		5
156 & 157	GR5	120+84.97	129+09.73	RT	824.76	8.2		38.18	762.5			1	1					9
156, 157, 278 & 279	GR6	129+25.82	41+25.20 JN-OBW	LT/RT	1050.00	10.5		48.61	950.0	37.5		1	1					13
158	GR6A	132+29.24	134+02.50	RT	173.26	1.7		8.02	112.5			1	1				3	
		RAMP OBE-JN																
183 & 184	GR7	92+73.03	95+48.26	RT	275.23	2.8		12.74	212.5			1	1					4
184 & 185	GR8	98+97.60	103+07.00	LT	409.40	4.1	52.11 (CADD)	11.62 (CADD)			412.5							12
185 & 186	GR9	103+07.00	107+21.78	LT	414.78	4.1		19.20	412.5									6
185 & 186	GR10	103+07.00	106+83.10	LT	376.10	3.8	106.91 (CADD)	3.80 (CADD)	350.0					1				8
186	GR11	104+99.71	106+39.61	RT	139.90	1.4		6.48	62.5			1		1				3
188	GR12	115+23.53	117+24.41	RT	200.88	2.0		9.30	137.5			1	1					4
		RAMP JN-OBE																
218 & 219	GR13	46+88.97	48+71.78	LT	182.81	1.8		8.46	100.0			1		1				3
218 & 219	GR14	47+25.98	49+13.24	RT	187.26	1.9		8.67	112.5			1		1				4
220	GR16	56+00.42	57+49.59	RT	149.17	1.5		6.91	137.5				1		1			4
220 - 222	GR15	56+43.61	64+74.45	LT	830.84	8.3		38.46	793.87					1	1			17
221 & 222	GR17	62+74.46	64+92.50	RT	218.04	2.2		10.09	137.5			1		1				4
223	GR18	69+36.10	72+87.70	LT	351.60	3.5			337.5				1		1			8
		RAMP OBW-JN																
262 & 263	GR19	35+87.05	43+42.50	LT	755.45	7.6		34.97	725.0					1				16
263 & 264	GR20	42+42.87	45+04.50	RT	261.63	2.6		12.11	187.5			1		1				5
264 & 265	GR22	48+63.10	49+93.72	LT	130.62	1.3		6.05	112.5				1		1			4
264 & 265	GR21	48+96.10	49+97.74	RT	101.64	1.0		4.71	75.0				1		1			3
		RAMP JN-OBW																
278 & 279	GR23	38+46.45	40+79.91	LT	233.46	2.3		10.81	212.5					1				4
279	GR25	41+20.92	42+55.44	LT	134.52	1.3		6.23	125.0				1		1			3
	GR24	NOT	USED															
280 - 282	GR26	48+81.26	59+86.55	RT	1105.29	11.1		51.17	1037.5			1	1					22
SUBTOTAL						105	159.02	447.29	8793.87	37.5	412.5	14	15	11	8	1	3	195
TOTALS CARRIED TO GENERAL SUMMARY						105	159	447	8794	37.5	412.5	14	15	11	8	1	3	195

GUARDRAIL SUBSUMMARY


CUY - 176 - 10.13

CALCULATED
NSP
CHECKED
MEP



PLAN SHEET NO.	REFERENCE NO.	STATION		SIDE	601	605	605	605	605	605	611	611	FOR INFORMATION ONLY				
		TIED CONCRETE BLOCK MAT, TYPE 1	6" SHALLOW PIPE UNDERDRAINS WITH GEOTEXTILE FABRIC		6" BASE PIPE UNDERDRAINS WITH GEOTEXTILE FABRIC	6" UNCLASSIFIED PIPE UNDERDRAINS WITH GEOTEXTILE FABRIC	6" DEEP PIPE UNDERDRAINS WITH GEOTEXTILE FABRIC	6" ROCK CUT UNDERDRAINS WITH GEOTEXTILE FABRIC	6" CONDUIT, TYPE F FOR UNDERDRAIN OUTLETS	PRECAST REINFORCED CONCRETE OUTLET	90-DEGREE BEND	45-DEGREE BEND	6"X6" TEE	6"X6" CROSS	6"X6" WYE		
		FROM	TO		SY	FT	FT	FT	FT	FT	FT	EACH	EACH	EACH	EACH	EACH	
155-156,278	U49	119+55.20	121+85.00	SR-176 LT.			937						2		2		
156-278	U50	121+85.00	125+10.00	SR-176 LT.		650									2		
157	U51	125+15.00	130+45.00	SR-176 LT.		1060									2		
157	U52	125+15.00	130+45.00	SR-176 RT.		530									1		
180	U53	76+50.00	78+78.00	OBE-JN LT.				228			41		1		1		
180	U54	76+50.00	78+78.00	OBE-JN RT.				228					1				
180-181	U55	78+83.00	81+04.21	OBE-JN LT.			213				10			1			
180-181	U56	78+83.00	81+04.21	OBE-JN RT.			203				25			1			
181	U57	81+06.00	84+60.00	OBE-JN RT.	2				357		111	1			1		
181	U58	81+06.00	84+60.00	OBE-JN LT.					357				1				
182	U59	84+60.00	88+65.00	OBE-JN RT.		405											
182	U60	84+60.00	88+65.00	OBE-JN LT.		405											
182-183	U60A	88+65.00	90+46.00	OBE-JN LT.						183	10			1			
182-183	U61	88+65.00	93+98.93	OBE-JN RT.						503	43			1			
183-184	U62	90+46.20	96+15.52	OBE-JN LT.						571	10			1			
184-185	U63	96+93.00	101+60.00	OBE-JN LT.		461											
184	U63A	96+25.00	96+93.00	OBE-JN LT.						68							
185	U64	101+60.00	102+35.00	OBE-JN LT.						148			1		1		
185	U65	100+59.26	101+60.00	OBE-JN LT.		100											
183-184,185	U66	96+93.00	101+60.00	LT./RT.		470											
184	U66A	93+71.68	96+93.00	LT./RT.						322							
185	U67	101+60.00	102+35.00	OBE-JN RT.						76	50				1		
185-186	U68	102+40.00	107+80.00	OBE-JN LT.						544			1				
185-186,186	U69	102+40.00	104+63.00	OBE-JN LT.						223					1		
185-186	U70	102+40.00	107+49.00	OBE-JN RT.						508	50			1	1		
186	U71	104+64.00	107+58.00	OBE-JN CL.						304			1		1		
186-187	U72	107+67.00	113+22	OBE-JN CL.						555			1				
186-187	U72A	108+07.00	113+22.00	OBE-JN LT.						536	20		1	1			
186-187	U73	107+67.00	113+22.00	OBE-JN RT.						547	43			2	1		
155-187,188	U74	113+22.00	115+86.00	LT./RT.						273							
155-187,188	U75	113+22.00	115+86.00	OBE-JN RT.						525							
155-188	U76	115+86.00	116+76.15	OBE-JN LT.						92					1		
155-188	U77	115+86.00	119+43.00	OBE-JN RT.						713					2		
155-188	U78	116+75.76	119+43.00	OBE-JN LT.						268	49		1	1			
155-156	U79	119+54.00	125+09.32	OBE-JN LT.		557									1		
155-156	U80	119+54.00	125+09.32	OBE-JN RT.		1110									2		
157	U81	125+13.00	130+44.00	OBE-JN RT.	2	1062					153	1			2		
218-278,279	U82	40+40.00	43+86.00	JN-OBE CL.					347						1		
278-279	U83	40+40.00	43+86.00	JN-OBE LT.					349						1		
218-219,279	U84	43+87.00	48+94.00	LT./RT.			521						1				
220	U85	56+60.00	58+50.00	JN-OBE LT.			368										
220	U86	56+16.00	58+50.00	LT./RT.			239										
221-258	U87	58+50.00	61+24.77	LT./RT.					544				1		1		
221-258	U88	58+50.00	60+41.78	LT./RT.						196					1		
221-258	U89	33+26.37	30+32.28	GE-2 LT.						353			1	1	1		
221-258	U90	30+30.00	33+28.49	LT./RT.						321					1		
221-222,223	U91	61+30.00	69+75.00	LT./RT.			843				79			2	1		
											10						
SUBTOTAL (CARRIED TO SHEET 142)					4	6810	3324	456	2824	6959	704	2					

PLAN SHEET NO.	REFERENCE NO.	STATION		SIDE	601	605	605	605	605	605	611	611	FOR INFORMATION ONLY				
		TIED CONCRETE BLOCK MAT, TYPE 1	6" SHALLOW PIPE UNDERDRAINS WITH GEOTEXTILE FABRIC		6" BASE PIPE UNDERDRAINS WITH GEOTEXTILE FABRIC	6" UNCLASSIFIED PIPE UNDERDRAINS WITH GEOTEXTILE FABRIC	6" DEEP PIPE UNDERDRAINS WITH GEOTEXTILE FABRIC	6" ROCK CUT UNDERDRAINS WITH GEOTEXTILE FABRIC	6" CONDUIT, TYPE F FOR UNDERDRAIN OUTLETS	PRECAST REINFORCED CONCRETE OUTLET	90-DEGREE BEND	45-DEGREE BEND	6"X6" TEE	6"X6" CROSS	6"X6" WYE		
		FROM	TO		SY	FT	FT	FT	FT	FT	FT	EACH	EACH	EACH	EACH	EACH	
221-222,223	U92	61+30.00	70+10.93	JN-OBE RT.			879										
221-222,223	U93	61+30.00	69+00.00	LT./RT.			750				10		1		1		
223	U94	69+80.00	70+23.00	JN-OBE LT.			31										
223	U95	69+04.00	70+11.00	JN-OBE RT.			95				10						
223	U96	70+23.00	70+94.00	JN-OBE LT.			69				10						
	U97	70+11.00	70+89.00	JN-OBE RT.			79										
223	U98	70+11.00	71+00.00	JN-OBE RT.			79										
223	U99	70+11.00	70+11.00	JN-OBE RT.							19						
278	U100	121+85.00	125+09.90	OBE-JN RT.		325									1		
	U101	NOT USED															
224-223	U102	71+00.00	75+54.00	JN-OBE LT.							445	10		2			
223	U103	71+00.97	71+88.00	JN-OBE RT.							74	10					
221-223,224	U104	71+00.97	75+54.00	JN-OBE RT.							440	10		2			
223-224	U105	72+00.00	73+93.00	JN-OBE RT.							184	10					
224	U106	74+04.00	74+95.00	JN-OBE RT.							81	10					
224	U107	75+05.77	75+54.00	JN-OBE RT.							38	10					
224	U108	75+54.00	76+03.00	JN-OBE RT.					38		10						
264-265,224	U109	75+54.00	76+03.00	JN-OBE LT.					40		10						
264-265,224	U110	75+54.00	76+03.00	JN-OBE RT.					49		13				1		
262-263,224	U111	50+25.00	51+14.60	LT./RT.							91		2		1		
262-263,224	U112	50+25.00	51+14.60	LT./RT.							180	43		1		2	
224-225	U113	74+81.28	82+00.00	LT./RT.							719						
224-225	U114	74+81.28	82+00.00	JN-OBE RT.							1440						
224	U115	76+03.00	76+49.00	JN-OBE RT.					47								
224	U116	76+03.00	76+69.00	JN-OBE RT.					55		10						
224-225	U117	76+03.00	82+00.00	JN-OBE LT.					598		10						
224	U118	76+79.00	77+59.00	JN-OBE RT.					70		10						
224	U119	77+69.00	78+49.00	JN-OBE RT.					70		10						
225	U120	78+59.00	79+39.00	JN-OBE RT.					69		10						
225	U121	79+49.00	80+39.00	JN-OBE RT.					80		10						
225	U122	80+49.00	82+00.00	JN-OBE RT.					141		10						
225-249	U123	82+00.00	87+33.00	JN-OBE RT.							1599	25		1		2	
225-249	U124	82+00.00	87+49.00	JN-OBE RT.					1082		10		1		1		
249-250	U125	287+60.00	292+31.00	EB-OL LT.					474				2		1		
249-250	U126	287+35.00	292+31.00	LT./RT.							992	35				2	
250	U127	292+31.00	293+24.00	LT./RT.							186						
250	U128	292+31.00	293+24.00	LT./RT.					93								
SUBTOTAL (THIS SHEET)						325	1982		2906	6469	345						
SUBTOTAL (CARRIED FROM SHEET 141)					6	2936	17721		3016	1830	627	3					
SUBTOTAL (CARRIED FROM SHEET 142)					4	6810	3324	456	2824	6959	704	2					
TOTALS CARRIED TO GENERAL SUMMARY					10	10071	23027	456	8746	15258	1676	5					

p:\AECOM-NA-AWS\ecomonline\local\AECOM_DS01_NA\Documents\60527425-CUY-176-10.13\900-CAD_GIS\101941_CUY-176-10.13\Design\Roadway\Sheets\101941_GP017.dgn Design 6/26/2020 9:36:57 AM Robert.janik

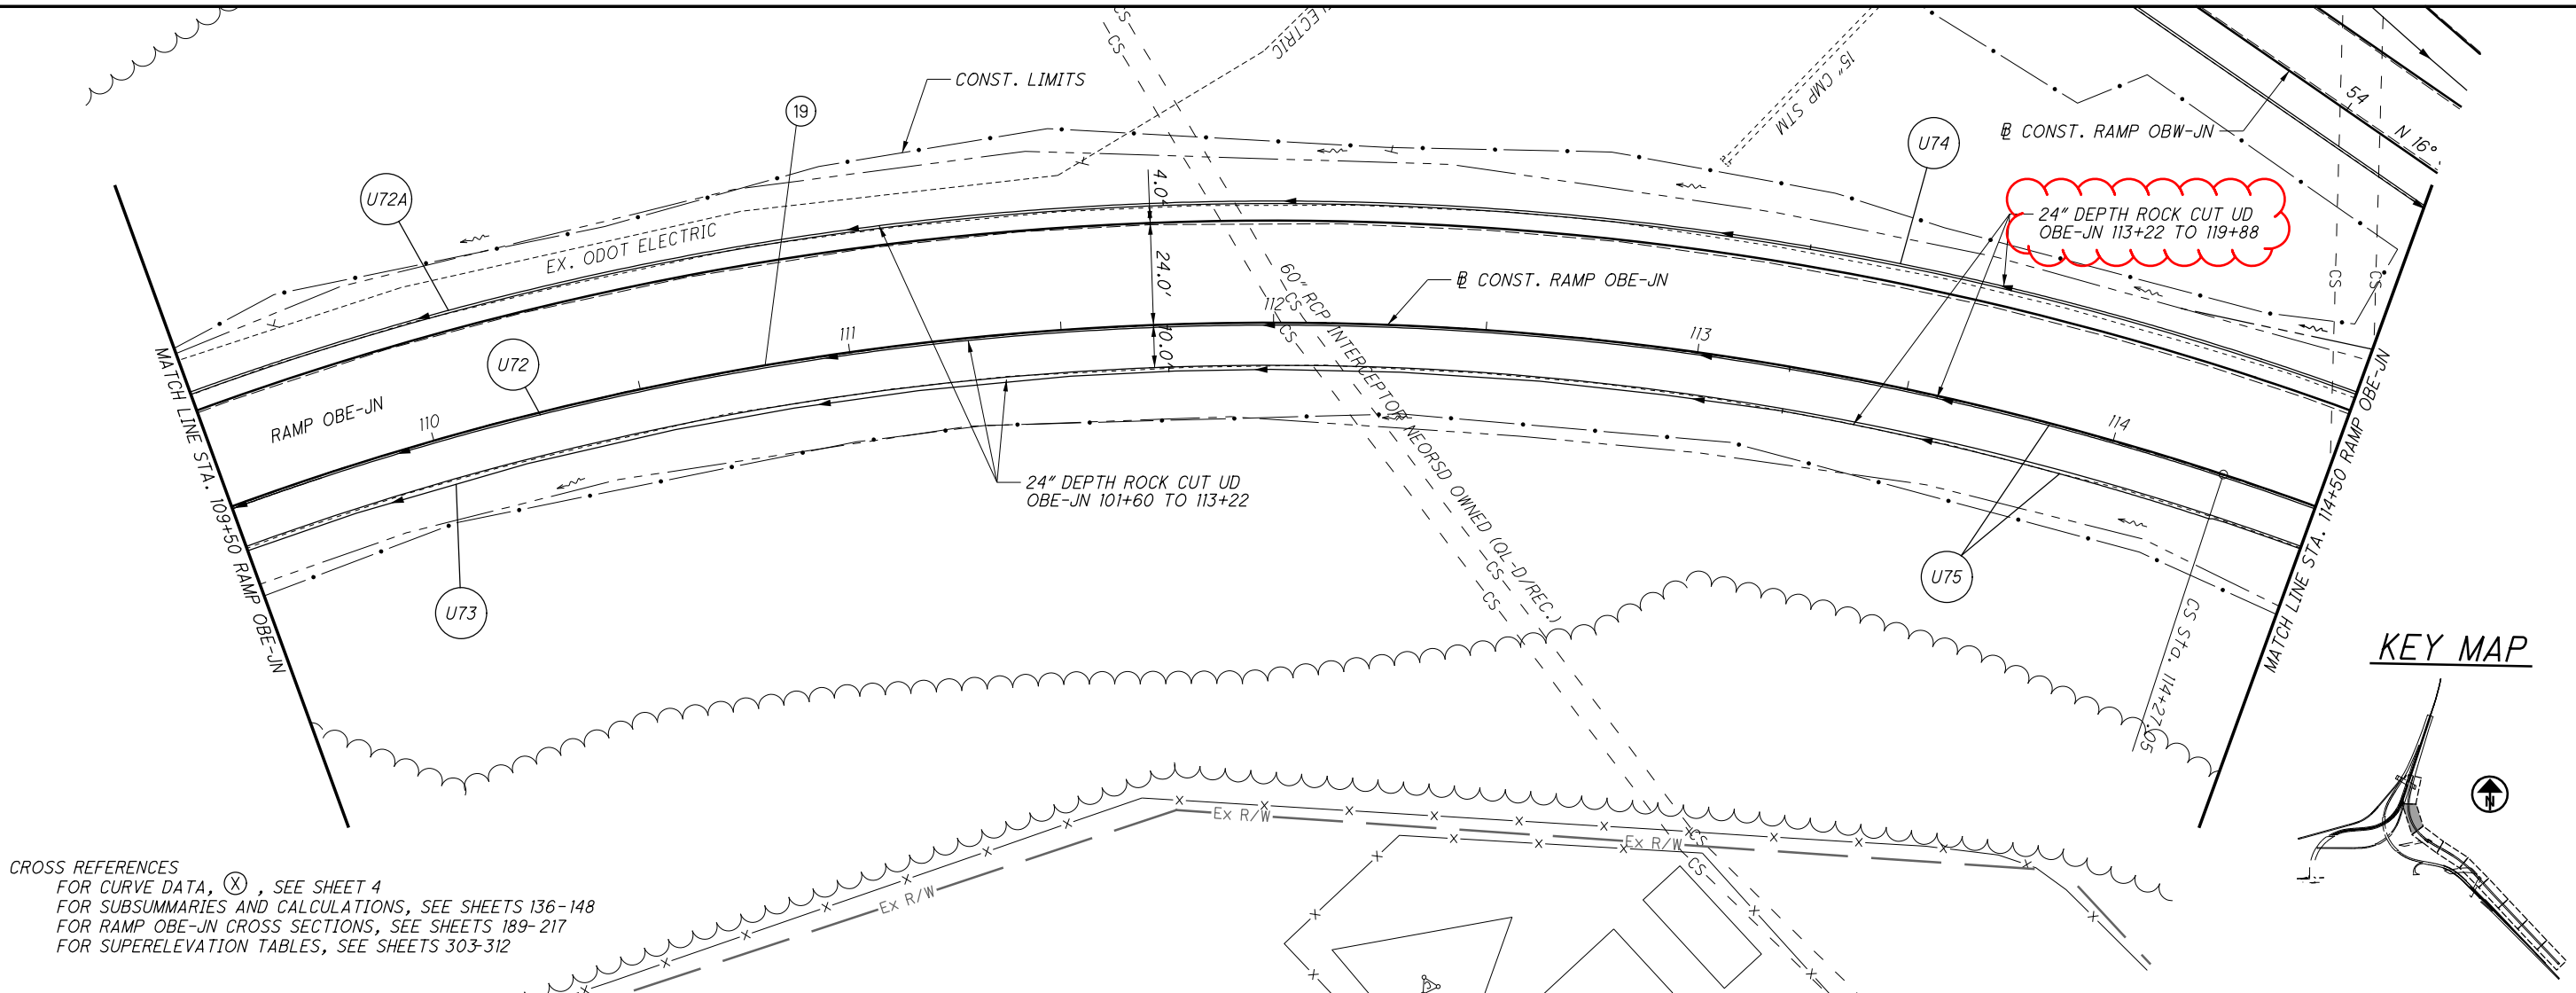

CROSS REFERENCES
 FOR CURVE DATA, (X), SEE SHEET 4
 FOR SUBSUMMARIES AND CALCULATIONS, SEE SHEETS 136-148
 FOR RAMP OBE-JN CROSS SECTIONS, SEE SHEETS 189-217
 FOR SUPERELEVATION TABLES, SEE SHEETS 303-312

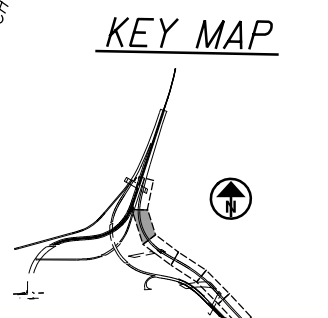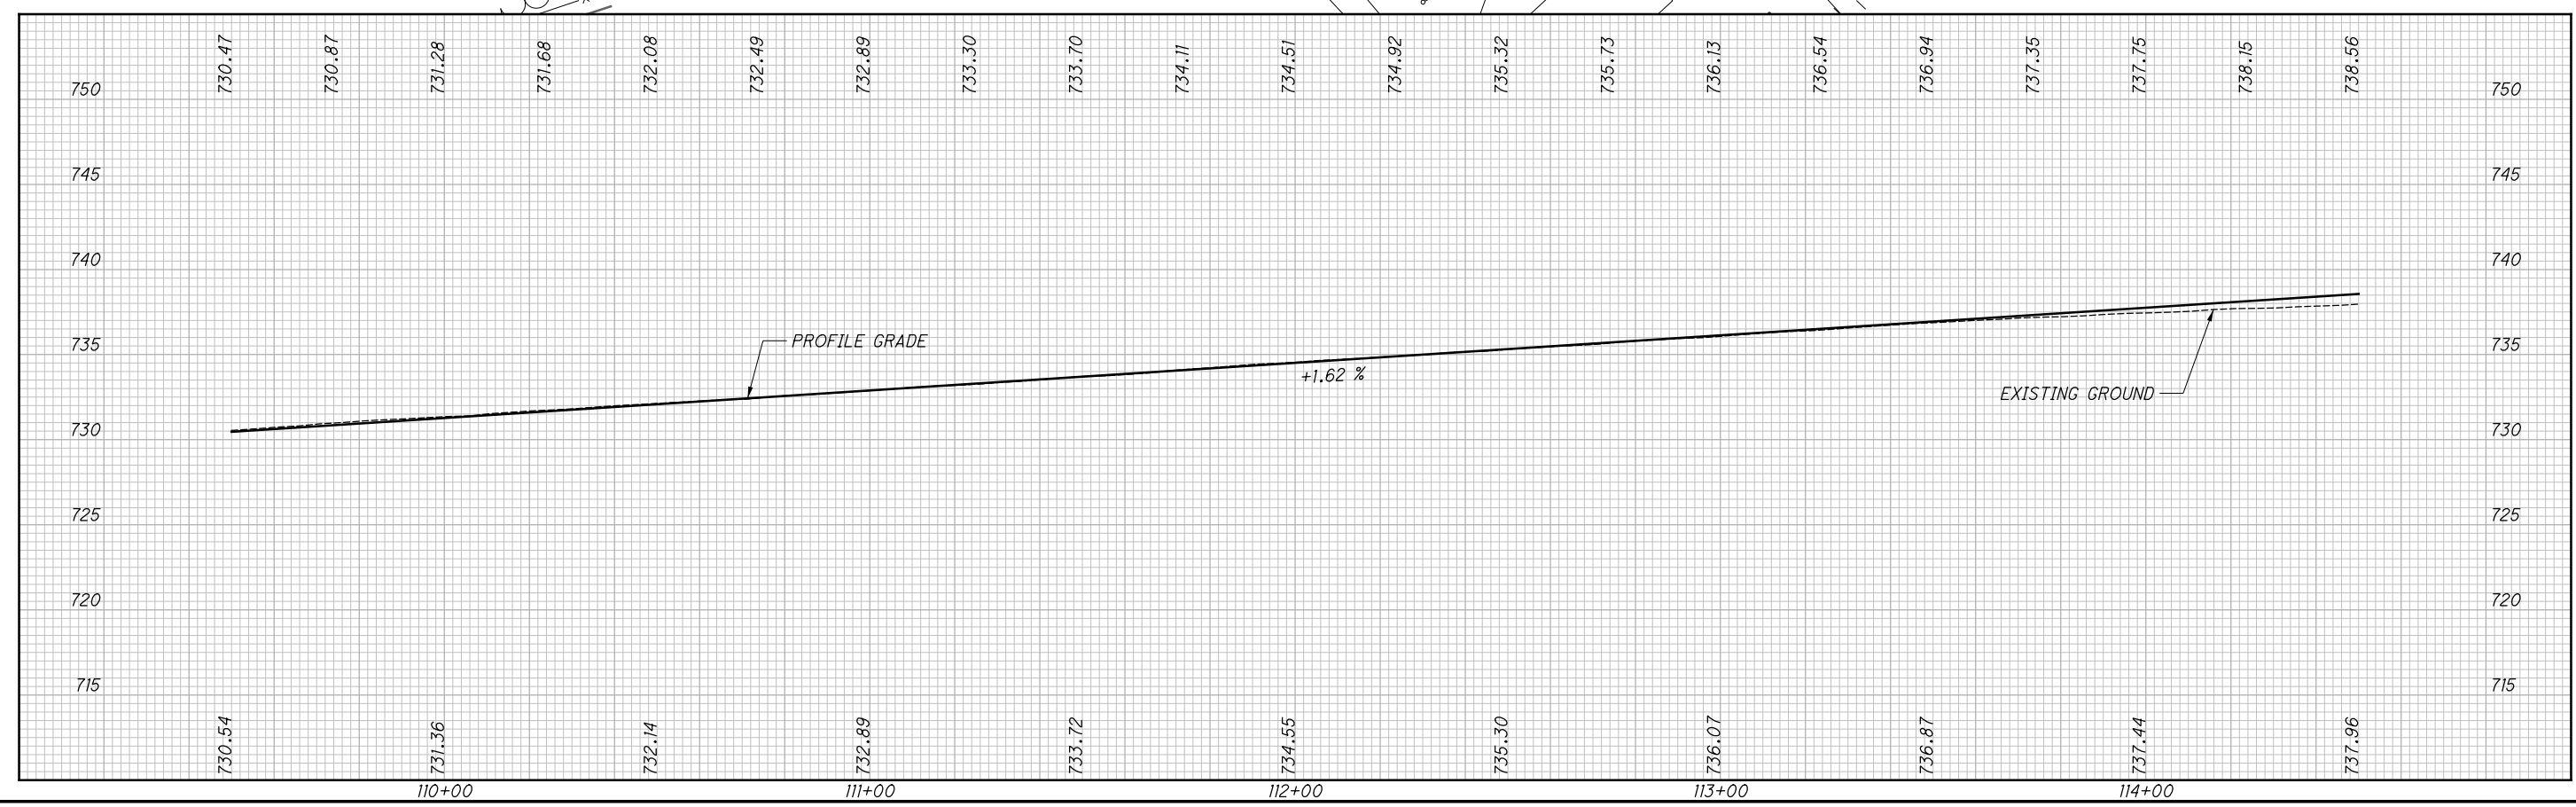


PLAN AND PROFILE - RAMP OBE-JN
STA. 109+50 TO STA. 114+50


CUY-176-10.13

187
 363

pw:\AECOM-NA-AWS\ecomonline\local\AECOM_DS01_NA\Documents\60527425-CUY-176-10.13\900-CAD_GIS\01941_CUY-176-10.13\Design\Roadway\Sheets\01941_GP018.dgn Design 6/26/2020 9:37:47 AM Robert.jank

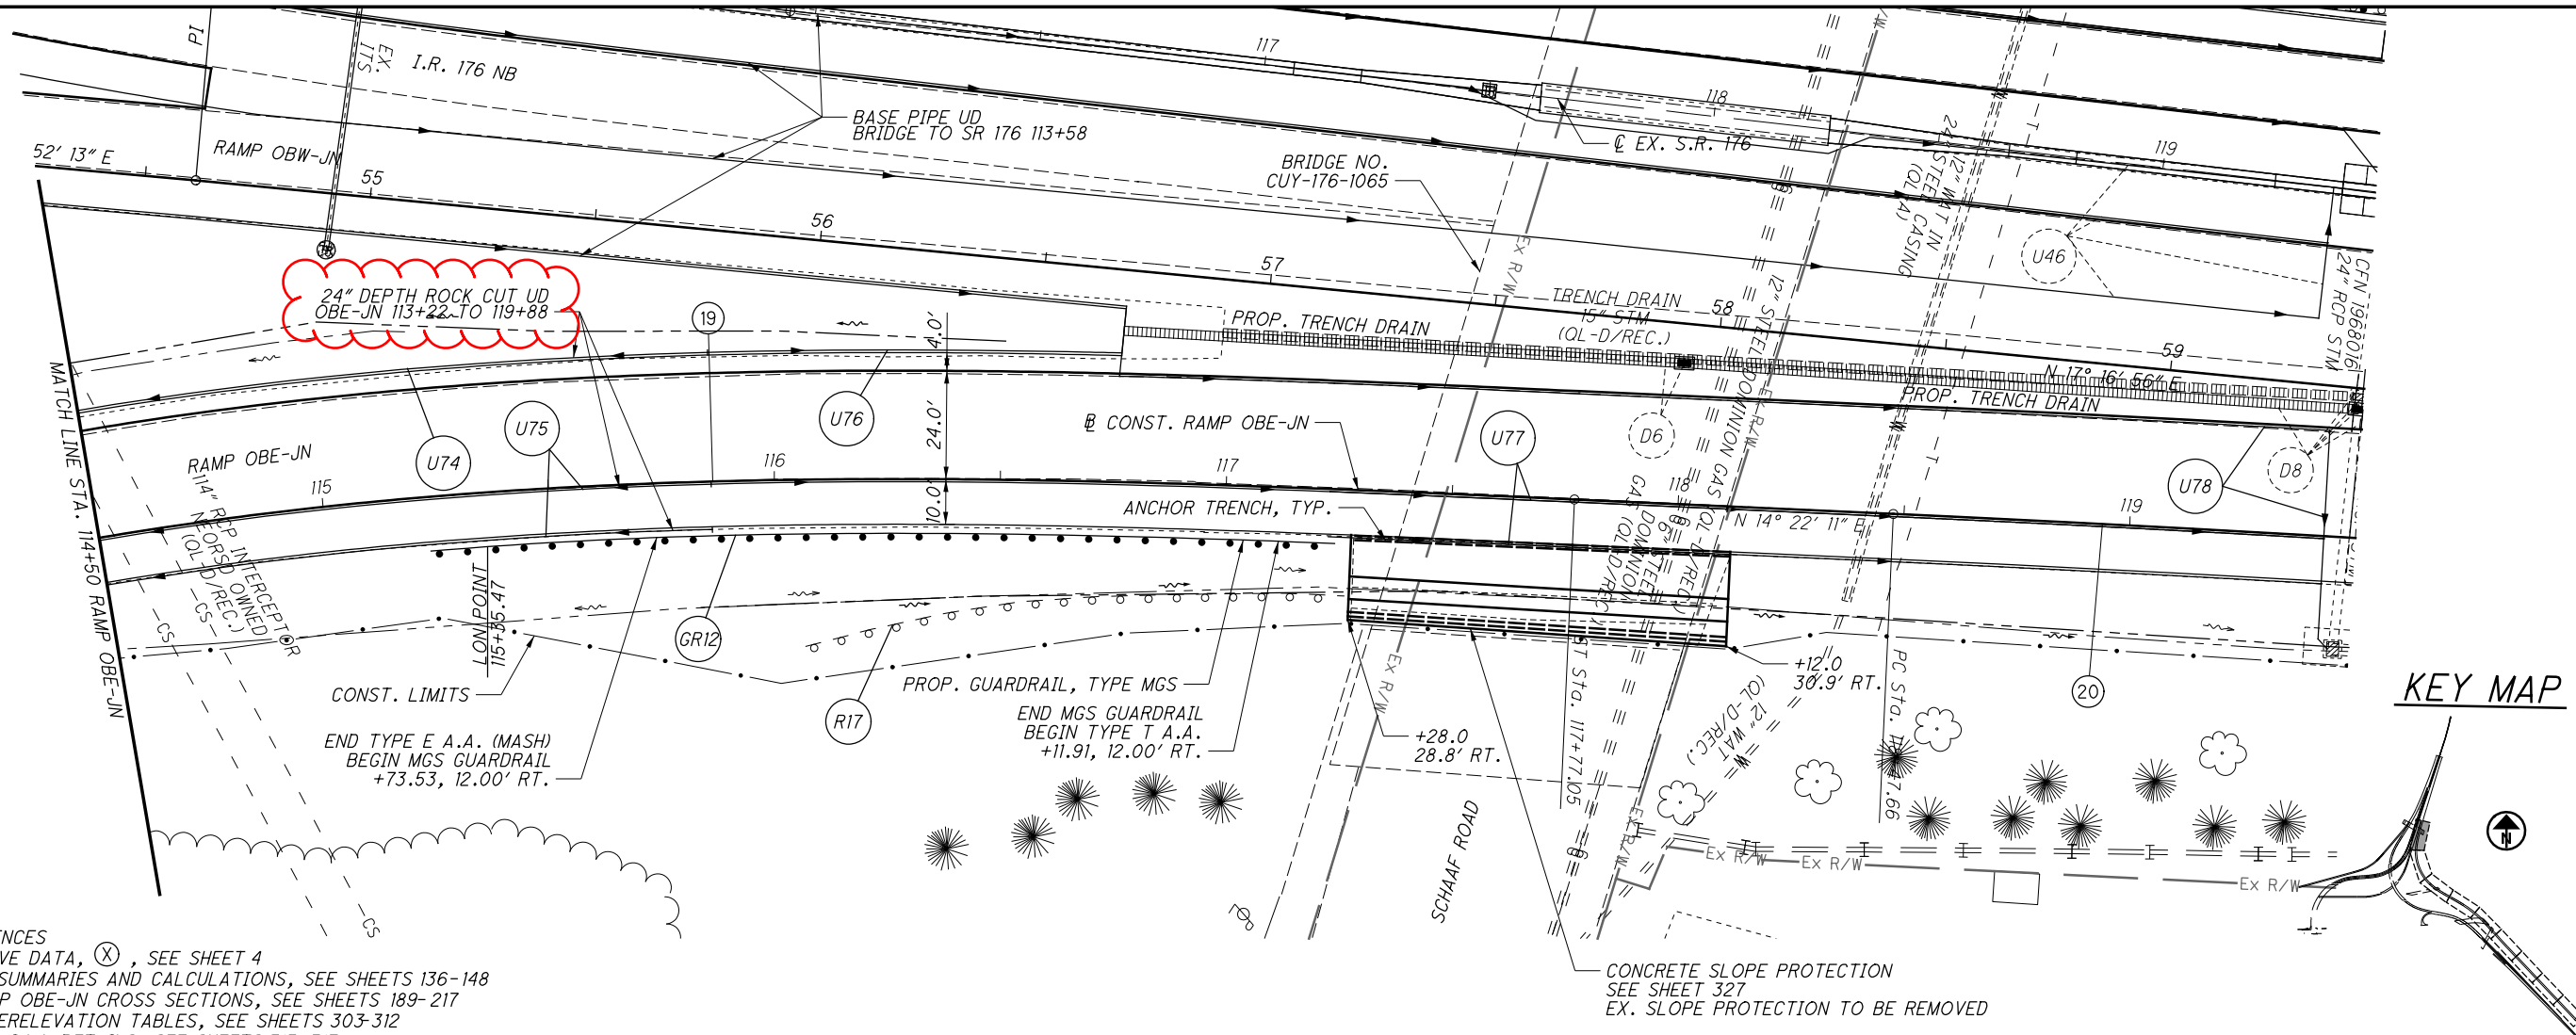

CROSS REFERENCES
 FOR CURVE DATA, (X), SEE SHEET 4
 FOR SUBSUMMARIES AND CALCULATIONS, SEE SHEETS 136-148
 FOR RAMP OBE-JN CROSS SECTIONS, SEE SHEETS 189-217
 FOR SUPERELEVATION TABLES, SEE SHEETS 303-312
 FOR TERMINAL DETAILS, SEE SHEETS 313-317

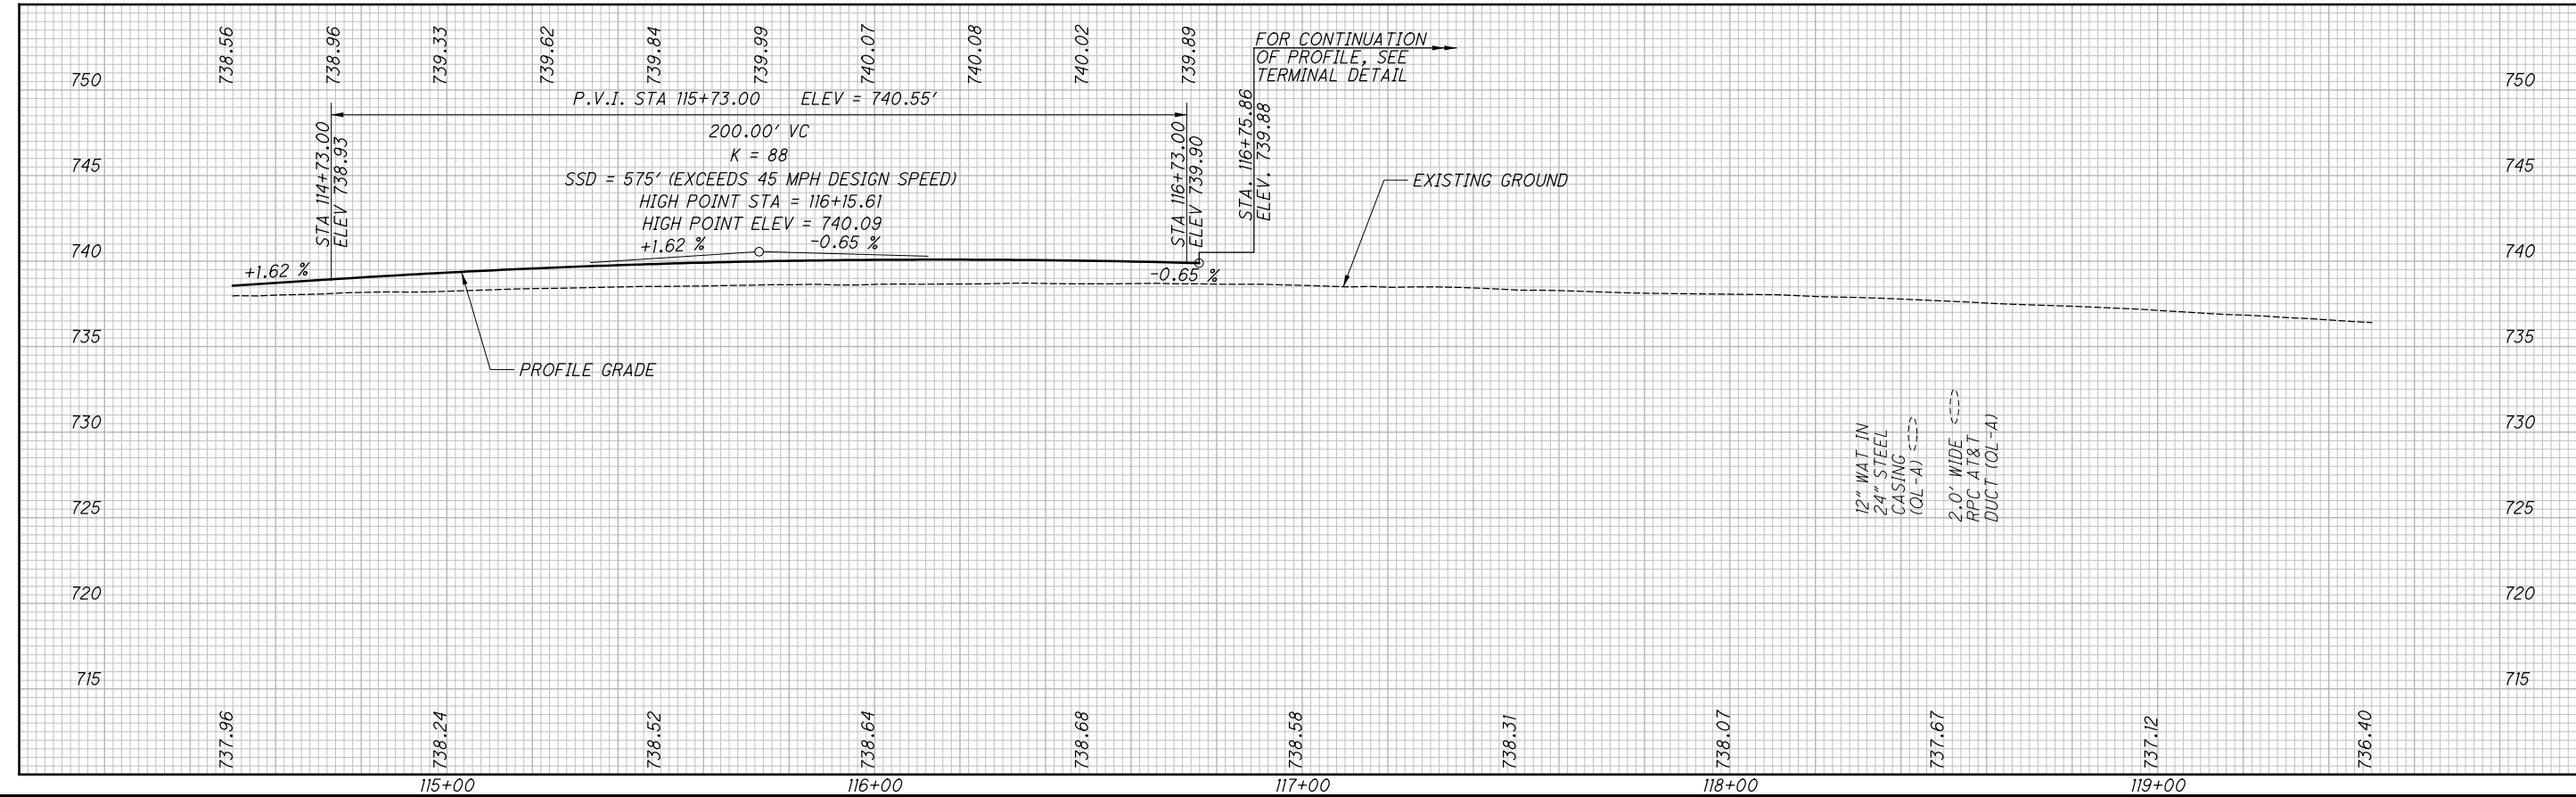


PLAN AND PROFILE - RAMP OBE-JN
STA. 114+50 TO STA. 119+50

CUY-176-10.13
 188
 363

p:\AECOM-NA-AWS\ecomonline\local\AECOM_DS01_NA\Documents\60527425-CUY-176-10.13\900-CAD_GIS\01941_CUY-176-10.13\Design\Roadway\Sheets\01941_XS005.dgn Sheet 6/22/2020 12:00:08 PM

SEEDING	END	
	WIDTH	SO. YDS.
	30	
	125	
	29	
	158	
	28	
	164	
	447	

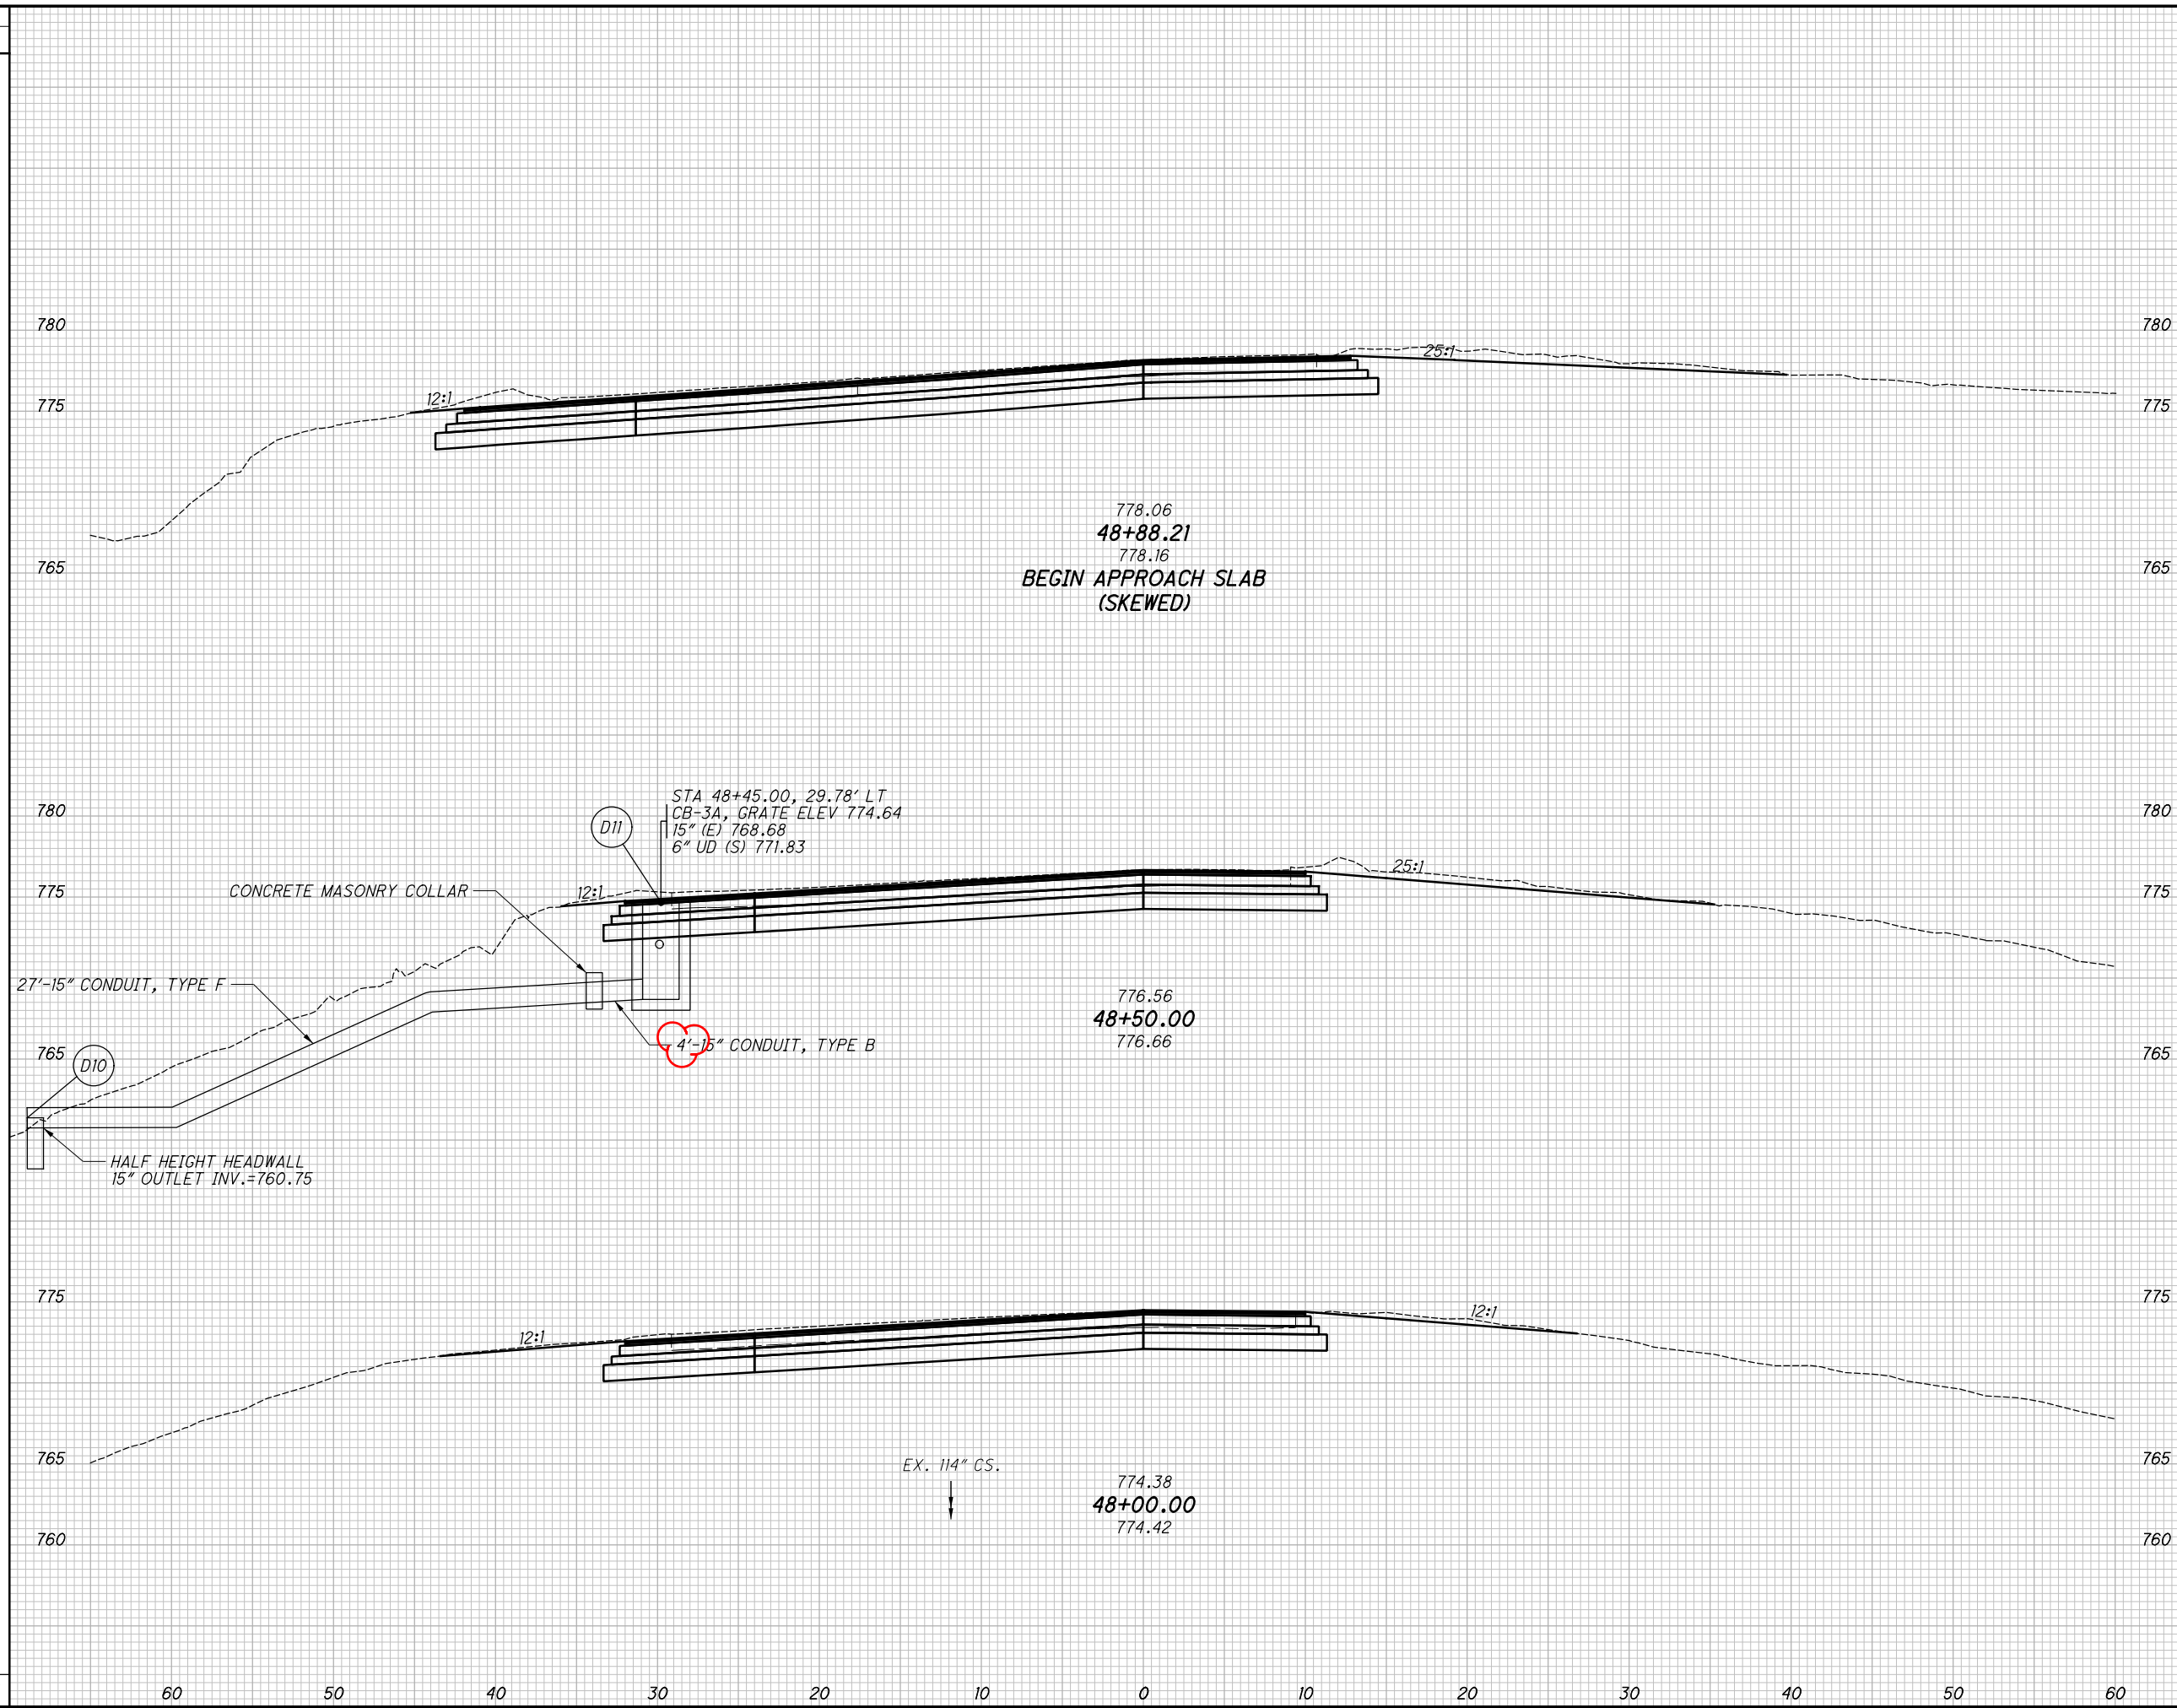

END AREA	VOLUME	
	CUT	FILL
157	0	
193	0	
116	0	
217	0	
118	0	
227	0	
637	0	

CALCULATED JEM
 CHECKED MAW
CROSS SECTIONS RAMP JN-OBE
STA. 48+00.00 TO STA. 48+88.21
CUY-176-10.13
 229
 363

p:\AECOM\NA-AWS\ecomonline\local\AECOM_DS01_NA\Documents\60527425-CUY-176-10.13\900-CAD_GIS\01941_CUY-176-10.13\Design\Roadway\Sheets\01941_XS005.dgn Sheet 6/22/2020 12:00:17 PM Robert.Jank

SEEDING	END	
	WIDTH	SO. YDS.
	24	
	122	
	20	
	56	
	20	
	0	
	178	


TEMPORARY PAVEMENT


END AREA	VOLUME	CALCULATED	CHECKED		
				CUT	FILL
114	0				
116	0				
129	0				
158	0				
	342	0	0		

**CROSS SECTIONS RAMP JN-OBE
 STA. 56+24.66 TO STA. 57+00.00**

CUY-176-10.13

230
363

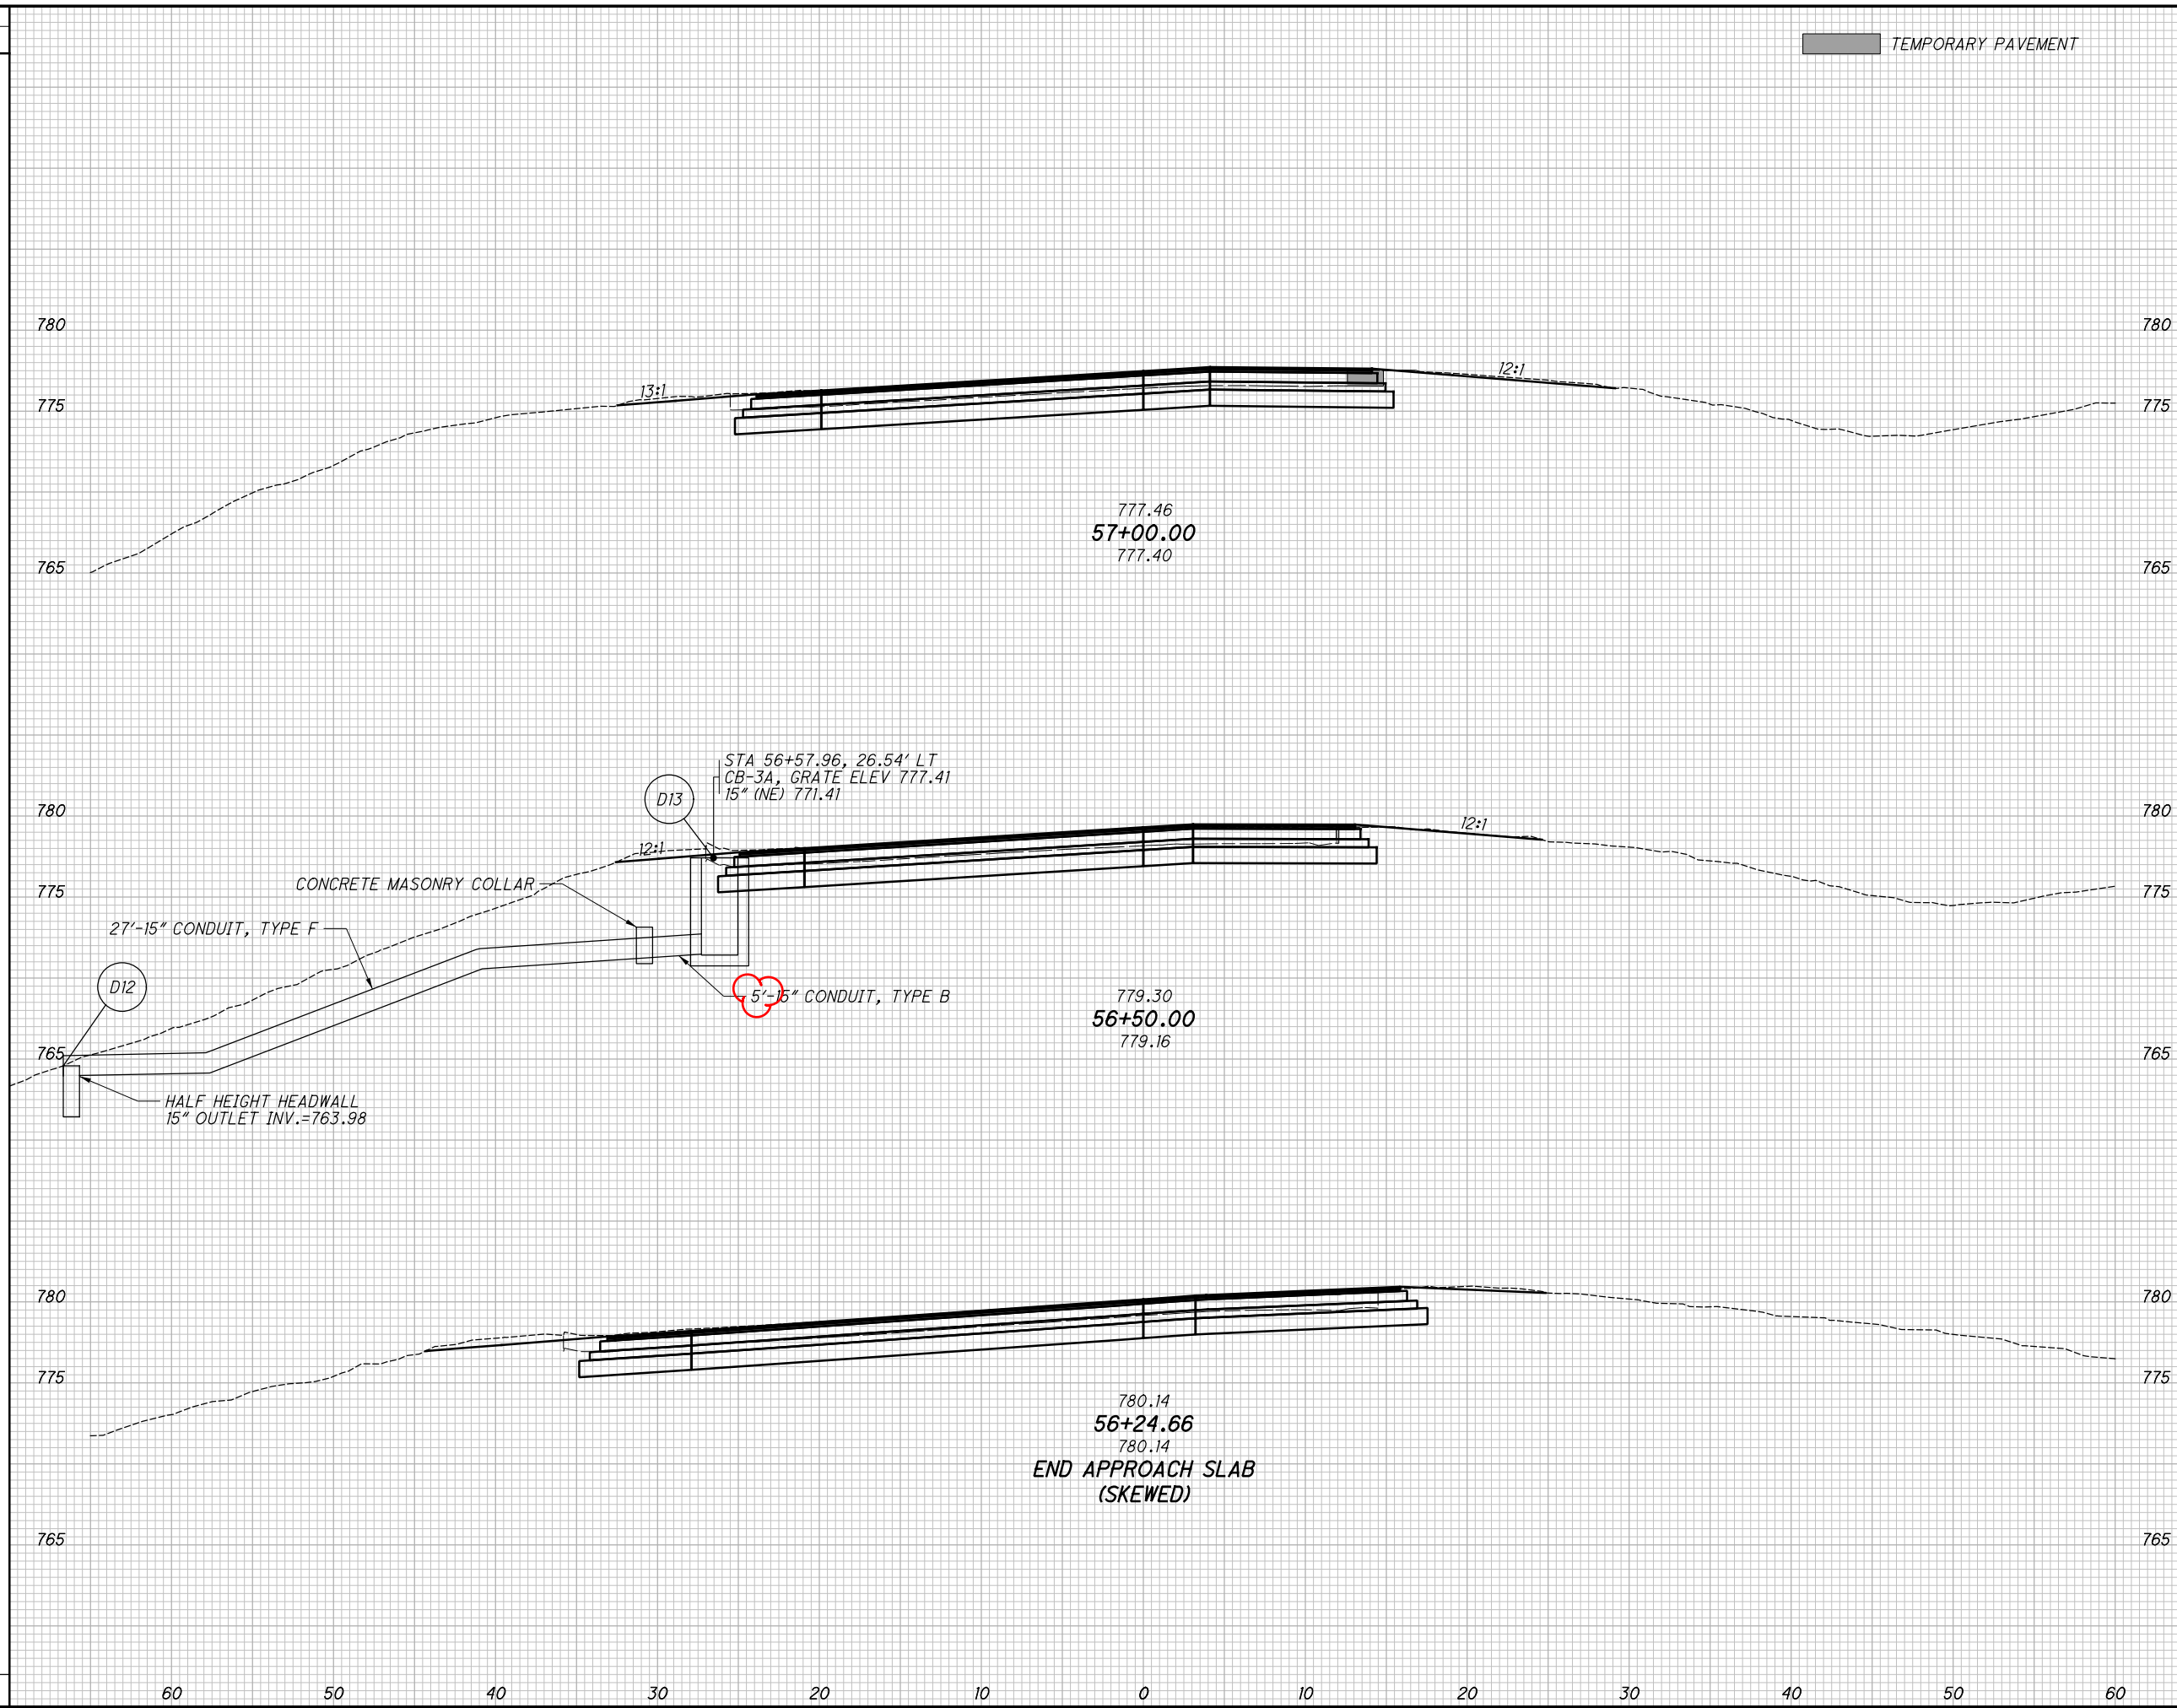

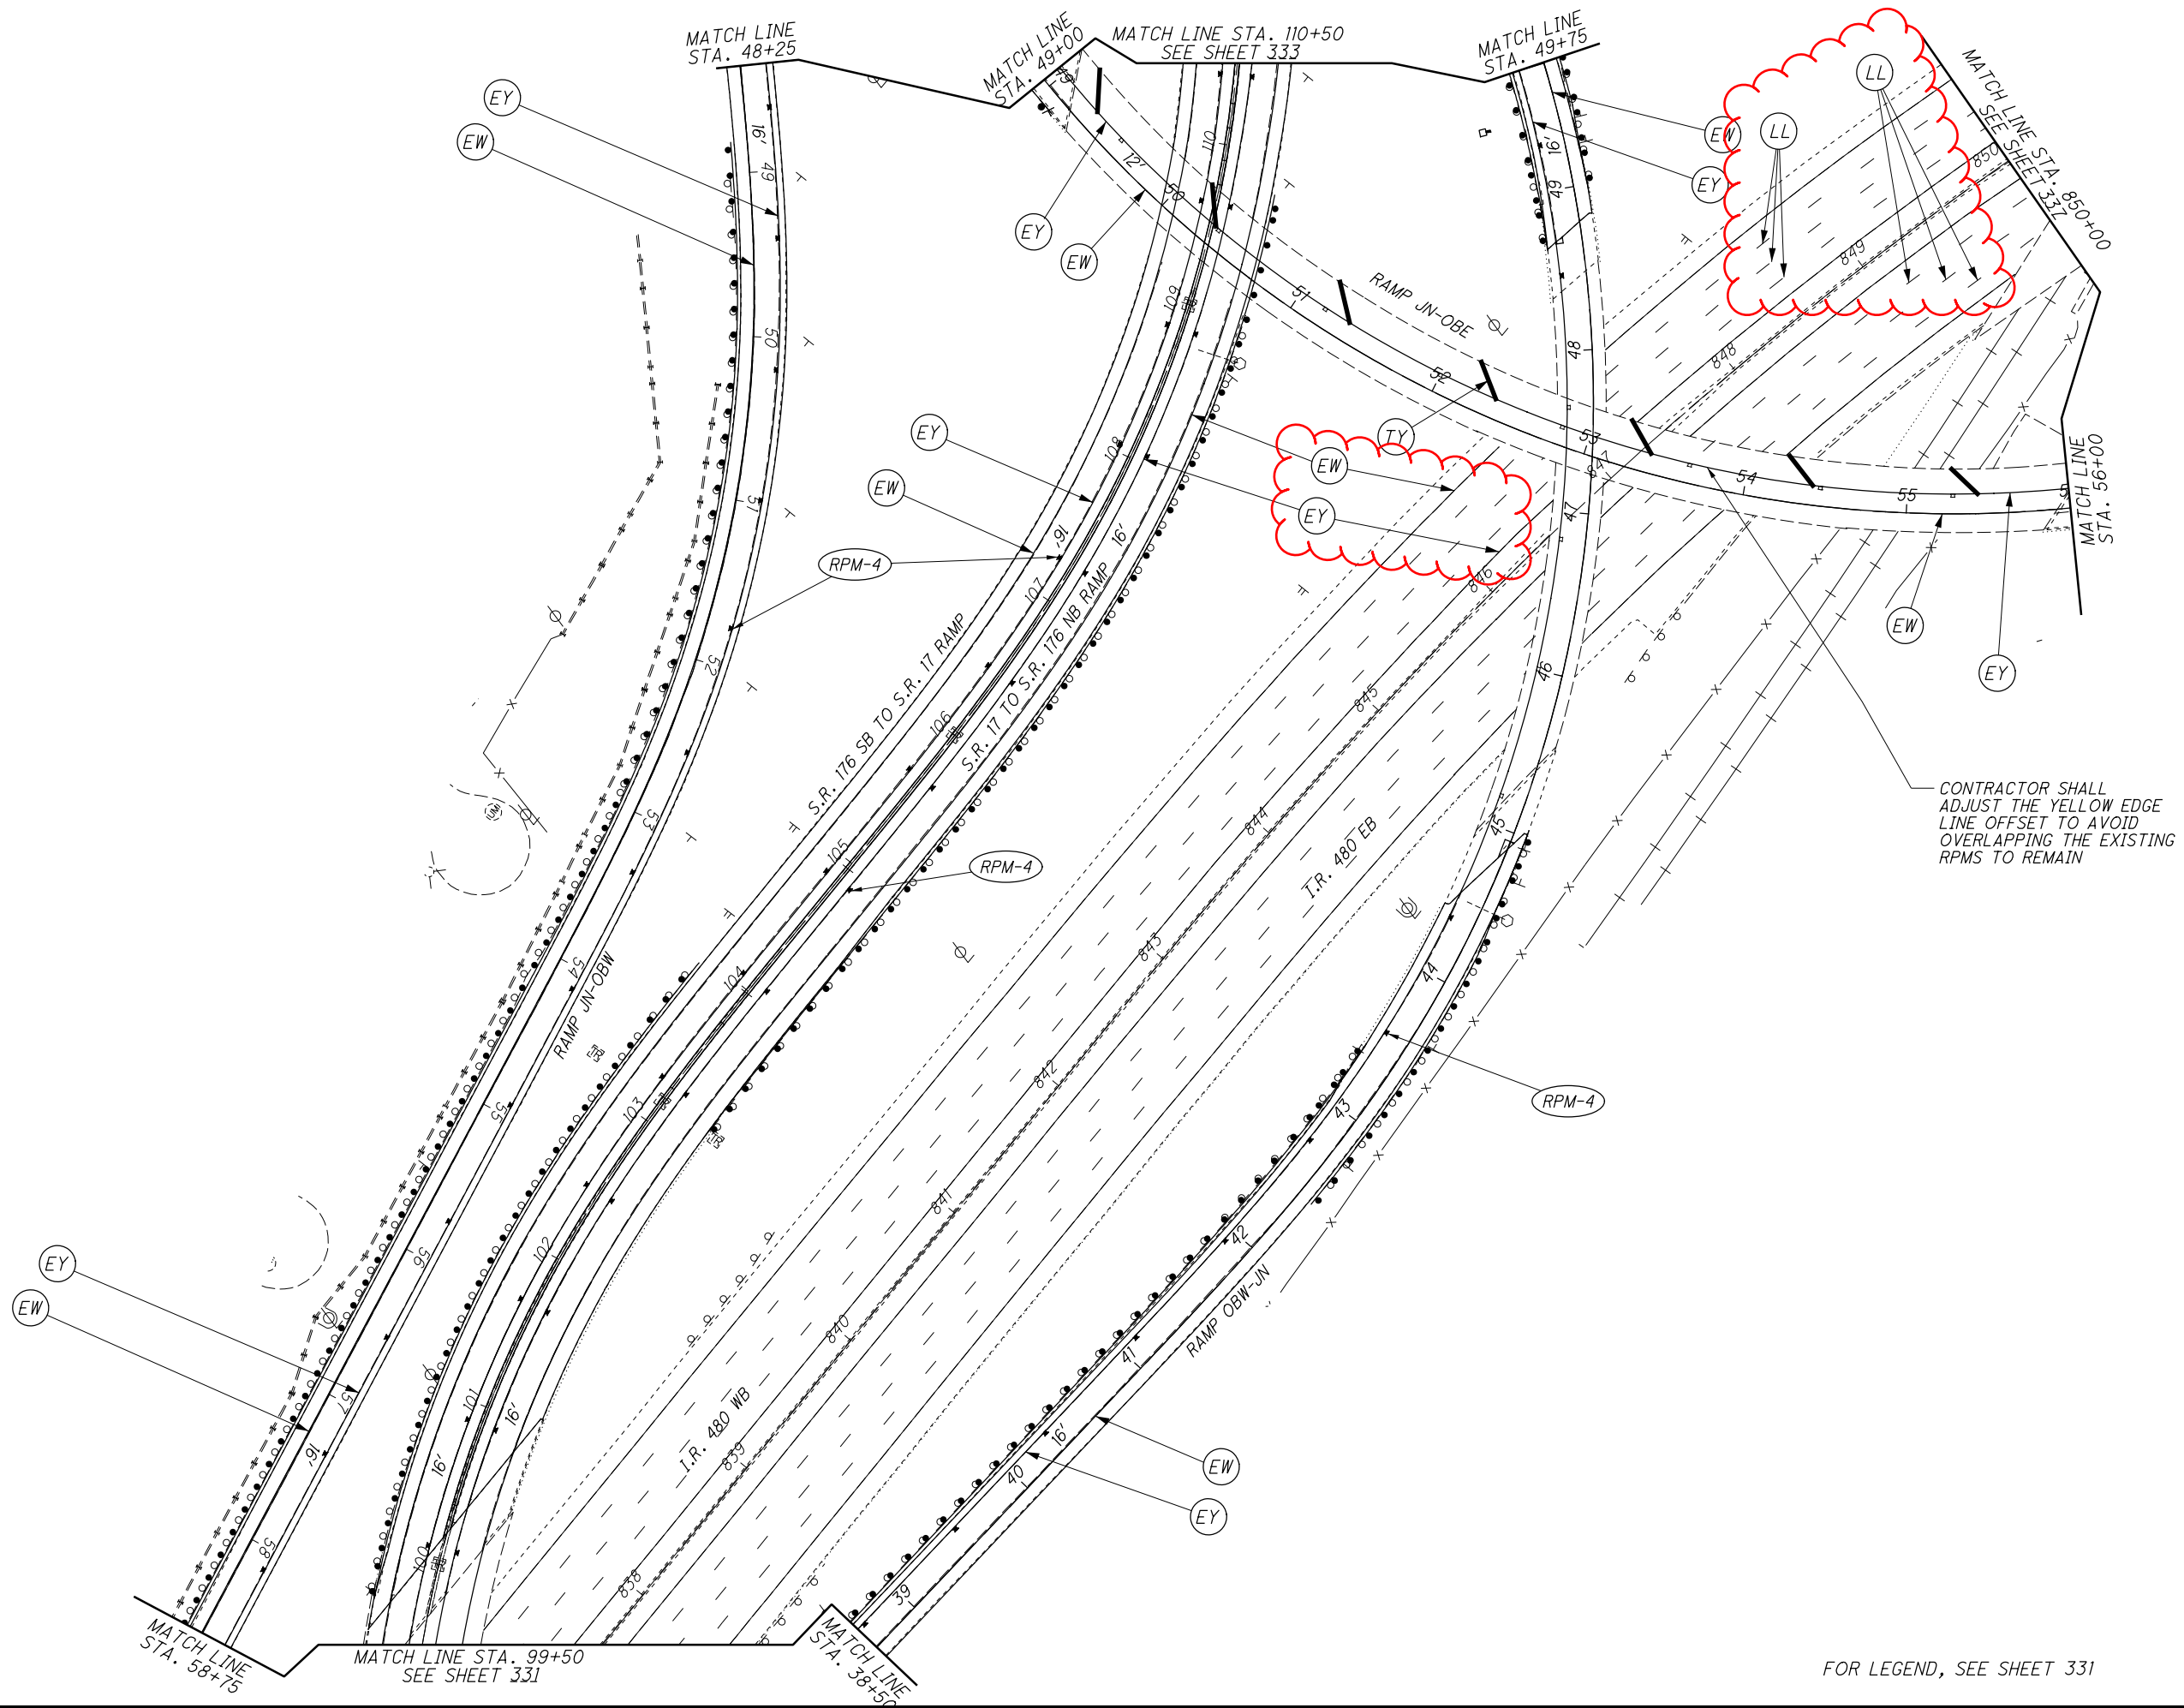


CALCULATED	CX
CHECKED	TKI

PAVEMENT MARKING PLAN
STA. 99+50 TO STA. 110+50

CUY-176-10.13

FOR LEGEND, SEE SHEET 331

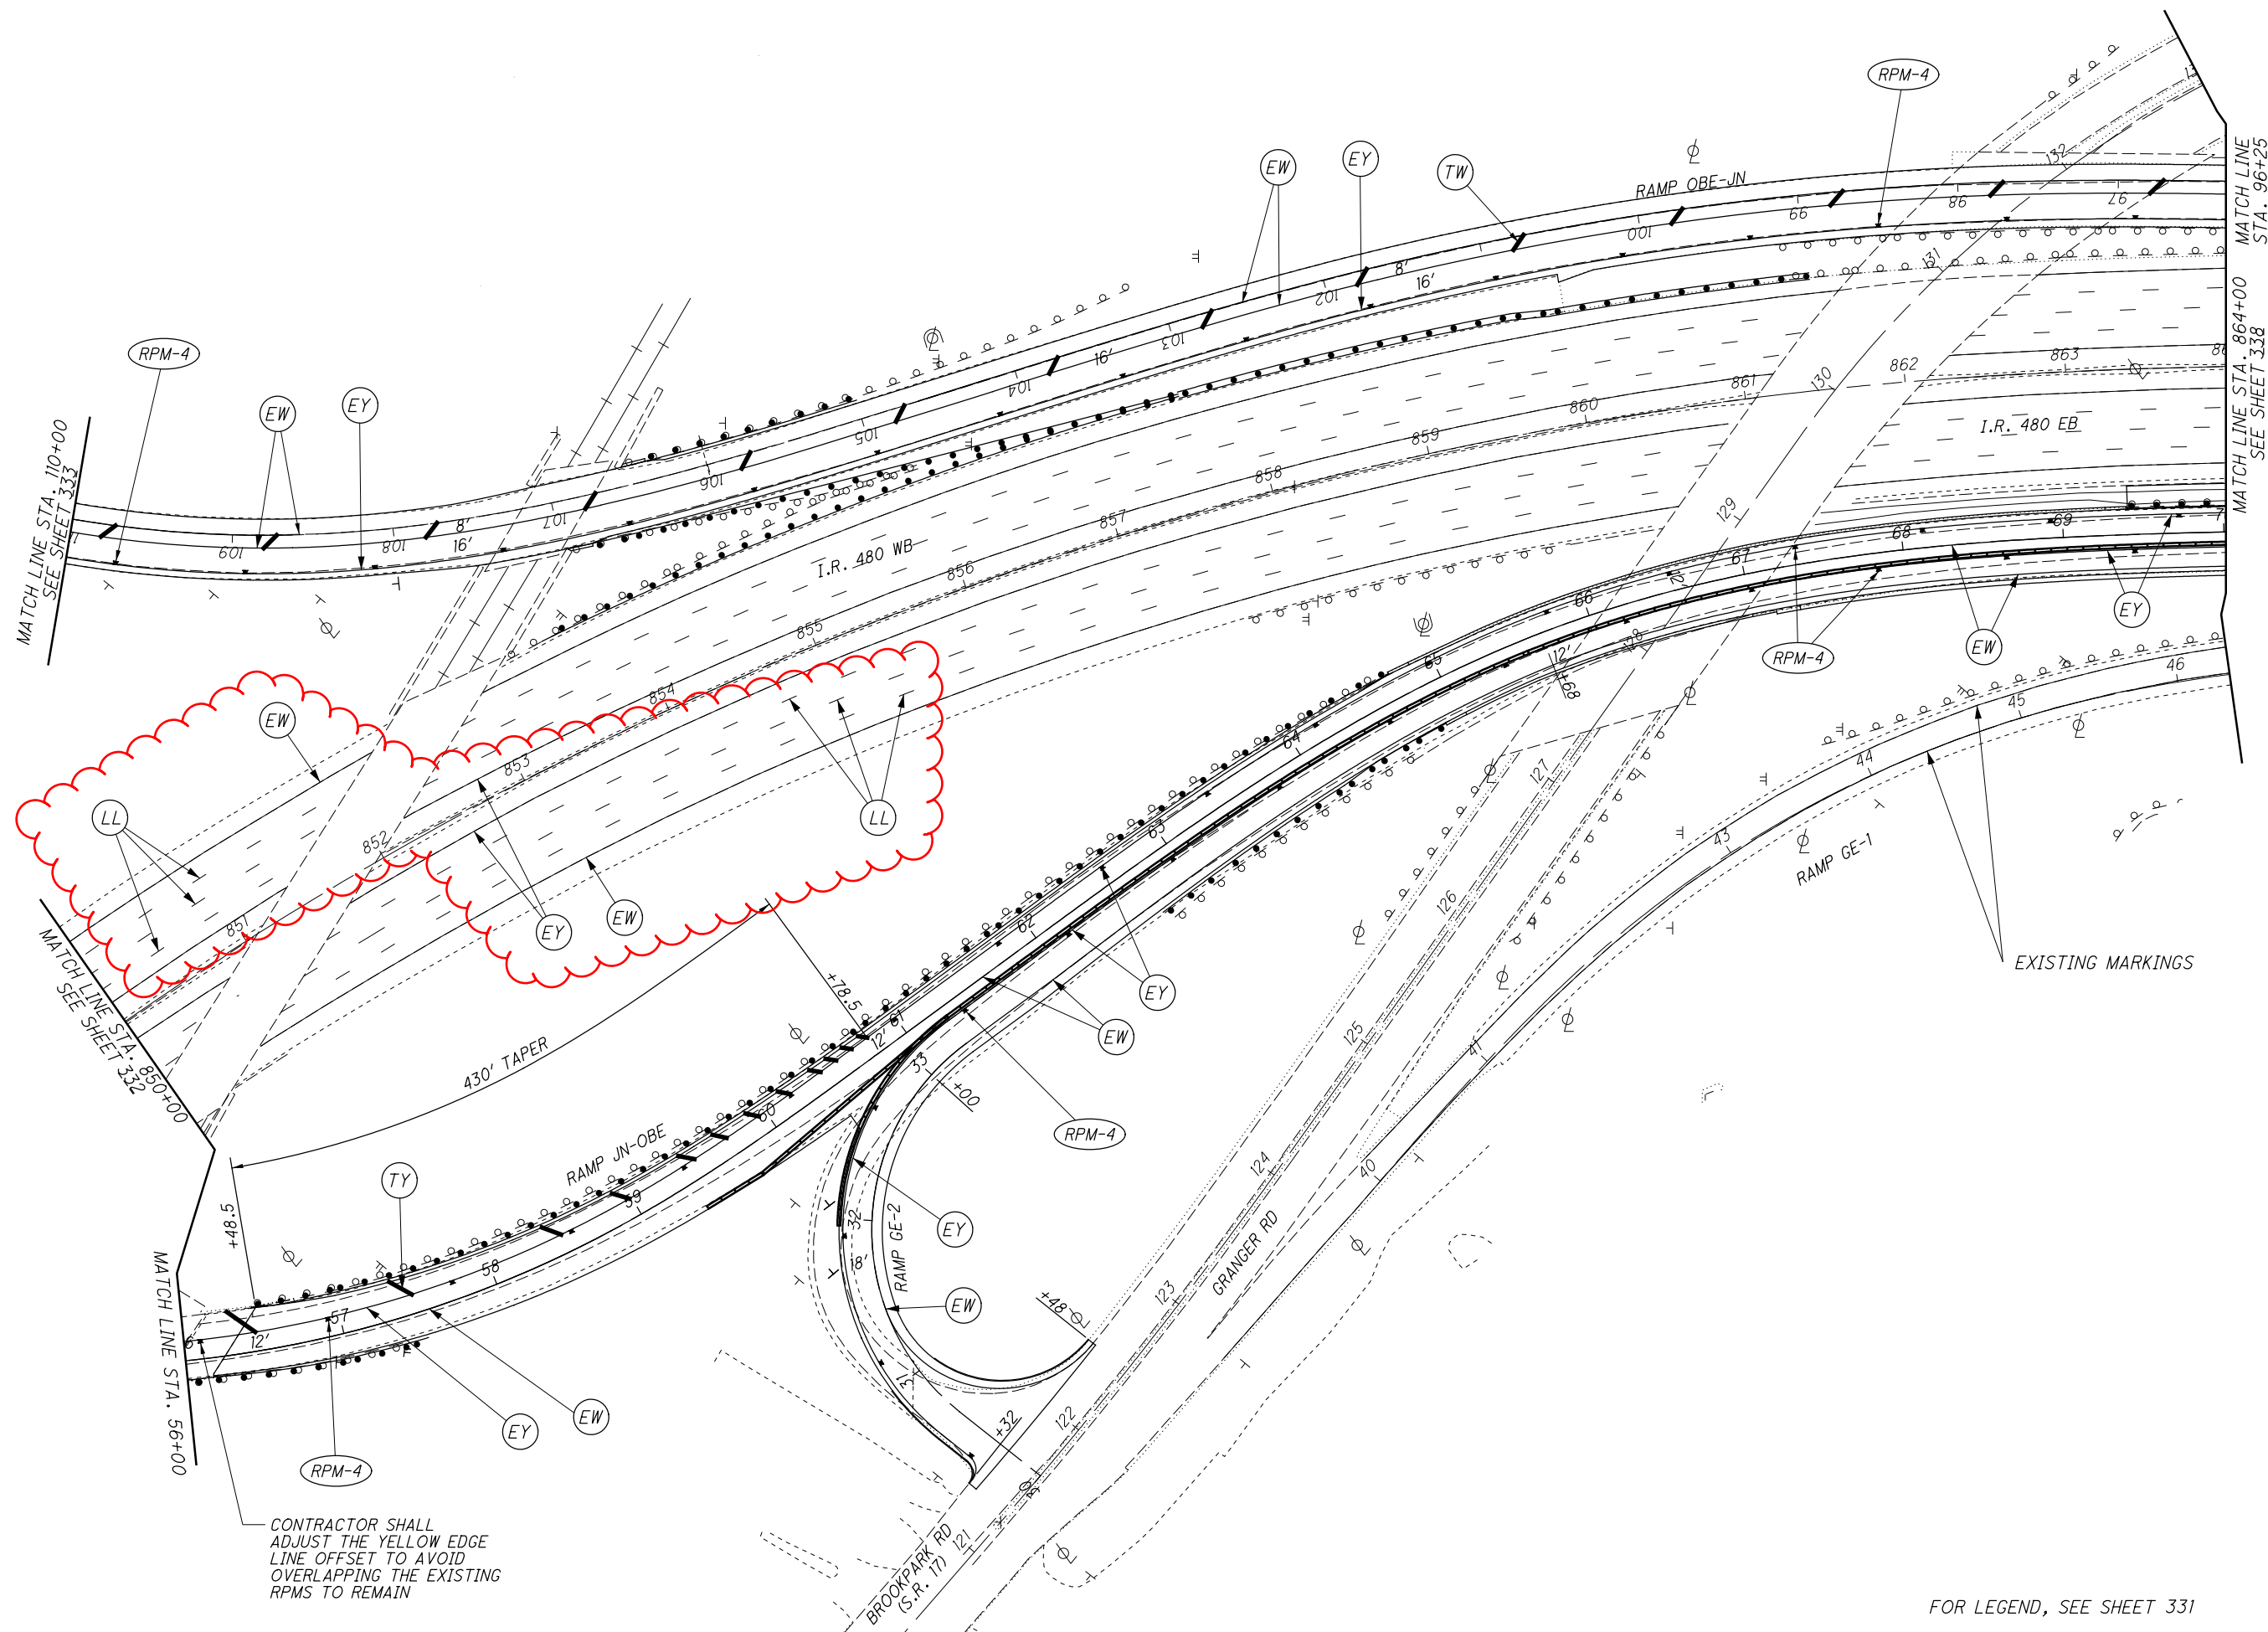


CALCULATED
CX
CHECKED
TKI

0 50 100
25
HORIZONTAL
SCALE IN FEET

PAVEMENT MARKING PLAN
STA. 850+00 TO STA. 864+00 (I.R. 480)

CUY-176-10.13

FOR LEGEND, SEE SHEET 331

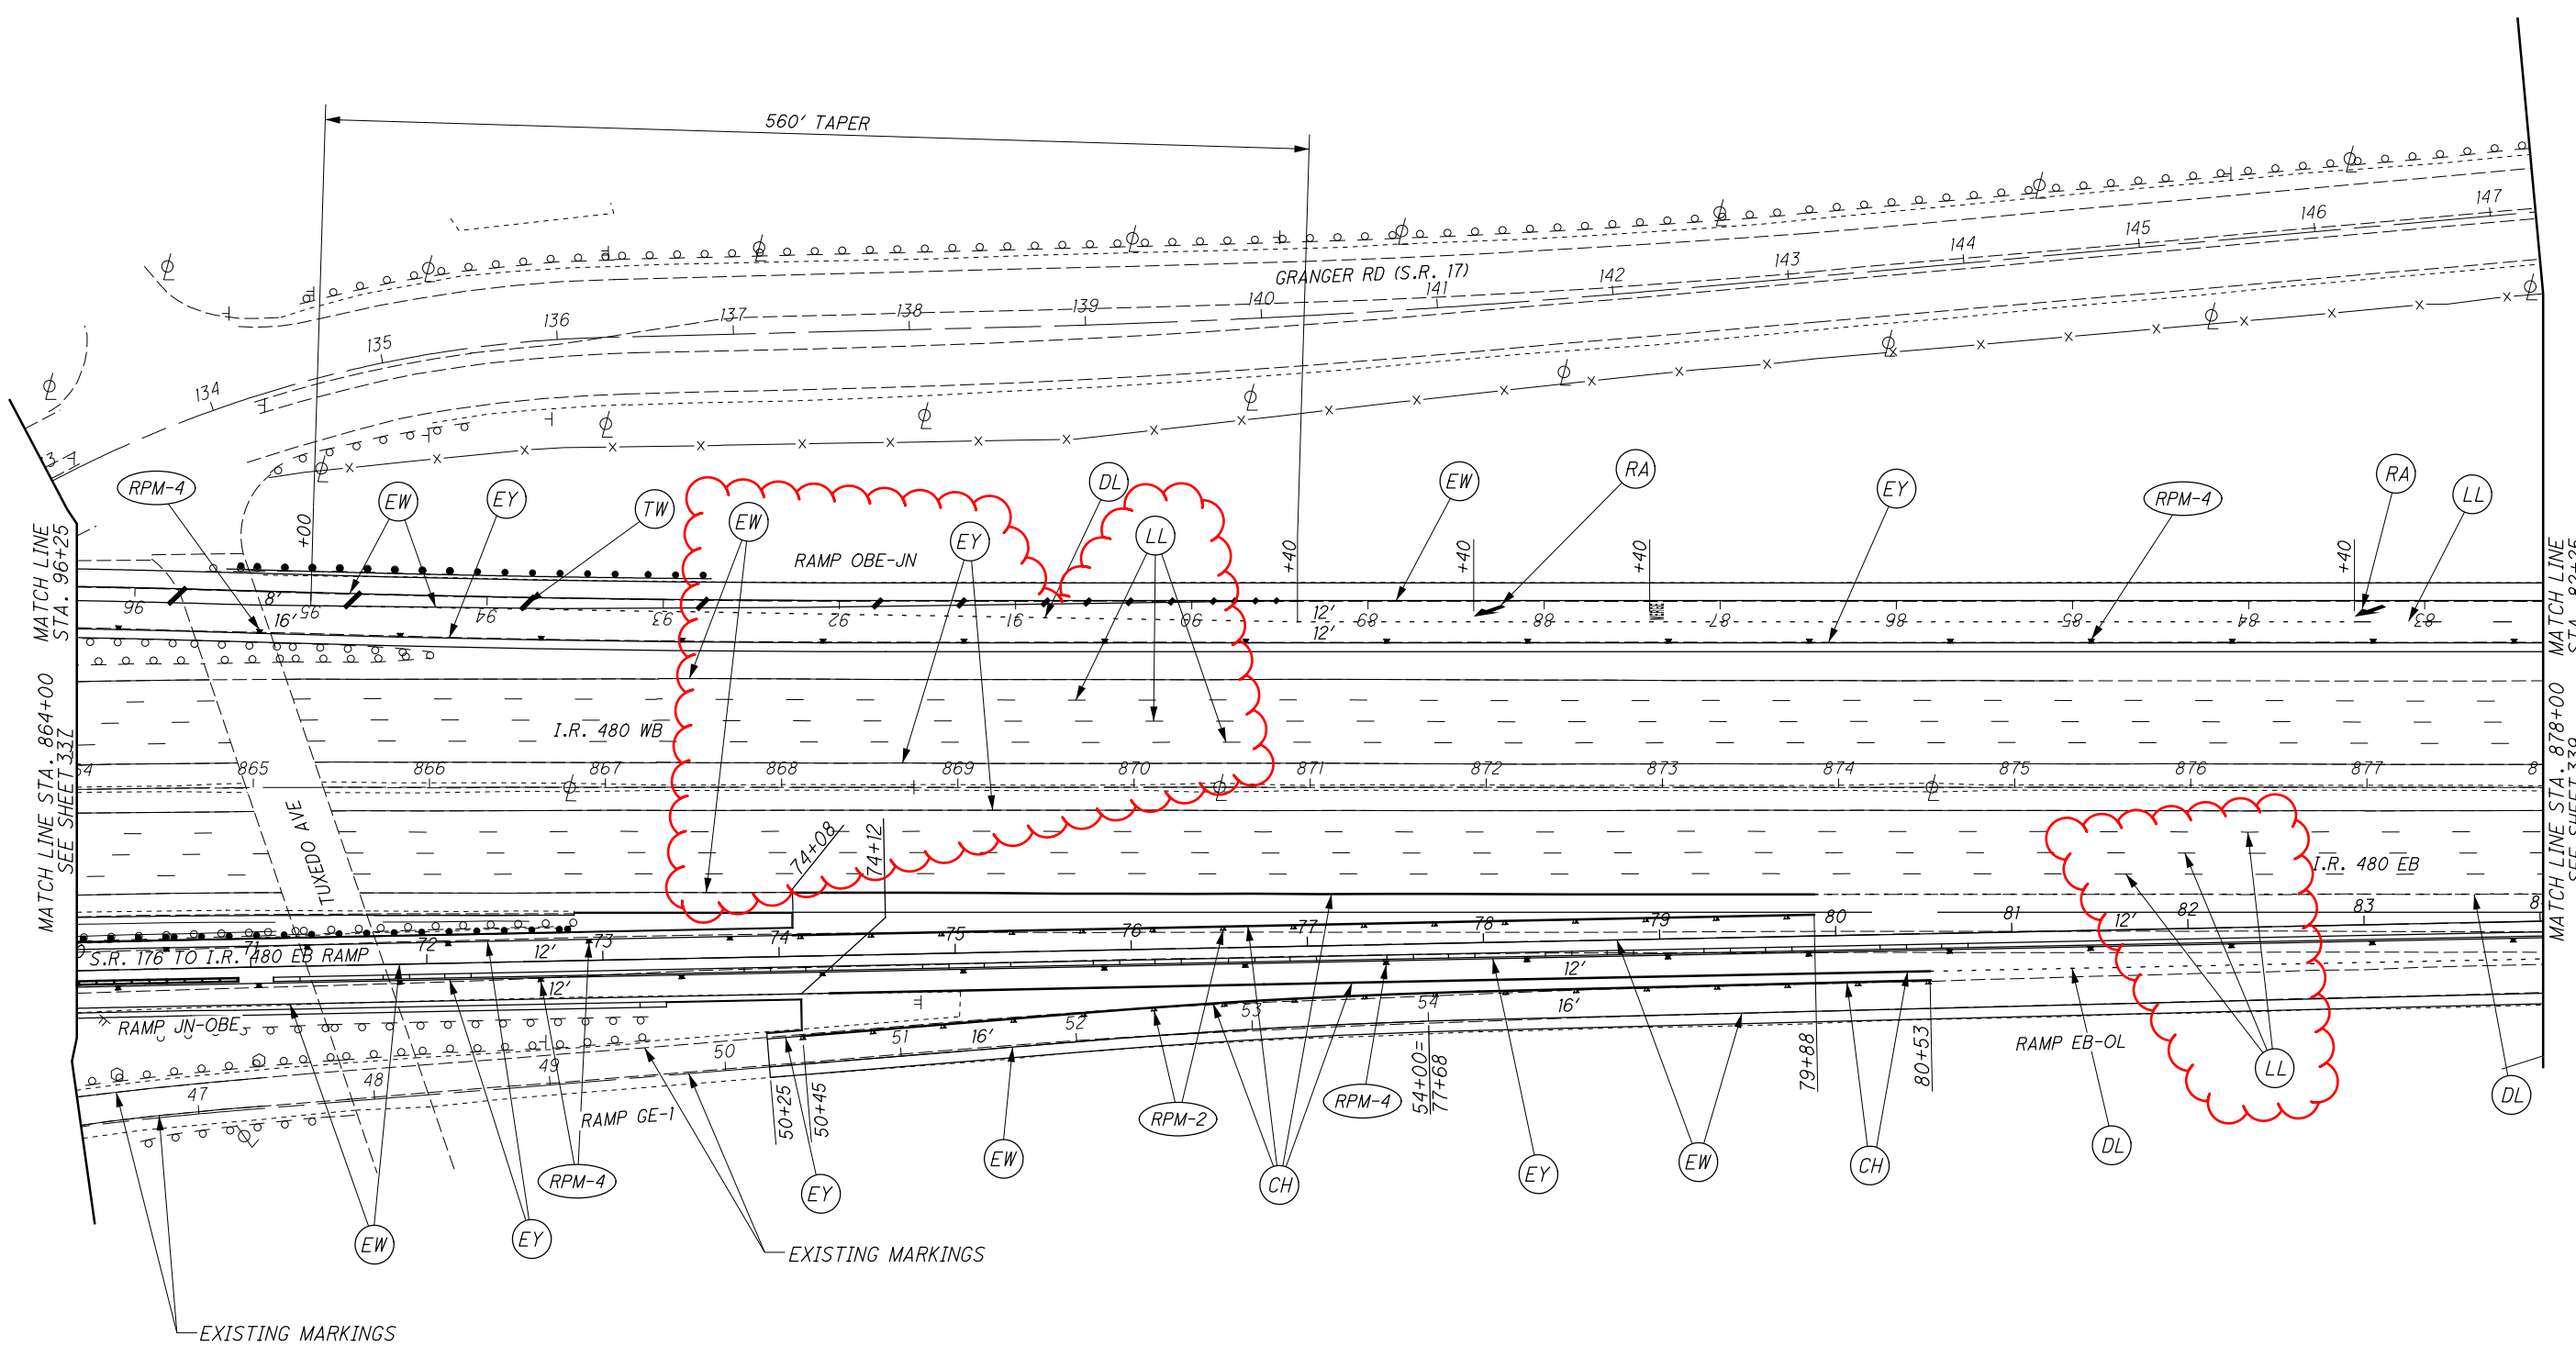


CALCULATED
CX
CHECKED
TKI

0 50 100
25
HORIZONTAL
SCALE IN FEET

PAVEMENT MARKING PLAN
STA. 864+00 TO STA. 878+00 (I.R. 480)

CUY-176-10.13

FOR LEGEND, SEE SHEET 331

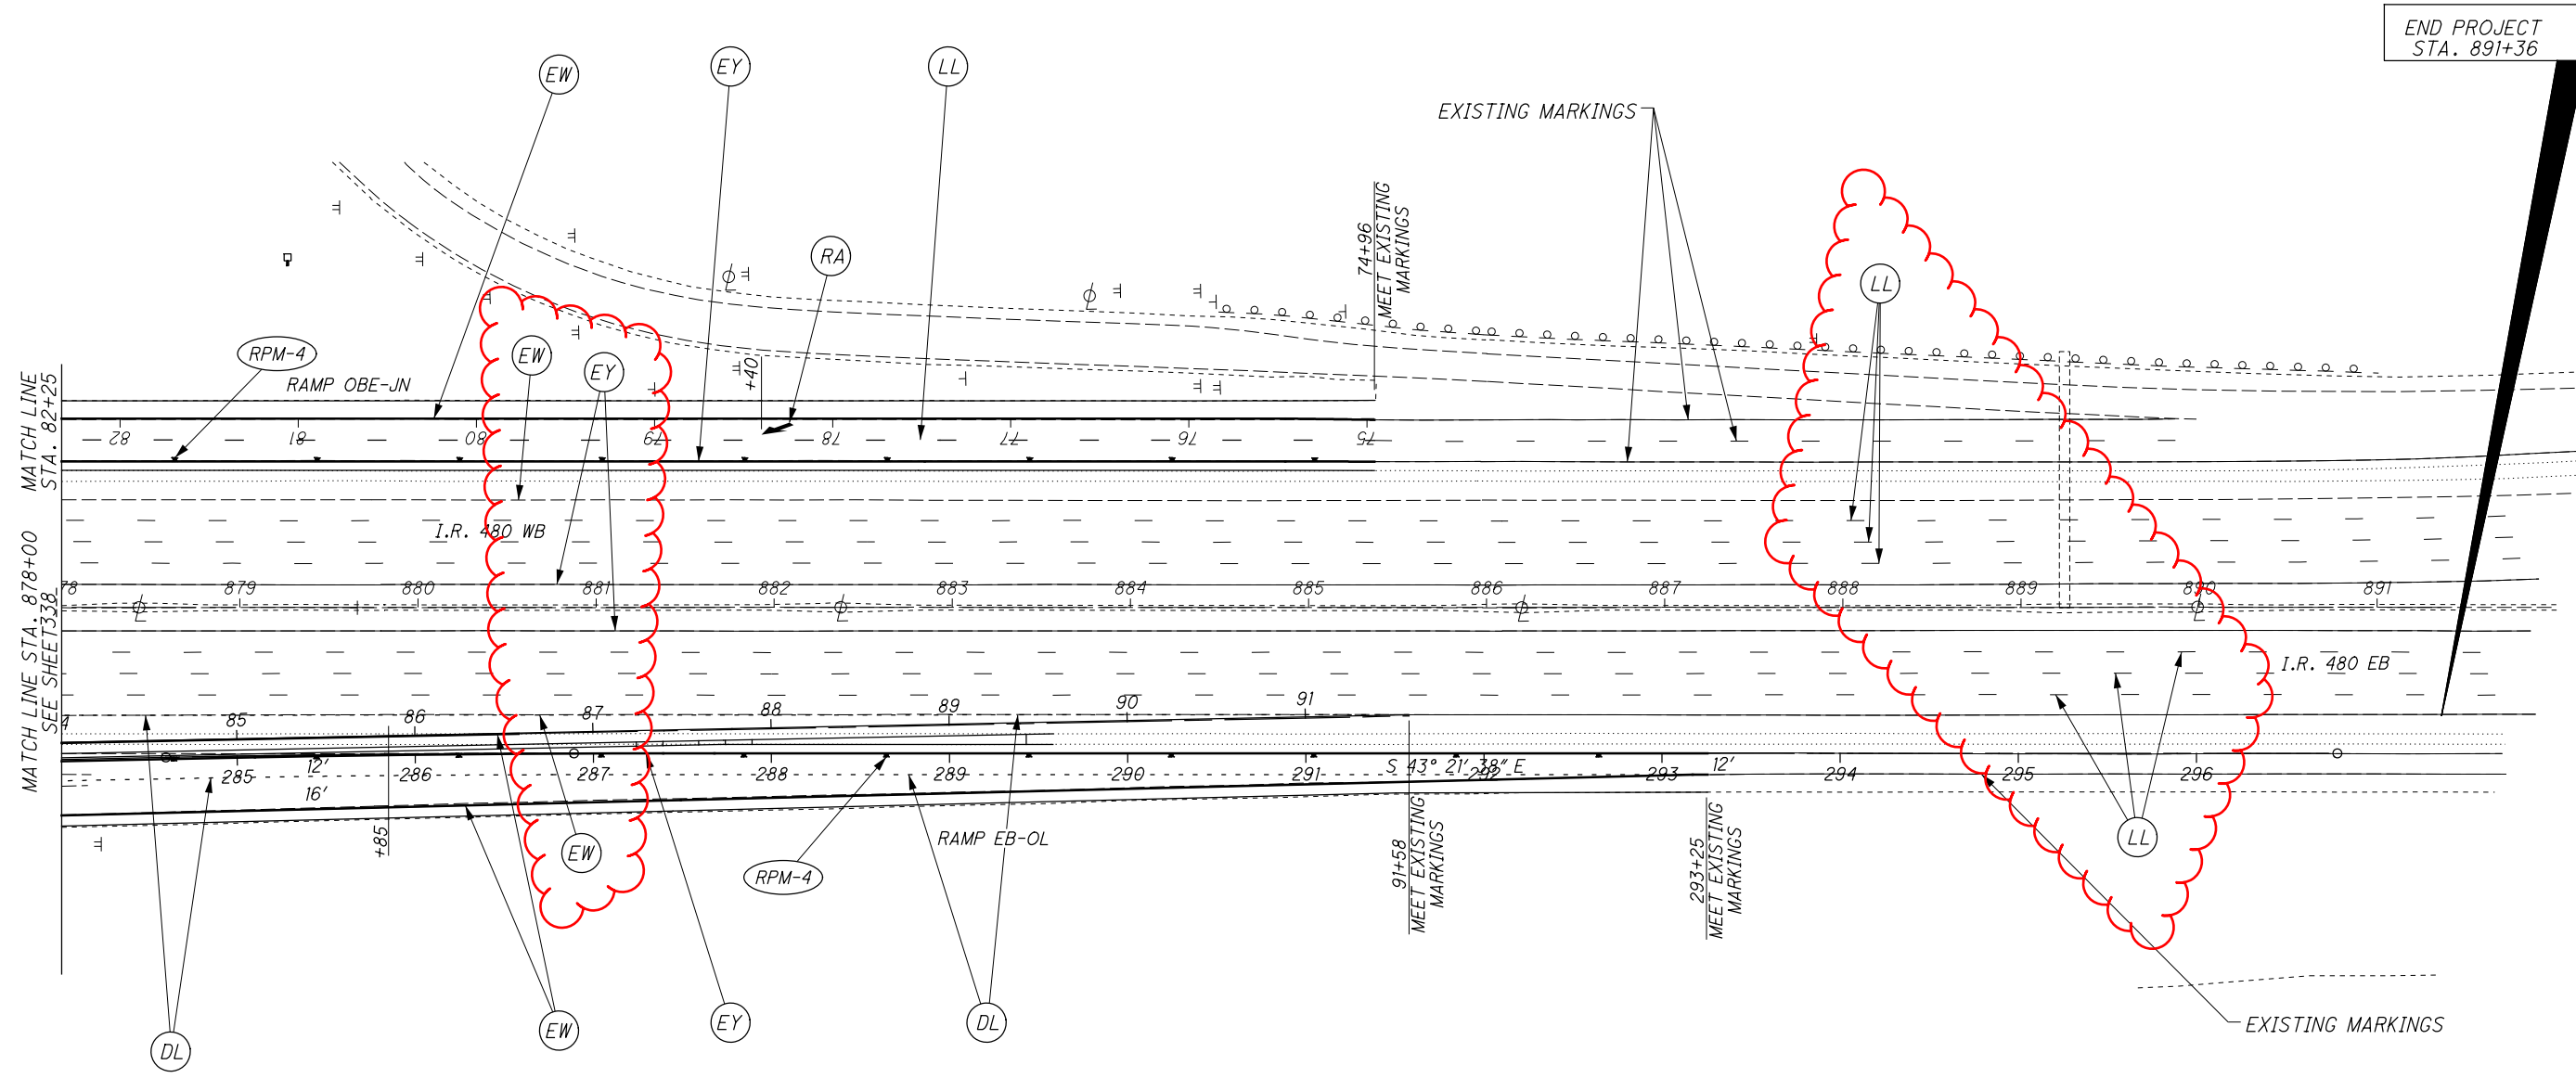

END PROJECT
STA. 891+36

CALCULATED CX
CHECKED TKI

0 50 100
HORIZONTAL SCALE IN FEET

PAVEMENT MARKING PLAN
STA. 878+00 TO STA. 891+36 (I.R. 480)

CUY-176-10.13

339
363

FOR LEGEND, SEE SHEET 331

SHEET NO.	REFERENCE NO.	STATION	SIDE	621	621	621	646	646	646	646	646	646	646	646	646	646	646	646	646	646	646	646	646	646		
				RPM	RPM REFLECTOR	RAISED PAVEMENT MARKER REMOVED	EDGE LINE, 6"	LANE LINE, 6"	LANE LINE, 6", AS PER PLAN	CHANNELIZING LINE, 12"	STOP LINE	CROSSWALK LINE	TRANSVERSE/DIAGONAL LINE	CHEVRON MARKING	ISLAND MARKING	LANE ARROW	WRONG WAY ARROW	LANE REDUCTION ARROW	WORD ON PAVEMENT, 96" "MERGE"	DOTTED LINE, 6" YELLOW 2' LINE 6' GAP	DOTTED LINE, 6" 3' LINE 9' GAP	DOTTED LINE, 12" 3' LINE 9' GAP	REMOVAL OF PAVEMENT MARKING	REMOVAL OF PAVEMENT MARKING		
		FROM TO		EACH	EACH	EACH	MILE	MILE	MILE	FT	FT	FT	FT	FT	SF	EACH	EACH	EACH	EACH	FT	FT	FT	EACH	FT		
		RAMP JN-OBE																								
339	EW	84+00 91+58	BL				0.14																			
339	DL	84+00 91+58	LT																		758					
		RAMP EB-OL																								
339	RPM4	284+00 293+25	LT	11		11																				
339	EY	284+00 293+25	BL				0.18																			
339	EW	284+00 293+25	RT				0.18																			
339	DL	284+00 293+25	RT																		925					
		IR 480																								
332	EY	845+71 891+36	CL				0.86																			
337	EY	851+50 891+25	CL				0.75																			
332	EW	845+71 891+36	LT				0.86																			
337	EW	851+50 891+25	RT				0.75																			
332	LL	842+71 904+39 (X3)	LT		154		3.50																			
332	LL	848+50 894+25 (X3)	RT		114		2.60																			
TOTALS THIS SHEET				11	269	11	3.73	6.10	0.00	0	0	0	0	0	0	0	0	0	0	0	1683	0	0	0		
TOTALS FROM SHEET				340	90	18	99	2.59	0.00	157	67	313	0	0	162	6	2	0	0	0	97	0	0	6	729	
TOTALS FROM SHEET				341	109	8	149	2.19	0.12	0.00	2356	0	0	554	0	0	0	0	0	0	0	0	0	0	0	0
TOTALS FROM SHEET				342	117	0	177	2.60	0.25	0.92	3643	0	0	161	308	0	0	0	0	0	0	564	1265	0	0	
TOTALS FROM SHEET				343	86	0	151	2.57	0.16	0.00	2441	0	0	179	0	0	0	0	3	1	0	1919	0	0	0	
TOTALS CARRIED TO GENERAL SUMMARY				413	295	587	13.68	6.63	0.92	8597	67	313	894	308	162	6	2	3	1	97	4166	1265	6	729		