

**ROUNDING**

THE ROUNDING AT SLOPE BREAKPOINTS SHOWN ON THE TYPICAL SECTIONS APPLIES TO ALL CROSS-SECTIONS, EVEN THOUGH OTHERWISE SHOWN.

**UTILITIES**

THE CONTRACTOR SHALL USE THE FOLLOWING PROCEDURE AT EACH LOCATION WHERE WORK IS PERFORMED, IN ACCORDANCE WITH SECTIONS 105.07 AND 107.16 IN THE CONSTRUCTION AND MATERIALS SPECIFICATIONS:

THE CONTRACTOR SHALL NOTIFY THE PROJECT ENGINEER, OHIO 811, THE OHIO DEPARTMENT OF TRANSPORTATION DISTRICT 4 HEADQUARTERS (MATT STEELE, 330-786-4832) AND ALL NON REGISTERED UTILITY OWNERS AT LEAST TWO (2) WORKING DAYS PRIOR TO COMMENCING CONSTRUCTION OPERATIONS IN ALL AREAS.

OHIO 811 1-800-362-2764 (CONTACT LIMITED BASIS PARTICIPANTS DIRECTLY)

ODOT 330-786-4832 (MATT STEELE)

ODOT ITS LAB 1606 W. BROAD ST, COLUMBUS, OH 43223, EMAIL: CEN.ITS.LAB@DOT.OHIO.GOV

(EMAIL FOR ITS LOCATES AS WE ARE NOT A MEMBER OF OUPS)

LISTED BELOW ARE ALL UTILITIES LOCATED WITHIN THE PROJECT CONSTRUCTION LIMITS TOGETHER WITH THEIR RESPECTIVE OWNERS:

AT&T OHIO  
13630 LORAIN AVE 2ND FLOOR  
CLEVELAND OHIO 44111  
216-750-0135  
MIKE DEIDERICH  
MD4145@ATT.COM

AT&T TRANSMISSION  
155 COMMERCE PARK DR. SUITE #1  
WESTERVILLE, OHIO 43082  
770-584-7083  
CHAD HARKNESS  
CHAD.HARKNESS@MCGFIBER.COM

CENTURYLINK (LEVEL 3 COMMUNICATIONS)  
100 S. CINCINNATI AVE., SUITE 1200  
TULSA, OK. 74103  
NATIONALRELO@CENTURYLINK.COM  
KENDALL ZETINA  
KENDALL.ZETINA@CENTURYLINK.COM

CHARTER COMM  
8179 DOW CIRCLE  
STRONGSVILLE, OHIO 44136  
216-575-8016  
Gary Naumann  
GARY.NAUMANN1@CHARTER.COM

CENTURYLINK/LUMEN  
ATTN: ALAN PETERS  
3801 ELM RD WARREN, OHIO 44483  
330-841-1309  
330-219-3306 CELL  
ALAN.L.PETERS@LUMEN.COM

**UTILITIES (CONTINUED)**

FRONTIER COMM  
6223 NORWALK ROAD  
MEDINA, OHIO 44256  
330-772-9586  
RANDY HOWARD  
J.HOWARD@FTR.COM

MCI  
120 RAVINE ST  
AKRON, OHIO 44303  
330 253 8267  
DANIEL ARZ  
DANIEL.ARZ@VERIZON.COM  
ALLAN GUEST  
ALLAN.GUEST@VERIZON.COM

WINDSTREAM  
560 TARNES AVE.  
ELYRIA, OHIO 44035  
440 329-4245  
GEOFFREY HAMM  
GEOFFREY.P.HAMM@WINDSTREAM.COM  
216 385-1669  
JEFF GULYAS  
JEFF.GULYAS@WINDSTREAM.COM

CLEVELAND WATER DEPARTMENT  
1201 LAKESIDE AVE.  
CLEVELAND, OH 44114  
216-362-6370  
FRED ROBERTS, PE  
fred\_roberts@clevelandwater.com

COUNTY OF SUMMIT - DEPT OF SANITARY  
RUSSELL M. PRY BUILDING  
1180 SOUTH MAIN STREET  
SUITE 201  
AKRON, OH 44301  
330-926-2405  
MELISSA MCFADDEN  
MELISSAMCFADDEN@SUMMITOH.NET

DOMINION ENERGY  
320 SPRINGSIDE DR, SECOND FLOOR  
AKRON OHIO 44333  
330-664-2783  
**MICHAEL A. SALVATORE, S.I.T.**  
michael.a.salvatore@dominionenergy.com  
330-664-2409  
JASON ROSS  
JASON.M.ROSS@DOMINIONENERGY.COM  
RELOCATIONS@DOMINIONENERGY.COM

OHIO EDISON (FIRST ENERGY CORP) - (USIC)  
76 S MAIN ST  
AKRON, OH 44308  
MICHAEL JANSON  
JANSONM@FIRSTENERGYCORP.COM

SUNOCO PIPELINE  
8111 WESTCHESTER DRIVE  
DALLAS, TX 75225  
216-346-1561  
713-989-7079  
RAY LEPOSKY  
AGT\_COMM@IRTH.COM

THE LOCATION OF THE UNDERGROUND UTILITIES SHOWN ON THE PLANS ARE AS OBTAINED FROM THE OWNERS AS REQUIRED BY SECTION 153.64 O.R.C.

SUE LEVEL A TEST HOLE INFORMATION DATED 09-09-21 IS AVAILABLE FOR UTILITIES ALONG SR-21.

**SURVEYING PARAMETERS**

PRIMARY PROJECT CONTROL MONUMENTS GOVERN ALL POSITIONING ON ODOT PROJECTS. SEE SHEET 4 OF THE PLANS FOR A TABLE CONTAINING PROJECT CONTROL INFORMATION.

USE THE FOLLOWING PROJECT CONTROL, VERTICAL POSITIONING, AND HORIZONTAL POSITIONING PARAMETERS FOR ALL SURVEYING:

**PROJECT CONTROL**

POSITIONING METHOD: STATIC GNSS METHODS  
MONUMENT TYPE: TYPE A

VERTICAL POSITIONING  
ORTHOMETRIC HEIGHT DATUM: NAVD88  
GEOID: GEOID 18

HORIZONTAL POSITIONING  
REFERENCE FRAME: NAD83 (2011)  
ELLIPSOID: GRS80  
MAP PROJECTION: LAMBERT CONFROMAL CONIC  
COORDINATE SYSTEM: OHIO STATE PLANE, NORTH ZONE (3401)  
COMBINED SCALE FACTOR: 1.00010358070  
ORIGIN OF COORDINATE SYSTEM: (0,0)

USE THE POSITIONING METHODS AND MONUMENT TYPE USED IN THE ORIGINAL SURVEY TO RESTORE ALL MONUMENTS RELATED TO PRIMARY PROJECT CONTROL THAT ARE DAMAGED OR DESTROYED BY CONSTRUCTION ACTIVITIES. RESTORE THE DAMAGED OR DESTROYED MONUMENTS IN ACCORDANCE WITH CMS 623.

UNITS ARE IN U.S. SURVEY FEET.

**WORK LIMITS**

THE WORK LIMITS SHOWN ON THESE PLANS ARE FOR PHYSICAL CONSTRUCTION ONLY. PROVIDE THE INSTALLATION AND OPERATION OF ALL WORK ZONE TRAFFIC CONTROL AND WORK ZONE TRAFFIC CONTROL DEVICES REQUIRED BY THESE PLANS WHETHER INSIDE OR OUTSIDE THESE WORK LIMITS.

**ITEM 623, CONSTRUCTION LAYOUT STAKES AND SURVEYING, AS PER PLAN**

IN ADDITION TO THE REQUIREMENTS OF THE CMS, THIS ITEM OF WORK WILL INCLUDE THE FOLLOWING ADDITIONAL REQUIREMENTS.

AN OHIO PROFESSIONAL SURVEYOR SHALL DETERMINE THE MINIMUM VERTICAL CLEARANCES OF ALL BRIDGES WITHIN THE PROJECT LIMITS AFTER COMPLETION OF ALL WORK, BUT PRIOR TO FINAL ACCEPTANCE OF THE PROJECT. AS A MINIMUM, MEASUREMENTS SHALL BE TAKEN ALONG THE CENTERLINE OF EACH FASCIA BEAM AT THE EDGE OF SHOULDERS, EDGE LINES, LANE LINES, AND CROWN OF THE ROADWAY BELOW. THE MEASUREMENTS SHALL BE DOCUMENTED ON THE ODOT VERTICAL CLEARANCE SURVEY FORM. THE FORM SHALL BEAR THE STAMP OR SEAL OF THE OHIO PROFESSIONAL SURVEYOR WHO HAS TAKEN THE MEASUREMENTS. THE OHIO PROFESSIONAL SURVEYOR SHALL SUBMIT THE COMPLETED FORM TO THE PROJECT ENGINEER AND THE DISTRICT BRIDGE MAINTENANCE ENGINEER PRIOR TO FINAL ACCEPTANCE OF THE PROJECT.

PAYMENT FOR ALL OF THE ABOVE WORK SHALL BE AT THE UNIT PRICE BID FOR ITEM 623, CONSTRUCTION LAYOUT STAKES AND SURVEYING, AS PER PLAN, WHICH SHALL INCLUDE ALL LABOR, EQUIPMENT, MATERIALS AND INCIDENTALS NECESSARY TO COMPLETE THE WORK ABOVE.

**PROTECTION OF RIGHT-OF-WAY LANDSCAPING**

PRIOR TO BEGINNING WORK, THE CONTRACTOR, THE PROJECT ENGINEER, AND A REPRESENTATIVE OF THE MAINTAINING AGENCY WILL REVIEW AND RECORD ALL LANDSCAPING ITEMS WITHIN THE RIGHT-OF-WAY (BOTH WITHIN AND OUTSIDE THE CONSTRUCTION LIMITS). A RECORD OF THIS REVIEW WILL BE KEPT IN THE PROJECT ENGINEER'S FILES. PRIOR TO FINAL ACCEPTANCE, A FINAL REVIEW OF LANDSCAPING ITEMS WILL BE MADE.

CONSTRUCT ALL ACTIVITIES, EQUIPMENT STORAGE, AND STAGING TO WITHIN THE CONSTRUCTION LIMITS. UNLESS OTHERWISE IDENTIFIED IN THE PLANS OR PROPOSAL, THE CONSTRUCTION LIMITS ARE IDENTIFIED AS 30 FEET FROM THE EDGE OF PAVEMENT.

SUBMIT A WRITTEN REQUEST TO THE PROJECT ENGINEER TO USE ANY AREA OUTSIDE THESE LIMITS. THE DOCUMENT SUBMITTED MUST CLEARLY IDENTIFY THE AREA AND EXPLAIN THE PROPOSED USE AND RESTORATION OF THE AREA. USE OF THESE AREAS FOR DISPOSAL OF WASTE MATERIAL AND CONSTRUCTION DEBRIS, EXCAVATION OF BORROW MATERIAL AND PLACEMENT OF PORTABLE PLANTS IS PROHIBITED. THE REQUEST MUST BE APPROVED, IN WRITING, BEFORE THE CONTRACTOR HAS PERMISSION TO USE THE AREA.

ANY ITEMS DAMAGED BEYOND THE CONSTRUCTION LIMITS, AS DEFINED ABOVE, WILL BE REPLACED IN KIND OR AS APPROVED BY THE PROJECT ENGINEER.

**CLEARING AND GRUBBING**

ALTHOUGH THERE ARE NO TREES OR STUMPS SPECIFICALLY MARKED FOR REMOVAL WITHIN THE LIMITS OF THE PROJECT, A LUMP SUM QUANTITY IS INCLUDED IN THE GENERAL SUMMARY FOR ITEM 201, CLEARING AND GRUBBING. ALL PROVISIONS AS SET FORTH IN THE SPECIFICATIONS UNDER THIS ITEM ARE INCLUDED IN THE LUMP SUM PRICE BID FOR ITEM 201, CLEARING AND GRUBBING.



**ITEM 204 - PROOF ROLLING**

THE FOLLOWING QUANTITY IS PROVIDED IN THE GENERAL SUMMARY TO ADDRESS LOCATIONS REQUIRING PROOF ROLLING.

ITEM 204 - PROOF ROLLING 34 HOUR.

**ITEM 441 - ANTI-SEGREGATION EQUIPMENT**

THE FOLLOWING QUANTITY IS PROVIDED IN THE GENERAL SUMMARY TO PAY ITEM ANTI-SEGREGATION EQUIPMENT.

ITEM 441 - ANTI-SEGREGATION EQUIPMENT 3443 CY.

**HIGH SULFATE SOILS**

THE FOLLOWING ITEMS AND QUANTITIES ARE TO BE USED AS DIRECTED BY THE ENGINEER TO ADDRESS HIGH SULFATE CONCENTRATED SOILS FOUND IN THE AREAS OF PAVEMENT CONSTRUCTION, TO ADDRESS AREAS THAT FAIL PROOF ROLL AFTER THE CHEMICAL STABILIZATION OR REQUIRE ATTENTION BEFORE CHEMICAL STABILIZATION CAN BE PERFORMED:

- ITEM 204 - EXCAVATION OF SUBGRADE, 3230 CY;
- ITEM 204 - GRANULAR MATERIAL, TYPE B, 3230 CY;
- ITEM 204 - GEOTEXTILE FABRIC, 9689 SY;

**CROSSINGS AND CONNECTIONS TO EXISTING PIPES AND UTILITIES**

WHERE PLANS PROVIDE FOR A PROPOSED CONDUIT TO BE CONNECTED TO, OR CROSS OVER OR UNDER AN EXISTING SEWER OR UNDERGROUND UTILITY, THE CONTRACTOR SHALL LOCATE THE EXISTING PIPES OR UTILITIES BOTH AS TO LINE AND GRADE BEFORE STARTING TO LAY THE PROPOSED CONDUIT.

IF IT IS DETERMINED THAT THE ELEVATION OF THE EXISTING CONDUIT, OR EXISTING APPURTENANCE TO BE CONNECTED, DIFFERS FROM THE PLAN ELEVATION OR RESULTS IN A CHANGE IN THE PLAN CONDUIT SLOPE, NOTIFY THE ENGINEER BEFORE STARTING CONSTRUCTION OF ANY PORTION OF THE PROPOSED CONDUIT WHICH WILL BE AFFECTED BY THE VARIANCE IN THE EXISTING ELEVATIONS.

IF IT IS DETERMINED THAT THE PROPOSED CONDUIT WILL INTERSECT AN EXISTING SEWER OR UNDERGROUND UTILITY IF CONSTRUCTED AS SHOWN ON THE PLAN, NOTIFY THE ENGINEER BEFORE STARTING CONSTRUCTION OF ANY PORTION OF THE PROPOSED CONDUIT WHICH WOULD BE AFFECTED BY THE INTERFERENCE WITH AN EXISTING FACILITY.

PAYMENT FOR ALL THE OPERATIONS DESCRIBED ABOVE IS INCLUDED IN THE CONTRACT PRICE FOR THE PERTINENT 611 CONDUIT ITEM.

**ITEM 422 - ASPHALT CONCRETE SURFACE COURSE, 12.5mm, TYPE A (447), AS PER PLAN**

THE REQUIREMENTS OF 442 AND 446 WILL APPLY; DEVIATIONS FROM THESE ARE AS FOLLOWS:

THE PERCENTAGE OF RECLAIMED MATERIAL PROPOSED FOR USE WILL BE INCLUDED IN THE MIX DESIGN PROCESS TO ESTABLISH THE JOB MIX FORMULA (JMF) IN ACCORDANCE WITH 401.04.

MATERIALS: THE MATERIALS WILL BE:  
AGGREGATES 703.05\*

\*THE VIRGIN COARSE AGGREGATE PORTION OF THE MIXTURE WILL CONTAIN 50% AIR COOLED BLAST FURNACE SLAG (ACBFS) AND MEET THE REQUIREMENTS OF 703.05.

USE AN NDES OF 50, AN NMAX OF 75 AND THE COMBINATION OF NEW AGGREGATES, NEW ASPHALT BINDER, AND RECLAIMED MATERIAL SHALL BE AS REQUIRED TO PRODUCE A COMPOSITION CONTAINING A MINIMUM OF 6.0% NEW ASPHALT BINDER RESULTING IN A MINIMUM TOTAL BINDER OF 6.5%.

703.05 DO NOT USE ANY FINE OR COARSE AGGREGATE WITH A 'SR' OR 'SRH' DESIGNATION ACCORDING TO THE OFFICE OF MATERIALS MANAGEMENT (OMM) IN ANY JOB MIX FORMULA (JMF) FOR THIS ITEM.

THE CONTRACTOR SHALL USE THE APPROPRIATE COUNTY, ROUTE AND SECTION TO OBTAIN TRAFFIC DATA, TO BE USED IN THE DESIGN OF THE JMF, AT THIS WEB SITE LOCATION:  
<http://www.odotonline.org/techservapps/traffmonit/countinformation/default.htm>

THIS ITEM IS FOR ROADS WITH GREATER THAN 1500 TRUCKS IN THE OPENING DAY TRAFFIC. THE 12.5MM MIX IS DESIGNED FOR MAXIMUM RUT RESISTANCE AT 1.5 INCHES (38 MM) THICK. THE SURFACE COURSE IS GENERALLY THE MOST EXPENSIVE LAYER AND AN INCREASED THICKNESS MAY NOT BE ECONOMICAL. IN SPECIAL SITUATIONS WHERE AN INTERMEDIATE COURSE IS NOT POSSIBLE, THE 12.5MM MIX MAY BE SPECIFIED UP TO A MAXIMUM OF 2.5 INCHES (65 MM). A 12.5MM MIX CANNOT BE PLACED PROPERLY AT A THICKNESS LESS THAN 1.5 INCHES (38 MM); DURABILITY AND CONSTRUCTABILITY PROBLEMS WILL RESULT. BEST PRACTICE IS TO USE 1.5 INCHES (38 MM). IF 446 OR 447 ACCEPTANCE IS SPECIFIED A UNIFORM THICKNESS IS REQUIRED.

**ITEM 254 - PAVEMENT PLANING, ASPHALT CONCRETE, AS PER PLAN**

THIS ITEM OF WORK SHALL BE PERFORMED IN CONFORMANCE WITH ITEM 254 IN THE CMS EXCEPT THE DEPTH SHALL VARY FROM 2". THIS WORK SHALL BE PERFORMED ON THE APPROACH SLAB LOCATED ALONG SR-21. ALL EQUIPMENT, LABOR, TOOLS, AND OTHER INCIDENTALS REQUIRED TO PERFORM THIS WORK SHALL BE INCLUDED IN THE UNIT BID PRICE FOR ITEM 254 PAVEMENT PLANING, ASPHALT CONCRETE, AS PER PLAN.

**ITEM 441 - ASPHALT CONCRETE SURFACE COURSE, TYPE 1, (446), PG64-22, AS PER PLAN**

703.05 DO NOT USE COARSE AGGREGATE FROM A SOURCE DESIGNATED 'SR' OR 'SRH' ACCORDING TO THE OFFICE OF MATERIALS MANAGEMENT (OMM) IN ANY JOB MIX FORMULA (JMF) FOR THIS ITEM.

**DRAINAGE DISCHARGE CONTINUANCE**

FURNISH A DRAINAGE DISCHARGE CONTINUANCE FOR ANY DRAINAGE DISCHARGE DISTURBED BY THE WORK AND NOT SHOWN IN THE PLANS. THE LOCATION, TYPE (CONDUIT OR SWALE), SIZE AND GRADE OF THE DRAINAGE DISCHARGE CONTINUANCE WILL BE AGREED TO BY THE ENGINEER

FURNISH AN INSPECTION WELL AT THE RIGHT OF WAY LINE PER SCD DM-3.1. FOR EACH DRAINAGE DISCHARGE THAT OUTLETS THROUGH A CURB OPENING, OR INTO A STORM SEWER OR DRAINAGE STRUCTURE. THE COST IS INCLUDED IN ITEM 611, INSPECTION WELL.

FURNISH A WELL GRADED TRANSITION BETWEEN THE DITCH AND THE SWALE WHEN OUTLETTING A SWALE TO A DITCH. THE COST FOR THE GRADED TRANSITION IS INCLUDED IN ITEM 203, EMBANKMENT AS PER PLAN.

FURNISH AN EROSION CONTROL PAD AS SHOWN IN SCD DM-1.1 WHEN OUTLETTING A CONDUIT TO A DITCH. THE COST FOR THE EROSION CONTROL PAD IS INCLUDED IN ITEM 611, CONDUIT, MISC: TYPE X FOR DRAINAGE DISCHARGE CONTINUANCE.

FURNISH A DRILLED CORE HOLE WHEN OUTLETTING INTO A STORM SEWER OR DRAINAGE STRUCTURE. THE COST OF THE DRILLED CORE HOLE IS INCLUDED IN ITEM 611, CONDUIT, MISC.: TYPE X FOR DRAINAGE DISCHARGE CONTINUANCE.

**DOCUMENTATION**  
PROVIDE WRITTEN DOCUMENTATION TO THE ENGINEER AND TO THE DISTRICT R/W PERMIT OFFICE. THE DOCUMENTATION INCLUDES THE CONSTRUCTION PROJECT NUMBER, PID, COUNTY, ROUTE, SECTION, LATITUDE AND LONGITUDE OF THE DRAINAGE DISCHARGE AT THE R/W, THE NAME OF PROPERTY OWNER WITH ADDRESS, THE DATE THE DRAINAGE DISCHARGE WAS LOCATED, THE DATE THE DRAINAGE DISCHARGE CONTINUANCE WAS FURNISHED, A DETAILED DESCRIPTION OF THE WORK AND PICTURES OF THE DRAINAGE DISCHARGE CONTINUANCE (IN PDF OR JPEG FORMAT). THE DOCUMENTATION IS INCLUDED IN ITEM 611, CONDUIT, MISC.: TYPE X FOR DRAINAGE DISCHARGE CONTINUANCE OR ITEM 203, EMBANKMENT AS PER PLAN.

**DRAINAGE DISCHARGE CONTINUANCE REMOVAL**  
THE ENGINEER MAY REQUIRE THE NEWLY INSTALLED DRAINAGE DISCHARGE CONTINUANCE TO BE REMOVED.

REMOVE THE NEWLY INSTALLED CONDUIT AND ANY EXISTING CONDUIT TO THE RIGHT OF WAY LINE. FOR CONDUIT THAT OUTLETS TO A STORM SEWER OR DRAINAGE STRUCTURE LEAVE 6 INCHES PROTRUDING OUTSIDE OF THE CONDUIT. PLUG THE PROTRUDING CONDUIT WITH EITHER A MANUFACTURED CAP OR CLASS QC 1 CONCRETE. FOR CONDUIT THAT OUTLETS TO THE DITCH REMOVE THE EROSION CONTROL PAD. RESTORE ALL AREAS AS REQUIRED. PLUG THE EXISTING CONDUIT REGARDLESS OF SIZE AT THE RIGHT OF WAY LINE WITH CLASS QC 1 CONCRETE AND RESTORE ALL AREAS AS REQUIRED. ALL COSTS ARE INCLUDED IN ITEM 202, REMOVAL MISC. CONDUIT.

DAM THE SWALE THAT OUTLETS TO THE DITCH AT THE R/W AS DIRECTED BY THE ENGINEER. ALL COSTS ARE INCLUDED IN ITEM 203, EMBANKMENT AS PER PLAN.

**DRAINAGE DISCHARGE CONTINUANCE REMOVAL (CONTINUED)**

REMOVE THE INSPECTION WELL AND RESTORE ALL AREAS AS REQUIRED. THE COST IS INCLUDED IN ITEM 202, REMOVAL MISC. INSPECTION WELL.

CONDUIT MATERIAL TYPES  
THE FOLLOWING CONDUIT MATERIAL TYPES MAY BE USED:  
707.33, 707.41 NON-PERFORATED, 707.42, 707.43, 707.45, 707.46, 707.47, AND 707.51 SDR35.

**PAY ITEMS**  
EACH OF THE PAY ITEMS LISTED BELOW FOR CONDUIT MISCELLANEOUS TYPES B, C, E AND F FOR DRAINAGE DISCHARGE CONTINUANCE INCLUDE CONDUIT SIZES 2 INCH TO 10 INCH. THERE IS NO COST DIFFERENTIATION FOR SIZE IN THESE PAY ITEMS.

THE FOLLOWING ESTIMATED QUANTITIES HAVE BEEN INCLUDED IN THE GENERAL SUMMARY FOR USE AS DIRECTED BY THE ENGINEER IN MAKING THE ABOVE DRAINAGE DISCHARGE CONTINUANCE:

- ITEM 611, 2 EACH INSPECTION WELL
- ITEM 611, 100 FT. CONDUIT, MISC TYPE B FOR DRAINAGE DISCHARGE CONTINUANCE
- ITEM 611, 100 FT. CONDUIT, MISC TYPE C FOR DRAINAGE DISCHARGE CONTINUANCE
- ITEM 611, 100 FT. CONDUIT, MISC TYPE E FOR DRAINAGE DISCHARGE CONTINUANCE
- ITEM 611, 100 FT. CONDUIT, MISC TYPE F FOR DRAINAGE DISCHARGE CONTINUANCE
- ITEM 202, 200 FT. REMOVAL MISC CONDUIT
- ITEM 202, 2 EACH REMOVAL MISC INSPECTION WELL
- ITEM 203, 25 CUBIC YARD EMBANKMENT AS PER PLAN

**ITEM 611 - CONDUIT BORED OR JACKED**

WHERE IT IS SPECIFIED THAT A CONDUIT BE INSTALLED BY THE METHOD OF BORING OR JACKING, NO TRENCH EXCAVATION SHALL BE CLOSER THAN 30 FEET TO THE (EDGE OF PAVEMENT) PROVIDE A STEEL CASING PIPE CONFORMING TO 748.06. JOINTS WITH A CIRCUMFERENTIAL FULLY PENETRATING B-U4B WELD THAT IS PERFORMED BY AN ODOT APPROVED FIELD WELDER OR MACHINED INTERLOCKING JOINTS ARE PERMITTED. THE INSTALLED CASING PIPE IS THE STORM WATER CONVEYANCE CARRIER UNLESS OTHERWISE SPECIFIED IN THE PLANS. HYDROSTATIC TESTING IS NOT REQUIRED FOR THE CASING PIPE.



DESIGNER	TQD
REVIEWER	DRJ 05/03/22
PROJECT ID	104983 (PRT 2)
SHEET	TOTAL
15	312

**REVIEW OF DRAINAGE FACILITIES**

PRIOR TO THE START OF WORK AND AGAIN BEFORE FINAL ACCEPTANCE, PERFORM AN INSPECTION WITH REPRESENTATIVES OF THE DEPARTMENT, CONTRACTOR AND LOCALS OF ALL EXISTING DRAINAGE FACILITIES THAT ARE TO REMAIN IN SERVICE WHICH MAY BE AFFECTED BY THE WORK. THE CONDITION OF THE EXISTING CONDUITS AND THEIR APPURTENANCES IS DETERMINED FROM FIELD OBSERVATIONS. RECORDS OF THE INSPECTION ARE MAINTAINED BY THE DEPARTMENT.

CONFIRM ALL EXISTING SEWERS INSPECTED INITIALLY BY THE ABOVE-MENTIONED PARTIES ARE MAINTAINED AND LEFT IN A CONDITION COMPARABLE TO THAT DETERMINED BY THE ORIGINAL INSPECTION. THE CONTRACTOR IS RESPONSIBLE TO CORRECT ANY CHANGE IN THE CONDITION RESULTING FROM THEIR OPERATIONS AS DIRECTED AND APPROVED BY THE ENGINEER.

PAYMENT FOR ALL OPERATIONS DESCRIBED ABOVE IS INCLUDED IN THE CONTRACT PRICE FOR THE PERTINENT 611 CONDUIT ITEMS.

**EXISTING SUBSURFACE DRAINAGE**

PROVIDE UNOBSTRUCTED OUTLETS FOR ALL EXISTING UNDERDRAINS OR AGGREGATE DRAINS ENCOUNTERED DURING CONSTRUCTION.

PROVIDE AN OUTLET PER STANDARD CONSTRUCTION DRAWING DM-1.1 FOR ALL UNDERDRAINS THAT OUTLET TO A SLOPE. UNDERDRAINS THAT CAN BE CONNECTED TO THE NEW OR EXISTING UNDERDRAINS AT THE END OF THE PROJECT LIMITS AS WELL AS ALL NECESSARY BENDS OR BRANCHES REQUIRED FOR CONNECTION ARE INCLUDED IN THE BASIS OF PAYMENT FOR UNCLASSIFIED PIPE UNDERDRAINS.

THE FOLLOWING ESTIMATED QUANTITIES HAVE BEEN INCLUDED IN THE GENERAL SUMMARY FOR THE WORK NOTED ABOVE:

ITEM 601, TIED CONCRETE BLOCK MAT WITH TYPE 1 UNDERLAYMENT 10 SQ. YD.

ITEM 611, 6 " CONDUIT TYPE F FOR UNDERDRAIN OUTLETS 100 FT.  
ITEM 611, PRECAST REINFORCED CONCRETE OUTLET 2 EACH  
ITEM 605, 6 " UNCLASSIFIED PIPE UNDERDRAINS WITH GEOTEXTILE FABRIC 100 FT.

**ITEM 202 - ABANDON MISC.: ABANDON PIPE IN PLACE**

THIS ITEM SHALL CONSIST OF CONSTRUCTING A BULKHEAD AT THE UPSTREAM END AND ABANDONING THE REMAINING PIPE IN PLACE. ALL EQUIPMENT, LABOR, TOOLS, AND OTHER INCIDENTALS REQUIRED TO PERFORM THIS WORK SHALL BE INCLUDED IN THE UNIT BID PRICE FOR THIS ITEM.

**SEEDING AND MULCHING**

THE FOLLOWING QUANTITIES ARE PROVIDED TO PROMOTE GROWTH AND CARE OF PERMANENT SEEDED AREAS:

ITEM 659, SOIL ANALYSIS TEST 2 EACH  
ITEM 659, TOPSOIL 3689 CU. YD.  
ITEM 659, SEEDING AND MULCHING 33275 SQ. YD.  
ITEM 659, REPAIR SEEDING AND MULCHING 1661 SQ. YD.  
ITEM 659, INTER-SEEDING 1661 SQ. YD.  
ITEM 659, COMMERCIAL FERTILIZER 10 TON  
ITEM 659, LIME 7 ACRES  
ITEM 659, WATER 270 M. GAL.  
ITEM 659, MOWING 75 M. SQ.FT.

SEEDING AND MULCHING SHALL BE APPLIED TO ALL AREAS OF EXPOSED SOIL BETWEEN THE RIGHT-OF-WAY LINES, AND WITHIN THE CONSTRUCTION LIMITS FOR AREAS OUTSIDE THE RIGHT-OF-WAY LINES COVERED BY WORK AGREEMENT OR SLOPE EASEMENT.

QUANTITY CALCULATIONS FOR SEEDING AND MULCHING ARE BASED ON LIMITS IDENTIFIED AS NECESSARY IN THE CROSS-SECTIONS. ANY ADDITIONAL AREAS OUTSIDE OF THE AREAS IDENTIFIED IN THE CROSS-SECTIONS THAT ARE DISTURBED BY THE CONTRACTOR TO FACILITATE CONSTRUCTION MUST BE RESTORED IN ACCORDANCE WITH C&MS 107.10 AND CONSIDERED INCIDENTAL TO THE WORK. NO ADDITIONAL COMPENSATION WILL BE MADE FOR THESE AREAS

**PART-WIDTH CONSTRUCTION**

BECAUSE OF THE NECESSITY TO BUILD THIS PROJECT UNDER TRAFFIC AND TO CONSTRUCT THE FULL PAVEMENT WIDTH IN STAGES, EXERCISE CARE TO PREVENT THE CONSTRUCTION OF A BUTT JOINT IN THE BASE COURSES. LAP LONGITUDINAL JOINTS AS SHOWN ON STANDARD CONSTRUCTION DRAWING BP-3.1.

**CONNECTION BETWEEN EXISTING AND PROPOSED GUARDRAIL**

WHEN IT IS NECESSARY TO SPLICE PROPOSED GUARDRAIL TO EXISTING GUARDRAIL, ONLY THE EXISTING GUARDRAIL SHALL BE CUT, DRILLED, OR PUNCHED. THE CONNECTION SHALL BE MADE USING A W-BEAM, BEAM SPLICE AS SHOWN IN AASHTO M 180-12, EXCEPT THE BEAM WASHERS ARE NOT TO BE USED. PAYMENT SHALL BE INCLUDED IN THE CONTRACT PRICE FOR THE RESPECTIVE GUARDRAIL ITEMS.

**ASPHALT CONCRETE BASE, PG 64-22 (449), AS PER PLAN**

IN ADDITION TO THE REQUIREMENTS OF ITEM 304, FOR THE PLACEMENT OF 302 ASPHALT BASE, USE ANTI-SEGREGATION EQUIPMENT CONFORMING TO THE REQUIREMENTS OF 401.03.C EXCLUDING THE USE OF REMIXING PAVERS.

**ITEM 606 - ANCHOR ASSEMBLY, MGS TYPE E MASH 2016**

THIS ITEM SHALL CONSIST OF FURNISHING AND INSTALLING ANY OF THE GUARDRAIL END TERMINALS FOR TYPE MGS GUARDRAIL AS LISTED ON ROADWAY ENGINEERING'S WEB PAGE UNDER ROADSIDE SAFETY DEVICES FOR APPROVED GUARDRAIL END TREATMENTS. INSTALLATION SHALL BE AT THE LOCATIONS SPECIFIED IN THE PLANS, IN ACCORDANCE WITH THE MANUFACTURER'S SPECIFICATIONS.

THE FACE OF THE TYPE E IMPACT HEAD SHALL BE COVERED WITH A SHEET OF TYPE G REFLECTIVE SHEETING, PER CMS 730.19.

REFER TO THE MANUFACTURER'S INSTRUCTIONS REGARDING THE INSTALLATION OF, AND THE GRADING AROUND THE FOUNDATION TUBES AND GROUND STRUT. THE TOP OF ANY FOUNDATION TUBE SHOULD BE LESS THAN 4 INCHES ABOVE THE GROUND. THE PLACEMENT OF THE FOUNDATION TUBES SHOULD BE AN APPROPRIATE DEPTH BELOW THE LEVEL LINE IN ORDER TO MAINTAIN THE FINISHED GUARDRAIL HEIGHT OF 31 INCHES FROM THE EDGE OF THE SHOULDER.

ON-SITE GRADING IS REQUIRED IF THE TOP OF THE FOUNDATION TUBES OR TOP OF THE GROUND STRUT DOES PROJECT MORE THAN 4 INCHES ABOVE THE GROUND LINE.

PAYMENT FOR THE ABOVE WORK SHALL BE MADE AT THE UNIT PRICE BID FOR ITEM 606, ANCHOR ASSEMBLY, MGS TYPE E MASH 2016 EACH, AND SHALL INCLUDE ALL LABOR, TOOLS, EQUIPMENT AND MATERIALS NECESSARY TO CONSTRUCT A COMPLETE AND FUNCTIONAL ANCHOR ASSEMBLY SYSTEM, INCLUDING ALL RELATED TRANSITIONS, REFLECTIVE SHEETING, HARDWARE, GRADING, EMBANKMENT AND EXCAVATION NOT SEPARATELY SPECIFIED, AS REQUIRED BY THE MANUFACTURER.

**PAVING UNDER GUARDRAIL**

THIS OPERATION SHALL INCLUDE PREPARATION OF THE GRADED SHOULDER USING ITEM 209, LINEAR GRADING, AS PER PLAN AND PAVING UNDER THE GUARDRAIL USING 441 ASPHALT CONCRETE INTERMEDIATE COURSE, TYPE 1, (449), UNDER GUARDRAIL, AS PER PLAN.

ITEM 209, LINEAR GRADING, AS PER PLAN SHALL CONSIST OF EXCAVATING TOPSOIL, AND PLACING GRANULAR MATERIAL.

ALL COLLECTED DEBRIS AND TOPSOIL, INCLUDING RHIZOMES, ROOTS AND OTHER VEGETATIVE PLANT MATERIAL SHALL BE REMOVED AND DISPOSED OF AS SPECIFIED IN 105.17.

THE REMOVED MATERIAL SHALL BE REPLACED WITH COMPACTIBLE GRANULAR MATERIAL CONFORMING TO 703.16 PLACED TO GRADE AS DETAILED ON THE TYPICAL SECTION OR AS APPROVED BY THE ENGINEER.

ALL EQUIPMENT, MATERIALS AND LABOR REQUIRED TO PERFORM THE WORK OUTLINED ABOVE SHALL BE INCLUDED FOR PAYMENT UNDER ITEM 209, LINEAR GRADING, AS PER PLAN.

PAVING UNDER GUARDRAIL SHALL CONSIST OF PLACING ITEM 441 TO THE DEPTH SPECIFIED USING ONE OF THE FOLLOWING METHODS:

METHOD A:

1. SET GUARDRAIL POSTS
2. PLACE ITEM 441

METHOD B:

1. PLACE ITEM 441
2. BORE ASPHALT AT POST LOCATIONS (MAY BE OMITTED IF STEEL POSTS ARE USED)
3. SET GUARDRAIL POSTS
4. PATCH AROUND POSTS. THE MATERIALS USED FOR PATCHING SHALL BE AN ASPHALT CONCRETE APPROVED BY THE ENGINEER. PATCHED AREAS SHALL BE COMPACTED USING EITHER HAND OR MECHANICAL METHODS. FINISHED SURFACES SHALL BE SMOOTH AND SLOPED TO DRAIN AWAY FROM THE POSTS.

ALL EQUIPMENT, MATERIALS AND LABOR REQUIRED TO PERFORM THE WORK OUTLINED ABOVE, WITH THE EXCEPTION OF SETTING GUARDRAIL POSTS, SHALL BE INCLUDED FOR PAYMENT UNDER ITEM 441, ASPHALT CONCRETE, INTERMEDIATE COURSE, TYPE 1 (448), UNDER GUARDRAIL, AS PER PLAN.

**ITEM 619 - FIELD OFFICE, TYPE C, AS PER PLAN**

IN ADDITION TO THE REQUIREMENT OF CMS 619, THE CONTRACTOR SHALL FURNISH AND SET UP A WI-FI ROUTER MEETING THE REQUIREMENTS OF IEEE 802.11AC AND PROVIDE INTERNET SERVICE WITH A MINIMUM DOWNLOAD SPEED OF 100 MBS AND MINIMUM UPLOAD SPEED OF 10 MBS FOR EXCLUSIVE USE OF THE DEPARTMENT.

ALL OTHER FIELD OFFICE ITEMS SUPPLIED SHALL MEET THE REQUIREMENTS OF A TYPE C OFFICE.

ITEM 619-FIELD OFFICE, TYPE C, AS PER PLAN 20 MONTHS.

**ITEM 606 - CABLE GUARDRAIL**

THIS ITEM SHALL CONSIST OF FURNISHING AND INSTALLING ANY ONE OF THE HIGH TENSION FOUR CABLE GUARDRAIL SYSTEMS AS LISTED ON THE OFFICE OF ROADWAY ENGINEERING'S WEB PAGE. PAYMENT FOR THE ABOVE WORK SHALL BE MADE AT THE UNIT PRICE BID FOR ITEM 606, CABLE BARRIER WITH CONCRETE LINE POST FOUNDATION, AND ITEM 606 CABLE BARRIER, ANCHOR ASSEMBLY AND SHALL INCLUDE ALL LABOR, TOOLS, EQUIPMENT AND MATERIALS NECESSARY TO CONSTRUCT A COMPLETE AND FUNCTIONAL HIGH TENSION CABLE GUARDRAIL SYSTEM NOT SEPARATELY SPECIFIED, AS REQUIRED BY THE MANUFACTURER. THE LENGTH OF THE TENSIONED CABLE NECESSARY TO INSTALL A FUNCTIONAL ANCHOR SYSTEM SHALL BE INCLUDED IN ITEM 606, CABLE BARRIER WITH CONCRETE LINE POST FOUNDATION.

INSTALLATION SHALL BE AT THE LOCATIONS SPECIFIED IN THE PLANS, IN ACCORDANCE WITH THE MANUFACTURER'S SPECIFICATIONS.

SYSTEMS SHALL HAVE A MAXIMUM DEFLECTION OF 8 FEET AND THE MAXIMUM LONGITUDINAL DISTANCE BETWEEN POSTS SHALL BE 15 FEET.

INSTALLATION WILL BE A FOUR CABLE HIGH TENSION SYSTEM INSTALLED IN SOCKETED POSTS FOUNDATION WITH A FOUR FOOT WIDE "NO MOW STRIP".

DELINEATE THE CABLE BARRIER USING TYPE 6 BARRIER REFLECTORS PER ITEM 626 OR USING FLEXIBLE POSTS PER ITEM 620 AS CALLED FOR IN THE PLANS OR DIRECTED BY THE ENGINEER.

ANCHOR TERMINAL STRUTS SHALL BE COVERED COMPLETELY ON BOTH SIDES WITH YELLOW TYPE J, ASTM D 4956 TYPE XI REFLECTIVE SHEETING, PER CMS 730.193.

TRANSITIONS TO W-BEAM GUARDRAIL ARE NOT ALLOWED.

REFER TO MANUFACTURER FOR MAXIMUM OFFSET FROM BREAK POINT.

TORPEDO OR BULLET SPLICES ARE NOT ALLOWED. ALL CABLE SPLICES SHALL BE A SWAGED OR OPEN BODY DESIGN THAT ALLOWS FOR ANNUAL INSPECTION BETWEEN THE WEDGE AND STRANDS OF CABLE.

POSTS ARE SET IN SOCKETED CONCRETE FOUNDATIONS AND SHALL NOT BE PERMANENTLY INSTALLED UNTIL THEIR RESPECTIVE RUNS OF TENSIONED CABLE GUARDRAIL ARE READY FOR FINAL CONNECTION TO THE END TERMINAL ASSEMBLY. THE CONTRACTOR SHALL REPLACE ANY POSTS DAMAGED DURING INSTALLATION AS DETERMINED BY THE ENGINEER AT NO ADDITIONAL COST TO THE STATE.

**POST CONSTRUCTION STORM WATER TREATMENT**

THIS PLAN UTILIZES STRUCTURAL BEST MANAGEMENT PRACTICES (BMP'S) FOR POST CONSTRUCTION STORM WATER TREATMENT.

**VEGETATED FILTER STRIP**

THIS PLAN UTILIZES VEGETATED FILTER STRIP(S) FOR POST CONSTRUCTION STORM WATER TREATMENT. PLACE EITHER ITEM 660 SODDING OR ITEM 659 SEEDING AND MULCHING WITH A 4-INCH LIFT OF TOPSOIL AND ITEM 670, SLOPE EROSION PROTECTION TO ALL DISTURBED AREAS DESIGNATED AS VEGETATED FILTER STRIPS, THE EDGE OF SHOULDER, AND THE FORESLOPE AS SPECIFIED IN THE PLANS.

**REMOVAL MISC.: CONCRETE PAD**

REMOVE EXISTING CONCRETE PADS NOTED ON PLANS. BACKFILL THE CAVITY CREATED BY THE REMOVAL ITEM ACCORDING TO CMS 202.02. PROPERLY DISPOSE OF THE MATERIAL OFF THE PROJECT SITE.

THE COST OF CONCRETE PAD AND DISPOSAL WILL BE PAID AT THE UNIT PRICE BID PER SQUARD YARD.



**ITEM SPECIAL - FILL AND PLUG EXISTING CONDUIT**

THIS ITEM CONSISTS OF THE CONSTRUCTION OF BULKHEADS IN AN EXISTING LESS THAN 24" IN DIAMETER CONDUIT AND FILLING THE AREA SEALED OFF WITH ITEM 613, SAND OR OTHER MATERIAL APPROVED BY THE ENGINEER.

LOCATE THE BULKHEADS AT THE LIMITS OF THE AREA TO BE FILLED, AS INDICATED ON THE PLANS. THE BULKHEADS CONSIST OF BRICK OR CONCRETE MASONRY WITH A MINIMUM THICKNESS OF 12 INCHES. PUMP THE FILL MATERIAL INTO PLACE OR BY OTHER MEANS APPROVED BY THE ENGINEER, SO THAT AFTER SETTLEMENT, AT LEAST 90 PERCENT OF THE CROSSECTIONAL AREA OF THE CONDUIT, FOR ITS ENTIRE LENGTH IS FILLED. THE LENGTH OF FILLED AND PLUGGED CONDUIT TO BE PAID FOR IS THE ACTUAL NUMBER OF FEET (MEASURED ALONG THE CENTERLINE OF EACH CONDUIT FROM OUTER FACE TO OUTER FACE OF BULKHEADS) FILLED AND PLUGGED AS DESCRIBED ABOVE.

IN LIEU OF FILLING AND PLUGGING THE EXISTING CONDUIT, THE PIPE MAY BE CRUSHED AND BACKFILLED PER 203, OR IT MAY BE REMOVED. THE LENGTH, MEASURED AS PROVIDED ABOVE, WILL BE PAID FOR AT THE CONTRACT PRICE PER FOOT FOR, ITEM SPECIAL, FILL AND PLUG EXISTING CONDUIT.

**REMOVAL MISC.: EXISTING ODOT ITS HIGHWAY ADVISORY RADIO**

REMOVE EXISTING ODOT ITS HIGHWAY ADVISORY RADIO ON WOOD POLE FROM THE FOLLOWING LOCATIONS: STATION 1026+79.34 RT AND 1028+39.68 RT. UNDERGROUND CABLE AND PULL BOXES IS TO BE ABANDONED IN PLACE. SERVICE NEEDS TO BE DISCONNECTED TO HIGHWAY ADVISORY RADIO. THE POWER SERVICE ARE TO BE MAINTAINED FOR FUTURE USE. PROPERLY DISPOSE OF THE ADVISORY RADIO OFF THE PROJECT SITE.

THE COST OF ITS HIGHWAY ADVISORY RADIO REMOVAL AND DISPOSAL WILL BE PAID AT THE UNIT BID PER EACH.

**ROUNDING**

THE ROUNDING AT SLOPE BREAKPOINTS SHOWN ON THE TYPICAL SECTIONS APPLIES TO ALL CROSSECTIONS, EVEN THOUGH OTHERWISE SHOWN.

**ITEM SPECIAL - MISC.: RECORD DRAWINGS**

THE FOLLOWING SHALL APPLY AND BE PAID FOR UNDER THIS PAY ITEM.

CONTRACTOR SHALL MAINTAIN AND PROVIDE ODOT WITH RECORD DRAWINGS AS SPECIFIED HEREIN. RECORD DRAWINGS SHALL INCLUDE COMPLETE DOCUMENTATION OF FIELD REVISIONS TO THE CONTRACT DOCUMENTS.

**FILING**

1. THE CONTRACTOR SHALL MAINTAIN IN HIS FIELD OFFICE IN A CLEAN, DRY, LEGIBLE CONDITION THE FOLLOWING: CONTACT DRAWINGS, SPECIFICATIONS, ADDENDA, CONFORMING SHOP DRAWINGS, CHANGE ORDERS, OTHER MODIFICATIONS TO THE CONTRACT, TEST RECORDS, SURVEY DATA AND ALL OTHER DOCUMENTS PERTINENT TO THE CONTRACTOR'S WORK.
2. THE CONTRACTOR SHALL PROVIDE FILES AND RACKS FOR PROPER STORAGE AND EASY ACCESS. FILING SHALL BE ESTABLISHED IN A FORMAT ACCEPTABLE TO ODOT.
3. THE CONTRACTOR SHALL MAKE DOCUMENTS AVAILABLE AT ALL TIMES FOR INSPECTION BY ODOT OR THEIR REPRESENTATIVES.
4. RECORD DRAWINGS SHALL NOT BE USED FOR ANY OTHER PURPOSE AND SHALL NOT BE REMOVED FROM THE LOCATIONS WITHOUT ODOT APPROVAL.
5. RECORDS MUST BE KEPT CURRENT IN ELECTRONIC FORMAT AND FURNISHED AT ANY TIME THROUGHOUT THE PROJECT, UPON REQUEST.

**RECORDING**

1. THE CONTRACTOR SHALL KEEP ALL RECORDS CURRENT.
2. THE CONTRACTOR SHALL NOT PERMANENTLY CONCEAL ANY WORK UNTIL REQUIRED INFORMATION HAS BE RECORDED.
3. CONTRACT DRAWINGS SHALL BE LEGIBLY MARKED TO RECORD ACTUAL CONSTRUCTION INCLUDING:
  - A. DEPTHS OF VARIOUS ELEMENTS OF FOUNDATION IN RELATION TO DATUM.
  - B. HORIZONTAL AND VERTICAL LOCATIONS OF UNDERGROUND UTILITIES AND APPURTENANCES REFERENCED TO PERMANENT SURFACE IMPROVEMENTS.
  - C. FIELD CHANGES OF DIMENSION AND DETAIL.
  - D. CHANGES MADE BY CHANGE ORDER OR FIELD ORDER.
  - E. DETAILS NOT ON ORIGINAL CONTRACT DOCUMENTS.
4. SPECIFICATIONS AND ADDENDA: LEGIBLY MARK EACH SECTION TO RECORD:
  - A. MANUFACTURERS, TRADE NAME, CATALOG NUMBER AND SUPPLIER OF EACH PRODUCT AND ITEM OF EQUIPMENT ACTUALLY INSTALLED.
  - B. CHANGES MADE BY CHANGE ORDER OR FIELD ORDER.
  - C. OTHER MATTERS NOT ORIGINALLY SPECIFIED.

**RECORD RETENTION**

AS ODOT MAY LEGITIMATELY REQUEST FROM TIME TO TIME, THE CONTRACTOR AGGRESS TO MAKE AVAILABLE FOR INSPECTION AND/OR REPRODUCTION BY THE LPA OR ODOT, ALL RECORDS, BOOKS, AND DOCUMENTS OF ANY KIND AND DESCRIPTION GENERATED BY THE CONTRACTOR THAT RELATE TO THIS CONTRACT. THESE RECORDS MUST BE MADE AVAILABLE IN ELECTRONIC FORMAT.

**SUBMITTALS**

A. THE CONTRACTOR SHALL ANNOTATE ALL RECORD DRAWINGS REVISIONS INTO ELECTRONIC COPIES OF PLAN DRAWINGS PROVIDED BY THE ENGINEER USING MICROSTATION, AS APPROVED BY THE ENGINEER. AT THE COMPLETION OF THE PROJECT, DELIVER ONE (1) PDF, ONE (1) COMPLETE PAPER COPY, AND ONE (1) COMPLETE ELECTRONIC COPY IN TIFF FORMAT OF RECORD DRAWING ORIGINAL DOCUMENTS TO THE ENGINEER FOR DELIVERY. HIGHLIGHT CHANGES WITH CLOUDS AND SHOW MICOSTATION CHANGES ON A SEPARATE LAYER.

**ITEM SPECIAL - MISC.: RECORD DRAWINGS (CONTINUED)**

B. PROVIDE TRANSMITTAL LETTER CONTAINING THE FOLLOWING INFORMATION:

1. DATE
2. PROJECT TITLE AND PROJECT NUMBER
3. CONTRACTOR'S NAME AND ADDRESS
4. TITLE AND NUMBER OF EACH DRAWING
5. CERTIFICATION OF LICENSED PROFESSIONAL ENGINEER IN THE STATE OF OHIO AND LEVEL II PREQUALIFIED BY ODOT FOR BRIDGE PROJECTS.
6. SIGNATURE OF CONTRACTOR OR HIS AUTHORIZED REPRESENTATIVE.

**PAYMENT**

PAYMENT FOR ALL THE ABOVE SHALL BE LUMP SUM UPON PROPER EXECUTION OF ALL WORK OF THIS ITEM AS DETERMINED BY THE ENGINEER.

**625, TEMPORARY LIGHTING**

THE TEMPORARY LIGHTING SHALL INCLUDE THE REMOVAL OF THE EXISTING LIGHTING WITHIN INFIELD OF RAMP G FROM SR-21 TO I-77 SOUTHBOUND. THERE ARE 8 EXISTING LIGHT POLES, LUMINAIRES, FOUNDATIONS AND APPURTENANCES TO REMOVE IN ACCORDANCE WITH CMS 625.21 AND AS SHOWN ON THE PLANS. THE LIGHT POLE FOUNDATION SHALL BE REMOVED TO A MINIMUM OF 1 FOOT BELOW THE FINISHED GRADE, PROPOSED PAVEMENT BASE OR REMOVE THE FOUNDATION COMPLETELY, AND SHALL INCLUDE BACKFILLING THE RESULTANT DEPRESSION WITH COMPACTED SOIL. ALL CABLES SHALL BE REMOVED AND CONDUITS ABANDONED.

THE CONTRACTOR SHALL COORDINATE PROJECT PID 111405, WHERE PERMANENT LIGHTING WILL BE INSTALLED. PERMANENT LIGHTING SHOULD BE INSTALLED BY THE END OF PHASE 2 (OPENING OF RAMP G).

THE CONTRACTOR SHALL NOT PROCEED WITH THE REMOVAL OF THE EXISTING LIGHTING BEFORE THE NEW TEMPORARY LIGHTING IS OPERATIONAL. THE POLES SHALL BE SPACED AT 150 FEET, BRACKET ARMS SHALL BE 30 FEET, LUMINAIRES SHALL PROVIDE THE STATED FOOTCANDLES OR AT A MINIMUM MATCH THE EXISTING LIGHTING, 30-FOOT MOUNTING HEIGHT OF LUMINAIRES, OVERHEAD WIRING METHODS, SHALL BE PLACED OUTSIDE THE CLEAR ZONE. THE TEMPORARY LIGHTING SHALL PROVIDE AN AVERAGE INITIAL INTENSITY OF 1.2 FOOTCANDLES WITH AN AVERAGE TO MINIMUM UNIFORMITY NOT TO EXCEED 3:1. THE MINIMUM OVERHEAD CONDUCTOR CLEARANCE SHALL BE 20 FEET. TEMPORARY OVERHEAD CONSTRUCTION SHALL NOT BE LESS THAN GRADE "B" FOR STRENGTH REQUIREMENTS AS DEFINED BY THE NATIONAL ELECTRIC SAFETY CODE. WOOD POLES WITH OVERHEAD WIRING MAY BE USED. HOWEVER, TEMPORARY LIGHTING SHALL MEET FEDERAL AND STATE SAFETY CRITERIA.

ALL MATERIALS NECESSARY TO COMPLETE THE TEMPORARY LIGHTING SHALL BE FURNISHED AND INSTALLED BY THE CONTRACTOR AND SHALL BE LEFT IN PLACE AT THE END OF THE CONTRACT.

THE MAINTAINING AGENCY WILL PAY FOR ELECTRICAL ENERGY CONSUMED BY EXISTING POWER SERVICES AND BY PROPOSED POWER SERVICES AFTER ACCEPTANCE OF THE TEMPORARY LIGHTING WORK.


PAYMENT SHALL BE MADE AT THE UNIT PRICE BID PER LUMP SUM FOR ITEM 625 TEMPORARY LIGHTING AND SHALL INCLUDE ALL LABOR, EQUIPMENT, MATERIALS, TESTING AND INCIDENTALS TO REMOVE THE EXISTING LIGHTING AND PLACE A TEMPORARY LIGHTING SYSTEM COMPLETE, FULLY OPERATIONAL AND IN PLACE.



Mark	NUMBER		LENGTH	WEIGHT		TYPE	DIMENSIONS						
	SUPER	TOTAL		SUPER	TOTAL		A	B	C	D	E	R	INC
<b>DECK</b>													
S401	160	160	30'-0"	3,207	3,207	STR.							
S402	20	20	10'-0"	134	134	STR.							
S403	228	228	26'-8"	4,062	4,062	STR.							
# S501	487	487	20'-6"	10,413	10,413	16	19'-11"						
# S502	487	487	19'-11"	10,117	10,117	STR.							
S503	522	522	7'-1"	3,857	3,857	16	6'-6"						
# S504	SER OF	SER OF	to	465	465	STR.						5 1/4"	
	40	40	19'-11"										
	1	1	2'-4"										
# S505	SER OF	SER OF	to	465	465	STR.						5 1/4"	
	40	40	19'-11"										
	1	1	2'-11"										
S506	SER OF	SER OF	to	536	536	STR.						4 1/2"	
	45	45	19'-11"										
	1	1	2'-4"										
S507	SER OF	SER OF	to	523	523	STR.						4 3/4"	
	45	45	19'-11"										
S508	200	200	30'-0"	6,258	6,258	STR.							
S509	25	25	14'-0"	366	366	STR.							
	1	1	2'-9"							2'-2"			
S510	SER OF	SER OF	to	49	49	16	to					5"	
	10	10	6'-7"				6'-0"						
S511	10	10	2'-3"	24	24	STR.							
S512	6	6	2'-0"	13	13	STR.							
SUB-TOTAL				40,489	40,489								
<b>PARAPET</b>													
R601	258	258	7'-4"	2,842	2,842	39	9 1/2"	11"	2'-3"	2'-3"	7"	12"	
R602	285	285	7'-1"	3,033	3,033	23	6"	3'-3"	3'-3"			2"	
	6	6	4'-4"					3'-6"					
R603	SER OF	SER OF	to	471	471	1	1'-0"	to				1"	
	11	11	5'-2"					4'-4"					
R604	24	24	4'-4"	157	157	1	1'-0"	3'-6"					
R605	27	27	7'-8"	311	311	39	9 1/2"	11"	2'-5"	2'-5"	7"	12"	
SUB-TOTAL				6,814	6,814								
TOTAL ALL REINFORCING					73,658								

**REINFORCING CALLOUT NOMENCLATURE**

BAR SIZE AND LOCATION ARE INDICATED IN THE BAR MARK.  
 LOCATION: THE BEGINNING 1 OR 2 LETTERS INDICATES WHERE THE BAR IS INITIALLY CAST INTO.  
 SIZE: THE FIRST NUMBER (IF 3 TOTAL NUMBERS) OR TWO NUMBERS (IF 4 TOTAL NUMBERS)  
 UNIQUE ID: THE LAST TWO NUMBERS ARE AN INDEX NUMBER. THE INDEX NUMBER NEED NOT BE SEQUENTIAL, IT IS SIMPLY TO ALLOW A UNIQUE IDENTIFICATION OF BARS OF THE SAME SIZE AND IN THE SAME LOCATION WITHIN THE STRUCTURE.

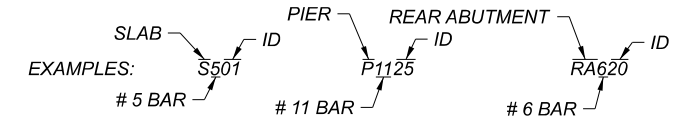

LOCATION MARKS USED: F = FOOTING, P = PIER, R = RAIL (PARAPET), A = ABUTMENT, WW = WINGWALL, D = ABUTMENT DIAPHRAGM, S = SLAB (DECK)

# = ALL OR A PORTION OF BARS PROVIDED WITH MECHANICAL CONNECTOR


**MINIMUM LAP SPLICE LENGTHS**

#4 BAR (ALL) = 2'-0"  
 #5 BAR (ALL) = 2'-6"  
 #6 BAR (ALL) = 3'-0"

**REINFORCING NOTES**

- ALL REINFORCEMENT BARS SHALL BE EPOXY COATED. PAYMENT FOR REINFORCING, INCLUDING MECHANICAL CONNECTORS, SHALL BE MADE WITH ITEM 509 - EPOXY COATED REINFORCING STEEL
- "STR." IN THE TYPE COLUMN INDICATES STRAIGHT BARS.
- "SER OF" DENOTES SERIES OF BARS, E.G. "X" SER OF "Y" = "X" SERIES OF "Y" BARS/SERIES.
- REFER TO C.M.S SECTION 509.05 FOR STANDARD BEND DIMENSIONS.
- MECHANICAL CONNECTORS: AN APPROVED TYPE OF MECHANICAL CONNECTOR FOR REINFORCING BARS SHALL BE PROVIDED IN ACCORDANCE WITH C.M.S. SECTION 509.07. INSTALLATION OF CONNECTORS SHALL CONFORM WITH MANUFACTURER RECOMMENDED PROCEDURES.

CONNECTORS AND DOWEL BARS USED WITH EPOXY COATED BARS SHALL BE EPOXY COATED. COATING FOR BOTH CONNECTORS AND BARS SHALL CONFORM TO THE SAME SPECIFICATIONS. COATINGS THAT HAVE BEEN DAMAGED OR THAT OTHERWISE DO NOT MEET SPECIFICATIONS WITH RESPECT TO COLOR, CONTINUITY AND UNIFORMITY, MAY BE REPAIRED AS DIRECTED BY THE ENGINEER, OR THEY SHALL BE REPLACED WITH MATERIAL WITH MEETS THE SPECIFICATIONS. FOR BARS UTILIZING A MECHANICAL CONNECTOR, THE BAR LENGTH FOR PAYMENT IS MEASURED TO THE CENTER OF THE PLANNED MECHANICAL CONNECTION. EXTRA BAR LENGTH AND/OR BAR END PREPARATION MAY BE NECESSARY DEPENDING UPON THE TYPE OF MECHANICAL CONNECTOR FURNISHED AND THOSE COSTS SHALL BE INCLUDED IN THE BID PRICE FOR ITEM 509. CONNECTORS AND DOWEL BAR EXTENSIONS SHALL CONFORM TO AND BE INCLUDED IN THE BID PRICE FOR ITEM 509.

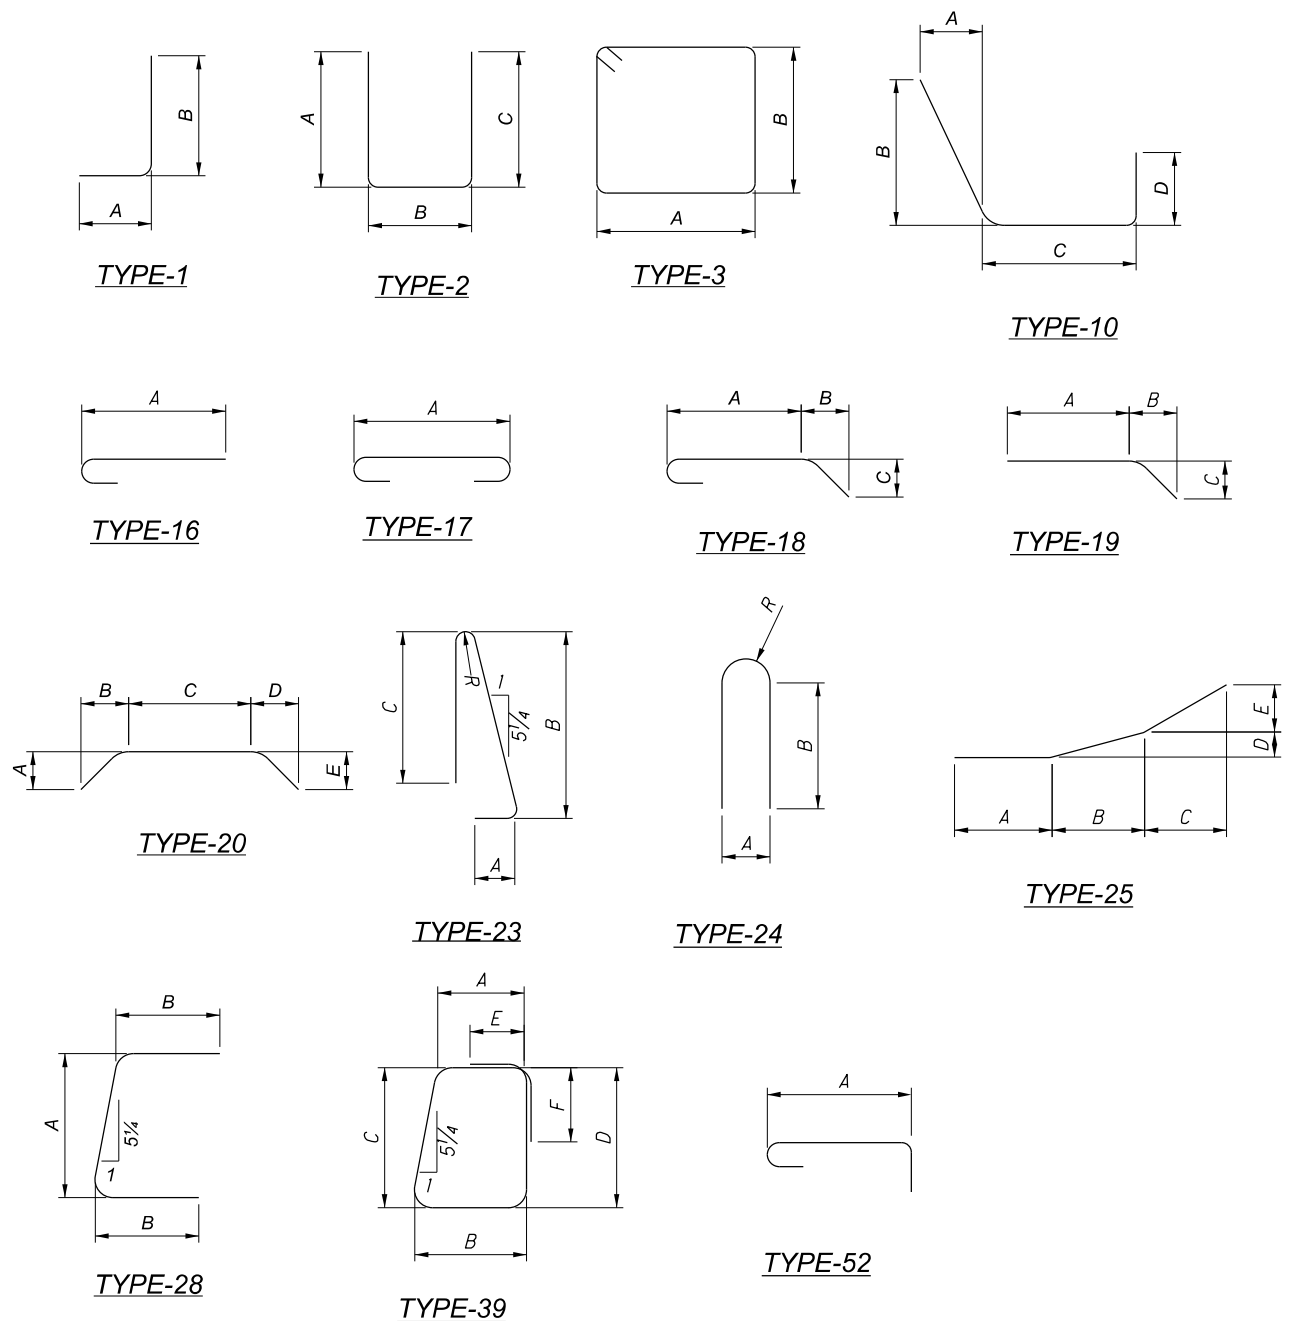

Mark	QUANTITY	LENGTH (FT)	TOTAL (FT)	TYPE	DIMENSIONS				
					A	B	C	D	E
R401	84.00	10.00	840.00	STR.					
R402	88.00	30.00	2640.00	STR.					
R403	11.00	13.00	143.00	STR.					
R405	8.00	11.75	94.00	STR.					
R406	36.00	10.00	360.00	STR.					
R407	18.00	6.42	115.50	25	2'-6"	2'-5"	1'-5"	1 1/2"	5"
R408	18.00	5.08	91.50	STR.					
R409	4.00	10.00	40.00	STR.					
R410	1.00	23.42	23.42	STR.					
R411	2.00	14.67	29.33	STR.					
R412	2.00	12.83	25.67	STR.					
R413	5.00	24.67	123.33	STR.					
R414	5.00	22.83	114.17	STR.					
TOTAL GFRP LENGTH			4640						

SFN	7704712
DESIGNER	Gannett Fleming
CHECKER	CTM
REVIEWER	MTM
PROJECT ID	104983 (PRT 2)
SUBSET	38
TOTAL	38
SHEET	256
TOTAL	312

Mark	NUMBER		LENGTH	WEIGHT		TYPE	DIMENSIONS						
	SUPER	TOTAL		SUPER	TOTAL		A	B	C	D	E	R	INC
<b>DECK</b>													
S401	140	140	30'-0"	2,806	2,806	STR.							
S402	20	20	21'-0"	281	281	STR.							
S403	228	228	19'-4"	2,945	2,945	STR.							
# S501	433	433	21'-0"	9,484	9,484	16	20'-5"						
# S502	433	433	20'-5"	9,221	9,221	STR.							
S503	461	461	6'-11"	3,326	3,326	16	6'-4"						
	1	1	3'-1"				2'-6"						
S504	SER OF	SER OF	to	465	465	16	to					5 3/4"	
	37	37	21'-0"				20'-5"						
	1	1	2'-6"										
S505	SER OF	SER OF	to	443	443	STR.						5 3/4"	
	37	37	20'-5"										
	1	1	3'-1"				2'-6"						
S507	SER OF	SER OF	to	48	48	16	to					6"	
	9	9	7'-1"				6'-6"						
	1	1	2'-9"										
# S508	SER OF	SER OF	to	389	389	STR.						6 1/4"	
	33	33	19'-10"										
	1	1	2'-9"										
# S509	SER OF	SER OF	to	389	389	STR.						6 1/4"	
	33	33	19'-10"										
S510	175	175	30'-0"	5,476	5,476	STR.							
S511	25	25	24'-6"	639	639	STR.							
S512	5	5	2'-6"	14	14	16	1'-11"						
S513	5	5	1'-11"	10	10	STR.							
# S514	5	5	2'-4"	13	13	STR.							
# S515	5	5	2'-4"	13	13	STR.							
SUB-TOTAL				35,962	35,962								
<b>PARAPET</b>													
R601	239	239	7'-4"	2,633	2,633	39	9 1/2"	11"	2'-3"	2'-3"	7"	12"	
R602	239	239	7'-1"	2,543	2,543	23	6"	3'-3"	3'-3"			2"	
	8	8	4'-4"					3'-6"					
R603	SER OF	SER OF	to	617	617	1	1'-0"	to				3/4"	
	11	11	5'-0"					4'-1 1/2"					
R604	32	32	4'-4"	209	209	1	1'-0"	3'-6"					
SUB-TOTAL				6,002	6,002								
TOTAL ALL REINFORCING				69,246									

# = ALL OR A PORTION OF BARS PROVIDED WITH MECHANICAL CONNECTOR

**MINIMUM LAP SPLICE LENGTHS**

#4 BAR (ALL) = 2'-0"


#5 BAR (ALL) = 2'-6"

#6 BAR (ALL) = 3'-0"

**REINFORCING NOTES**

- ALL REINFORCEMENT BARS SHALL BE EPOXY COATED. PAYMENT FOR REINFORCING, INCLUDING MECHANICAL CONNECTORS, SHALL BE MADE WITH ITEM 509 - EPOXY COATED REINFORCING STEEL
- "STR." IN THE TYPE COLUMN INDICATES STRAIGHT BARS.
- "SER OF" DENOTES SERIES OF BARS, E.G "X" SER OF "Y" = "X" SERIES OF "Y" BARS/SERIES.
- WHEN NO BAR LEG DIMENSIONS ARE SHOWN, IT INDICATES A STANDARD BEND/RETURN. REFER TO C.M.S SECTION 509.05 FOR STANDARD BEND DIMENSIONS.
- MECHANICAL CONNECTORS: AN APPROVED TYPE OF MECHANICAL CONNECTOR FOR REINFORCING BARS SHALL BE PROVIDED IN ACCORDANCE WITH C.M.S. SECTION 509.07. INSTALLATION OF CONNECTORS SHALL CONFORM WITH MANUFACTURER RECOMMENDED PROCEDURES.

CONNECTORS AND DOWEL BARS USED WITH EPOXY COATED BARS SHALL BE EPOXY COATED. COATING FOR BOTH CONNECTORS AND BARS SHALL CONFORM TO THE SAME SPECIFICATIONS. COATINGS THAT HAVE BEEN DAMAGED OR THAT OTHERWISE DO NOT MEET SPECIFICATIONS WITH RESPECT TO COLOR, CONTINUITY AND UNIFORMITY, MAY BE REPAIRED AS DIRECTED BY THE ENGINEER, OR THEY SHALL BE REPLACED WITH MATERIAL WITH MEETS THE SPECIFICATIONS. FOR BARS UTILIZING A MECHANICAL CONNECTOR, THE BAR LENGTH FOR PAYMENT IS MEASURED TO THE CENTER OF THE PLANNED MECHANICAL CONNECTION. EXTRA BAR LENGTH AND/OR BAR END PREPARATION MAY BE NECESSARY DEPENDING UPON THE TYPE OF MECHANICAL CONNECTOR FURNISHED AND THOSE COSTS SHALL BE INCLUDED IN THE BID PRICE FOR ITEM 509. CONNECTORS AND DOWEL BAR EXTENSIONS SHALL CONFORM TO AND BE INCLUDED IN THE BID PRICE FOR ITEM 509.

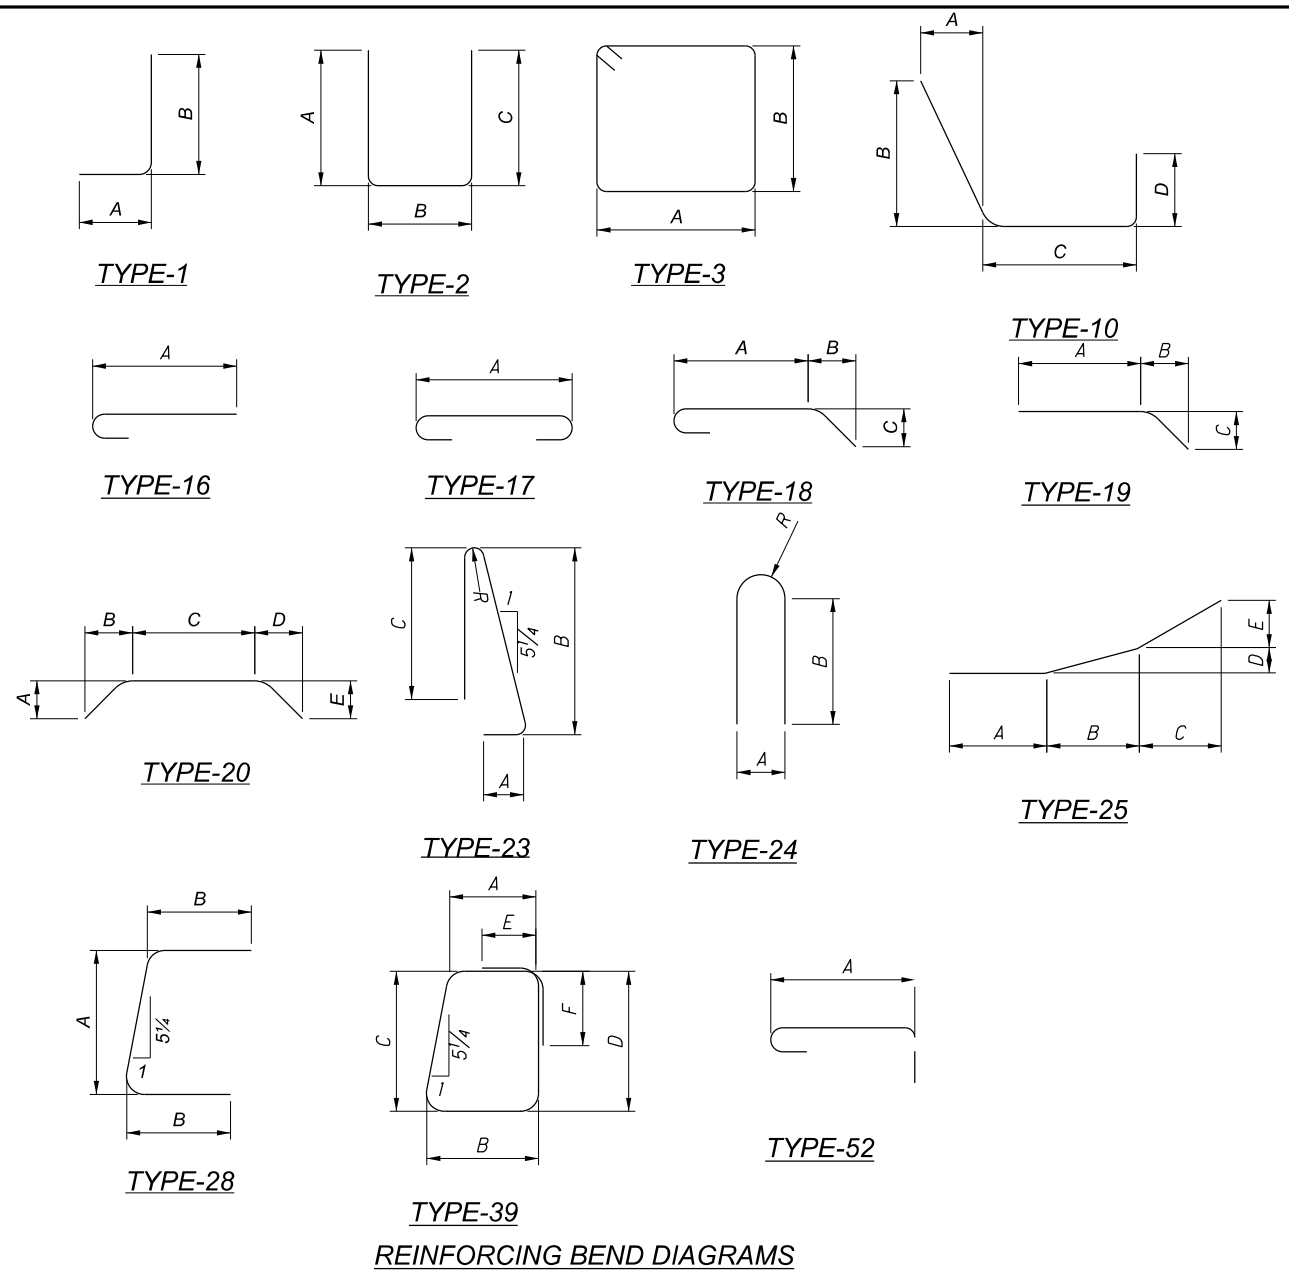

GFRP PARAPET BARS									
MARK	QUANTITY	LENGTH (FT)	TOTAL (FT)	TYPE	DIMENSIONS				
					A	B	C	D	E
R401	76	10.00	760	STR.					
R402	77	30.00	2310	STR.					
R403	11	21.00	231	STR.					
R404	8	13.25	106	STR.					
R406	44	10.00	440	STR.					
R407	24	7.92	190	25	2'-6"	2'-5"	2'-11"	1 1/2"	5"
R408	24	6.58	158	STR.					
TOTAL GFRP LENGTH			4195						

**REINFORCING CALLOUT NOMENCLATURE**  
 BAR SIZE AND LOCATION ARE INDICATED IN THE BAR MARK.

**LOCATION:** THE BEGINNING 1 OR 2 LETTERS INDICATES WHERE THE BAR IS INITIALLY CAST INTO.

**SIZE:** THE FIRST NUMBER (IF 3 TOTAL NUMBERS) OR TWO NUMBERS (IF 4 TOTAL NUMBERS) UNIQUE ID: THE LAST TWO NUMBERS ARE AN INDEX NUMBER. THE INDEX NUMBER NEED NOT BE SEQUENTIAL, IT IS SIMPLY TO ALLOW A UNIQUE IDENTIFICATION OF BARS OF THE SAME SIZE AND IN THE SAME LOCATION WITHIN THE STRUCTURE.

EXAMPLES: # 5 BAR S501, # 11 BAR P1125, # 6 BAR RA620

LOCATION MARKS USED: F = FOOTING, P = PIER, R = RAIL (PARAPET), A = ABUTMENT, WW = WINGWALL, D = ABUTMENT DIAPHRAGM, S = SLAB (DECK)

REINFORCING LIST 2 OF 2  
 BRIDGE NO. SUM-77-3227R  
 IR-77 OVER BRECKSVILLE RD.

RSN	CTM
MTO	3/22
PROJECT ID	104983 (PRT 2)
SUBSET	TOTAL
37	37
SHEET	TOTAL
293	312