


MATCHLINE STA. 23+50

BENCH MARK
 STA. 36+84.9, 27.55' LT.
 EXISTING HYDRANT TOP
 TOP=1003.40



CALCULATED AWD
 CHECKED AKB

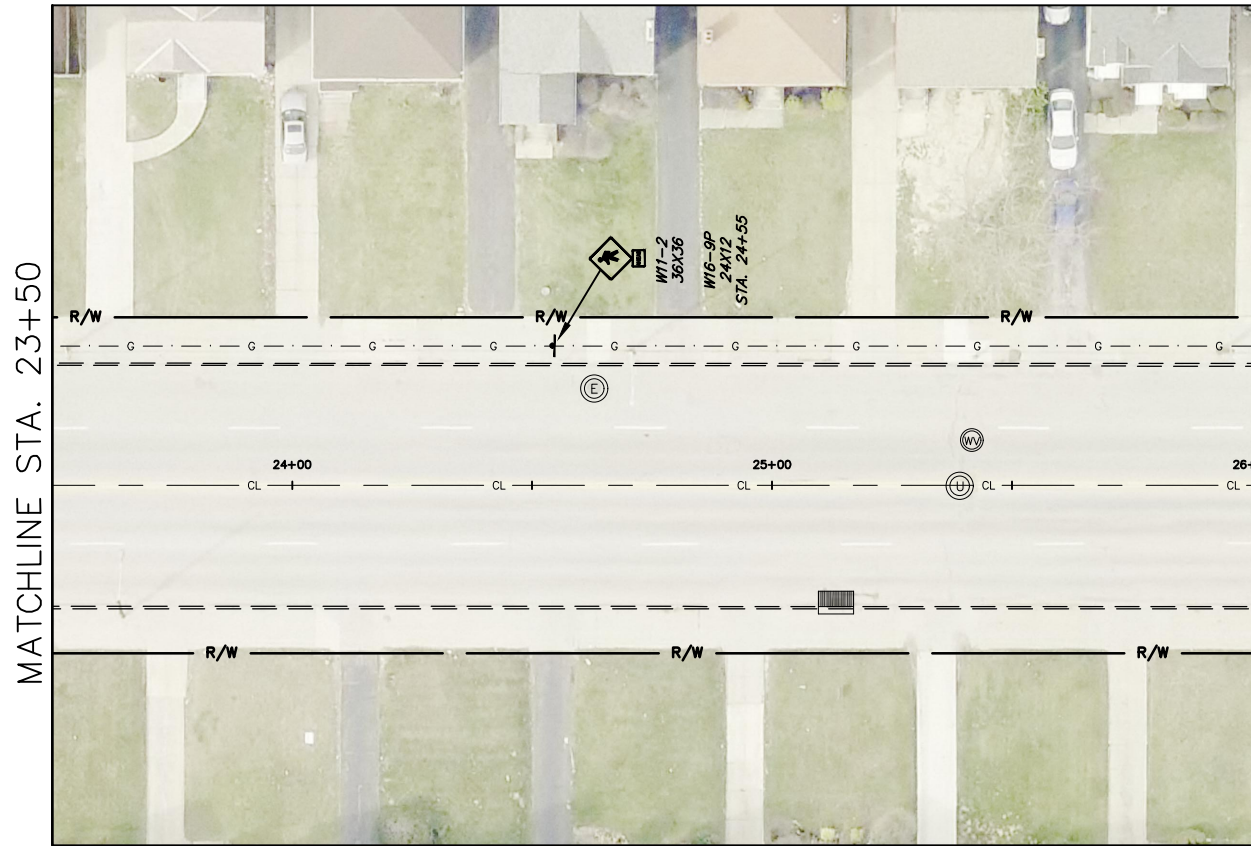

MATCHLINE STA. 23+50

202	WALK REMOVED	SF	340
608	4" CONCRETE WALK, AS PER PLAN	SF	242
608	CURB RAMP, AS PER PLAN (STA. 22+42)	SF	98
630	SIGNING, MISC.: SOLAR POWERED RECTANGULAR RAPID FLASHING BEACON (RRFB) SIGN ASSEMBLY, COMPLETE, AS PER PLAN (MID-BLOCK X-ING AT THAYNE)(STA. 22+42)	EACH	2
630	GROUND MOUNTED SUPPORT	FT	28
630	SIGN, FLAT SHEET (W11-2), 6 TOTAL	SF	54
630	SIGN, FLAT SHEET (W6-7P), 4 TOTAL	SF	8
630	SIGN, FLAT SHEET (W6-9P), 2 TOTAL	SF	4
644	CROSSWALK LINE, 12"	FT	102

REV. NO.	INITIALS	DATE	DESCRIPTION
1	AWD	2/25/22	QUANTITY REVISIONS

ADDITIVE ALTERNATE 1
 THAYNE RD. MID-BLOCK PEDESTRIAN CROSSING

CUY - CEDAR ROAD