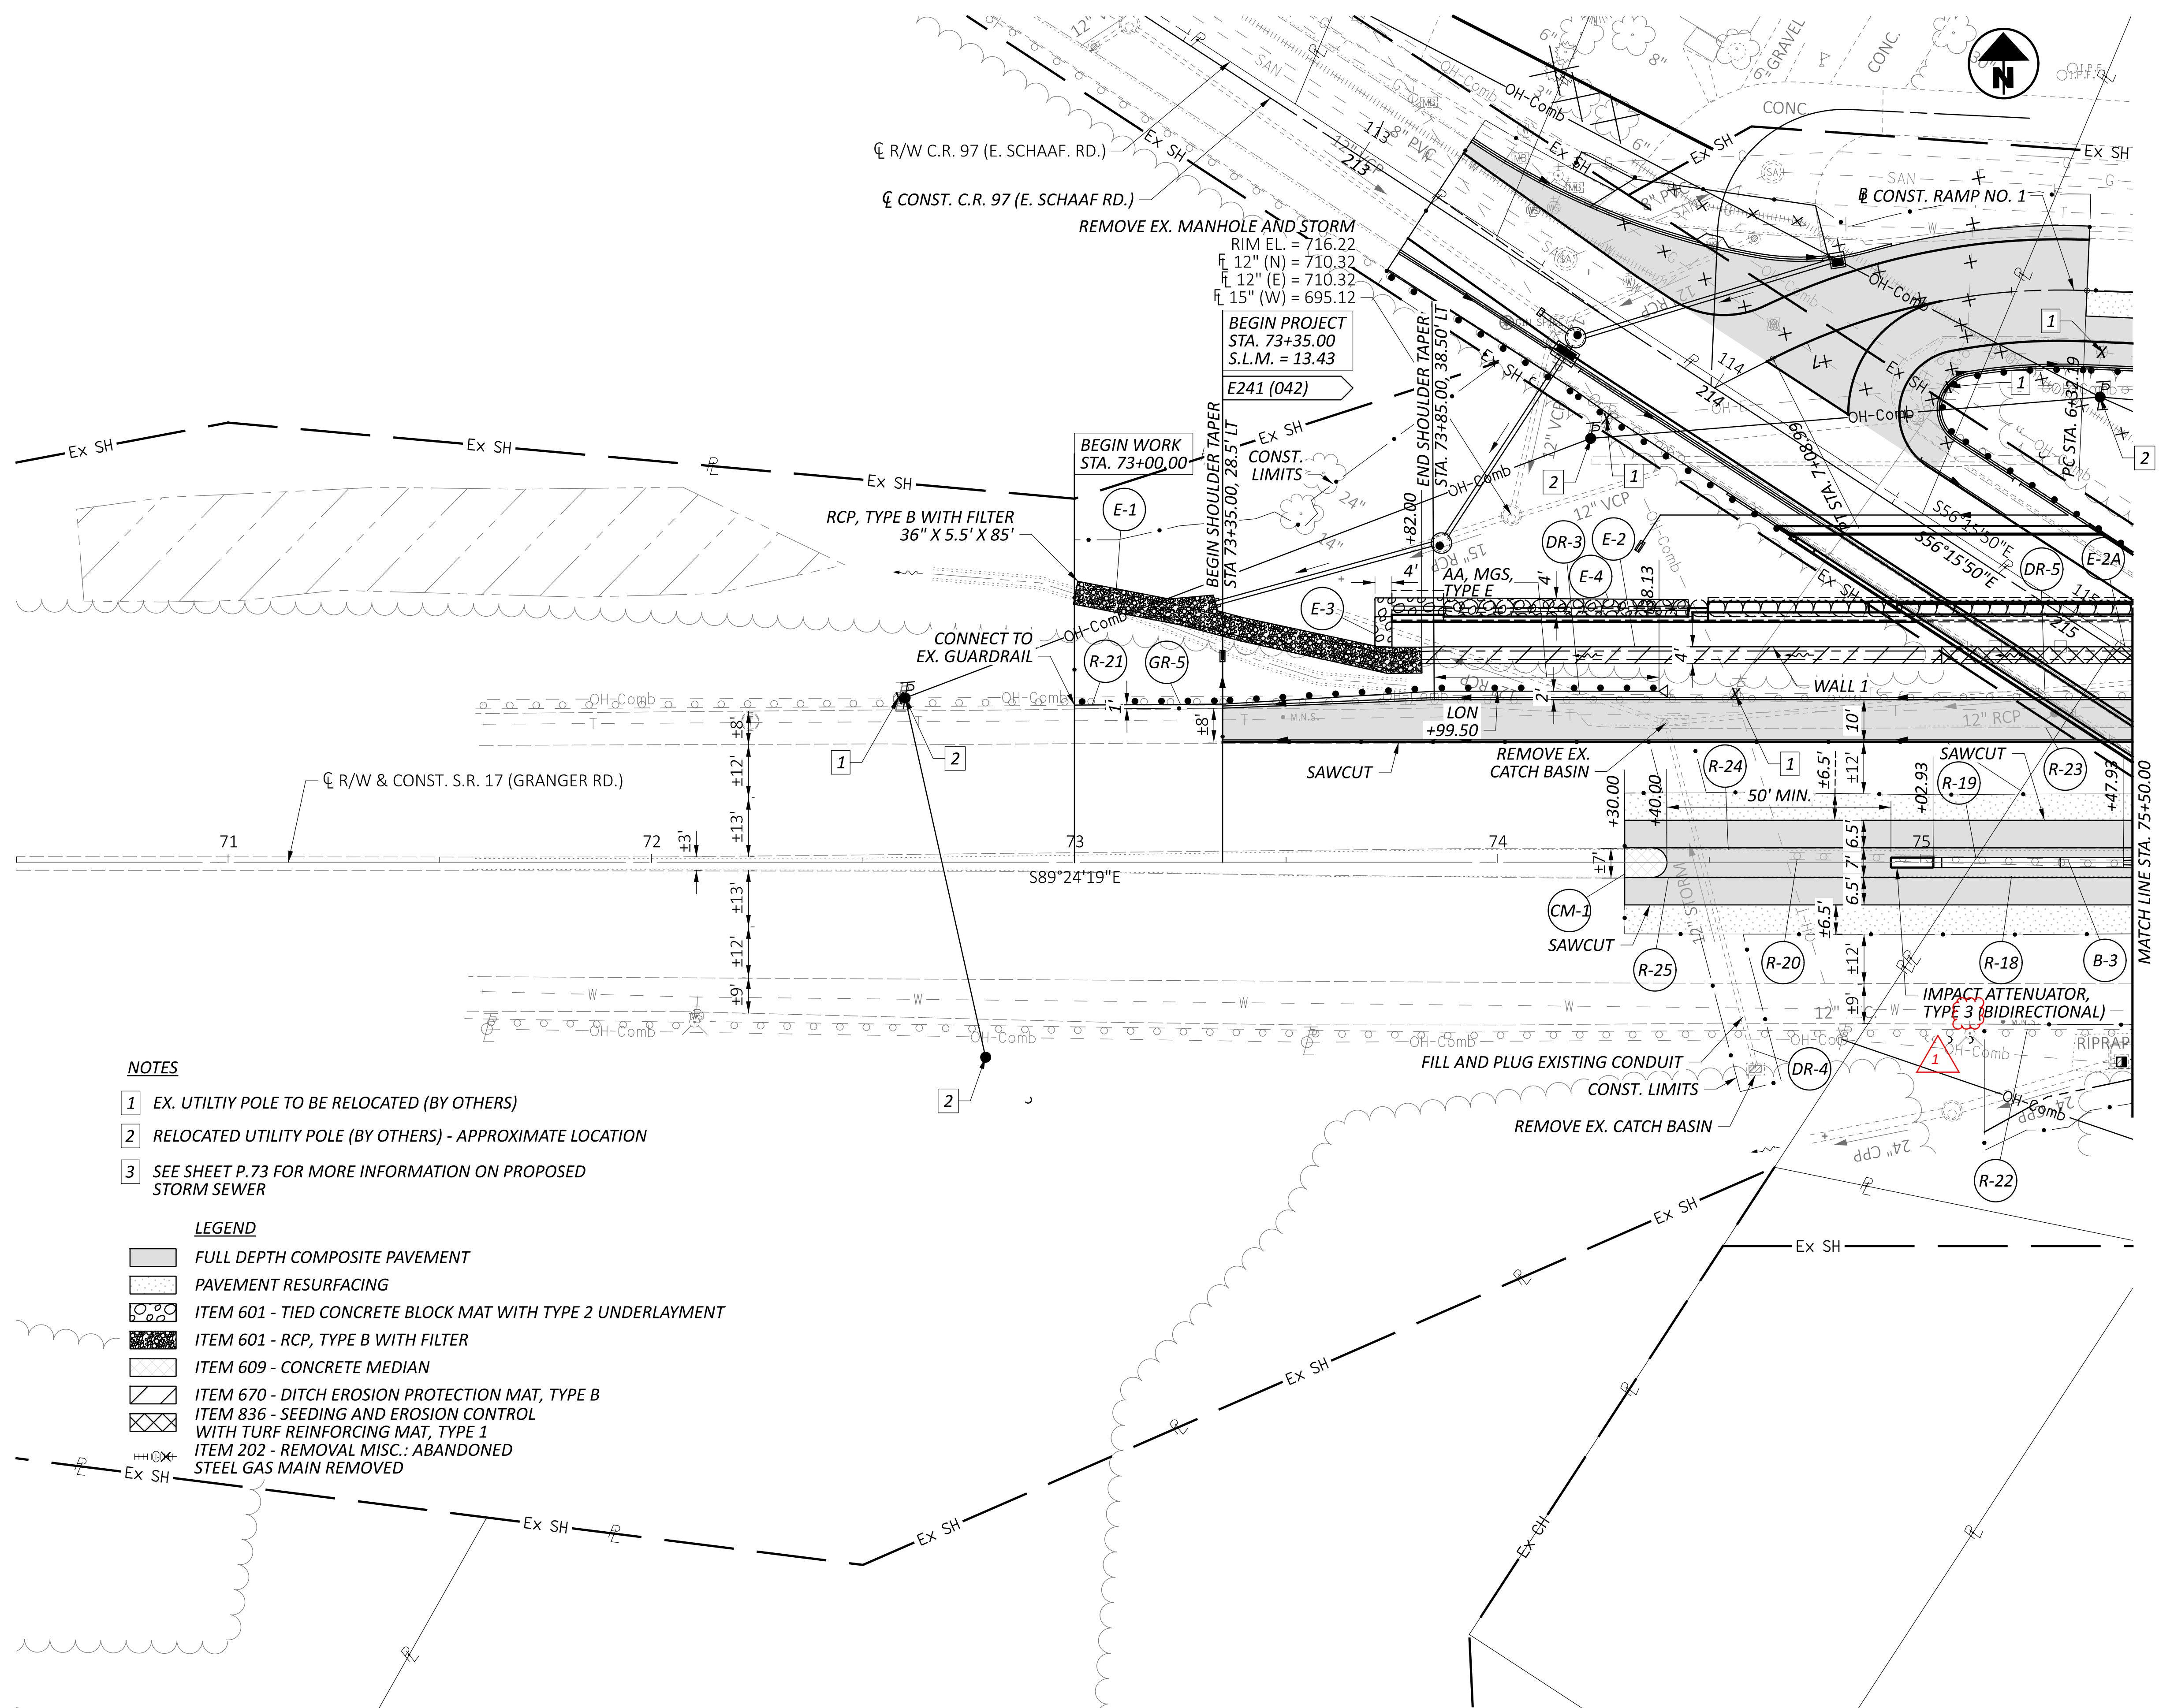


**NOTES**

- 1 EX. UTILITY POLE TO BE RELOCATED (BY OTHERS)
- 2 RELOCATED UTILITY POLE (BY OTHERS) - APPROXIMATE LOCATION
- 3 SEE SHEET P.73 FOR MORE INFORMATION ON PROPOSED STORM SEWER

LEGEND

- FULL DEPTH COMPOSITE PAVEMENT
- PAVEMENT RESURFACING
- ITEM 601 - TIED CONCRETE BLOCK MAT WITH TYPE 2 UNDERLAYMENT
- ITEM 601 - RCP, TYPE B WITH FILTER
- ITEM 609 - CONCRETE MEDIAN
- ITEM 670 - DITCH EROSION PROTECTION MAT, TYPE B
- ITEM 836 - SEEDING AND EROSION CONTROL WITH TURF REINFORCING MAT, TYPE 1
- ITEM 202 - REMOVAL MISC.: ABANDONED STEEL GAS MAIN REMOVED

HORIZONTAL
SCALE IN FEET
0 20 40PLAN - S.R. 17 (GRANGER RD.)
BEGIN TO STA. 75+50.00

DESIGN AGENCY

HR

DESIGNER

TJS

REVIEWER

MJL 04/25/24

PROJECT ID


112998

SHEET

P.36

TOTAL

151

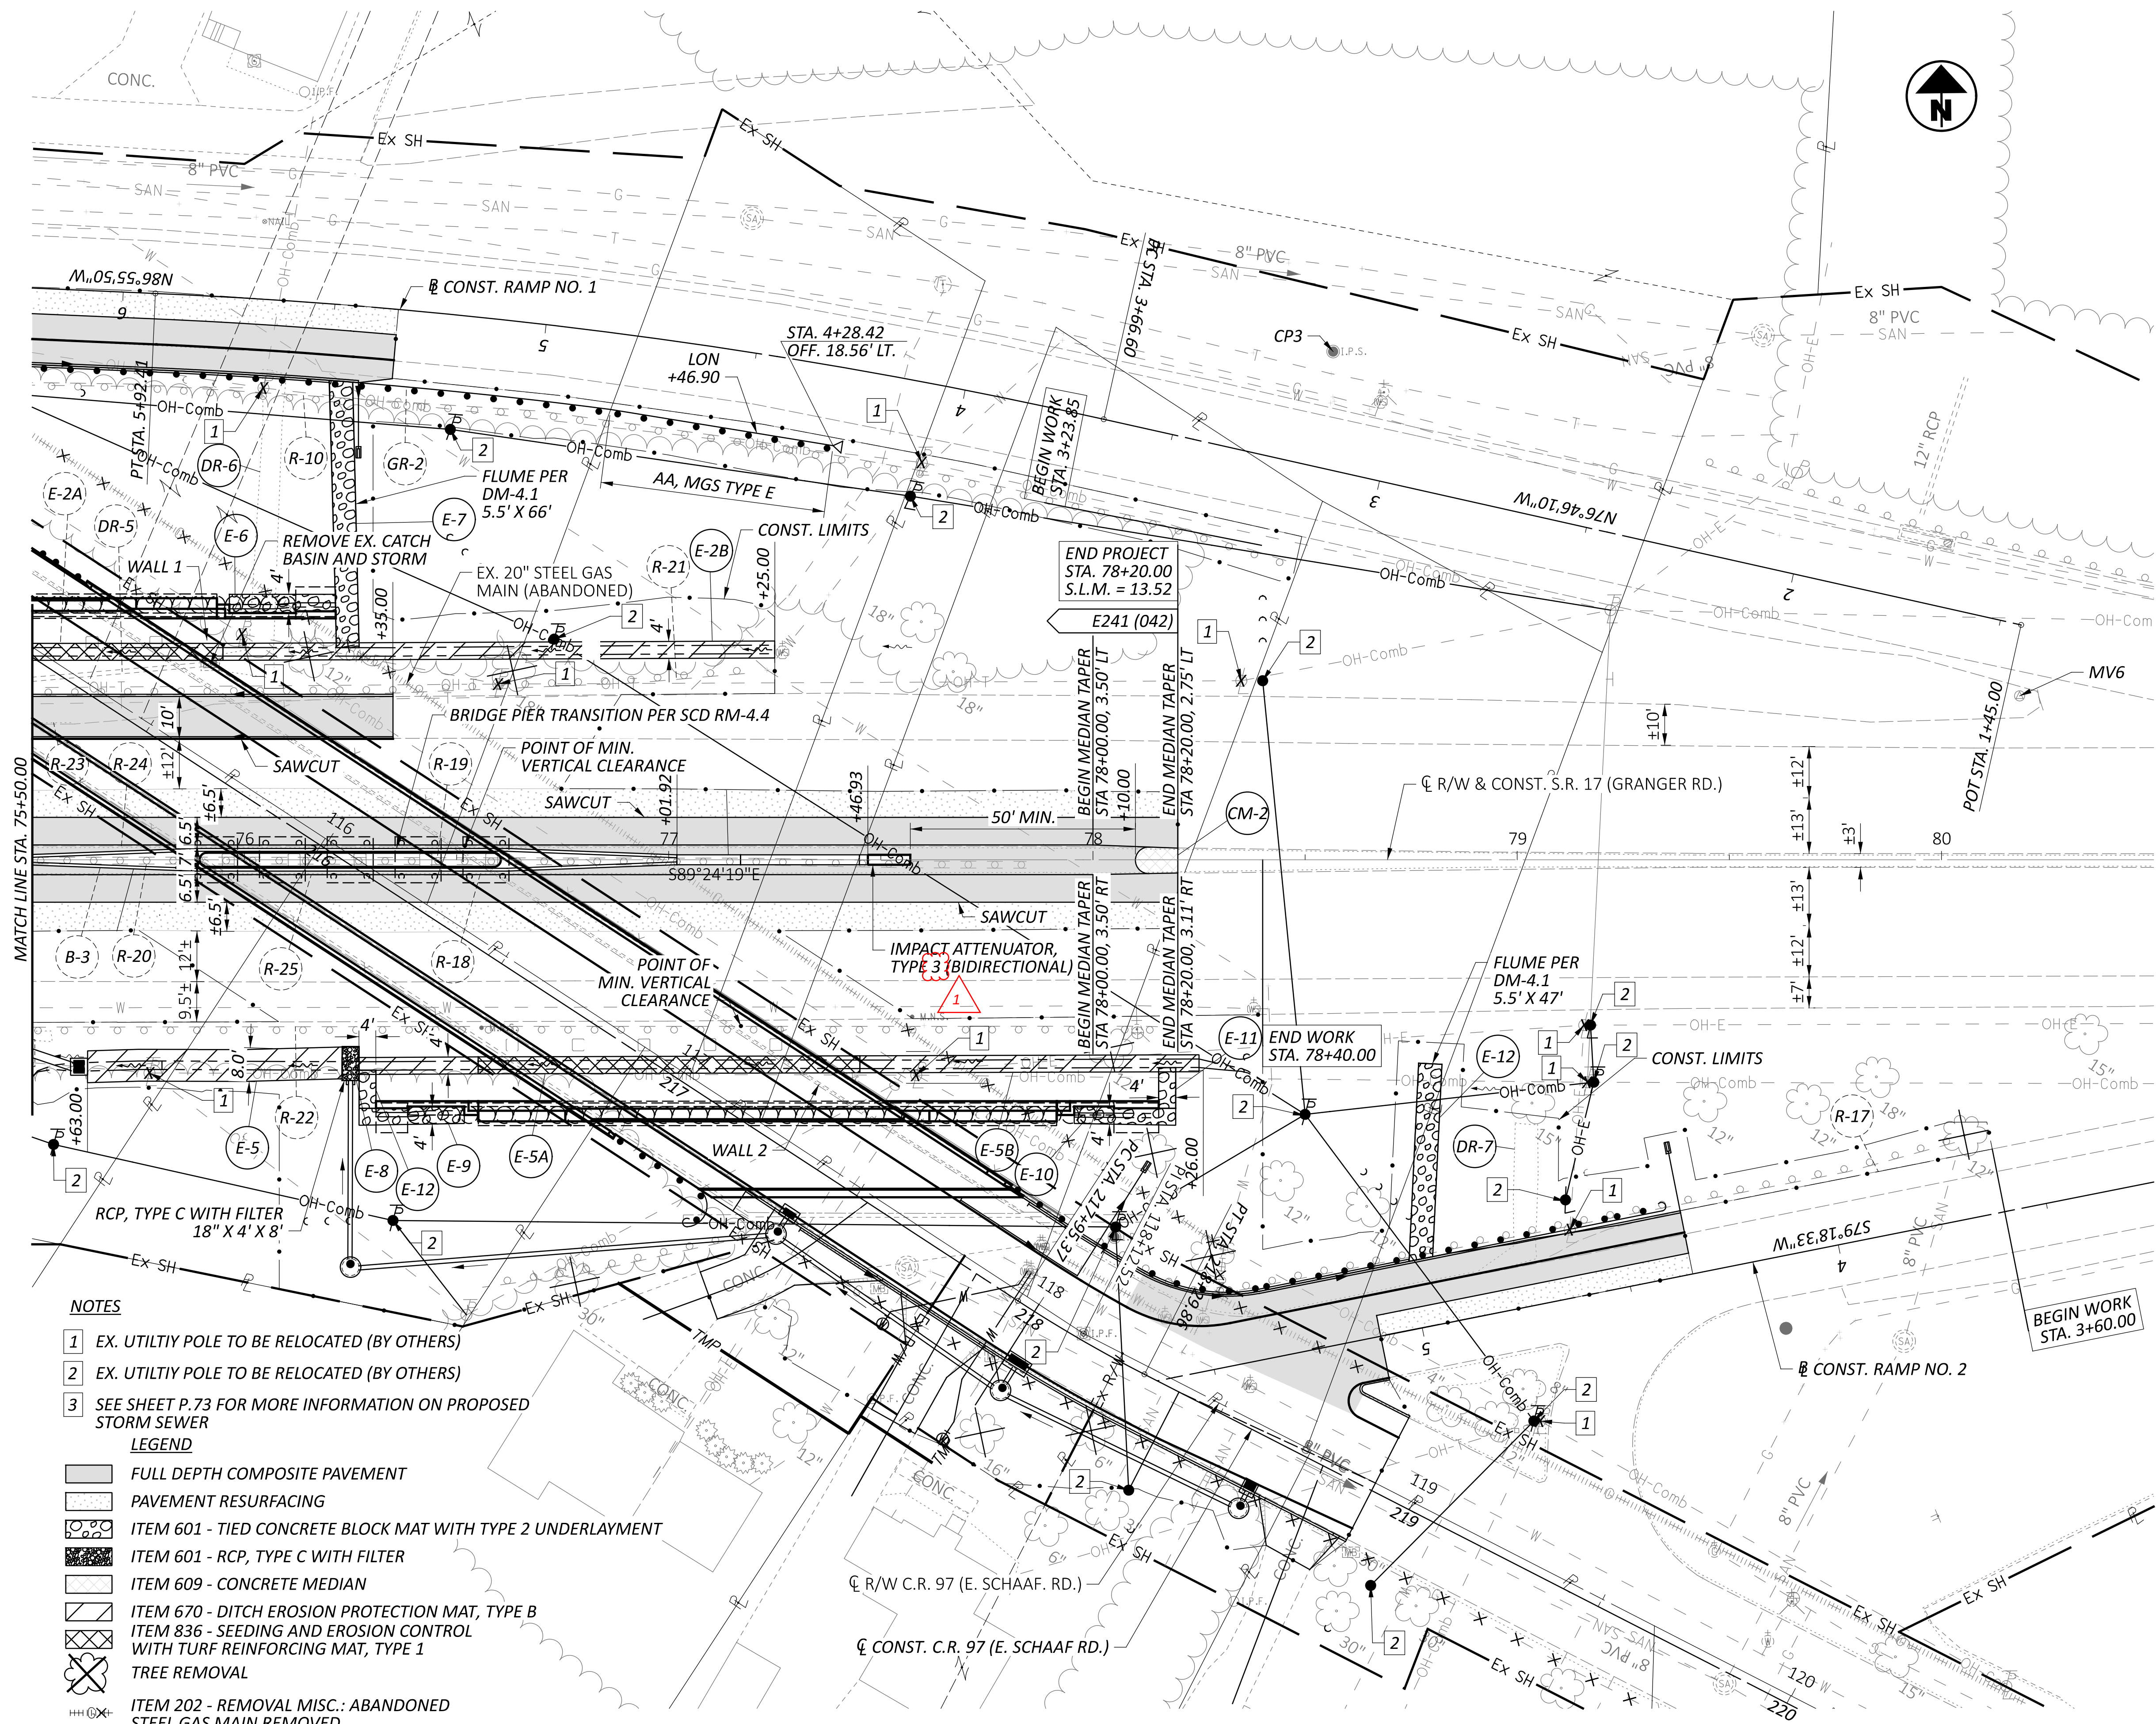PLAN - S.R. 17 (GRANGER RD.)
STA. 75+50.00 TO ENDHORIZONTAL
SCALE IN FEET
0 20 40

DESIGN AGENCY

HR

DESIGNER

TJS

REVIEWER

MJL 04/25/24

PROJECT ID

112998

SHEET

P.37

TOTAL

151