

NOTES:



1. REFER TO SURVEY PARAMETERS NOTE IN THE GENERAL NOTES FOR PROJECT CONTROL INFORMATION.

2. A QUANTITY OF 11 YELLOW/RED RPMs HAS BEEN CARRIED TO THE SUBSUMMARY TO BE PLACED ON THE EXISTING YELLOW EDGE LINE PER ODOT SCD TC-73.20.

3. A QUANTITY OF 11 WHITE/RED RPMs HAS BEEN CARRIED TO THE SUBSUMMARY TO BE PLACED ON THE EXISTING WHITE EDGE LINE PER ODOT SCD TC-73.20.

4. A QUANTITY OF 11 WHITE/RED RPMs HAS BEEN CARRIED TO THE SUBSUMMARY TO BE PLACED ON THE EXISTING WHITE LANE LINE PER ODOT SCD TC-73.20.

LOCATION 09

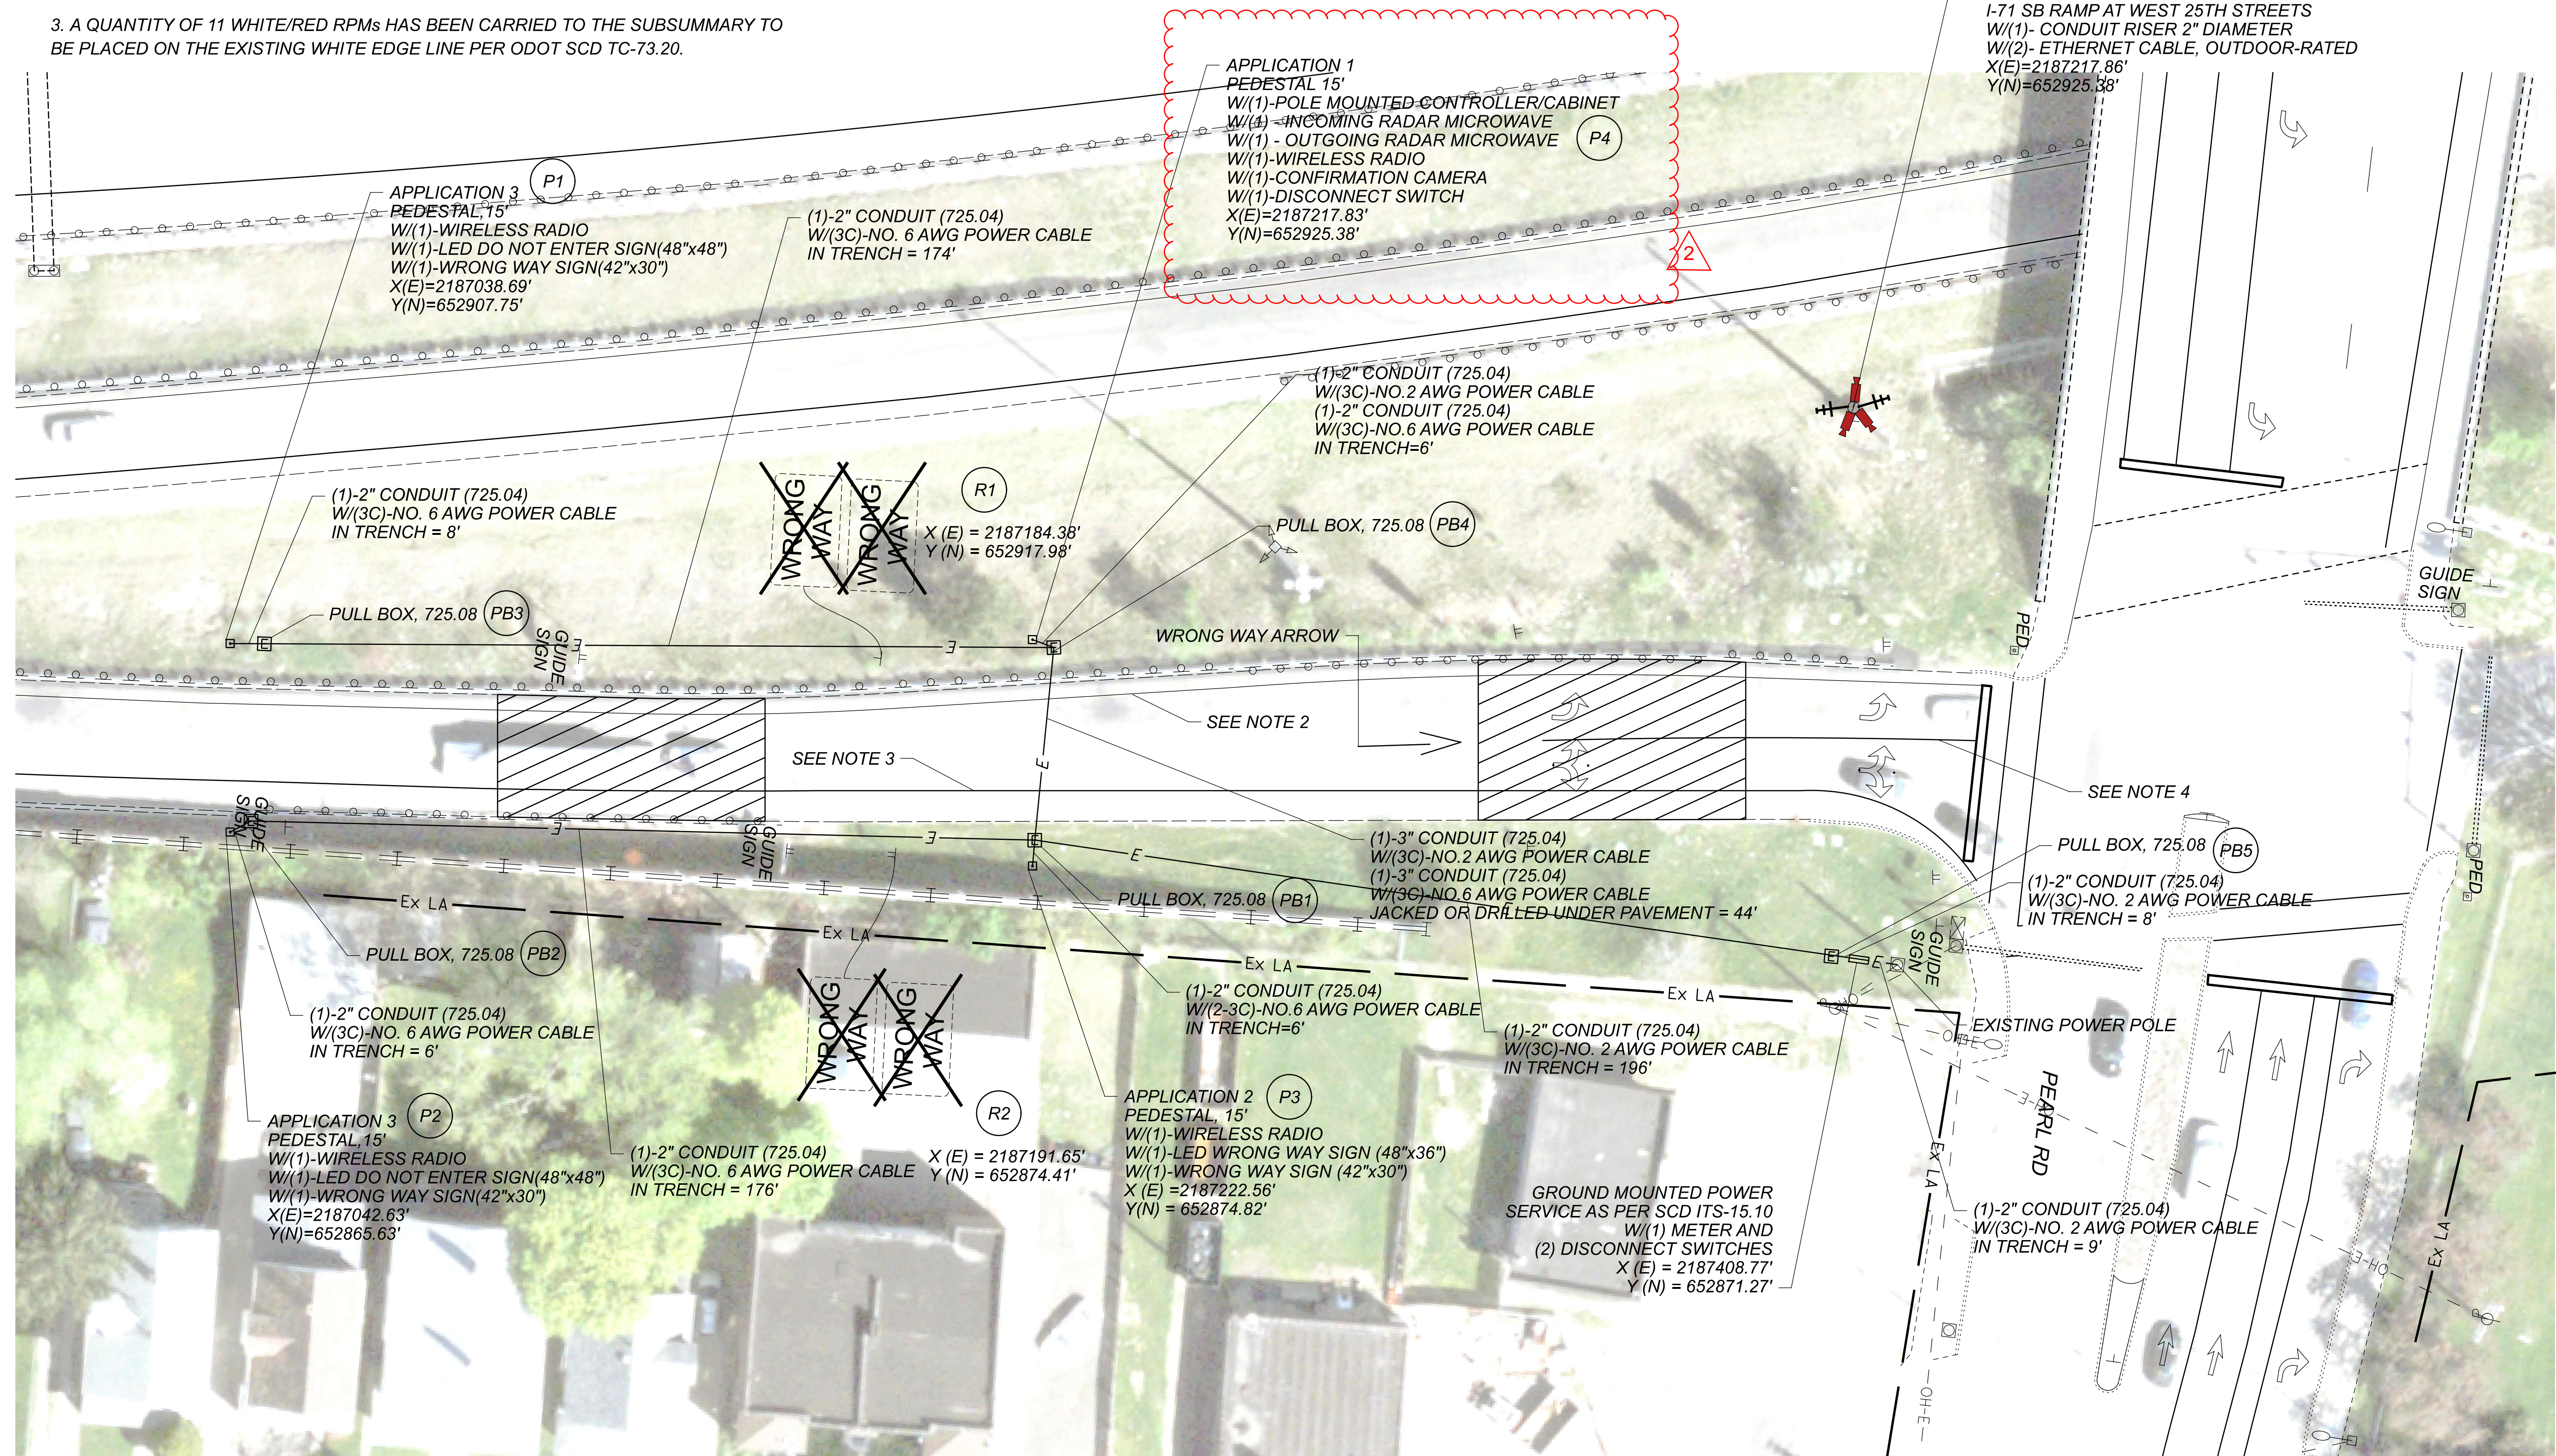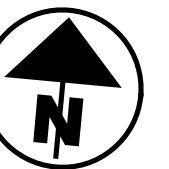

PULL BOX TABLE

| PULL BOX # | COORDINATES |           | SIZE |
|------------|-------------|-----------|------|
|            | X (E)       | Y (N)     |      |
| 1          | 2187222.51  | 652880.63 | 18"  |
| 2          | 2187047.05  | 652868.52 | 18"  |
| 3          | 2187046.34  | 652908.39 | 18"  |
| 4          | 2187222.75  | 652924.06 | 18"  |
| 5          | 2187403.61  | 652973.60 | 18"  |



- APPROXIMATE DETECTION AREA

| NO.       | DATE    | DESCRIPTION         |
|-----------|---------|---------------------|
| 2         | 5-23-23 | CHANGED CAMERA NOTE |
| 1         | 5-18-23 | ADDED NOTES         |
| REVISIONS |         |                     |

DESIGN AGENCY  
**WOOLPERT**  
 ONE EASTON OVAL  
 SUITE 400  
 COLUMBUS, OH 43219  
 T 614-476-6000

|            |             |
|------------|-------------|
| DESIGNER   | JTB         |
| REVIEWER   | JGW 2/13/23 |
| PROJECT ID | 113797      |
| SUBSET     | 0           |
| TOTAL      | 0           |
| SHEET      | 36          |
| TOTAL      | 72          |



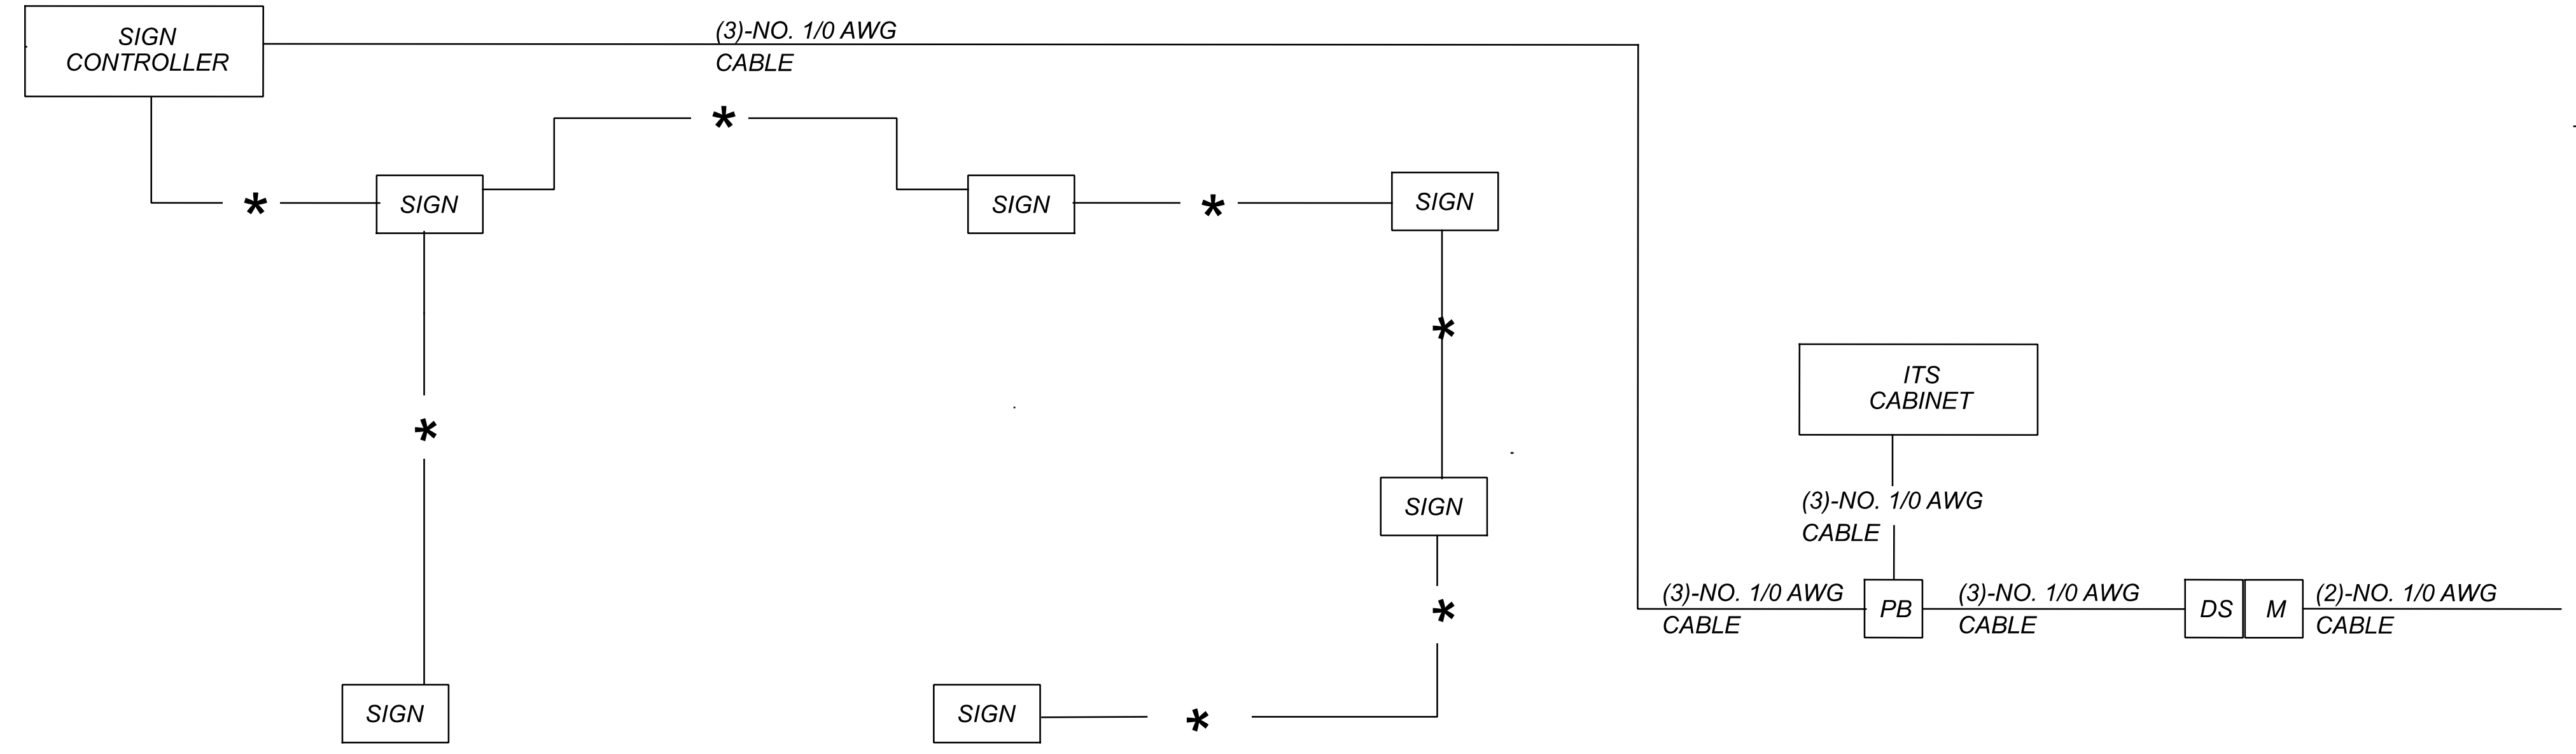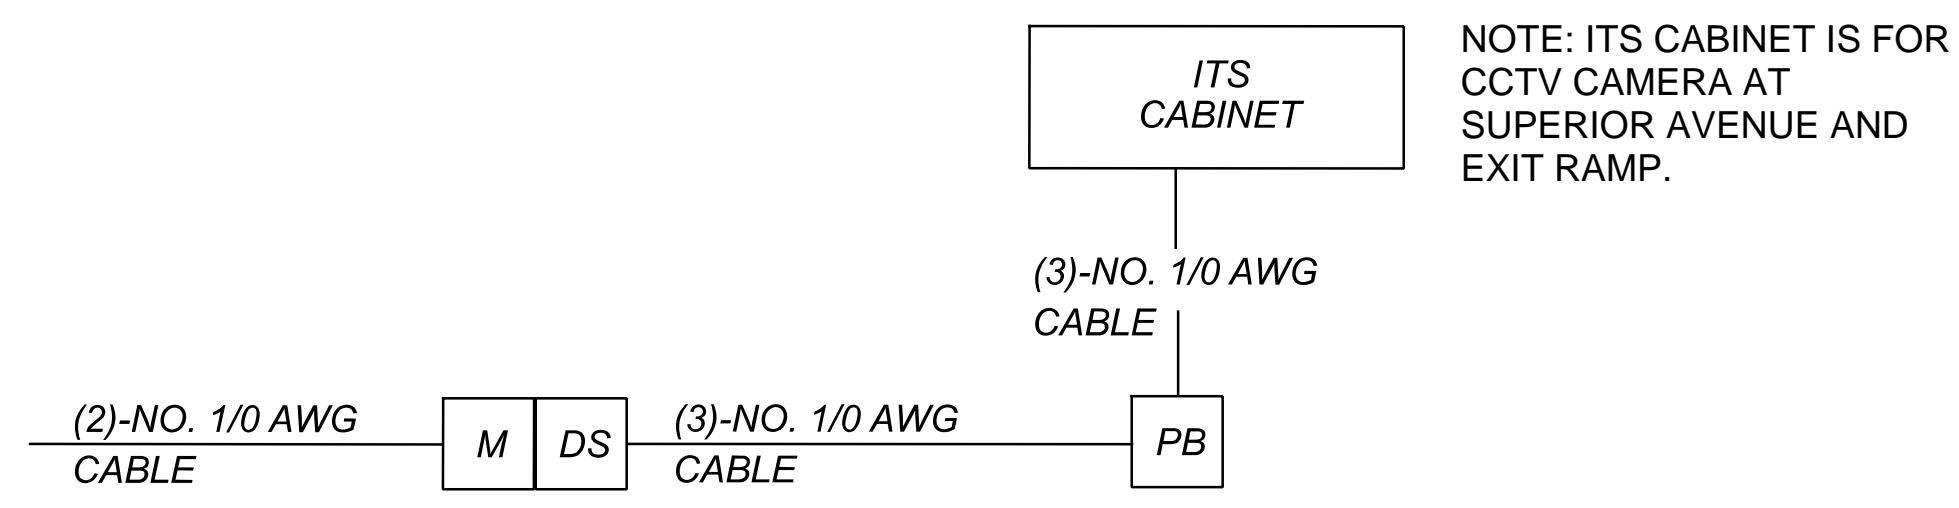

**WIRING DIAGRAM LEGEND**

- \* - (3C)-NO. 6 AWG
- DS - DISCONNECT SWITCH
- M - METER

WIRING DIAGRAM

2

| NO.       | DATE    | DESCRIPTION            |
|-----------|---------|------------------------|
| 2         | 5-23-23 | REVISED WIRING DIAGRAM |
| 1         | 5-18-23 | REVISED WIRING DIAGRAM |
| REVISIONS |         |                        |

DESIGN AGENCY  
**WOOLPERT**  
 ONE EASTON OVAL  
 SUITE 400  
 COLUMBUS, OH 43219  
 T 614-476-6000

DESIGNER  
**JTB**  
 REVIEWER  
**JGW 2/13/23**

|            |       |        |
|------------|-------|--------|
| PROJECT ID |       | 113797 |
| SUBSET     | TOTAL |        |
| 0          | 0     |        |
| SHEET      | TOTAL |        |
| 53         | 72    |        |